





[illegible]

CONTRACTOR : SAUDI SERVICES FOR ELECTRO MECHANIC WORKS CO. LTD.
CLIENT : SAUDI ELECTRICITY COMPANY, CENTRAL REGION BRANCH
PROJECT : REINFORCEMENT OF S/S 8501, 8808 & 8812
SUBSTATION : S/S 8501
CONTRACT NO. : 516/20/3
TITLE : OPERATION SINGLE LINE DIAGRAM - S/S 8501

We reserve all rights in this document and in the information contained therein. Reproduction, use or disclosure to third parties without express authority is strictly forbidden. © ABB Electrical Industries Ltd.

| | | | | | | | | | |
|---|---------|---|---------|--|---|-----|------|------|-----|
| CLIENT KINGDOM OF SAUDI ARABIA SAUDI ELECTRICITY COMPANY CENTRAL REGION BRANCH PROJECTS MANAGEMENT DEPARTMENT | |  | | المالك المملكة العربية السعودية الشركة السعودية للكهرباء فرع المنطقة الوسطى ادارة تنفيذ المشاريع | | | | | |
| CONTRACTOR : SAUDI SERVICES FOR ELECTRO MECHANIC WORKS CO. LIMITED P.O BOX 6341, RIYADH 11442 | |  | | المقاول الشركة السعودية لخدمات الأعمال الكهربائية والميكانيكية المحدودة ص ب ٦٣٤١ الرياض ١١٤٤٢ | | | | | |
| PROJECT NO. : 516/20/3 | | رقم العقد ٣/٢٠/٥١٦ | | | | | | | |
| PROJECT REINFORCEMENT OF 132 KV SUBSTATIONS NOS. 8501, 8808 & 8812 | | المشروع تعزيز محطات جهد ١٣٢ ك ف أرقام ٨٥٠١ , ٨٨٠٨ , ٨٨١٢ | | | | | | | |
| DESIGN BY | KARTHIK | DATE | : 01 29 | | TITLE: OPERATION SINGLE LINE DIAGRAM 8501 | | | | |
| DRAWN BY | MIM | SCALE | : NTS | | | | | | |
| DESIGNER :  ABB AUTOMATION CO. LTD. شركة ايه بي بي لأجهزة التحكم الآلي المحدودة P.O BOX 414 RIYADH 11383 KINGDOM OF SAUDI ARABIA | | | | | | | | | |
| DWG. NO. S10114-AAAAA | | SHEET # 000 REV. # 00 | | | | | | | |
| OPERATIONAL SINGLE LINE DIAGRAM (EXISTING/MODIFIED) | | Resp dept | | AUT | Rev ind | 00 | Lang | en | |
|  ABB Electrical Ind. | | S10114-AAAAA | | Sheet | | 000 | | Cont | 001 |

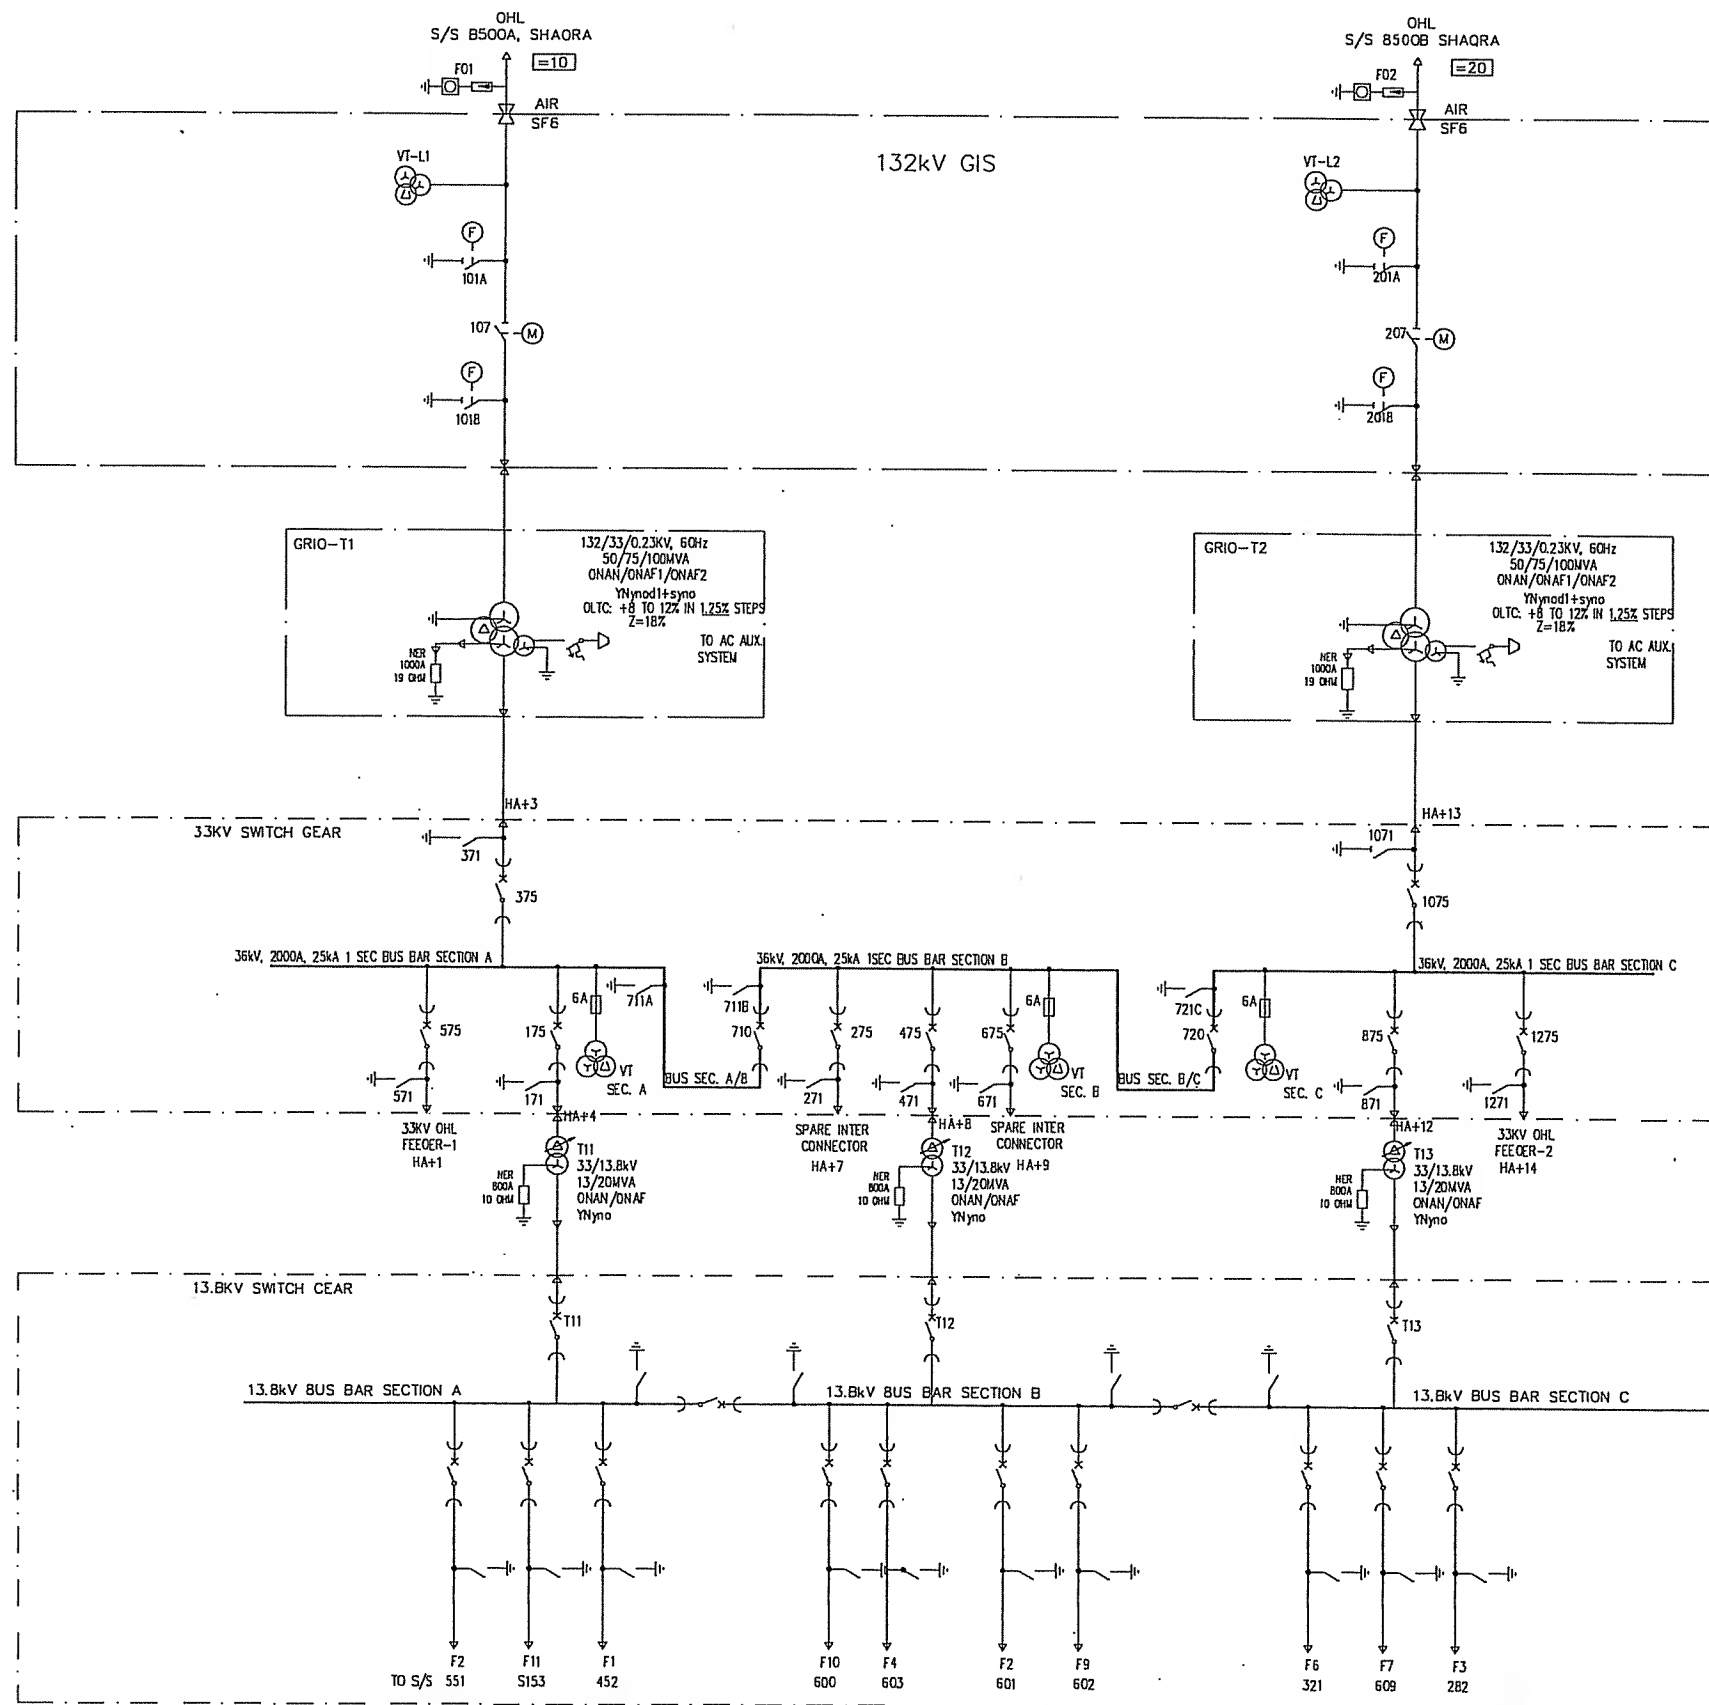
AS BUILT

Based on

| | | | | | | |
|--------|----------|------|------|----------|-------|--------------------------------|
| | | | | Prepared | 01 29 | KARTHIK |
| | | | | Approved | 01 29 | KAMAL AL-MUHANNA |
| | | | | | | S/S 8501 , 132/33/13.8KV |
| | | | | | | SEC-CRB, CONTRACT No. 516/20/3 |
| Rev In | Revision | Appd | Year | Week | | |

abbd_a3 rev. b

We reserve all rights in this document and in the information contained therein. Reproduction, use or disclosure to third parties without express authority is strictly forbidden. © ABB Electrical Industries Ltd.



| LEGENDS | |
|---------|---------------------------------------|
| | POWER TRANSFORMER |
| | 33kV CIRCUIT BREAKER |
| | 3-PHASE VOLTAGE TRANSFORMER |
| | EARTHING SWITCH FAST ACTING |
| | 132kV ON LOAD DISCONNECTOR |
| | MOULDED CASE CIRCUIT BREAKER |
| | OHL FEEDER |
| | AC DISTRIBUTION BOARD |
| | UGF CABLE SEALING HEAD |
| | OHL CONNECTION - (GAS TO AIR BUSHING) |
| | SURGE ARRESTOR |
| | NEUTRAL EARTHING RESISTOR |
| | BUSHING CABLE CONNECTION |
| | FUSE (RATINGS SHOWN) |

| | | | |
|--|-----------------|--|----------------|
| CLIENT KINGDOM OF SAUDI ARABIA SAUDI ELECTRICITY COMPANY CENTRAL REGION BRANCH PROJECTS MANAGEMENT DEPARTMENT | | المملكة العربية السعودية الشركة السعودية للكهرباء فرع المنطقة الوسطى إدارة تنفيذ المشاريع | |
| CONTRACTOR : SAUDI SERVICES FOR ELECTRO MECHANIC WORKS CO. LIMITED P.O. BOX 6341, RIYADH 11142 | | المقاول الشركة السعودية لخدمات الأعمار الكهربائية والميكانيكية المحدودة ص ب ٦٣٤١ الرياض ١١٤٤٢ | |
| PROJECT NO. : 516/20/3 | | رقم المشروع ٥١٦ / ٢٠ / ٣ | |
| PROJECT REINFORCEMENT OF 132 KV SUBSTATIONS NOS. 8501, 8508 & 8512 | | المشروع تعزيز محطات جهد ١٣٢ ك ف رقم ٨٥٠١ ، ٨٥٠٨ ، ٨٥١٢ | |
| DESIGN BY : KARTHIK | DATE : 01.35 | TITLE: OPERATIONAL SINGLE LINE DIAGRAM (EXISTING)-S/S 8501 | |
| DRAWN BY : MM | SCALE : NTS | DWG. NO. S10114-AAAAA | |
| DESIGNER : ABB ABB AUTOMATION CO. LTD. شركة أ بي بي لأجهزة التحكم الكلي المحدودة P.O. BOX 414 RIYADH 11383 KINGDOM OF SAUDI ARABIA | | SHEET # 001 REV. # 00 | |
| Resp dept : AUT | | Rev ind : 00 | Lang : en |
| S10114-AAAAA | | Sheet : 001 | Cont. : 002 |

File name

00 AS BUILT
Rev. I Revision


Prepared 01.35 KARTHIK
Approved 01.35 KAMAL
S/S 8501, 132/33/13.8kV
SEC-CRB, CONTRACT NO.: 516/20/3

OPERATIONAL SINGLE LINE DIAGRAM
(EXISTING)

ABB ABB Electrical Ind.

AUT-A3-C1-REVO

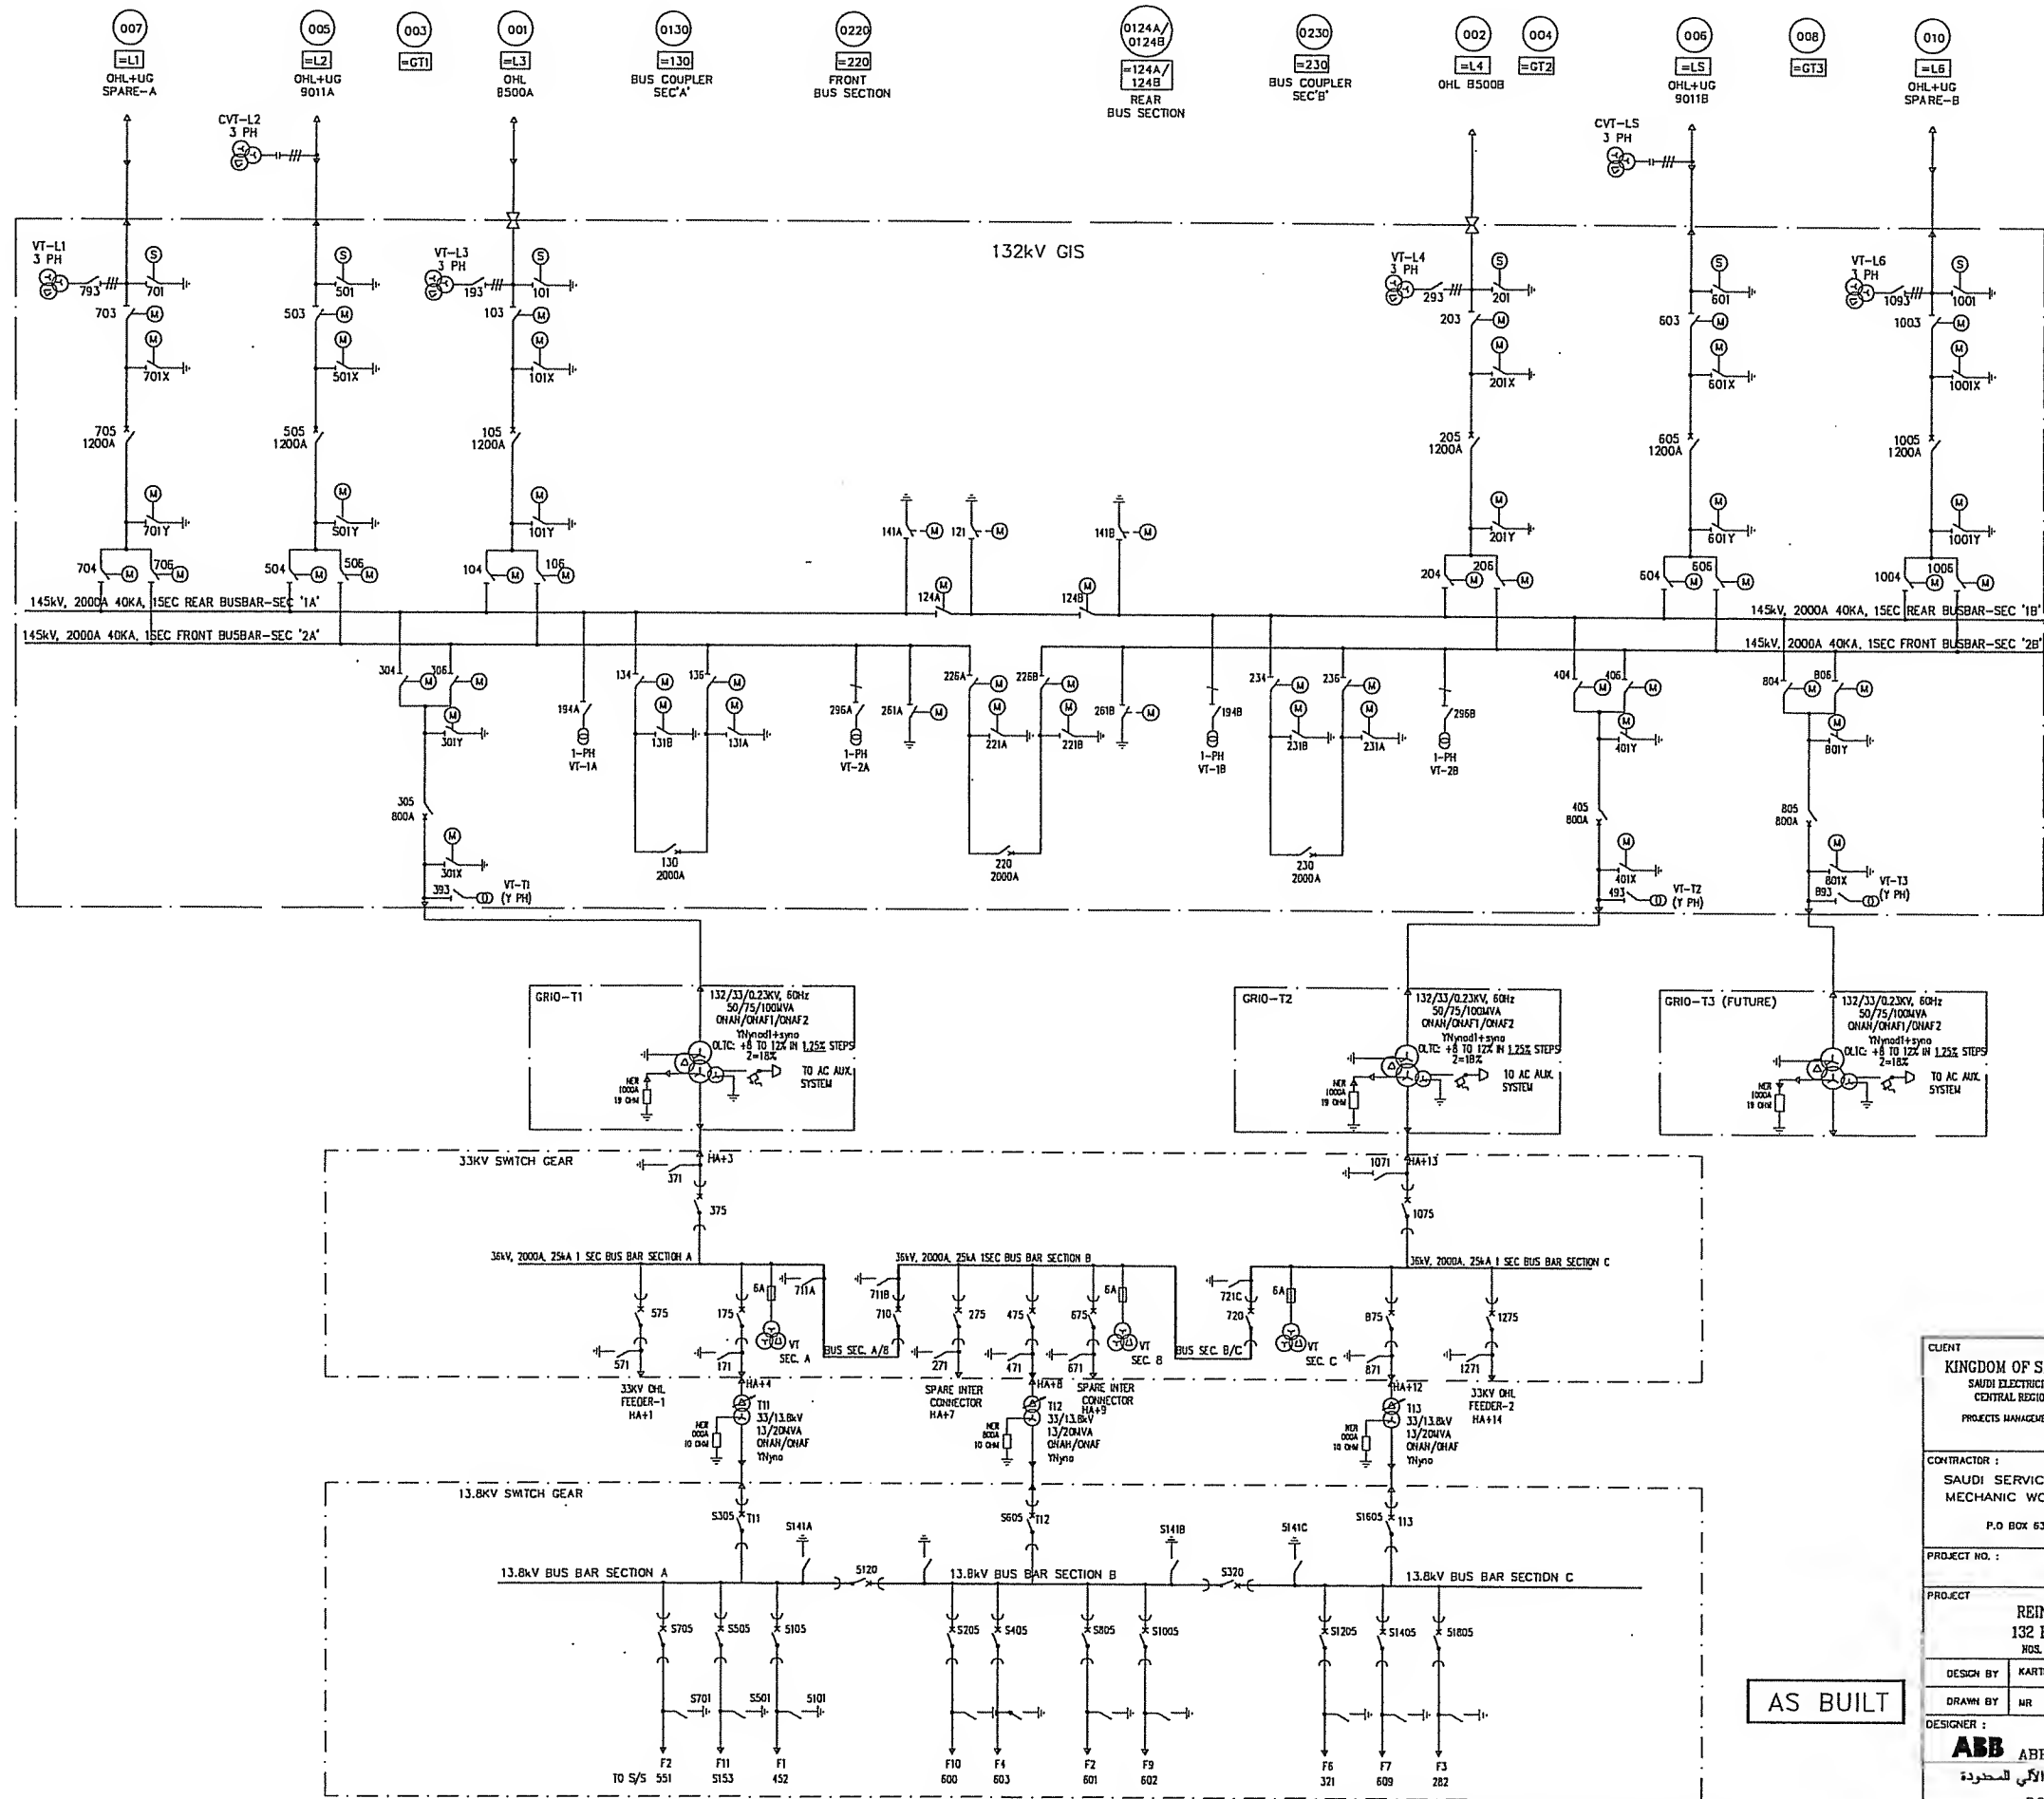We reserve all rights in this document and in the information contained herein. Reproduction, use or disclosure to third parties without express authority is strictly forbidden. © ABB Electrical Industries Ltd.



| LEGENDS | |
|---------|--|
| | POWER TRANSFORMER |
| | 33kV CIRCUIT BREAKER |
| | 3-PHASE - 60kV VOLTAGE TRANSFORMER WITH MANUAL OPERATING DEVICE |
| | CAPACITIVE VOLTAGE TRANSFORMER (3 PHASE) |
| | 132kV CIRCUIT BREAKER |
| | 132kV 1-PHASE VOLTAGE TRANSFORMER WITH MANUAL OPERATING DEVICE |
| | MAINTENANCE EARTHING SWITCH (MOTOR DRIVEN OPERATION) |
| | HIGH SPEED EARTHING SWITCH (MOTOR DRIVEN SPRING CHARGED OPERATION) |
| | DISCONNECTING SWITCH (MOTOR DRIVEN OPERATION) |
| | MOULDED CASE CIRCUIT BREAKER |
| | OHL FEEDER |
| | AC DISTRIBUTION BOARD |
| | UCF CABLE SEALING HEAD |
| | OHL CONNECTION - (CAS TO AIR BUSHING) |
| | NEUTRAL EARTHING RESISTOR |
| | BUSHING CABLE CONNECTION |
| | FUSE (RATINGS SHOWN) |

132kV DOUBLE BUSBAR GIS
MAKE: HICO
RATED: 145kV, 2000A AT 55°C
SHORT CIRCUIT RATING: 40KA, 1SEC
NOTE:
1. THE EXISTING 132/33kV G1/G2 FEEDER ARRANGEMENT FED FROM 8500 S/S TO BE MODIFIED TO FEED FROM 132kV GIS-DOUBLE BUSBAR, AS PER THE ARRANGEMENT SHOWN IN THIS SLD

| | | | |
|---|-----------------|---|----------|
| CLIENT KINGDOM OF SAUDI ARABIA SAUDI ELECTRICITY COMPANY CENTRAL REGION BRANCH PROJECTS MANAGEMENT DEPARTMENT | | المملكة العربية السعودية الشركة السعودية للكهرباء إدارة المنطقة الوسطى إدارة تنفيذ المشاريع | |
| CONTRACTOR : SAUDI SERVICES FOR ELECTRO MECHANIC WORKS CO. LIMITED P.O BOX 6341, RIYADH 11442 | | المقاول لشركة السعودية لخدمات الأعمال الكهربائية والميكانيكية المحدودة ص ب ٦٣٤١ الرياض ١١٤٤٢ | |
| PROJECT NO. : 516/20/3 | | رقم المشروع ٢٠١٦ / ٥١٦ | |
| PROJECT REINFORCEMENT OF 132 KV SUBSTATIONS HOS. 6301, 6008 & 6012 | | المشروع تعزيز محطات جهد ١٣٢ ك ف رقم ٦٣٠١، ٦٠٠٨، ٦٠١٢ | |
| DESIGN BY : KARTHIK | DATE : 01.35 | TITLE: OPERATIONAL SINGLE LINE DIAGRAM S/S 8501 | |
| DRAWN BY : HR | SCALE : NTS | | |
| DESIGNER : ABB AUTOMATION CO. LTD. شركة إيه بي سي لأجهزة التحكم الألي المحدودة P.O BOX 414 RIYADH 11303 KINGDOM OF SAUDI ARABIA | | DWG. NO. S10114-AAAAA SHEET / 002 REV. / 00 | |
| Resp dep: AUT | | Rev ind: 00 | Lang: en |
| S10114-AAAAA | | Sheet: 002 | Cont: -- |

| | | | | | |
|-----------------|--|------------------------|--|--|--|
| File name | | Prepared 01.35 KARTHIK | | OPERATIONAL SINGLE LINE DIAGRAM (MODIFIED) | |
| | | Approved 01.35 KAMAL | | ABB Electrical Ind. | |
| 00 AS BUILT | | RG 03 46 | | | |
| Rev In Revision | | Appd Year Week | | | |
| AUT-A3-C1-REV0 | | | | | |

| ITEM | DESIGNATION | SHEET |
|------|-------------------------------|-------|
| =1 | 33/13,8kV TRANSFORMER BAY T11 | 1 |
| =2 | 33kV INTERCONNECTOR LINE | 51 |
| =3 | 33kV INCOMING TRANSFORMER BAY | 101 |
| =4 | 33/13,8kV TRANSFORMER BAY T12 | 151 |
| =5 | 33kV INTERCONNECTOR LINE | 251 |
| =8 | 33/13,8kV TRANSFORMER BAY T13 | 351 |
| =10 | 33kV INCOMING TRANSFORMER BAY | 451 |
| =71 | 33kV BUSBAR ZONE 1 | 651 |
| =T11 | 33/13,8kV TRANSFORMER T11 | 701 |
| =72 | 33kV BUSBAR ZONE 2 | 751 |
| =T12 | 33/13,8kV TRANSFORMER T12 | 801 |
| =73 | 33kV BUSBAR ZONE 3 | 851 |
| =T13 | 33/13,8kV TRANSFORMER T13 | 901 |
| =AB | 33kV BUSSECTION | 951 |
| =BC | 33kV BUSSECTION | 1001 |

الخطة النهائية
AS BUILT

| | |
|--|---|
| الشركة السعودية الموحدة للكهرباء بالمنطقة الوسطى | |
| SCECO CENTRAL PROJECTS MANAGEMENT DEPARTMENT | |
| CONTRACT NO. 503/9/3 | PROJECT: WASHAM, DAWADMI & SUDAIR PROJECT |
| 132/33 kV-MAJMA'AH S/S 8501 | |
| CONTRACTOR: ACEM - ASEA | |
| Rev | Ind |
| 2 | 1 |
| Lang | Sheet |
| | 0.10 |
| Rev | Ind |
| 2 | 1 |

SYMBOL ID /D:XL824028-FBR:0.10/0 92-07-02 1B.50

| | | | | |
|---|------------|----|-------|------------------|
| 2 | SCECO SNAG | LS | 92 26 | S/S 8501 |
| 1 | AS BUILT | LS | 91 21 | 33kV SWG |
| | | | | LIST OF CONTENTS |

Design checked by
B NILSSON
Drawing checked by
L SVENSSON
Drawn by
SK

CIRCUIT DIAGRAM
S/S 8501 132/33kV
SCECO CENTRAL SAUDI ARABIA

ABB HV SWITCHGEAR

Iss by Dept Year Week
TOCF 90 36

L 9743.1017
XL 824 028-FBR

AL 1010
P1010

| ITEM | DESIGNATION | SHEET |
|-------|-------------------------------|-------|
| +XA.1 | SCADA INTERFACE EQUIPMENT | 12 |
| +HA.4 | AUX. VOLTAGE SUPPLY | 15 |
| | HEATING AND LIGHTING | 16 |
| | C.B. OPERATION CIRCUITS | 18 |
| -175 | CIRCUIT BREAKER EQUIPMENT | 19 |
| | INTERLOCKING | 23 |
| -171 | EARTH SWITCH EQUIPMENT | 24 |
| | TRANSFORMER DIFFERENTIAL PROT | 27 |
| | OVERCURRENT PROT | 28 |
| -T11 | CURRENT TRANSFORMER | 30 |

الخطة النهائية
AS BUILT


SYMBOL ID /D:XL824028-FBR:1/0

DATE 91-05-31 12.10

AS BUILT

LIST OF CONTENTS

| | | | | |
|-----------------------------------|---|-----|-----------|-------|
| Design checked by 8 NILSSON | CIRCUIT DIAGRAM | Rev | Int | Sheet |
| Drawing checked by S STRIOGHAN | S/S 8501 132/33kV SCECO CENTRAL SAUDI ARABIA | L | 9743.1017 | 1 |
| Drawn by IA | ABB HV SWITCHGEAR | Rev | Int | Sheet |
| TCF | 90 10 | 1 | 12 | |

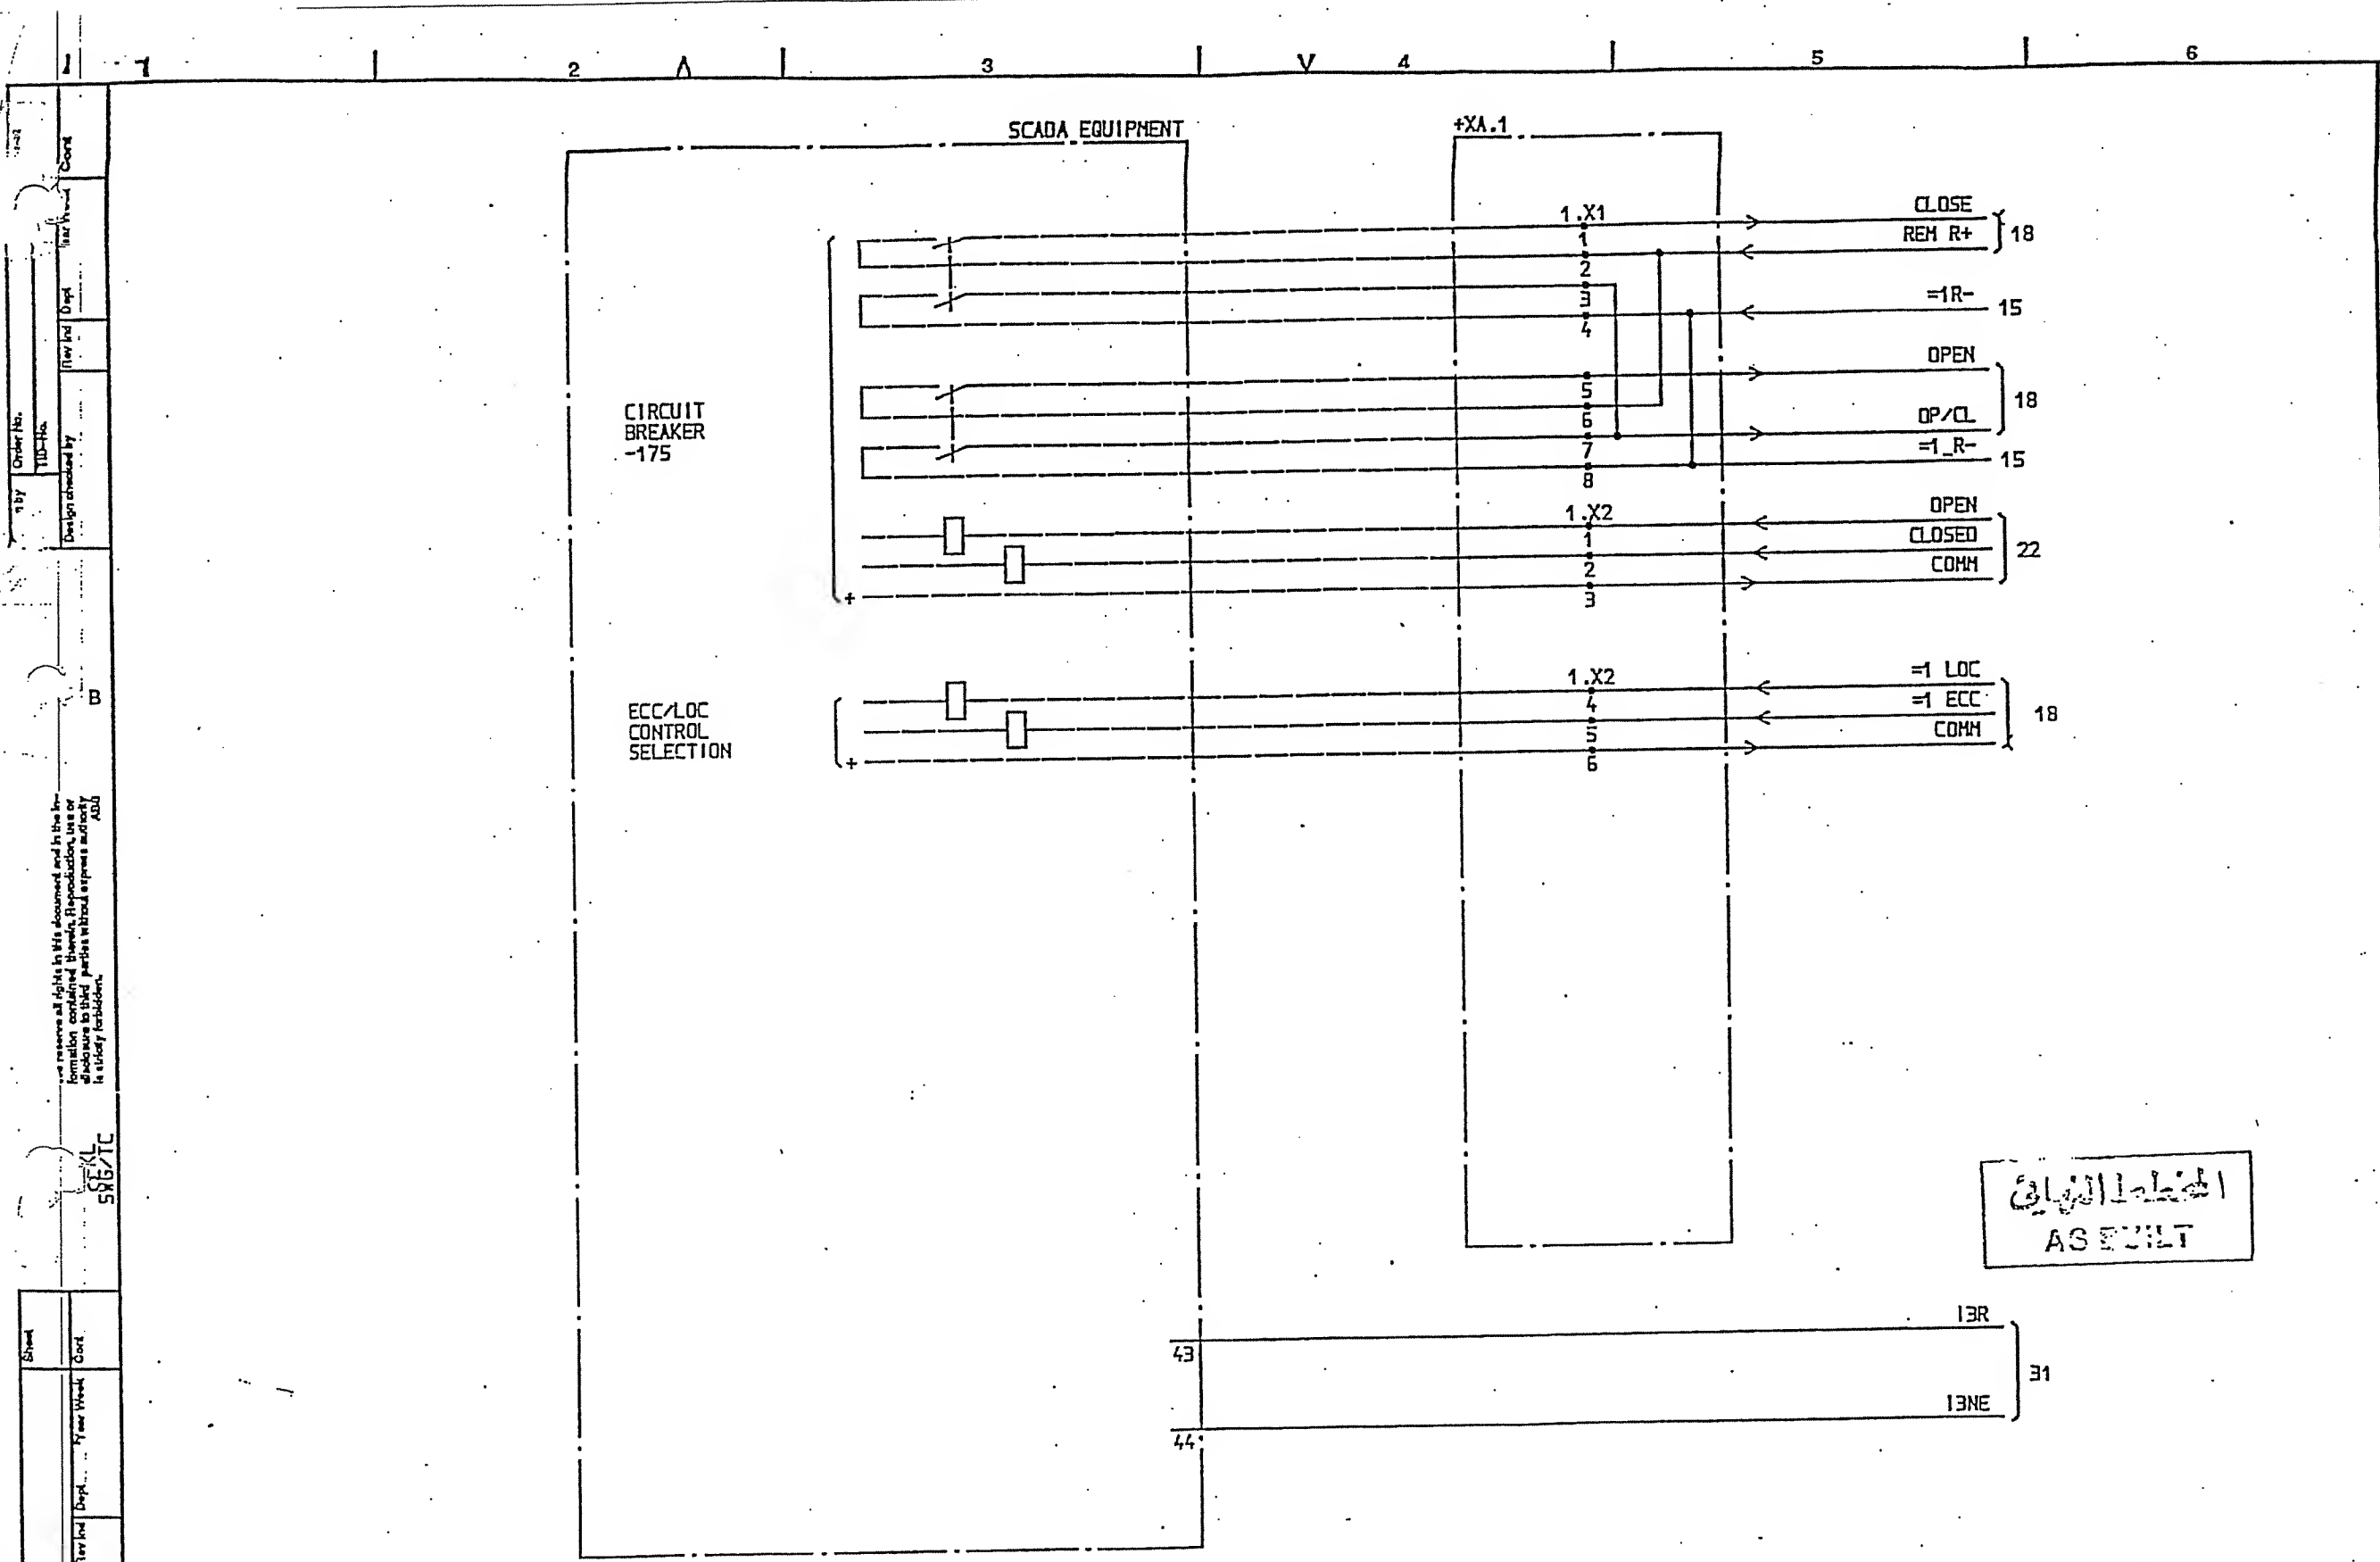

المشاور
AS EULT

SYMBOL ID /D:XL82402B-FBR:12/0

DATE 91-05-31 12.10

| | | | | |
|---|----------|------|-----------|-------------------------------|
| 1 | AS BUILT | LS | 91 21 | 33/13,8kV TRANSFORMER BAY T11 |
| 2 | | Appd | Year Week | SCADA INTERFACE EQUIPMENT |

Design checked by
B NILSSON
Drawing checked by
S STRIDSHAN
Drawn by
IA




CIRCUIT DIAGRAM
S/S 8501 132/33kV
SCECO CENTRAL SAUDI ARABIA
ABB HV SWITCHGEAR

Iss by Dept
TCF
Year Week
90 10

L 9743.1017
XL 824 028-FBR

| | | |
|-----|-----|-------|
| Rev | Ind | Sheet |
| 1 | 12 | 15 |

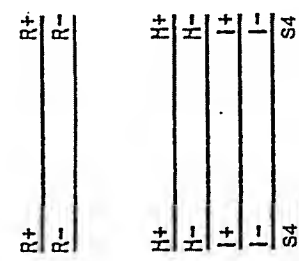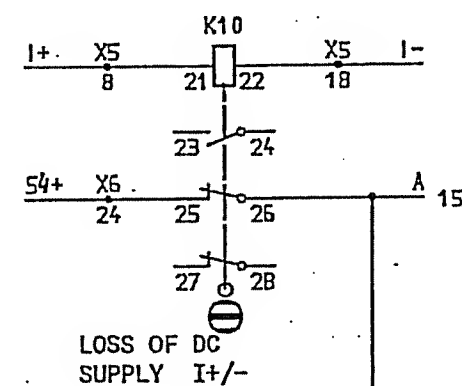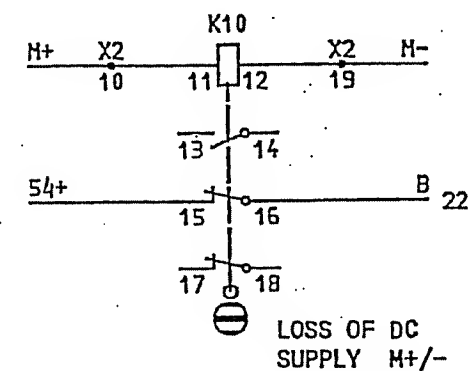ASB



VS...
- P.N.J. ...
31/12.02

الجنرال الثاني
AS EILT

© MODIFICATION DONE
UNDER CONTRACT 516/20/3

MODIFIED

SYMBOL ID NO: XL824028-FBR:15.10/0

DATE 91-06-06 09.55


33/13,8kV TRANSFORMER BAY T11

Design checked by
B NILSSON
Drawing checked by
L SVENSSON
Drawn by
SK

| | |
|----------------------------|---|
| CIRCUIT DIAGRAM | |
| 5/5 8501 132/33kV | |
| 5CECD CENTRAL SAUDI ARABIA | |
| ABB HV SWITCHGEAR | 7 |

| |
|-----------------|
| L 9743.1017 |
| XL 824 028-FBR. |

| | |
|-----------|-------|
| Flow Incl | Sheet |
| Lang | Sheet |
| Flow Incl | Cont |
| 1 | 16 |

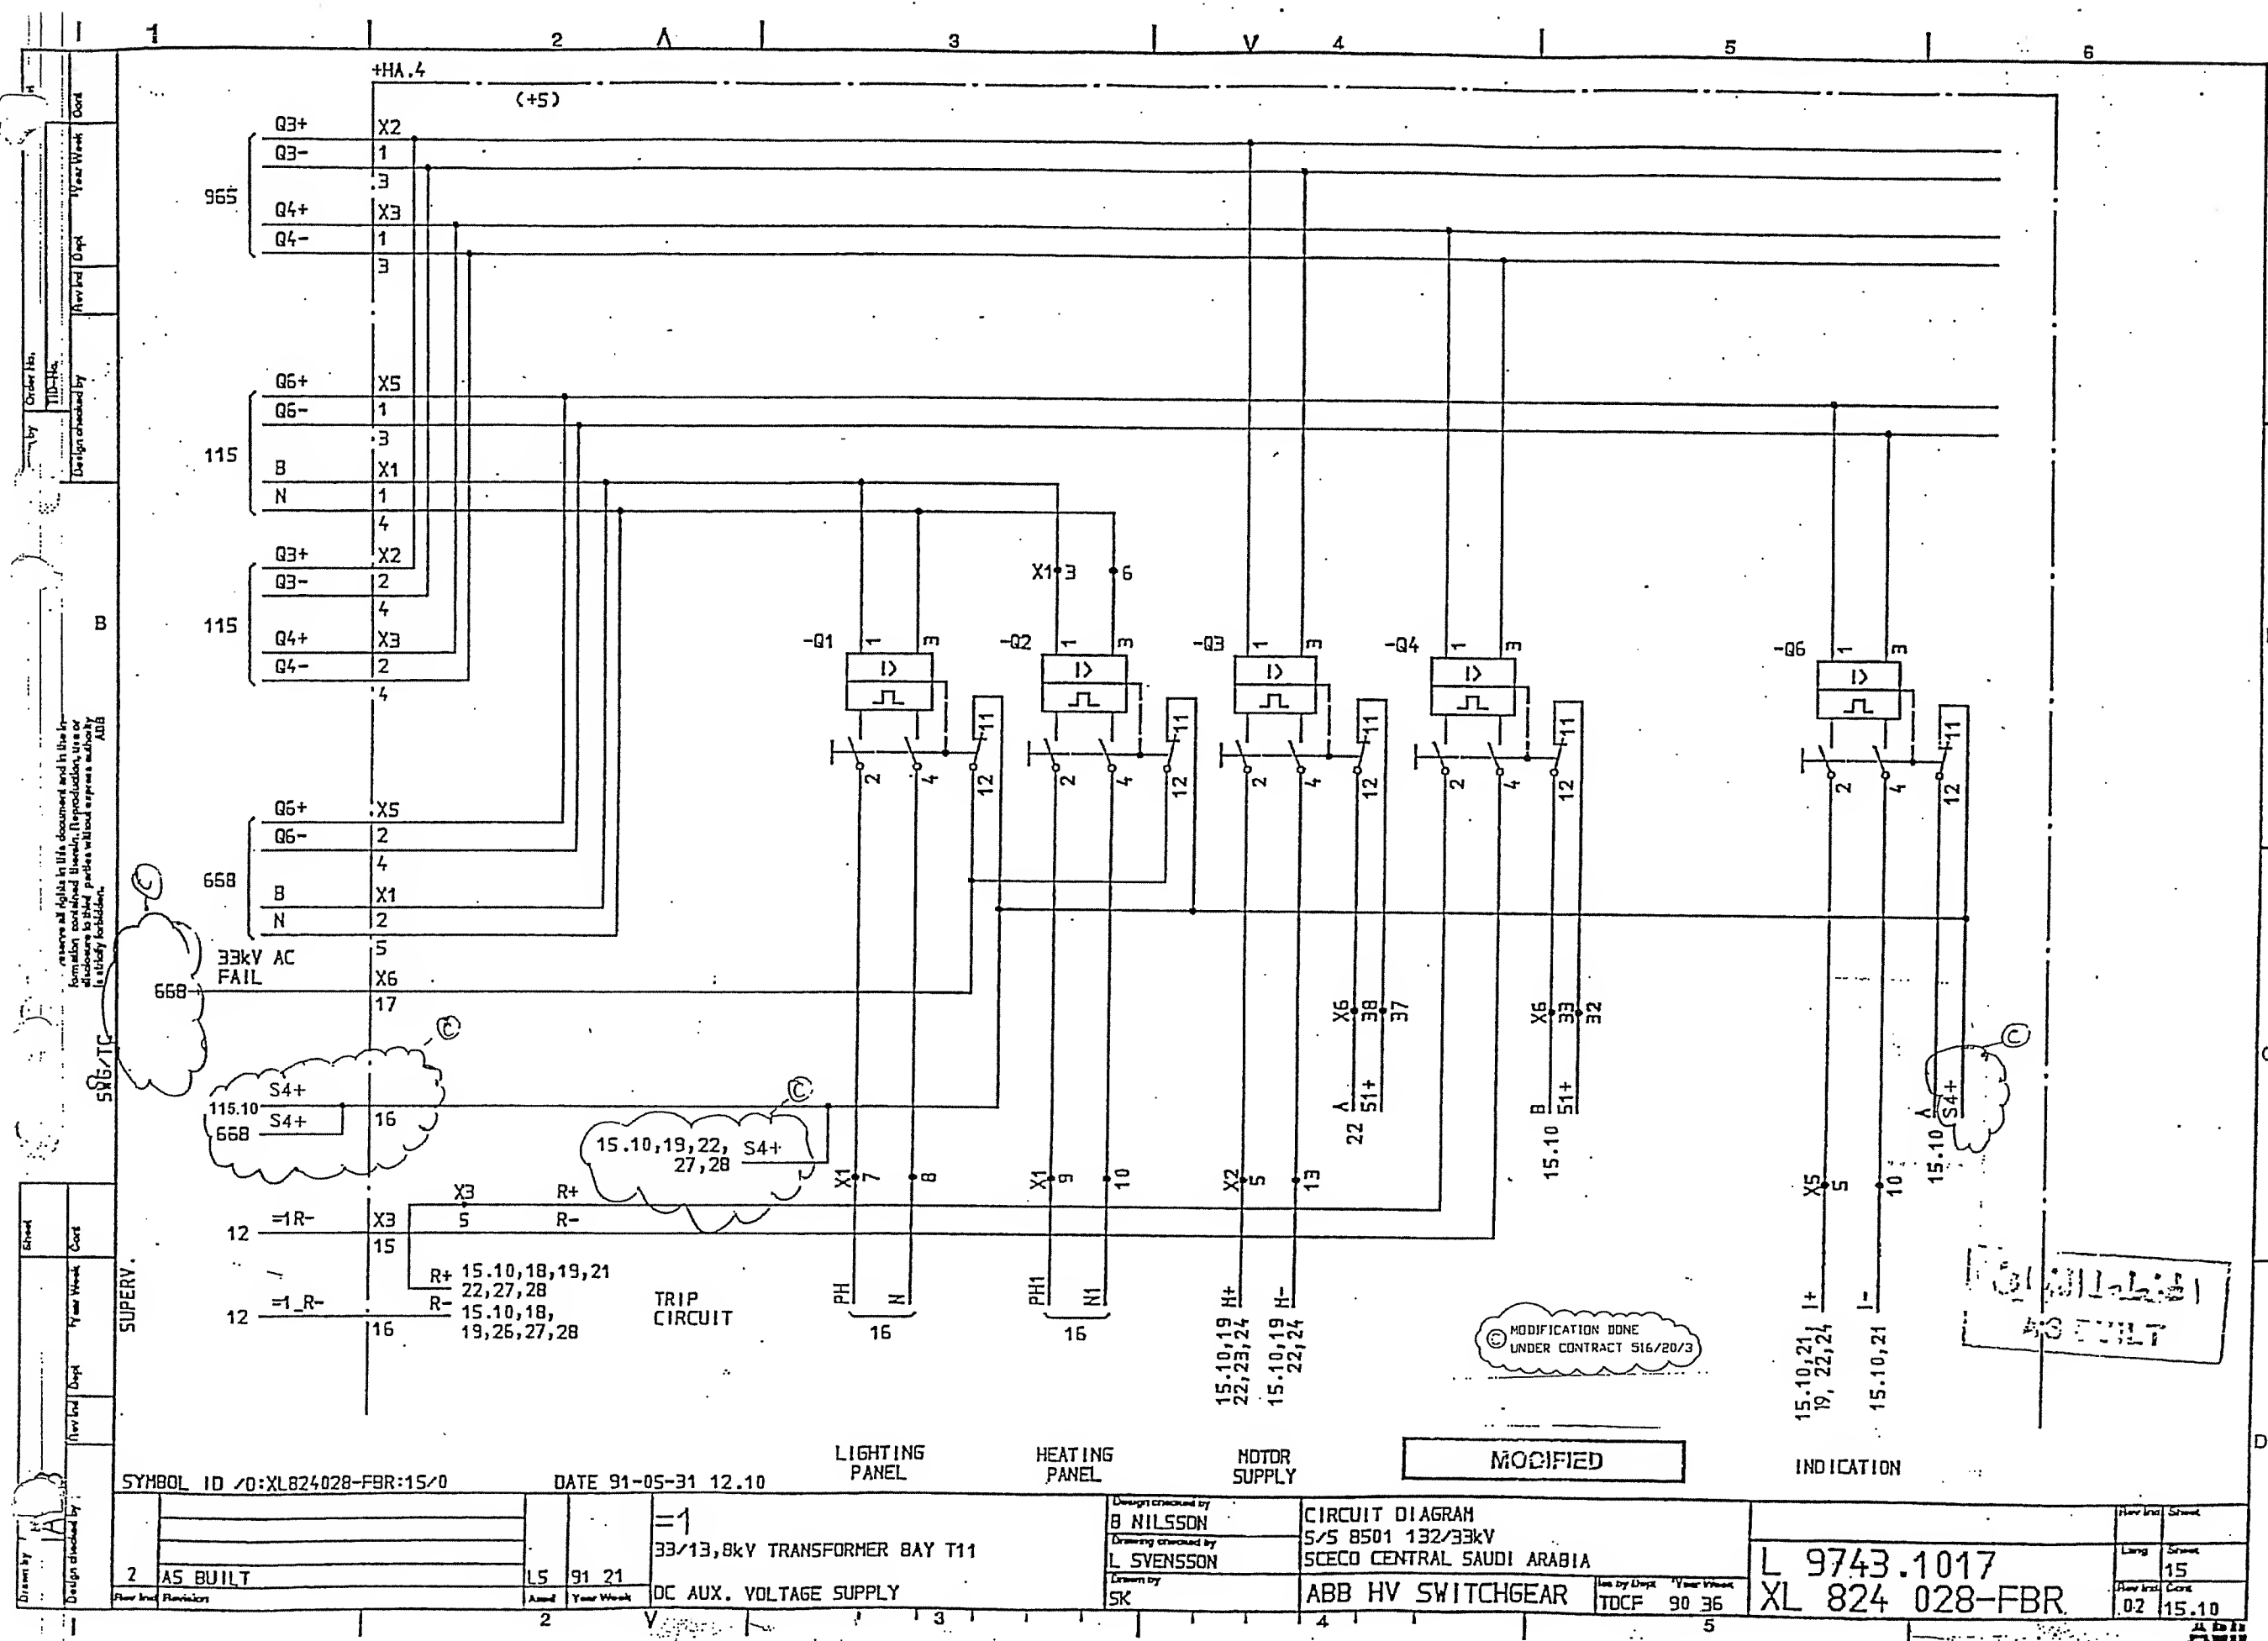

| | | | |
|-----------|-----------|-------|-------------------|
| Order No. | Year/Week | Dept. | Design checked by |
| 100-100 | 91/21 | 15 | 91/21 |

| | | | |
|----------|---------|-----------|-------|
| Drawn by | Checked | Year/Week | Dept. |
| 100-100 | 100-100 | 91/21 | 15 |

| | | | |
|----------|-----------|-----------|-------|
| Flow No. | Revisions | Year/Week | Dept. |
| 2 | AS BUILT | 91/21 | 15 |

SYMBOL ID /0:XL824028-FBR:15/0

DATE 91-05-31 12.10

=1
33/13,8kV TRANSFORMER BAY T11
DC AUX. VOLTAGE SUPPLY


Design checked by
B NILSSON
Drawing checked by
L SVENSSON
Drawn by
SK


CIRCUIT DIAGRAM
S/S 8501 132/33kV
SCECO CENTRAL SAUDI ARABIA
ABB HV SWITCHGEAR

Iss. by Dept
TDCF 90 36

L 9743.1017
XL 824 028-FBR

| | |
|----------|-----------|
| Flow No. | Revisions |
| 15 | 02 |

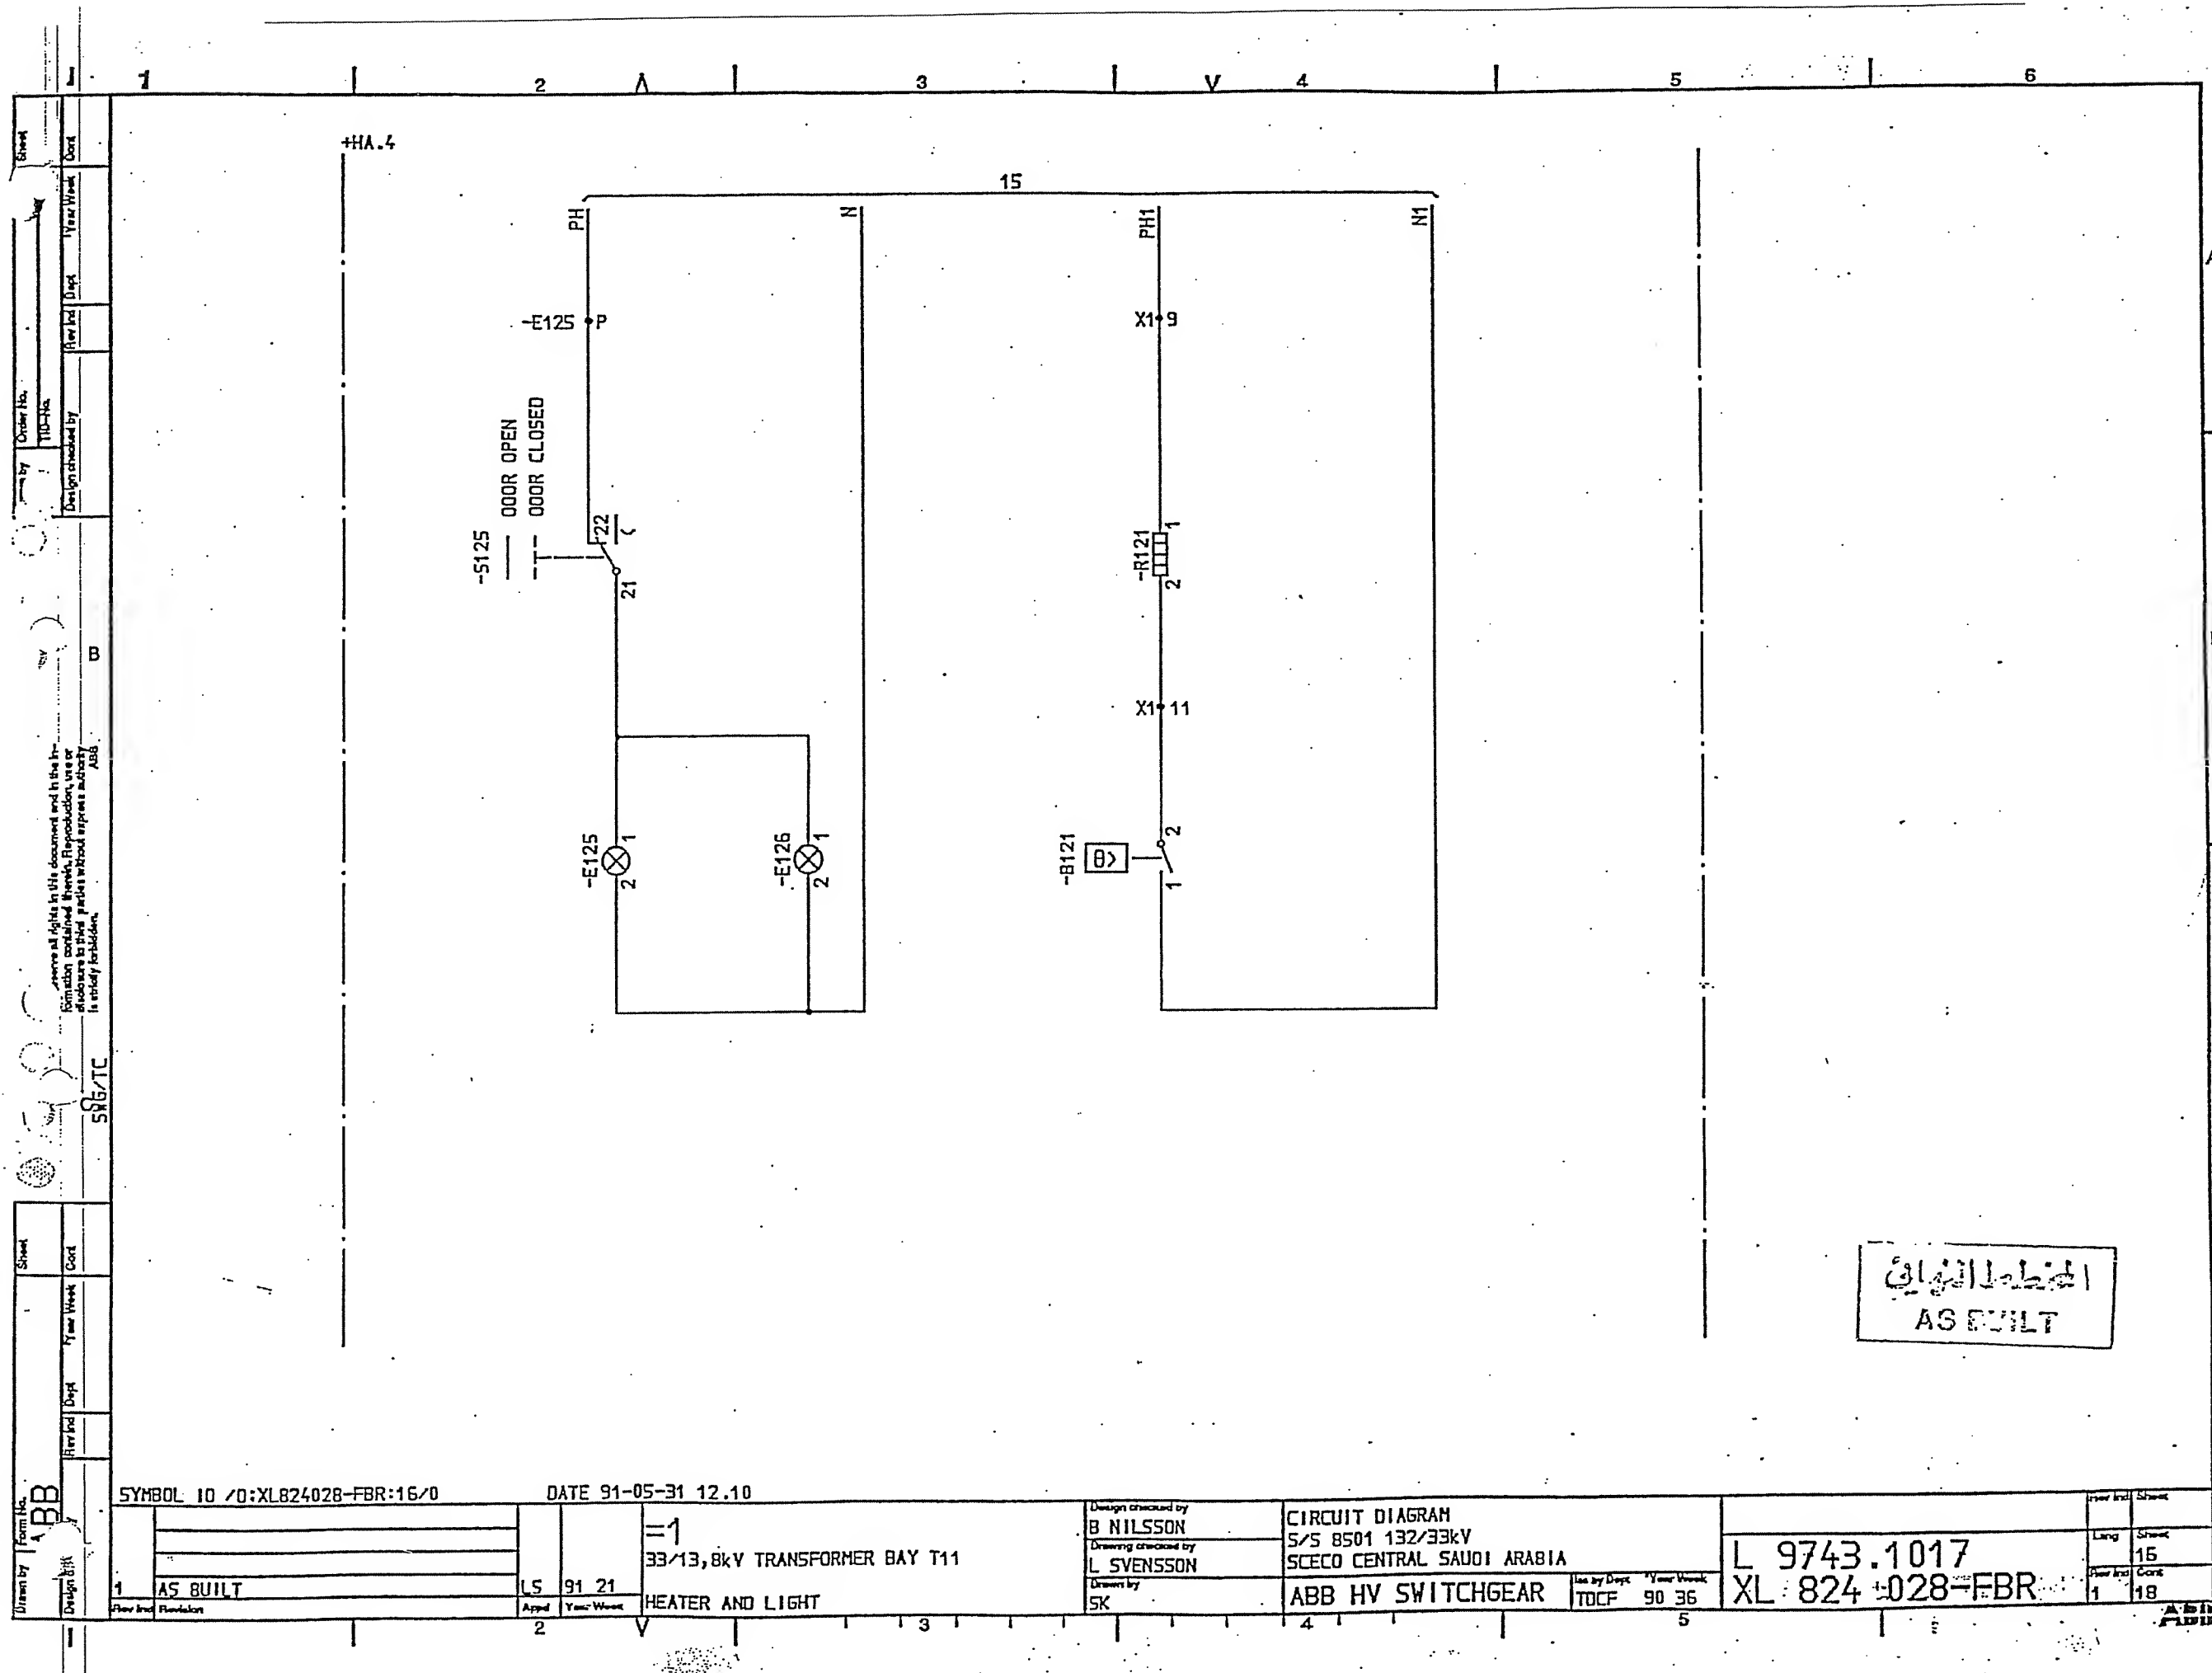

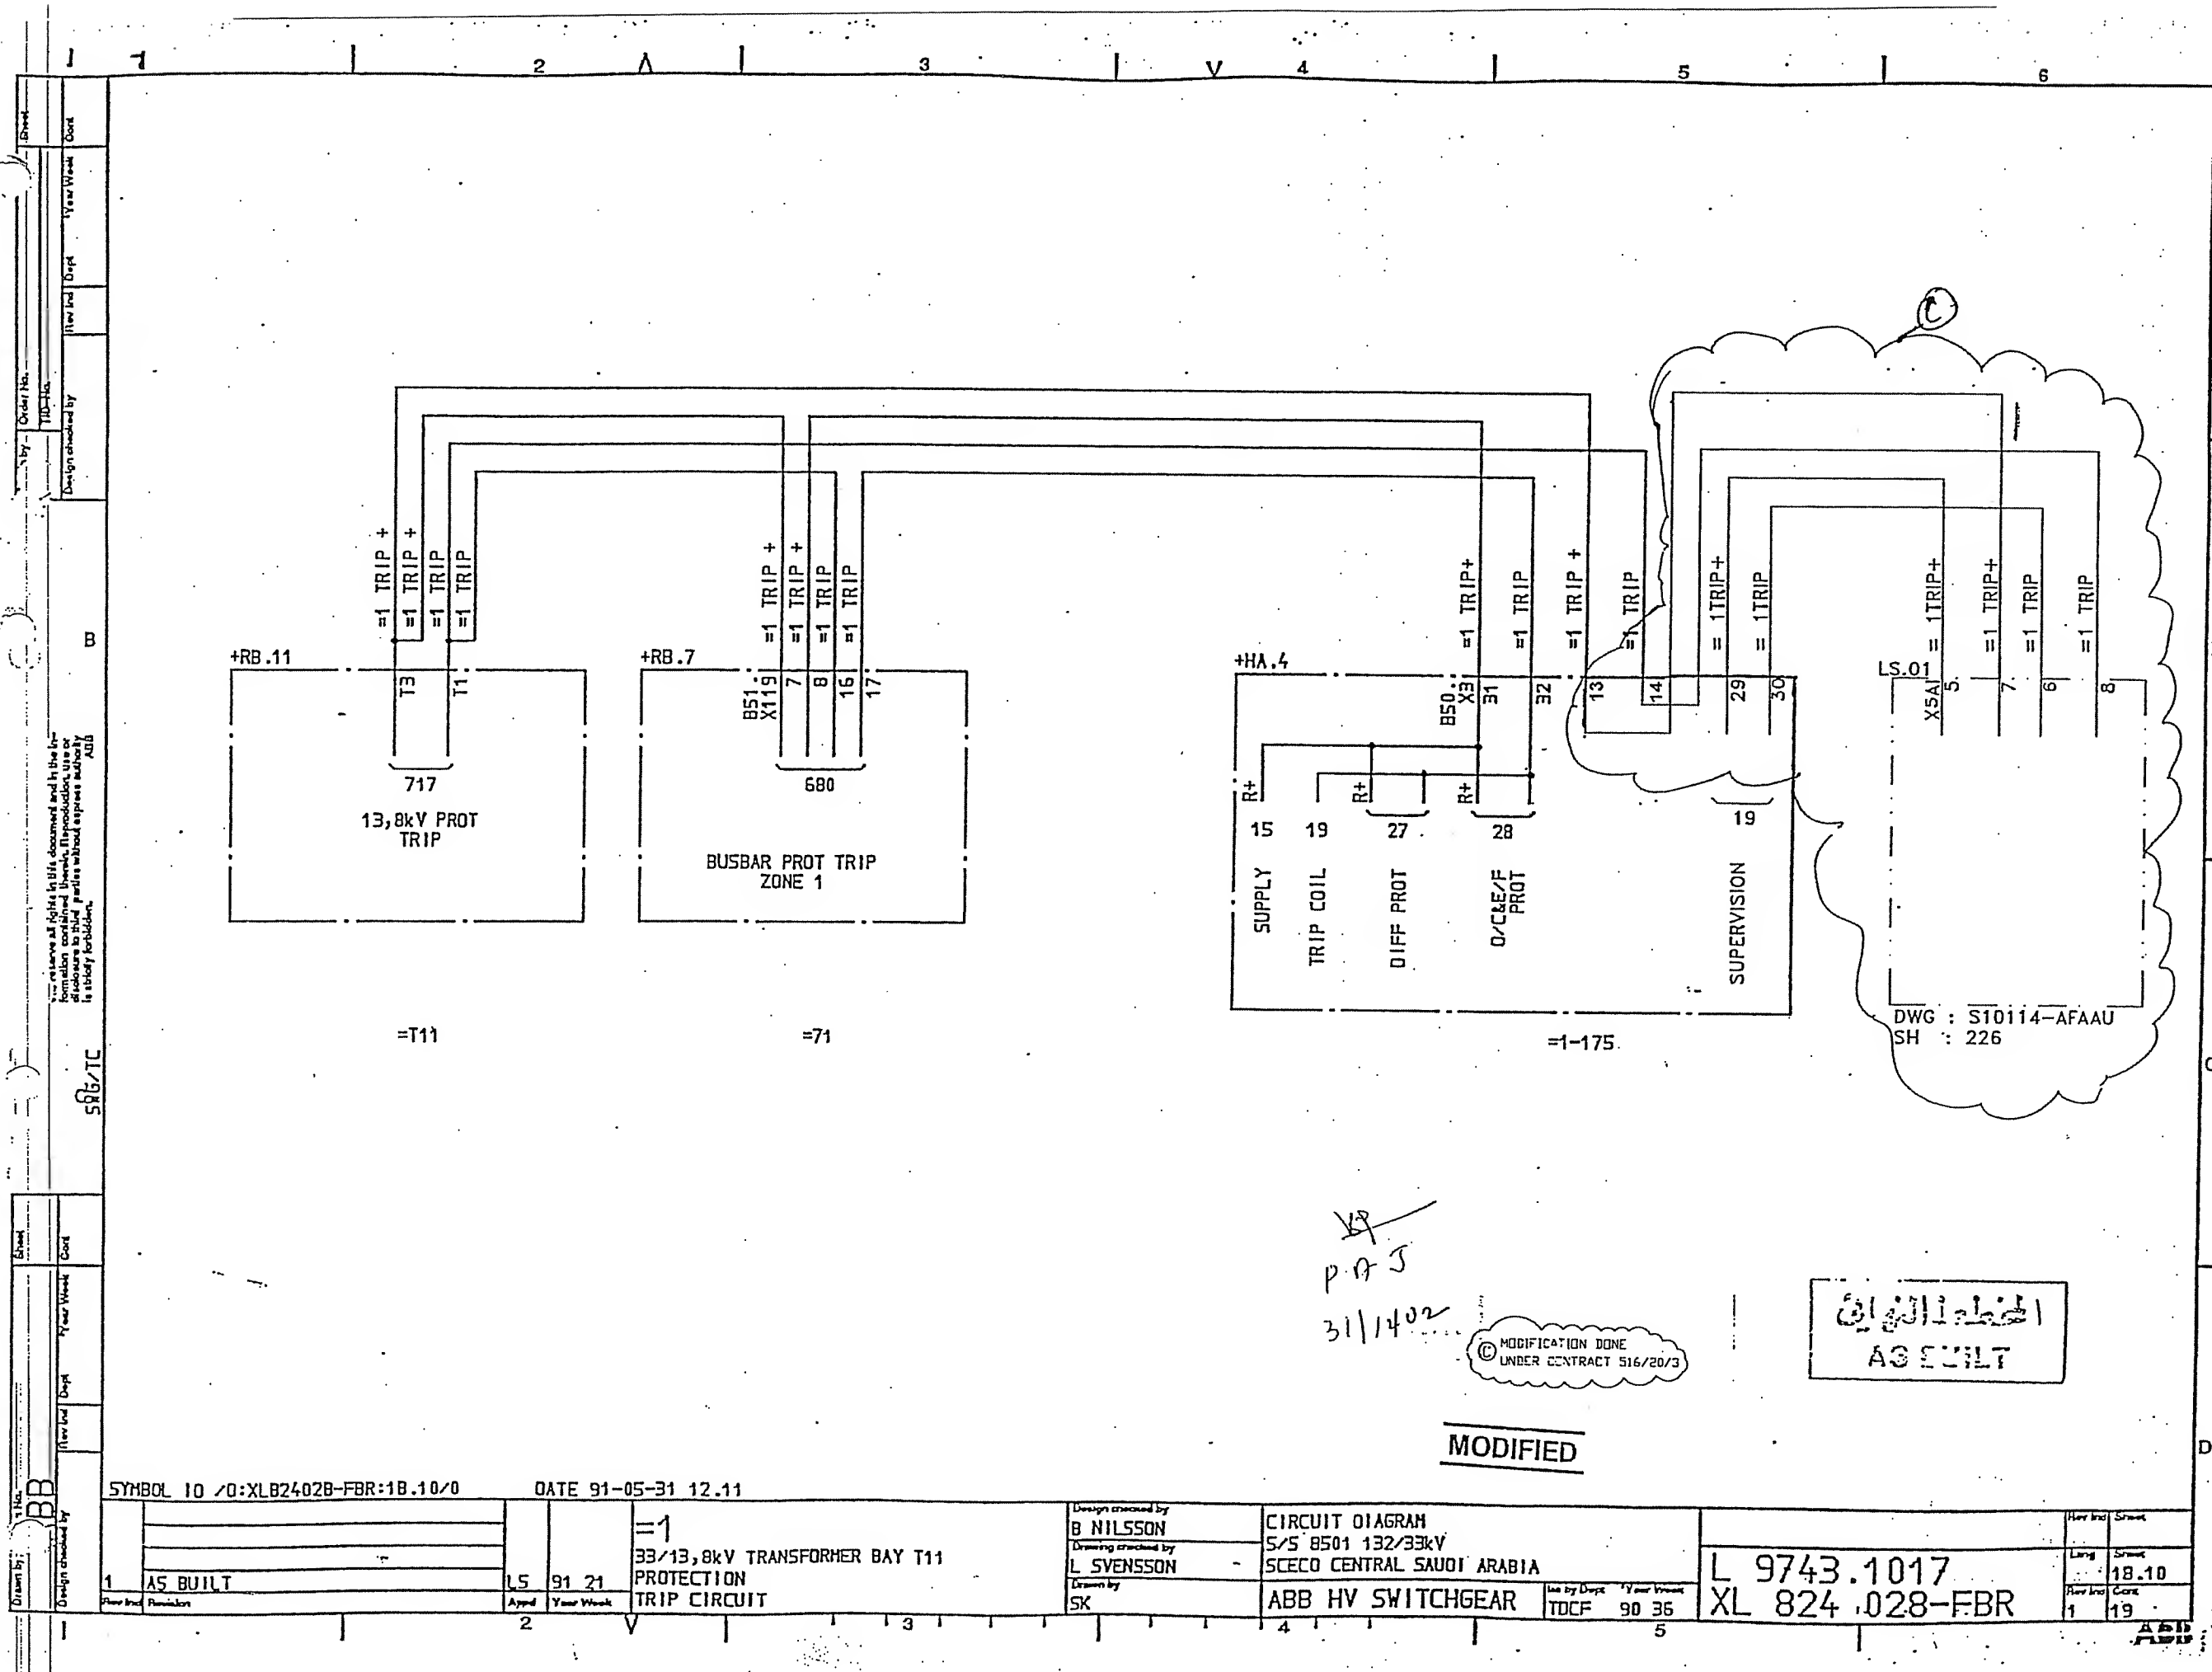

SYMBOL 10 /0:XLB2402B-FBR:1B.10/0


DATE 91-05-31 12.11

| | | | | |
|---|----------|----|-------|---|
| 1 | AS BUILT | LS | 91 21 | 33/13,8kV TRANSFORMER BAY T11 PROTECTION TRIP CIRCUIT |
| 2 | | | | |

| | |
|----------------------------------|---|
| Design checked by B NILSSON | CIRCUIT DIAGRAM |
| Drawing checked by L SVENSSON | S/S 8501 132/33kV SCECO CENTRAL SAUDI ARABIA |
| Drawn by SK | ABB HV SWITCHGEAR |


| | | |
|------------------------|--------------------|-------------------------------|
| Issued by Dept TOCF | Year Week 90 35 | L 9743.1017 XL 824.028-FBR |
|------------------------|--------------------|-------------------------------|


| | | |
|-----|-------|-----|
| Rev | Rev | Rev |
| 1 | 18.10 | 19 |

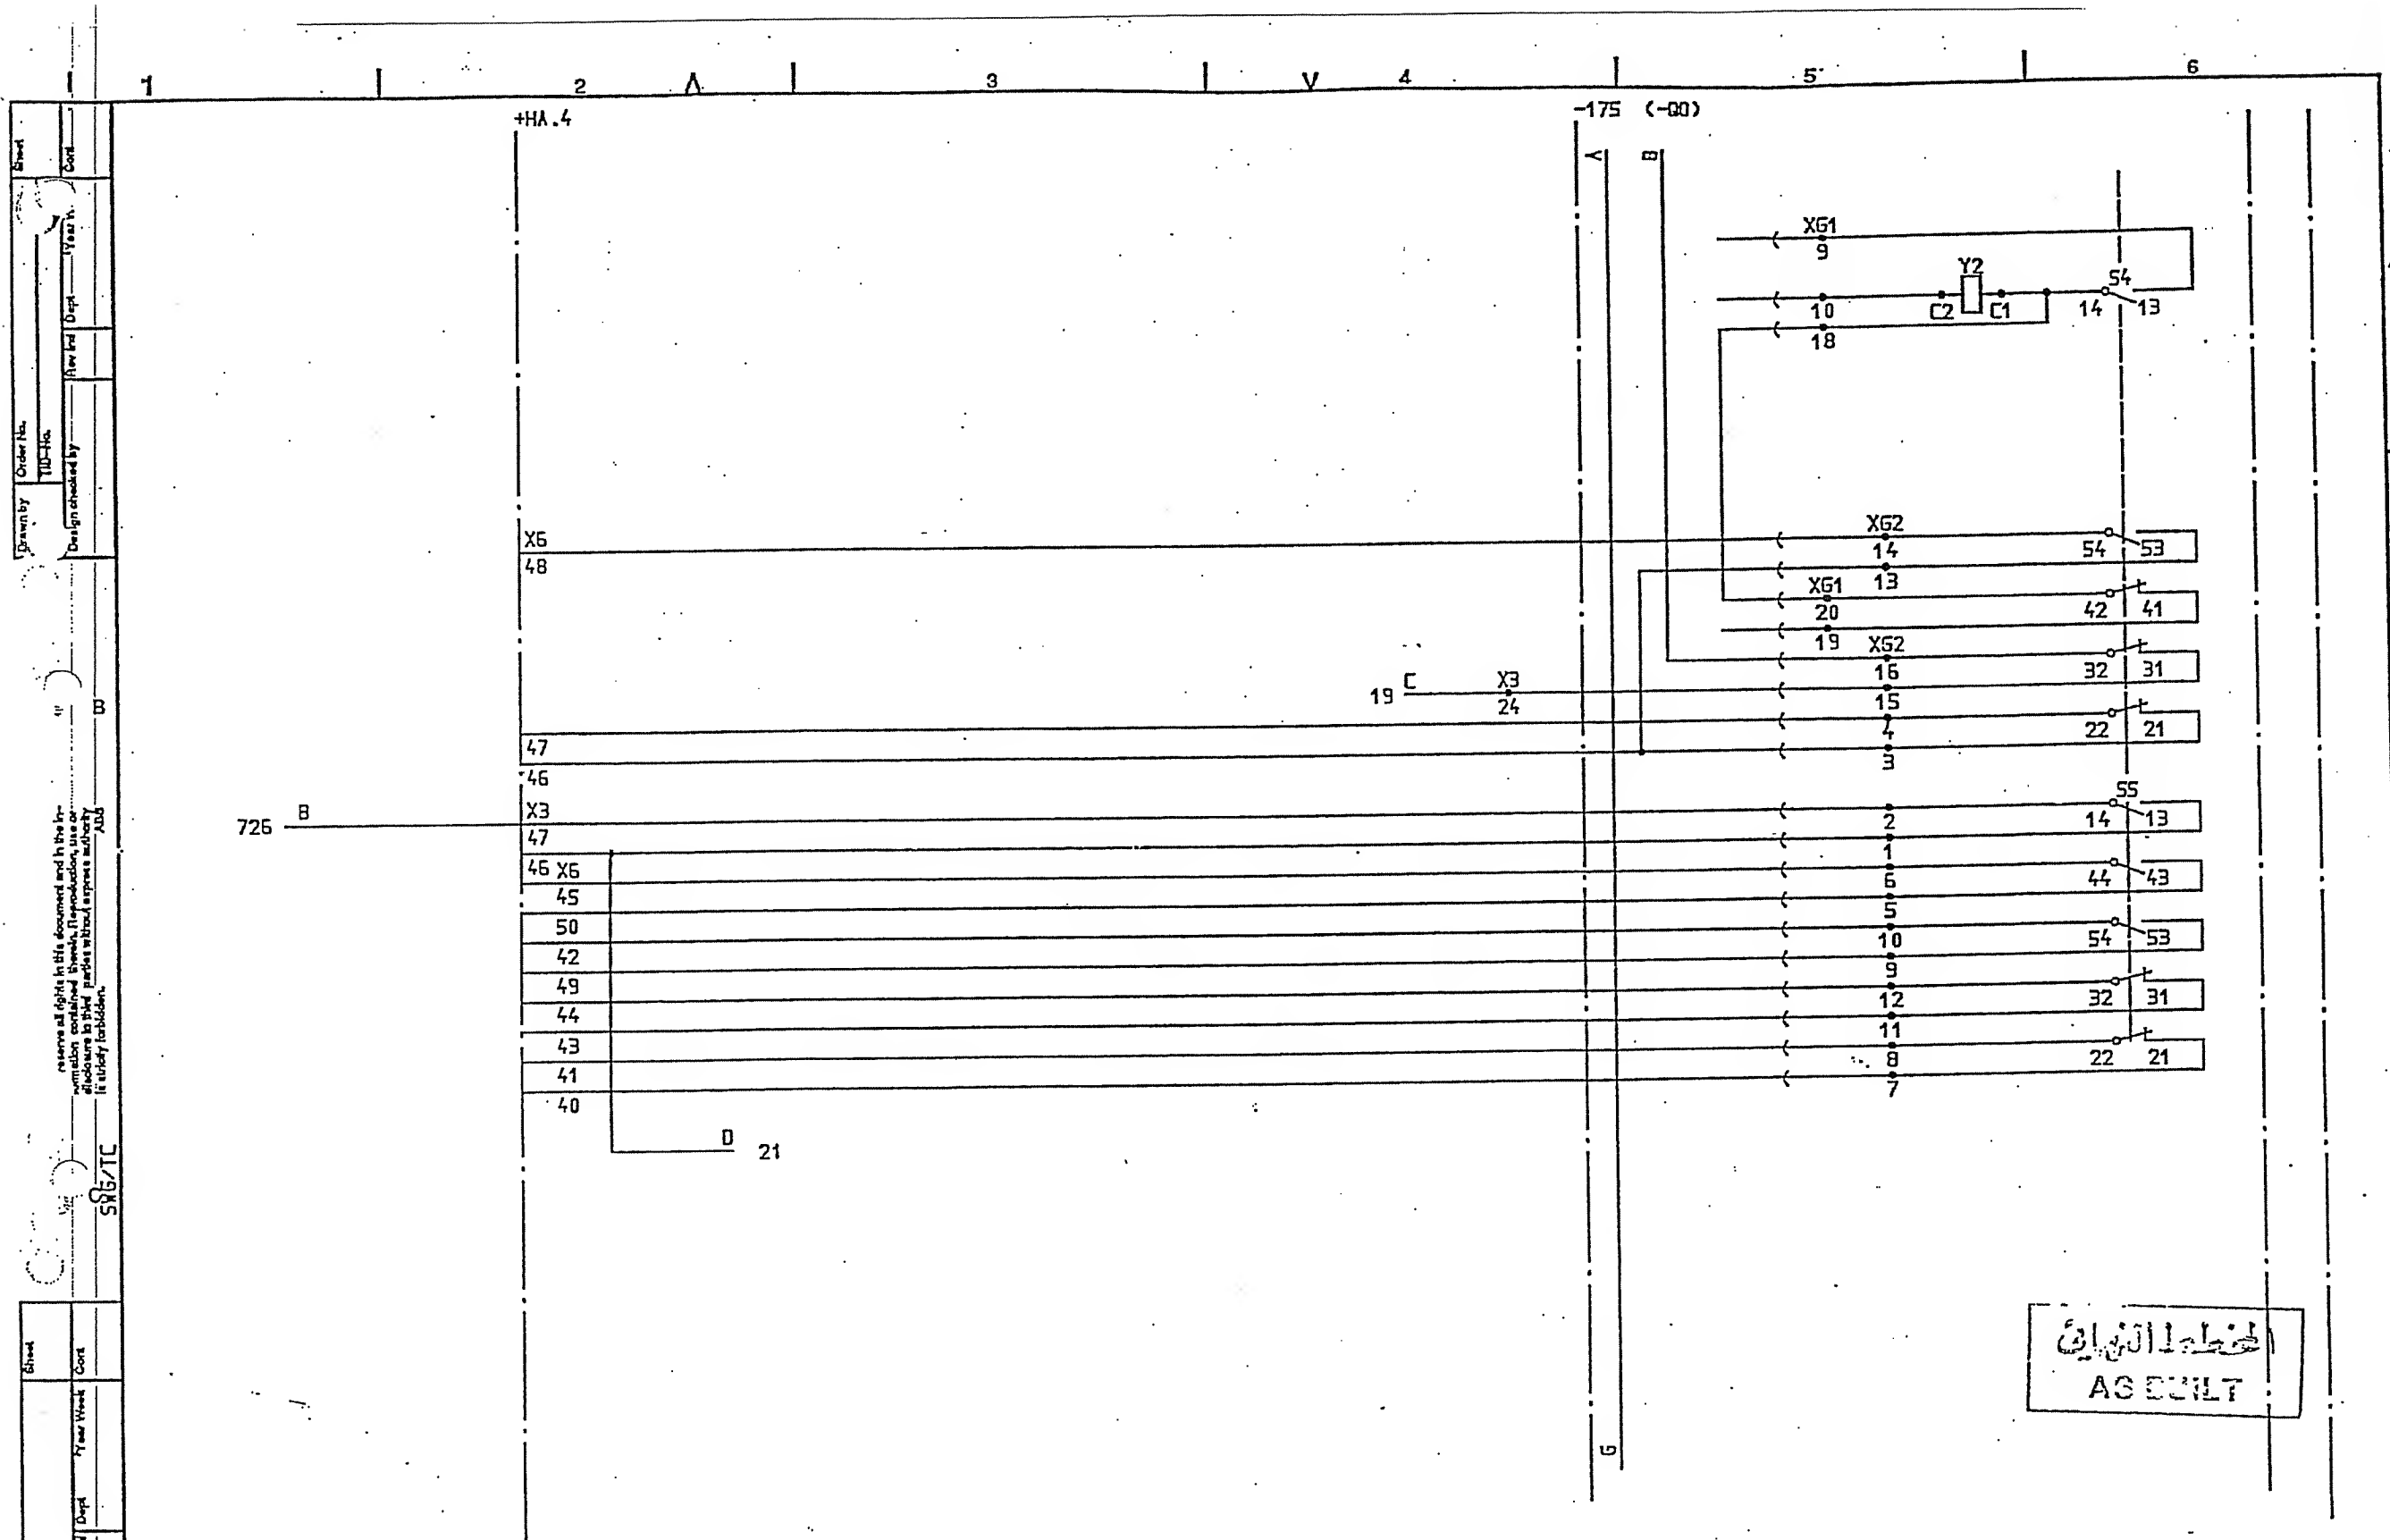



الحلقة الأولى
AS BUILT

| | | | | | | | | | |
|----------------------------------|--|--------------------------------|--|----------------------------------|--|----------------------------|--|----------------|--|
| SYMBOL ID /D:XL824028-FBR:20/0 | | DATE 91-06-13 12.56 | | Design checked by B NILSSON | | CIRCUIT DIAGRAM | | Rev Incl Sheet | |
| Drawing checked by L SVENSSON | | 33/13,8kV TRANSFORMER BAY T11 | | Drawing checked by L SVENSSON | | S/S 8501 132/33kV | | L 9743.1017 | |
| Drawing checked by SK | | CIRCUIT BREAKER EQUIPMENT -175 | | Drawing checked by SK | | SCECO CENTRAL SAUDI ARABIA | | XL 824 028-FBR | |
| 1 AS BUILT | | 15 91 21 | | 15 91 21 | | ABB HV SWITCHGEAR | | Rev Incl Sheet | |
| 1 | | 15 | | 15 | | TDCF 90 36 | | Larg Sheet | |
| 1 | | 15 | | 15 | | 1 | | 20 | |
| 1 | | 15 | | 15 | | 1 | | 21 | |

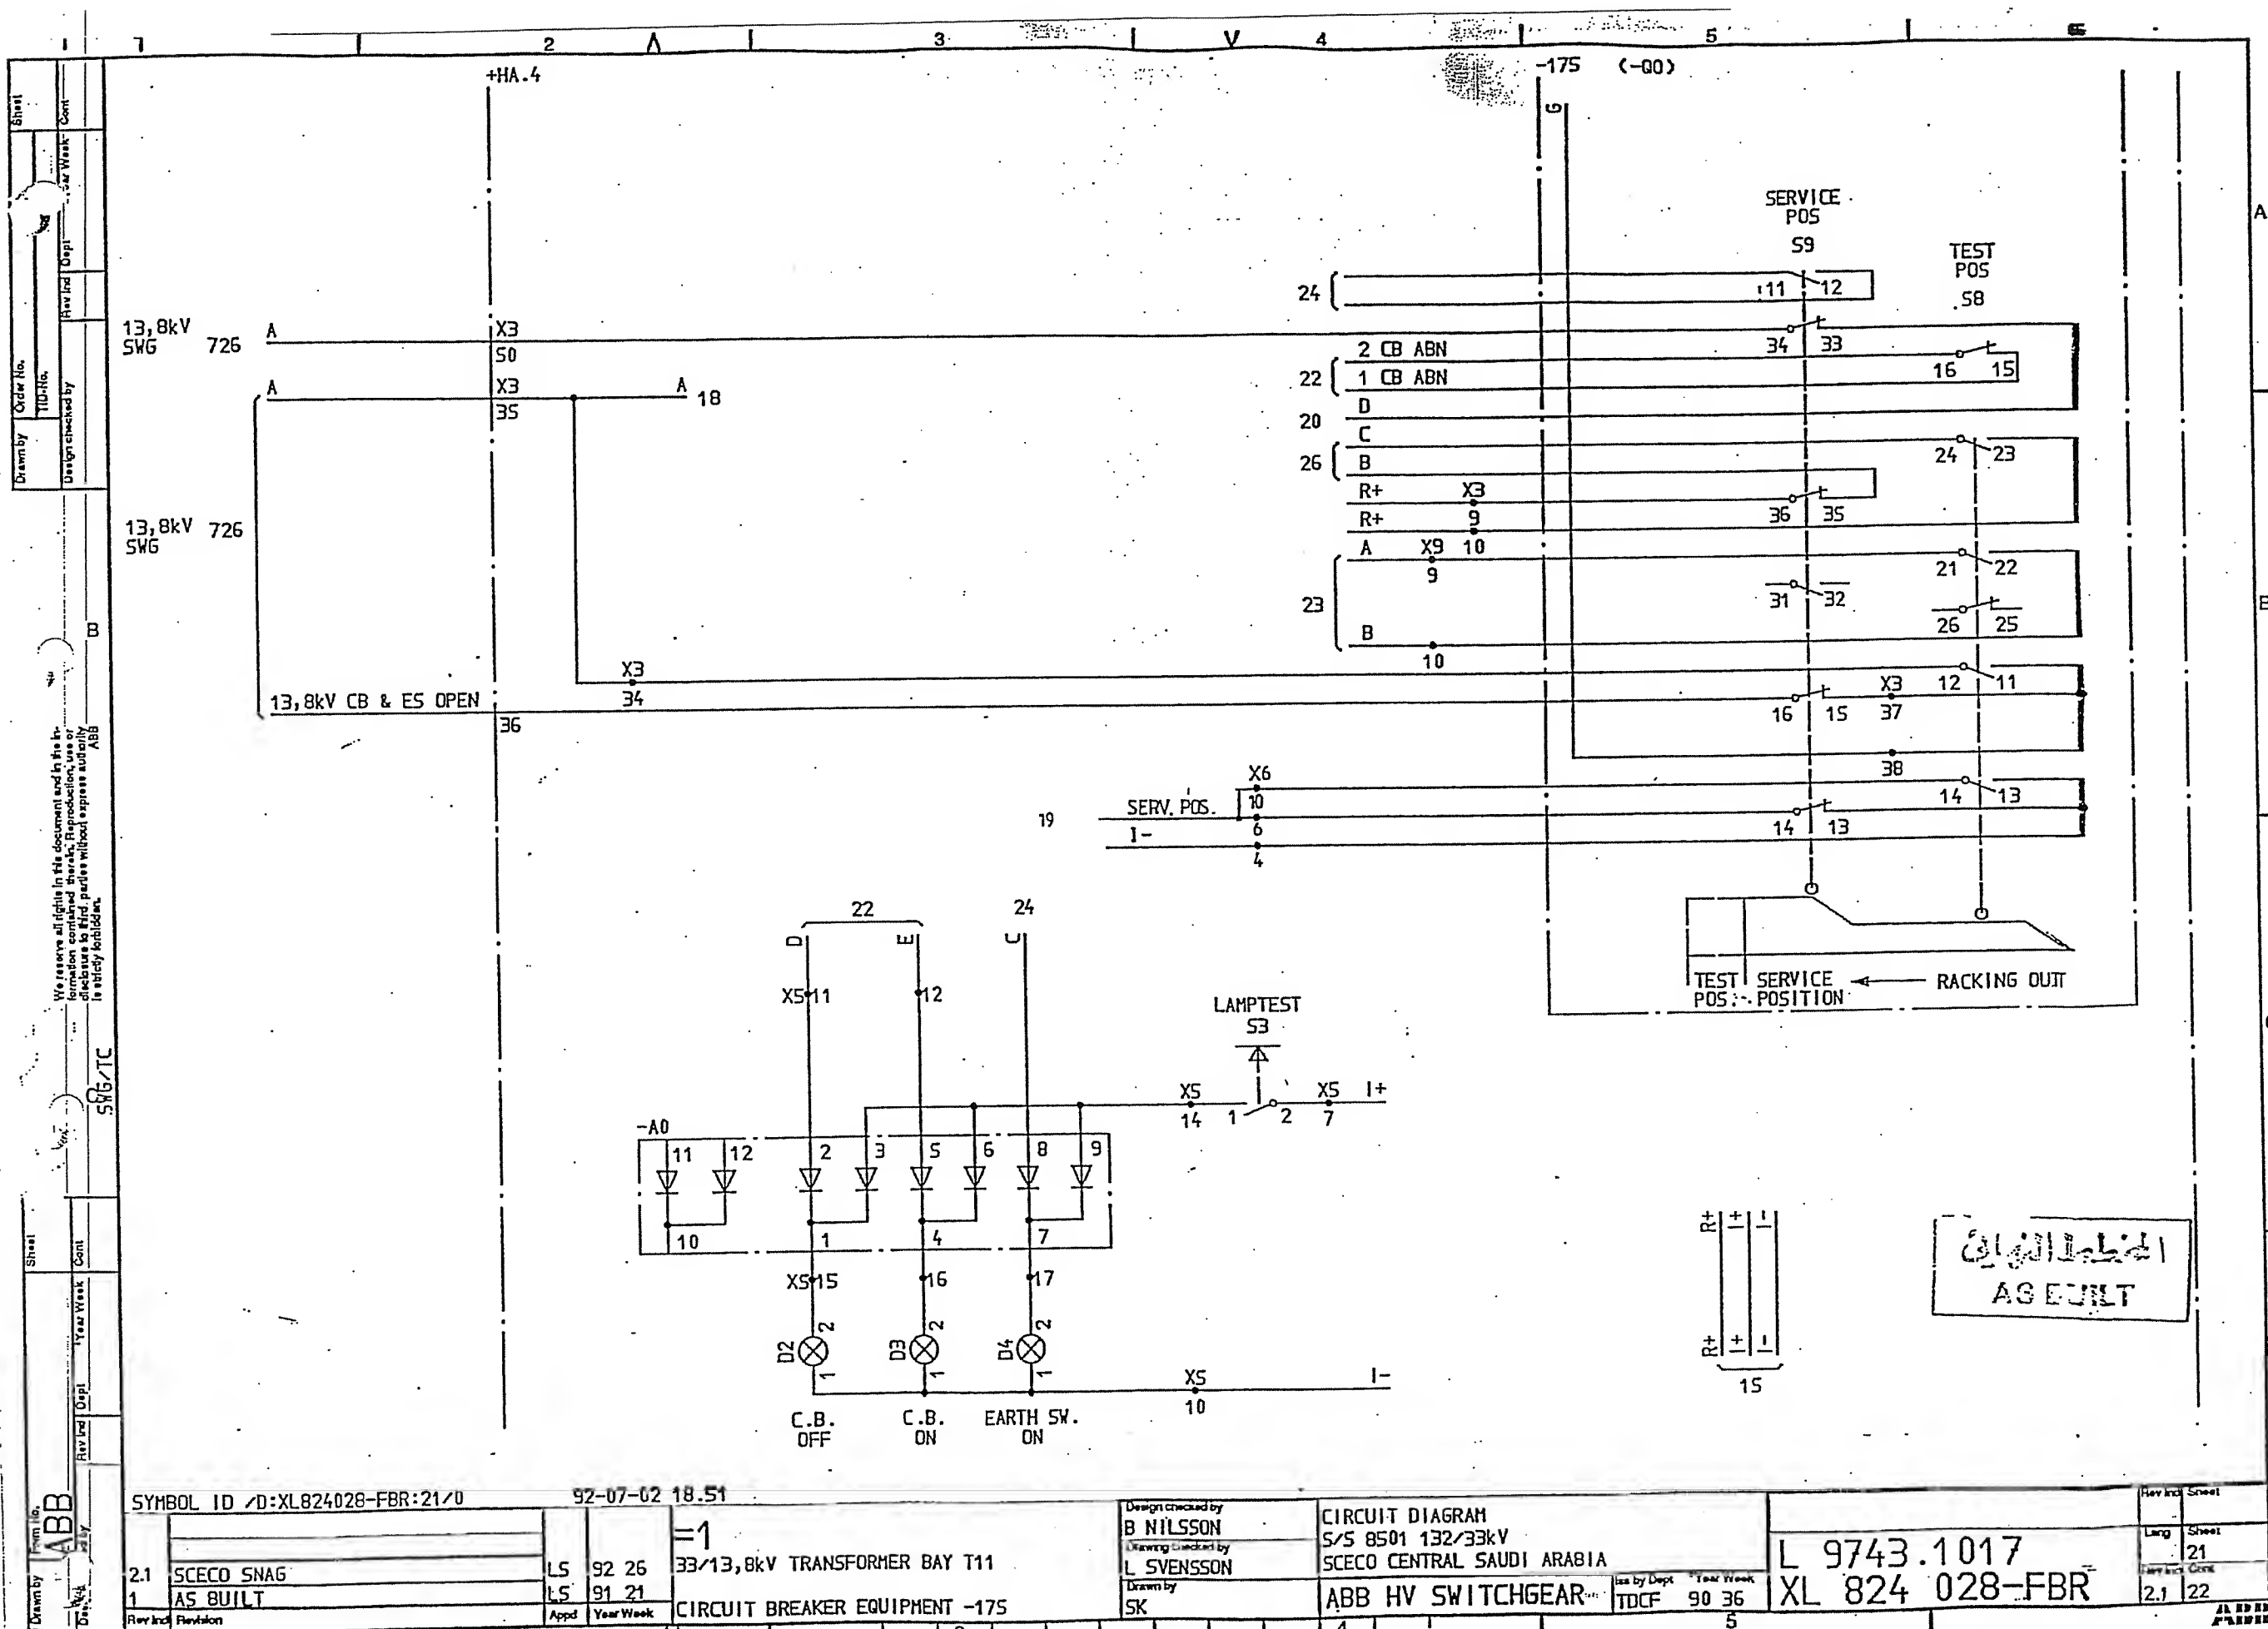


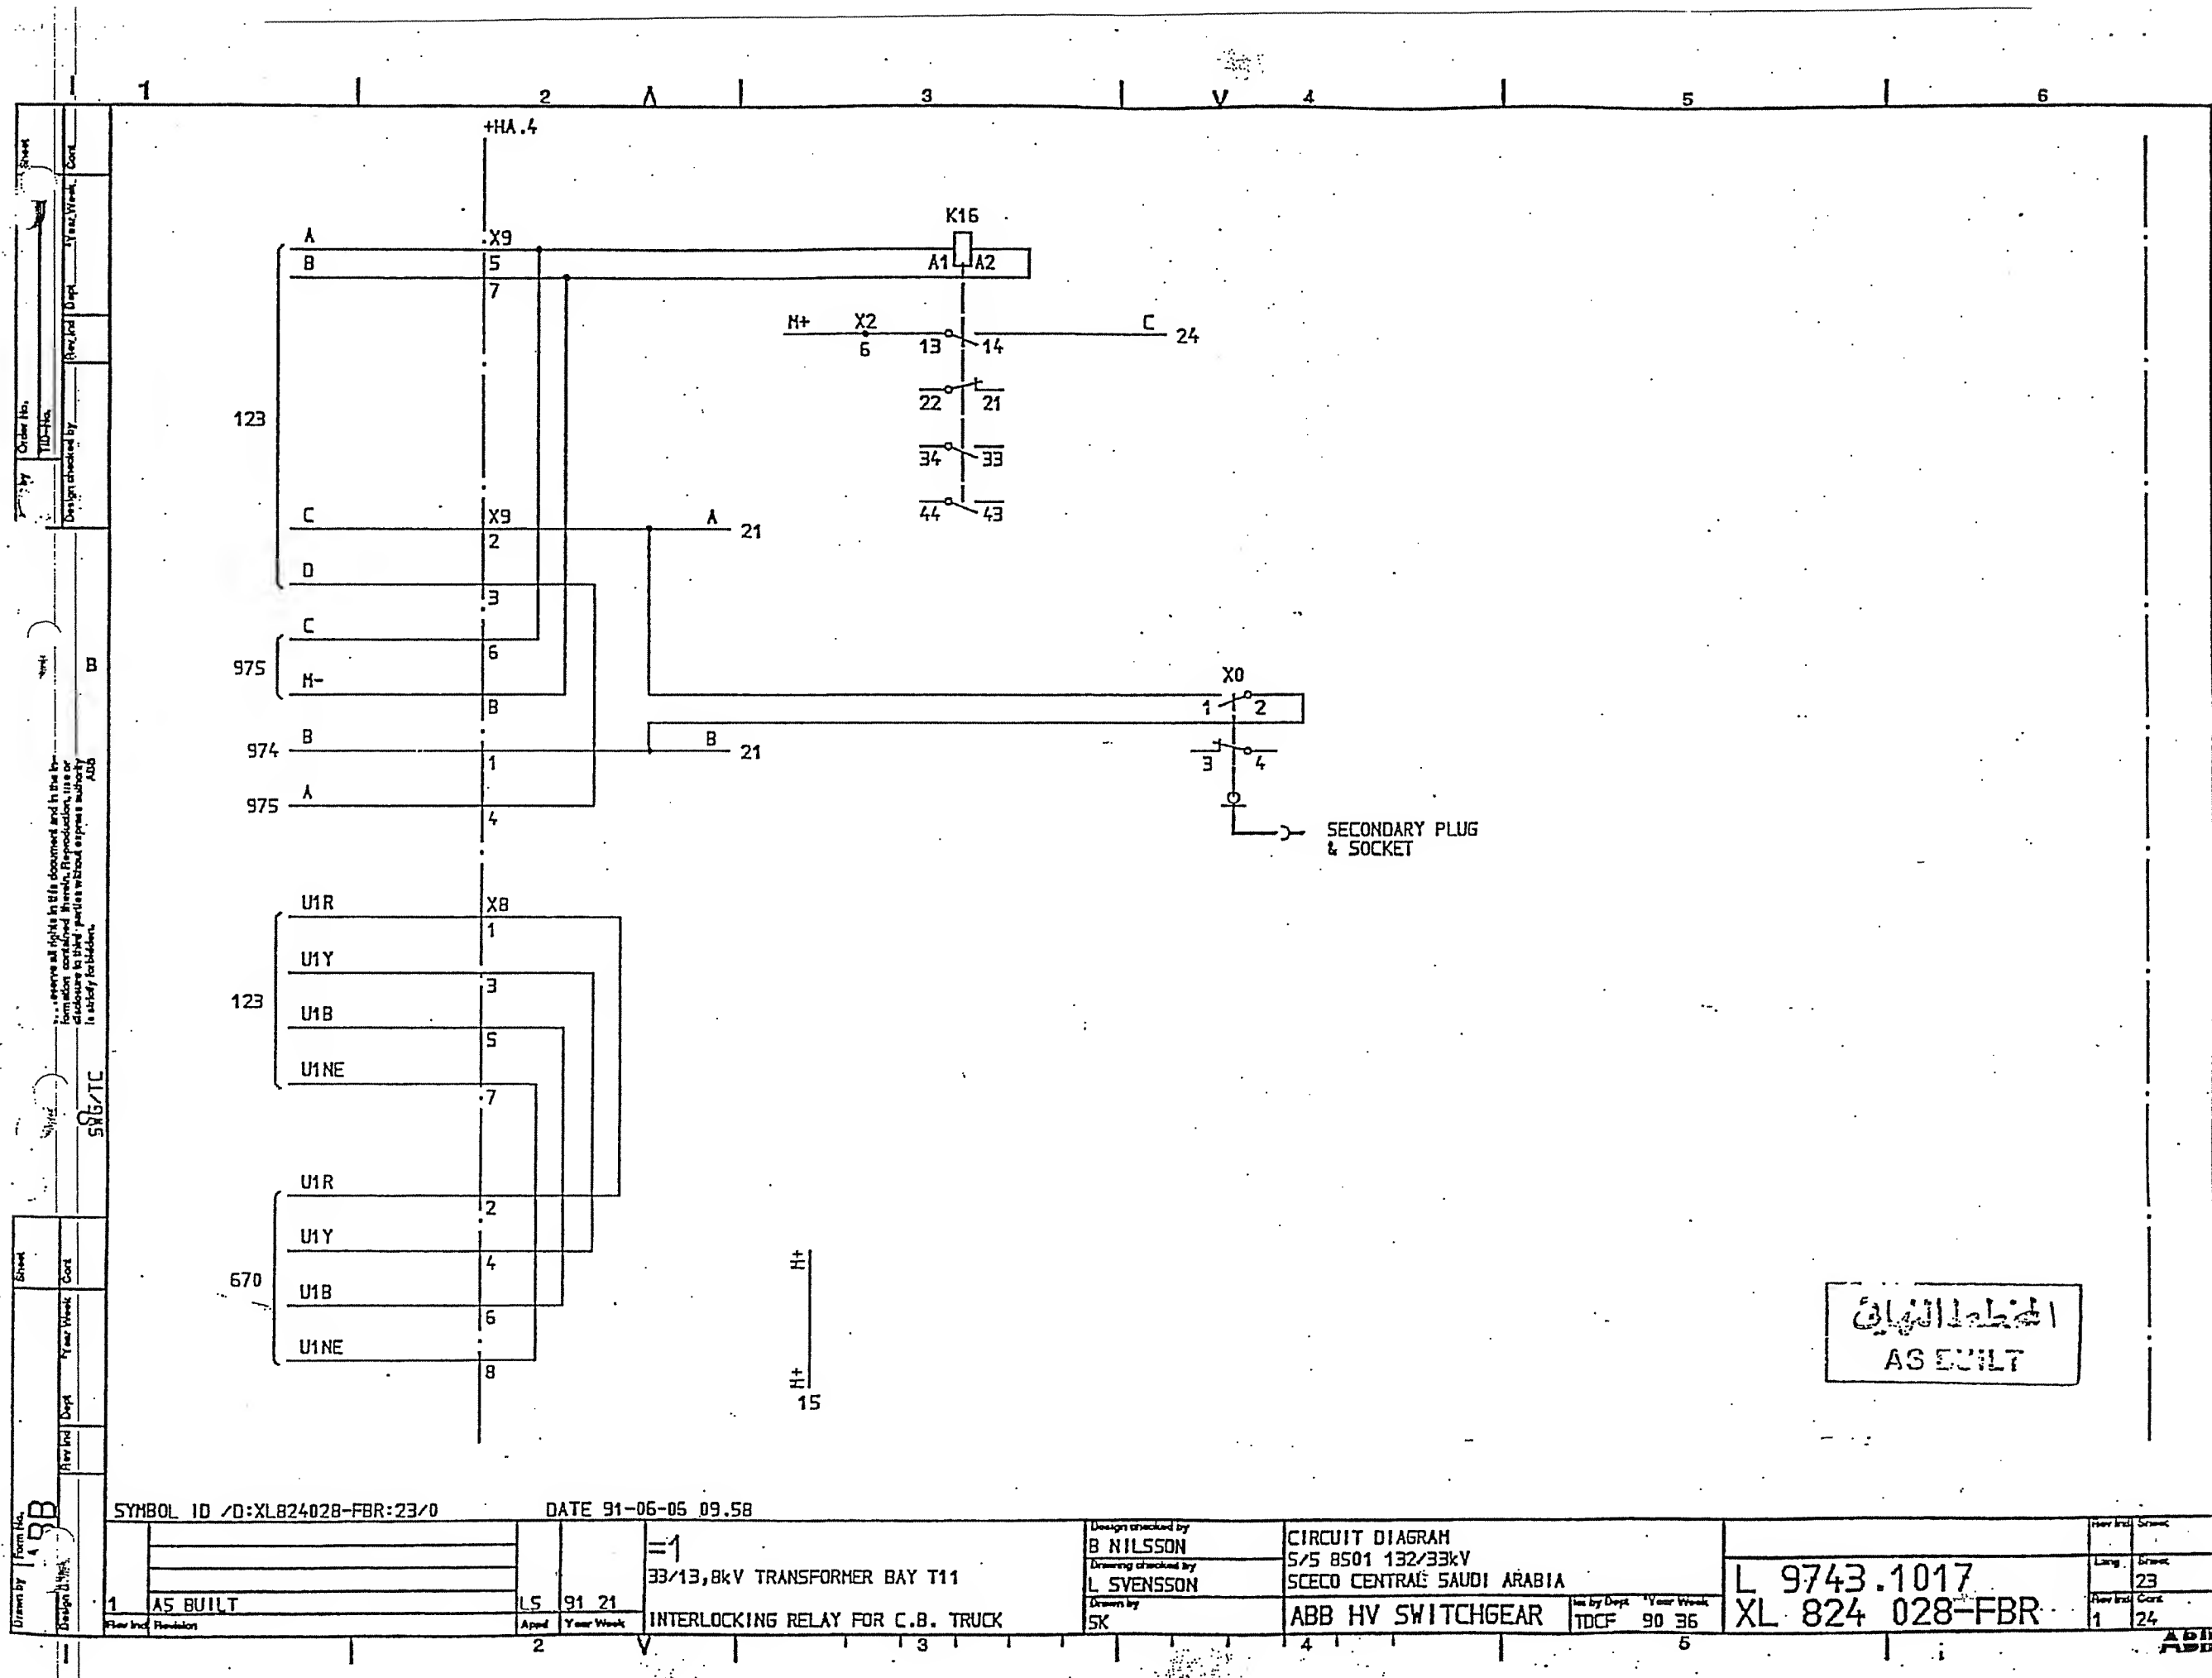

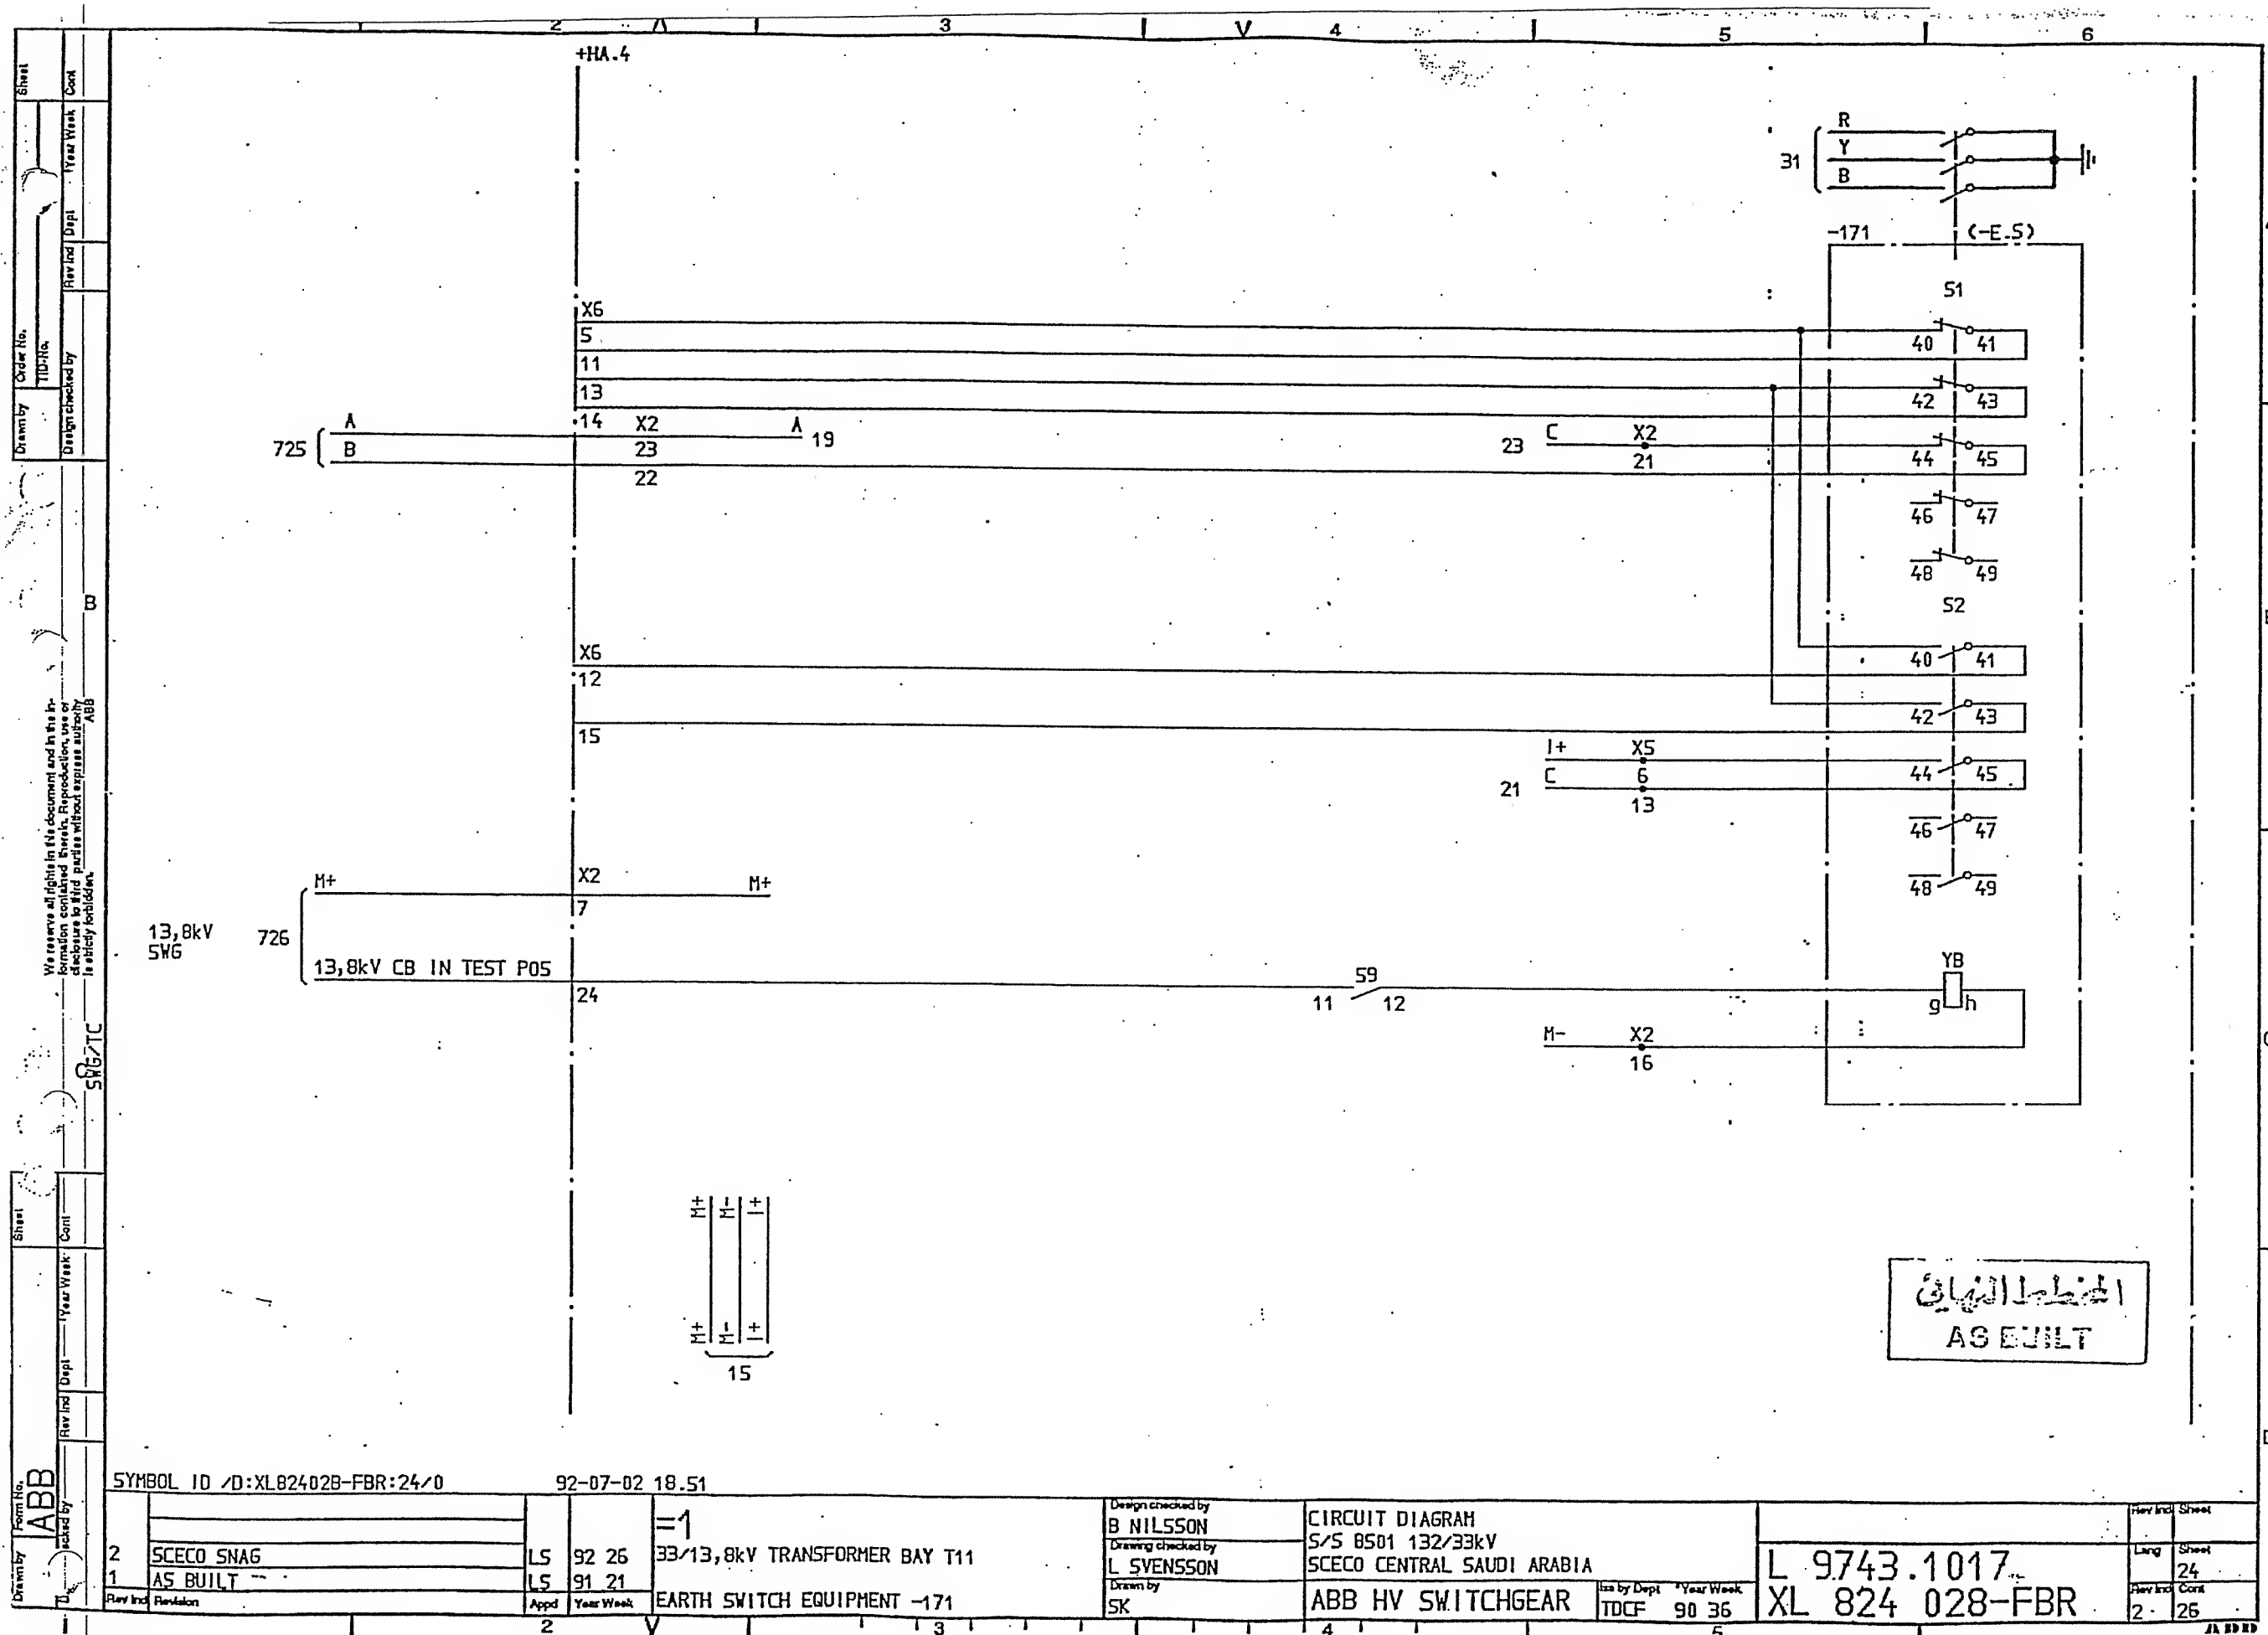

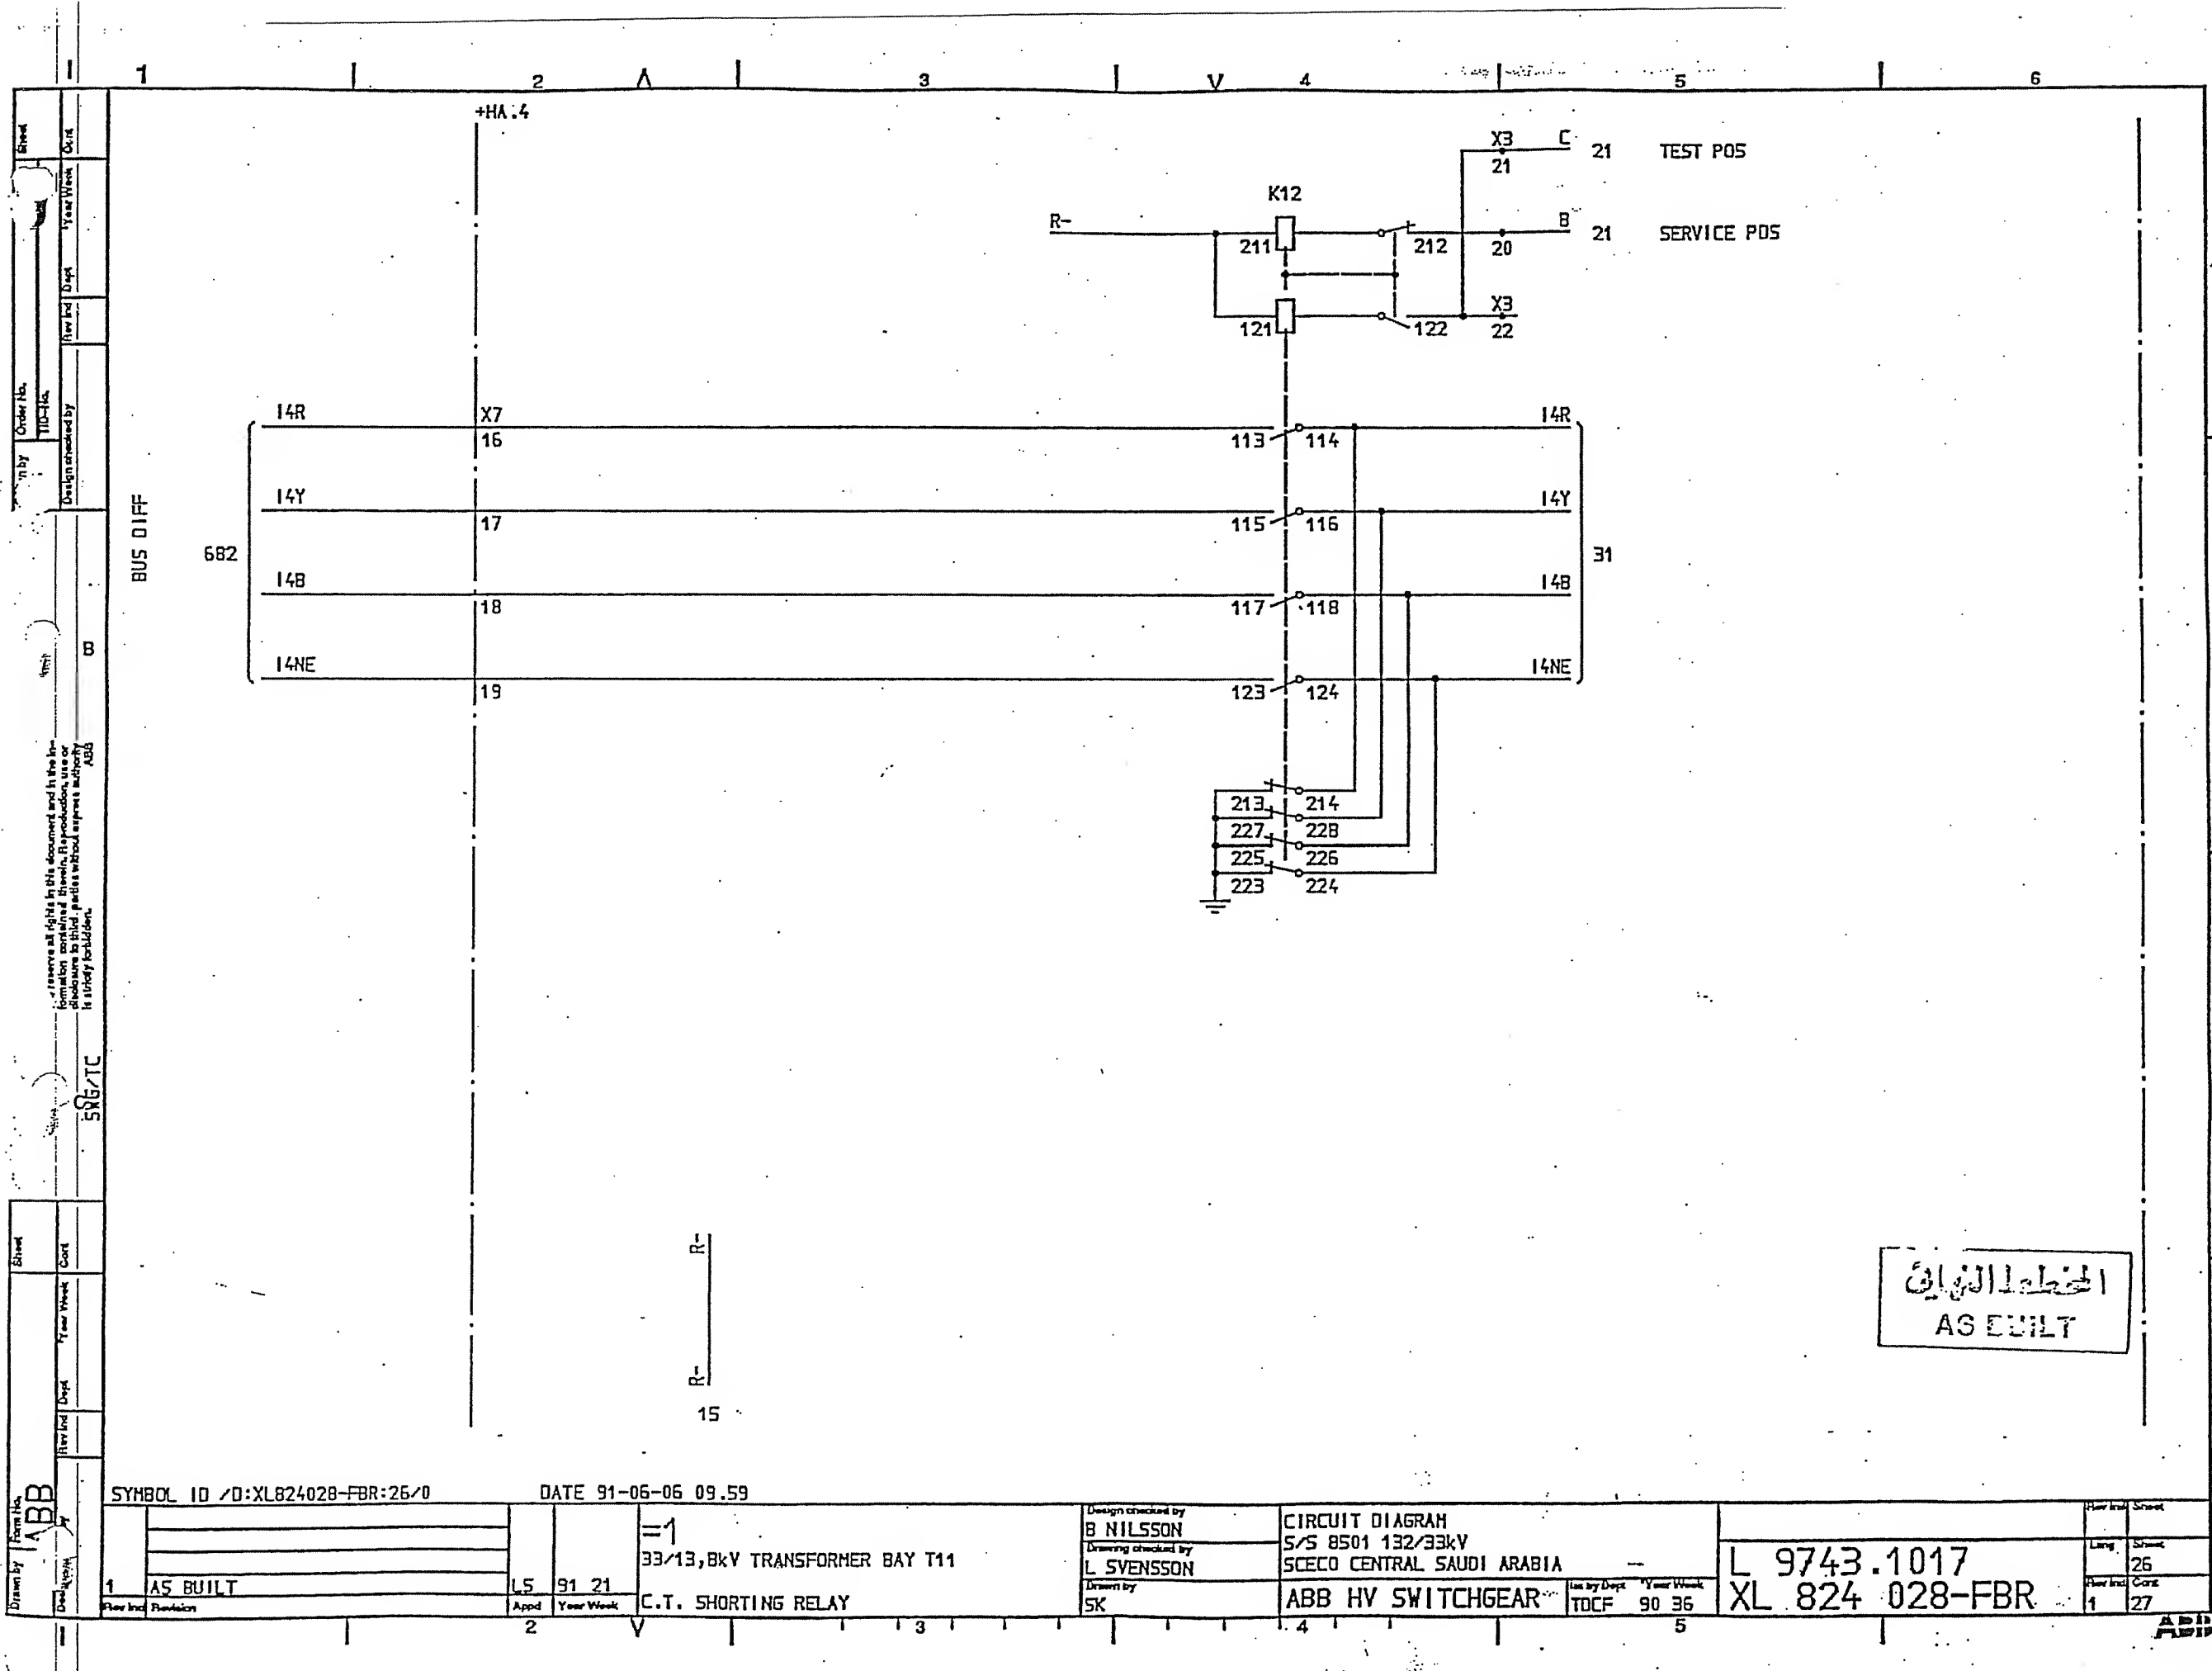

| | | | | | | | | | | | |
|----------------------|--|------------------------------|--|----------------------|--|---------------------------------------|--|----------------------------|--|----------------|--|
| Drawn by: ABB | | SYMBOL ID: XL824028-FBR:26/0 | | DATE: 91-06-06 09.59 | | Design checked by: B NILSSON | | CIRCUIT DIAGRAM | | Rev Int Sheet | |
| Drawn by: ABB | | 1 AS BUILT | | LS 91 21 | | Drawing checked by: L SVENSSON | | S/S 8501 132/33kV | | Ling Sheet | |
| Drawn by: ABB | | 1 AS BUILT | | LS 91 21 | | Drawing checked by: L SVENSSON | | SCECO CENTRAL SAUDI ARABIA | | 26 | |
| Drawn by: ABB | | 1 AS BUILT | | LS 91 21 | | Drawing checked by: L SVENSSON | | ABB HV SWITCHGEAR | | Rev Int Sheet | |
| Drawn by: ABB | | 1 AS BUILT | | LS 91 21 | | Drawing checked by: L SVENSSON | | TDCF 90 36 | | 1 27 | |
| Drawn by: ABB | | 1 AS BUILT | | LS 91 21 | | Drawing checked by: L SVENSSON | | L 9743.1017 | | XL 824 028-FBR | |
| Drawn by: ABB | | 1 AS BUILT | | LS 91 21 | | Drawing checked by: L SVENSSON | | C.T. SHORTING RELAY | | 2 | |

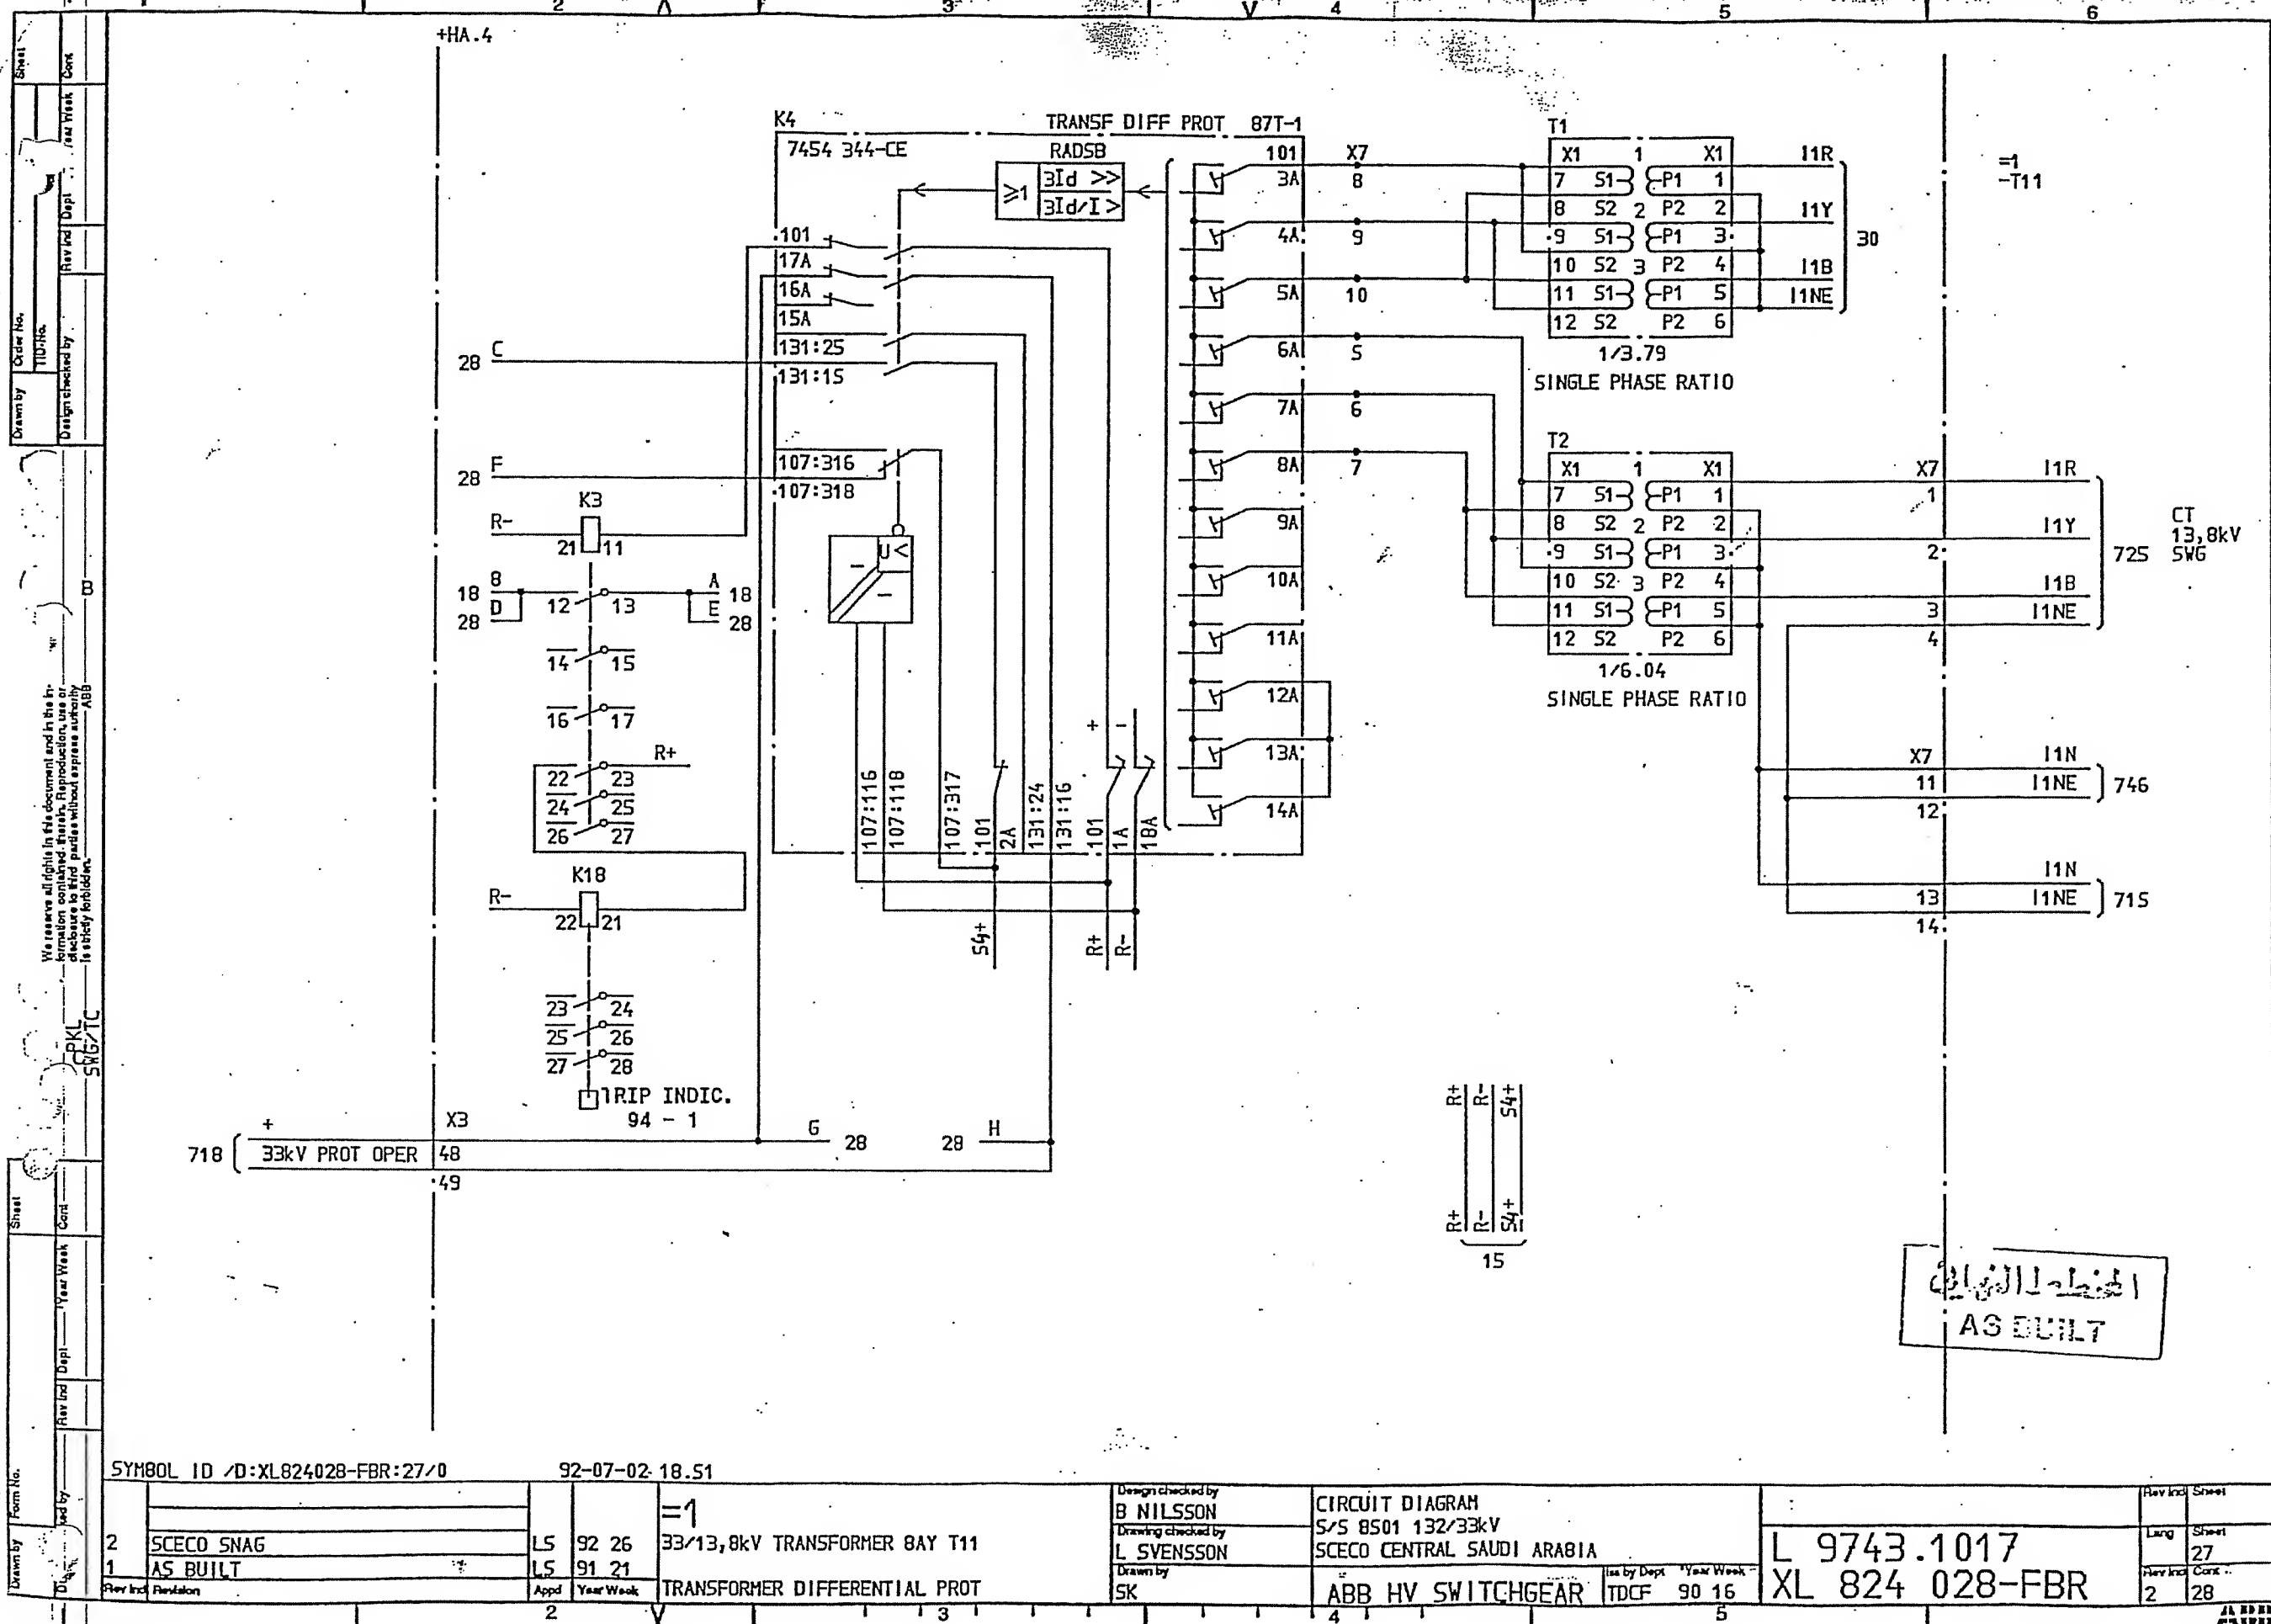

SYH80L ID /D:XL824028-FBR:27/0

92-07-02-18.51

| | | | | |
|---------|------------|------|-----------|-------------------------------|
| 2 | SCECO SNAG | L5 | 92 26 | 33/13,8kV TRANSFORMER 8AY T11 |
| 1 | AS BUILT | L5 | 91 21 | TRANSFORMER DIFFERENTIAL PROT |
| Rev Ind | Revision | Appd | Year Week | |
| | | 2 | V | |

Design checked by
B NILSSON
Drawing checked by
L SVENSSON
Drawn by
SK

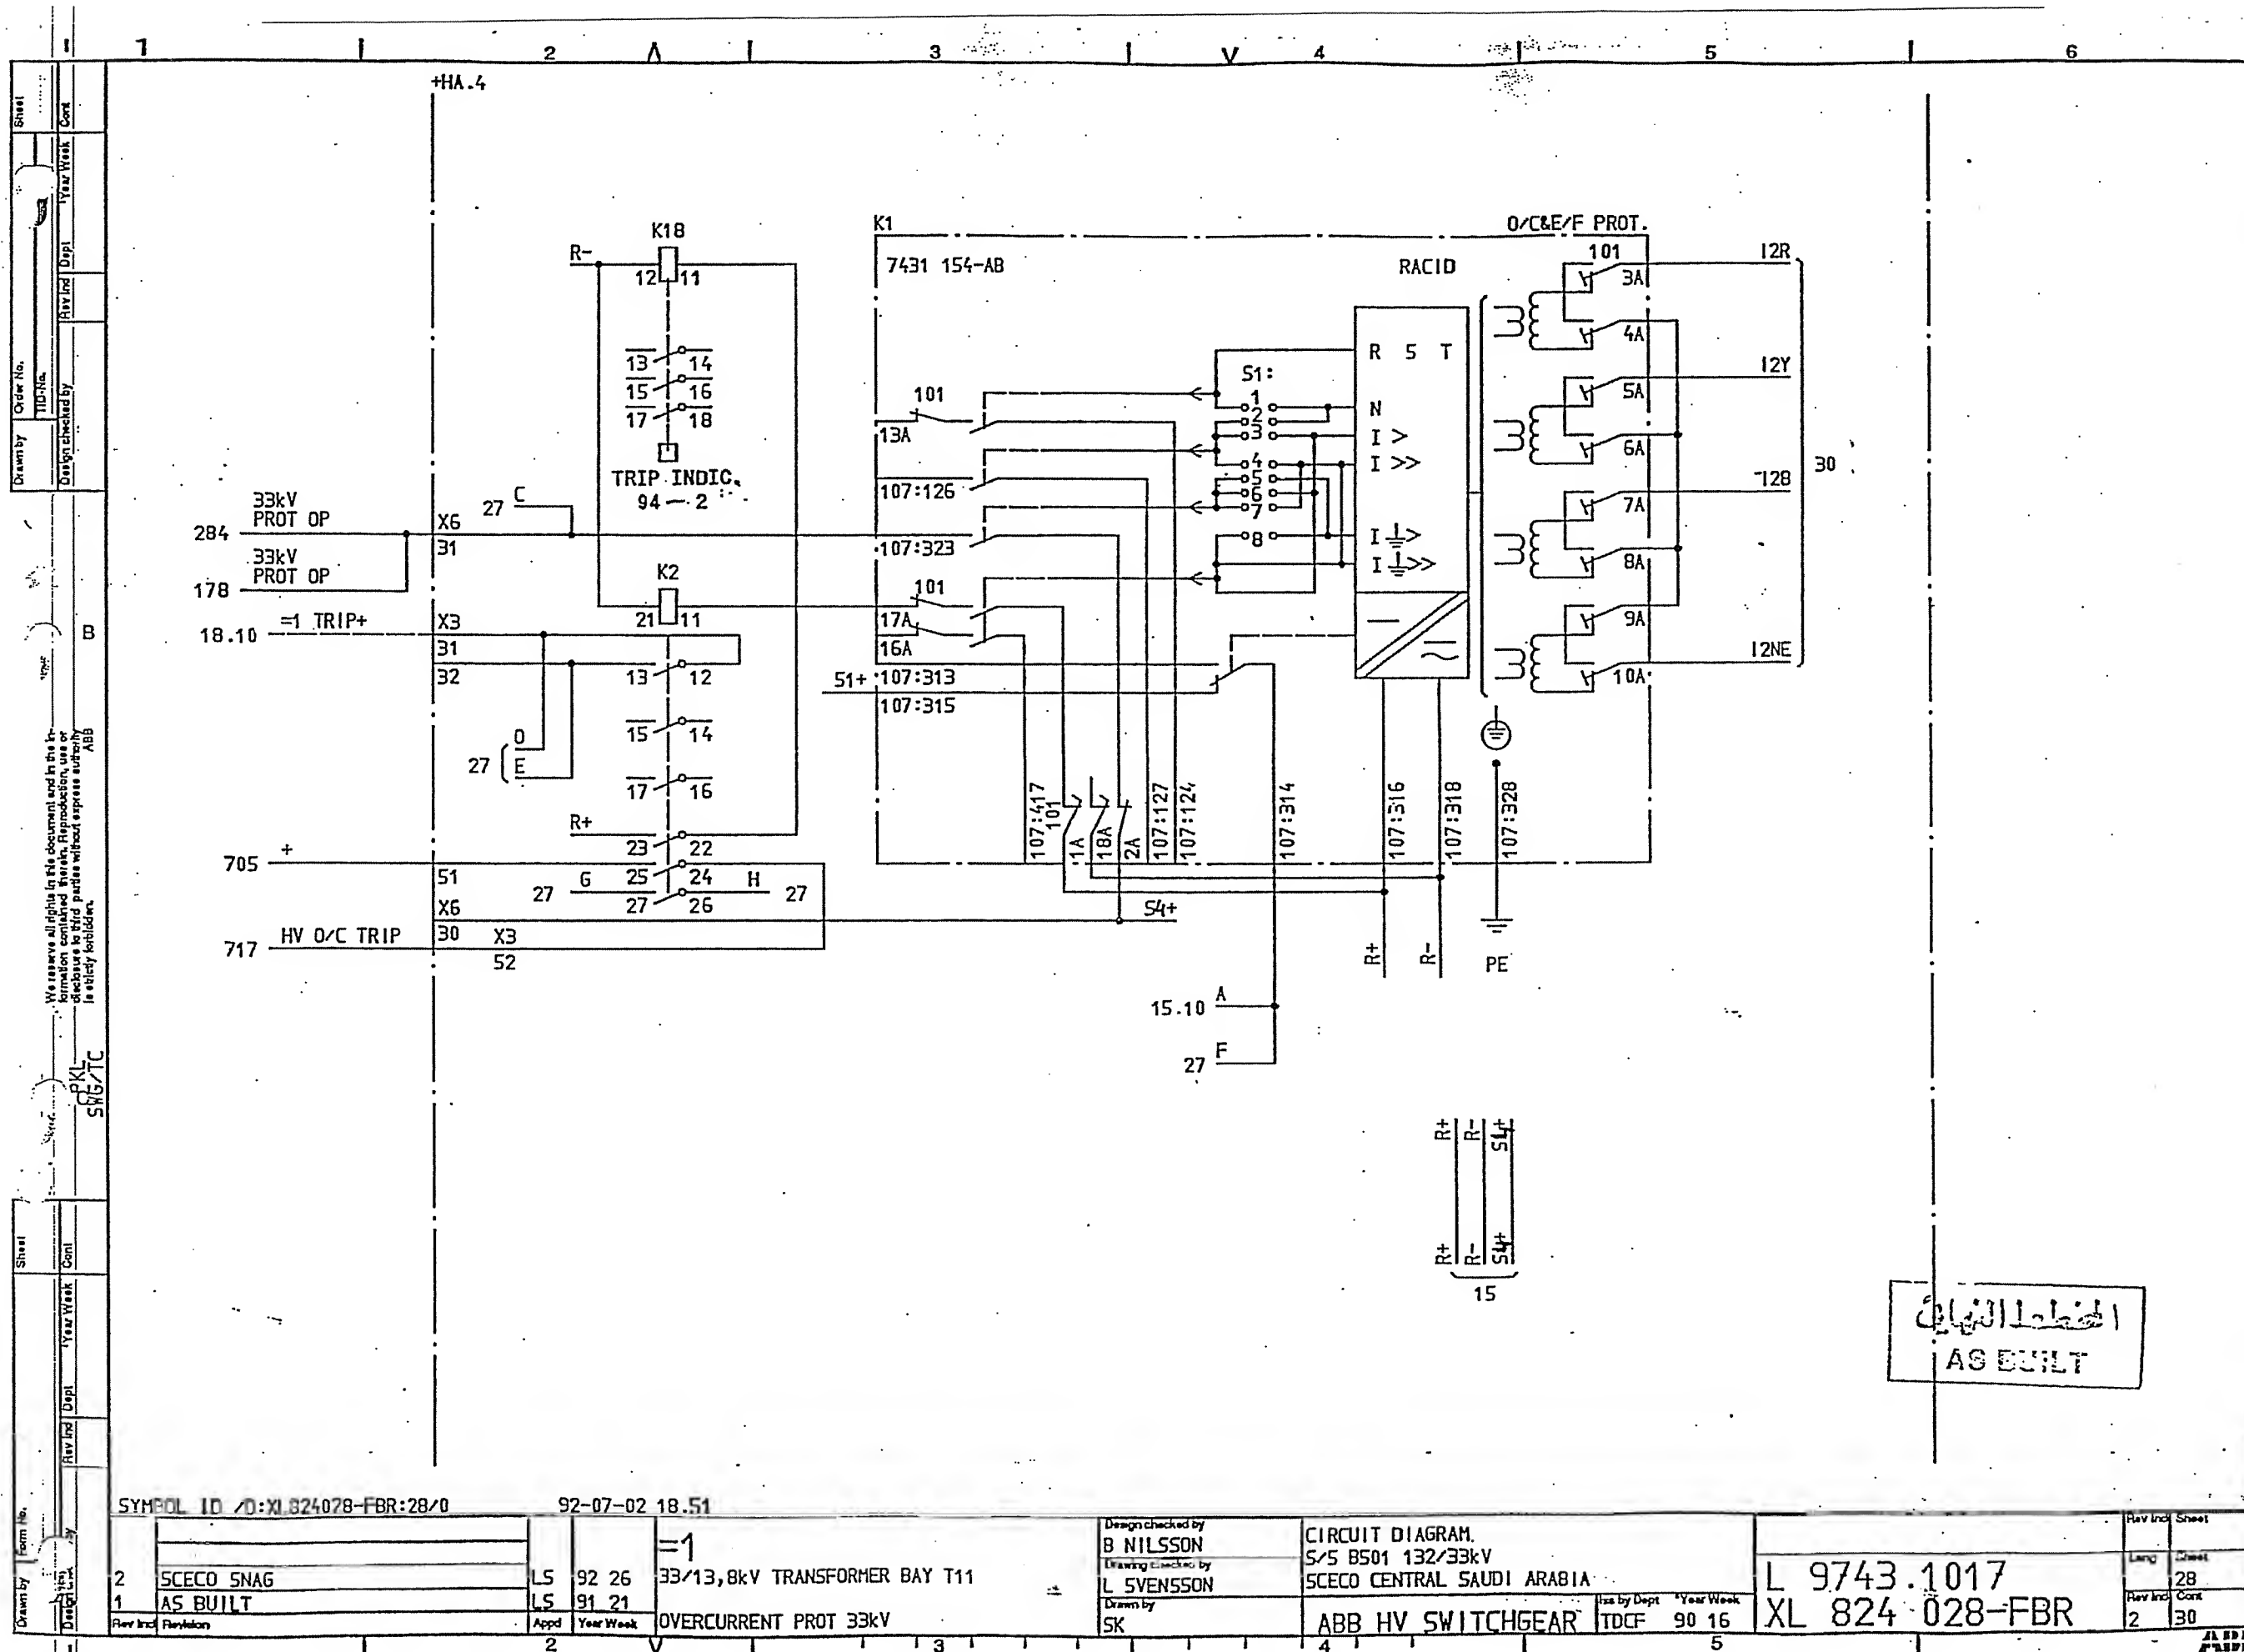
CIRCUIT DIAGRAM
S/S 8501 132/33kV
SCECO CENTRAL SAUDI ARABIA
ABB HV SWITCHGEAR

Iss by Dept Year Week
TDCF 90 16

L 9743.1017
XL 824 028-FBR

Rev Ind Sheet
Lung Sheet
Rev Ind Cont
2 28

الخريطة الكهربائية
AS BUILT



الخطة النهائية
AS BUILT

SYMBOL ID /D:XL824028-FBR:28/0

92-07-02 18.51

| | | | | | |
|-------------------|------------|------|-----------|-----------------------|-------------------------------|
| 2 | SCECO SNAG | LS | 92 26 | =1 | 33/13,8kV TRANSFORMER BAY T11 |
| 1 | AS BUILT | LS | 91 21 | | |
| Rev Incl Revision | | Appd | Year Week | OVERCURRENT PROT 33kV | |
| | | 2 | | | |


Design checked by
B NILSSON
Drawing checked by
L SVENSSON
Drawn by
SK

CIRCUIT DIAGRAM.
S/S B501 132/33kV
SCECO CENTRAL SAUDI ARABIA
ABB HV SWITCHGEAR

Iss by Dept
TDCF 90 16

L 9743.1017
XL 824 028-FBR

| | |
|----------|-------|
| Rev Incl | Sheet |
| Lang | Sheet |
| Rev Incl | Cont |
| 2 | 30 |

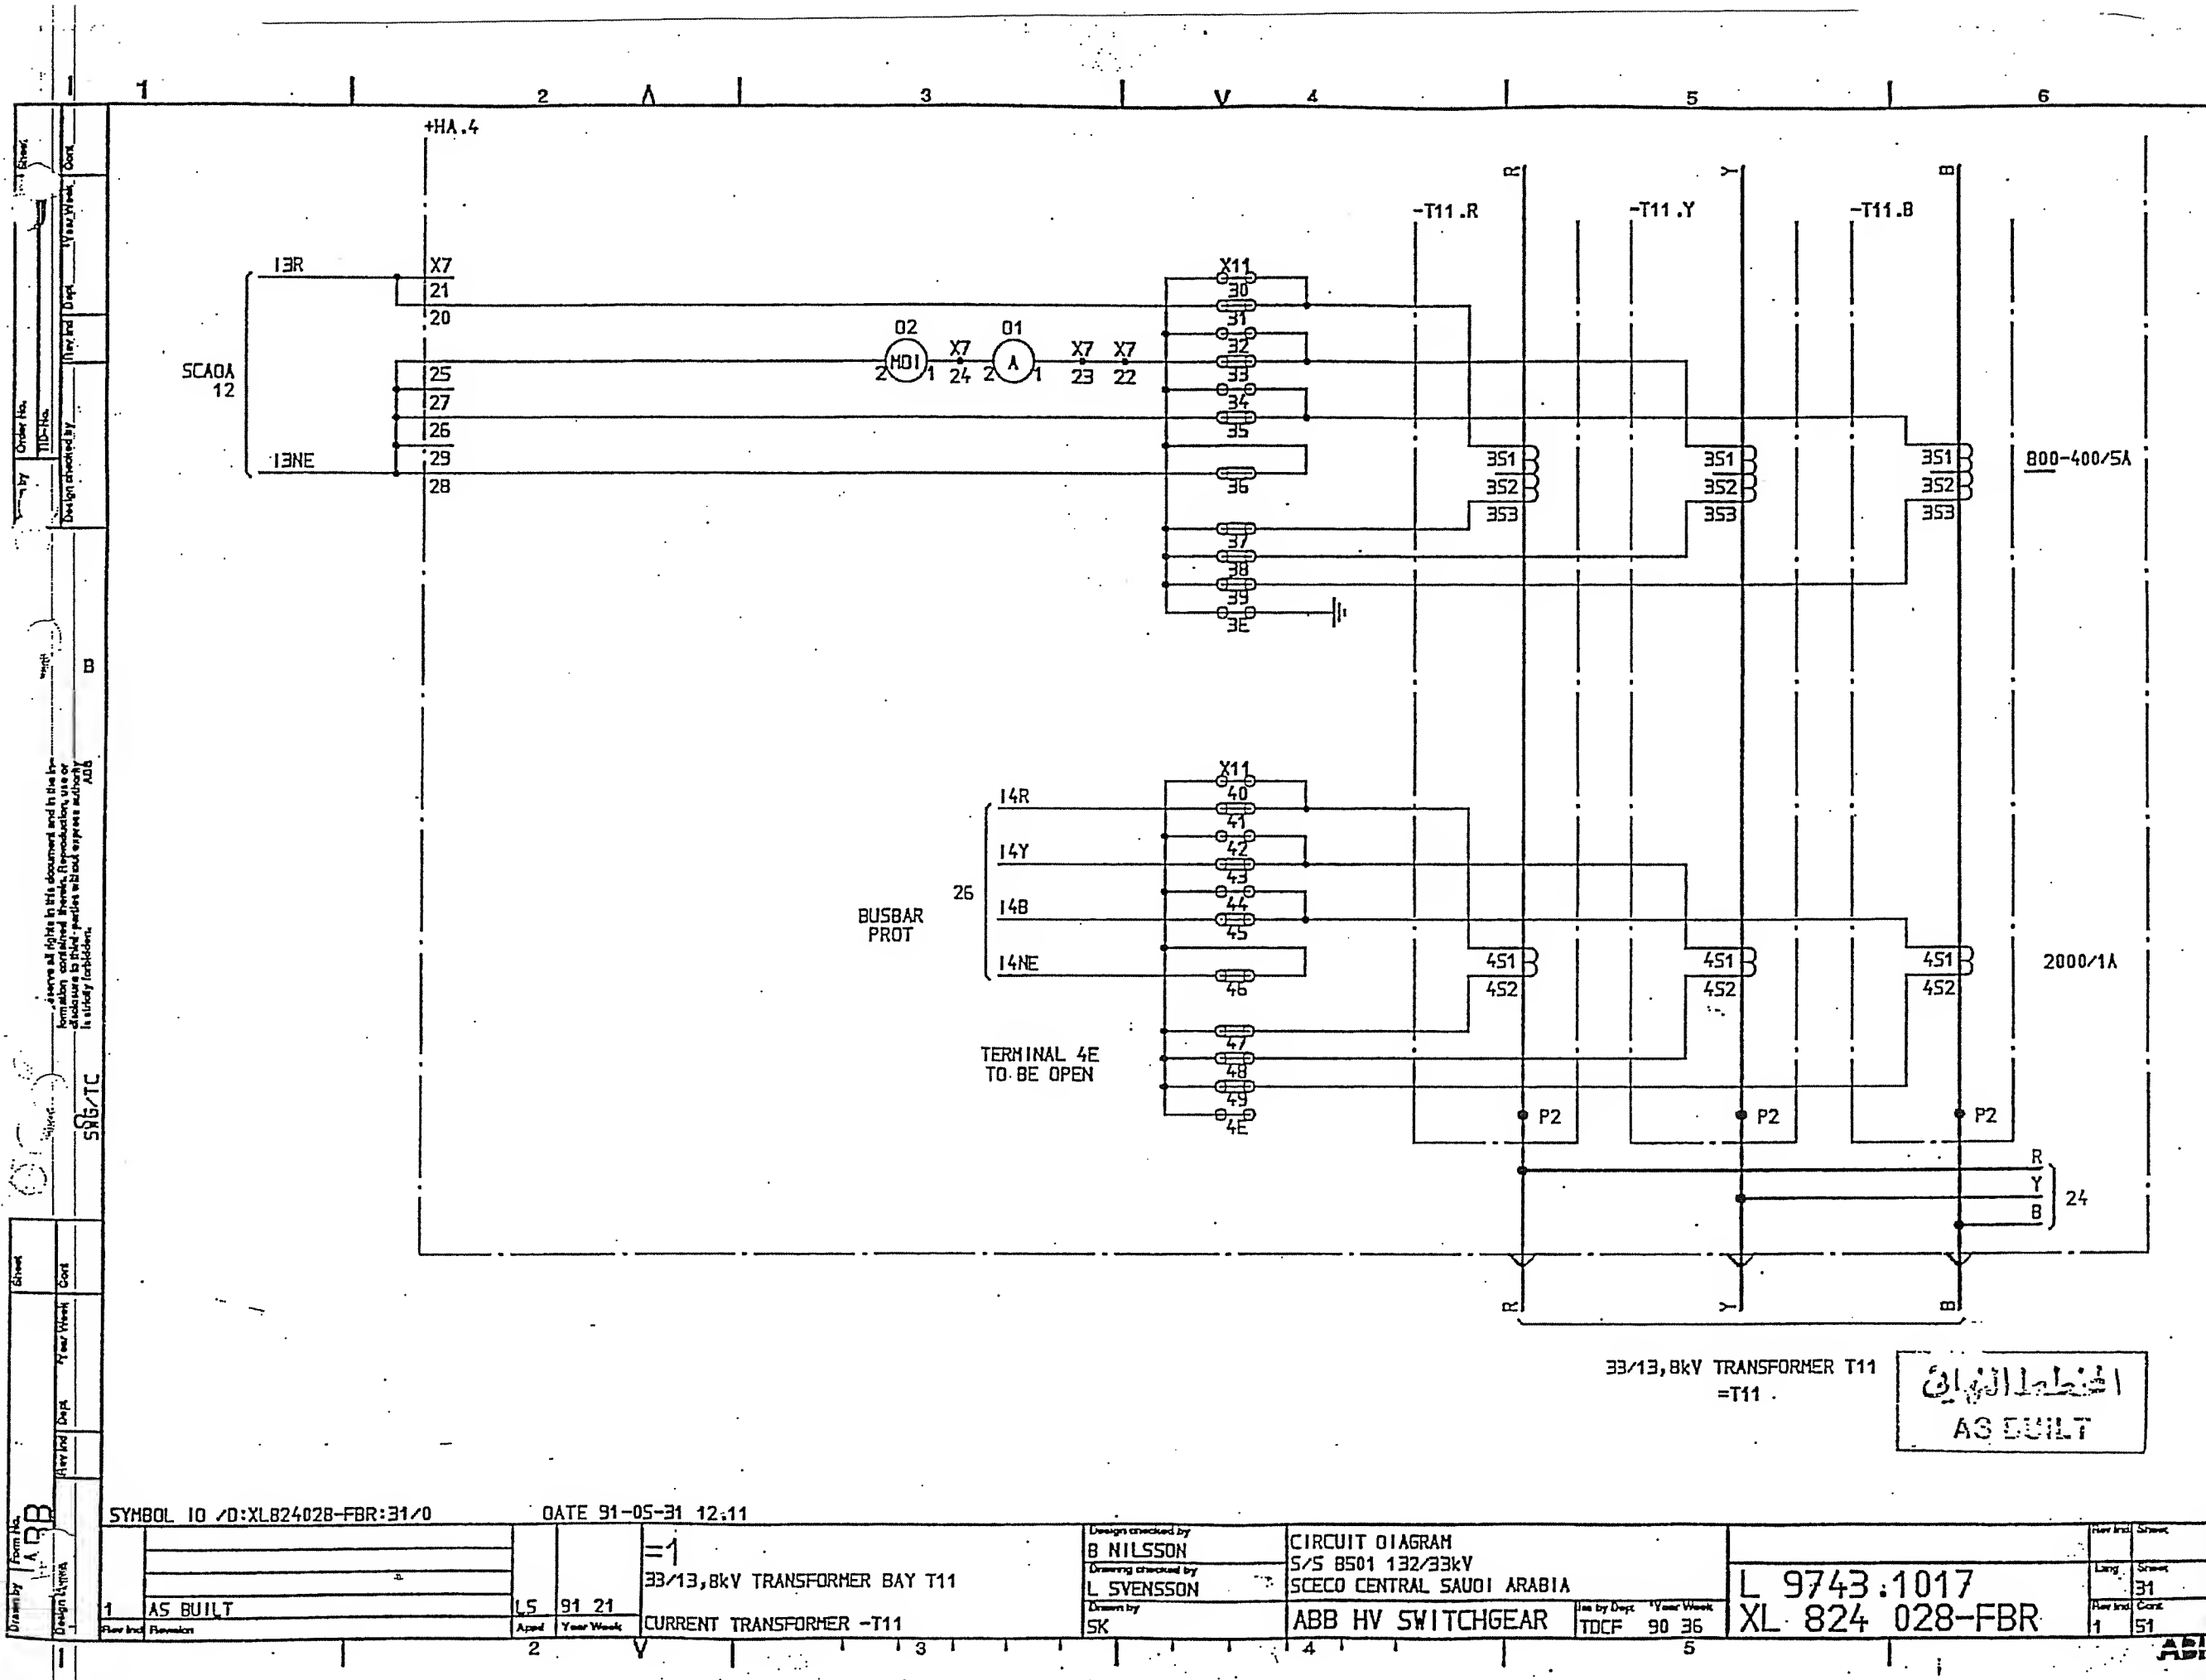

| ITEM | DESIGNATION | SHEET |
|-------|------------------------------------|-------|
| +RB.3 | HEATING AND LIGHTING RELAY CUBICLE | 54 |
| | VOLTAGE DISTRIBUTION RELAY CUBICLE | 55 |
| +XA.1 | SCADA INTERFACE EQUIPMENT | 62 |
| +HA.7 | AUX. VOLTAGE SUPPLY | 65 |
| | HEATING AND LIGHTING | 66 |
| | C.B. OPERATION CIRCUITS | 68 |
| -275 | CIRCUIT BREAKER EQUIPMENT | 69 |
| | INTERLOCKING | 73 |
| -271 | EARTH SWITCH EQUIPMENT | 74 |
| | TRIP RELAYS | 78 |
| -T11 | CURRENT TRANSFORMER | 80 |
| +RB.3 | DISTANCE PROTECTION | 82 |
| | AUTO RECLOSE RELAY | 85 |
| | OVERCURRENT AND EARTH FAULT PROT. | 87 |

المخطط النهائي
AS BUILT

SYMBOL 10 /D:XL824028-FBR:51/0

DATE 91-05-31 12.11

| | | | | | |
|---|----------|----|-------|----|---------------------------|
| 1 | AS BUILT | L5 | 91 21 | =2 | 33kV INTERCONNECTION LINE |
| | | | | | LIST OF CONTENTS |



Design checked by
B NILSSON
Drawing checked by
L SVENSSON
Drawn by
SK

CIRCUIT DIAGRAM
S/S 8501 132/33kV
SCECO CENTRAL SAUDI ARABIA
ABB HV SWITCHGEAR


Iss by Dept. Year Week
TDCF 90 36

L 9743.1017
XL 824 028-FBR-

| | |
|----------|-------|
| Drawn by | Sheet |
| Long | 51 |
| Drawn by | Cont |
| 1 | 54 |

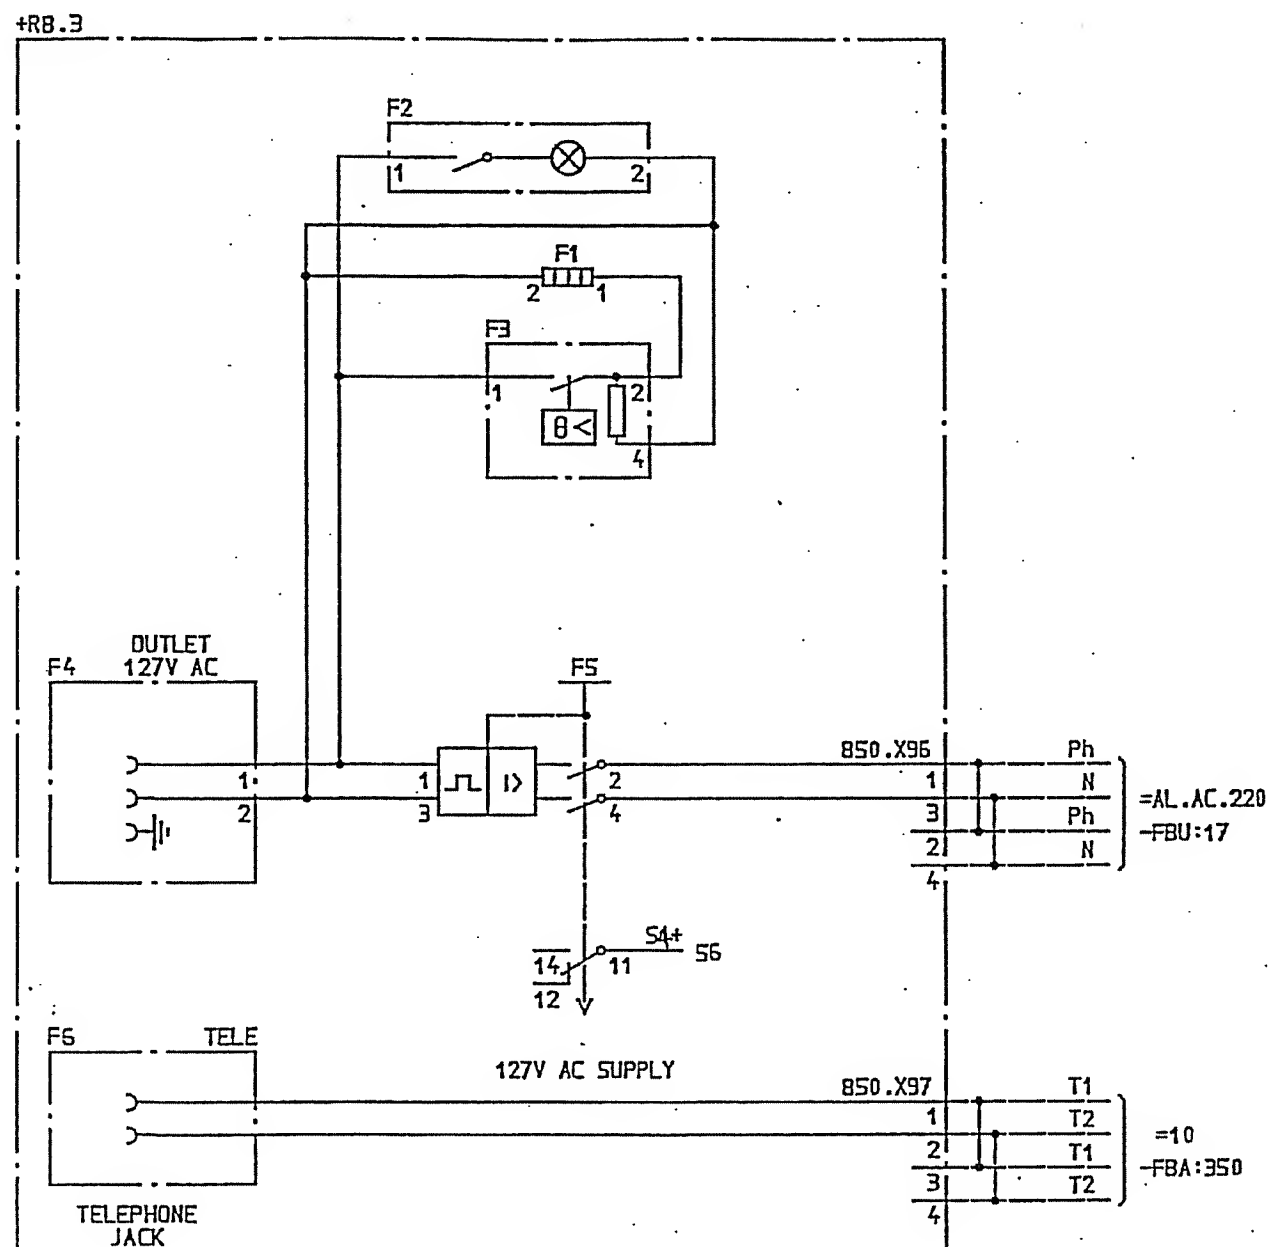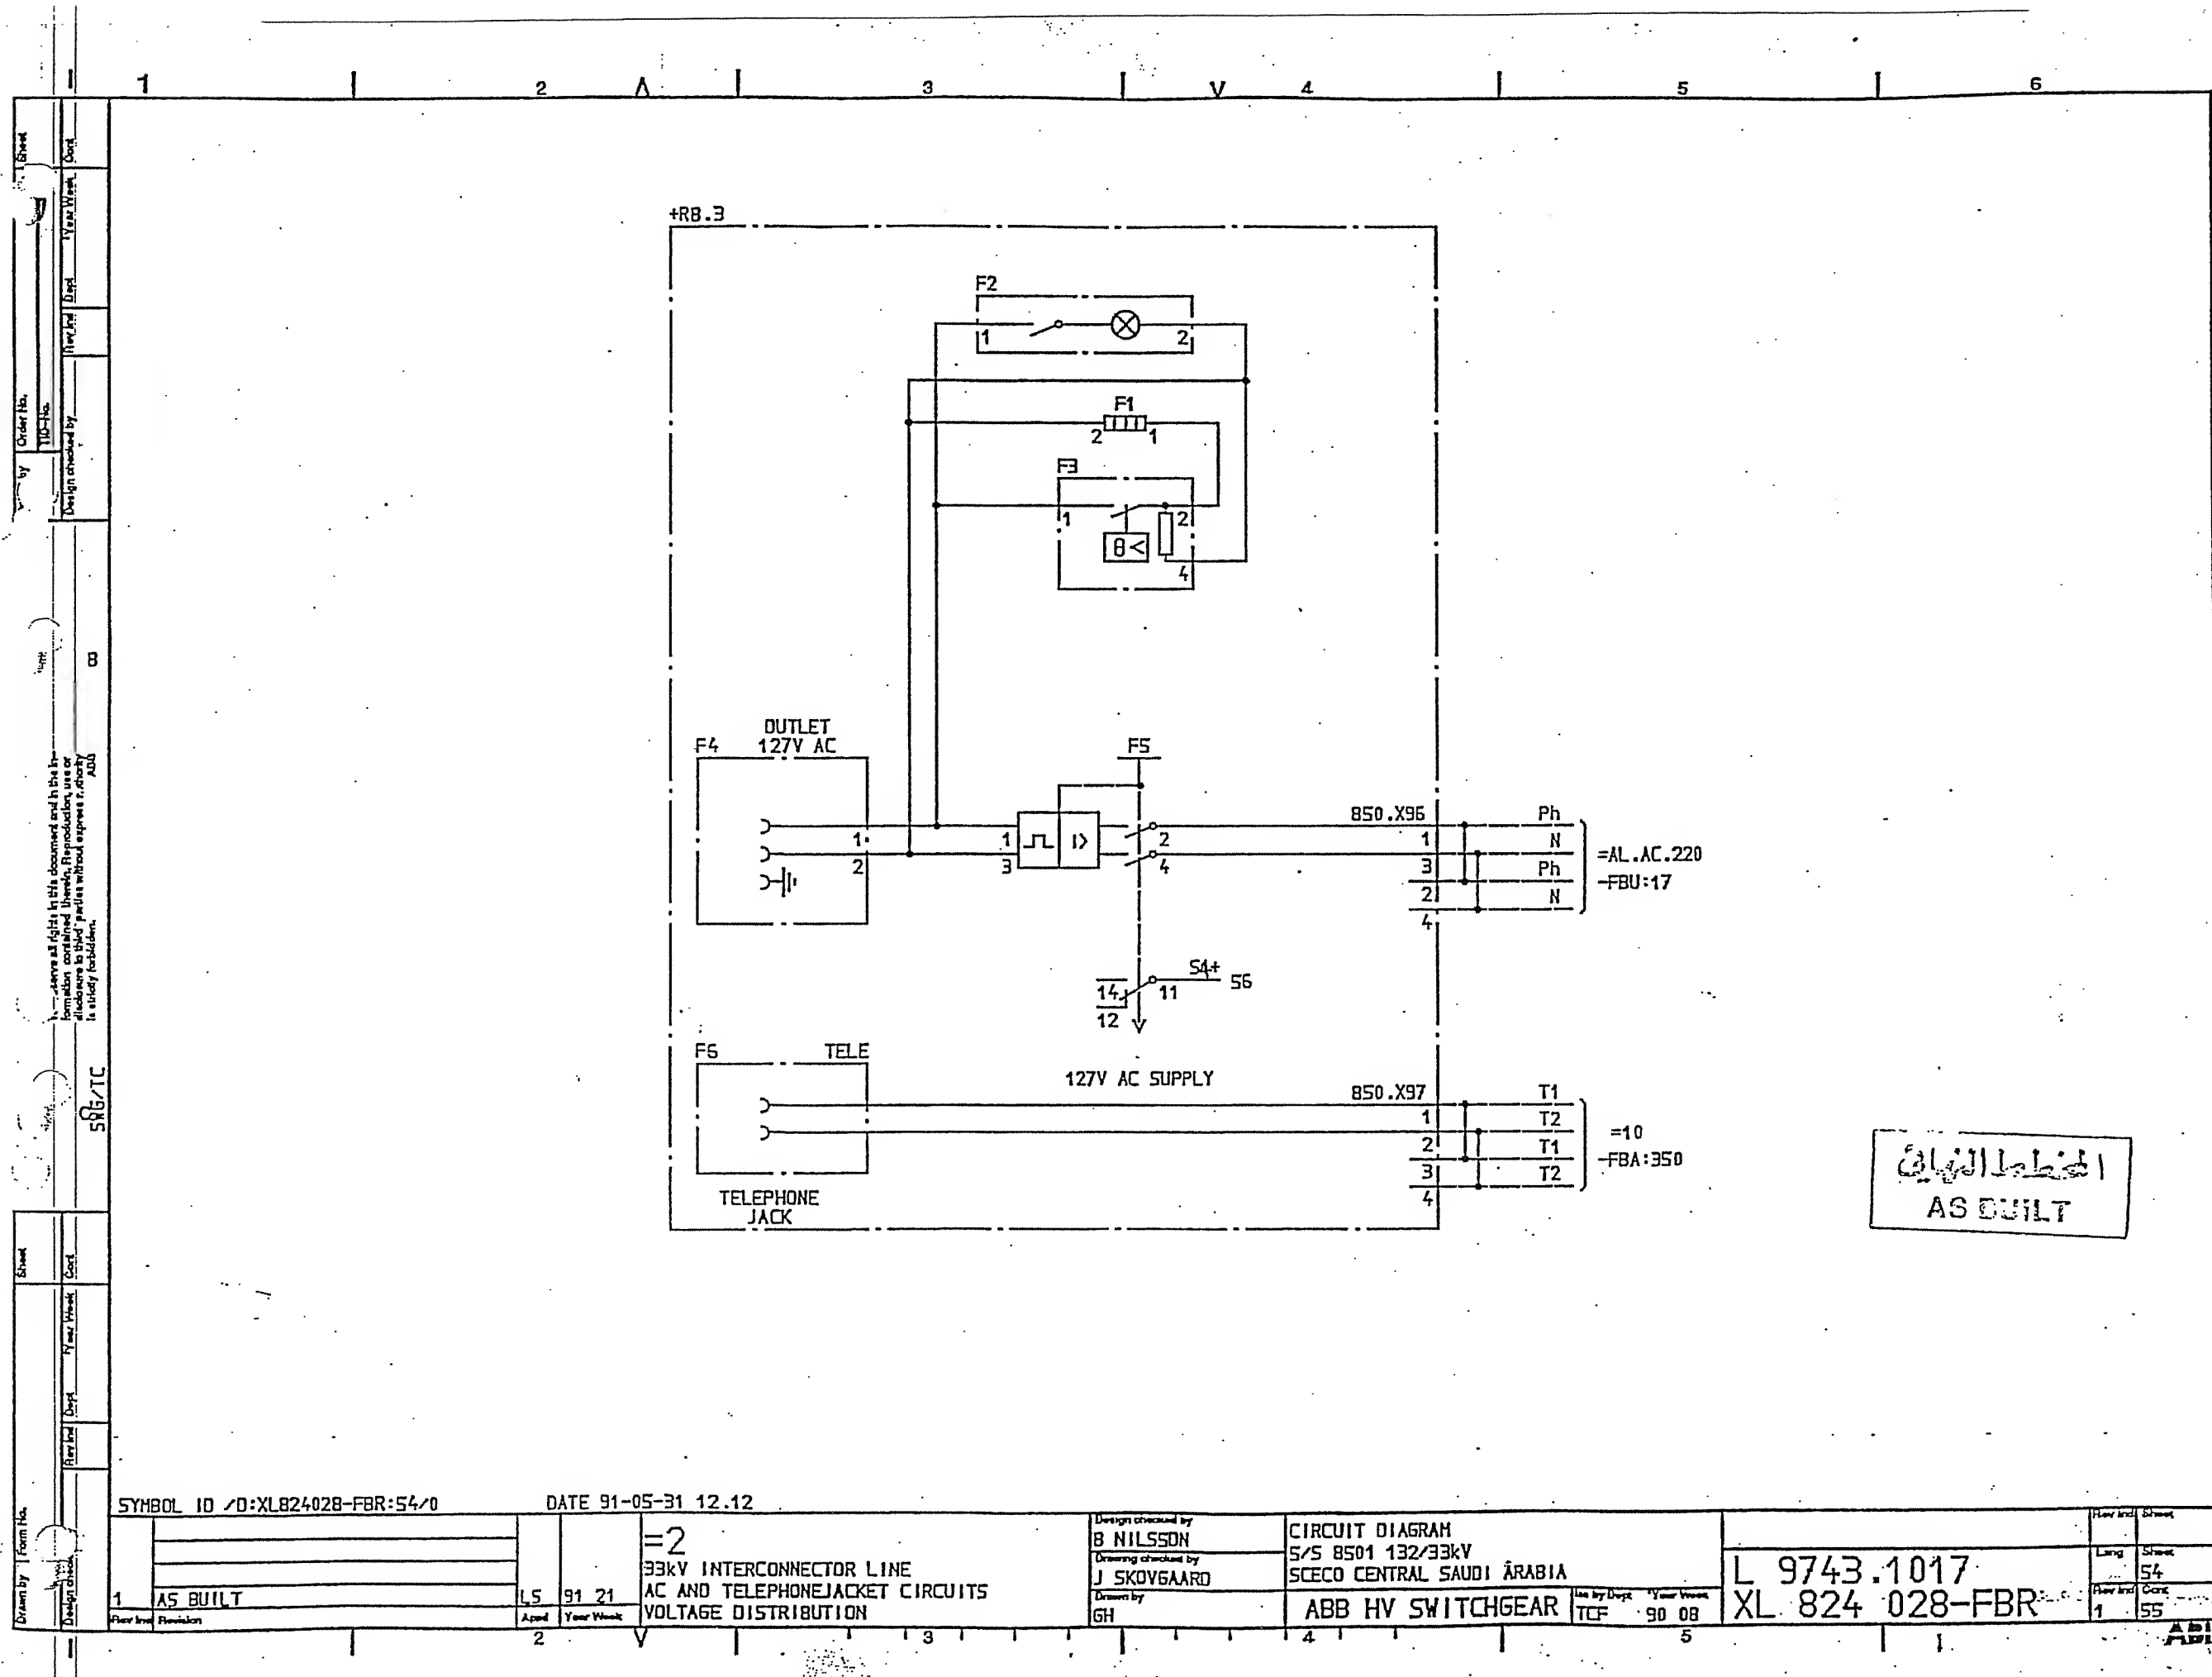


المخطط النهائي
AS BUILT

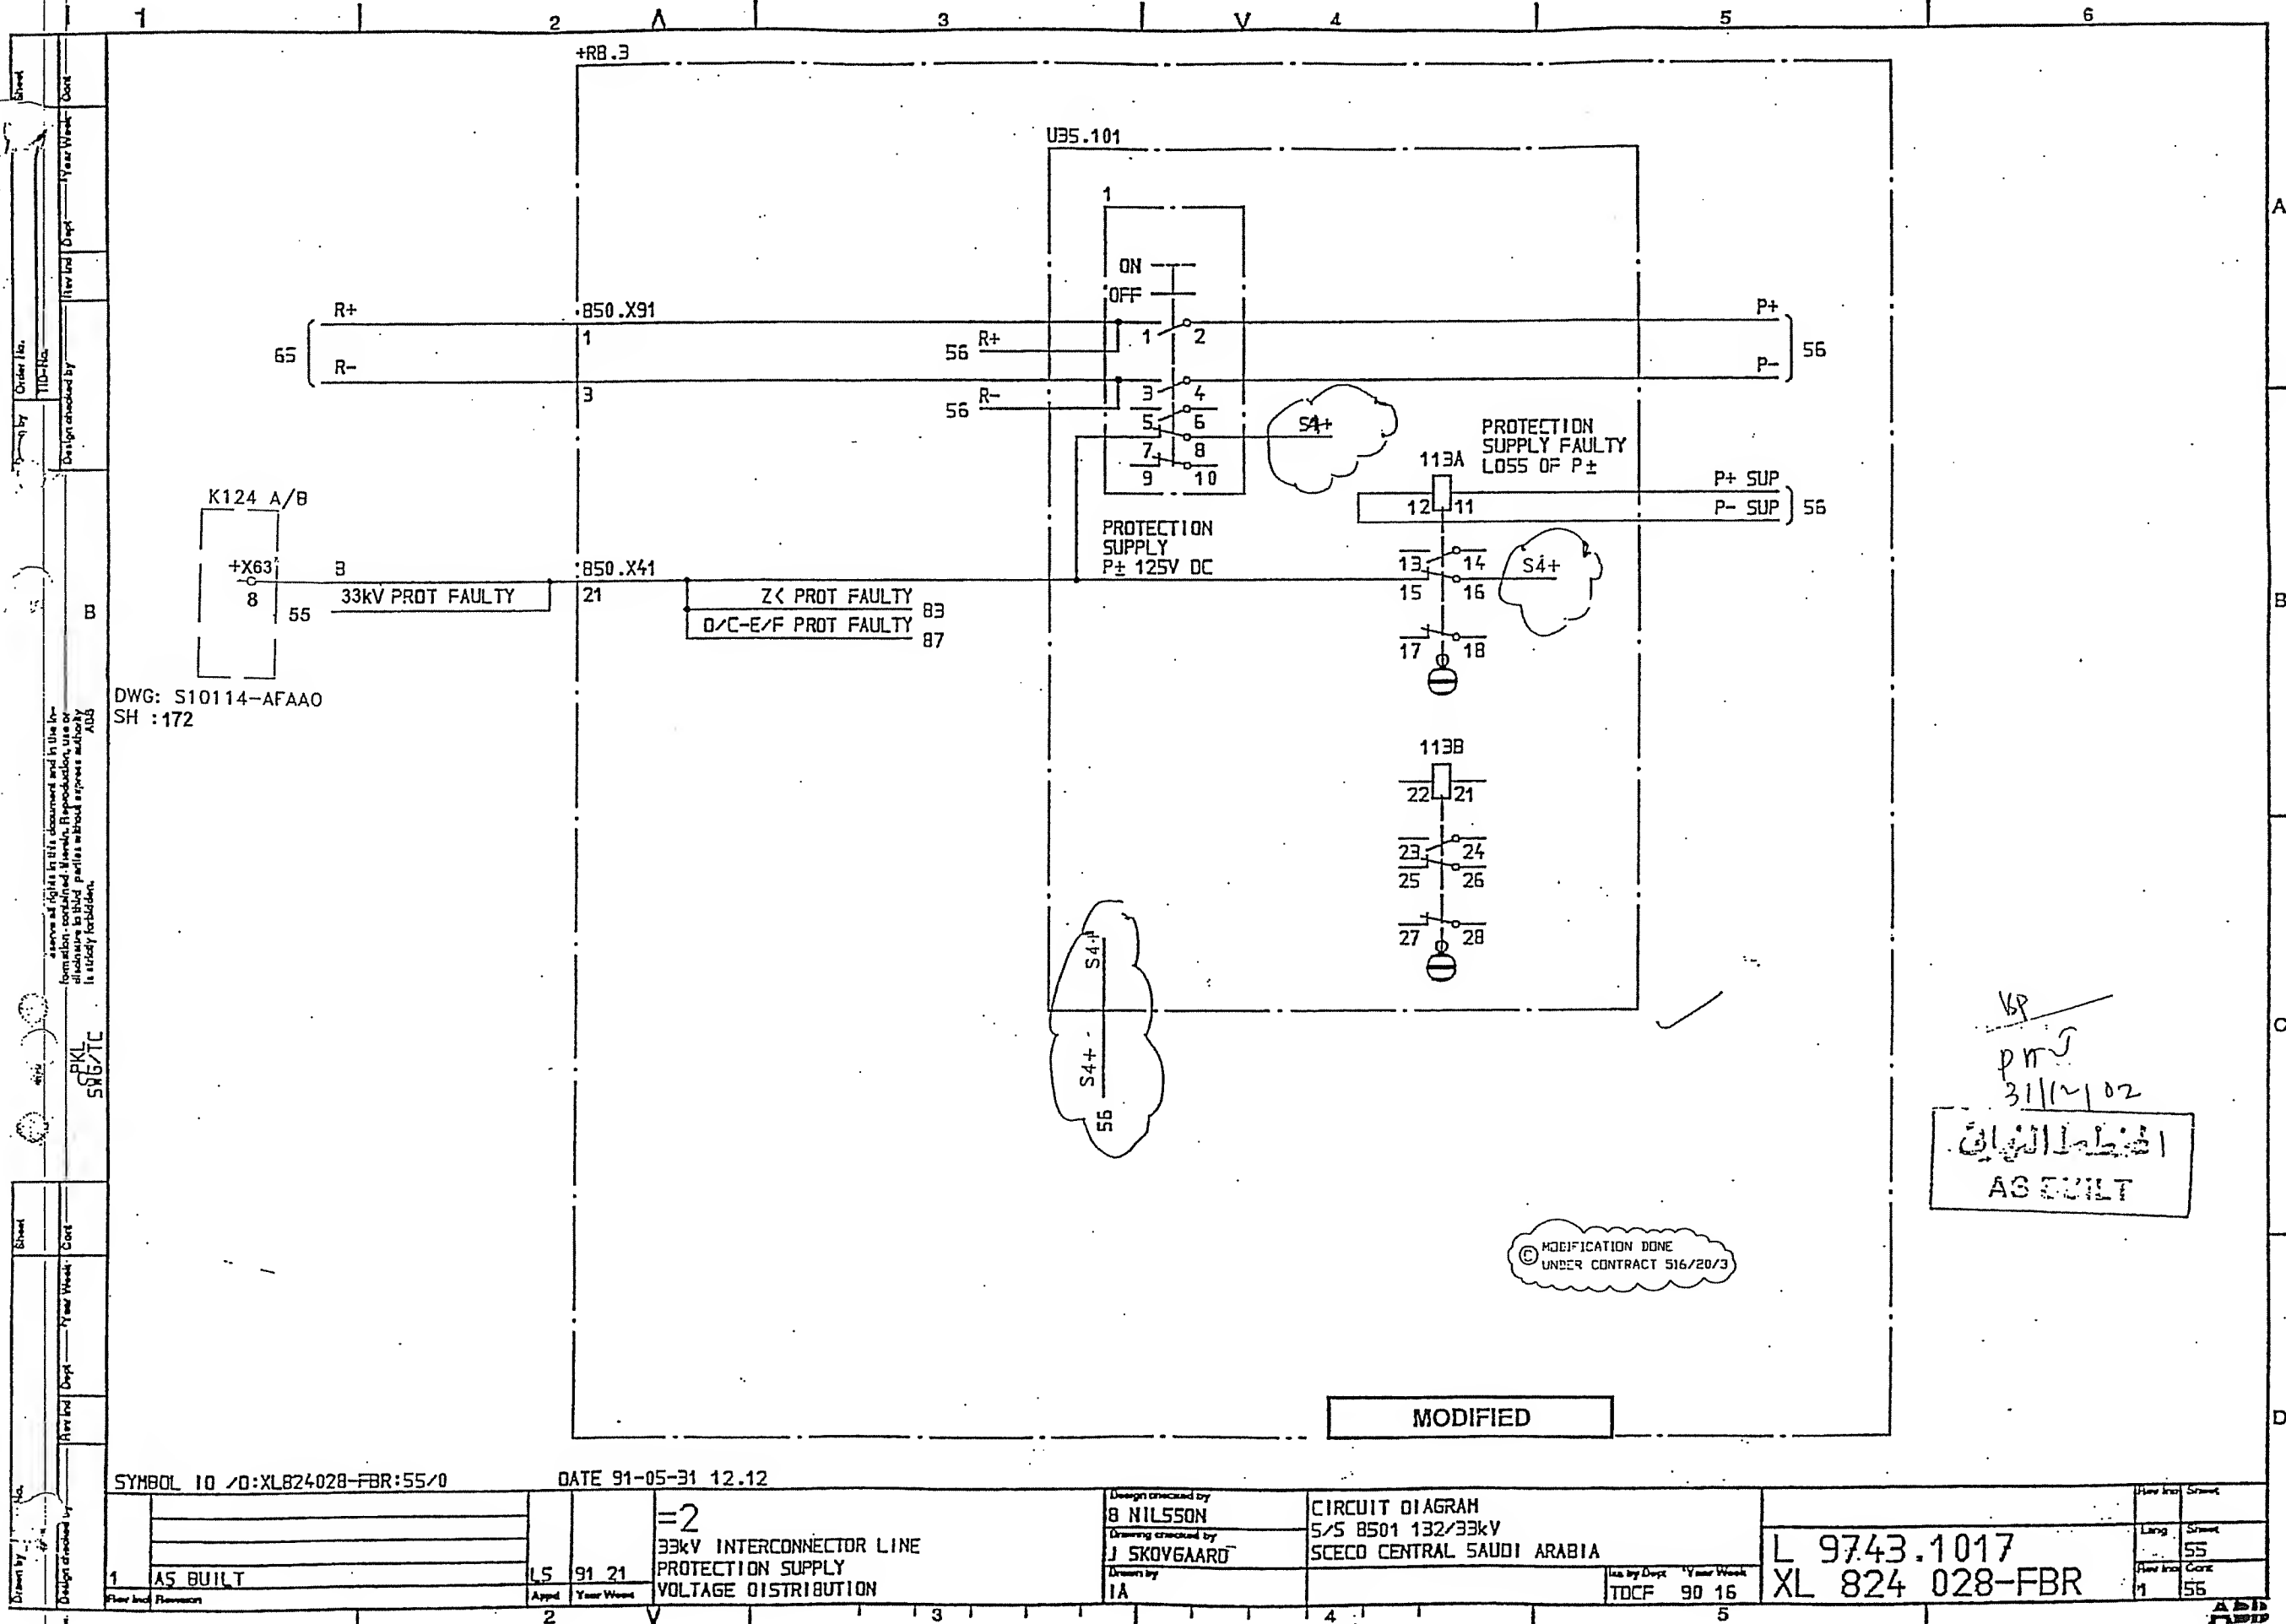


SYMBOL 10 /0:XL824028-FBR:55/0

DATE 91-05-31 12.12


| | | | | | | | | | |
|---|----------|----|-------|---|---|--|---|---|---|
| 1 | AS BUILT | LS | 91 21 | 2 | V | 3 | 4 | 5 | 6 |
| 33kV INTERCONNECTOR LINE PROTECTION SUPPLY VOLTAGE DISTRIBUTION | | | | | | CIRCUIT DIAGRAM 5/5 B501 132/33kV SCECO CENTRAL SAUDI ARABIA | | | |
| Design checked by B NILSSON Drawing checked by J SKOVGAARD Drawn by IA | | | | | | L 9743.1017 XL 824 028-FBR | | | |
| Iss. by Dept TDCF | | | | | | 90 16 | | | |

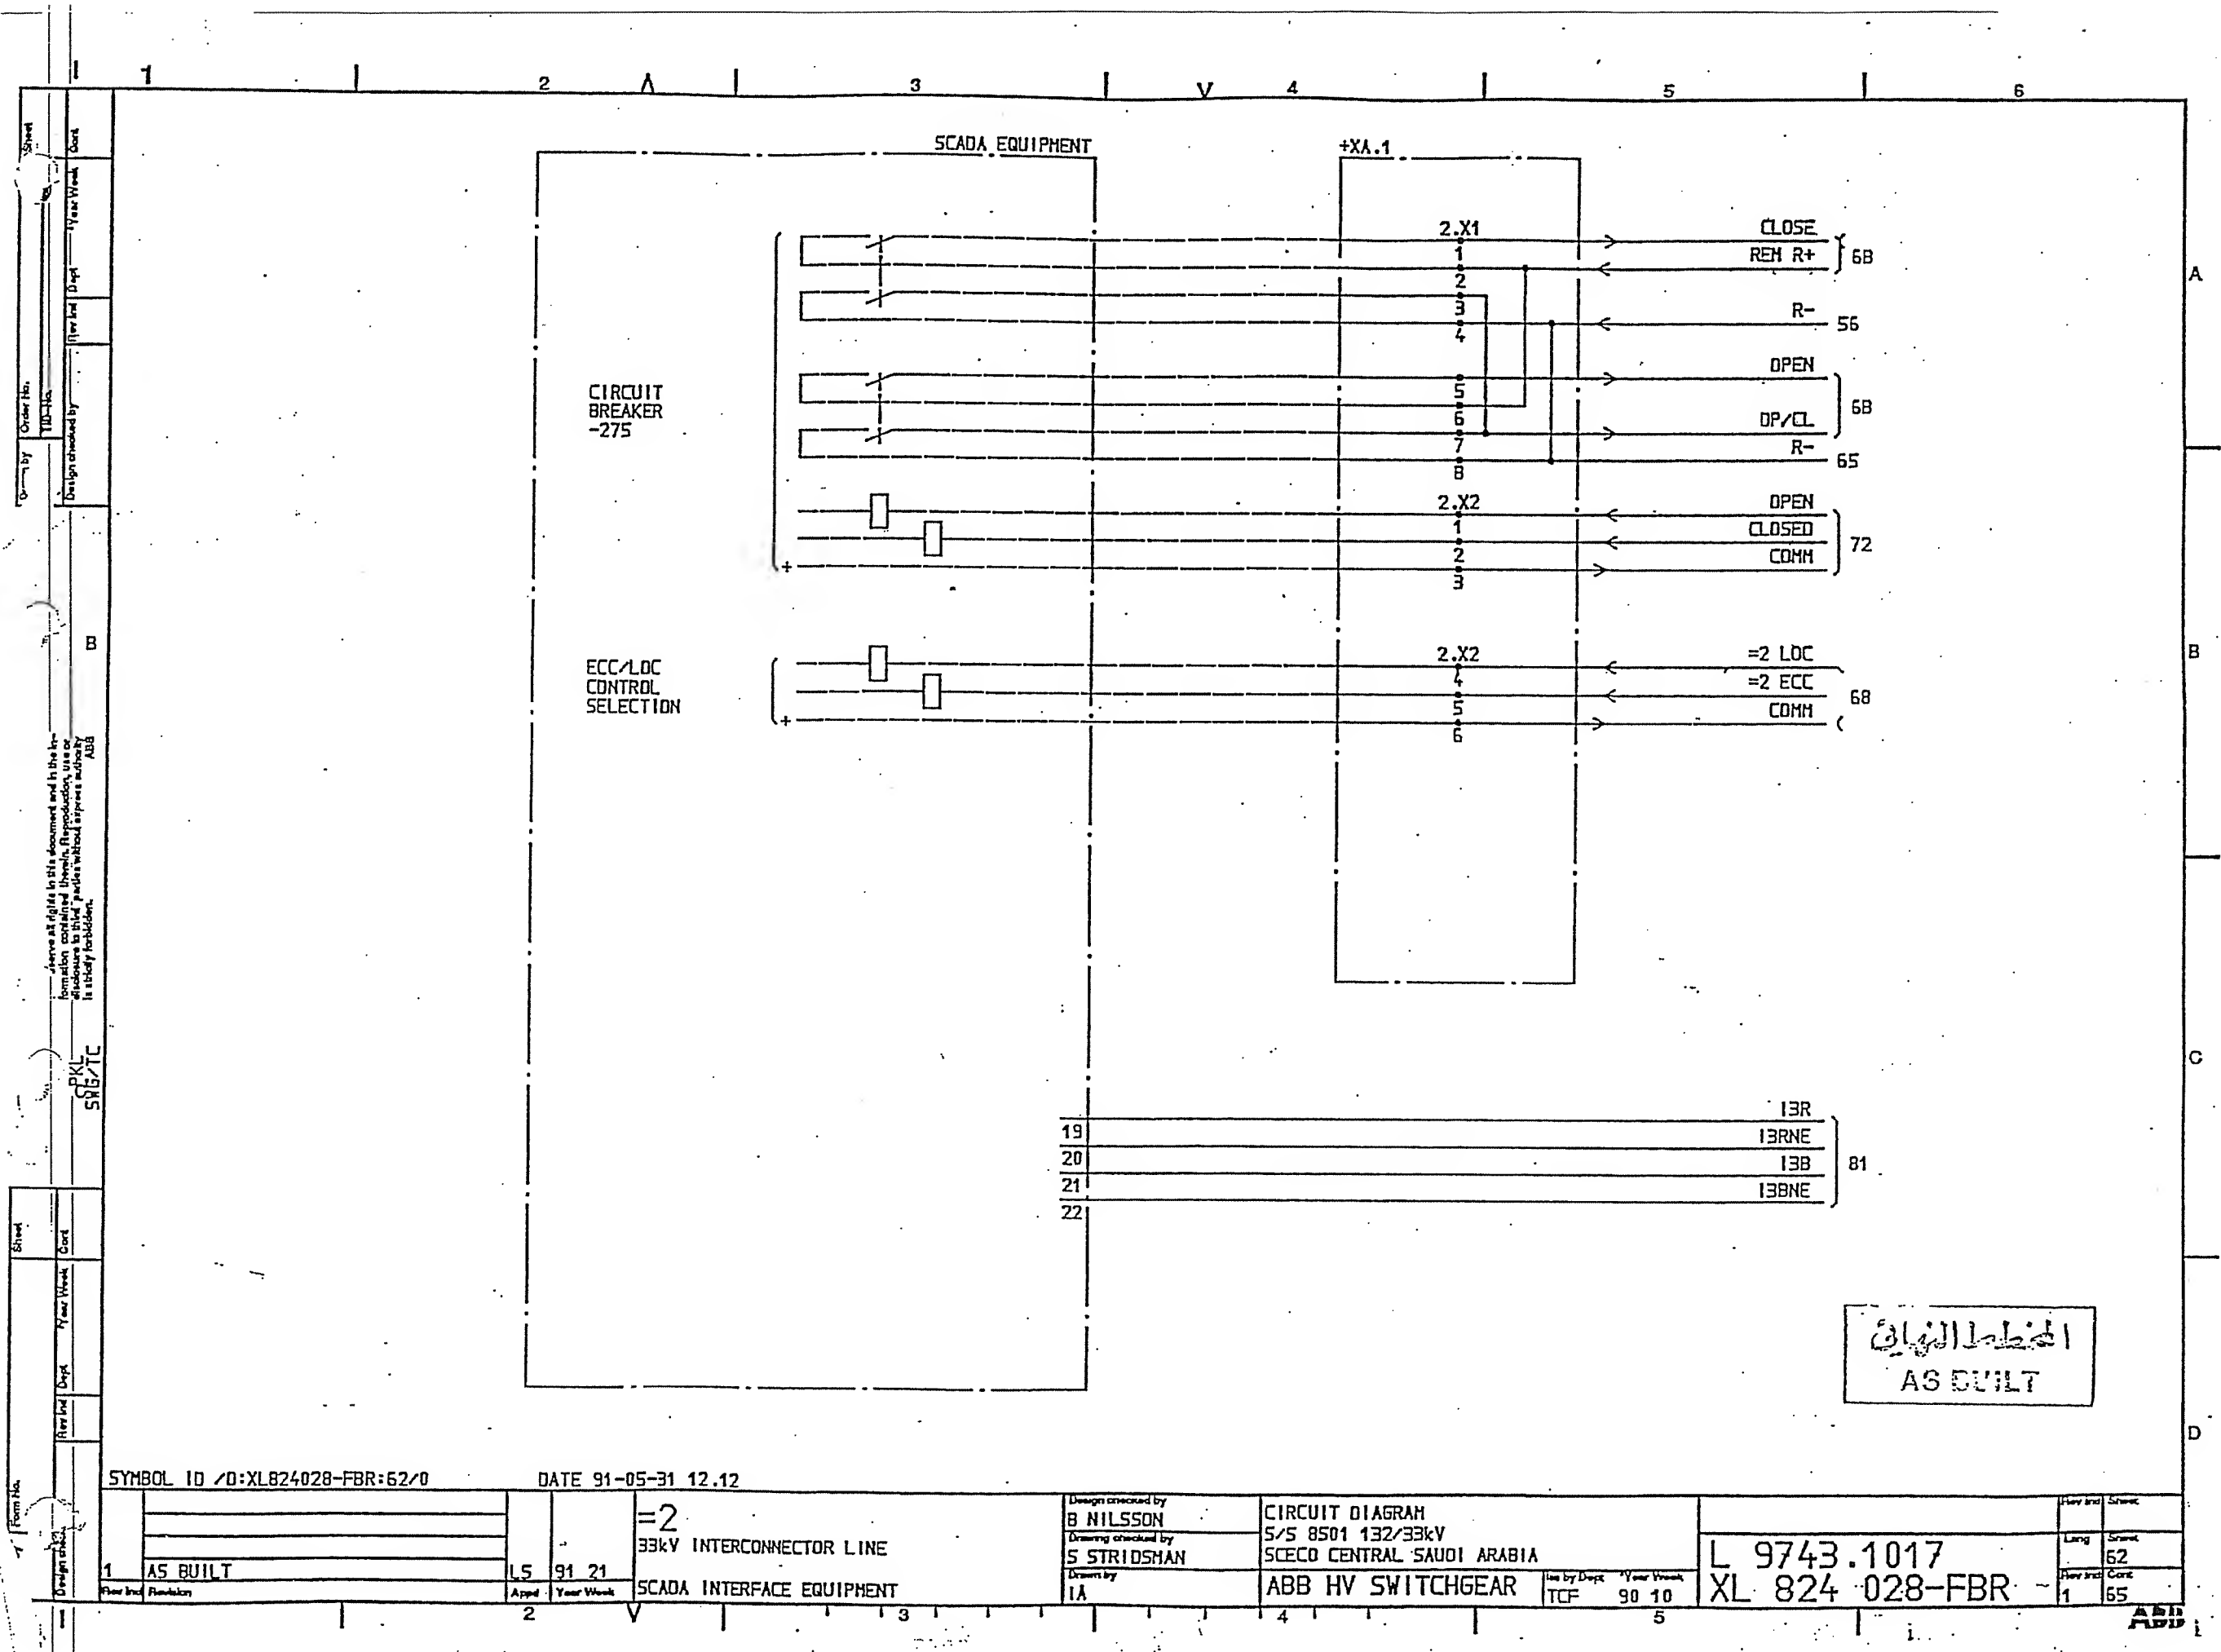

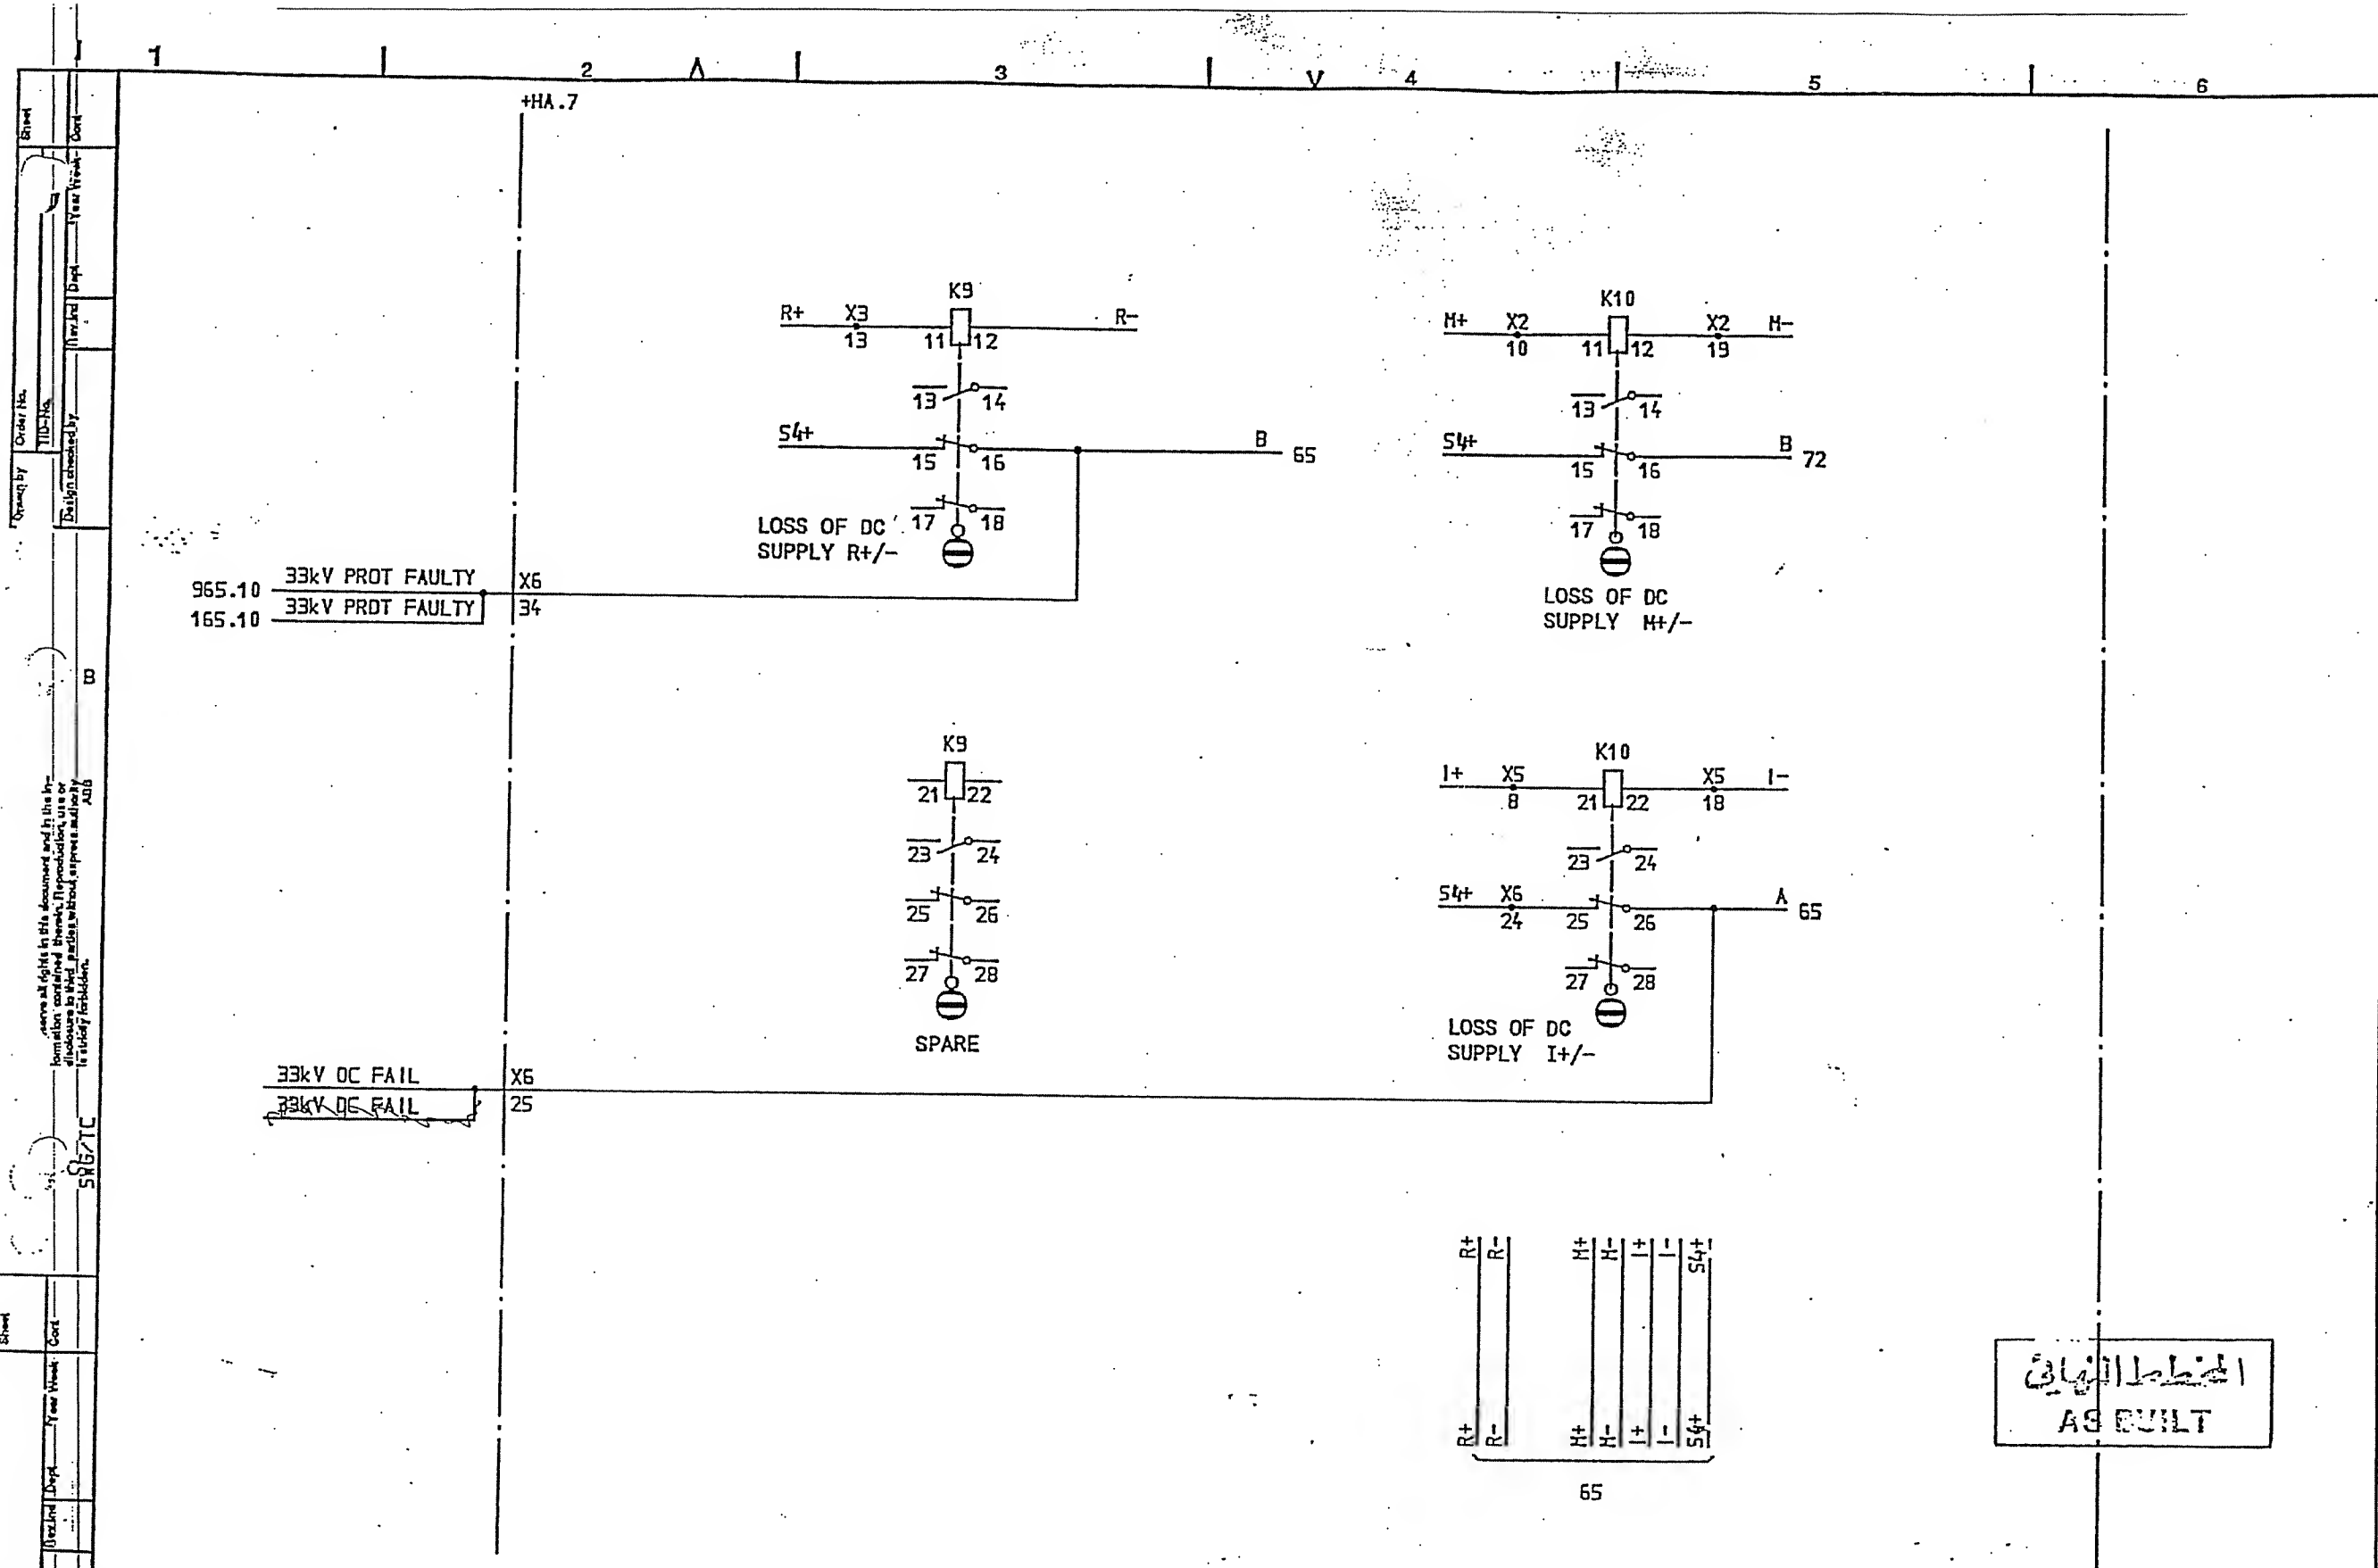

| | | | | | |
|-----------------------------------|----------------|-------------------------|--|--------------------|----------------|
| Drawn by BB | Check by BB | Design checked by BB | Order No. 110-110 | Year Week 91 21 | Sheet 65.10 |
| SYMBOL ID /0:XL824028-FBR:65.10/0 | | | DATE 91-05-31 12.12 | | |
| =2 33kV INTERCONNECTOR LINE | | | CIRCUIT DIAGRAM S/S 8501 132/33kV SCECO CENTRAL SAUDI ARABIA | | |
| AS BUILT | | | L 9743.1017 | | |
| DC AUX. VOLTAGE SUPPLY | | | XL 824 028-FBR | | |
| Appd 2 | | | Year Week 90 35 | | |
| Design checked by B NILSSON | | | Line by Dept TDCF | | |
| Drawing checked by L SVENSSON | | | Year Week 90 35 | | |
| Drawn by SK | | | Sheet 65 | | |

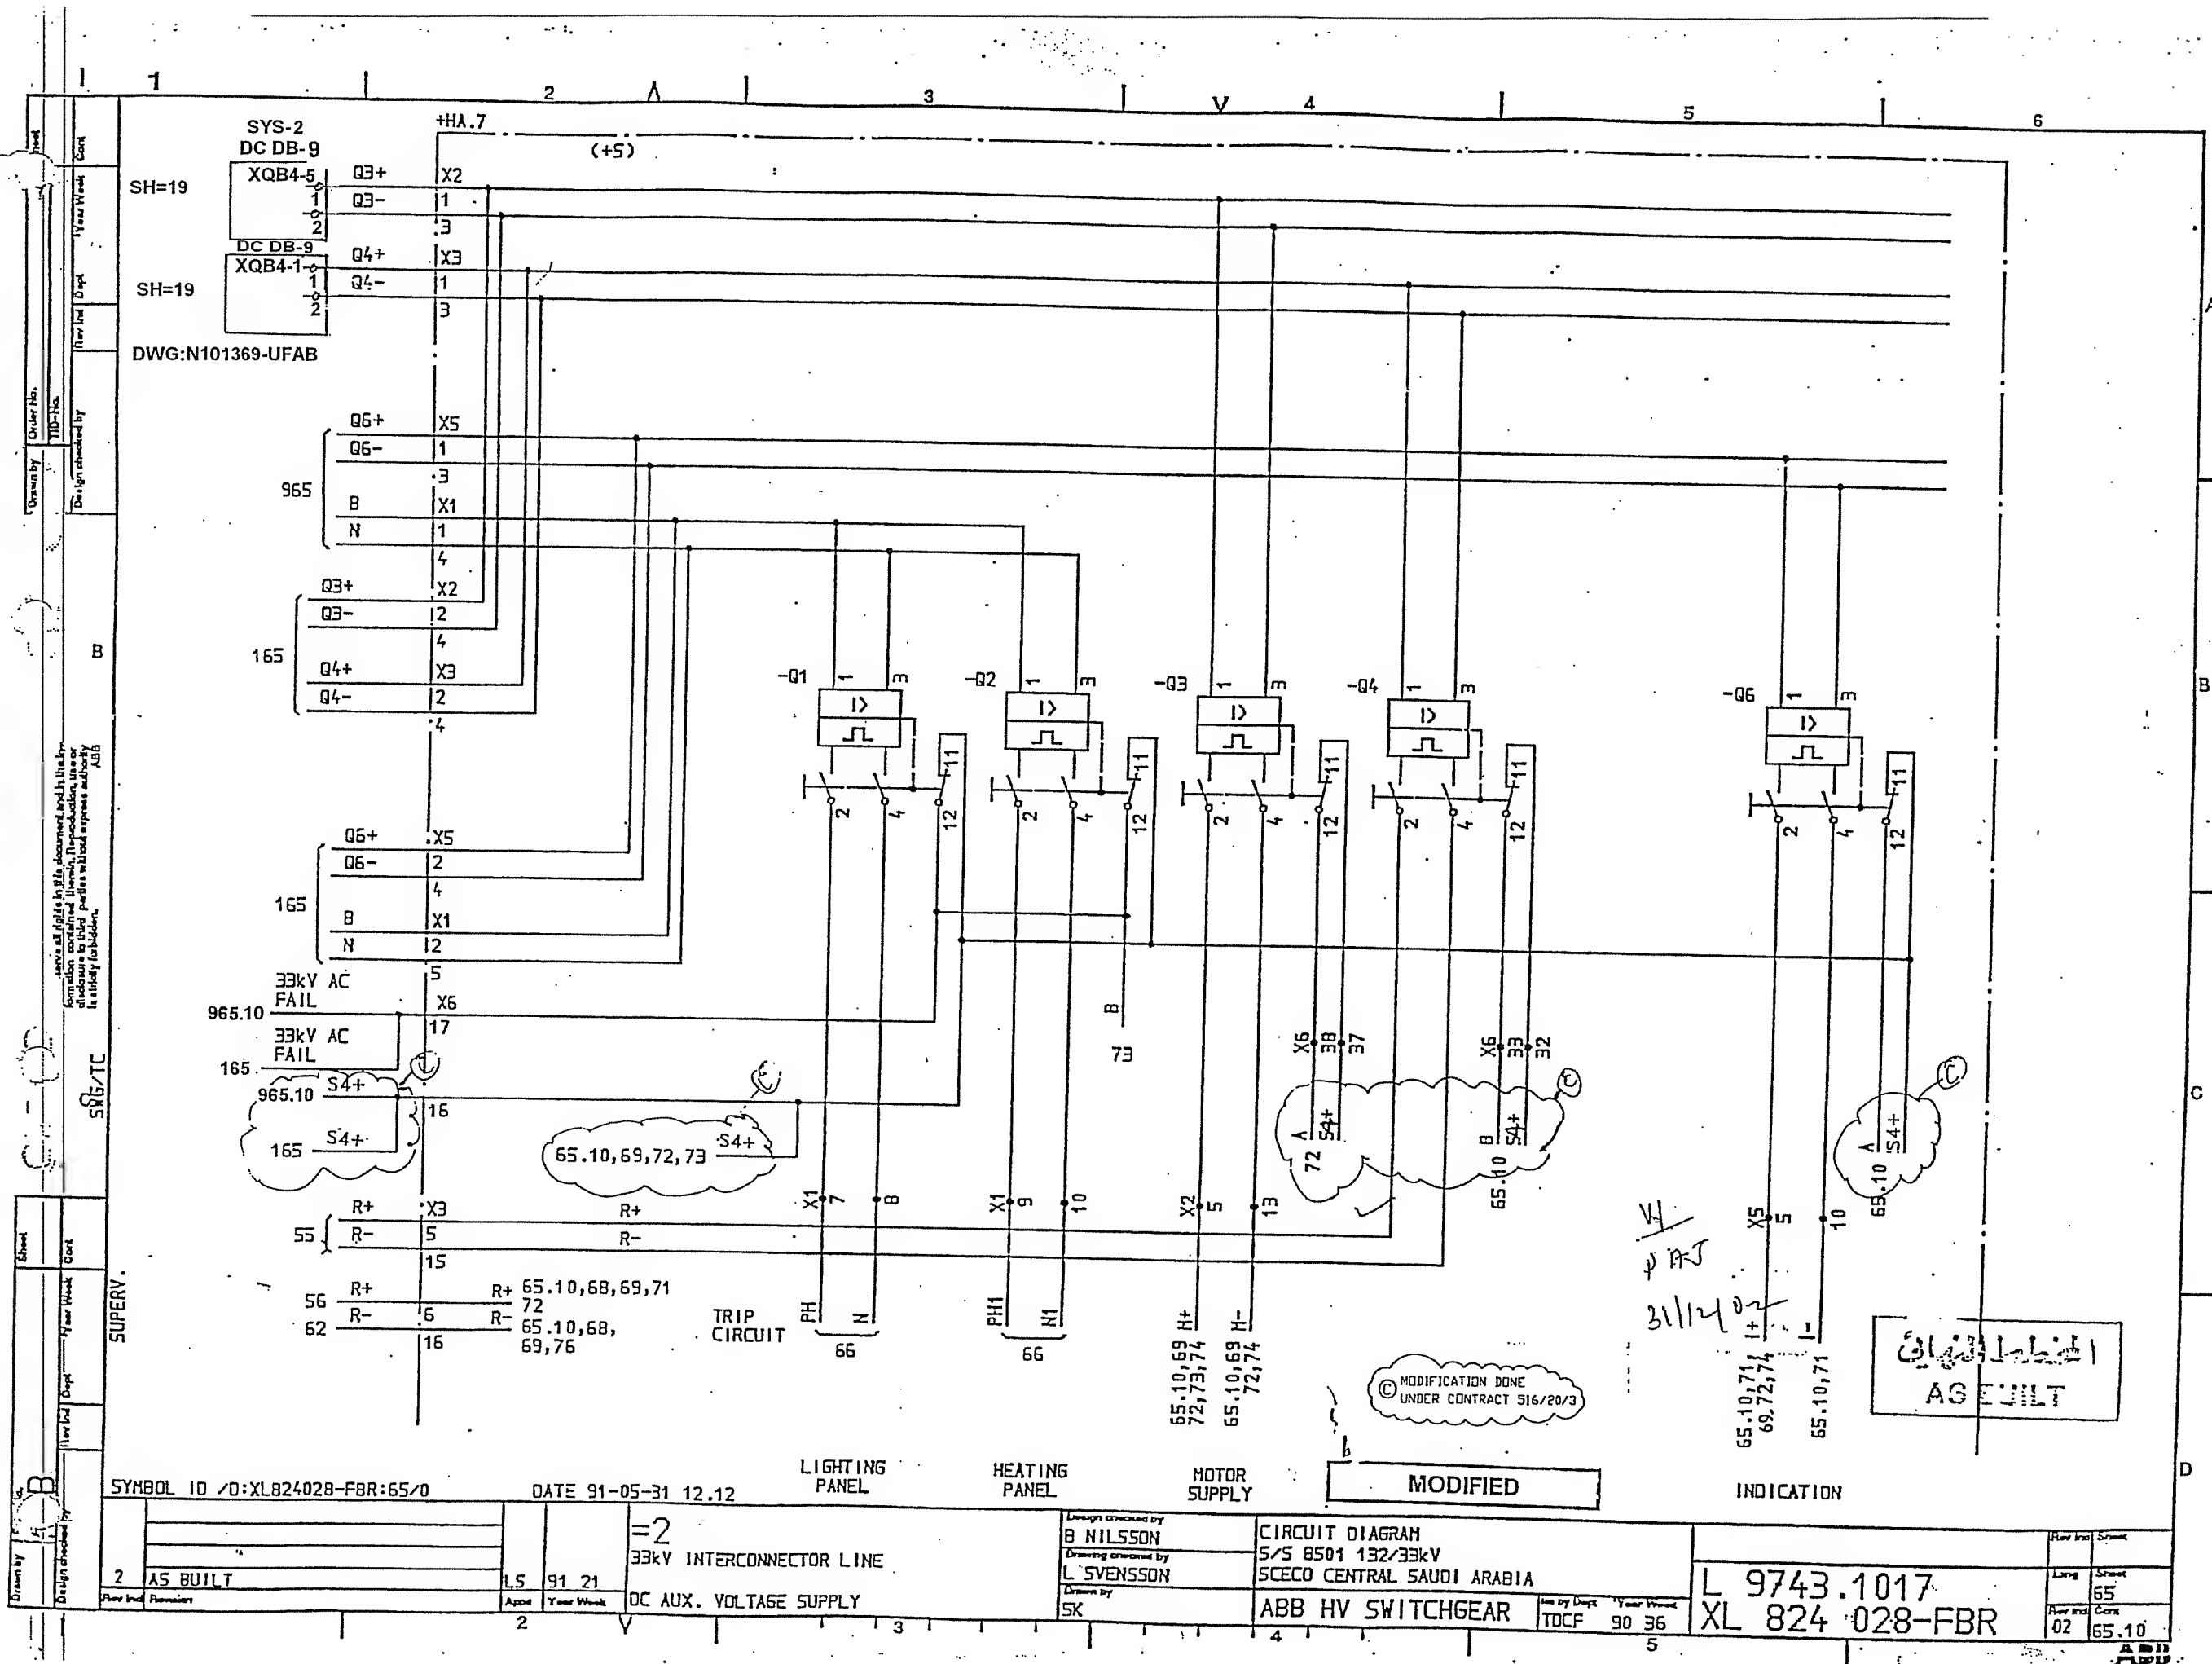المخطط النهائي
AS BUILT



SYMBOL ID /O:XL824028-FBR:65/0

DATE 91-05-31 12.12

LIGHTING PANEL

HEATING PANEL

MOTOR SUPPLY

MODIFIED


INDICATION


| | | | | | |
|---|----------|------|-------|---|--------------------------|
| 2 | AS BUILT | LS | 91 21 | 2 | 33kV INTERCONNECTOR LINE |
| 2 | | APPR | | 2 | DC AUX. VOLTAGE SUPPLY |

| | | | |
|--------------------|------------|----------------------------|-------------------|
| Design checked by | B NILSSON | Circuit diagram | 5/S 8501 132/33kV |
| Drawing checked by | L SVENSSON | SCECO CENTRAL SAUDI ARABIA | |
| Drawn by | SK | ABB HV SWITCHGEAR | |

| | |
|--------|-------|
| Rev No | Sheet |
| 02 | 65 |
| 02 | 65.10 |

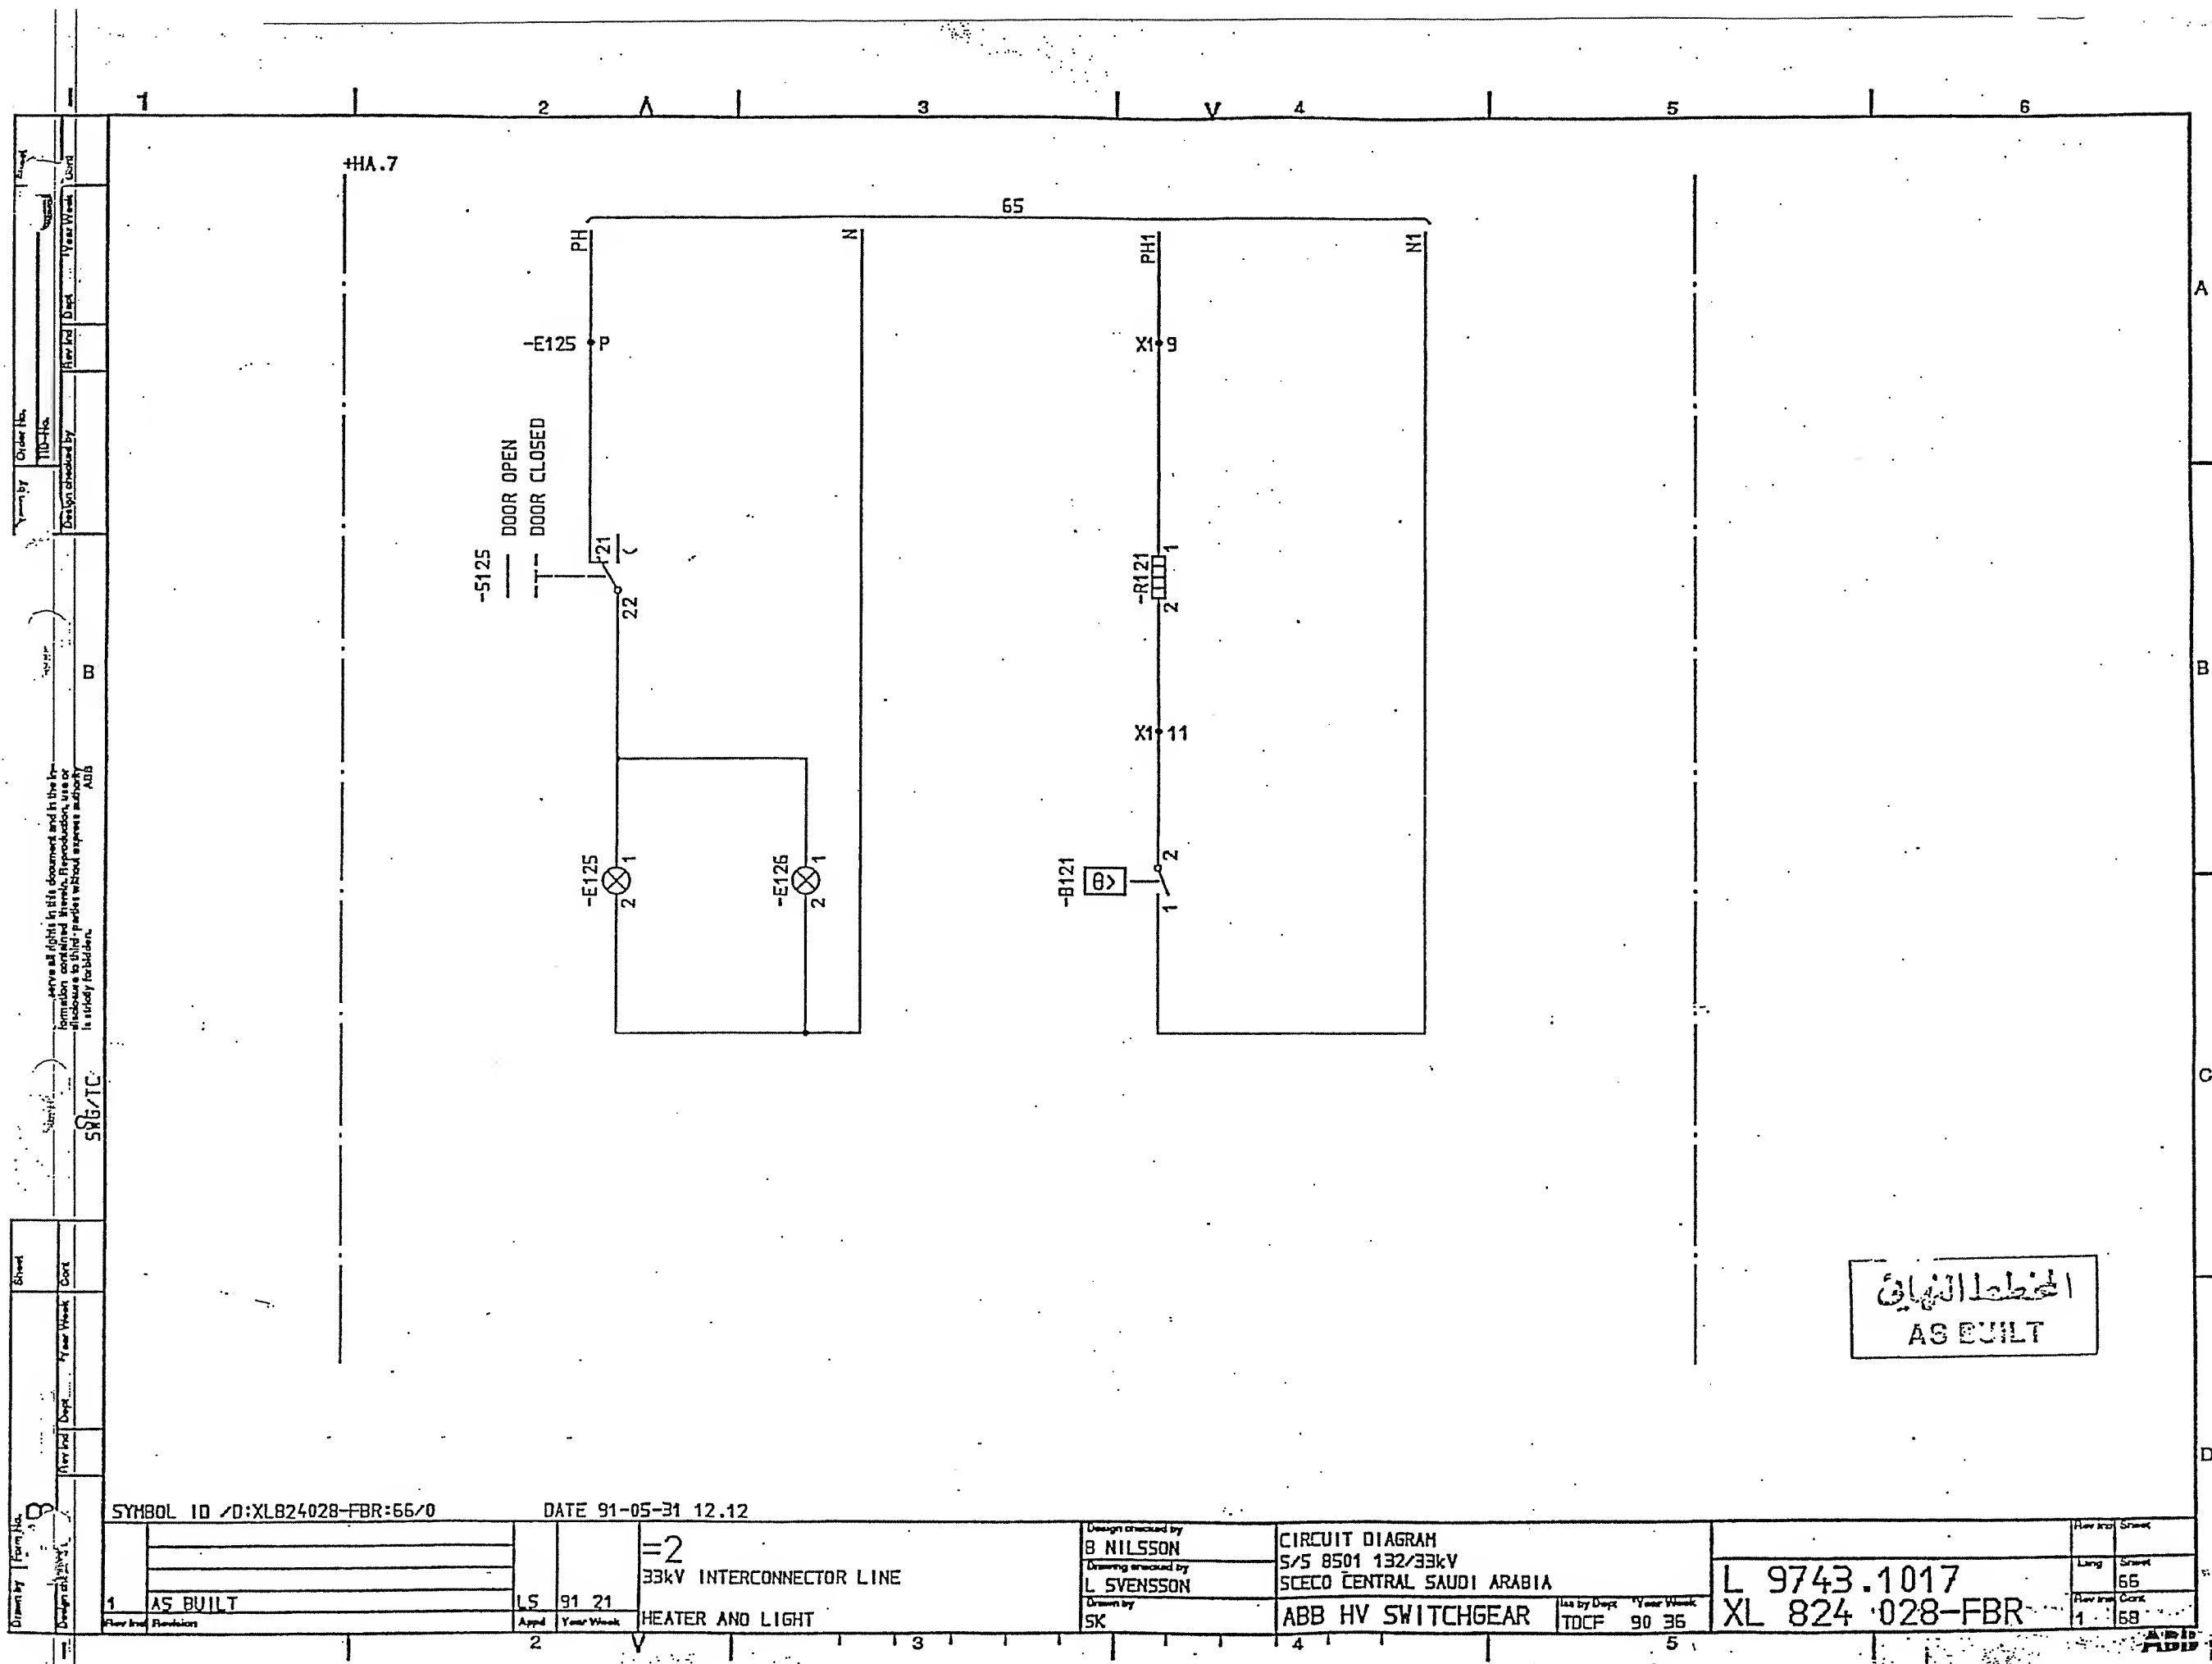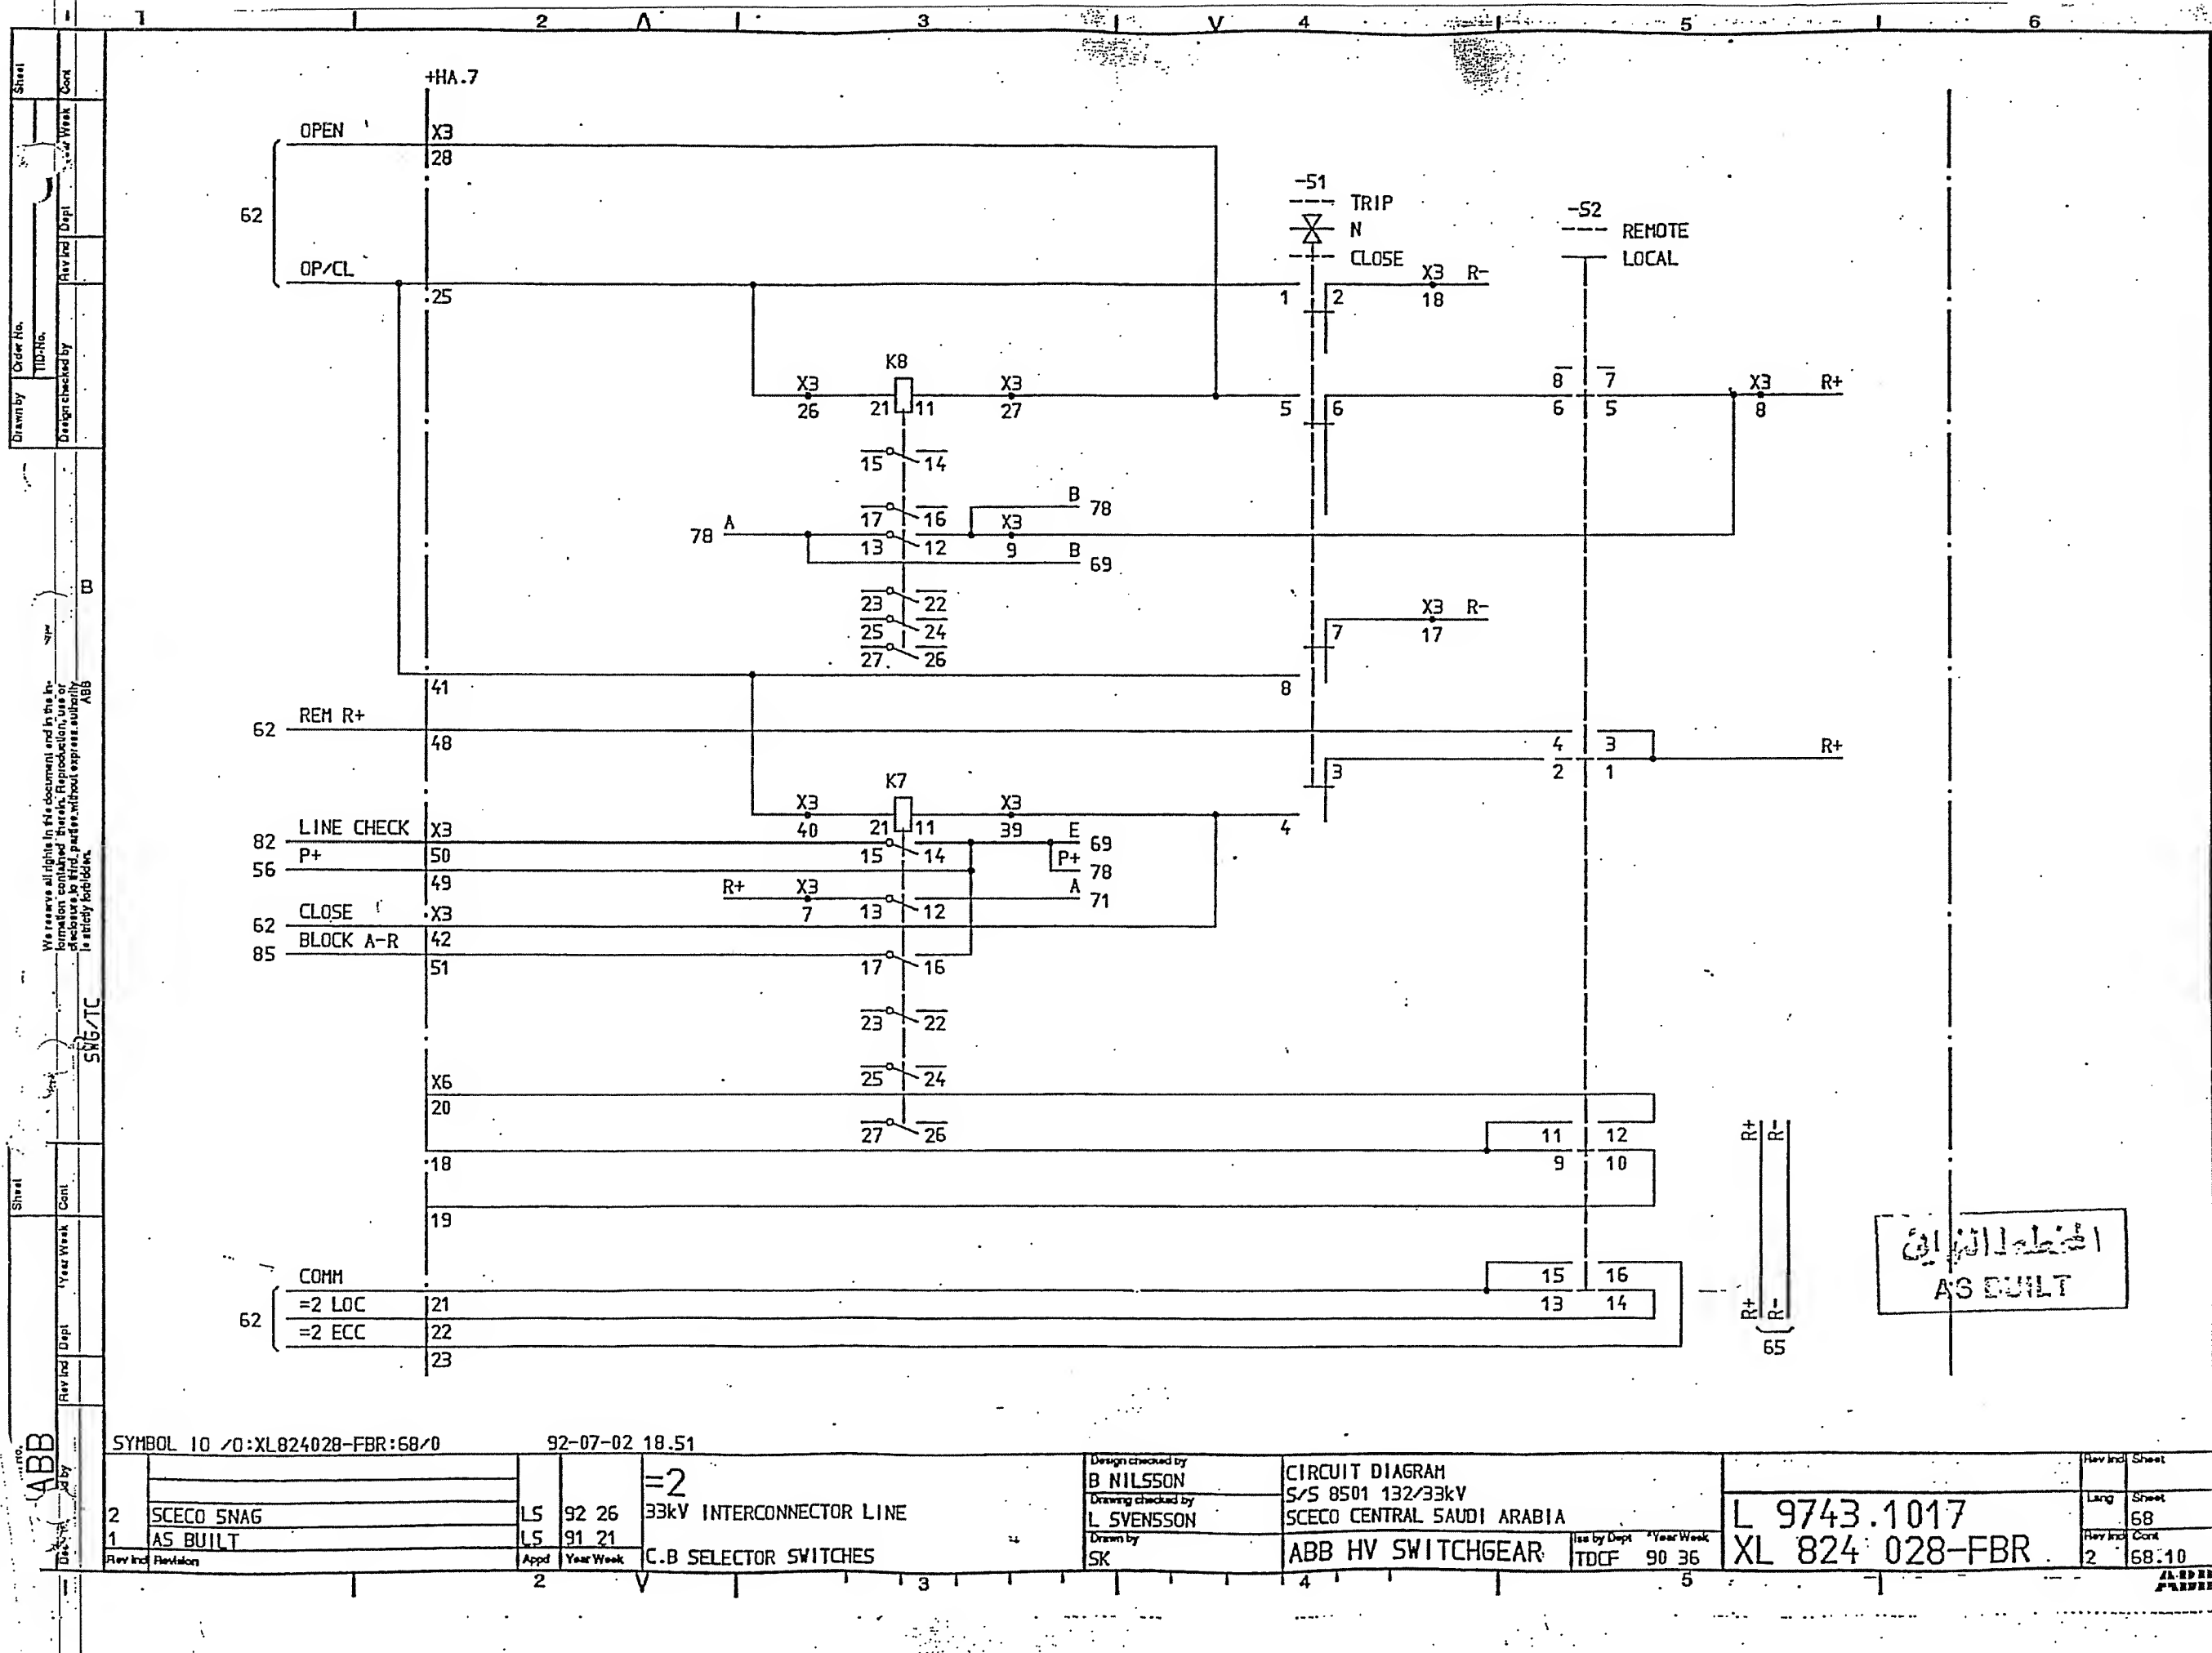L 9743.1017
XL 824 028-FBR





SYMBOL 10 /O:XL824028-FBR:68/0

92-07-02 18.51

| | | | | | |
|---------|------------|------|-----------|----|--------------------------|
| 2 | SCECO SNAG | LS | 92 26 | =2 | 33kV INTERCONNECTOR LINE |
| 1 | AS BUILT | LS | 91 21 | | |
| Rev Ind | Revision | Appd | Year Week | | C.B SELECTOR SWITCHES |


Design checked by
B NILSSON
Drawing checked by
L SVENSSON
Drawn by
SK

CIRCUIT DIAGRAM
S/S 8501 132/33kV
SCECO CENTRAL SAUDI ARABIA
ABB HV SWITCHGEAR

Iss by Dept
TDCF 90 36

L 9743.1017
XL 824 028-FBR

| | |
|---------|-------|
| Rev Ind | Sheet |
| Lang | Sheet |
| Rev Ind | Cont |
| 2 | 68.10 |

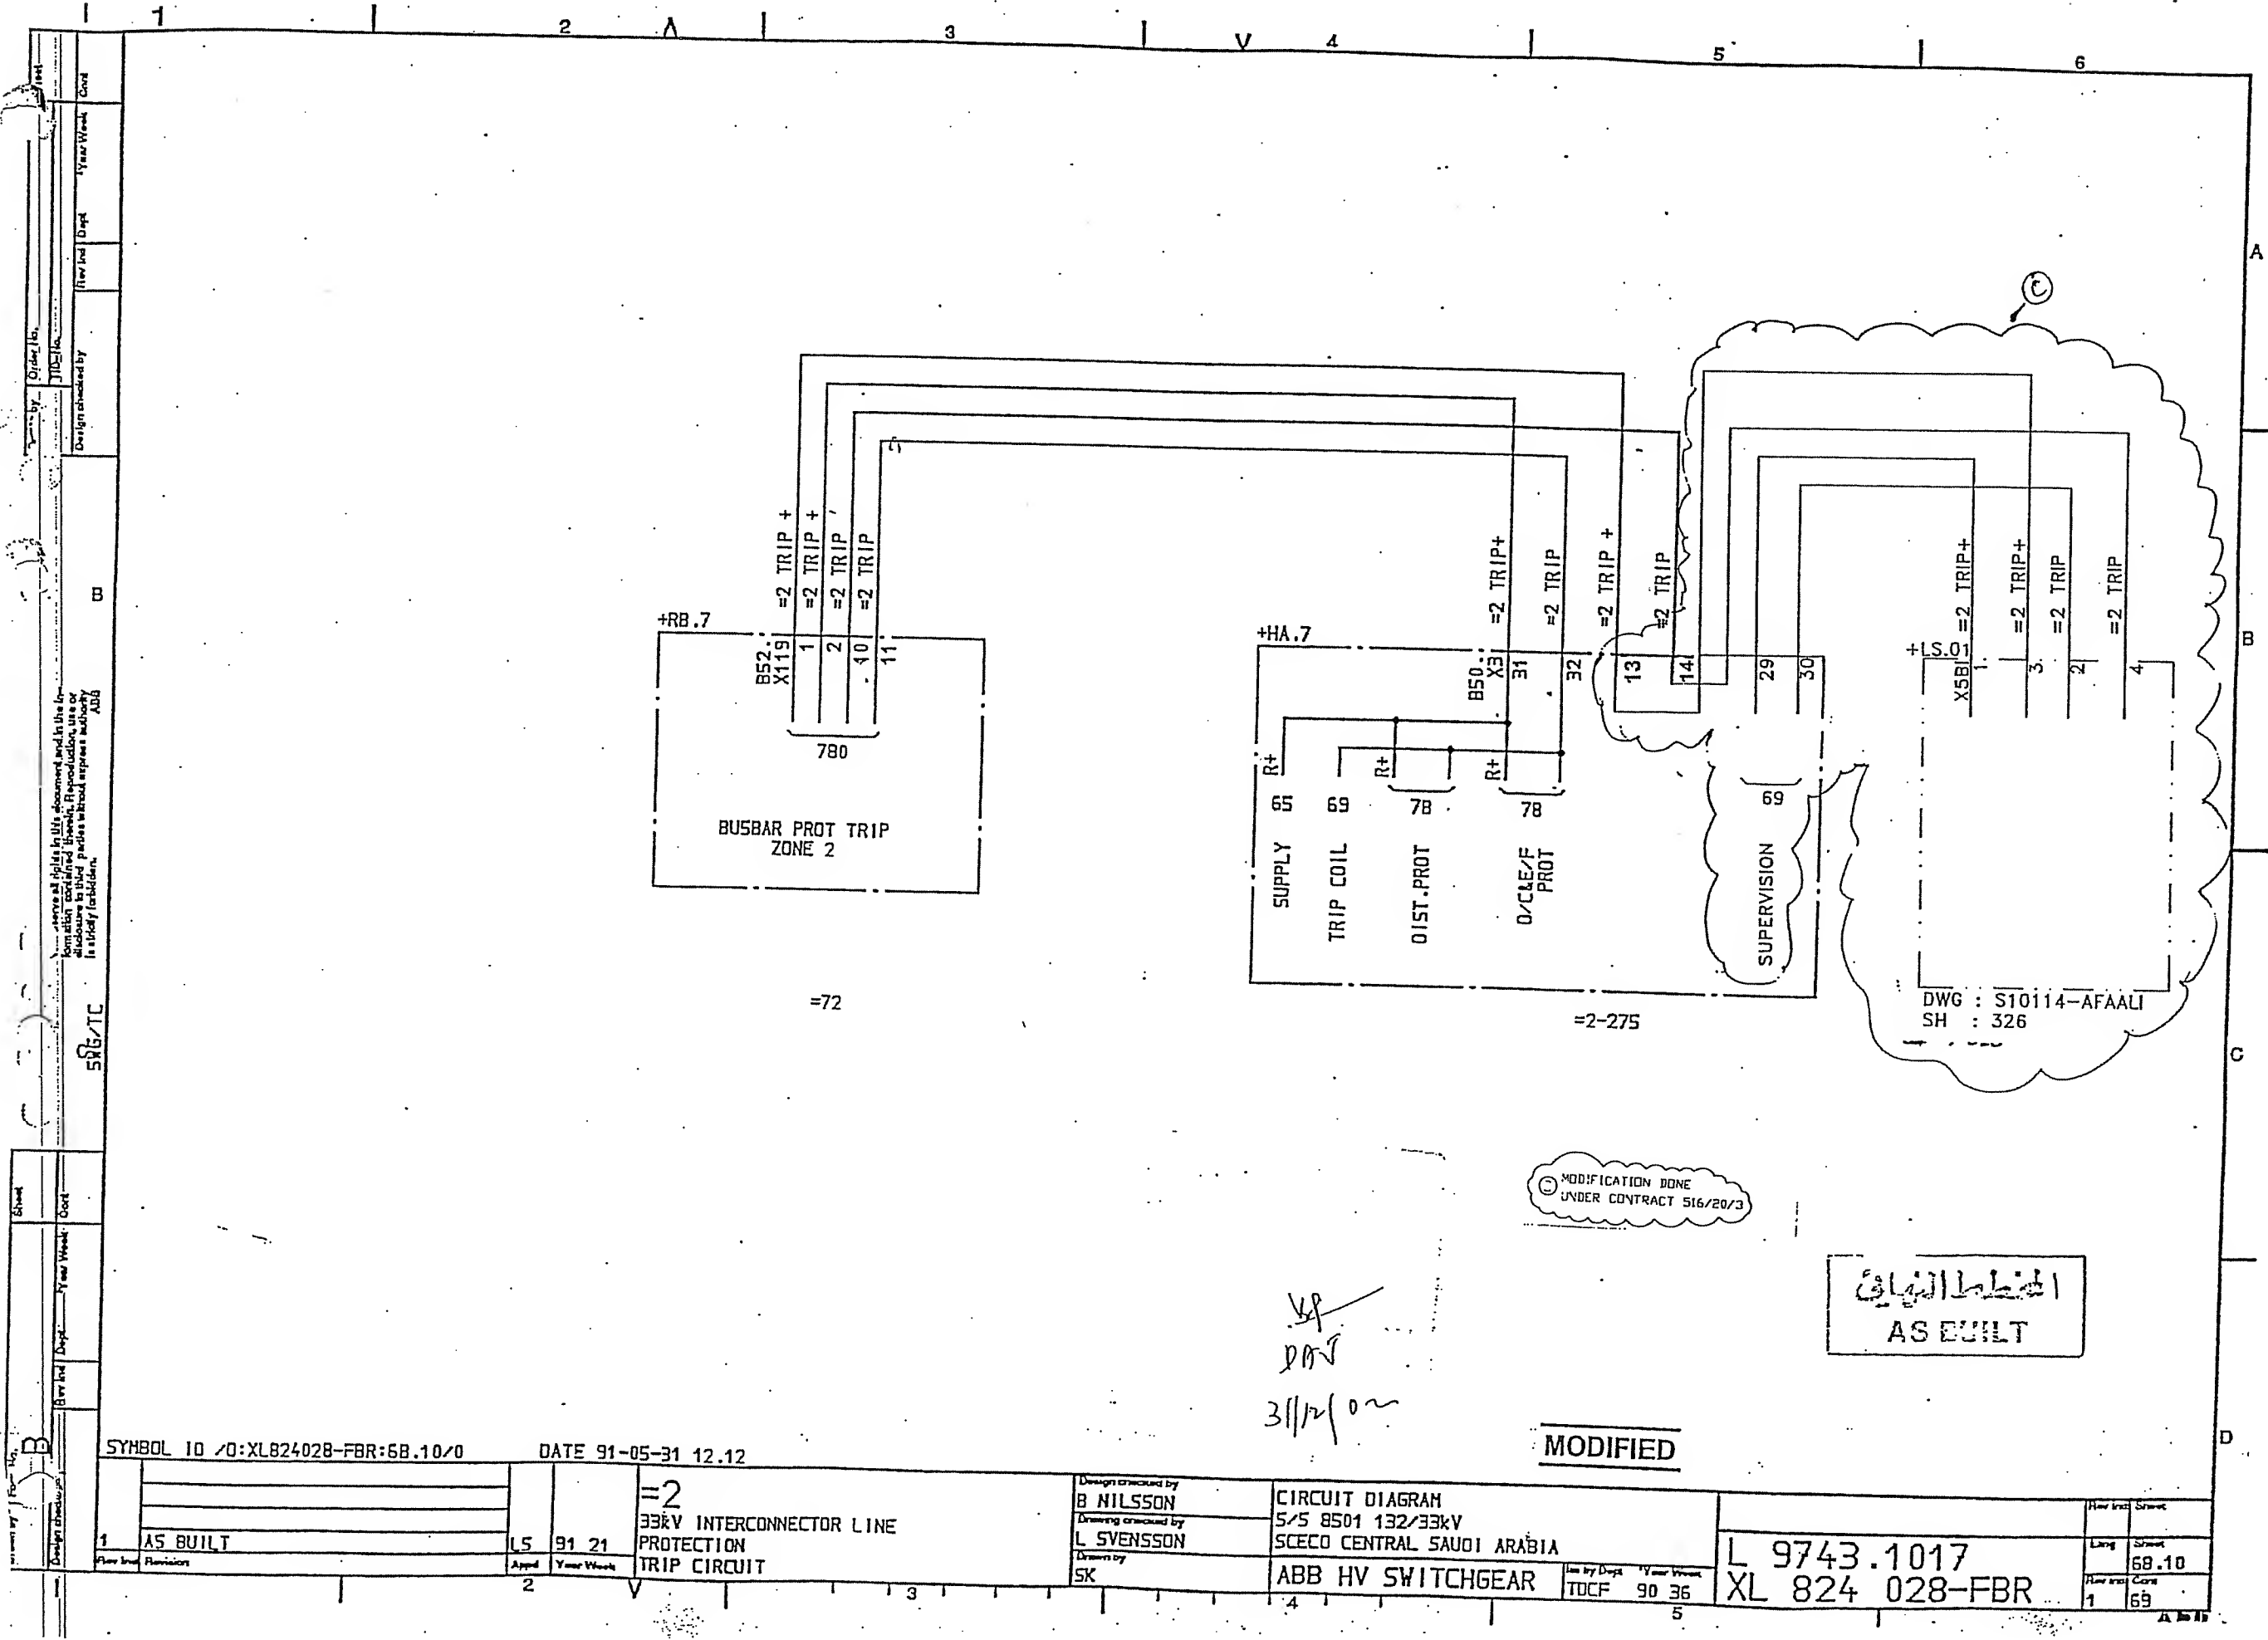

Design checked by: [Signature]
 Design approved by: [Signature]
 Year Week: [Blank]
 Date: [Blank]

SYMBOL ID: 0:XL824028-FBR:68.10/0

DATE 91-05-31 12.12

| Rev | Rev | Year Week | Appd | Year Week | Appd | Year Week |
|-----|----------|-----------|------|-----------|------|-----------|
| 1 | AS BUILT | LS | 91 | 21 | | |
| 2 | | | | | | |

=2
 33kV INTERCONNECTOR LINE
 PROTECTION
 TRIP CIRCUIT

Design checked by:
 B NILSSON
 Drawing checked by:
 L SVENSSON
 Drawn by:
 SK

CIRCUIT DIAGRAM
 5/5 8501 132/33kV
 SCECO CENTRAL SAUDI ARABIA
 ABB HV SWITCHGEAR
 TDCF 90 36


L 9743.1017
 XL 824 028-FBR


| Rev | Rev | Year Week | Appd | Year Week | Appd | Year Week |
|-----|-------|-----------|------|-----------|------|-----------|
| 1 | 68.10 | | | | | |
| 2 | 69 | | | | | |

MODIFICATION DONE
 UNDER CONTRACT 516/20/3

AS BUILT

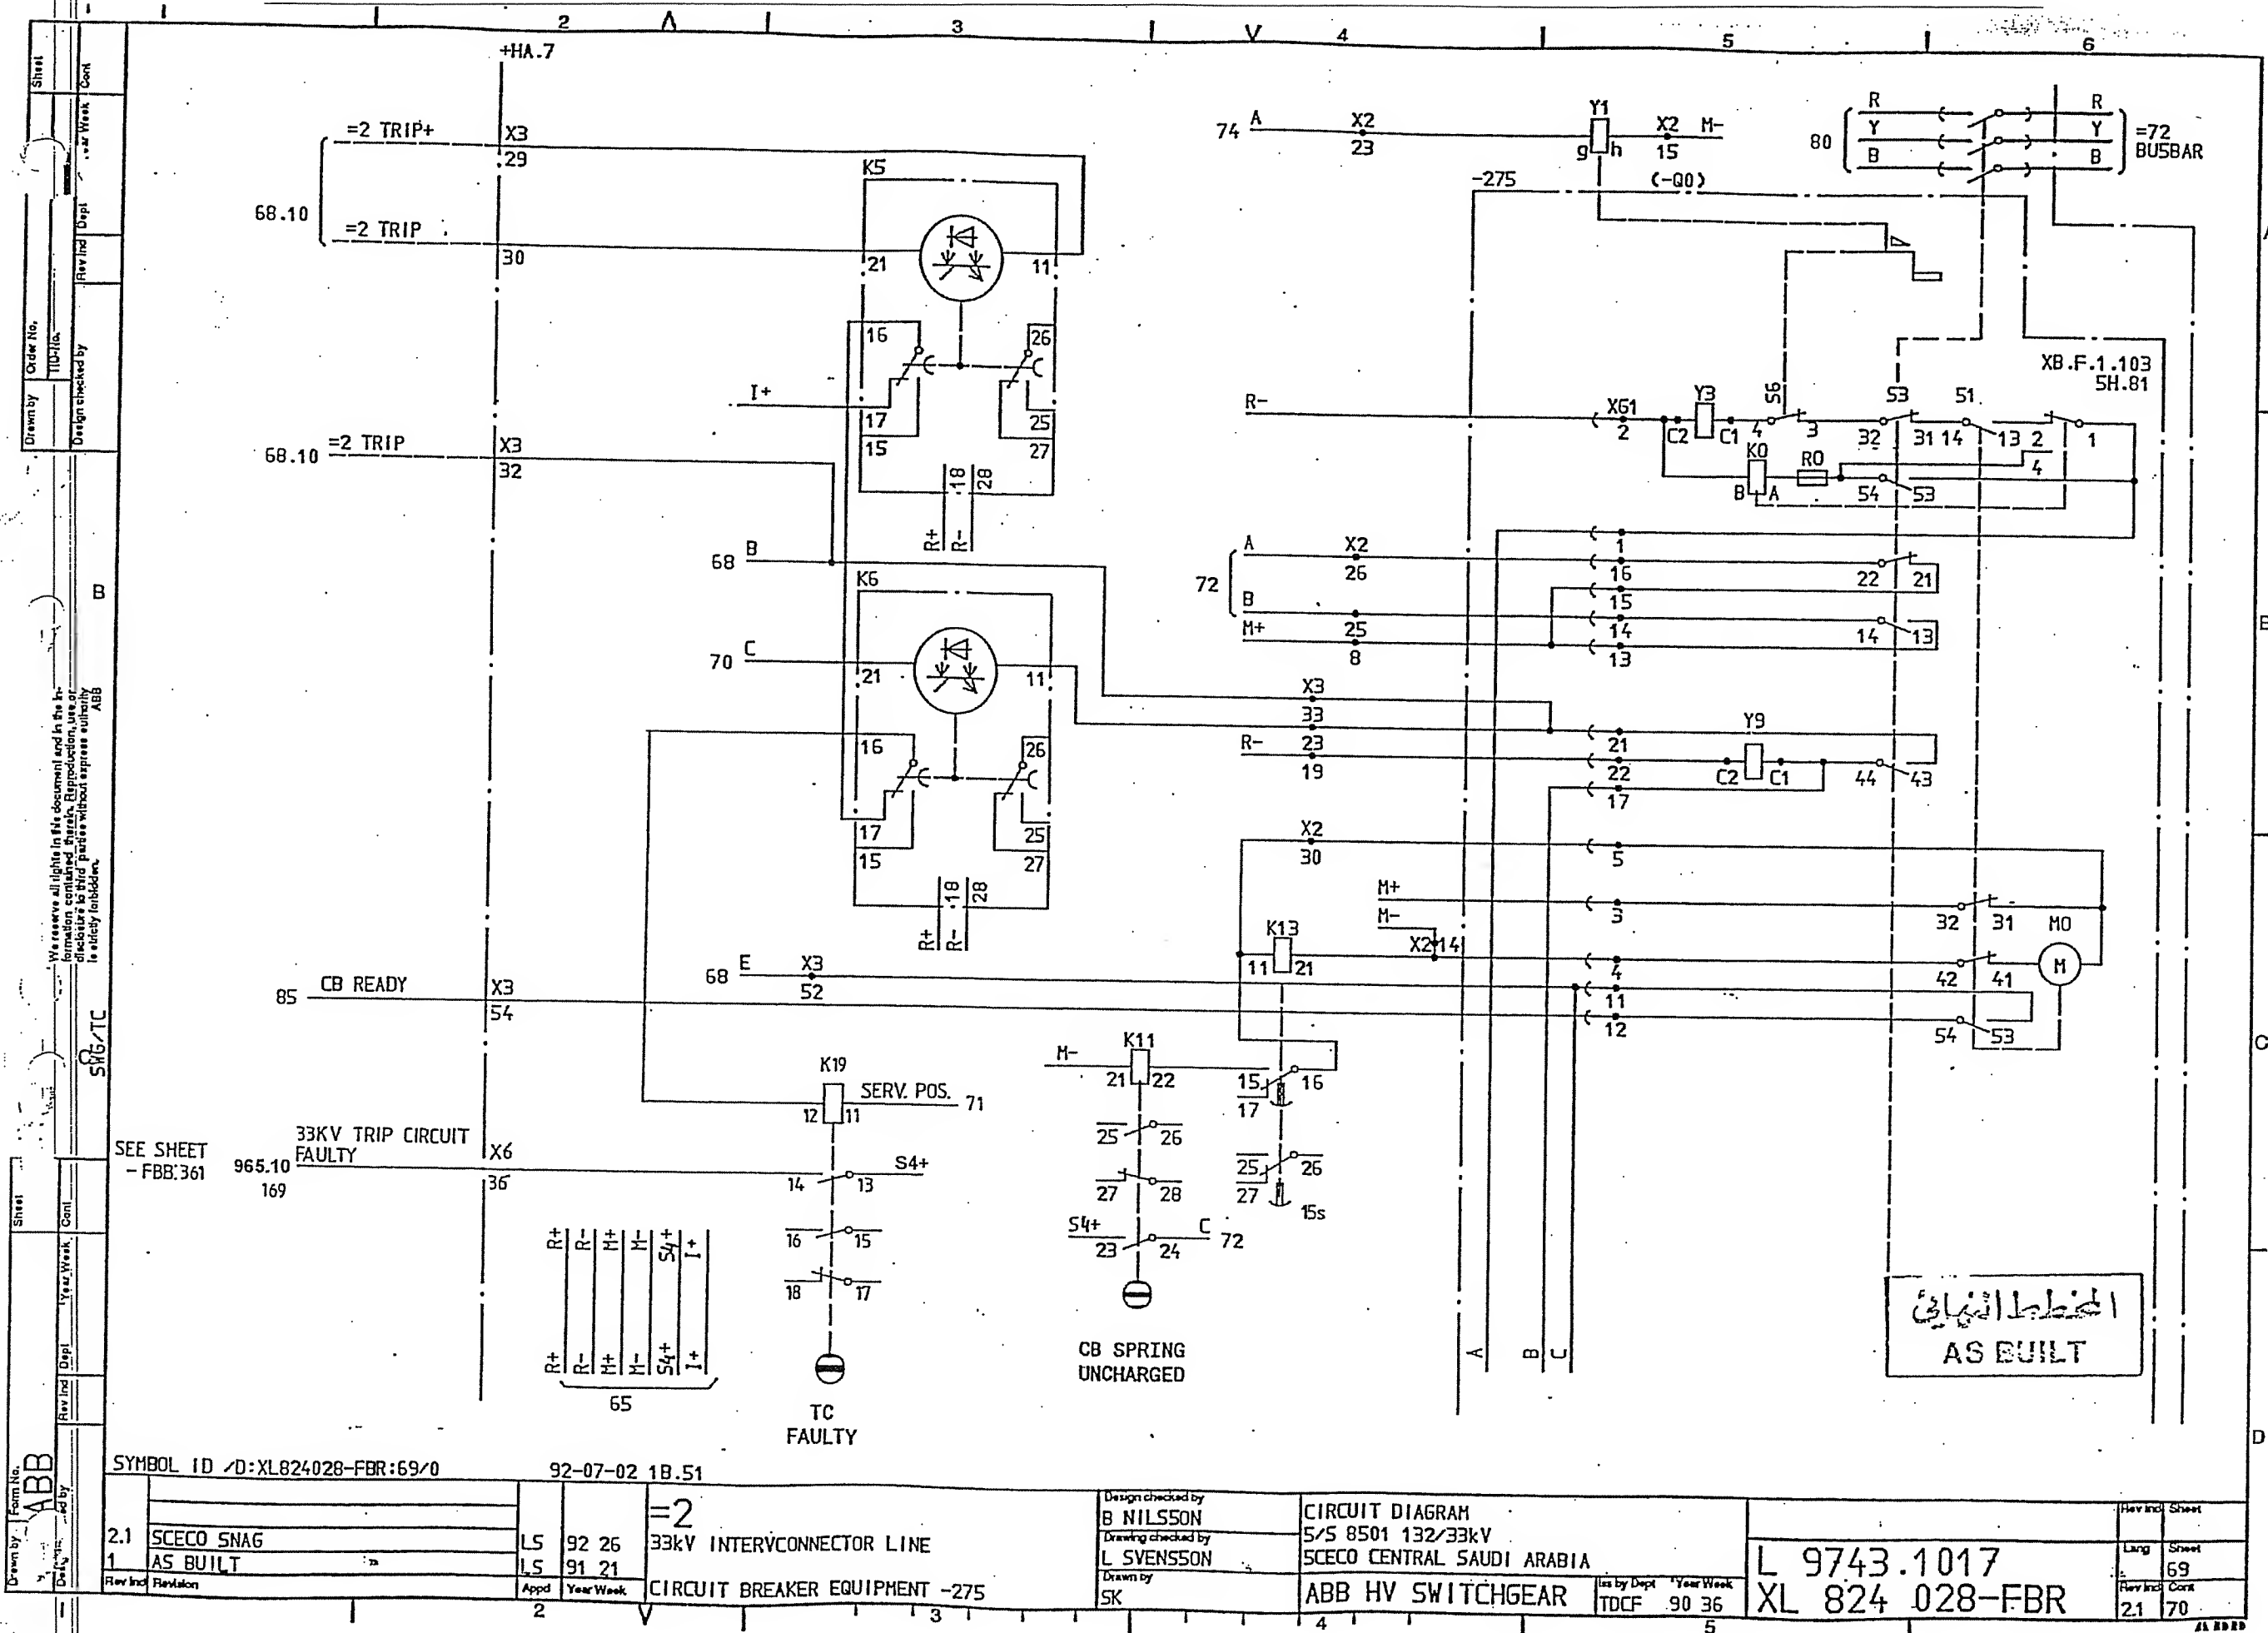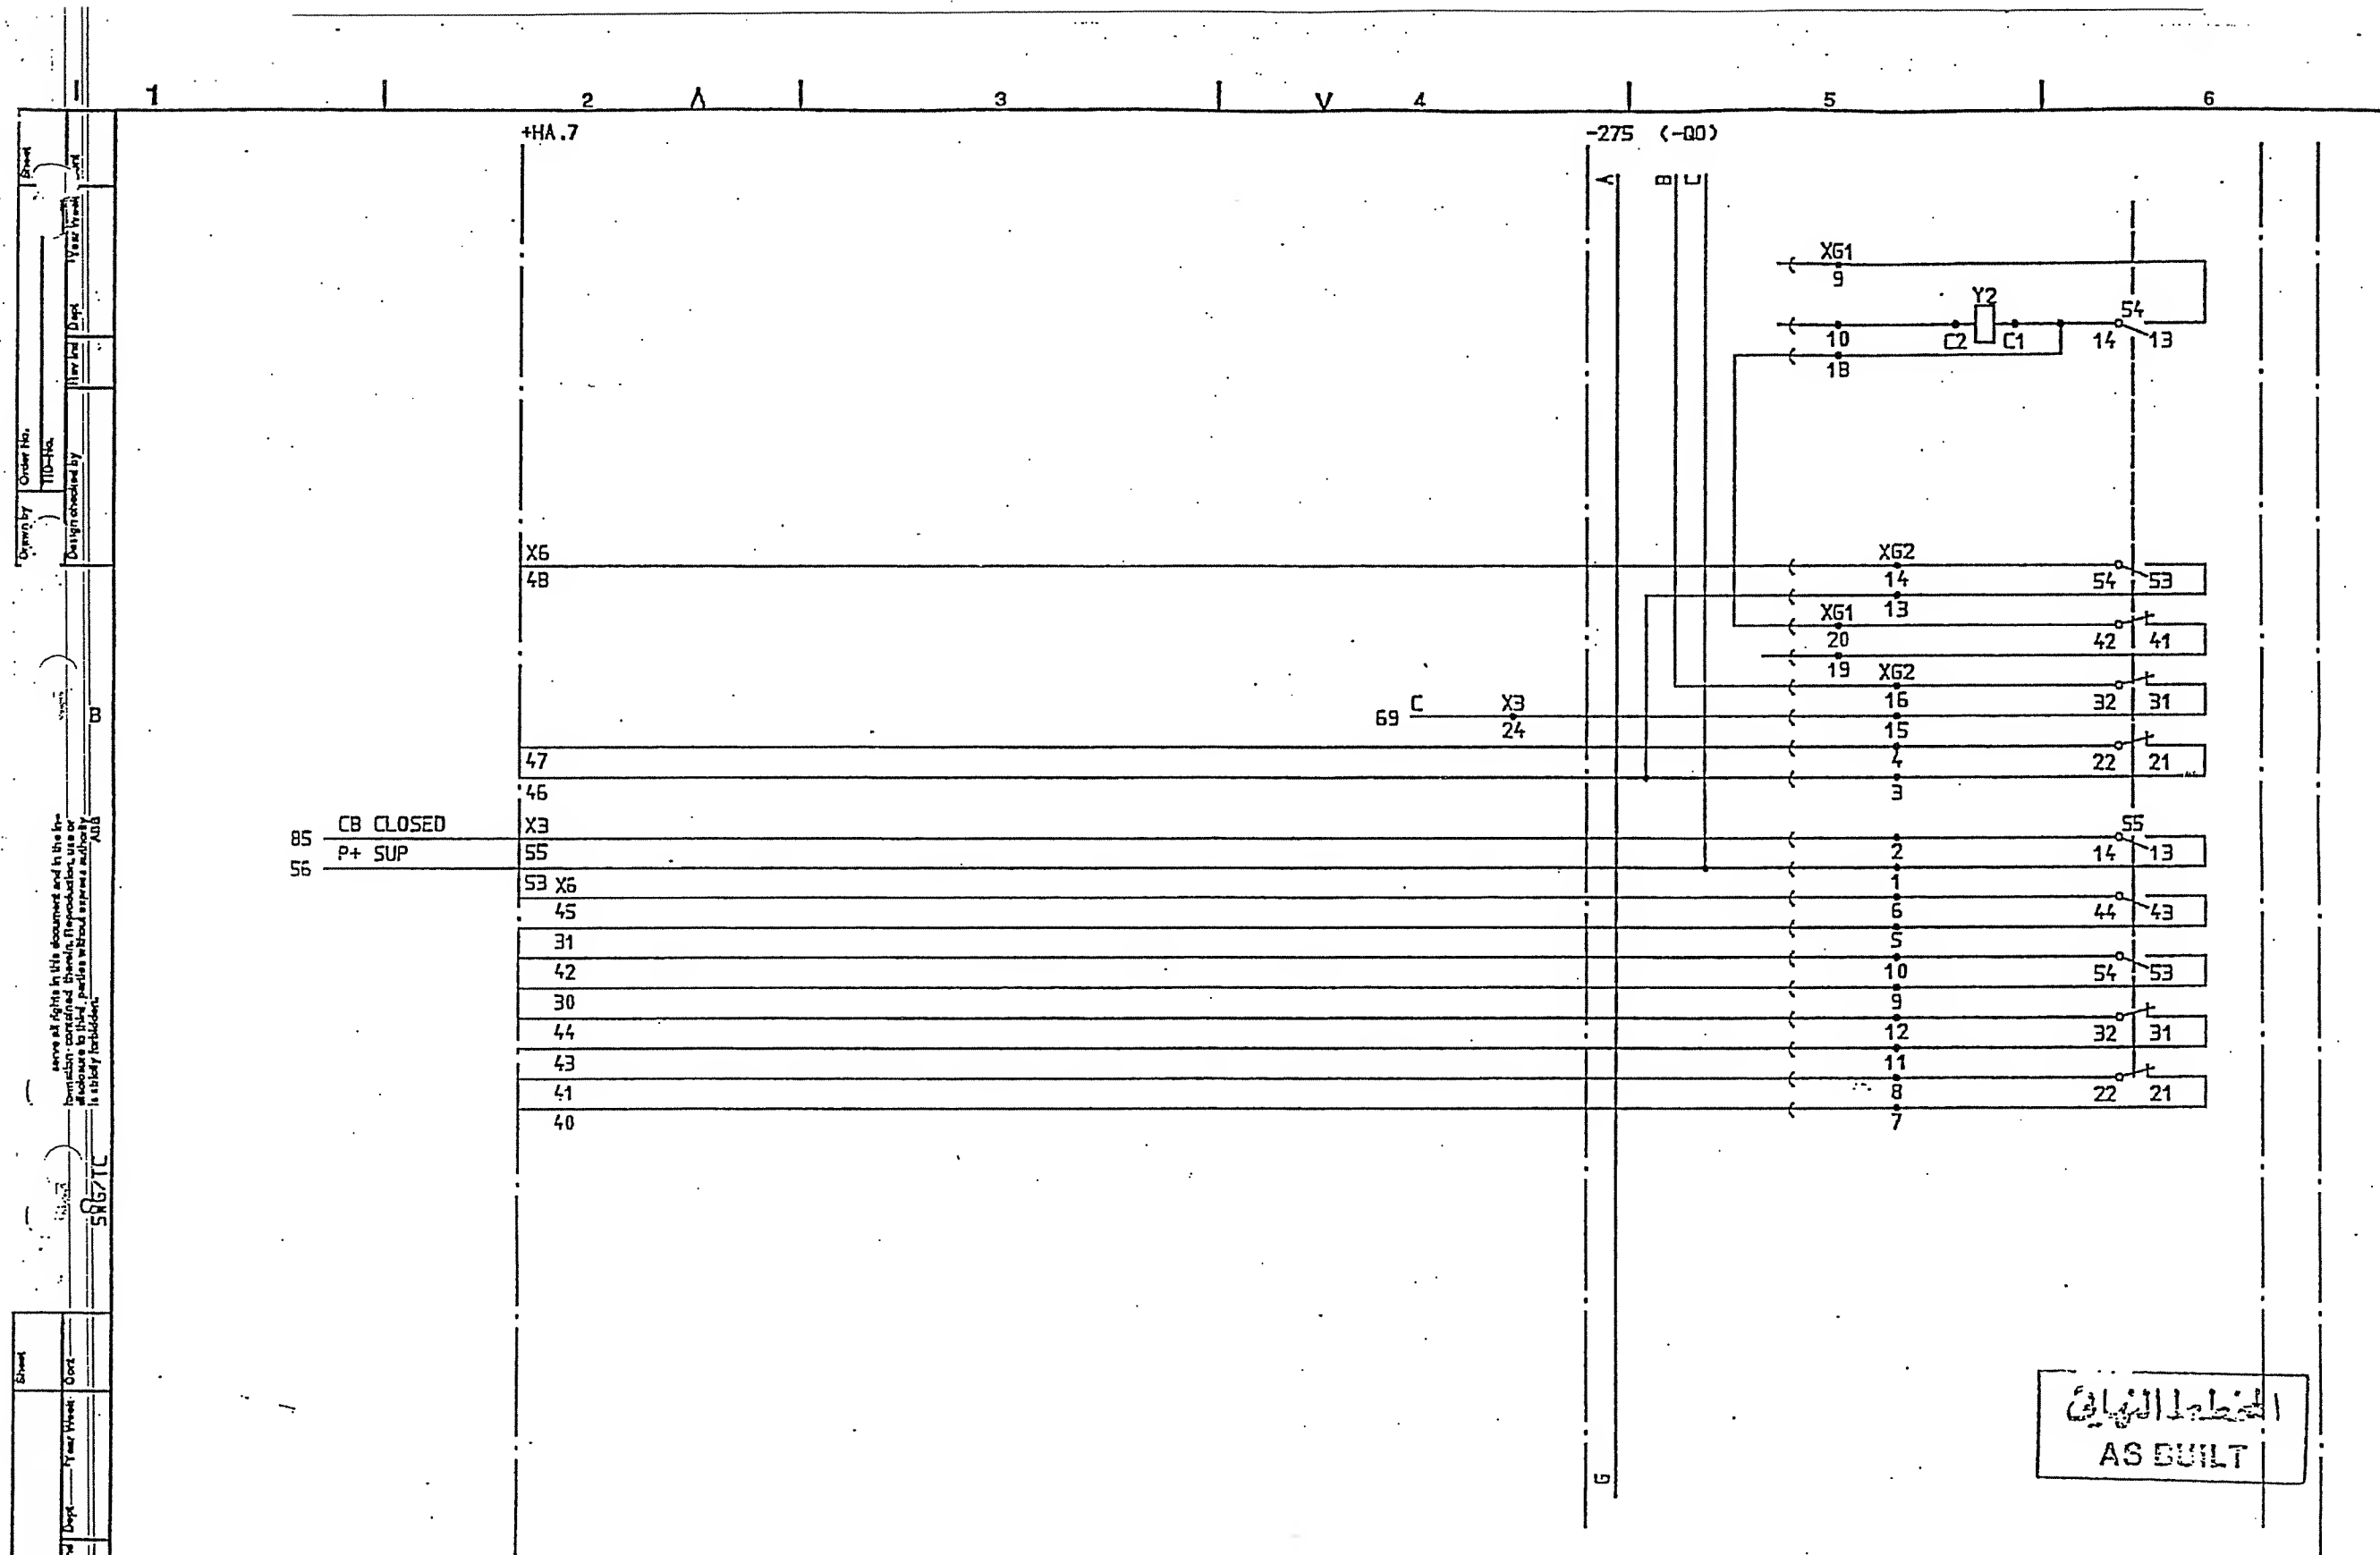3/12/02






الخط المخطط
AS BUILT


SYMBOL ID /D:XL824028-FBR:70/0

DATE 91-05-31 12.12

| | | | | | | | |
|---------------|-------------|--------------------------------|--|--|-------------------------------|----------|-------------|
| 1 AS BUILT | 15 91 21 | =2 33kV INTERCONNECTOR LINE | Design checked by B NILSSON Drawing checked by L SVENSSON Drawn by SK | CIRCUIT DIAGRAM S/S 8501 132/33kV SCECO CENTRAL SAUDI ARABIA | L 9743.1017 XL 824 028-FBR | Rev 1 | Sheet 70 |
| 1 AS BUILT | 15 91 21 | CIRCUIT BREAKER EQUIPMENT -275 | SK | ABB HV SWITCHGEAR TDCF 90 36 | L 9743.1017 XL 824 028-FBR | Rev 1 | Sheet 71 |

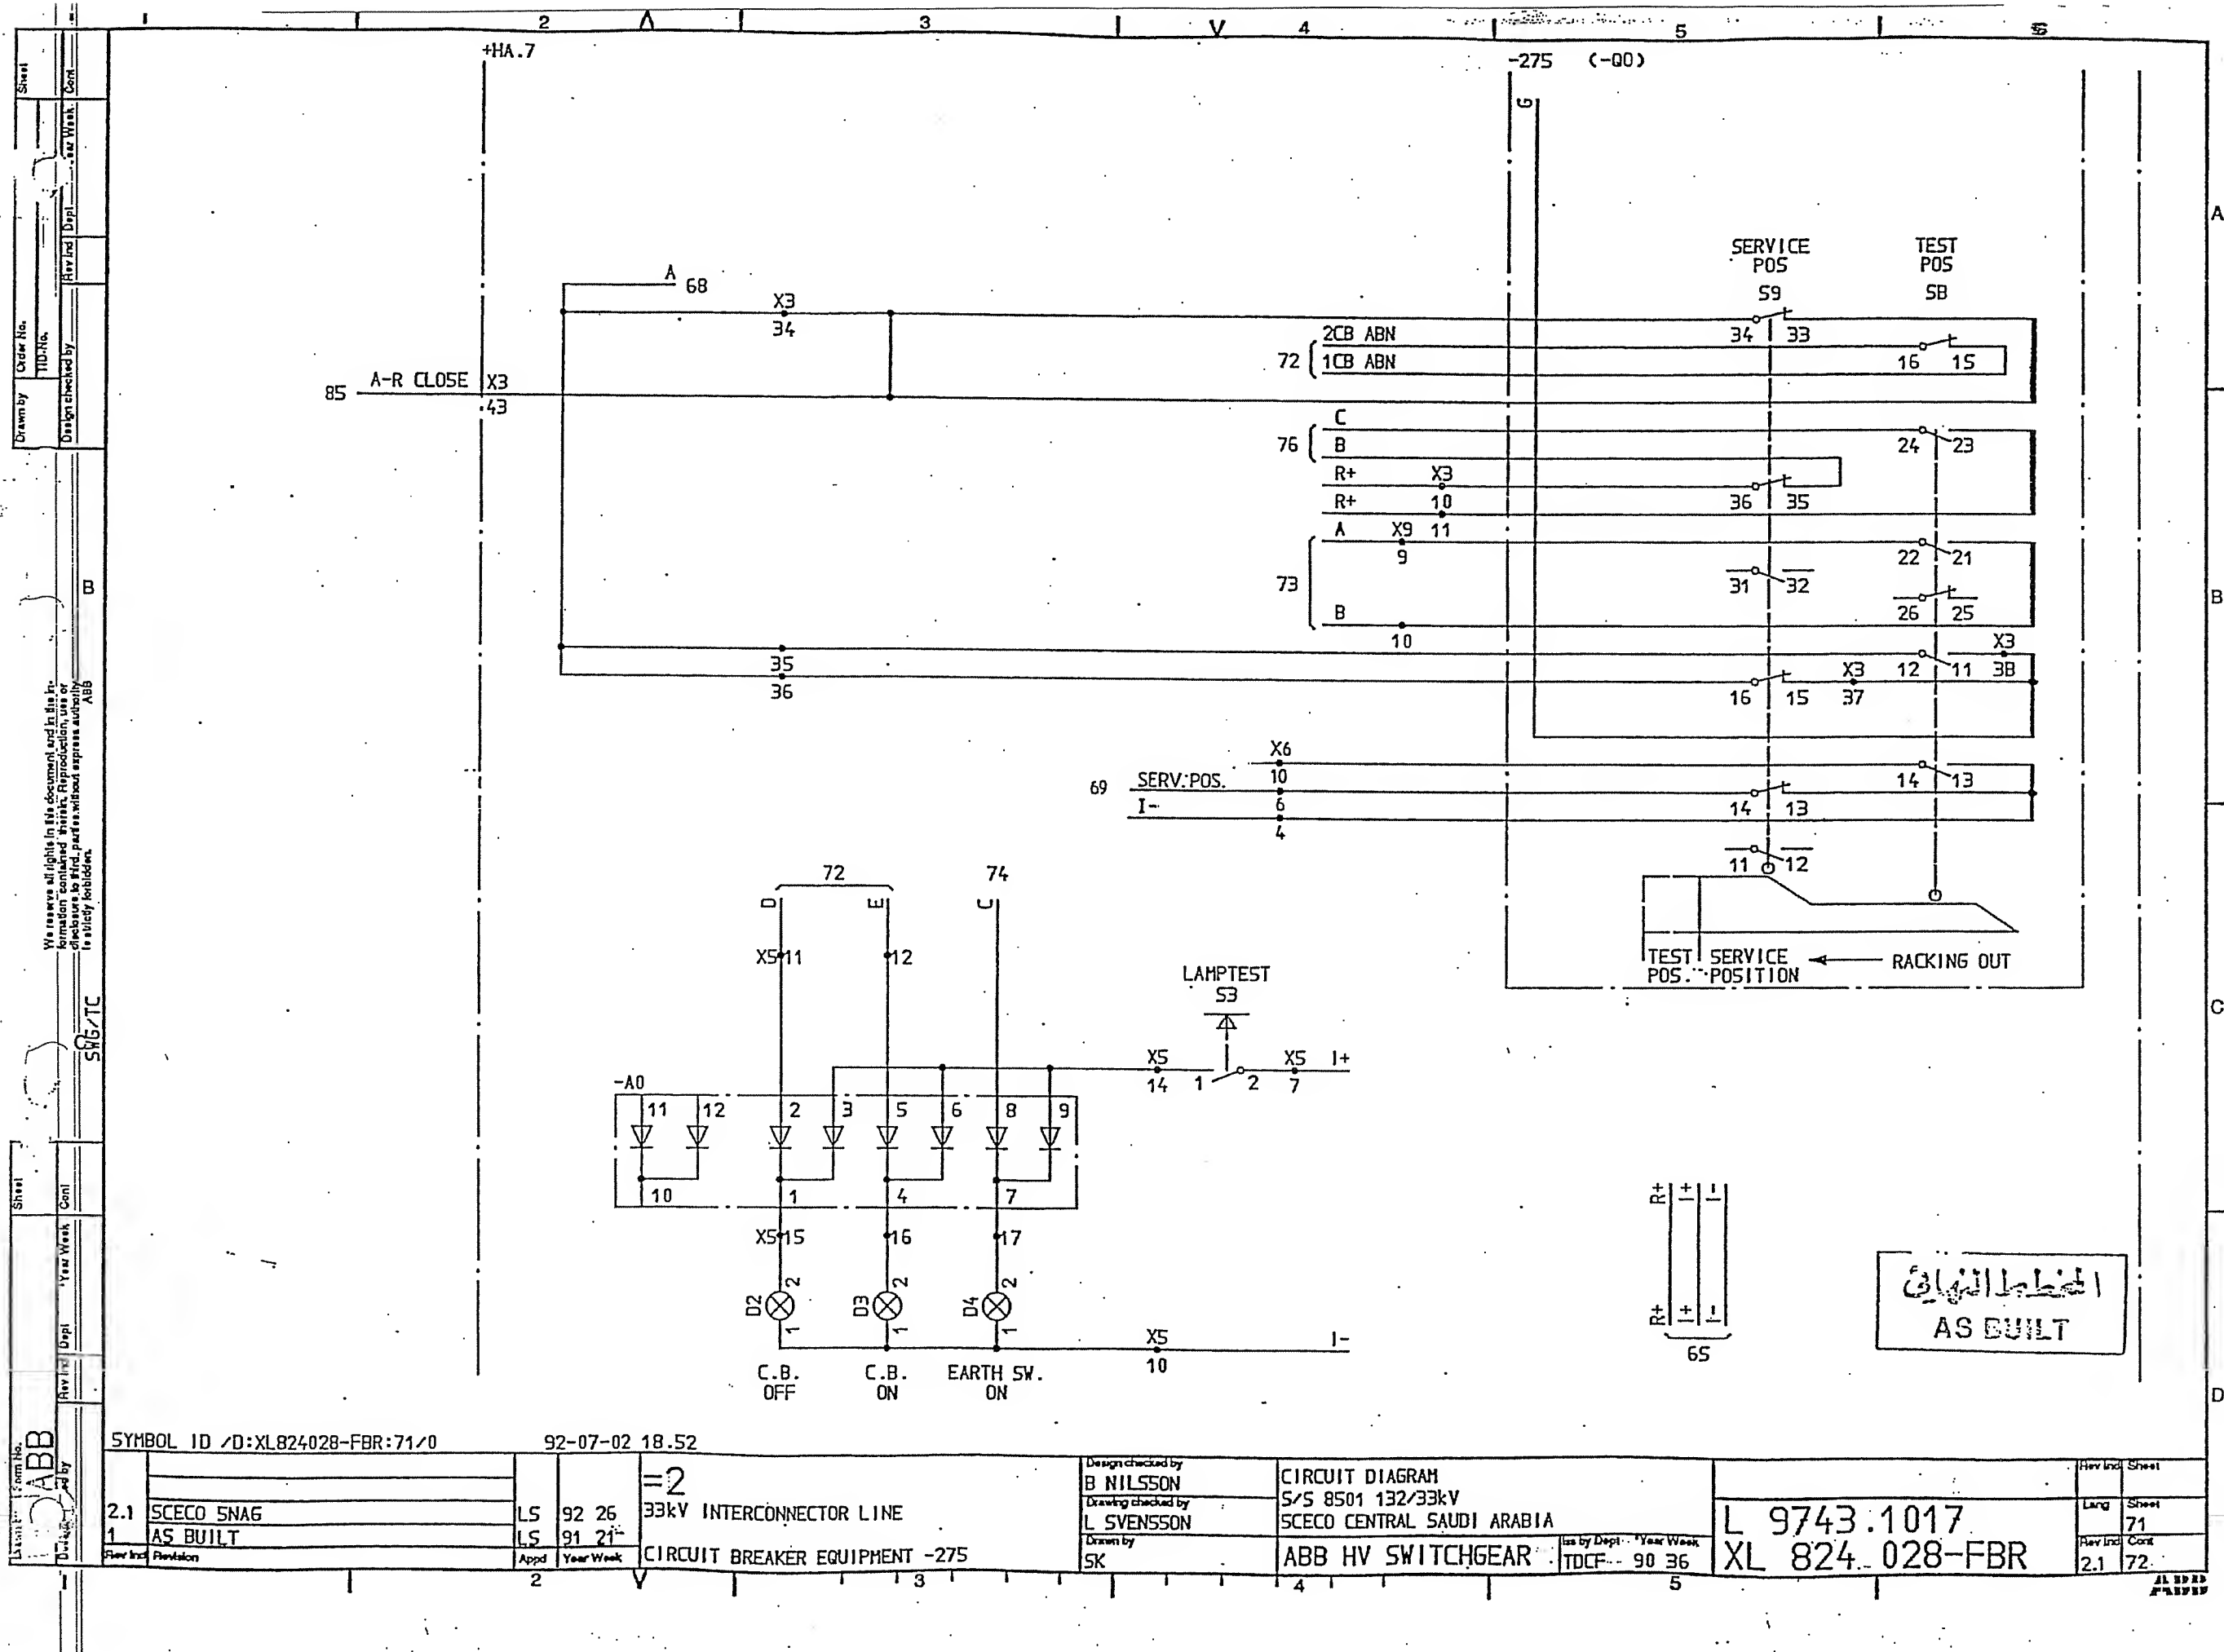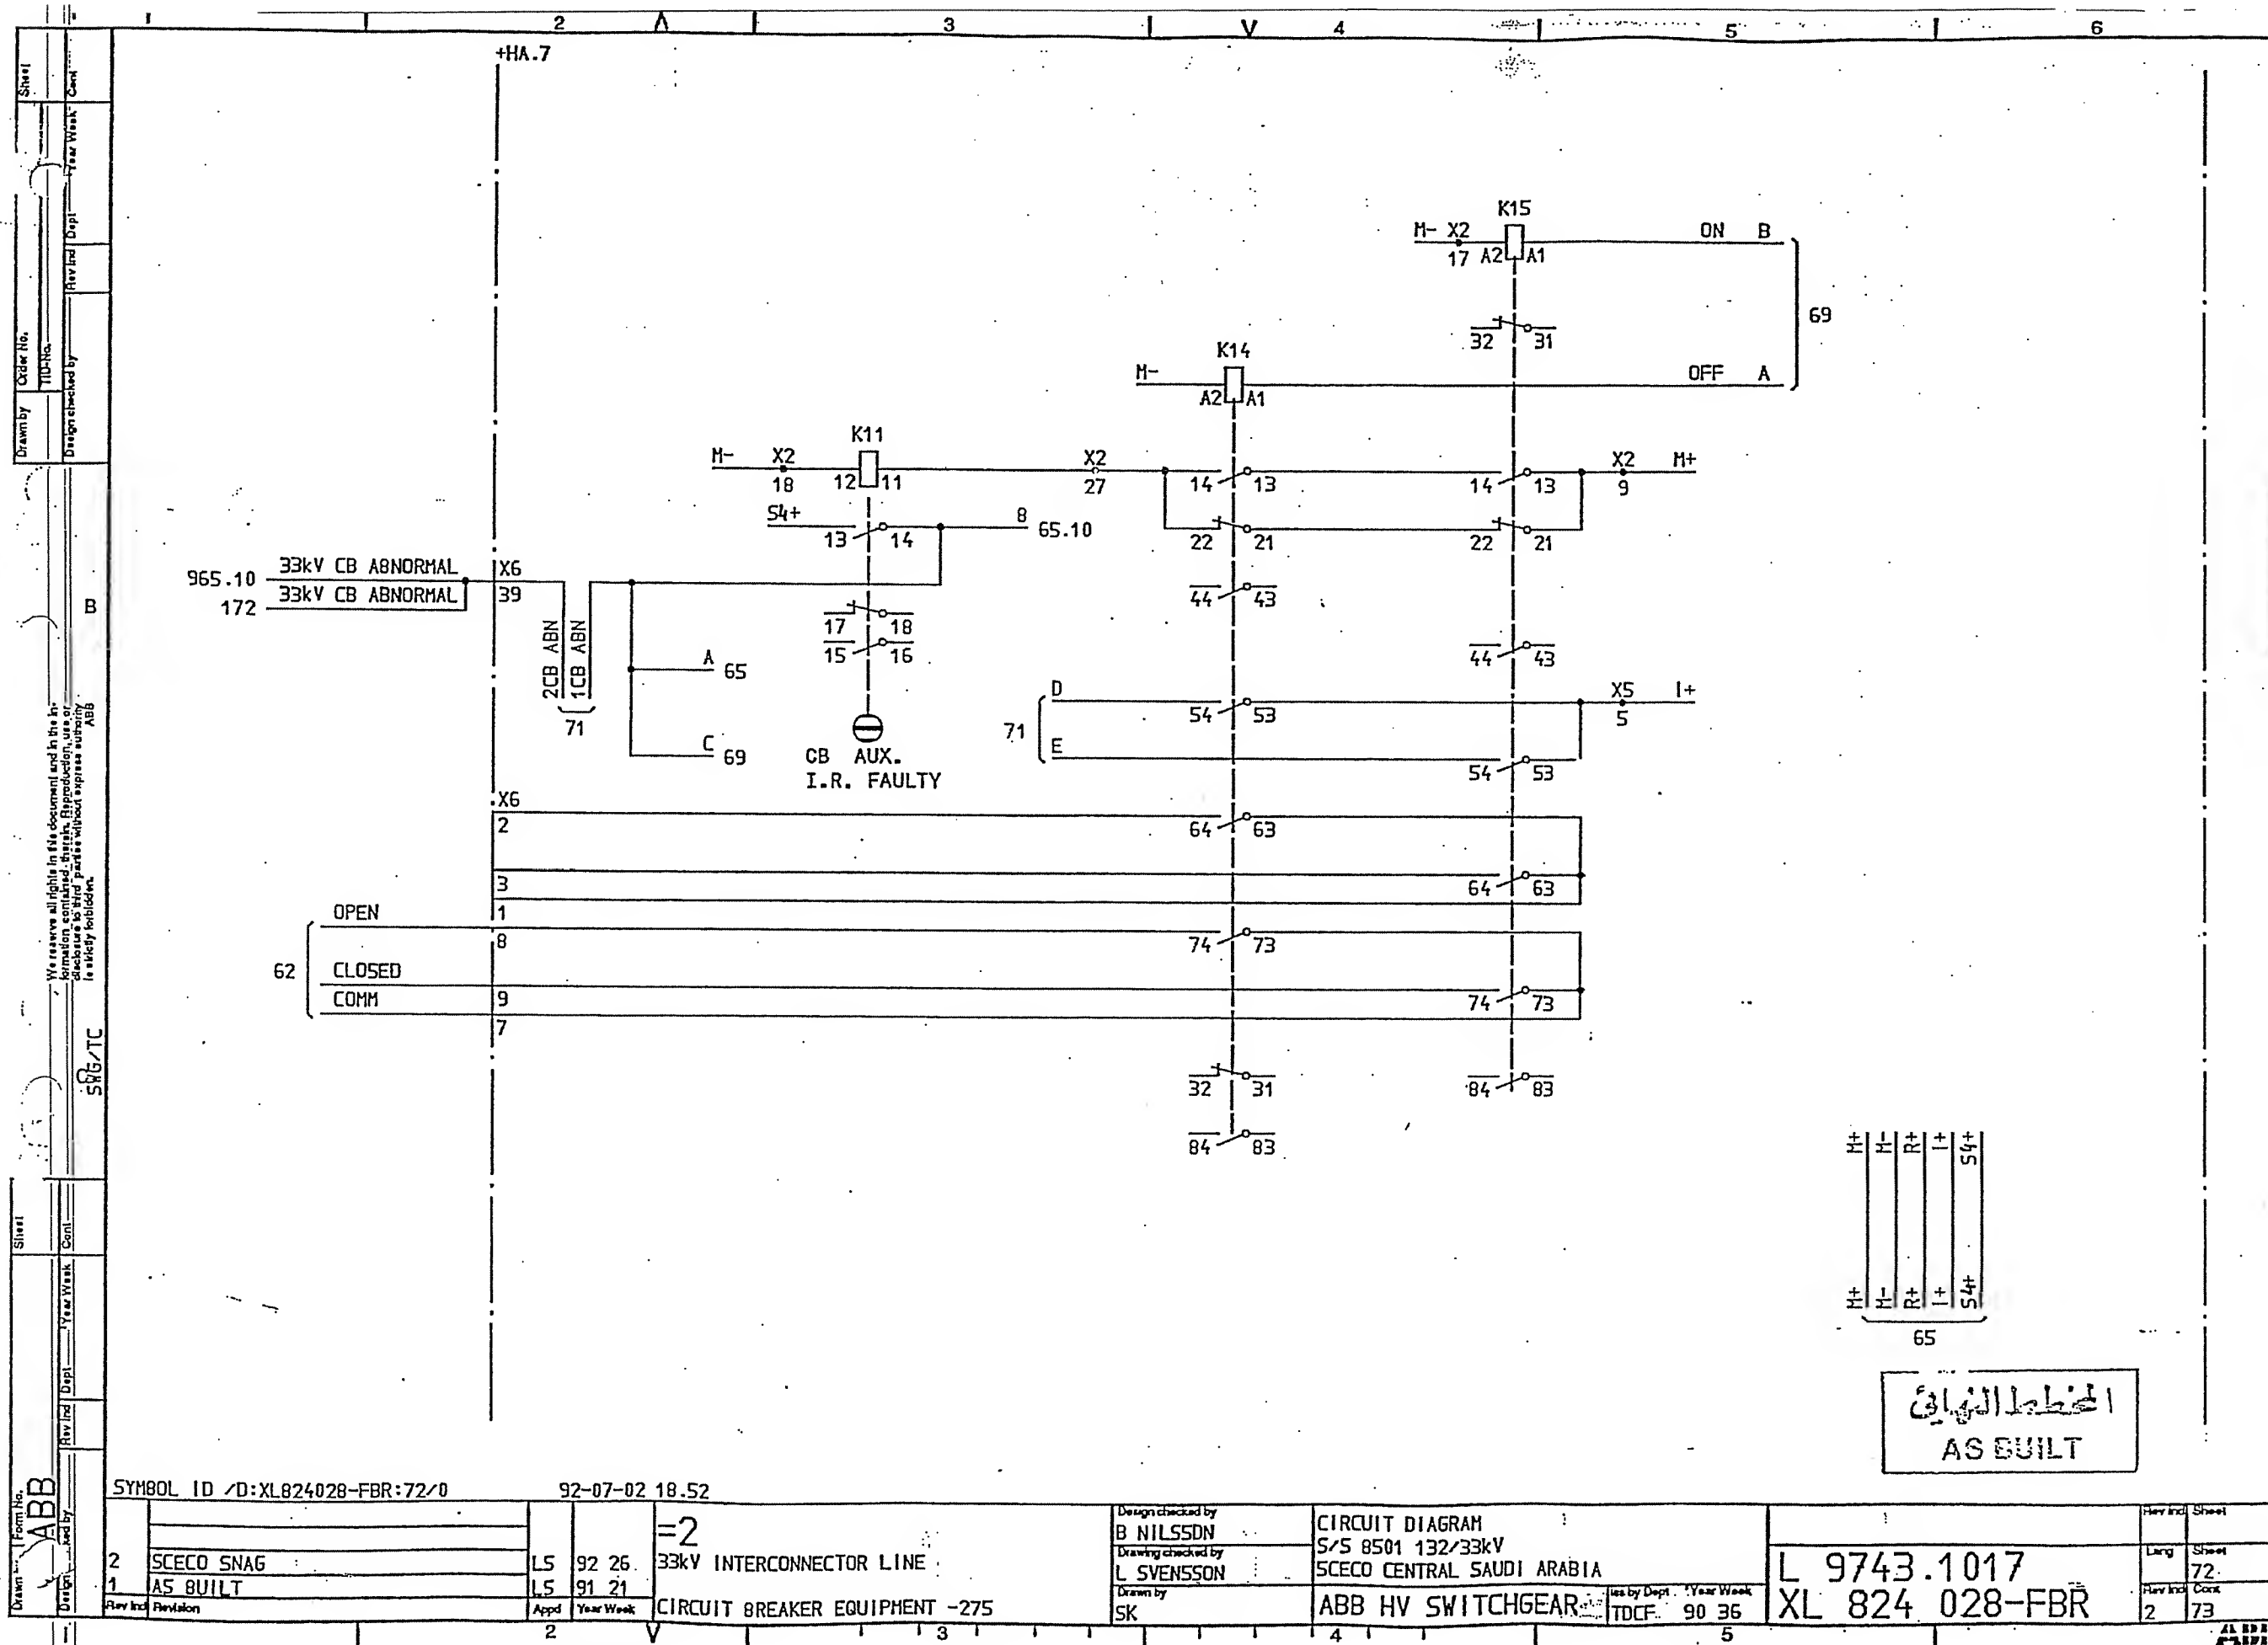ABB





المخطط النهائي
AS BUILT

SYMBOL ID /D:XL824028-FBR:72/0

92-07-02 18.52

| | | | | | |
|-----|------------|----------|-------|-----------|--------------------------------|
| 2 | SCECO SNAG | LS | 92 26 | =2 | 33kV INTERCONNECTOR LINE |
| 1 | AS BUILT | LS | 91 21 | | |
| Rev | Ind | Revision | Appd | Year Week | CIRCUIT BREAKER EQUIPMENT -275 |
| 2 | | | | | |

Design checked by
B NILSSON
Drawing checked by
L SVENSSON
Drawn by
SK


CIRCUIT DIAGRAM
S/S 8501 132/33kV
SCECO CENTRAL SAUDI ARABIA
ABB HV SWITCHGEAR

Iss by Dept Year Week
TDCF 90 36

L 9743.1017
XL 824 028-FBR

| | | |
|-----|-----|-------|
| Rev | Ind | Sheet |
| 2 | | 72 |
| | | 73 |

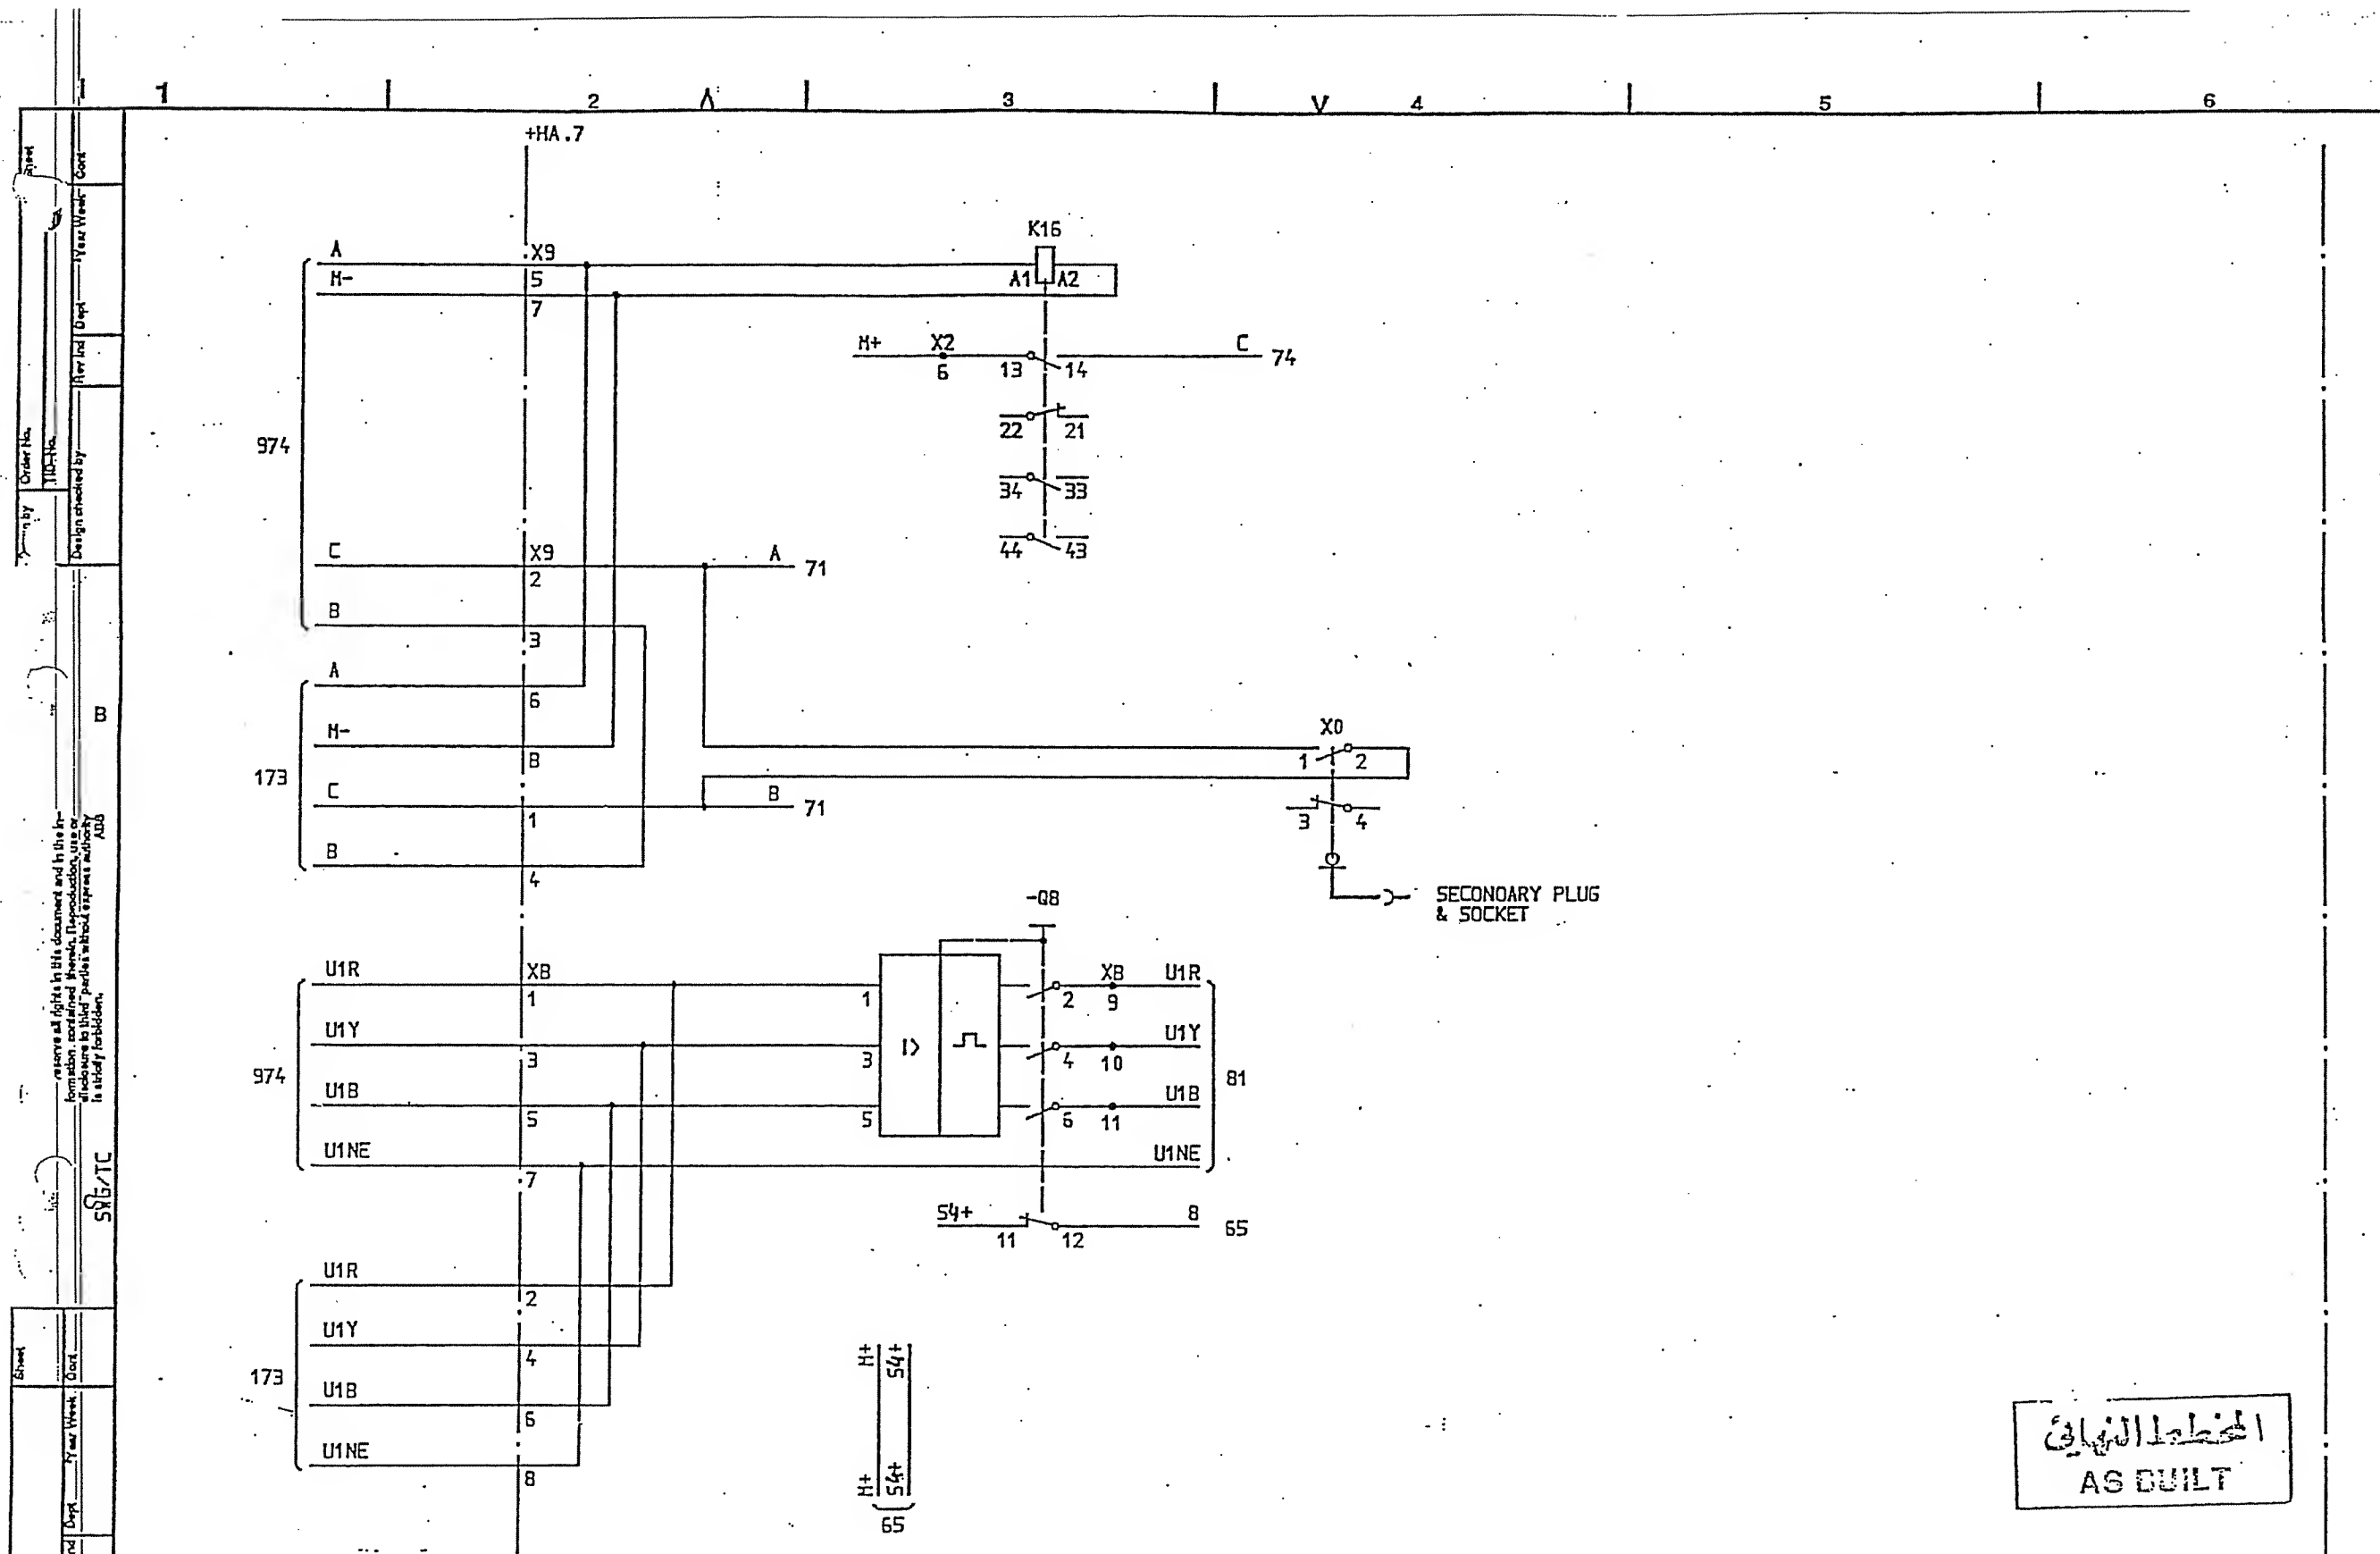
ALBID




المخطط النهائي
AS BUILT

| | | | | | | | | | |
|--------------------------------|--|--------------------------|--|-----------------------------------|--|--|--|---------------|--|
| SYMBOL ID /D:XL824028-FBR:73/0 | | DATE 91-06-06 10.02 | | Design checked by B NILSSON | | CIRCUIT DIAGRAM S/S 8501 132/33kV SCECO CENTRAL SAUDI ARABIA | | Rev Int Sheet | |
| =2 | | 33kV INTERCONNECTOR LINE | | Drawing checked by L SVENSSON | | L 9743.1017 | | Living Sheet | |
| 1 AS BUILT | | L5 91 21 | | INTERLOCKING RELAY FOR C.B. TRUCK | | ABB HV SWITCHGEAR | | Rev Int Sheet | |
| 2 | | V | | SK | | TDCF 90 36 | | 1 73 | |
| | | | | | | | | 1 74 | |

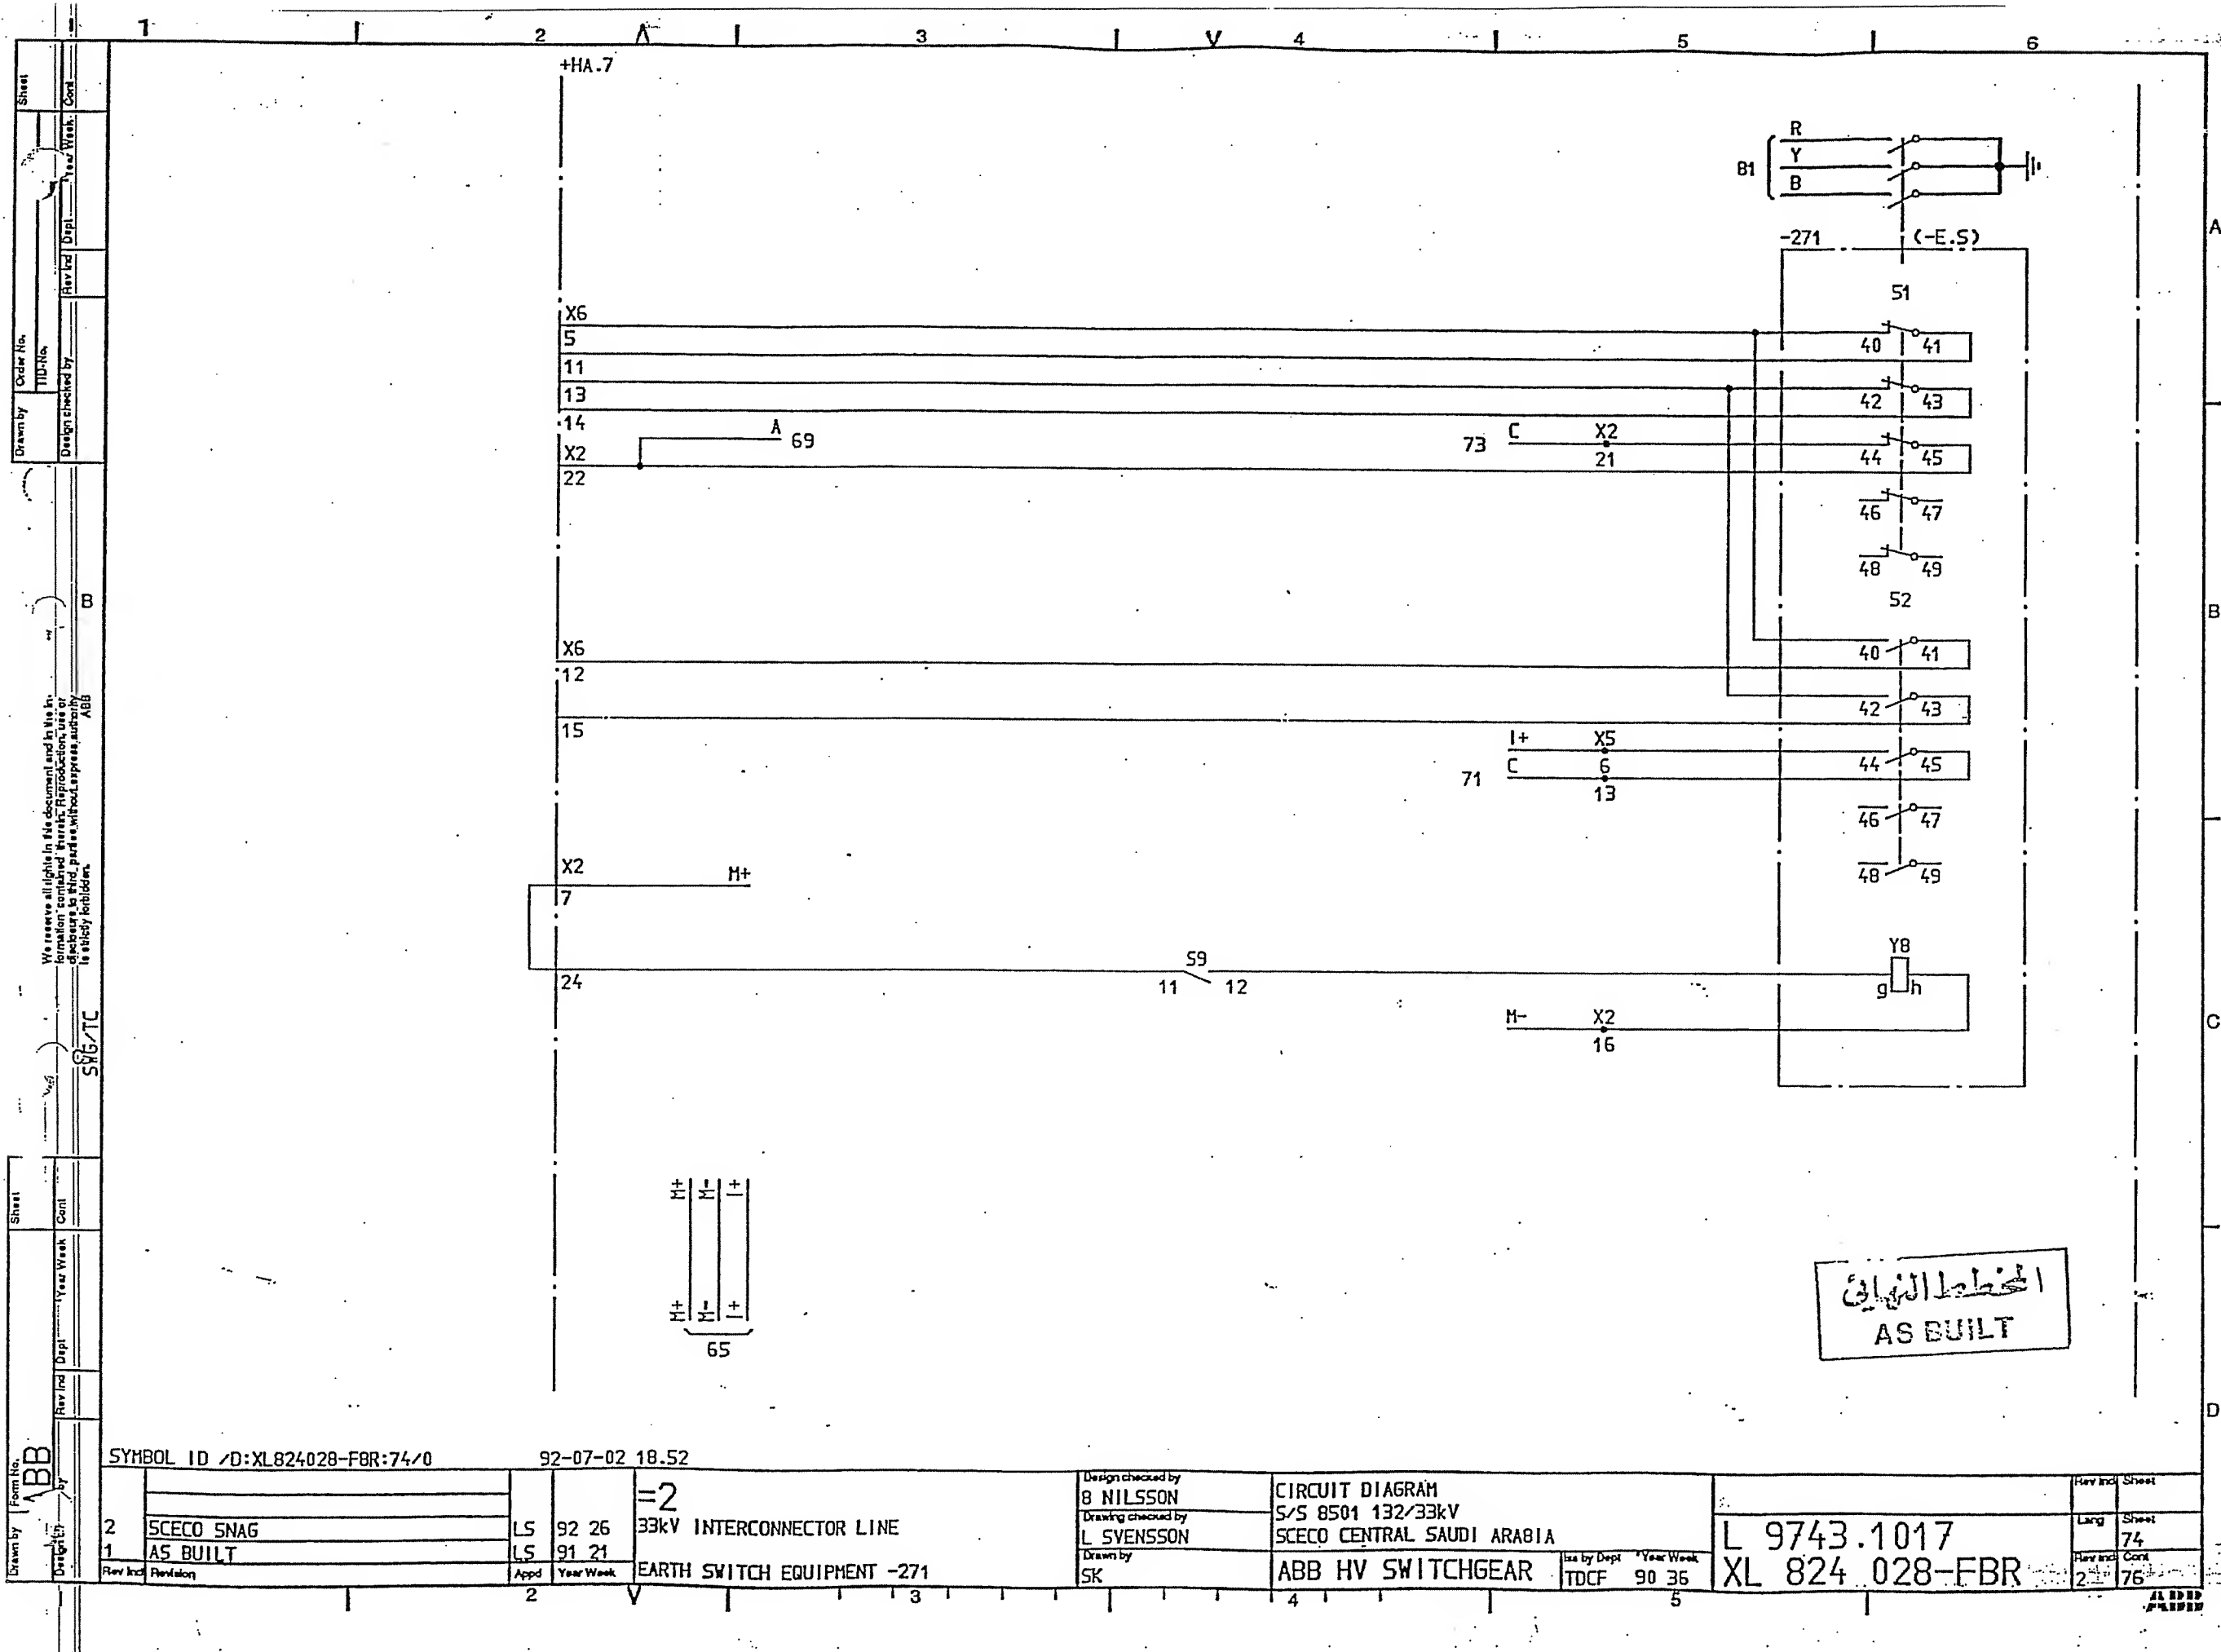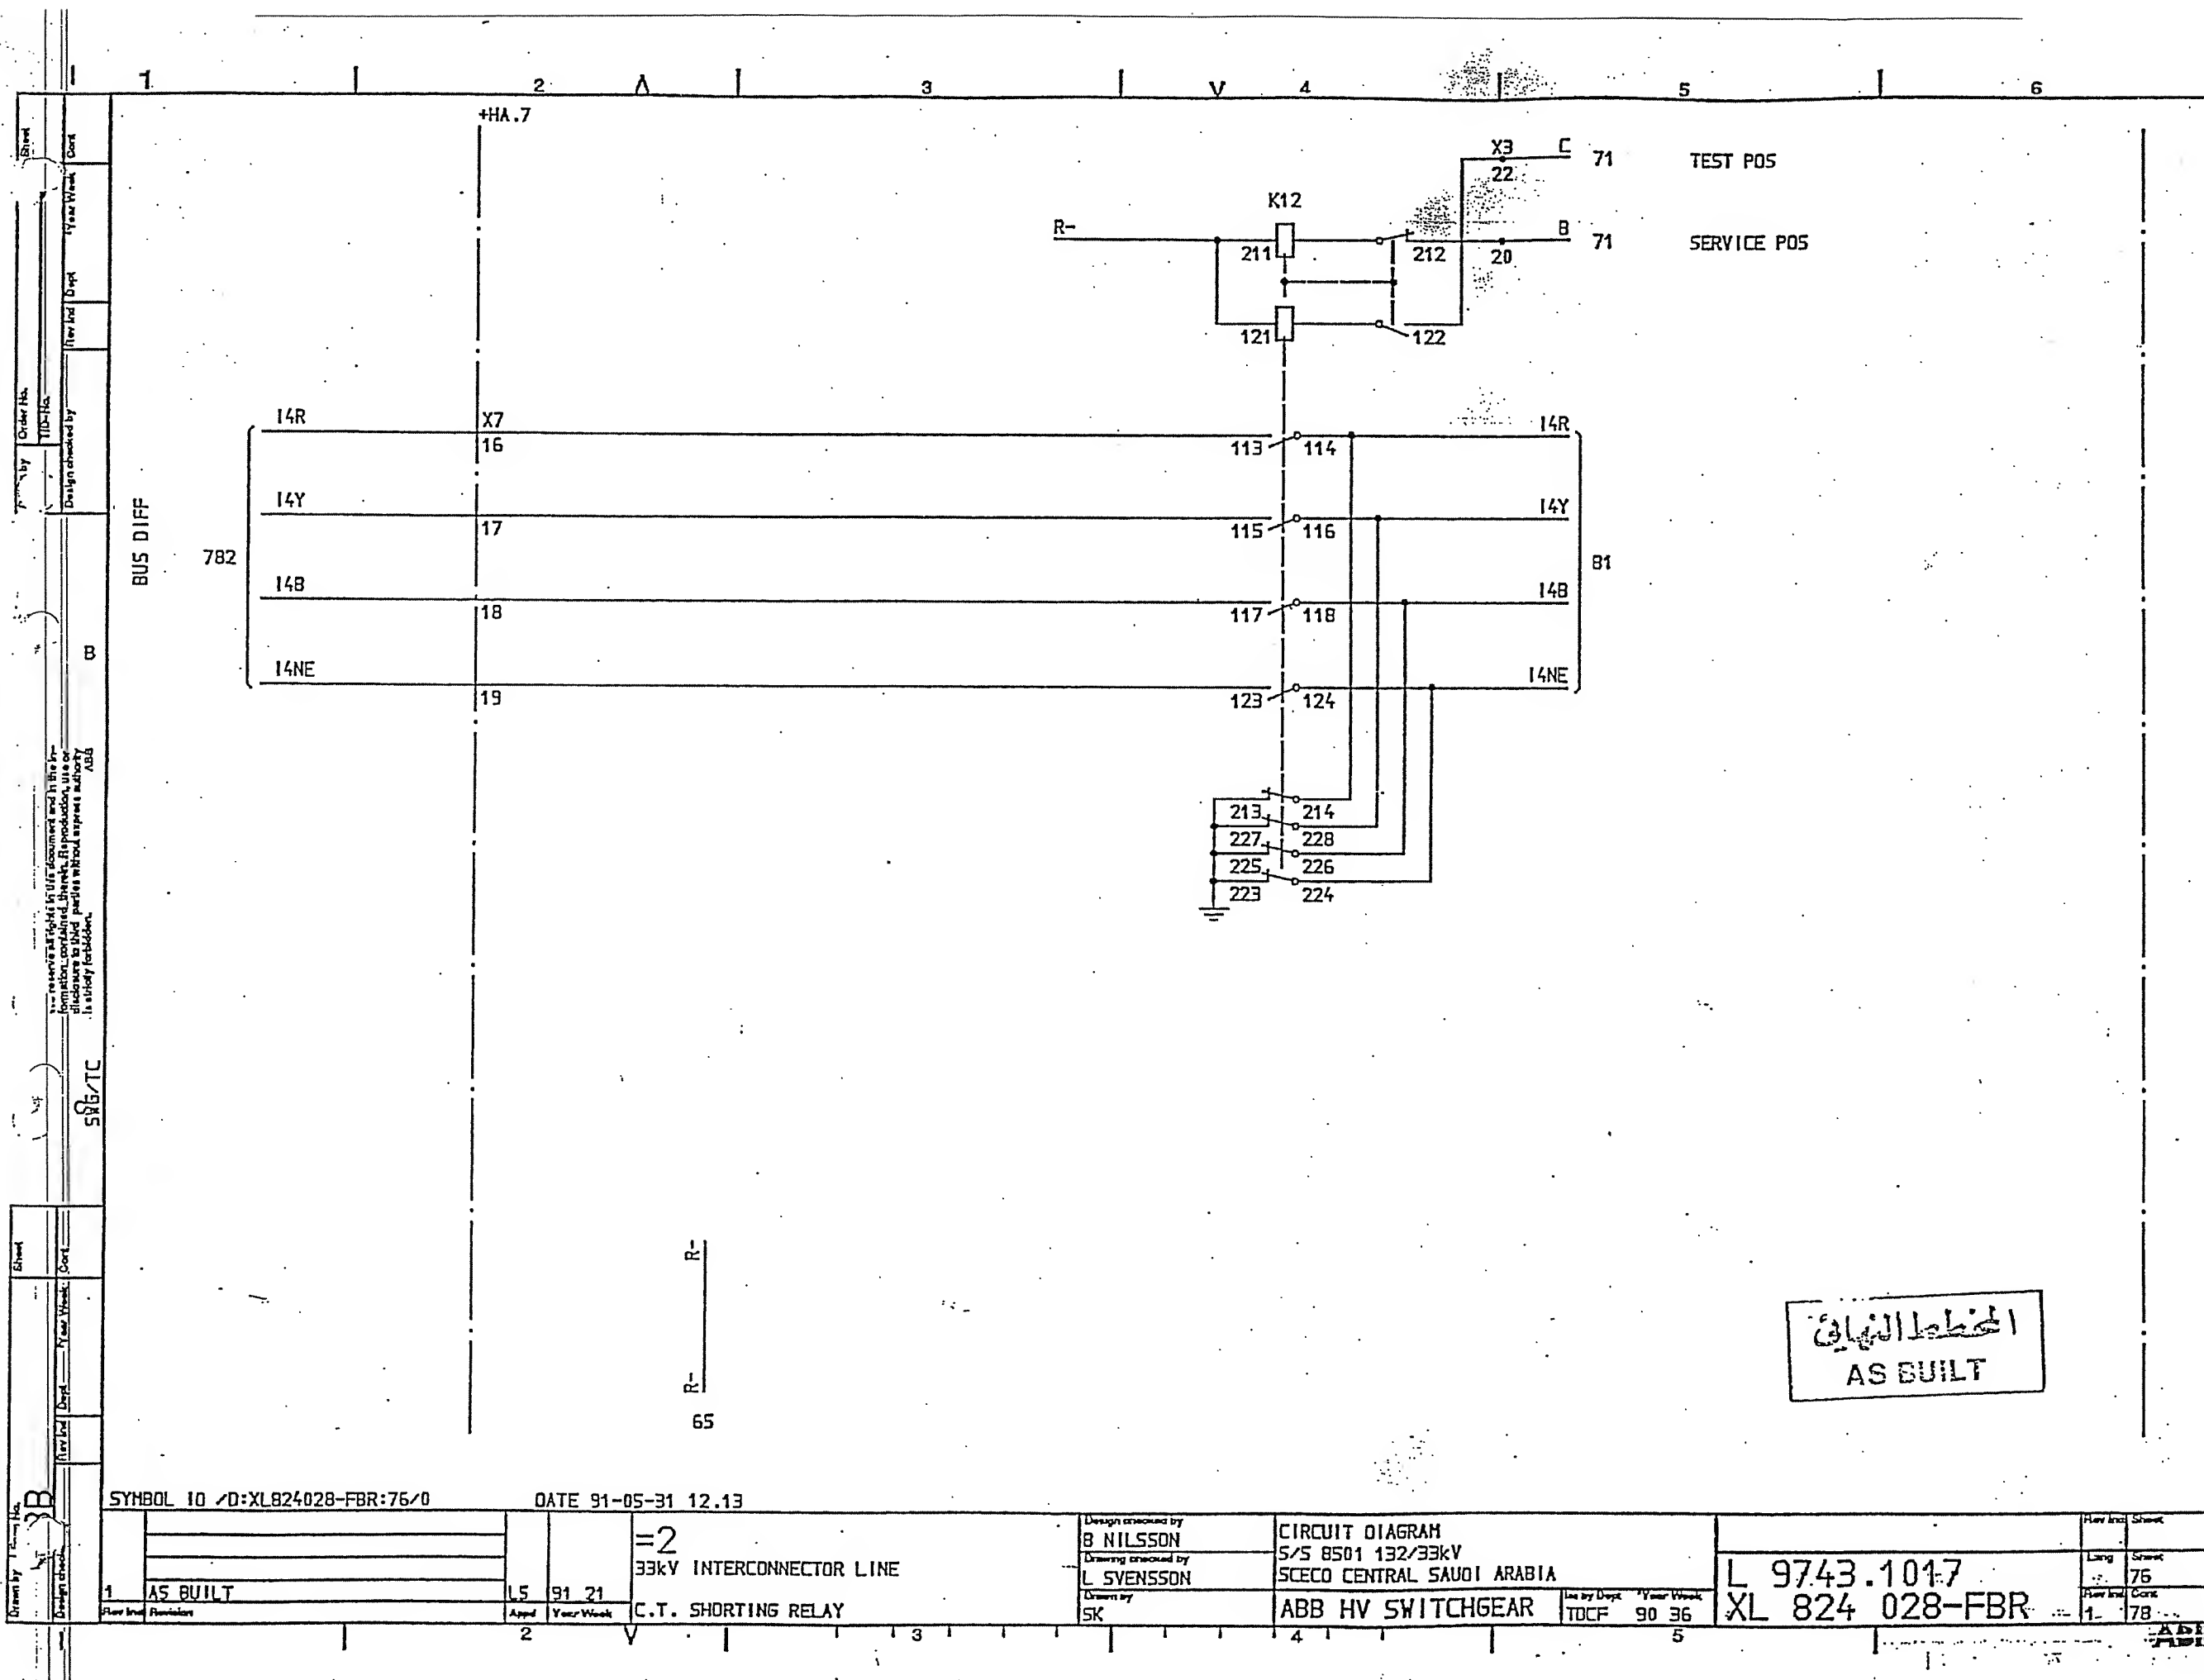ABB





SYMBOL 10 /D:XL824028-FBR:76/0

DATE 91-05-31 12.13

| | | | | |
|----------|----|-------|----|--------------------------|
| AS BUILT | L5 | 91 21 | =2 | 33kV INTERCONNECTOR LINE |
| | | | | C.T. SHORTING RELAY |

Design checked by
B NILSSON
Drawing checked by
L SVENSSON
Drawn by
SK

CIRCUIT DIAGRAM
S/S 8501 132/33kV
SCECO CENTRAL SAUDI ARABIA
ABB HV SWITCHGEAR

Line by Dept Year Week
TOCF 90 36

L 9743.1017
XL 824 028-FBR

| | | |
|-----|-----|-------|
| Rev | Int | Sheet |
| 1 | 76 | 78 |

21 21

DIST. PROT

83 MAIN PROT TRIP

+HA.7

X3

44

TRIP INDIC.
94 - 1

56 P-

45

K18

12 11

13 14

15 16

17 18

K2

21 11

68.10 =2TRIP+

X3

31

13 12

15 14

17 16

23 22

25 24

27 26

32

68 P+

87 BACK-UP PROT TRIP

X3

46

K3

21 11

68 A

13 12

15 14

17 16

23 22

25 24

27 26

8 68

68 P+

56 P-SUP

47

K18

22 21

23 24

25 26

27 28

TRIP INDIC.
94 - BU

المخطط النهائي
AS BUILT

SYMBOL ID /D:XL824028-FBR:78/0

92-09-09 07.32

2 SCECO SNAG
1 AS BUILT

LS 92 26
LS 91 21

=2
33kV INTERCONNECTOR LINE
TRIP RELAYS 33kV

Design checked by
B NILSSON
Drawing checked by
L SVENSSON
Drawn by
SK

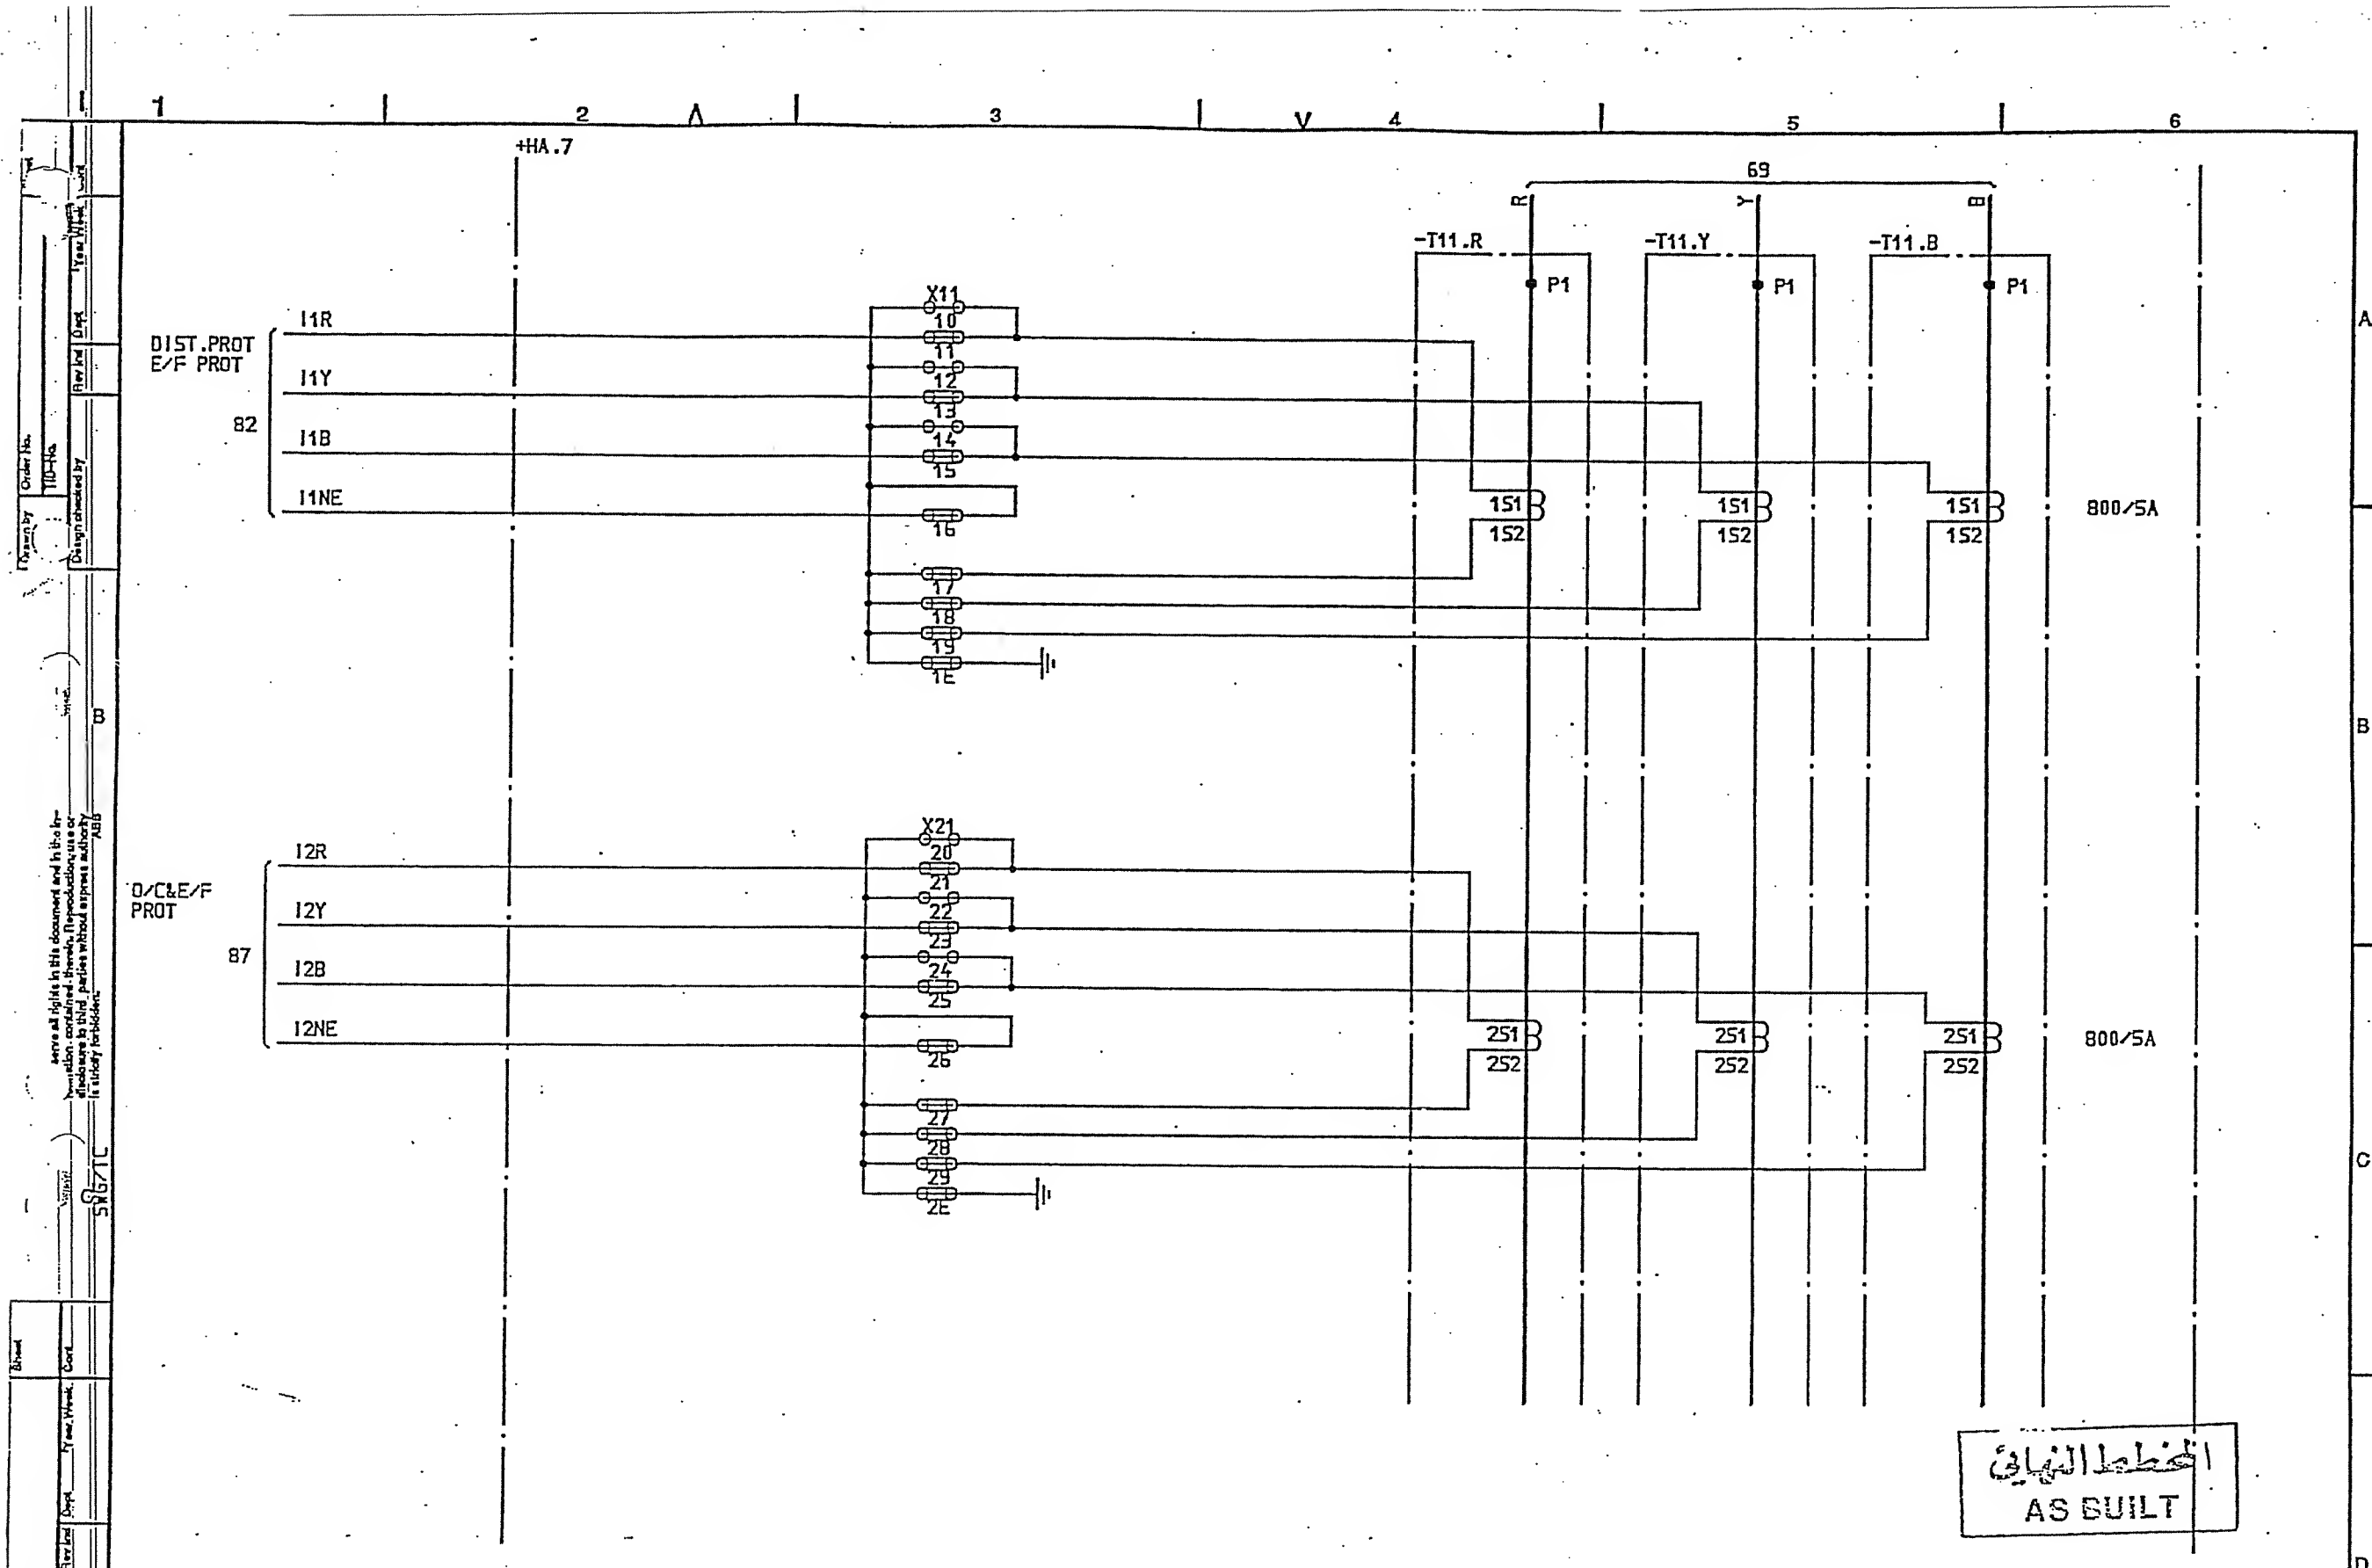
CIRCUIT DIAGRAM
S/S 8501 132/33kV
SCECO CENTRAL SAUDI ARABIA
ABB HV SWITCHGEAR

Issued by Dept
TDCF 90 36

L 9743.1017
XL 824 028-FBR


Rev No. 2
Cont. 80

ABB



الخطة النهائية
AS BUILT

| | | | | | |
|--------------------------------|--|---------------------|--|--|--|
| SYMBOL ID /D:XL824028-FBR:80/0 | | DATE 91-05-06 10.03 | | | |
| 1 AS BUILT | | L5 91 21 | | =2 33kV INTERCONNECTOR LINE | |
| 1 AS BUILT | | L5 91 21 | | CURRENT TRANSFORMER -T11 | |
| 1 AS BUILT | | L5 91 21 | | CIRCUIT DIAGRAM S/S 8501 132/33kV SCECO CENTRAL SAUDI ARABIA | |
| 1 AS BUILT | | L5 91 21 | | ABB HV SWITCHGEAR | |
| 1 AS BUILT | | L5 91 21 | | L 9743.1017 XL 824 028-FBR | |

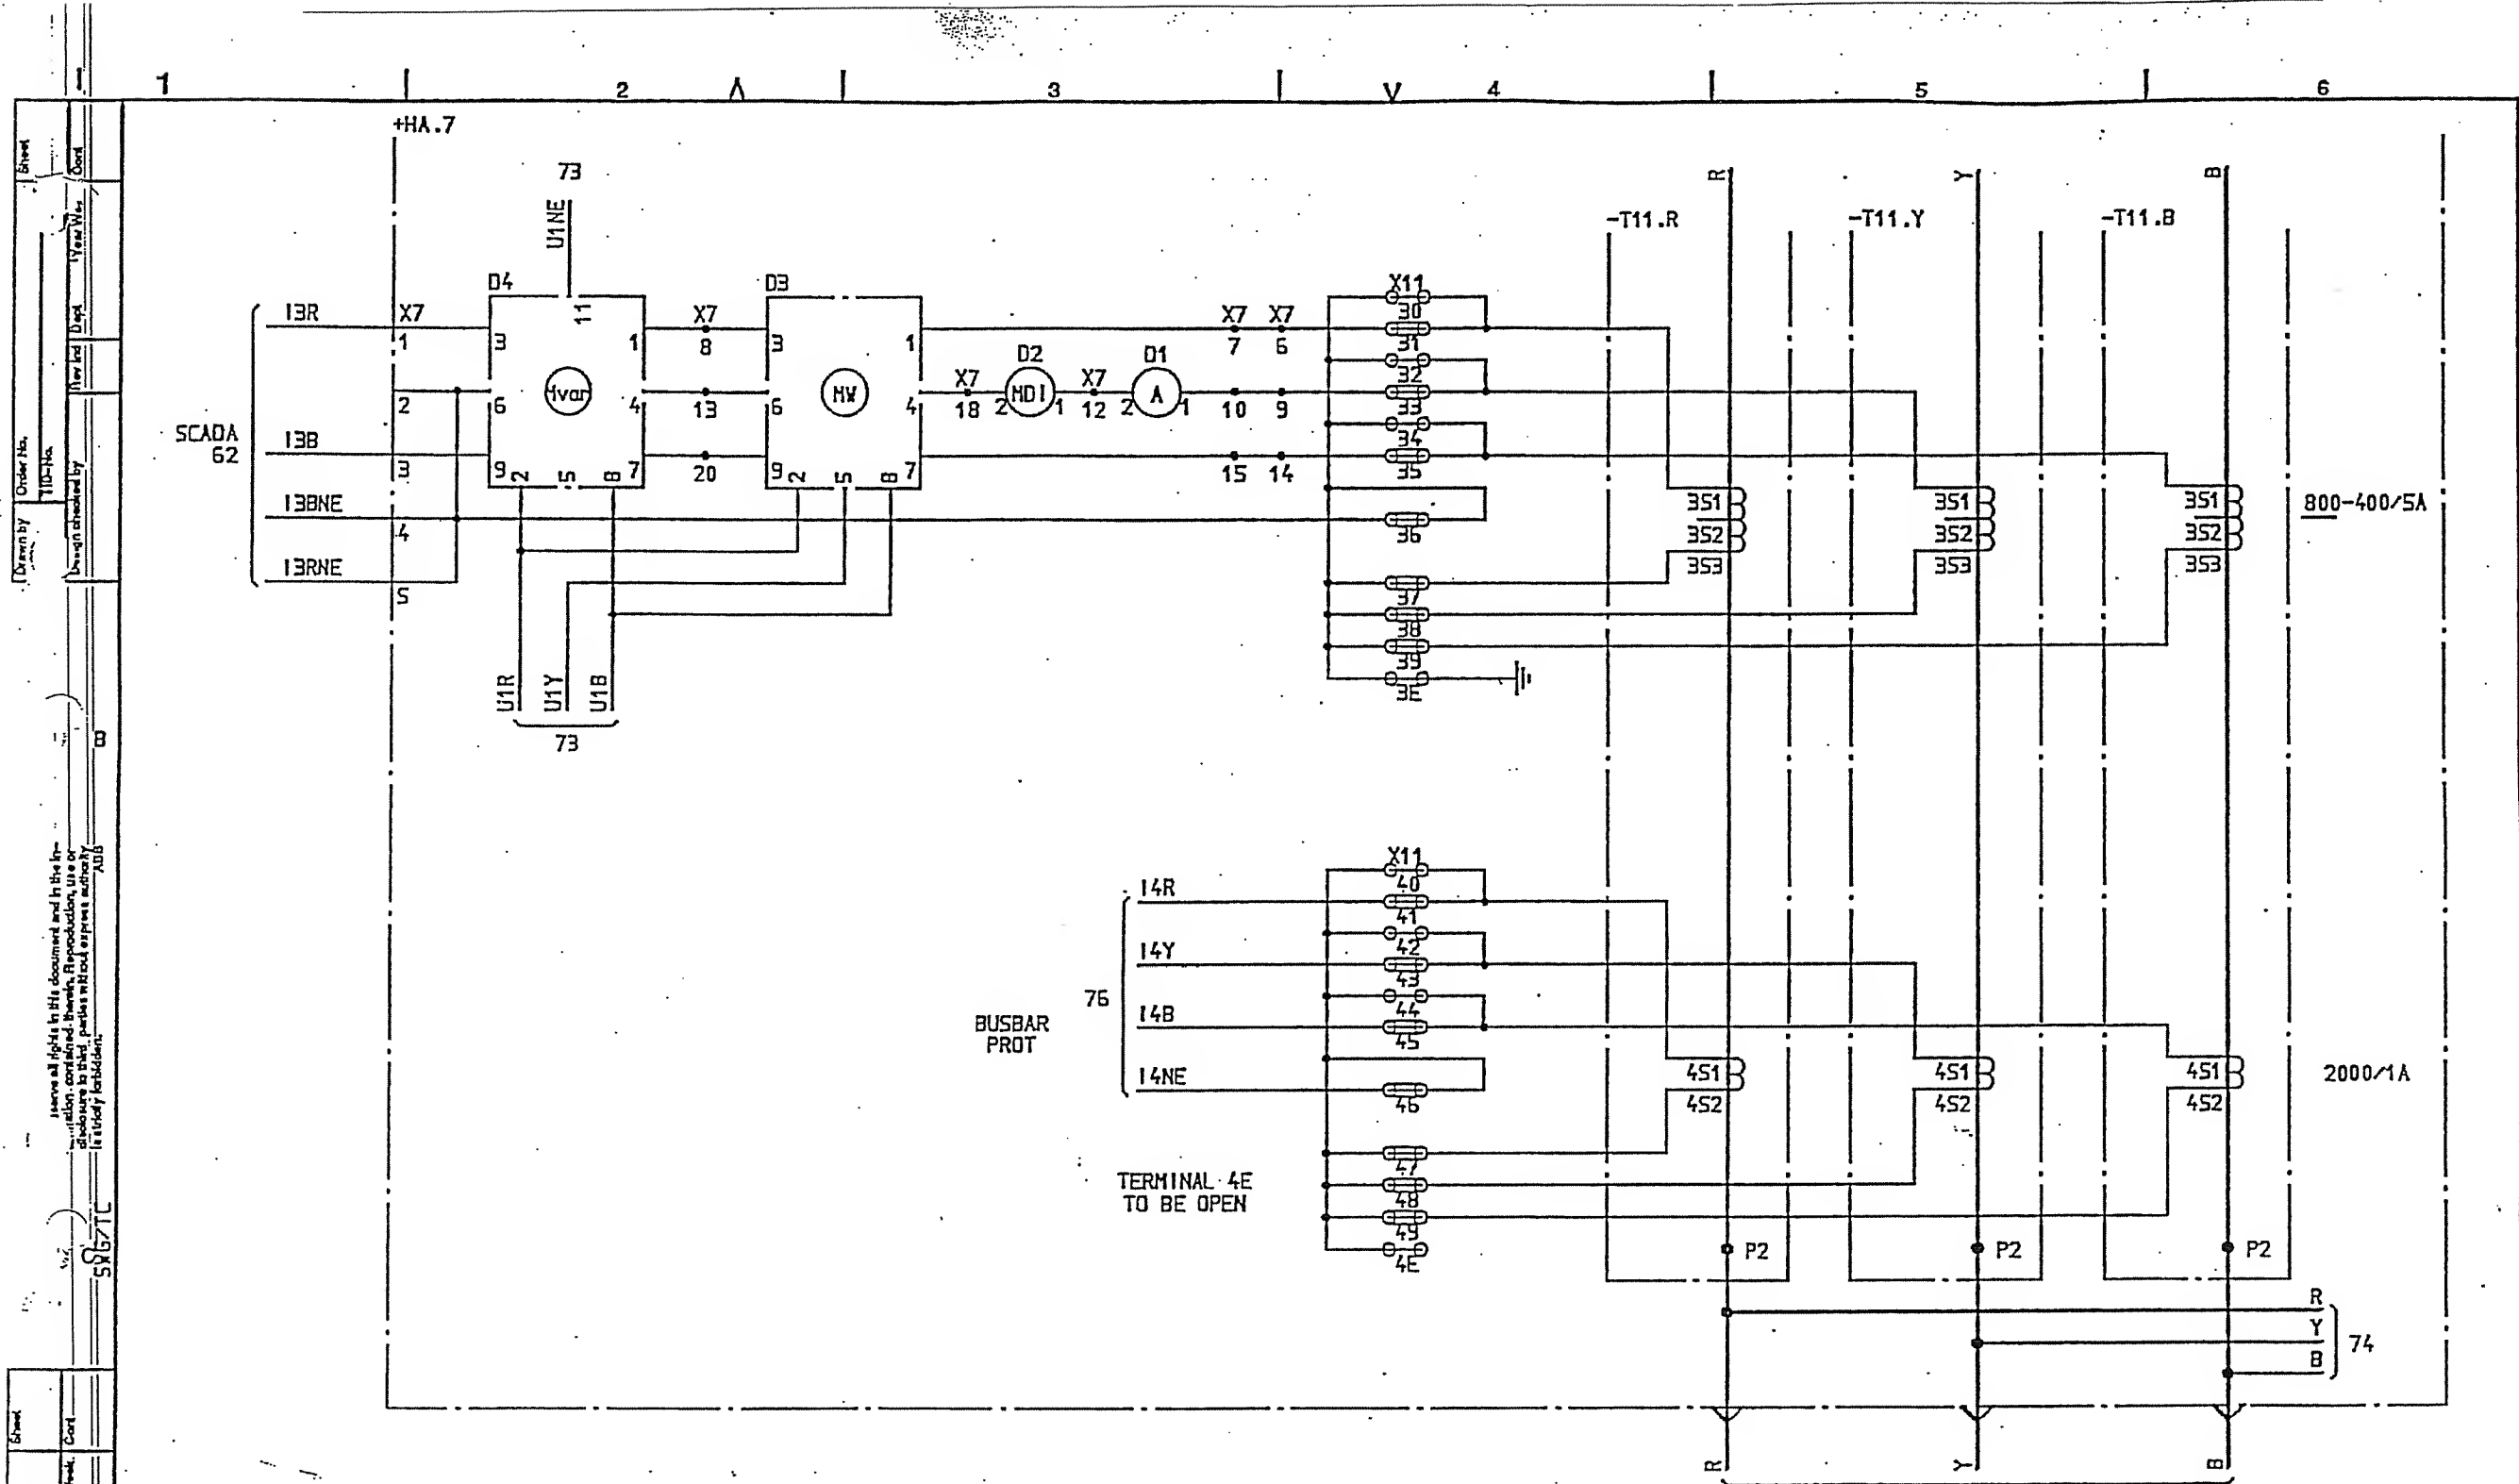

المخطط النهائي
AS BUILT

SYMBOL ID /0:XL824028-FBR:81/0

DATE 91-05-31 12.13

| | | | | | |
|---|----------|----|-------|---|--------------------------|
| 1 | AS BUILT | L5 | 91 21 | 2 | 33kV INTERCONNECTOR LINE |
| 1 | AS BUILT | L5 | 91 21 | 2 | CURRENT TRANSFORMER -T11 |

Design checked by
B NILSSON
Drawing checked by
L SVENSSON
Drawn by
SK


CIRCUIT DIAGRAM
S/S 8501 132/33kV
SCECO CENTRAL SAUDI ARABIA
ABB HV SWITCHGEAR

Iss by Dept
TDCF 90 36

L 9743.1017
XL 824 028-FBR

| Rev | Rev | Rev |
|-----|-----|-----|
| 1 | 81 | 82 |

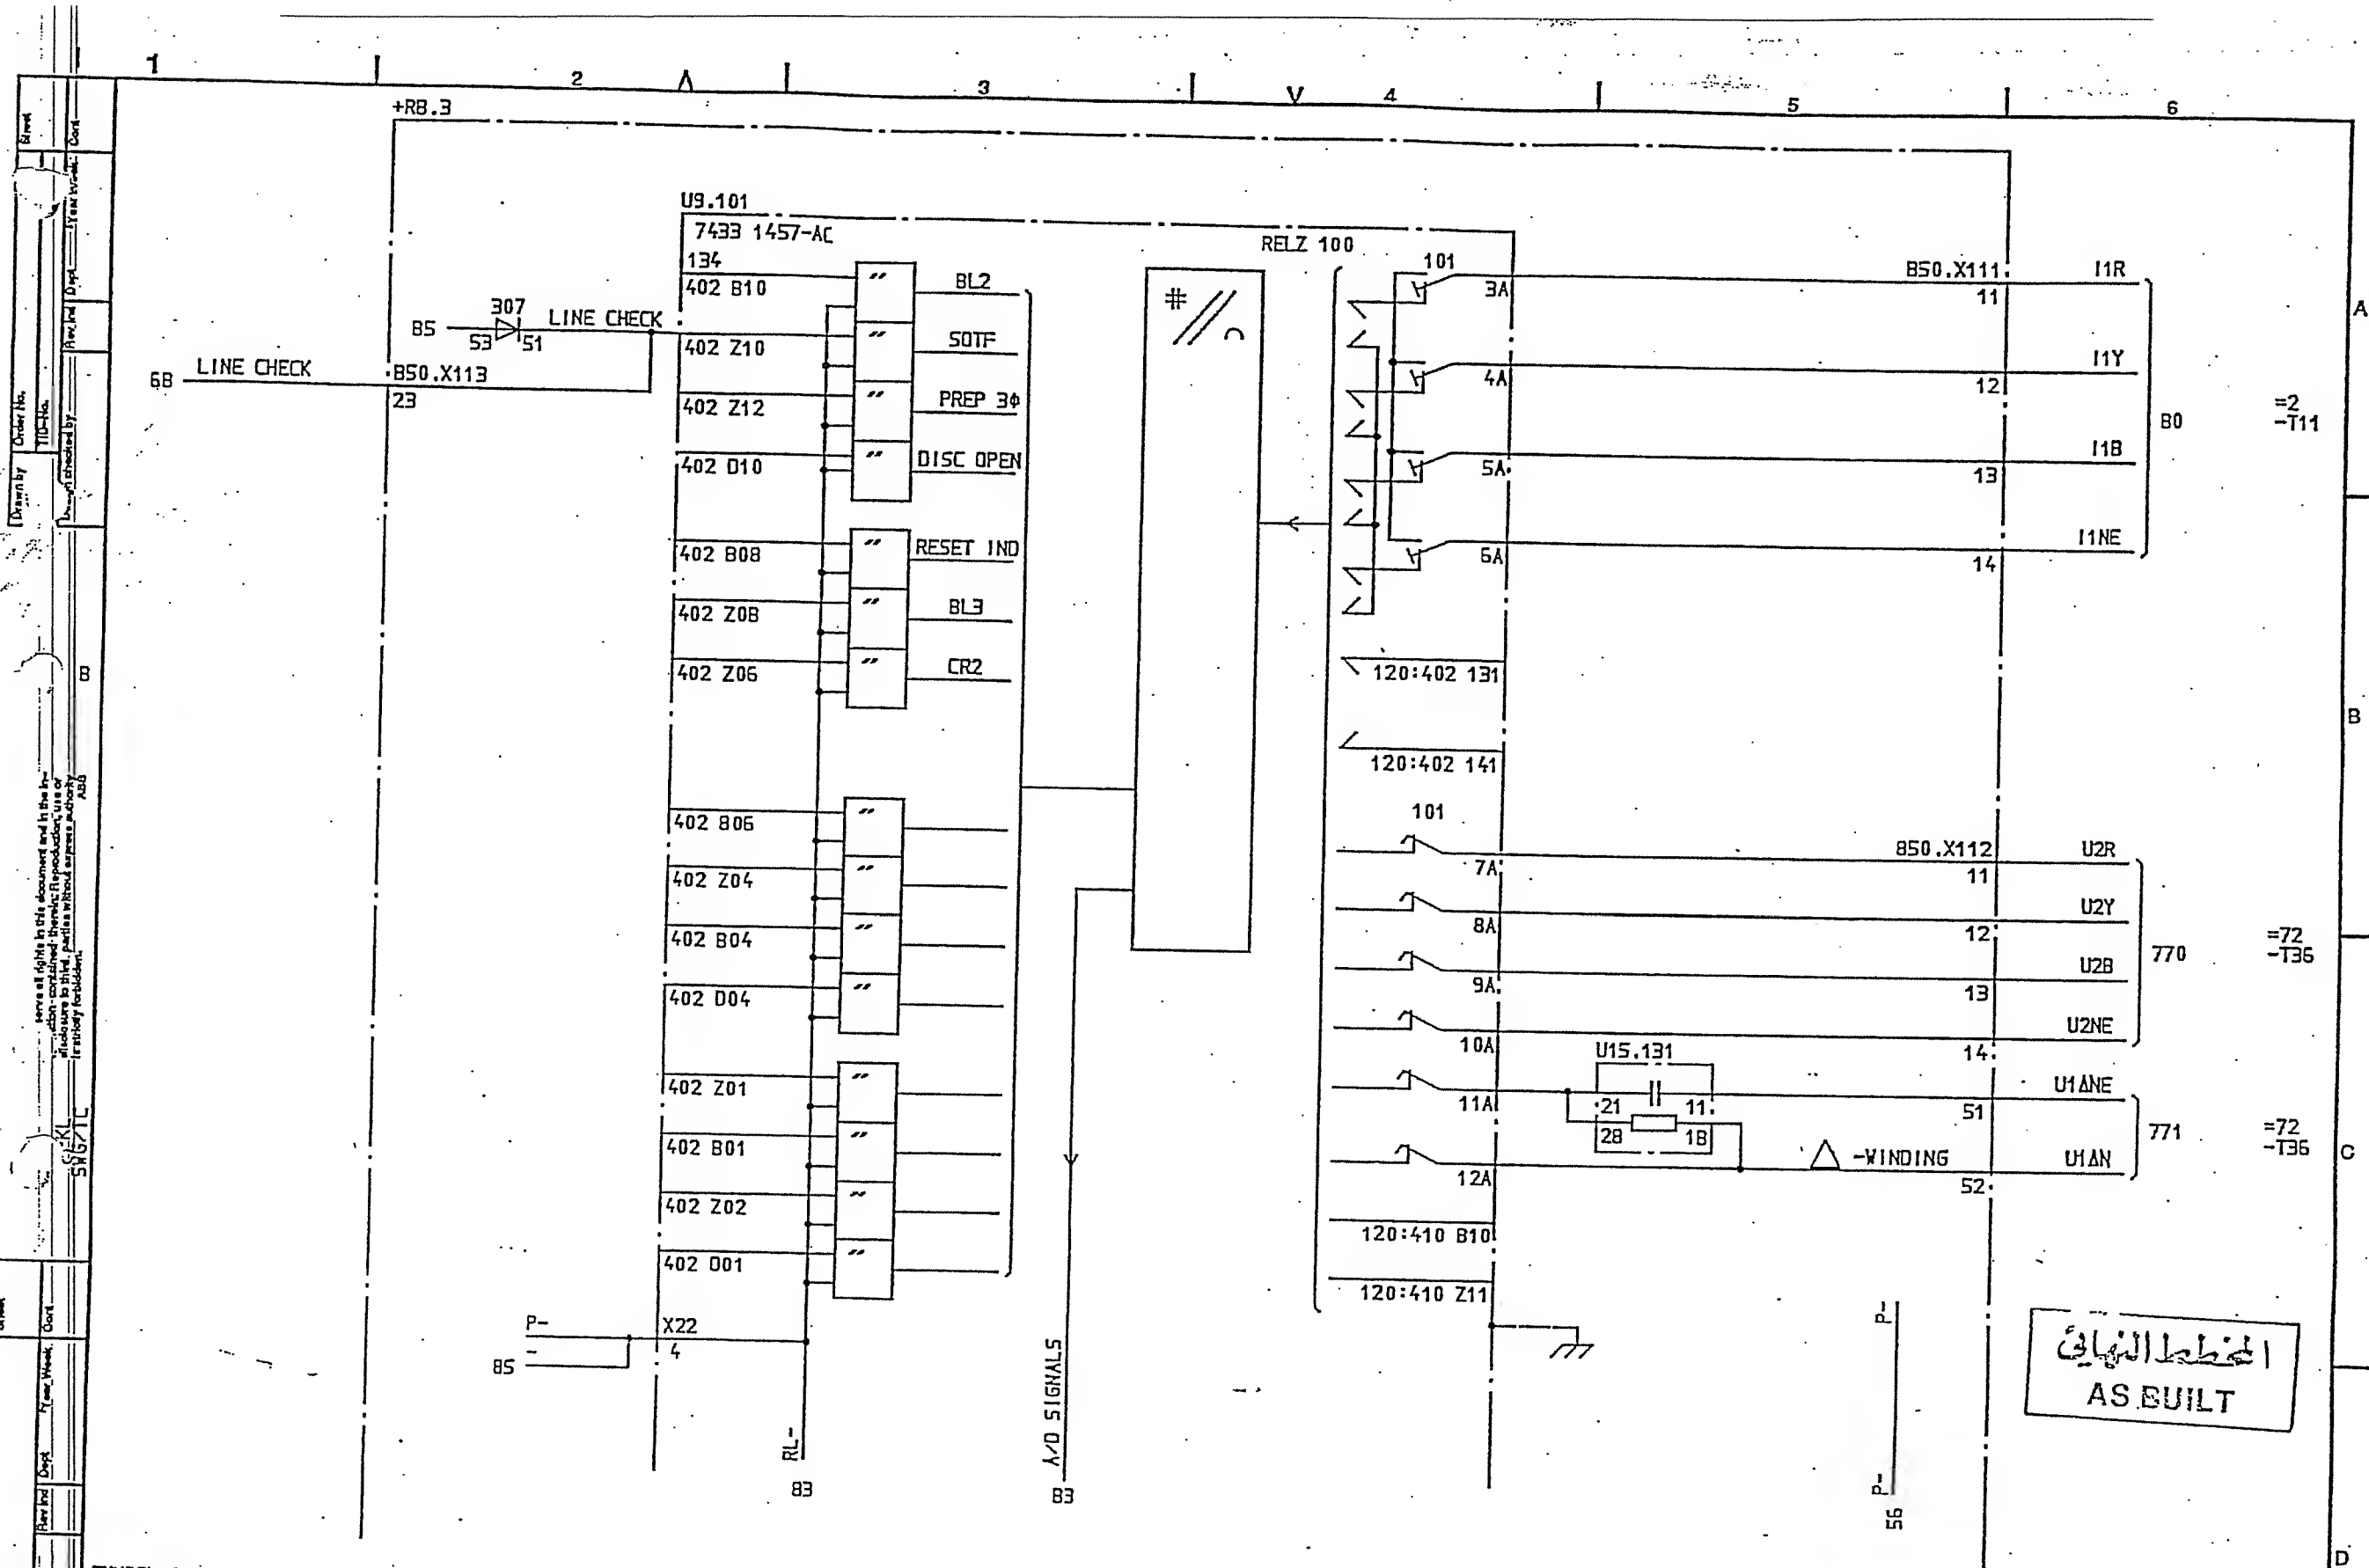
ABB




SYMBOL ID /D:XL824028-FBR:B2/0

DATE 91-06-06 10.04

| | | | | | |
|---------------|-------------|--------------------------------|---|---|-------------------------------|
| 1 AS BUILT | 15 91 21 | =2 33kV INTERCONNECTOR LINE | Design checked by B NILSSON Drawing checked by J SKOVGAARD Drawn by 1A | CIRCUIT DIAGRAM S/S 8501 132/33kV SCECO CENTRAL SAUDI ARABIA ABB HV SWITCHGEAR | L 9743.1017 XL 824 028-FBR |
| 2 AS BUILT | 15 91 21 | DISTANCE PROTECTION | TDCF 90 15 | 5 | 1 83 |

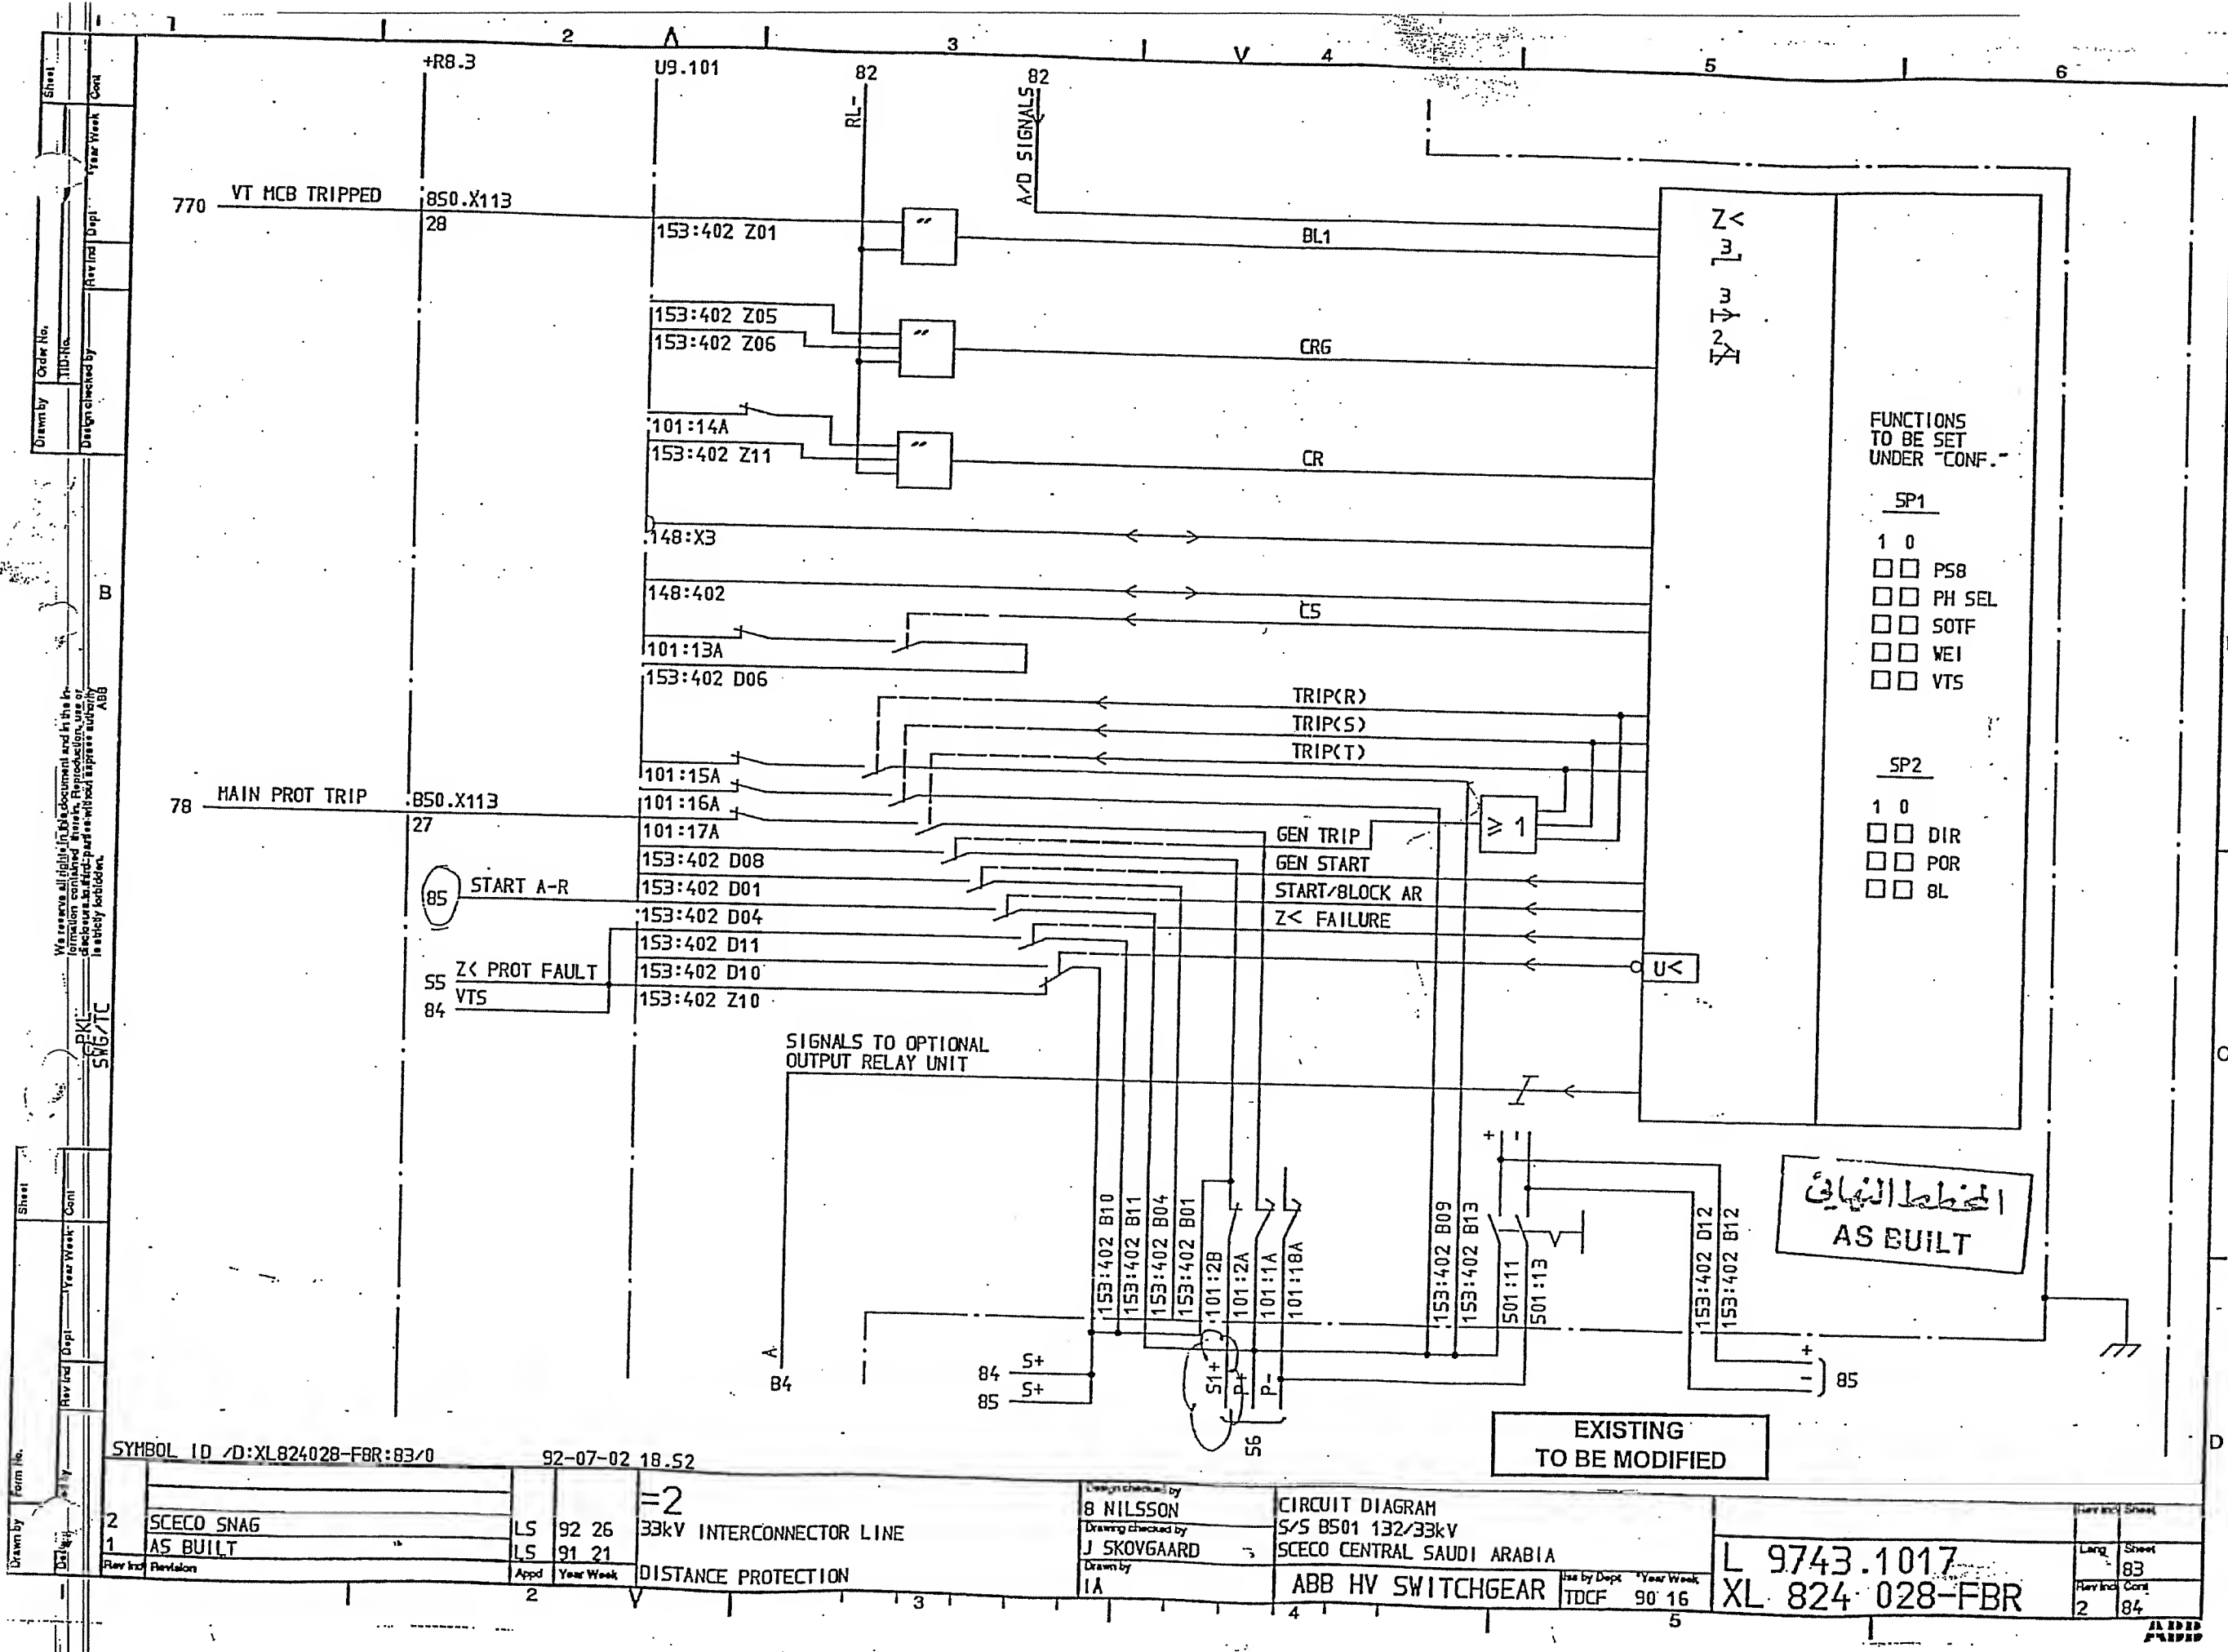

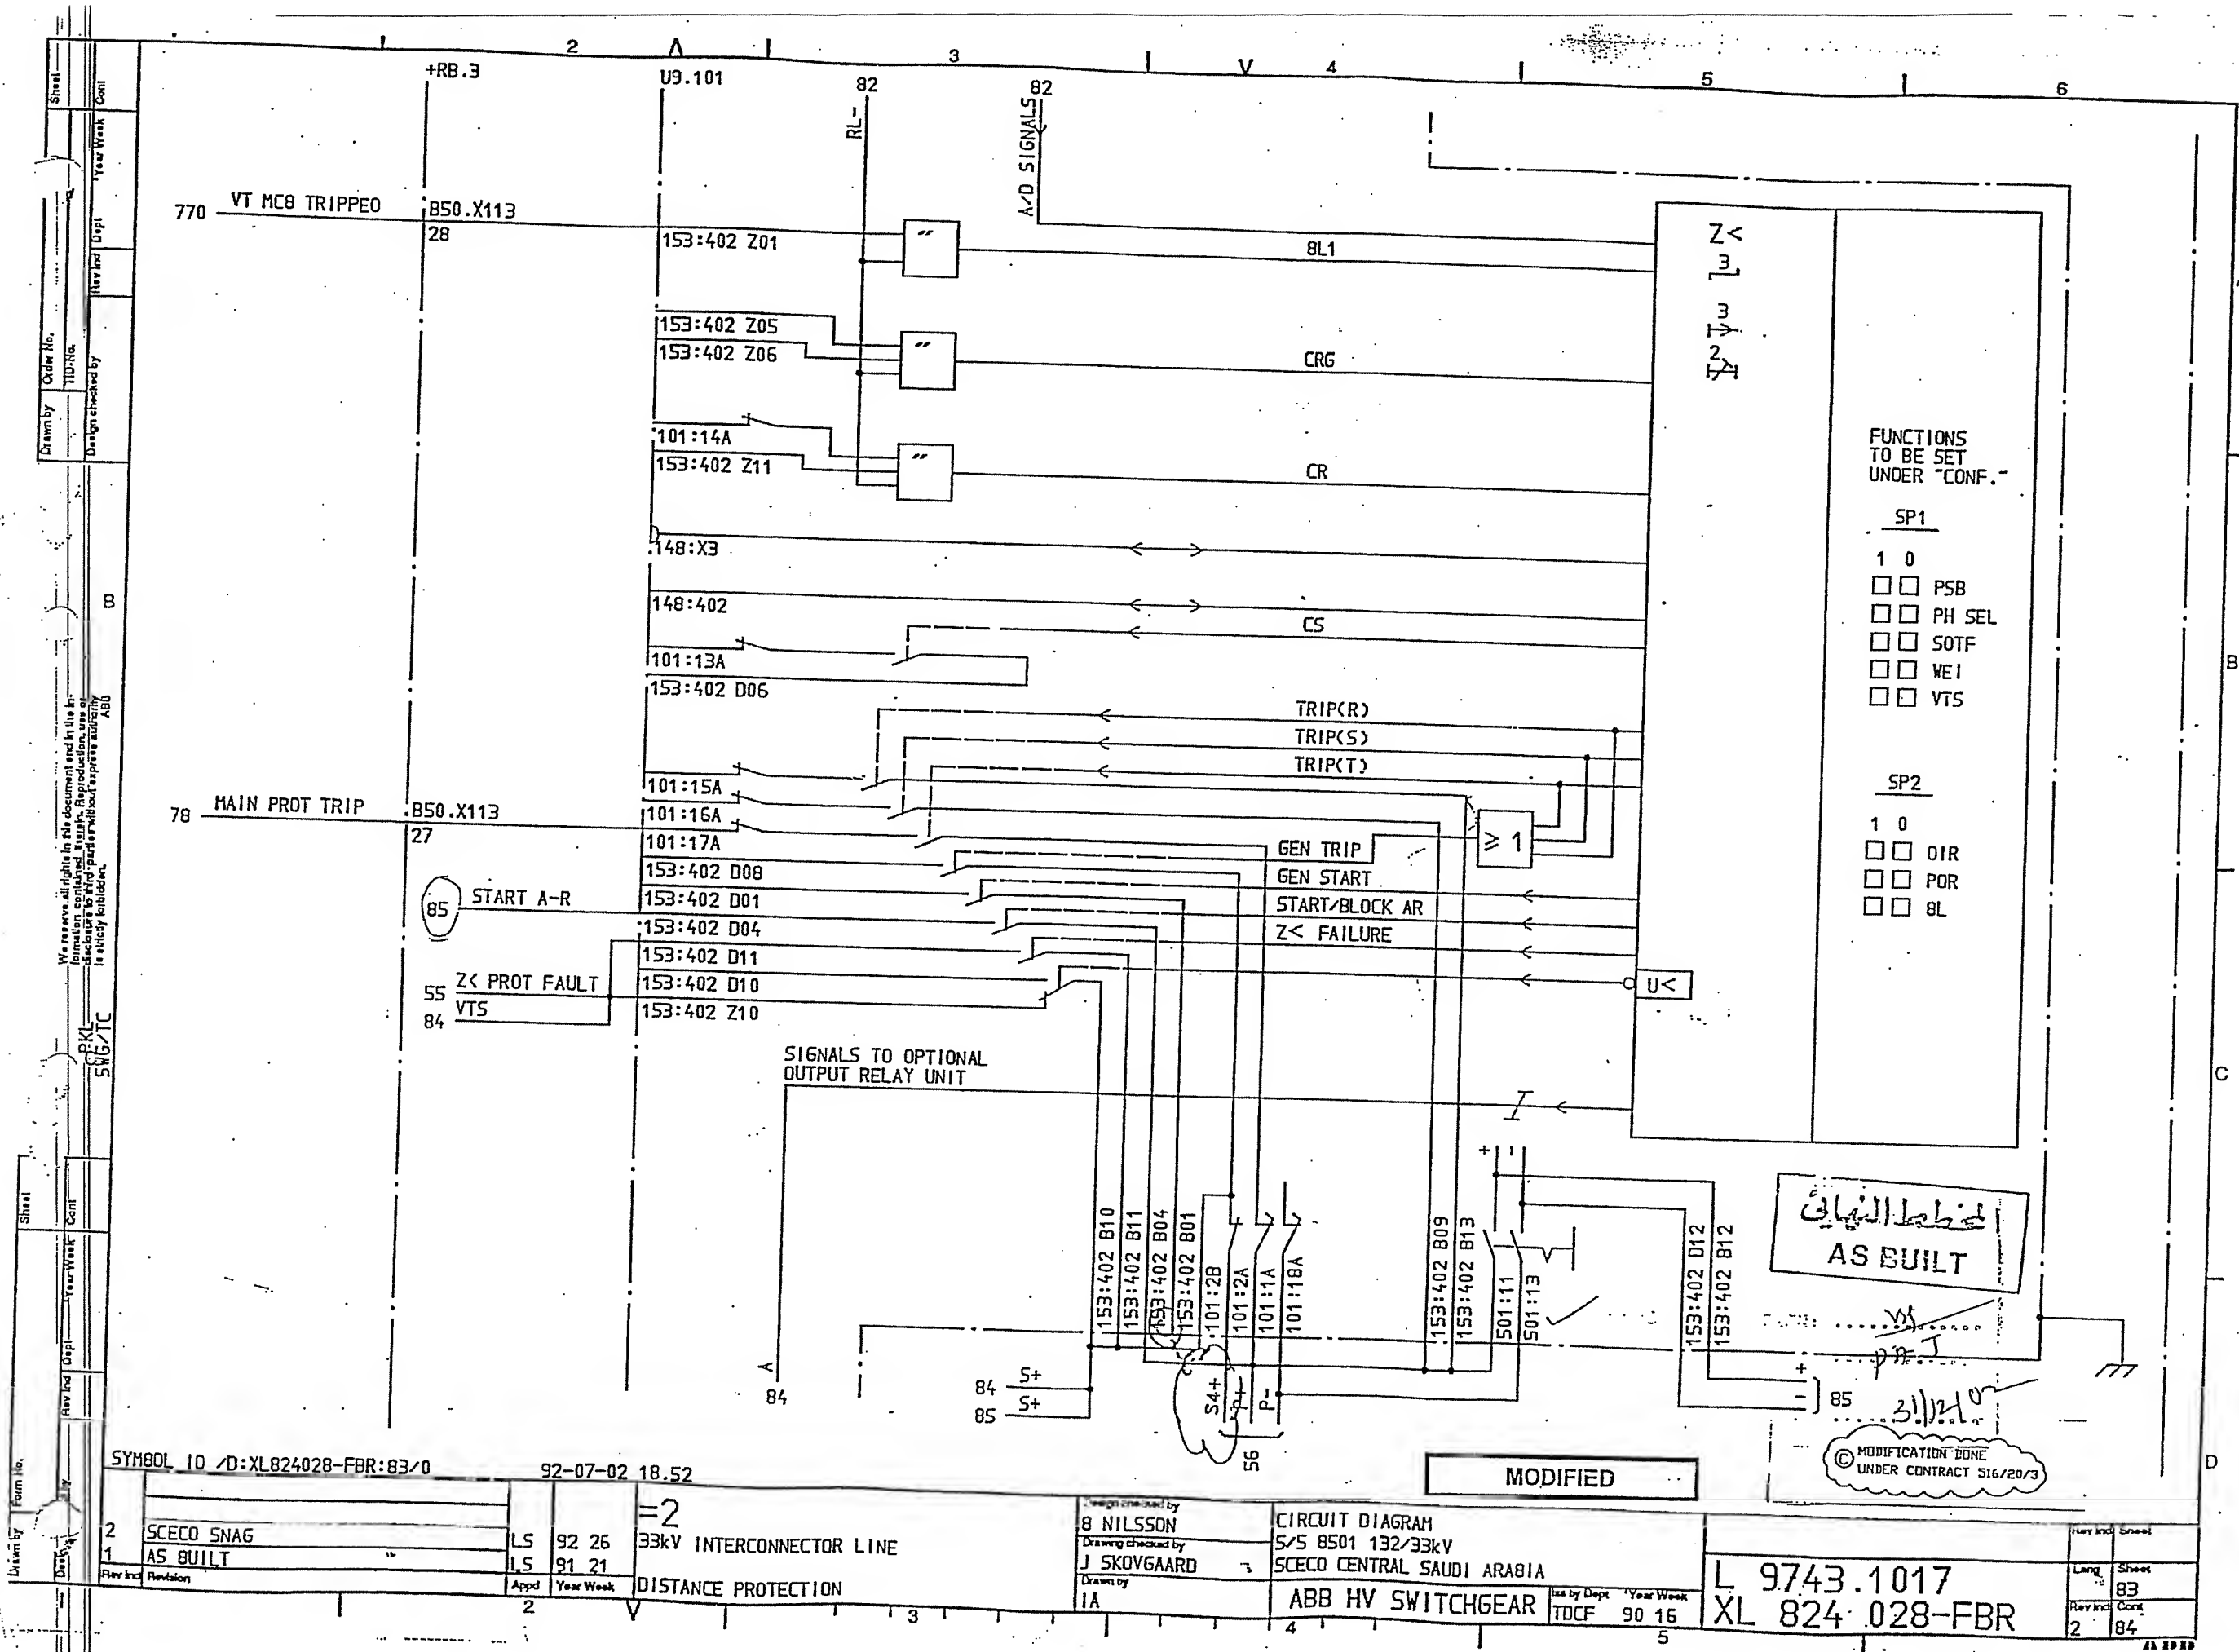

| | |
|-------------------|-----------|
| Order No. | Sheet |
| Design checked by | Year Week |
| Rev Ind | Cont |

We reserve all rights in this document and in the information contained therein. Reproduction, use or disclosure is prohibited without express authority.

| | |
|-------------------|-----------|
| Design checked by | Year Week |
| Rev Ind | Cont |

DWG: S10114-AFAAO
SH : 172
K124 A/B

X63 F
9
33kV
PRDT OP

86 START A-R 164
850. ZC
X41 PROT OP

23 D/C-E/F
87 PROT OP

83 VTS

SYMBOL 10 /D:XL824028-FBR:84/0

92-07-02 18.52

=2

33kV INTERCONNECTOR LINE

DISTANCE PROTECTION

Design checked by
B NILSSON
Drawing checked by
J SKOVGAARD
Drawn by
IA

CIRCUIT DIAGRAM
S/S 8501 132/33kV
SCECO CENTRAL SAUDI ARABIA
ABB HV SWITCHGEAR

Iss by Dept
TDCF 90 16

Year Week
5

L 9743.1017
XL 824 028-FBR

| | |
|---------|-------|
| Rev Ind | Sheet |
| 2 | 84 |
| 2 | 85 |


RLKG 100 OPTION

DIAGRAM (SETTING UNDER "CONF")

| RELAY | 1 | 2 | 3 | 4 | 5 | 6 | 7 | 8 | 9 | 10 |
|-------|---------|---------|---------|---------|---------|---------|---------|---------|---------|---------|
| K1 | BLCK | BLCK | T3U | TRI | TRWEI | TRI | BLCK | TRLC | TRLC | TRLC |
| K2 | TRLC | GS | VTS | TRLC | TRLC | TRLC | ST3I0 | ST3I0 | GS | GS |
| K5 | TRC | PSB | ECHO | PSB | PSB | PSB | PSB | TRC | TRC | TRC |
| K8 | TRIP3PH | TRIP3PH | TRIP3PH | TRIP3PH | TRIP3PH | TRIP3PH | TRIP3PH | TRIP3PH | TRIP3PH | TRIP3PH |
| K10 | GS | FI1 | TRZ1 | TRIP3PH | SUP | TRIP3PH | TRZ1 | TRIP3PH | FI1 | TRIP3PH |
| K3 | ZM1 | TRZ1 | TRC | TRIPR | PSR | TRIPR | TRWEI | TRIPR | TRZ1 | ZM1 |
| K14 | ZM2 | TRZ2 | TRLC | TRIPS | PSS | TRIPS | TRLC | TRIPS | TRZ2 | ZM2 |
| K15 | ZM3 | TRZ3 | TRWEI | TRIPT | PST | TRIPT | TREF | TRIPT | TRZ3 | ZM3 |
| K9 | CS | CS | CS | CS | CS | CS | CS | CS | CS | CS |
| K6 | CR1 | CR1 | CR1 | CR1 | CR1 | CR1 | CR1 | CR1 | CR1 | CR1 |
| K7 | AR | SUPN | PSB | AR | CS | AR | CS2 | AR | CS | CR1 |
| K4 | NDS | SUPI | SUP | SUP | CR1 | SUPI | CR2 | SUP | SUP | GT |
| K11 | TRZ1 | PSR | PSR | TRZ1 | ZM1 | CS | CS2 | TREF | PSR | AR |
| K13 | TRZ2 | PSS | PSS | TRZ2 | ZM2 | CR1 | CR2 | TREF | PSS | PSR |
| K12 | TRZ3 | PST | PST | TRZ3 | ZM3 | TRC | SUPN | CS2 | PST | PSS |
| K16 | TRZ3R | PSN | PSN | TRZ3R | ZM3R | TRZ1 | SUPI | CR2 | PSN | PST |
| | | | | | | | | | | PSN |

PLANT ADAPTED PROGRAMMING
STANDARD PROGRAMMING AT DELIVERY

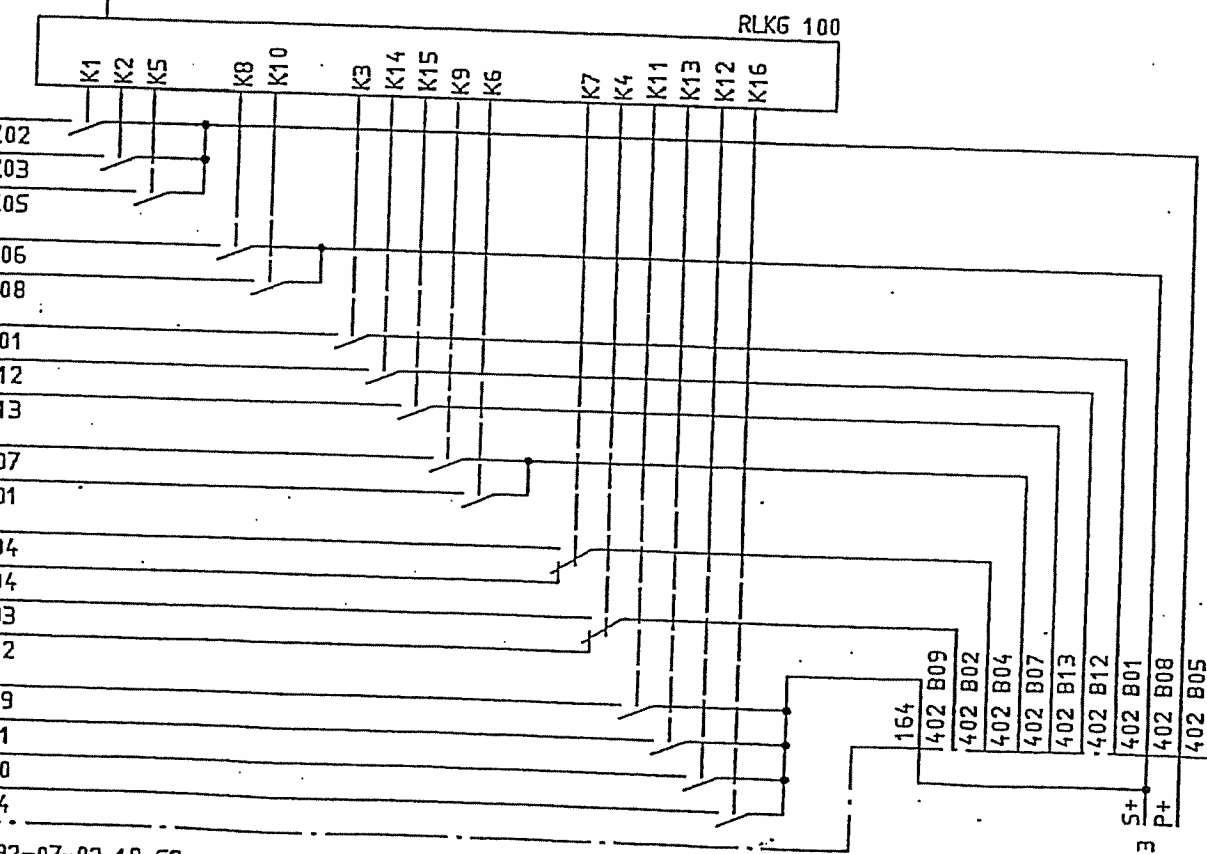X




المخطط النهائي
AS BUILT

MODIFICATION DONE
UNDER CONTRACT 516/20/3

MODIFIED

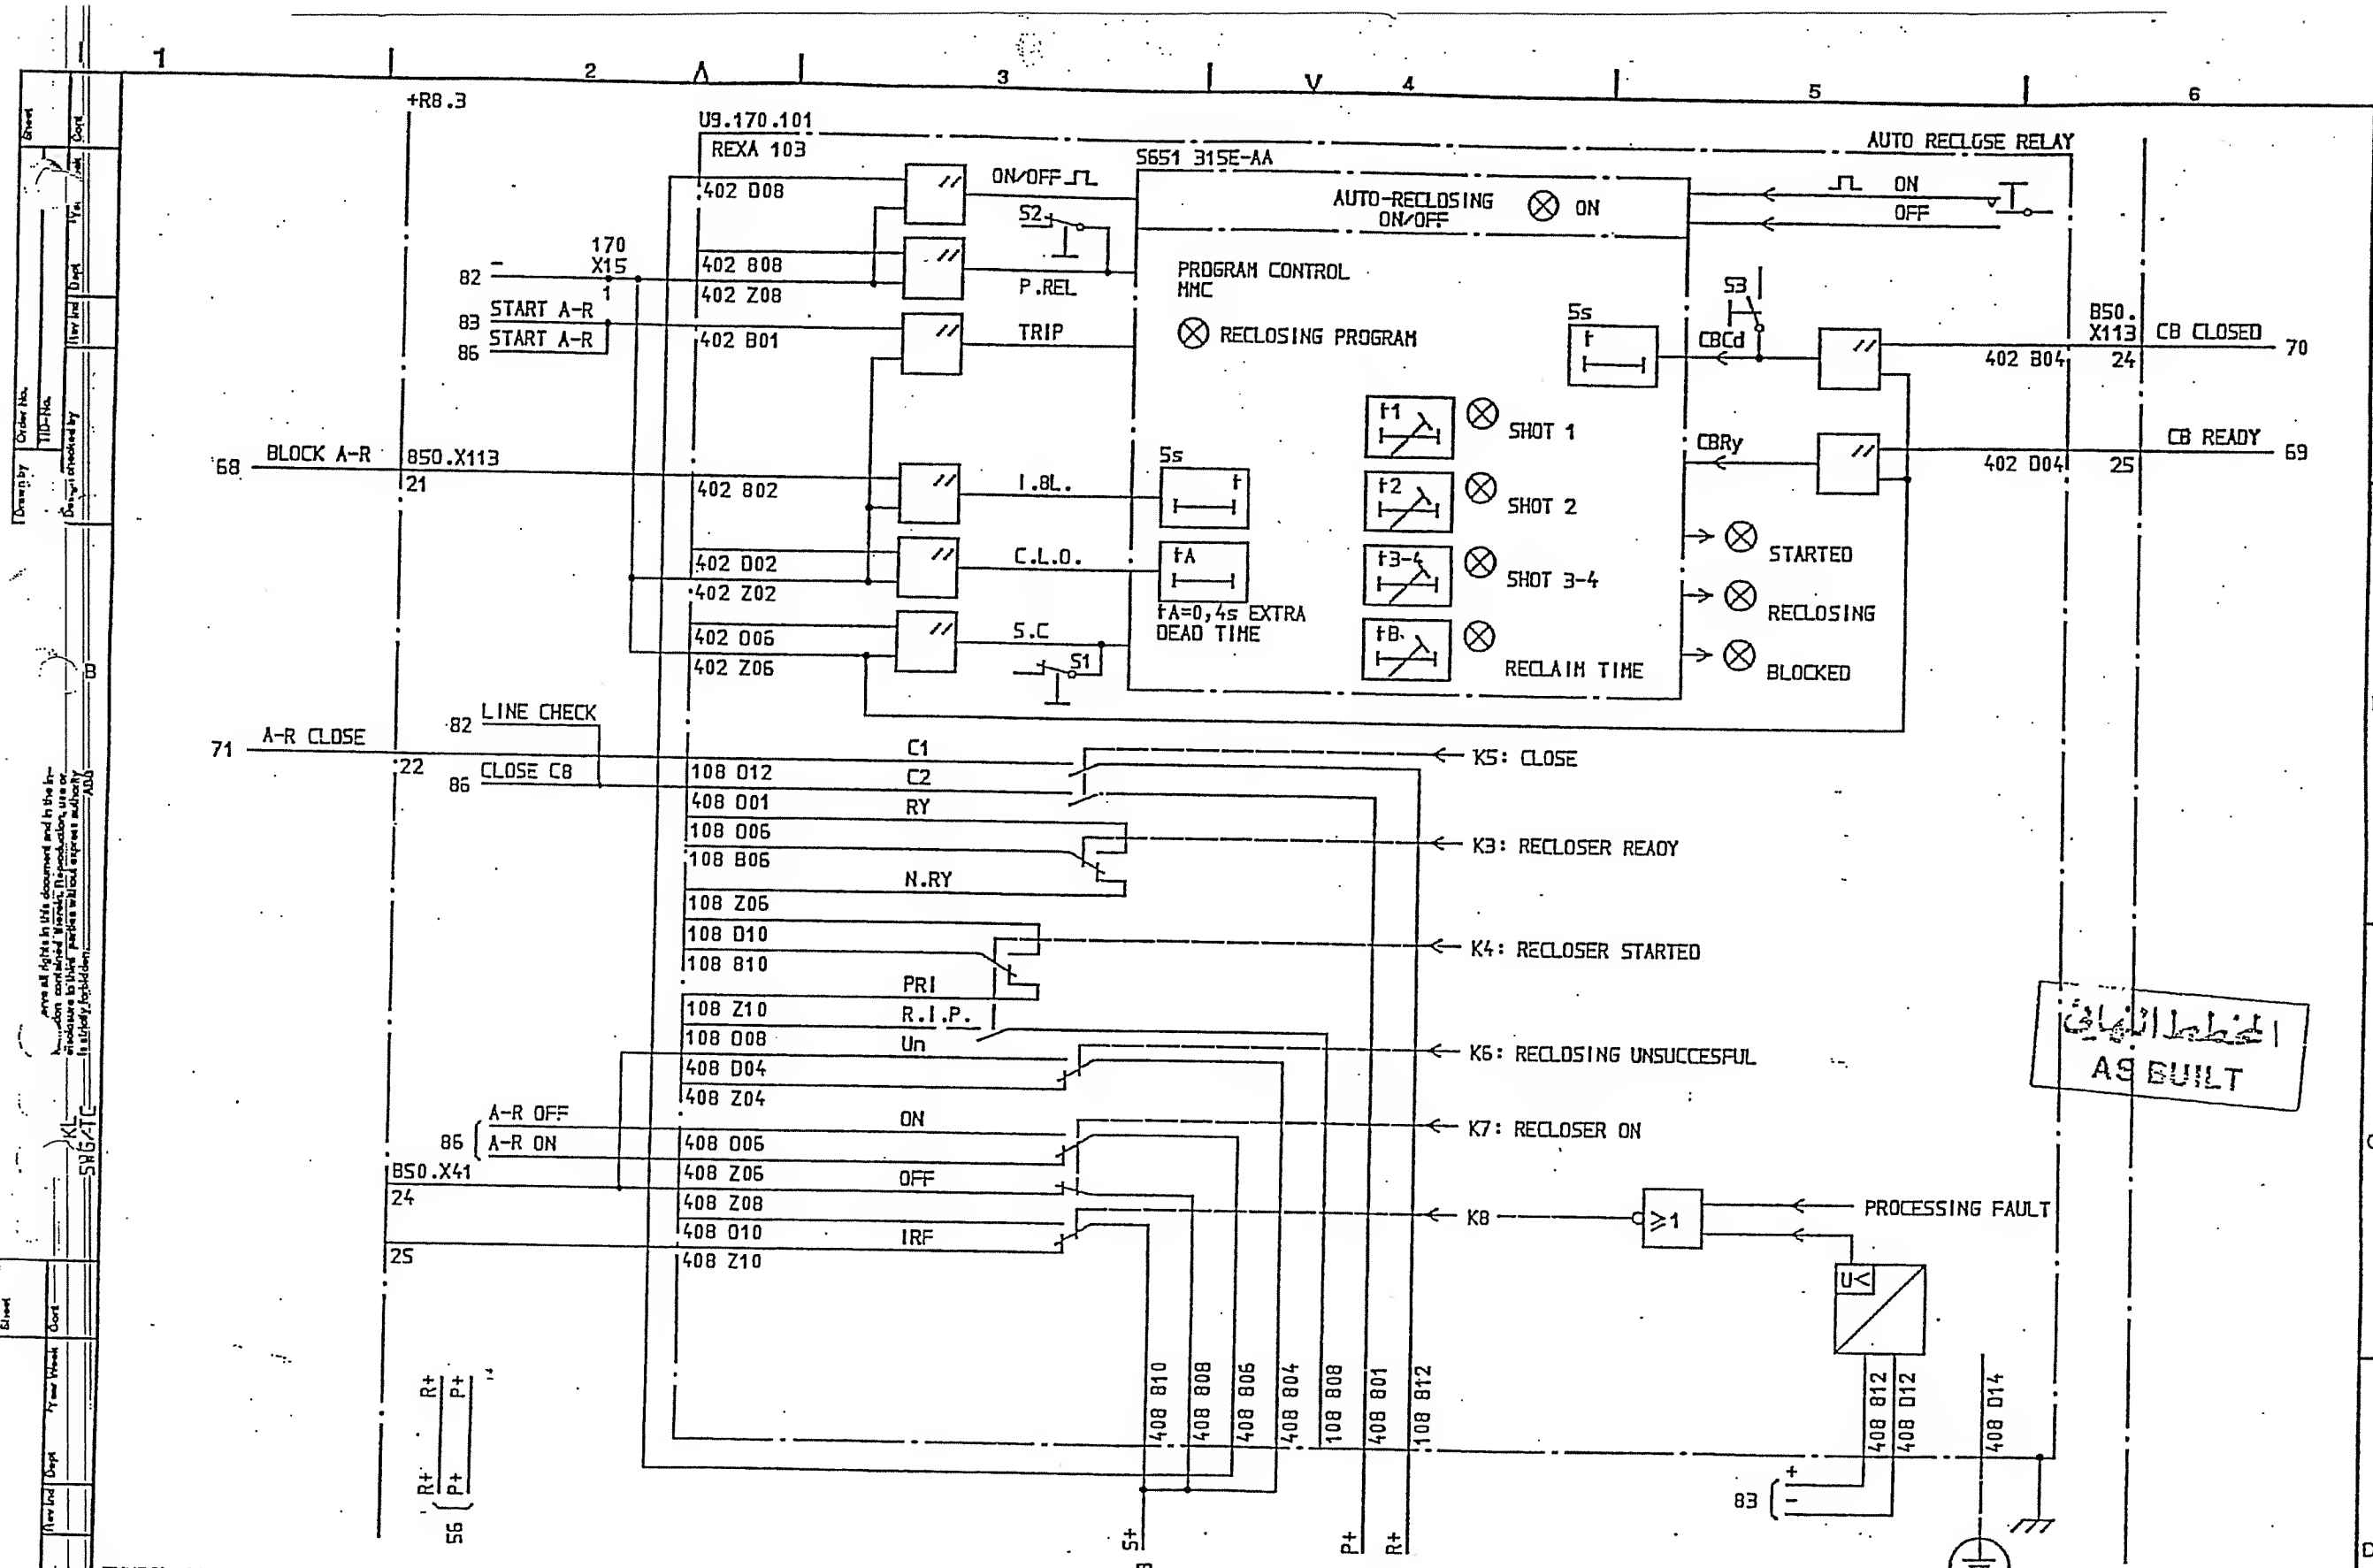31/12/02




المخطط النهائي
AS BUILT

| | | |
|-----------------------------------|--|---------------|
| Design checked by B NILSSON | CIRCUIT DIAGRAM S/S 8501 132/33kV SCECO CENTRAL SAUDI ARABIA | Rev Int Sheet |
| Drawing checked by J SKOVGAARD | ABB HV SWITCHGEAR | Lang Sheet |
| Drawn by IA | Iss by Dept Year Week TDCF 90 16 | Rev Int Sheet |
| | | 1 85 |


L 9743.1017
XL 824 028-FBR

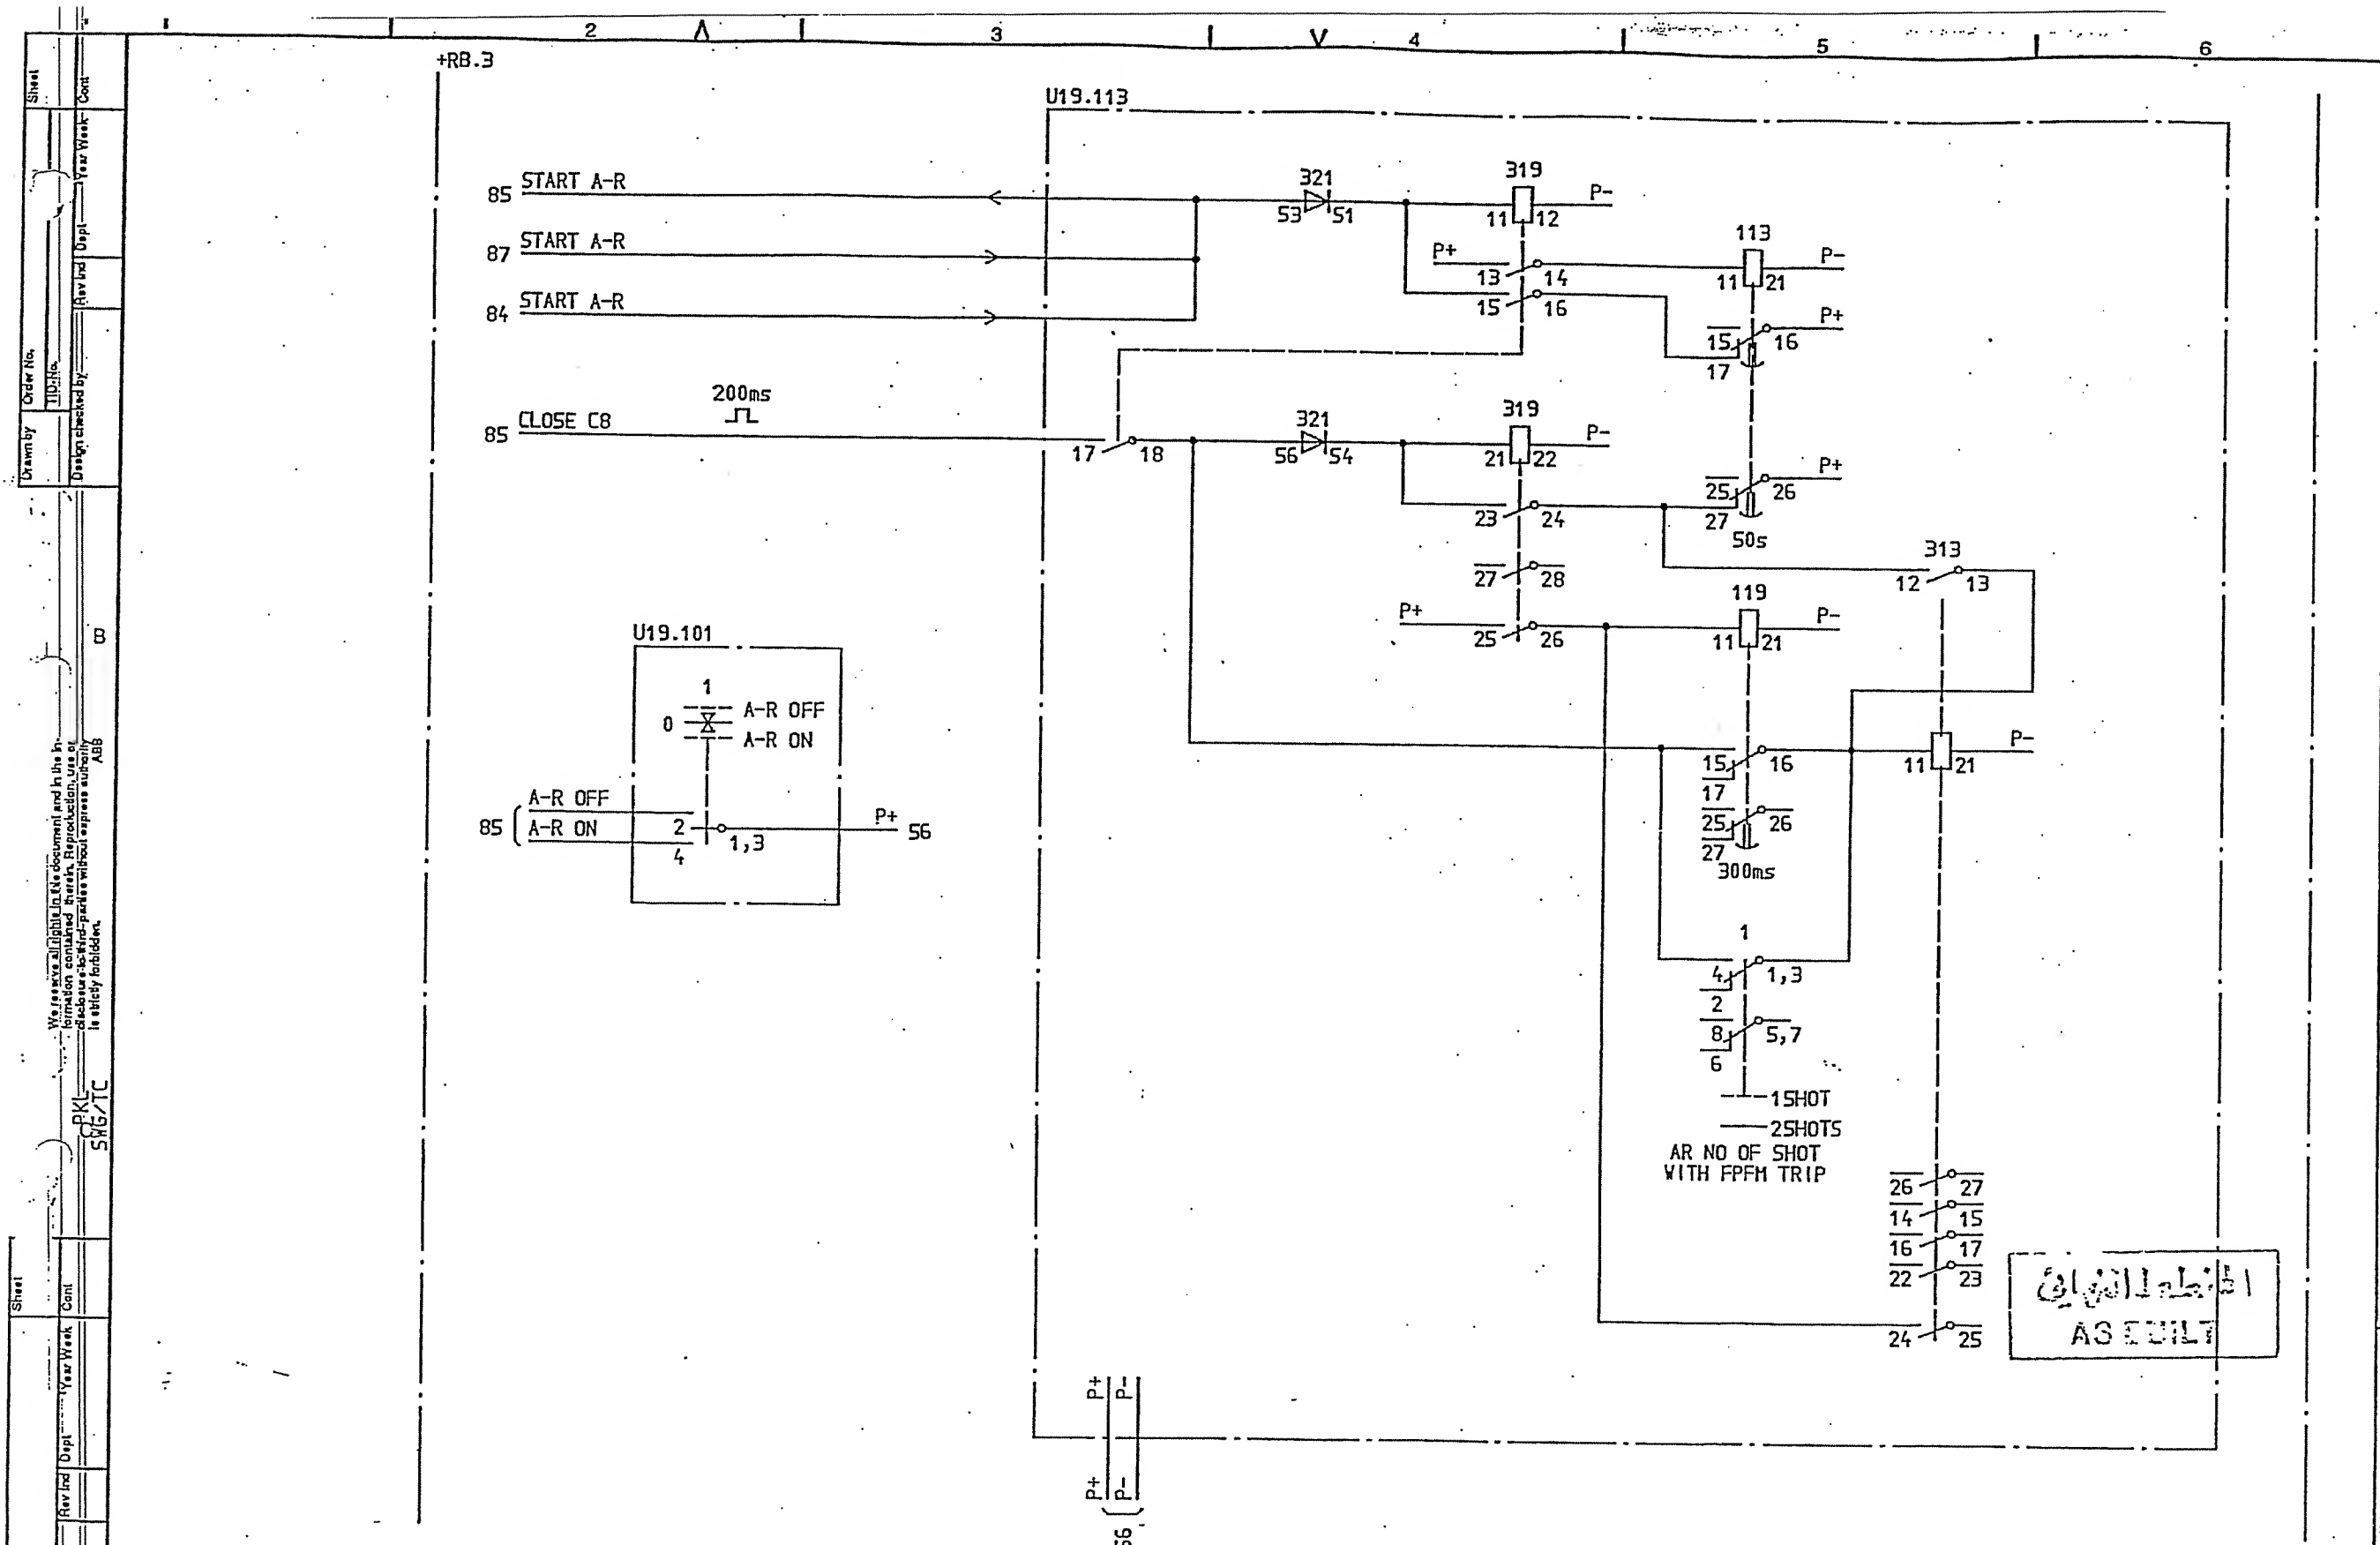
ADD
ADD



| | | | | | | | | | | | | | | | |
|--------------------------------|------------|----------------|-----------|----|-------|--------------------------|--|--------------------|-------------|-------------------|--|----------------------------|-----------|---------------|-------|
| SYMBOL ID /D:XL824028-FBR:86/0 | | 92-07-02 18.52 | | =2 | | 33kV INTERCONNECTOR LINE | | CIRCUIT DIAGRAM | | S/S 8501 132/33kV | | SCECO CENTRAL SAUDI ARABIA | | Rev Ind Sheet | |
| 2 | SCECO SNAG | LS | 92 26 | LS | 92 26 | AUTO RECLOSE RELAY LOGIC | | Design checked by | B NILSSON | ABB HV SWITCHGEAR | | Iss by Dept | Year Week | Lung | Sheet |
| 1 | AS BUILT | LS | 91 21 | LS | 91 21 | | | Drawing checked by | J SKOVGAARD | | | TDCF | 90 16 | 86 | 86 |
| | | Appd | Year Week | | | | | Drawn by | IA | | | | | Rev Ind Cont | 87 |

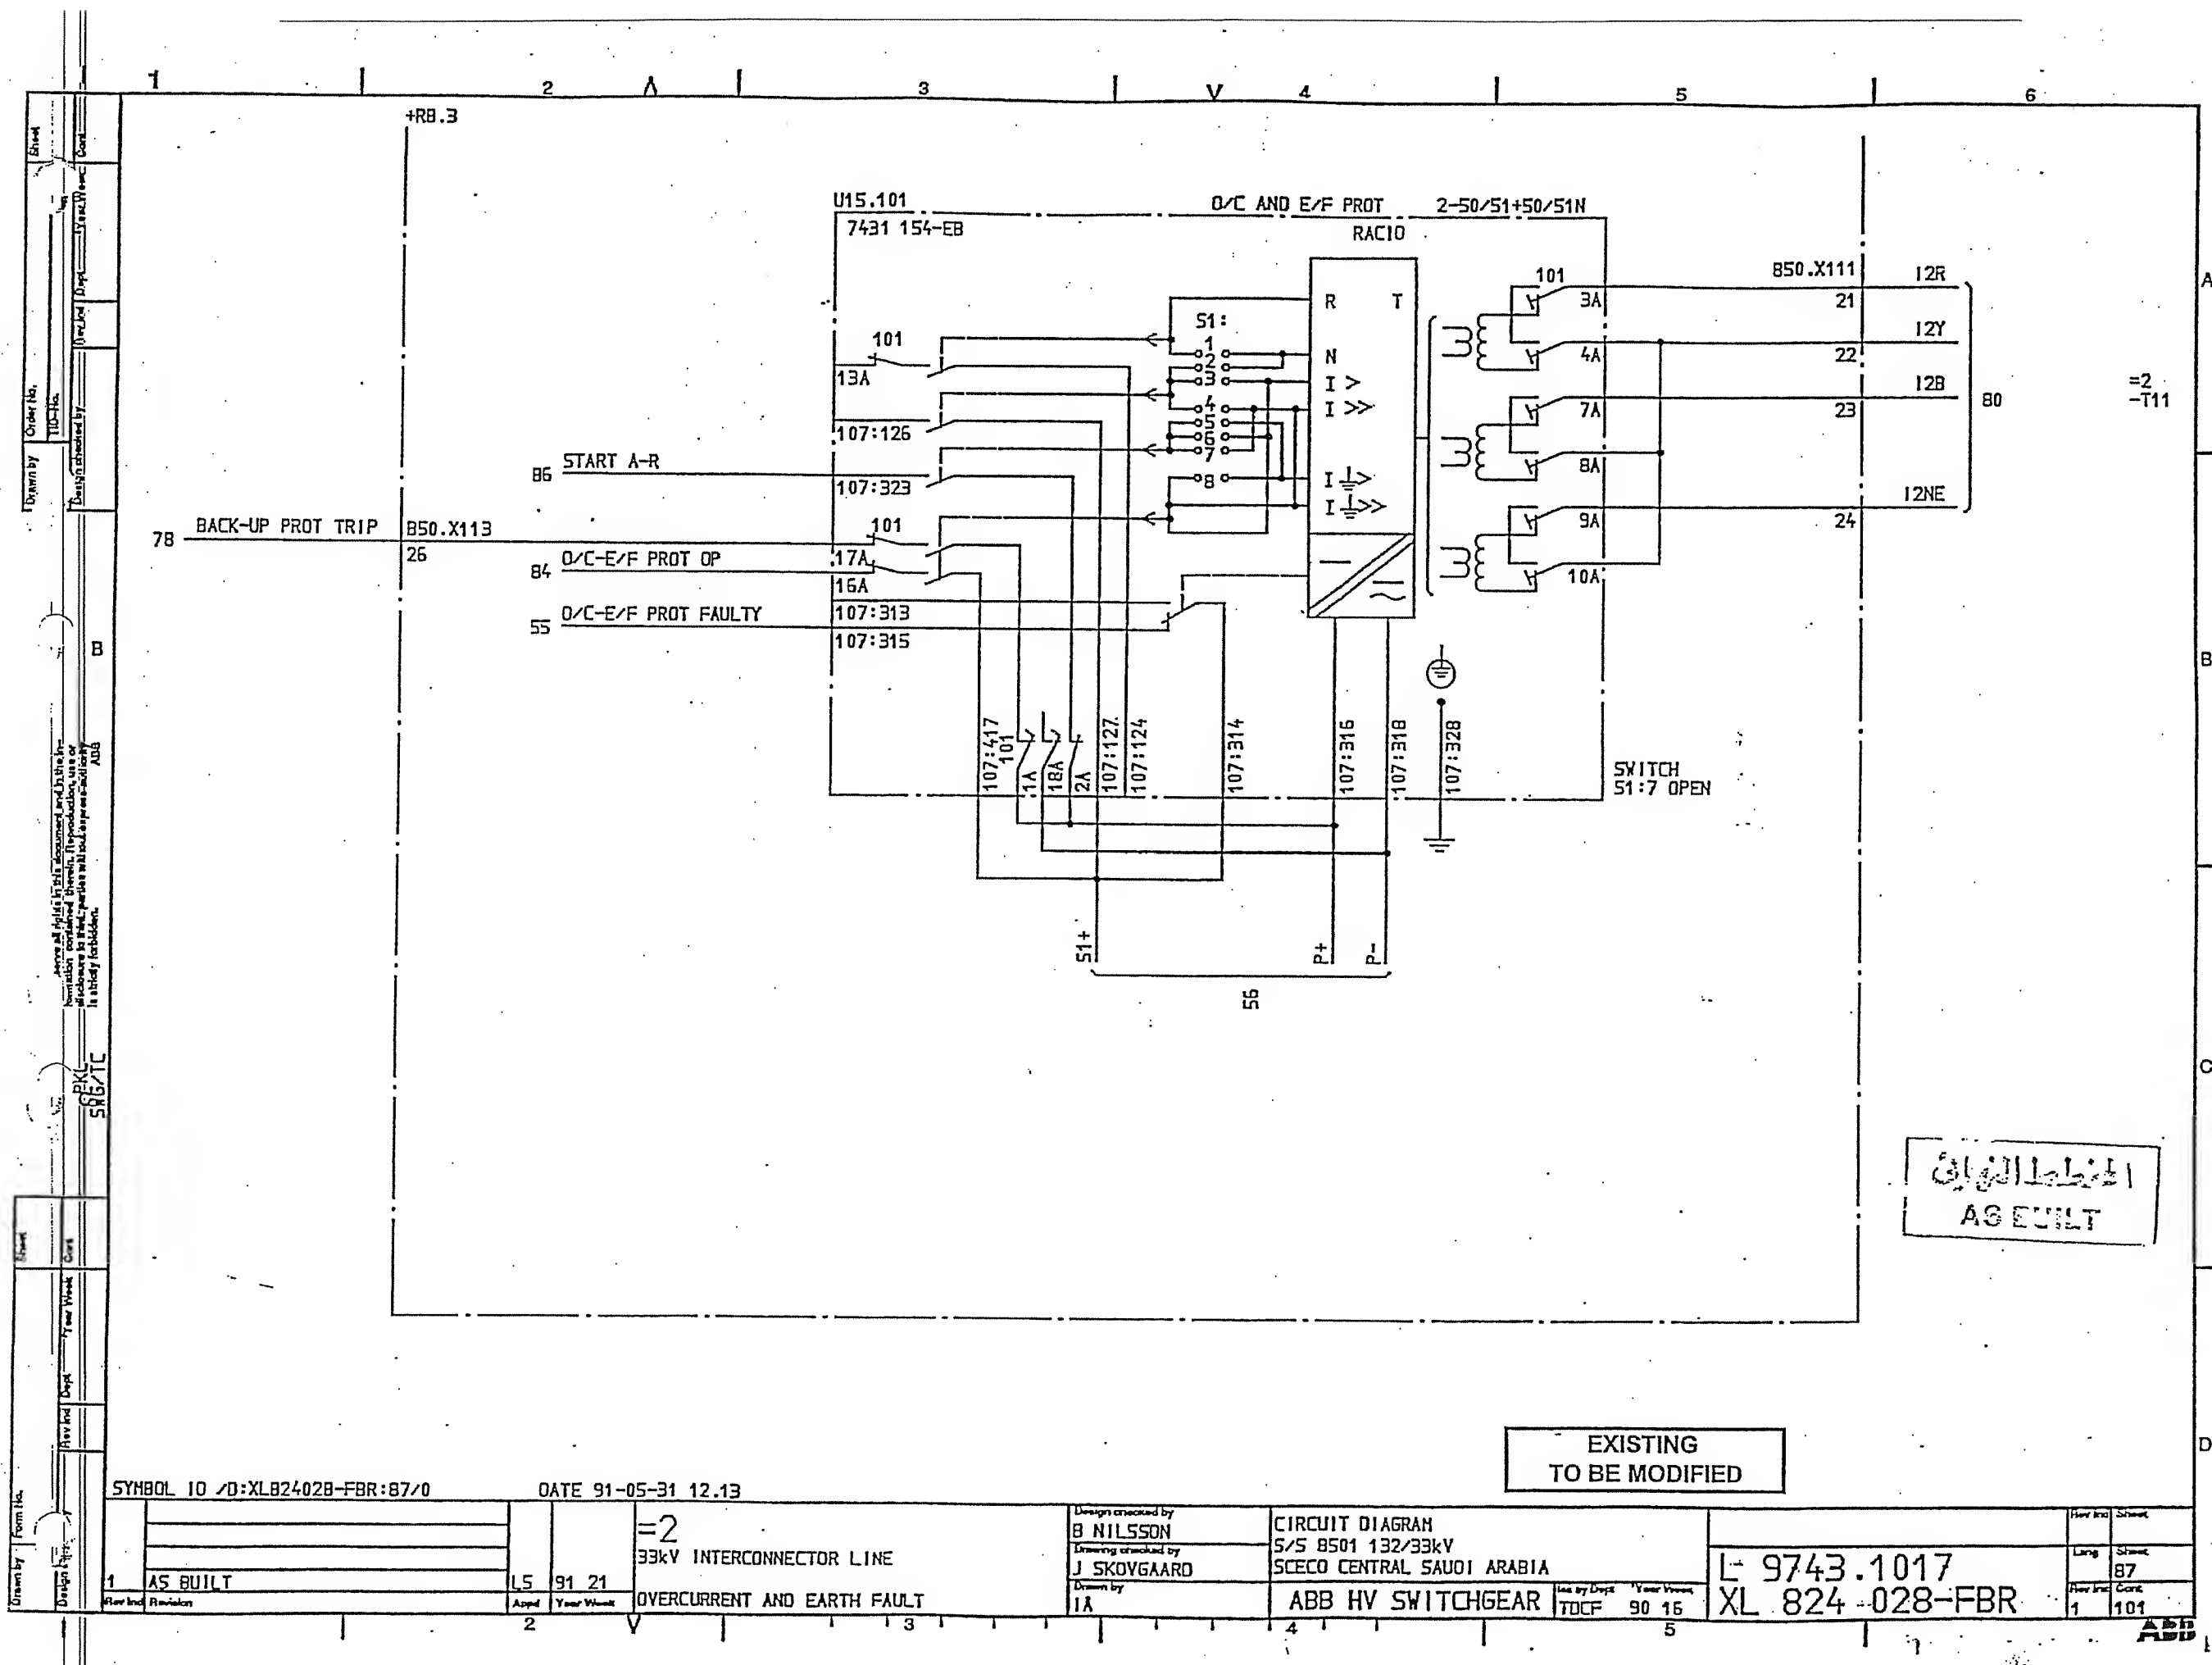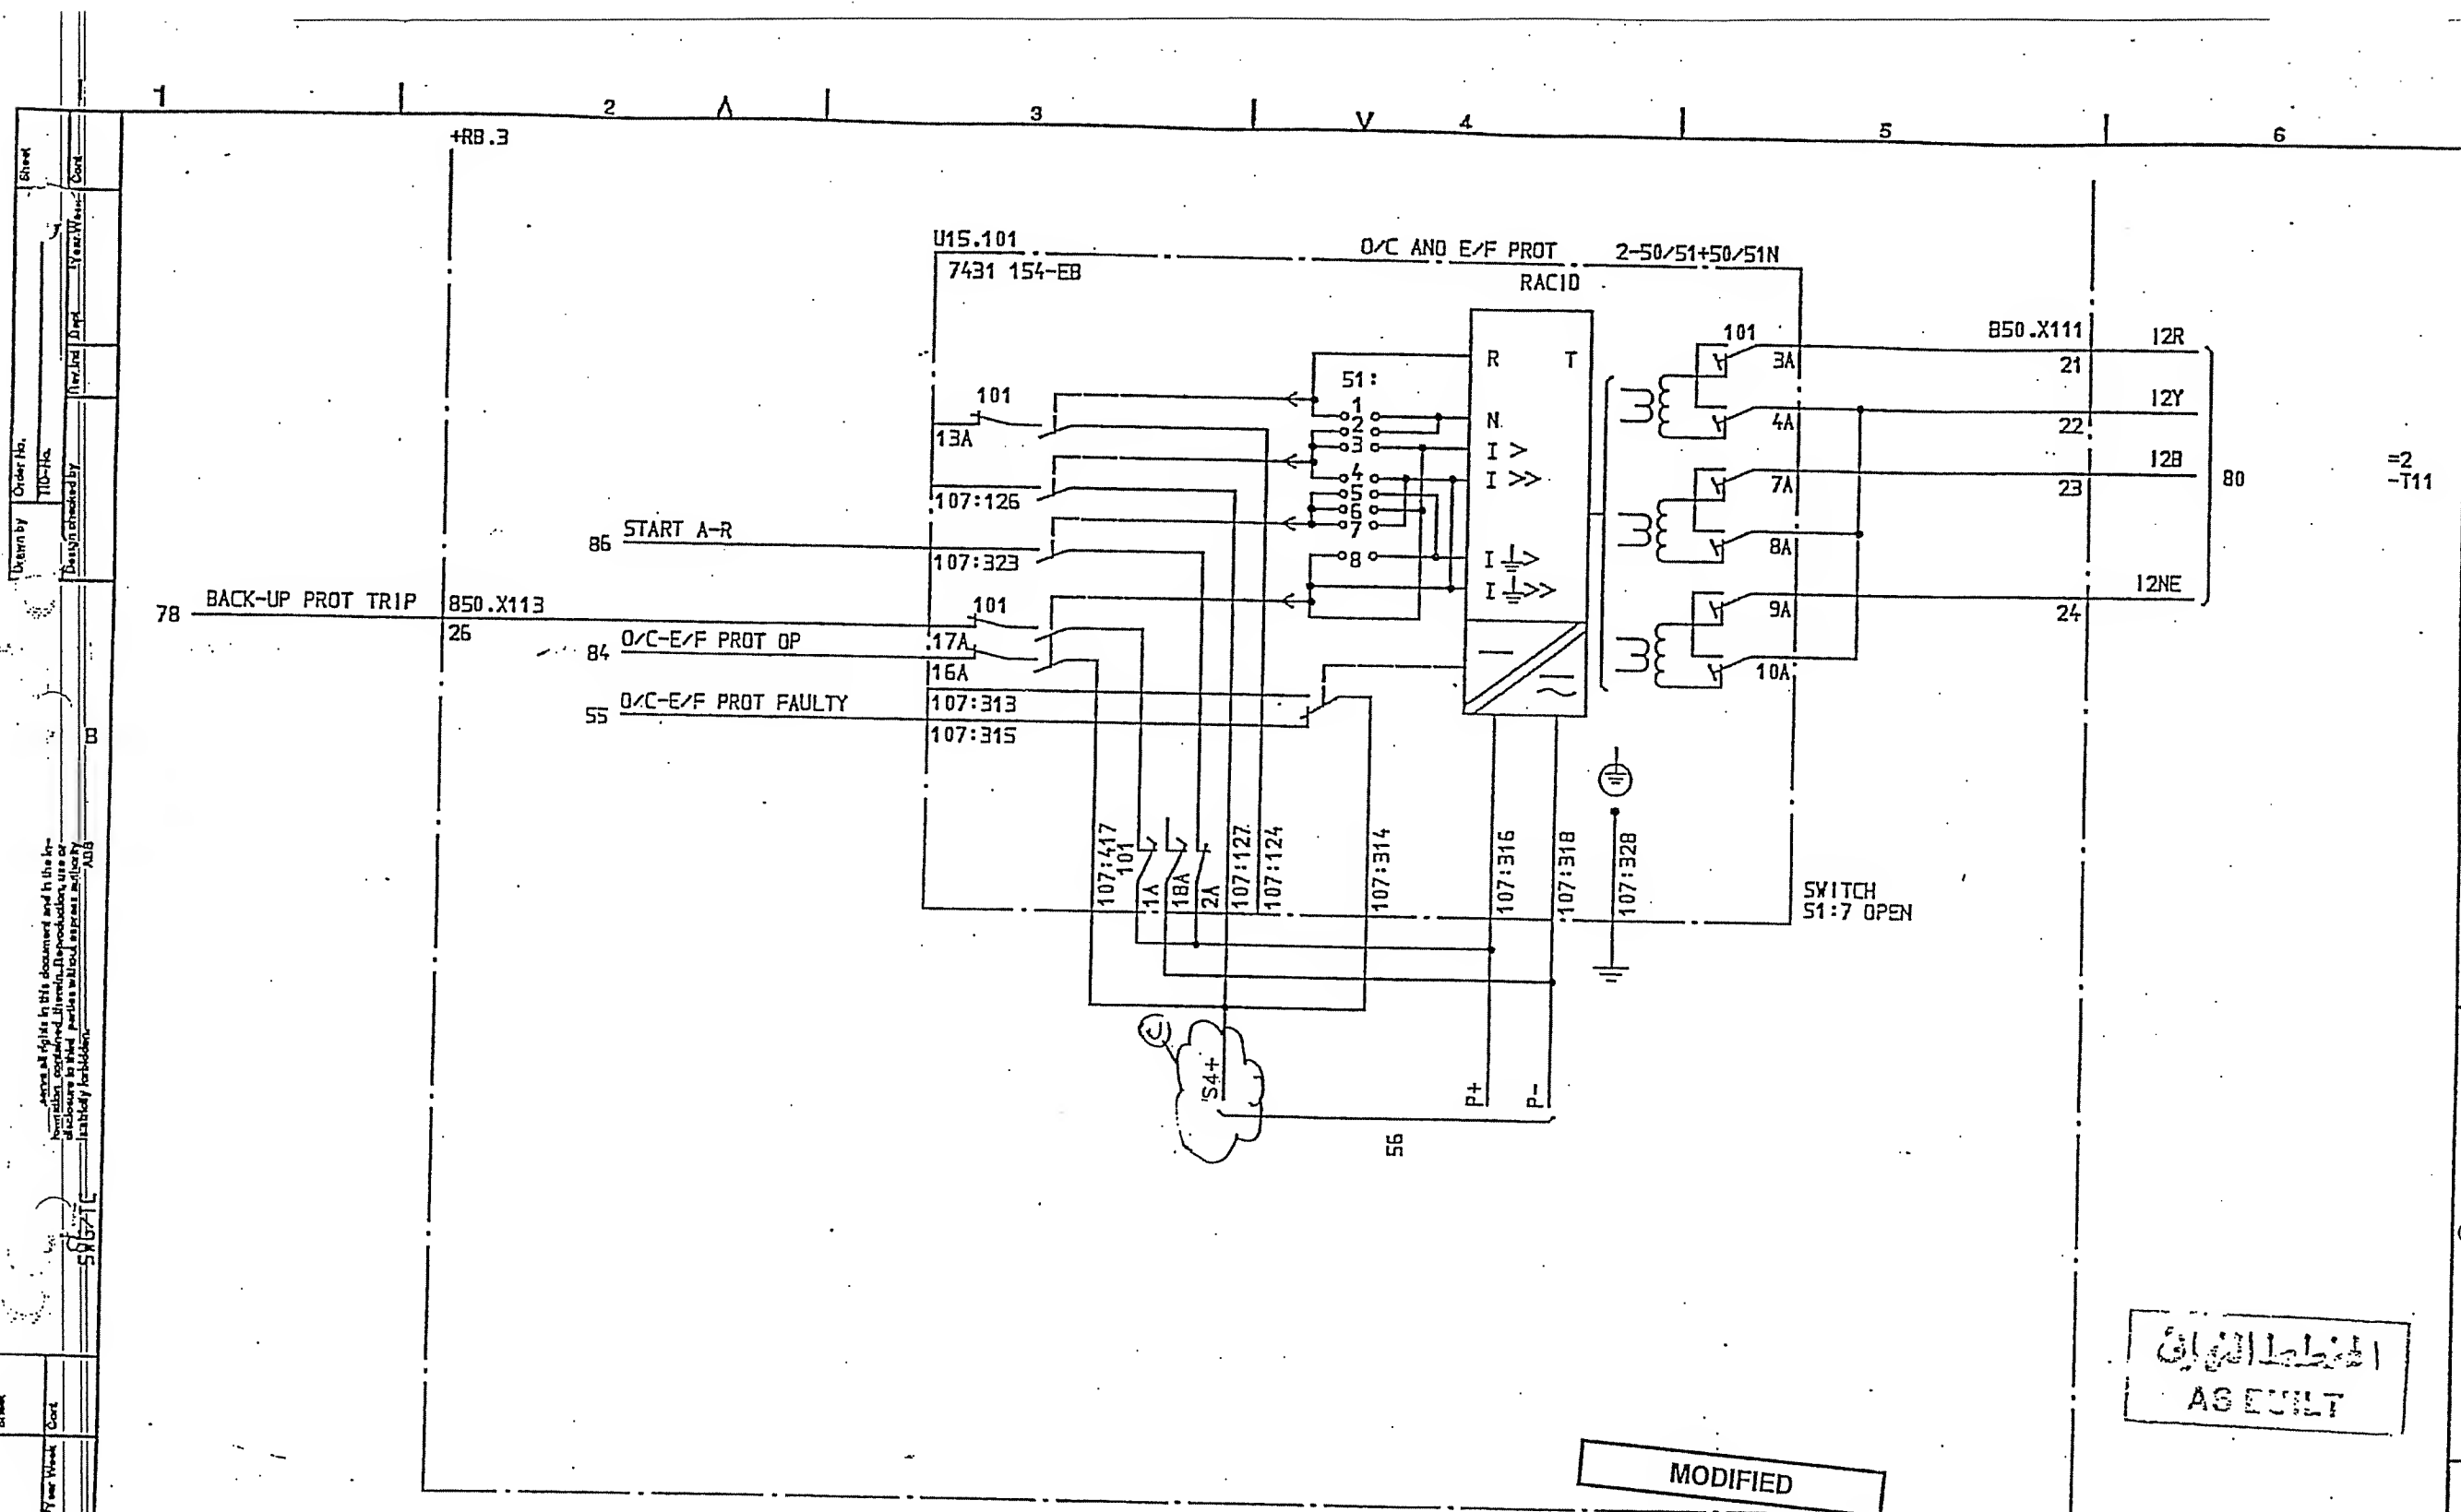الخطبة العامة
ASSEMBLY





الخط الكهربائي
AS EULT

© MODIFICATION DONE
UNDER CONTRACT 516/20/3

31/12/02
P.A.J.

SYMBOL 10 /O:XL824028-FBR:87/0

DATE 91-05-31 12.13

| | | | | |
|-----------------------------|---|---|--|---|
| 1 AS BUILT 15 91 21 2 | =2 33kV INTERCONNECTOR LINE OVERCURRENT AND EARTH FAULT | Design checked by 8 NILSSON Drawing checked by J SKOVGAARD Drawn by 1A | CIRCUIT DIAGRAM 5/5 8501 132/33kV SCECO CENTRAL SAUDI ARABIA ABB HV SWITCHGEAR Use by Dept Year Week TDCF 90 16 | L- 9743.1017 XL 824-028-FBR 1 101 |
|-----------------------------|---|---|--|---|

ABB

| ITEM | DESIGNATION | SHEET |
|-------|-------------------------------------|---------|
| +KA.1 | VOLTAGE DISTRIBUTION | 107 |
| +XA.1 | SCADA INTERFACE EQUIPMENT | 112 |
| +HA.3 | AUX. VOLTAGE SUPPLY | 115 |
| | HEATING AND LIGHTING | 116 |
| | C.B. OPERATION CIRCUITS | 118 |
| -375 | CIRCUIT BREAKER EQUIPMENT | 119 |
| | INTERLOCKING | 123 |
| -371 | EARTH SWITCH EQUIPMENT | 124 |
| | OVERCURRENT PROT. | 128 |
| -T30 | CURRENT TRANSFORMER | 130 |
| -371 | EARTH SWITCH EQUIPMENT | 135 |
| -375 | CIRCUIT BREAKER EQUIPMENT | 140 |
| -305 | CB 305 CLOSING AND TRIPPING CIRCUIT | 141-143 |
| -375 | CB 375 CLOSING AND TRIPPING CIRCUIT | 144-145 |
| -375 | DC SUPPLY LOOPING ±R1 ±R2 | 146-147 |

الخطة النهائية
AS BUILT

SYMBOL ID /D:XL82402B-FBR:101/0

DATE 91-05-31 12.13

| | | | | |
|----------|----------|-------|-----------|---|
| AS BUILT | LS | 91 21 | 3 | 33kV INCOMING TRANSFORMER BAY LIST OF CONTENTS |
| Rev Ind | Revision | Appd | Year Week | |

Design checked by
B NILSSON
Drawing checked by
L SVENSSON
Drawn by
SK

CIRCUIT DIAGRAM
S/S BS01 132/33kV
SCECO CENTRAL SAUDI ARABIA

ABB HV SWITCHGEAR

Iss by Dept Year Week
TDCF 90 36

L 9743.1017
XL 824 028-FBR

| | |
|---------|-------|
| Rev Ind | Sheet |
| 1 | 107 |

| | | |
|-------------------|-----------|-----------|
| Drawn by | Sheet | Order No. |
| Design checked by | Year Week | Year Week |
| Design checked by | Year Week | Year Week |
| Design checked by | Year Week | Year Week |

SYMBOL ID /D:XL924028-FBR:107/0

DATE 91-05-31 12.13

| Rev | Ind | Revision |
|-----|-----|----------|
| 1 | | AS BUILT |

| | | |
|----|-------|---|
| L5 | 91 21 | 33kV INCOMING TRANSFORMER BAY CB OPERATION VOLTAGE DISTRIBUTION |
|----|-------|---|


| | |
|--------------------|-------------|
| Design checked by | B NILSSON |
| Drawing checked by | S STRIDSMAN |
| Drawn by | IA |

| |
|-----------------------------|
| CIRCUIT DIAGRAM |
| S/S 8501 132/33kV |
| SCECO. CENTRAL SAUDI ARABIA |
| ABB HV SWITCHGEAR |

| | | |
|-----|-----|------|
| Rev | Ind | Week |
| 1 | | 107 |


| |
|----------------|
| L 9743.1017 - |
| XL 824 028-FBR |

| | | |
|-----|-----|------|
| Rev | Ind | Week |
| 1 | | 112 |

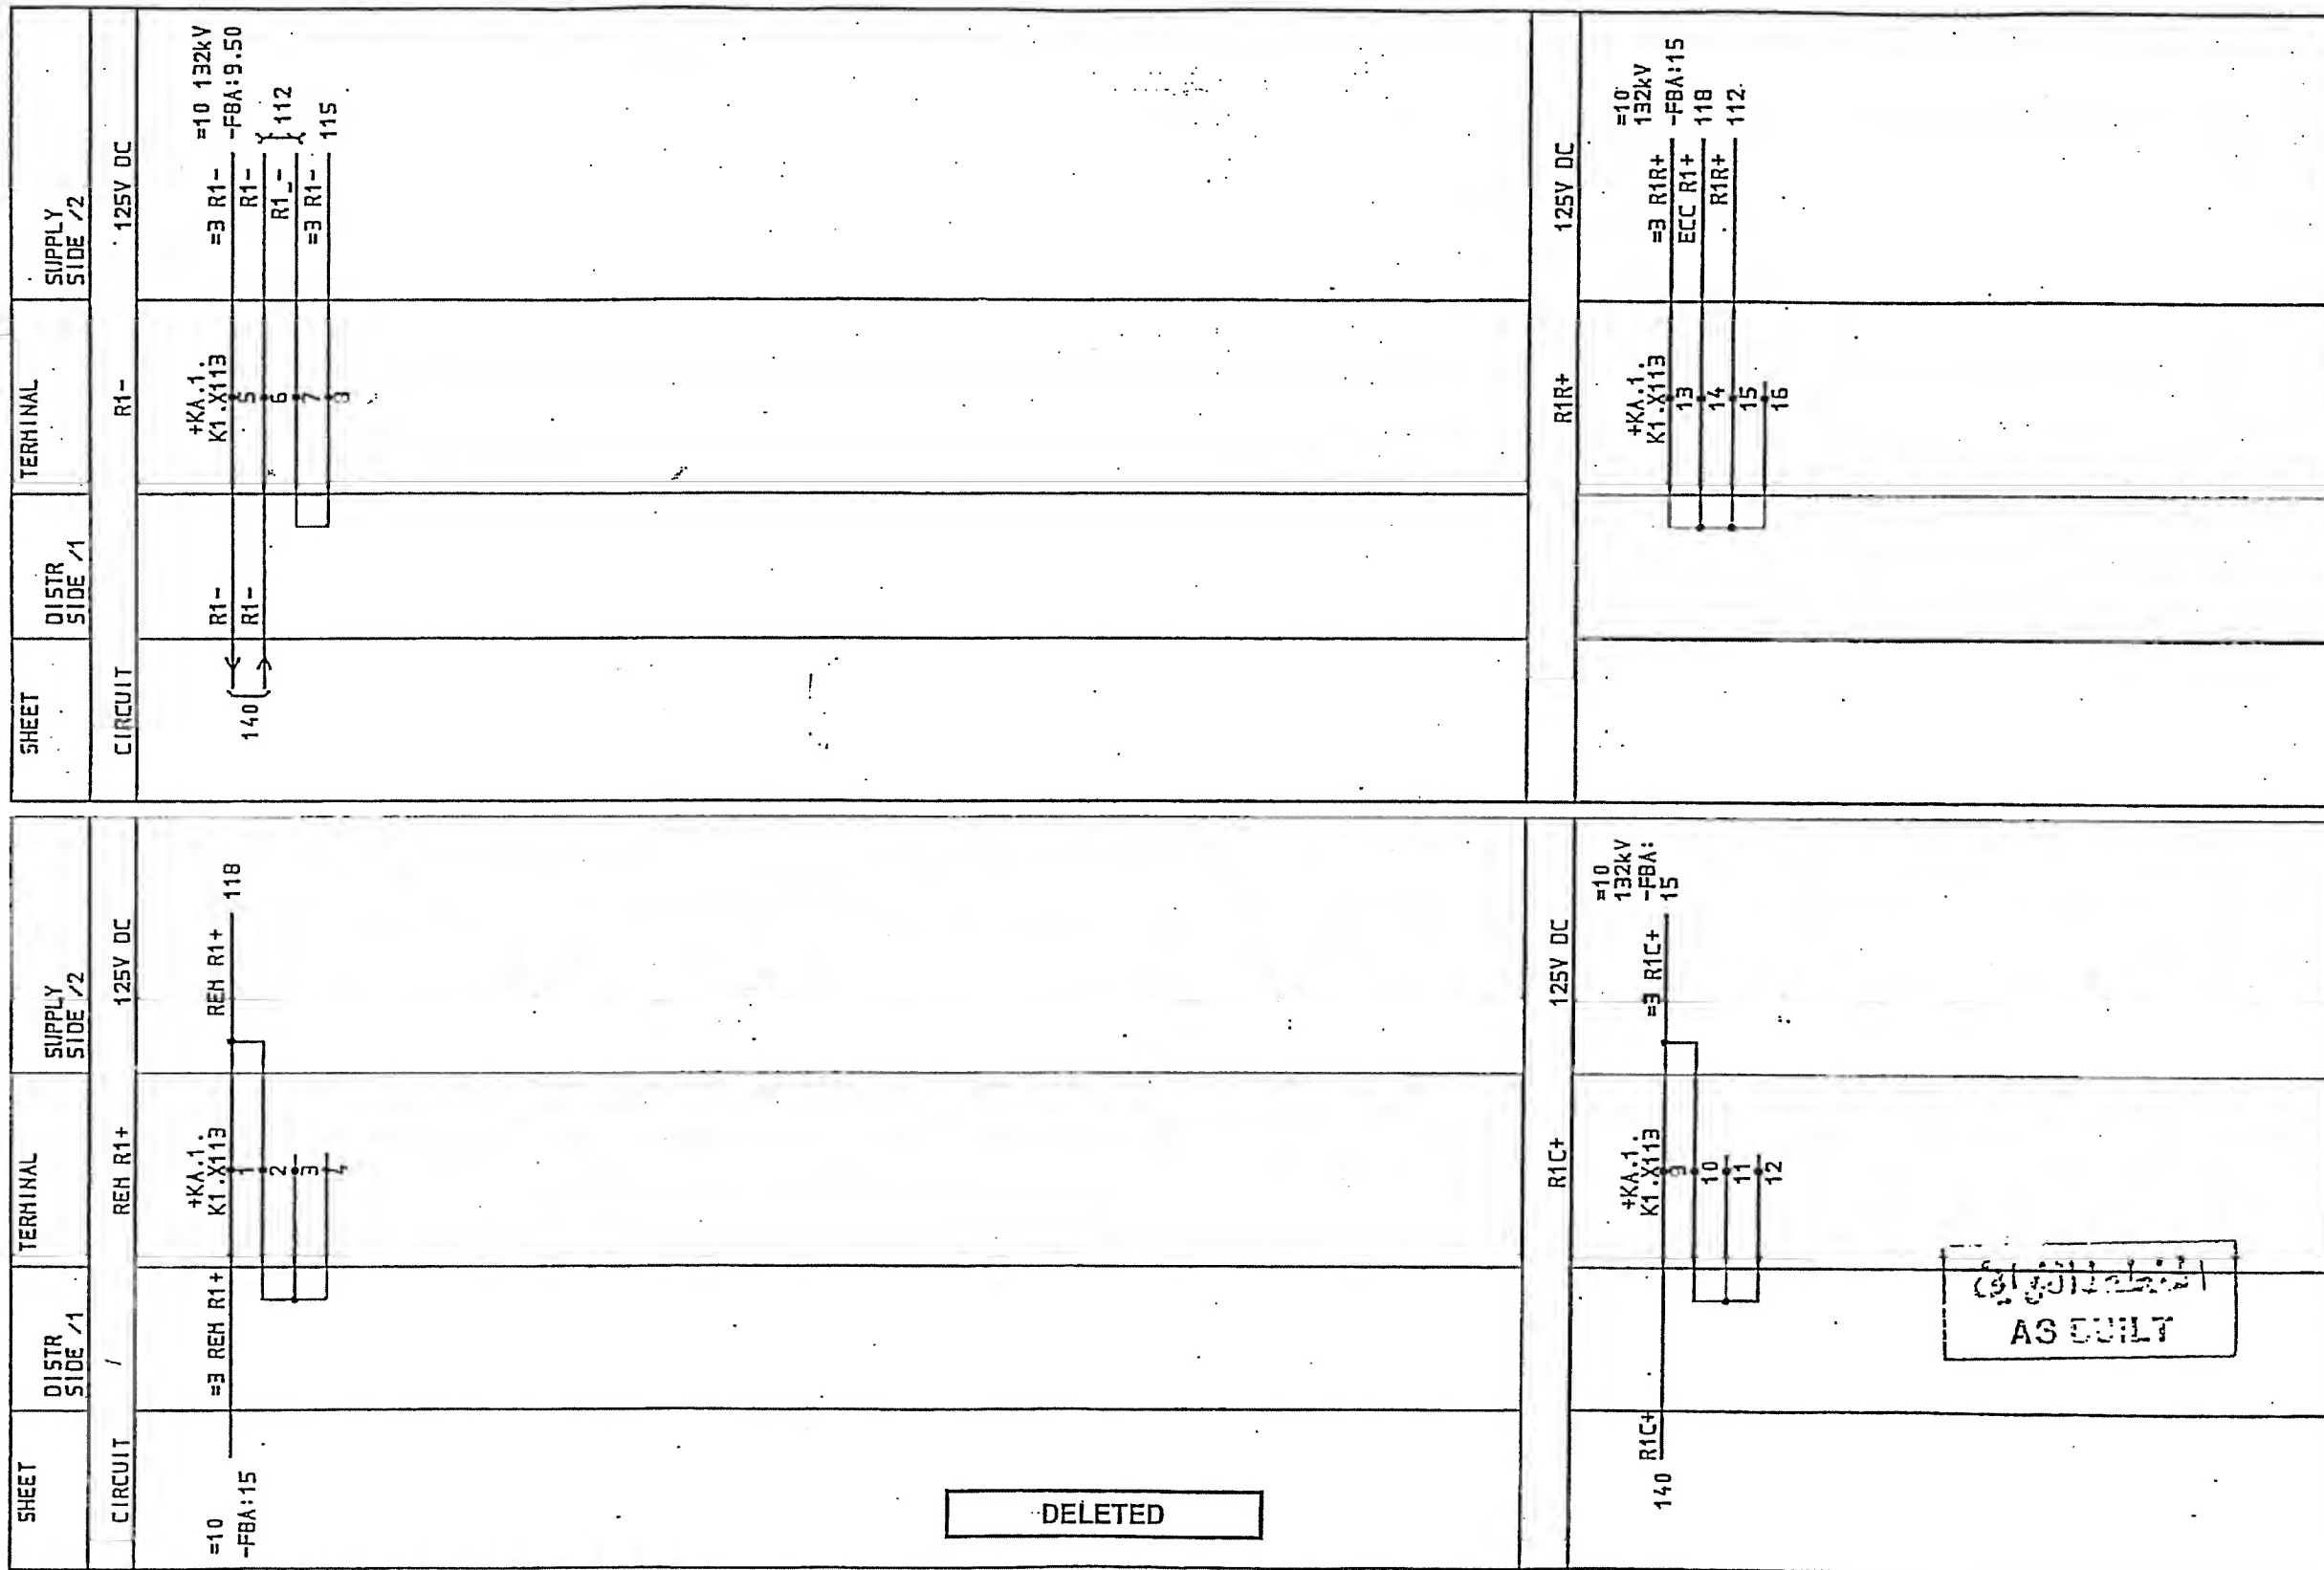

DELETED

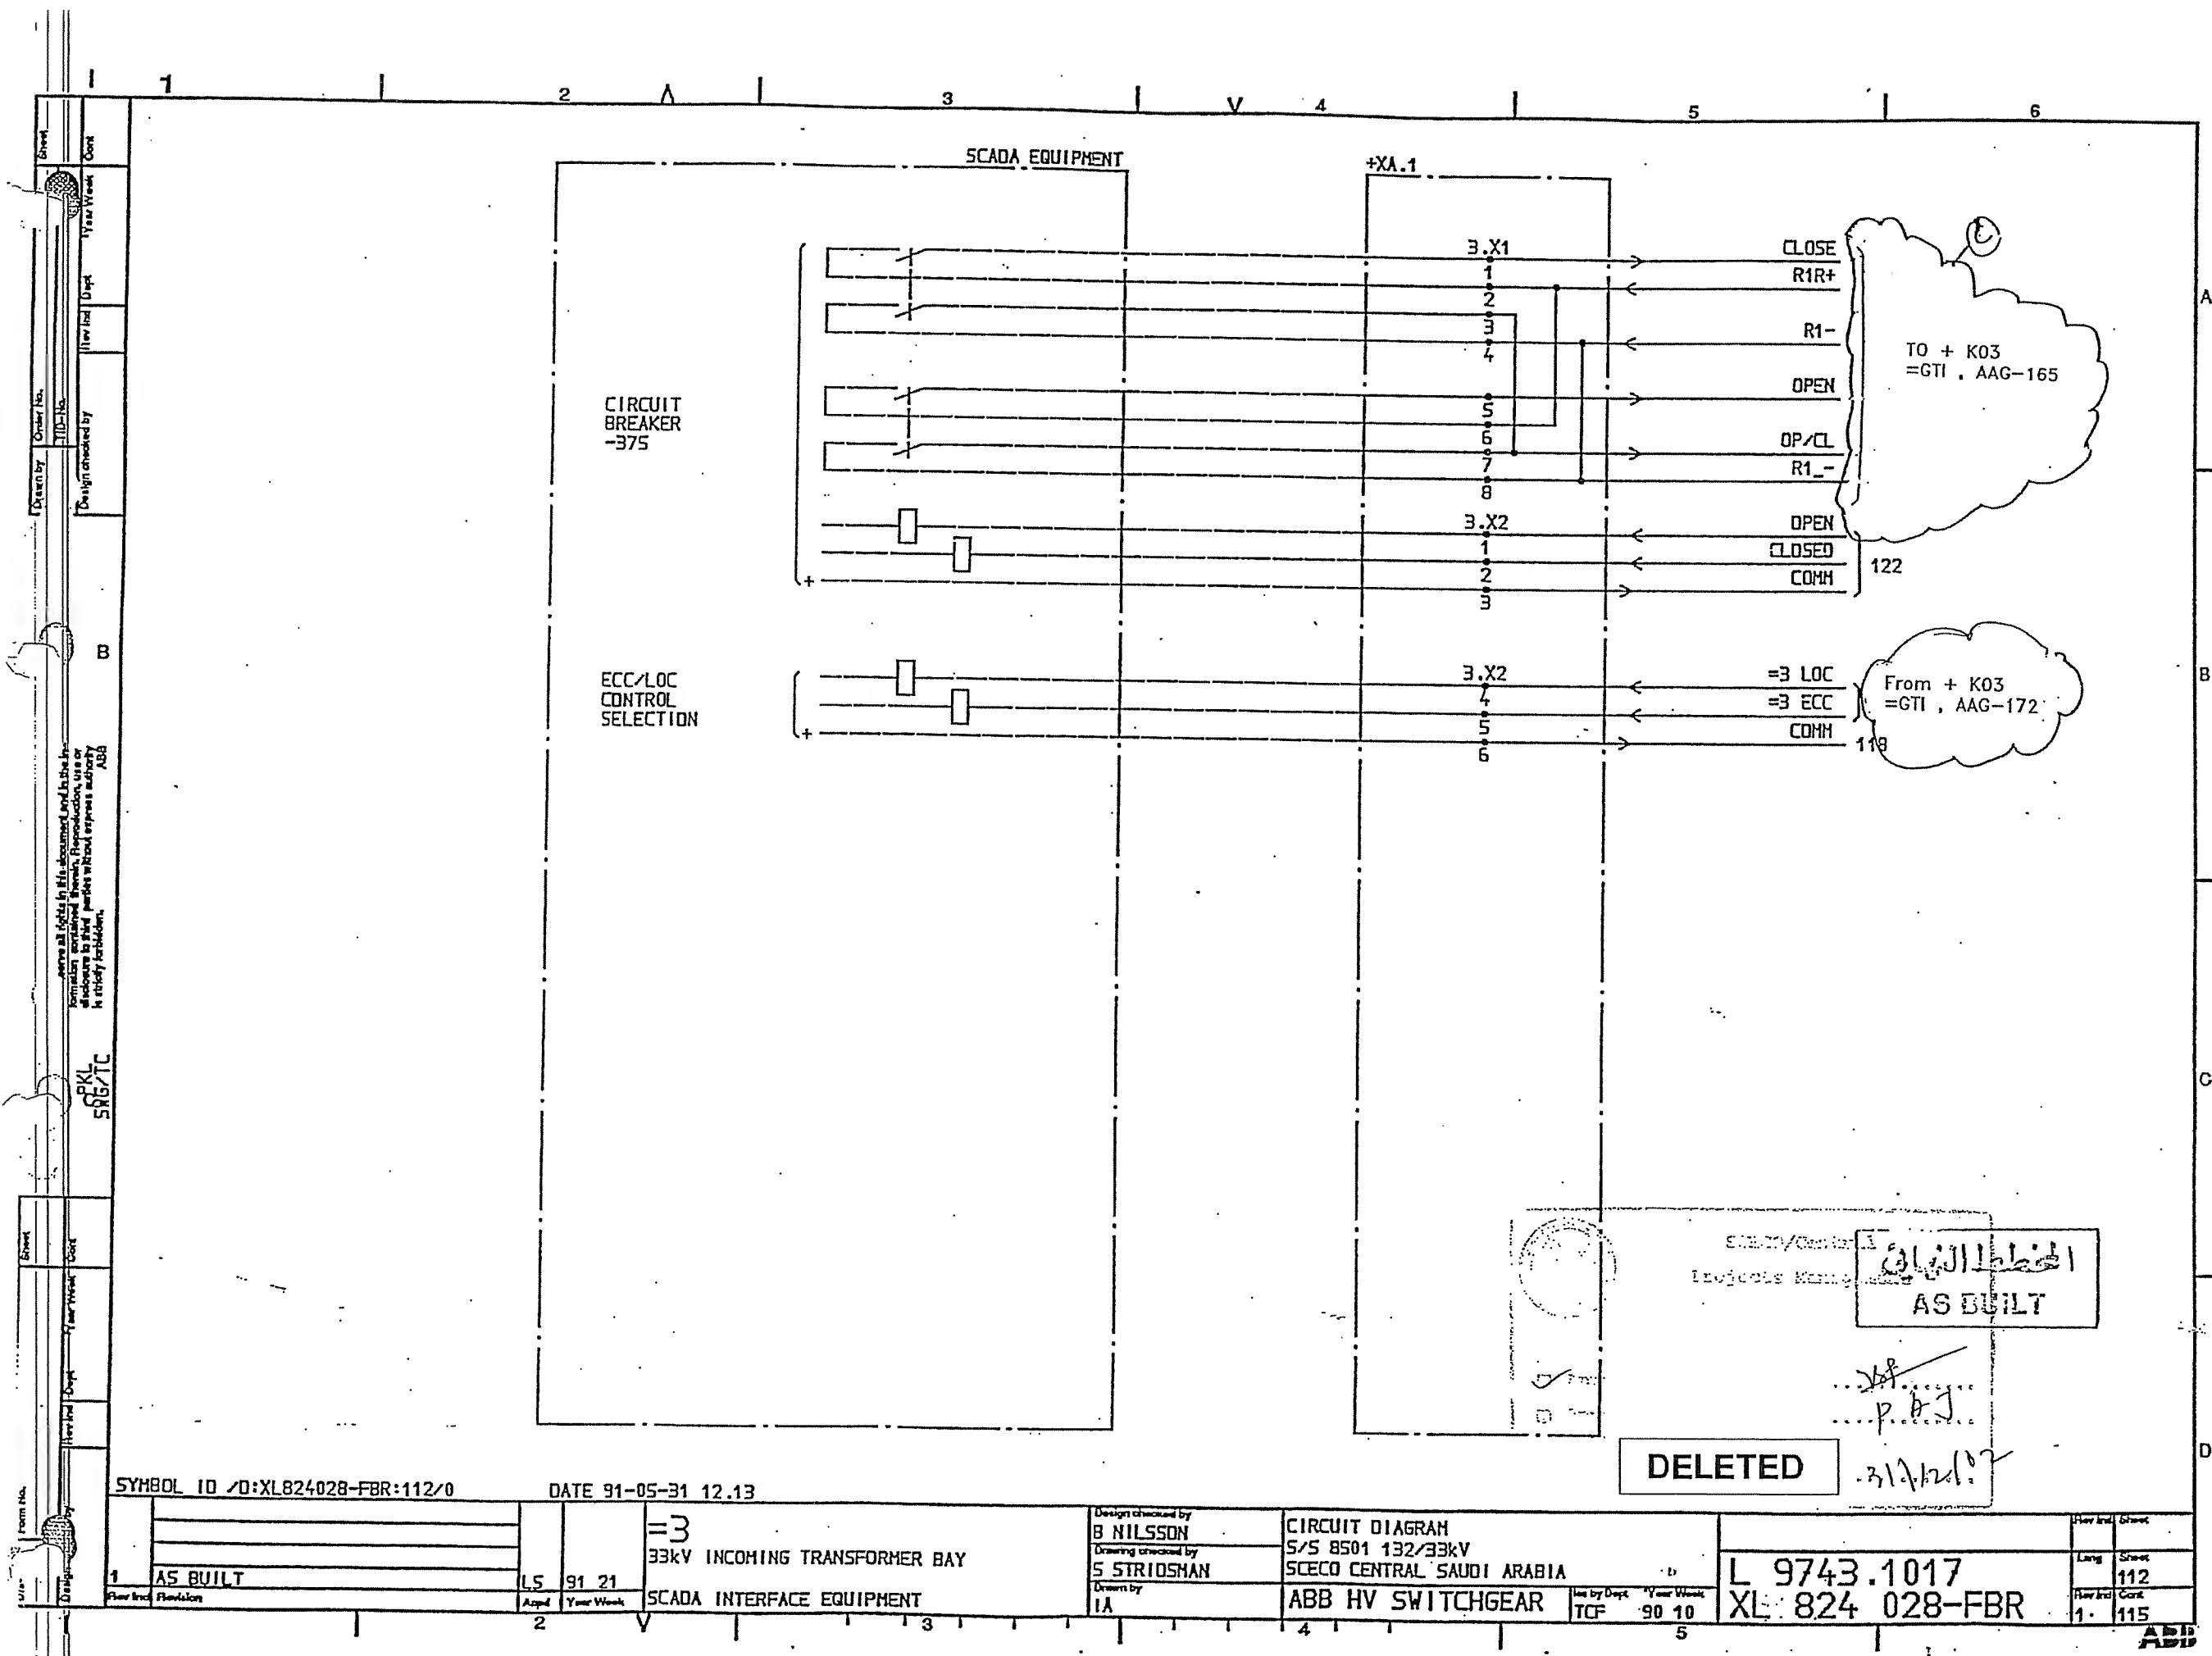AS BUILT



Drawn by: [Signature]
 Design checked by: [Signature]
 Order No. [Blank]
 Drawn by: [Signature]
 Design checked by: [Signature]
 Order No. [Blank]
 Drawn by: [Signature]
 Design checked by: [Signature]
 Order No. [Blank]

SYMBOL ID /D:XL824028-FBR:112/0

DATE 91-05-31 12.13

| | | | | |
|---|----------|------|-----------|-------------------------------|
| 1 | AS BUILT | LS | 91 21 | 33kV INCOMING TRANSFORMER BAY |
| 2 | | Aspd | Year Week | SCADA INTERFACE EQUIPMENT |

Design checked by
 B NILSSON
 Drawing checked by
 S STRIDSHAN
 Drawn by
 IA

CIRCUIT DIAGRAM
 S/S 8501 132/33kV
 SCECO CENTRAL SAUDI ARABIA
 ABB HV SWITCHGEAR

Iss by Dept
 TCF
 Year Week
 90 10

L 9743.1017
 XL 824 028-FBR


| | | |
|-----|-----|-------|
| Rev | Int | Sheet |
| 1 | 1 | 112 |
| 1 | 1 | 115 |


DELETED

المخطط النهائي
 AS BUILT

[Signature]
 P. H. J.
 31/12/97

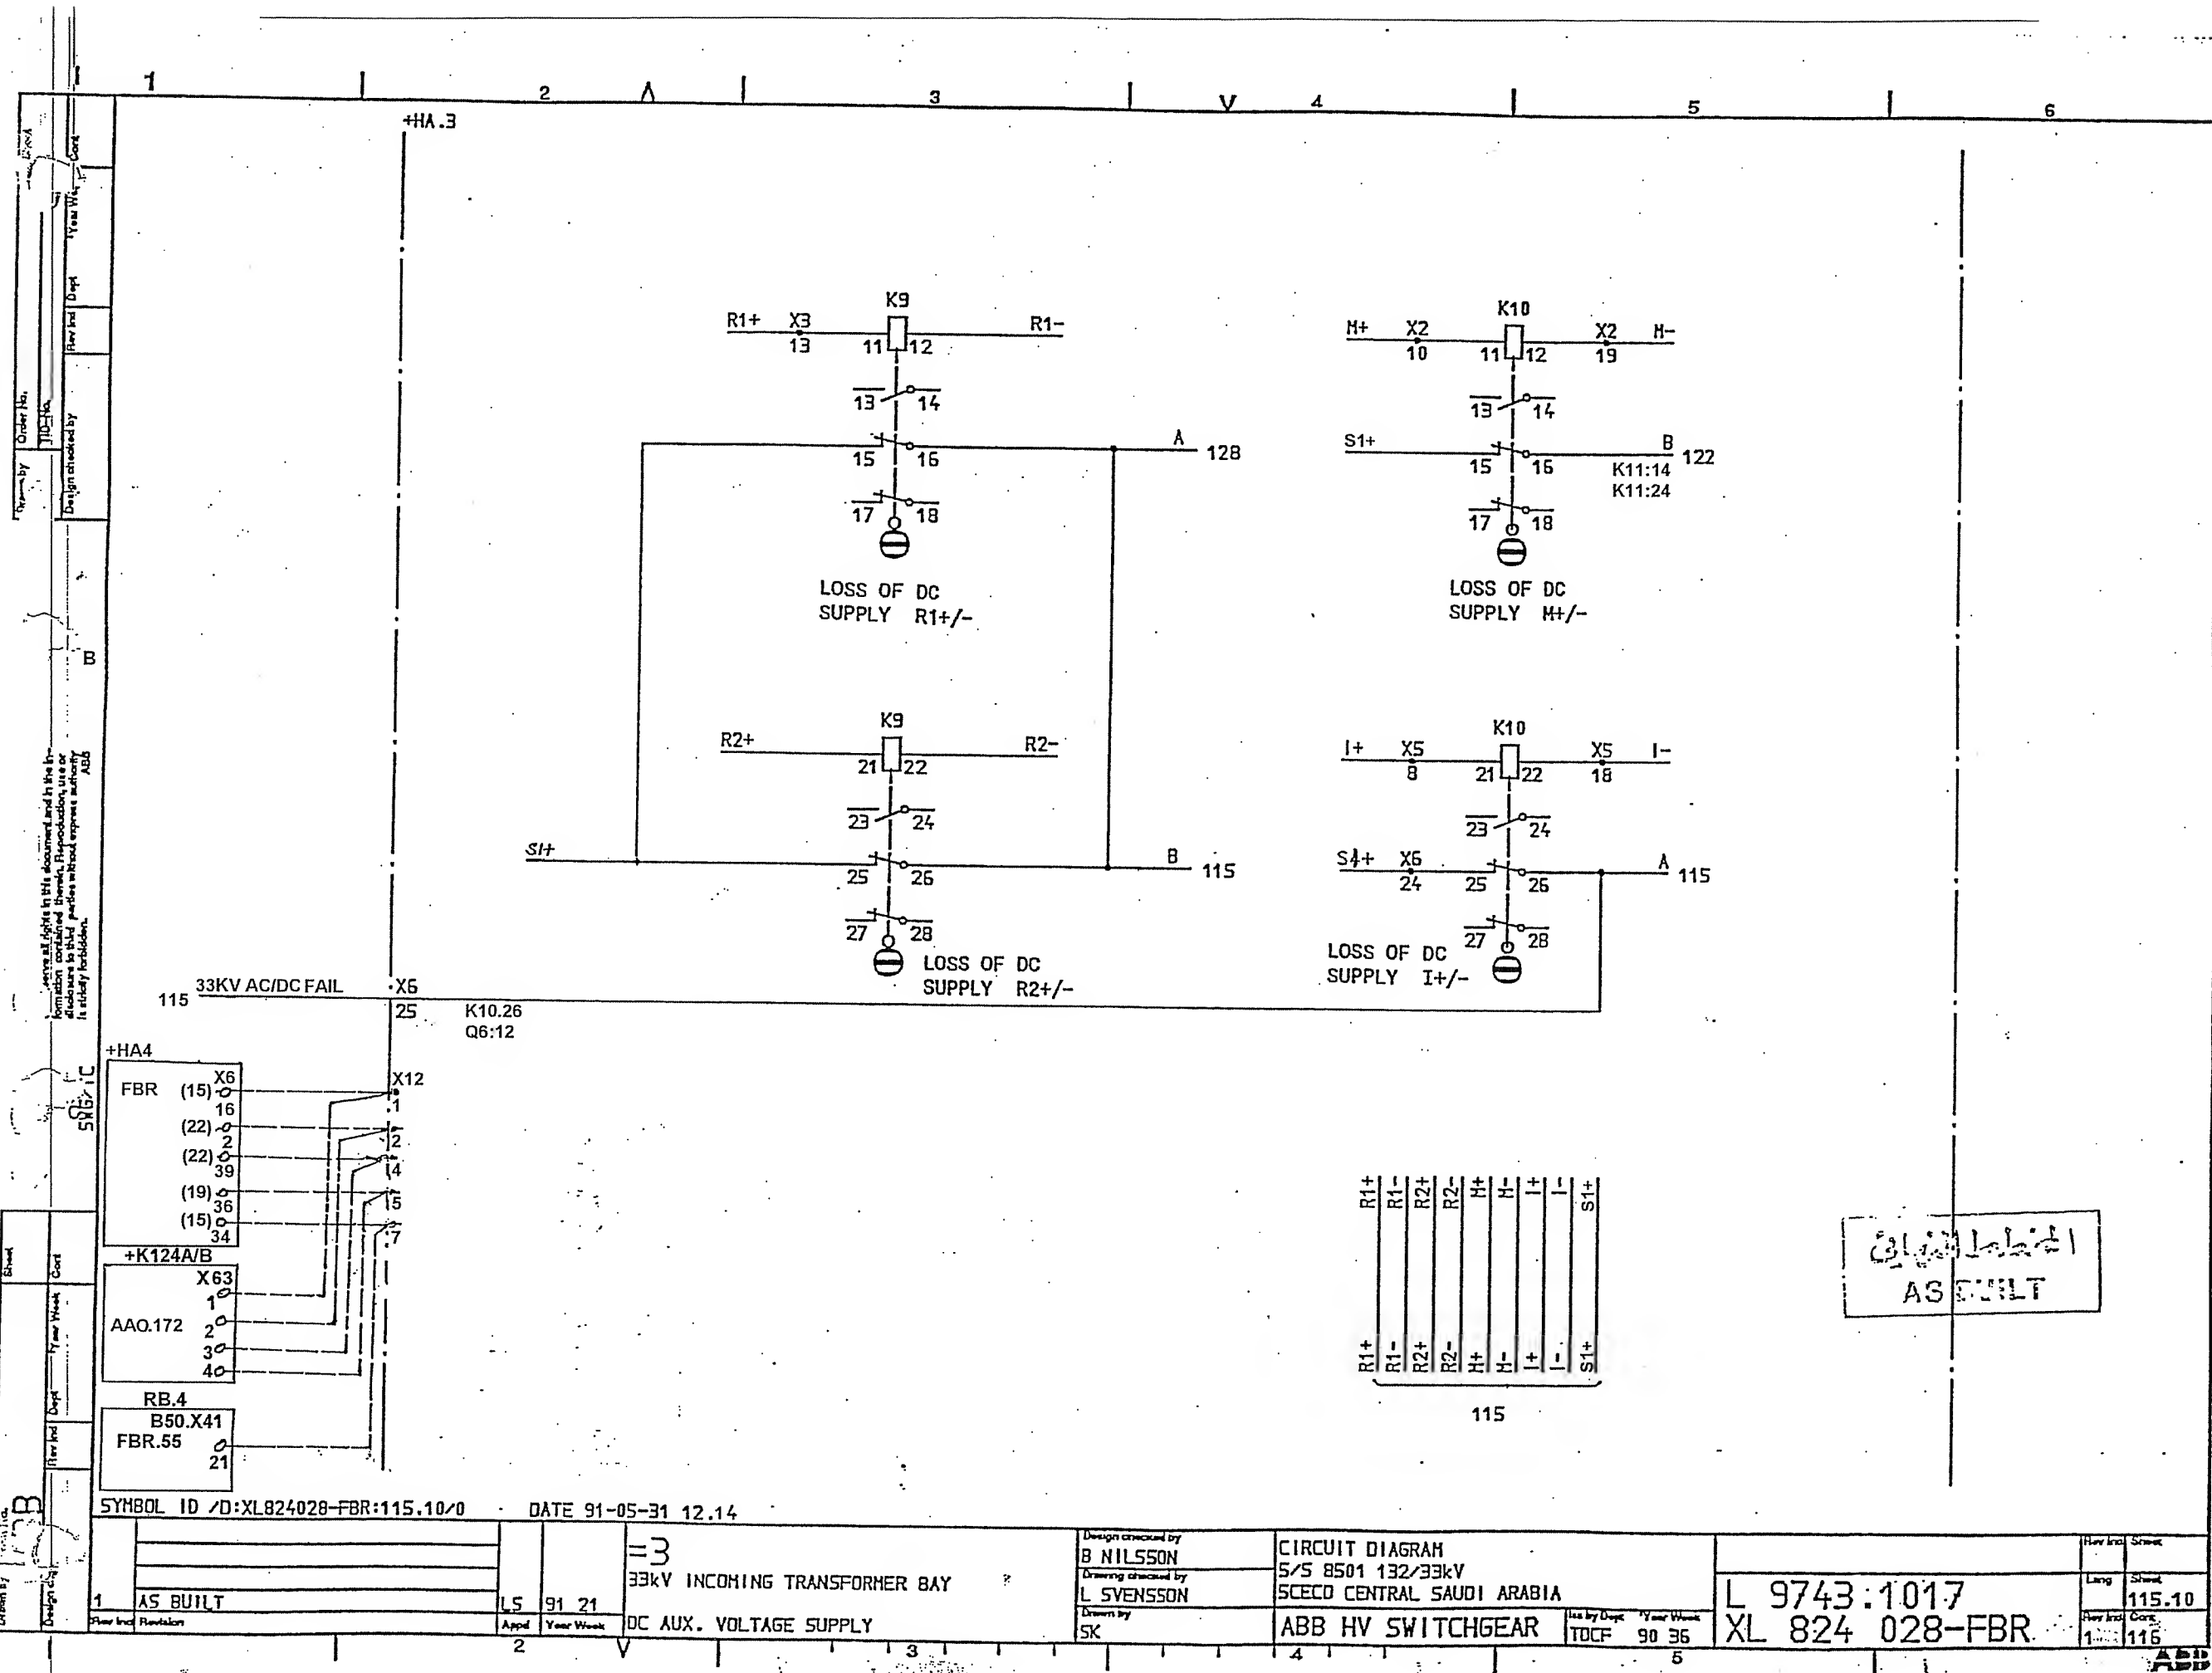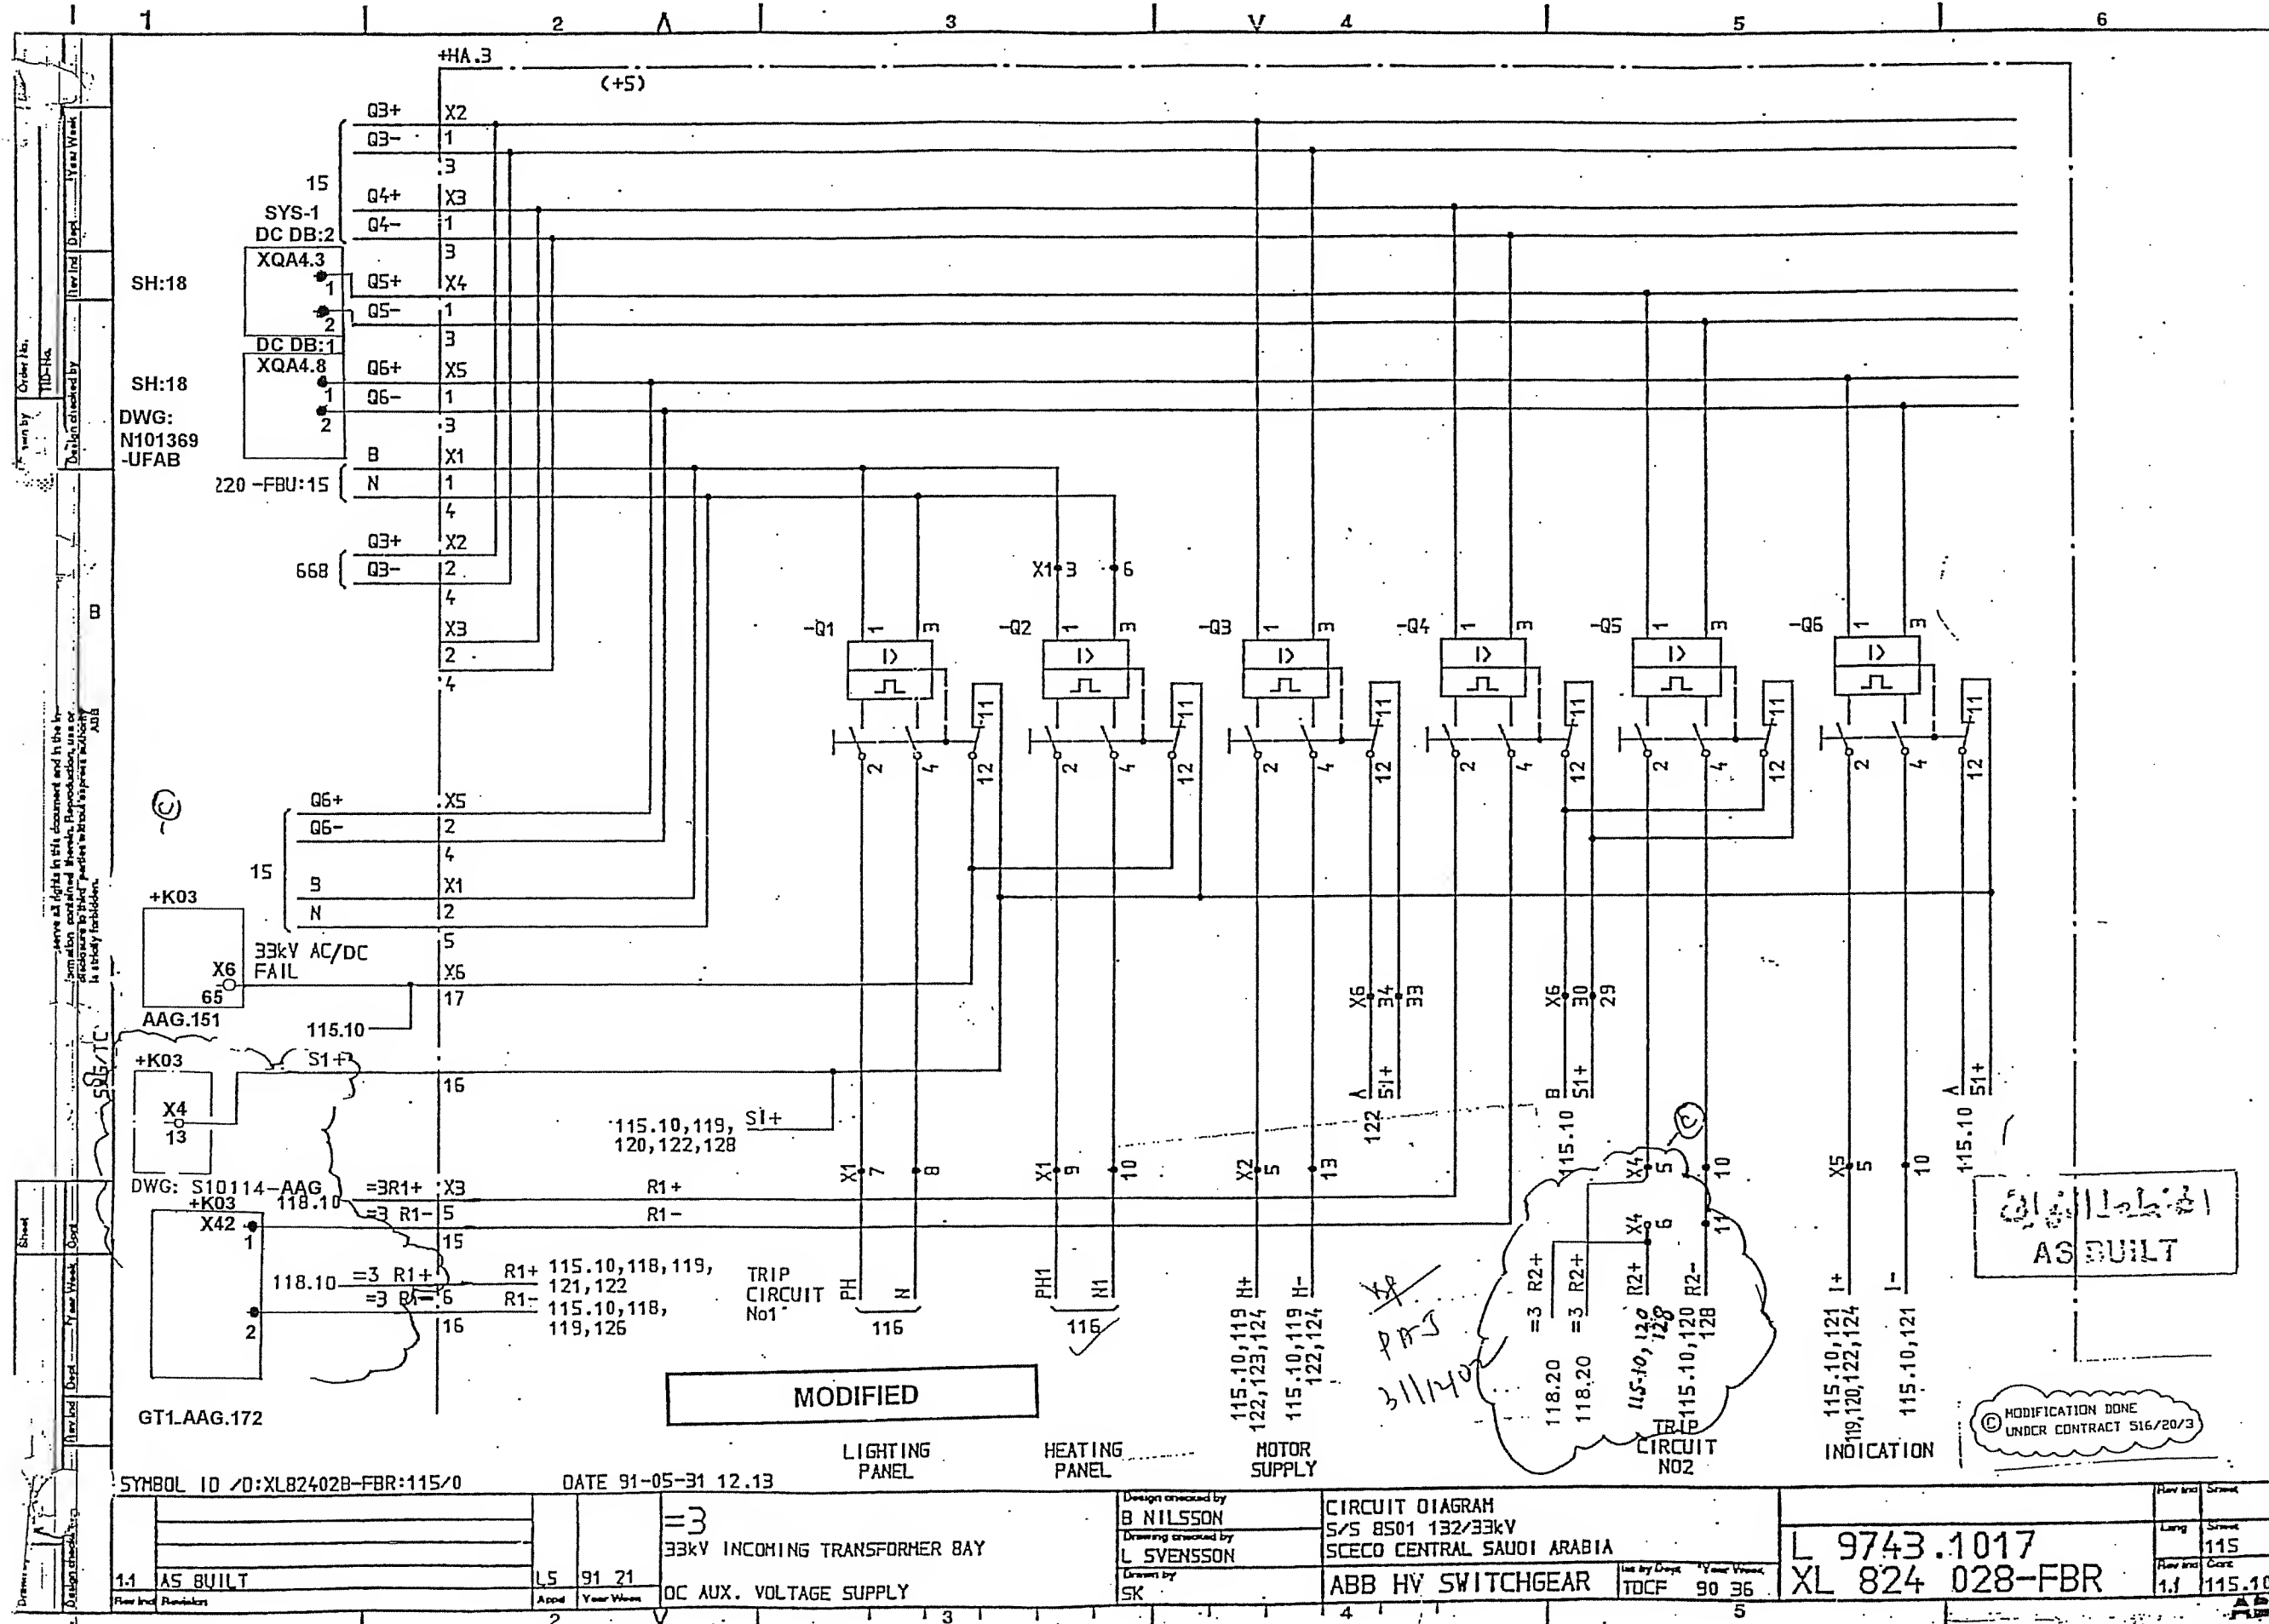ABB





| | | | | | | | | |
|-------------------|-----------|-----------|-----------|-----------|-----------|-----------|-----------|-----------|
| Drawn by | Form No. | Sheet | Rev | Ind | Dept | Year | Week | Cont |
| | | | | | | | | |
| Design checked by | Order No. | Order No. | Order No. | Order No. | Order No. | Order No. | Order No. | Order No. |
| | | | | | | | | |

Access all rights in this document and the information contained herein for reproduction, use or disclosure to third parties without express authority is strictly prohibited.

SRG/TC

SYMBOL ID /D:XL824028-FBR:116/0

DATE 91-05-31 12.14

| | | | | |
|---|----------|----|-------|------------------|
| 1 | AS BUILT | 15 | 91 21 | HEATER AND LIGHT |
| 2 | | | | |


| | |
|--------------------|------------|
| Design checked by | B NILSSON |
| Drawing checked by | L SVENSSON |
| Drawn by | SK |

| | |
|------------------------------|------------|
| CIRCUIT DIAGRAM | |
| S/S 8501 132/33kV | |
| SCECO CENTRAL SAUDI ARABIA * | |
| ABB HV SWITCHGEAR | TOCF 90 36 |

| |
|----------------|
| L 9743.1017 |
| XL 824 028-FBR |


| | | |
|-----|-----|-------|
| Rev | Ind | Sheet |
| 1 | | 116 |
| 1 | | 118 |


#HA.3

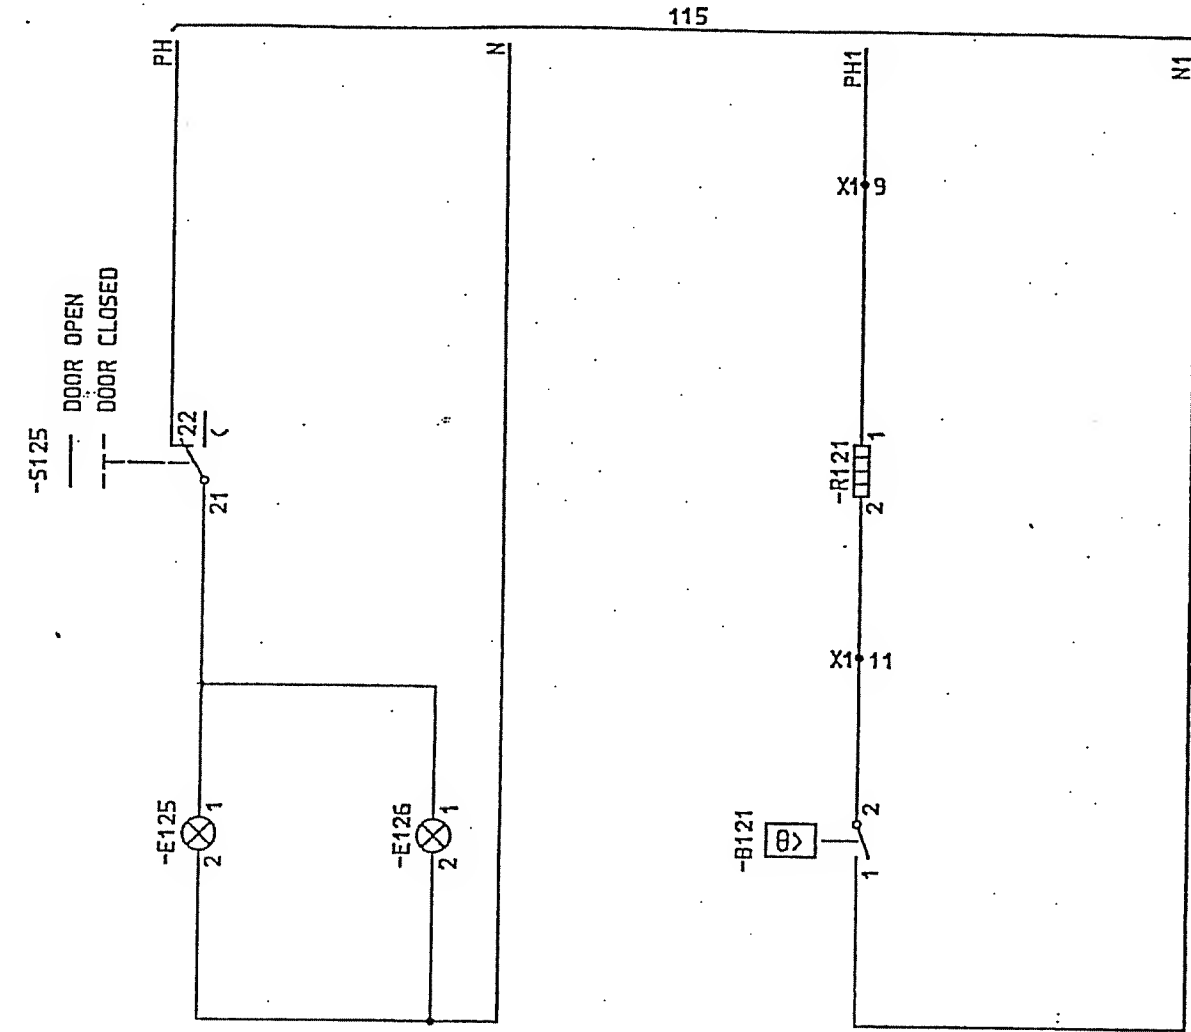


الهيئة العامة للغذاء والدواء
AS BUILT

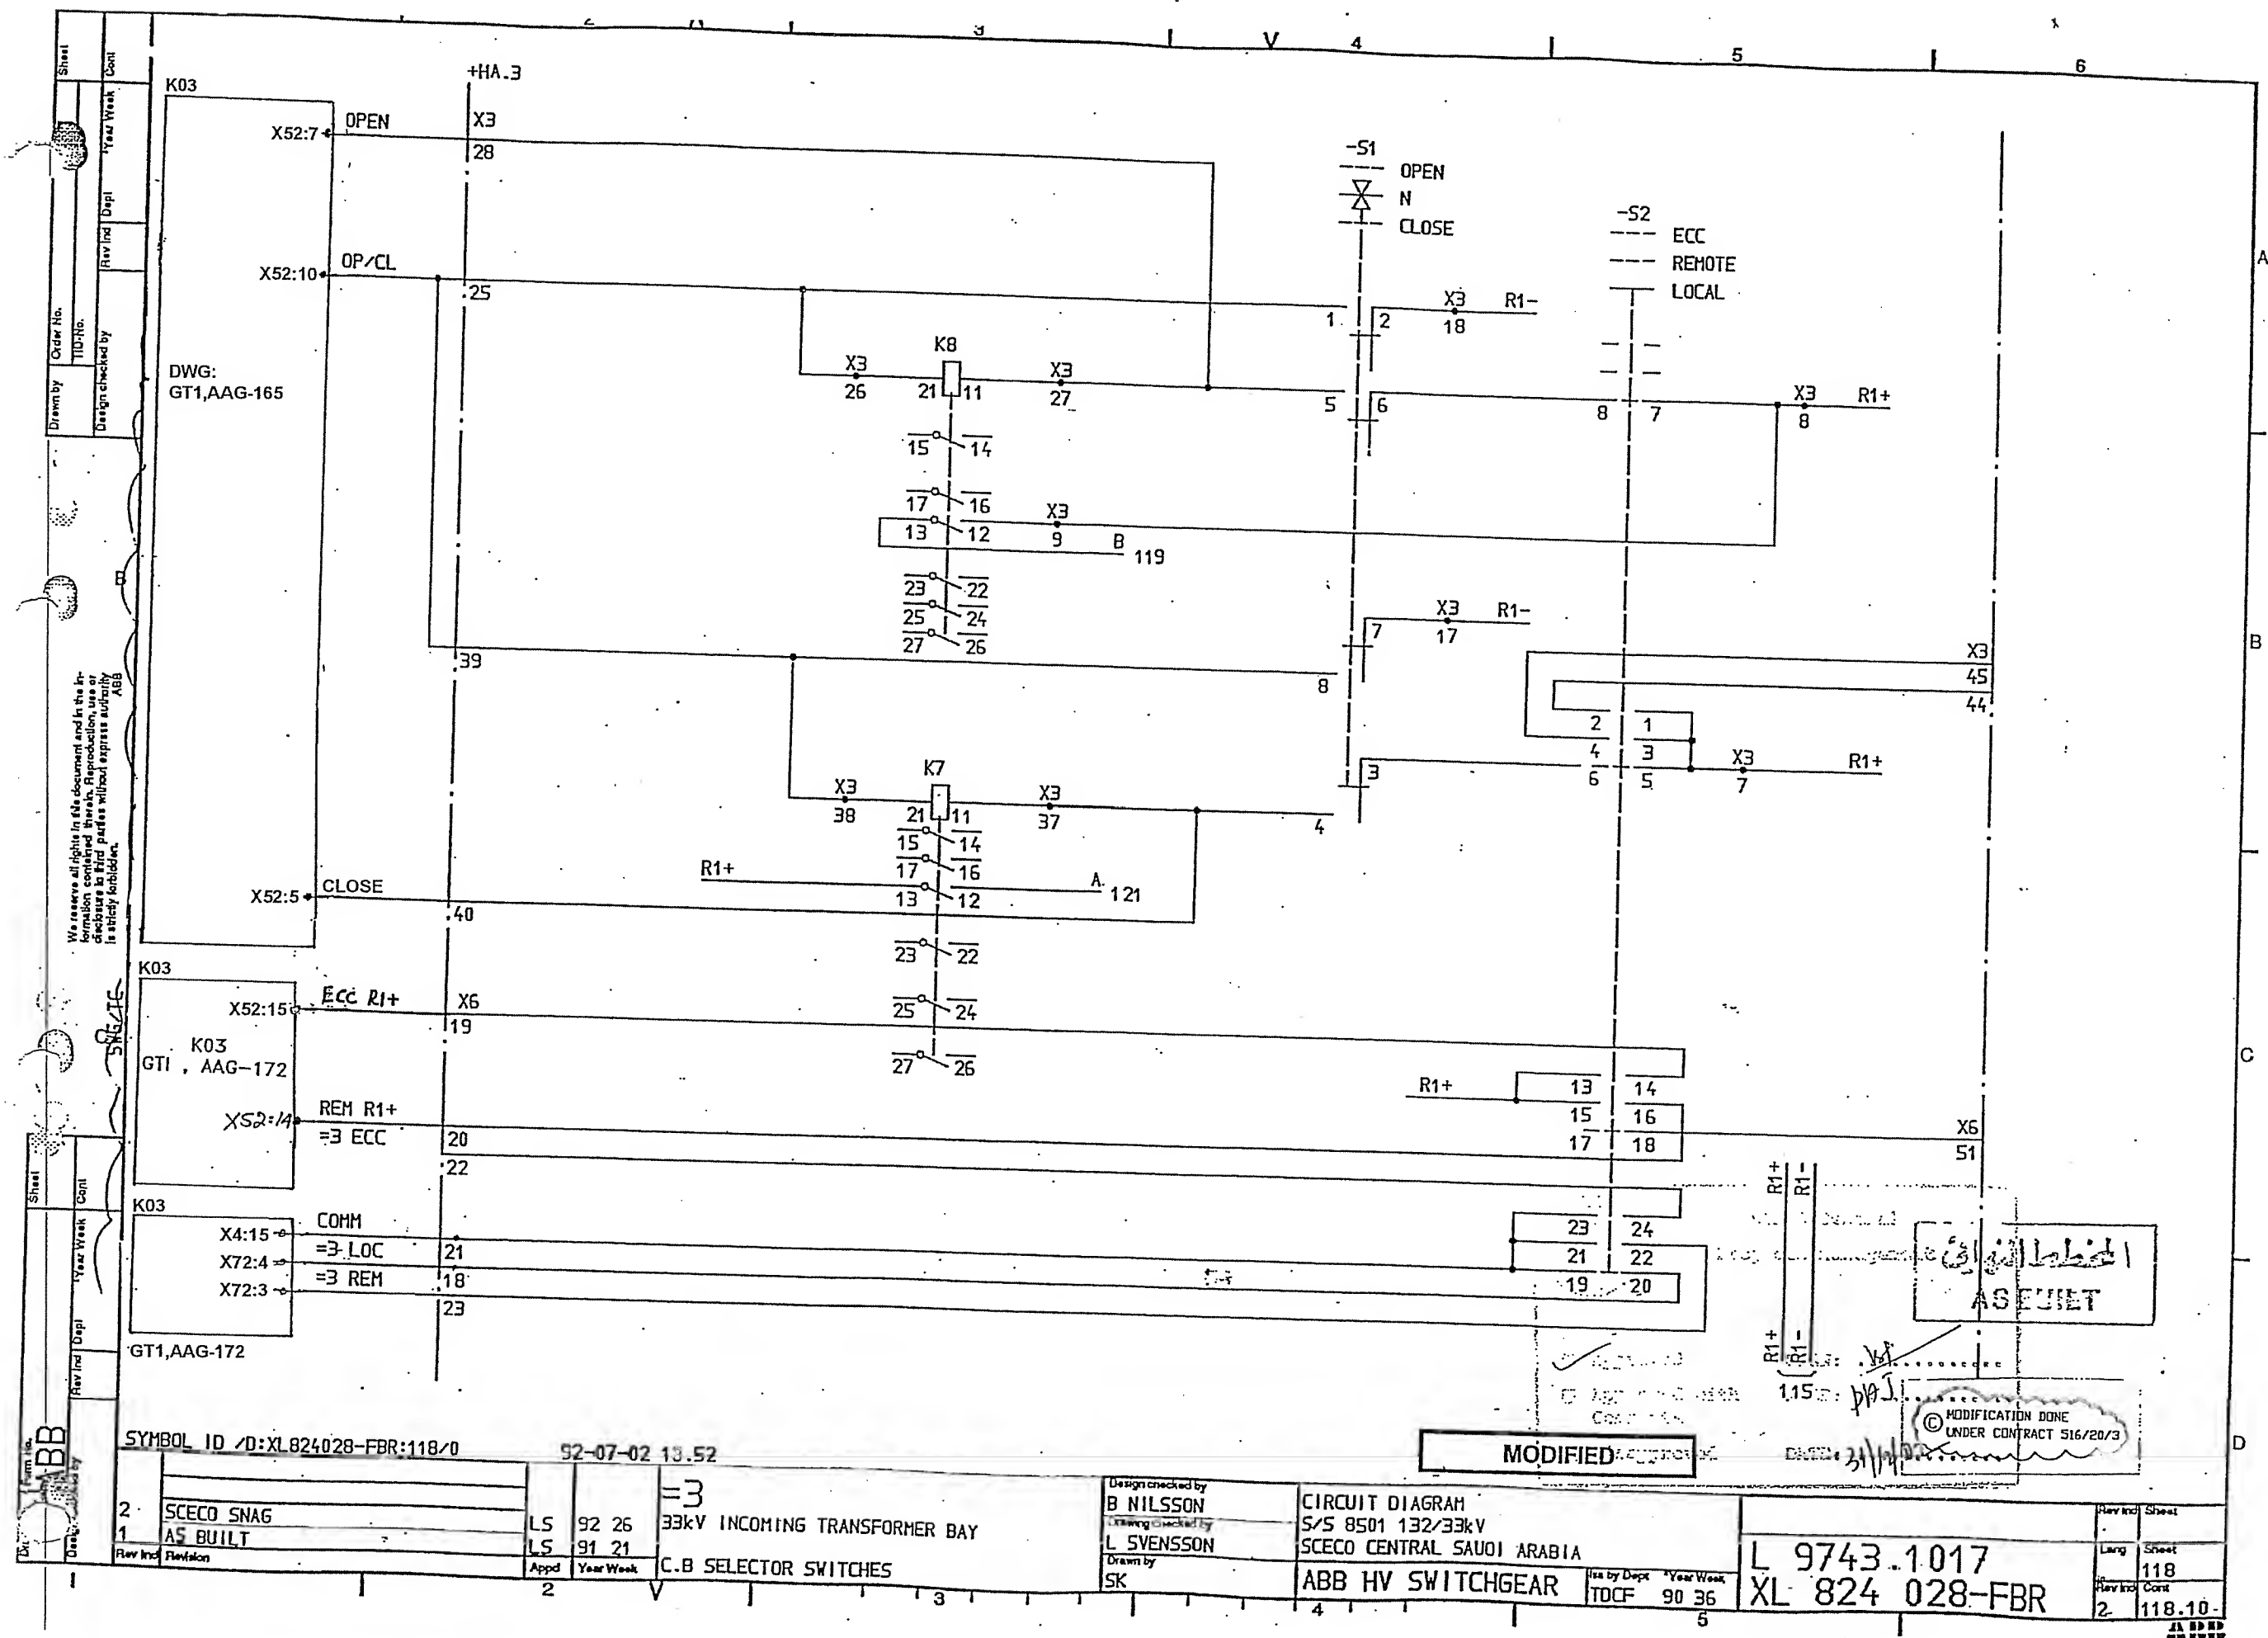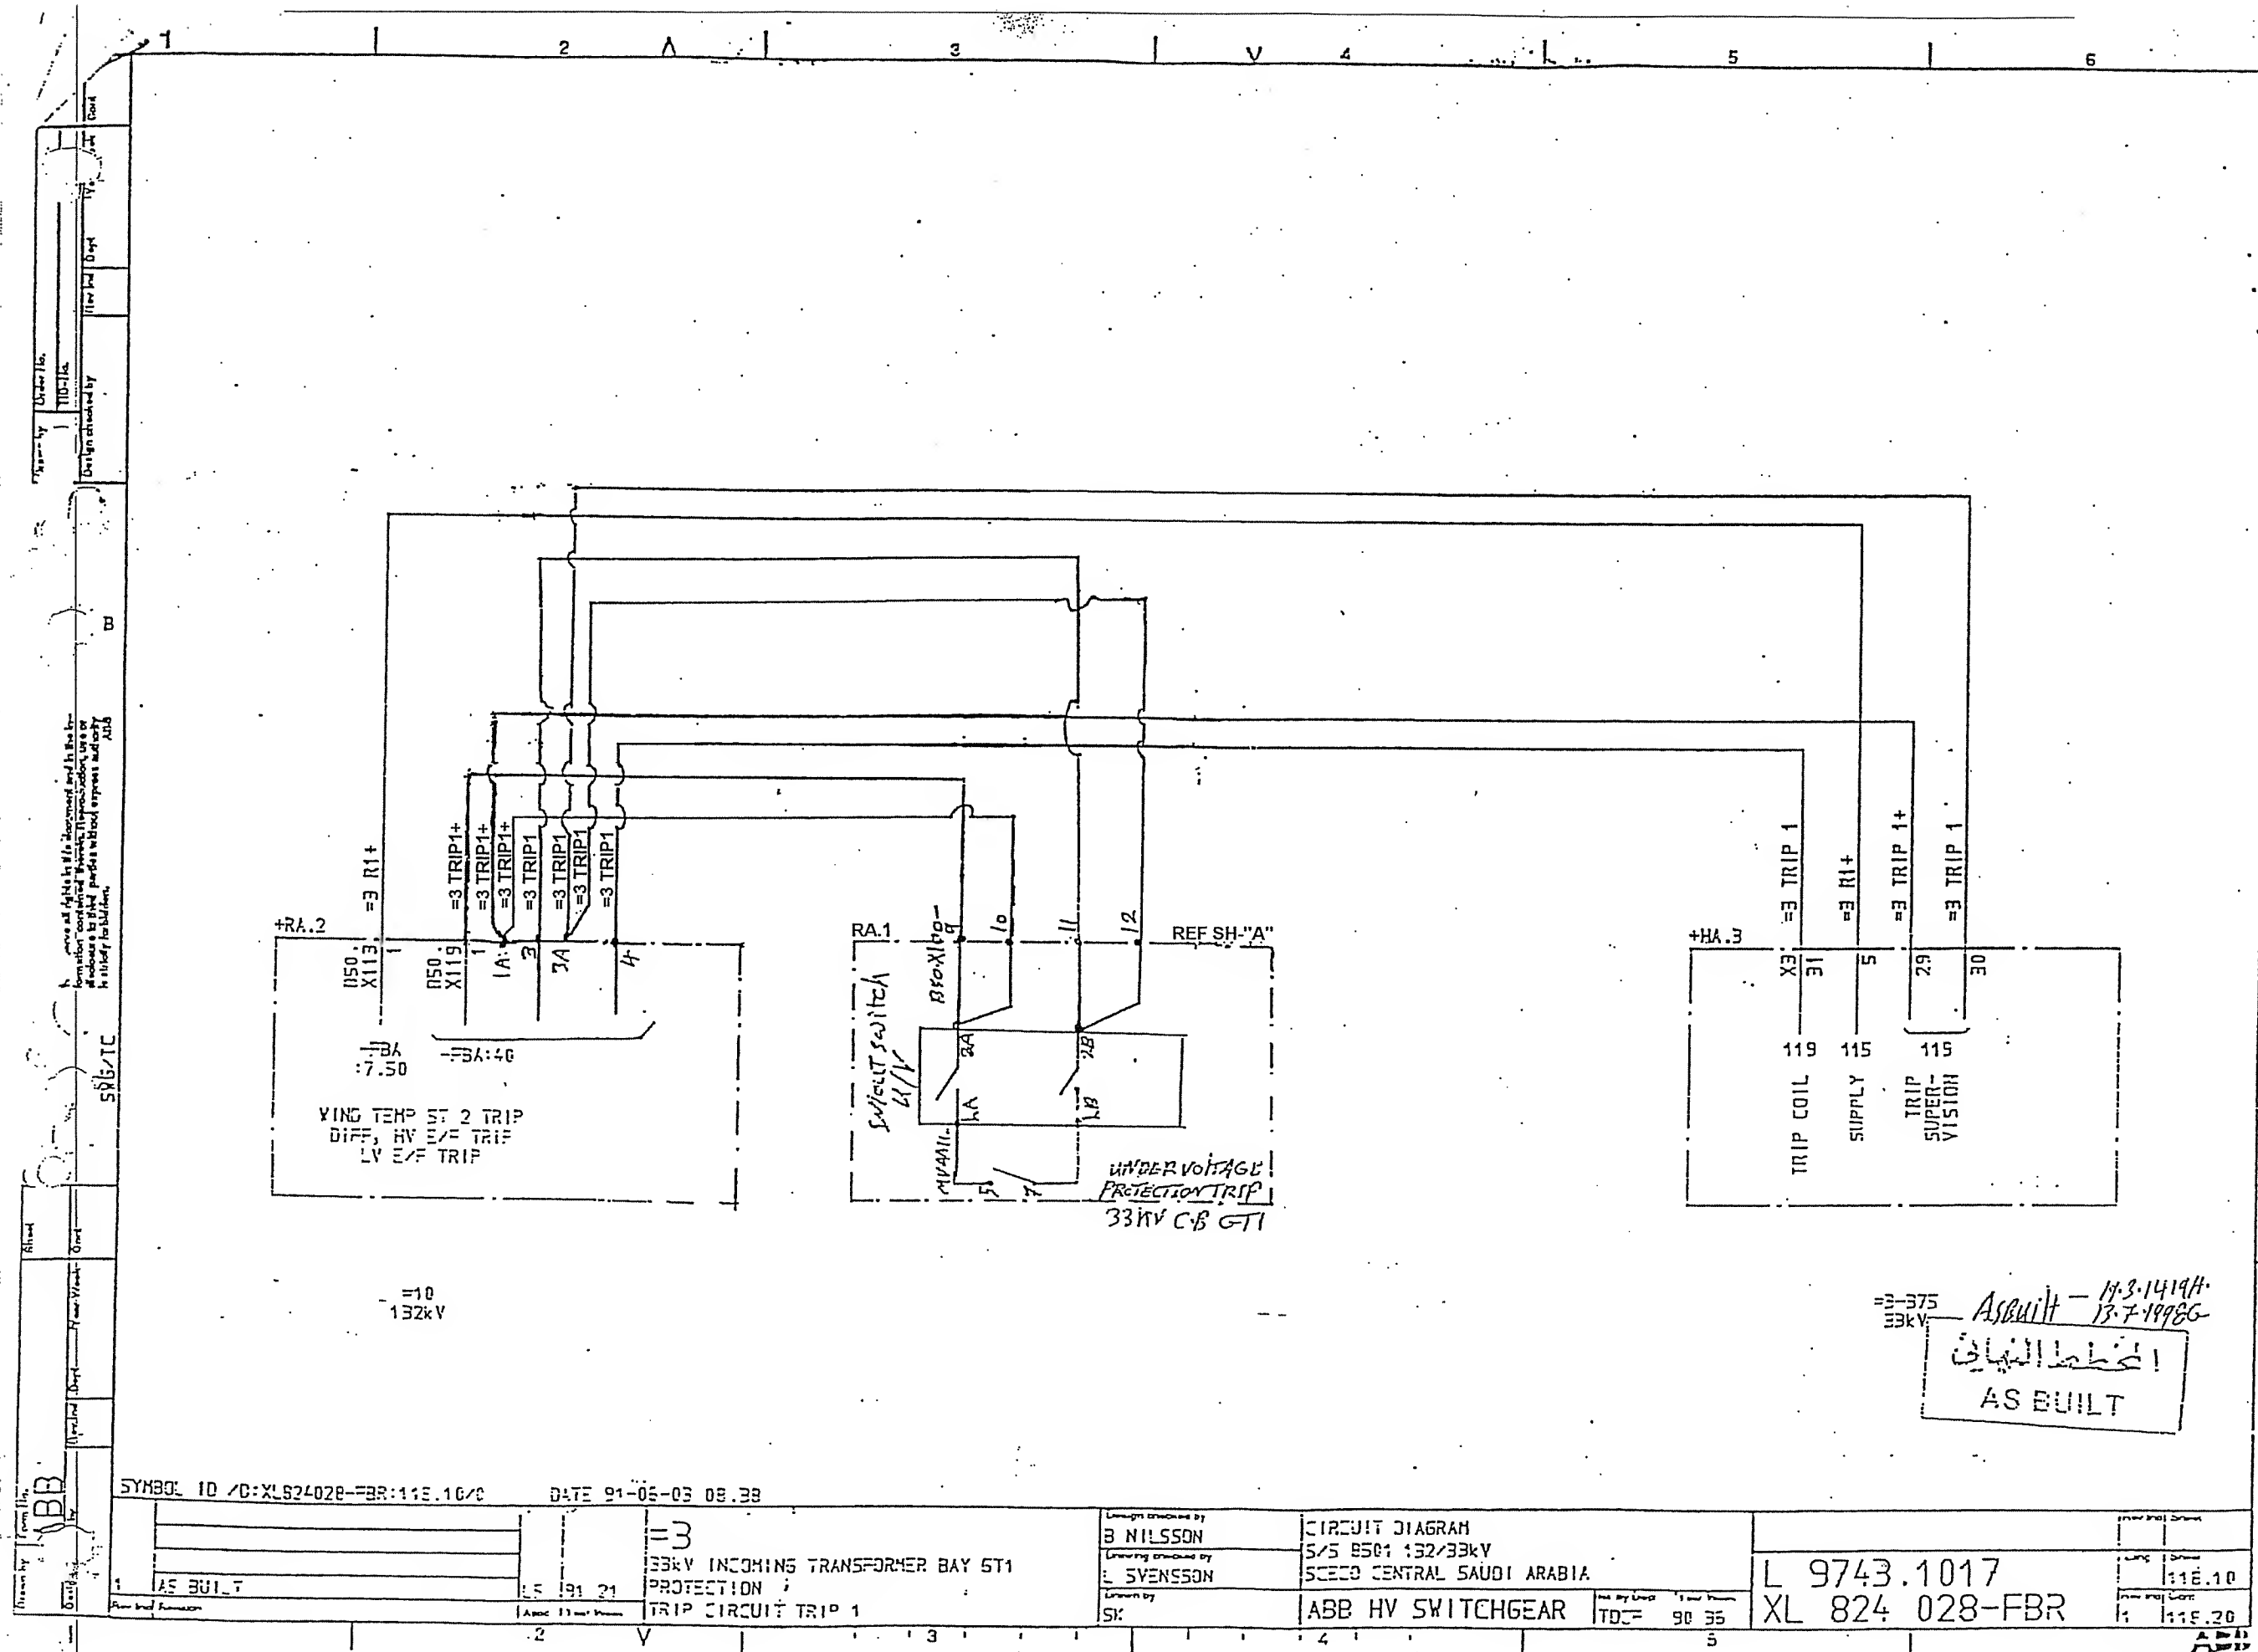A
B
C
D






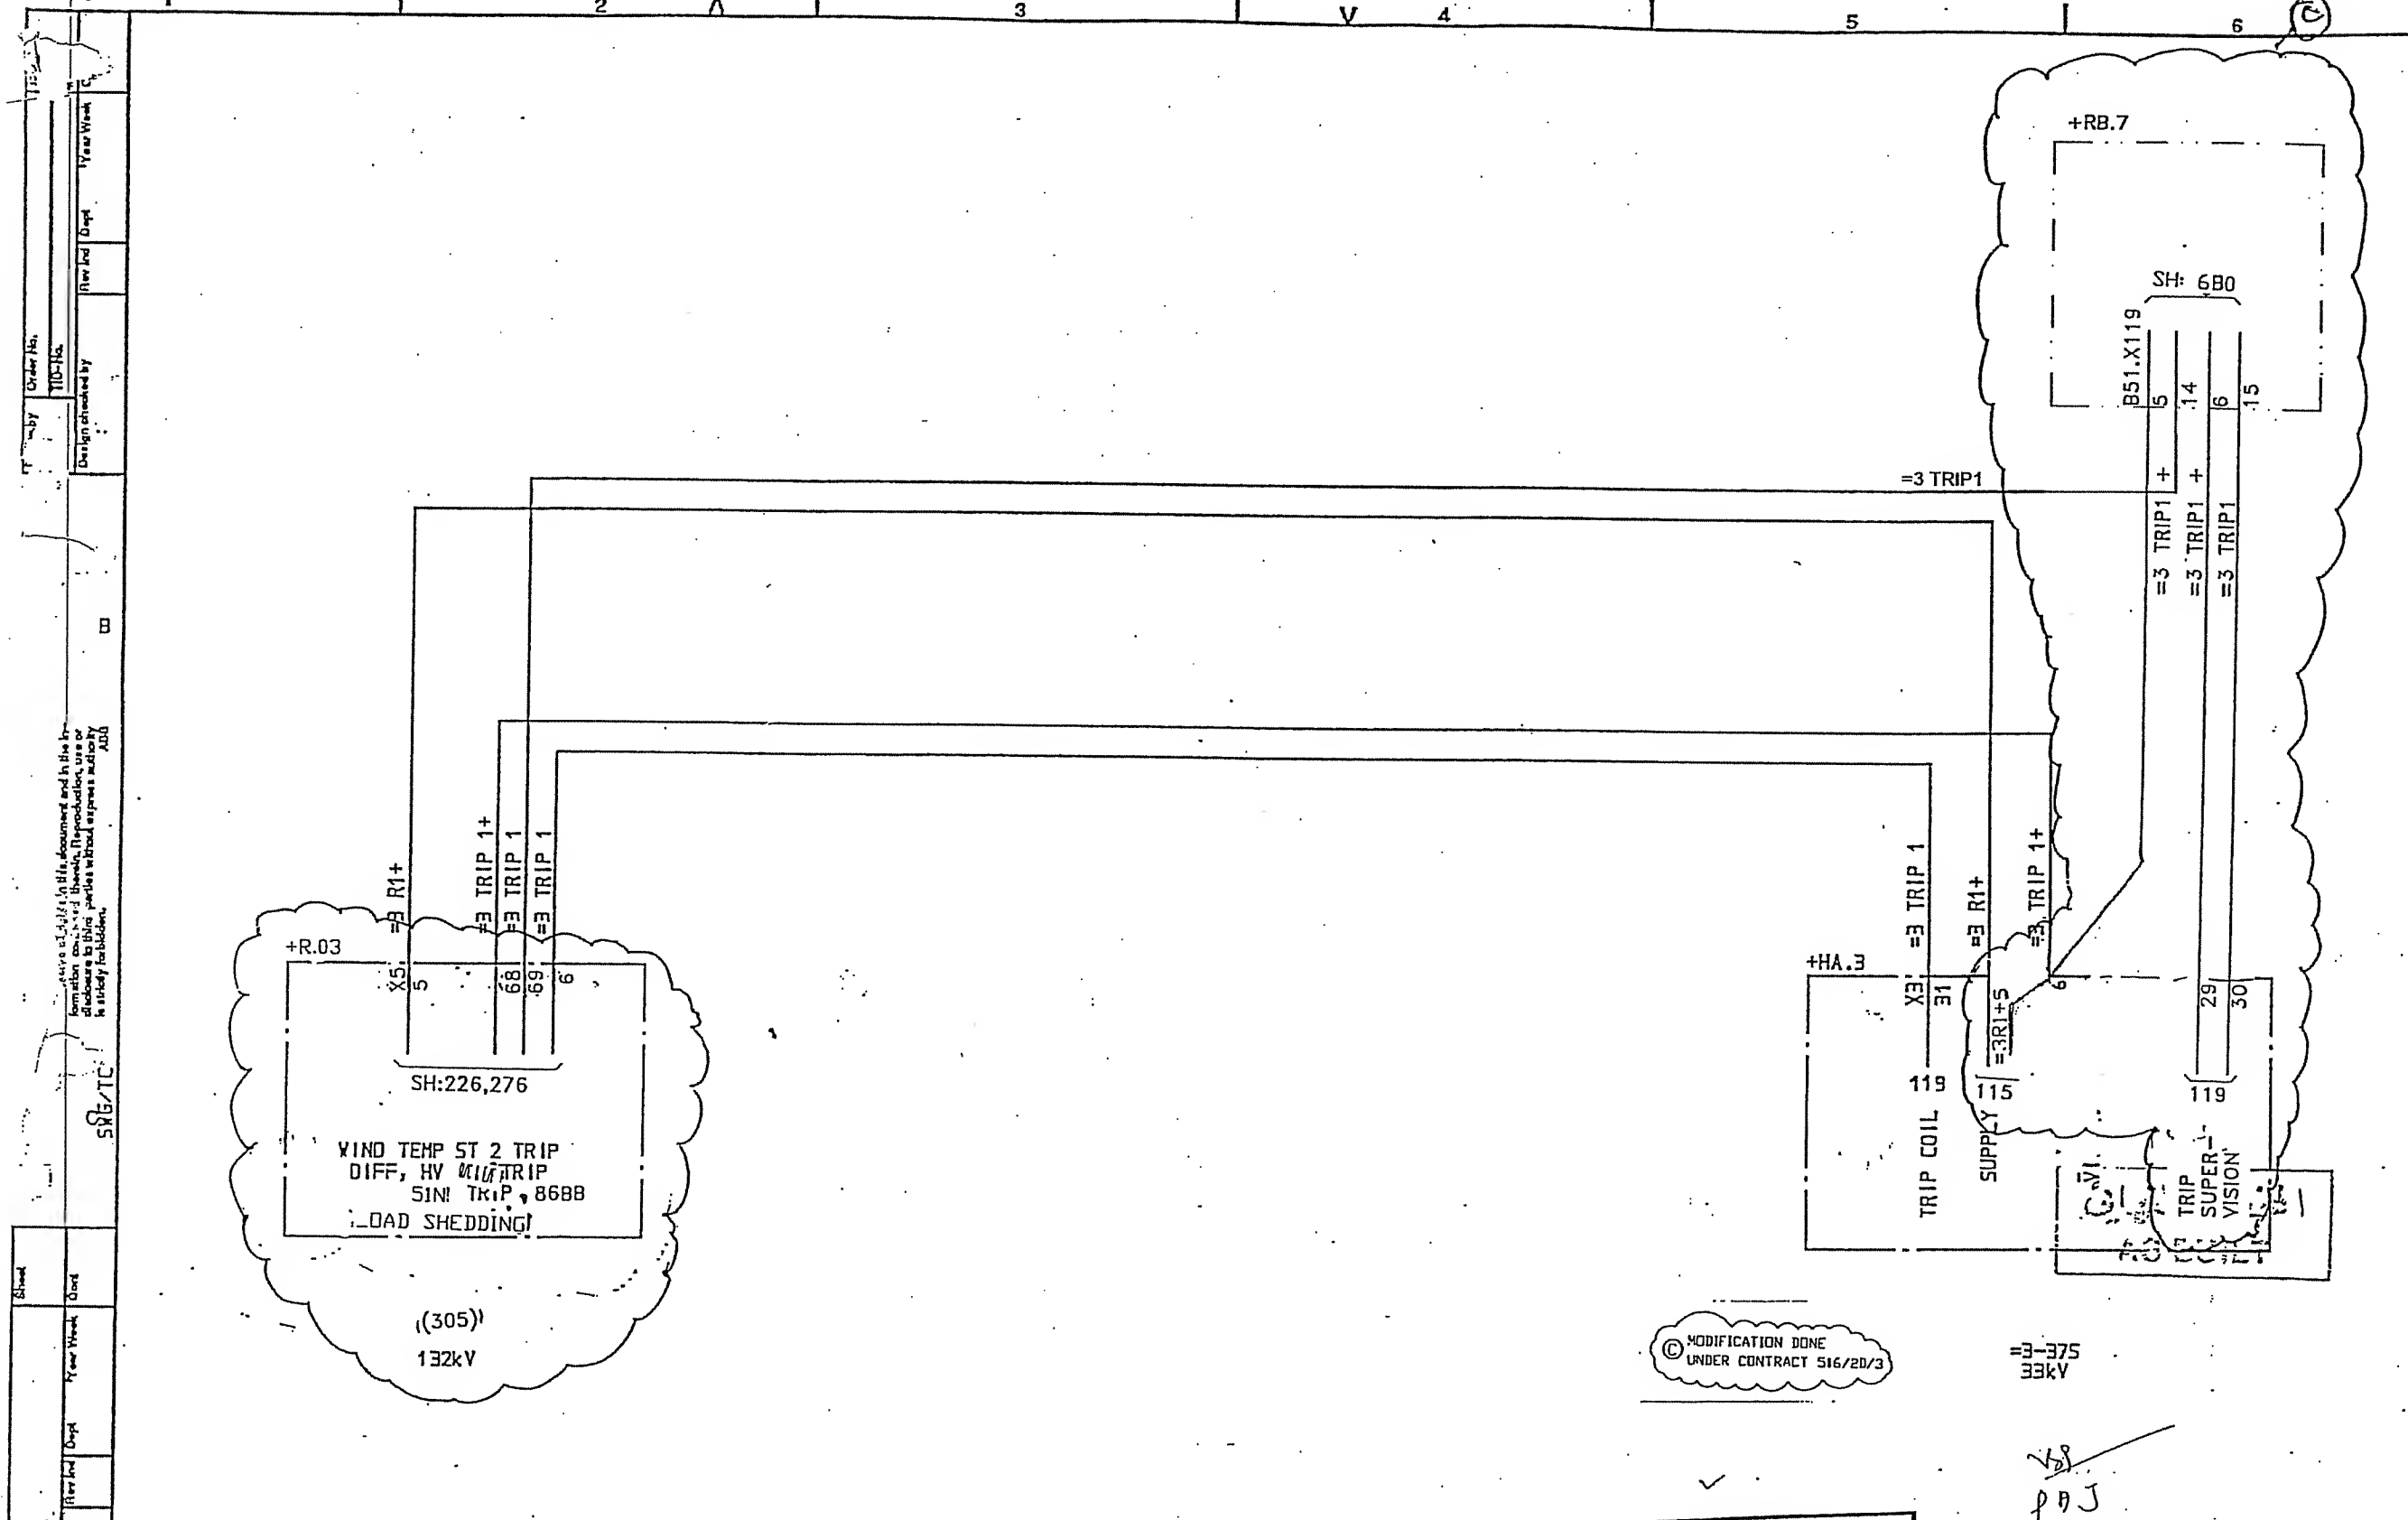AS BUILT - 14.3.1419H
 13.7.1998G
 AS BUILT



| | | | | | |
|-------------------|-----------|-------------------|-----------|-----------|-----------|
| Drawn by | Sheet | Year Week | Year Week | Year Week | Year Week |
| Design checked by | Order No. | Design checked by | Order No. | Order No. | Order No. |

| | | | | | | | | |
|---|----------|------|-----------|--|----------------------------------|--|-------------------------------|-------------------------|
| 1 | AS BUILT | LS | 91 21 | 33kV INCOMING TRANSFORMER BAY GT1 PROTECTION TRIP CIRCUIT TRIP 1 | Design checked by B NILSSON | CIRCUIT DIAGRAM S/S 8501 132/33kV SCECD CENTRAL SAUDI ARABIA | L 9743.1017 XL 824 028-FBR | Rev Int Sheet |
| 2 | | Appl | Year Week | | Drawing checked by L SVENSSON | Line by Dept Year Week TDCF 90 36 | | Lang Sheet 118.10 |
| 3 | | | | | Drawn by SK | | | Rev Int Sheet 118.20 |

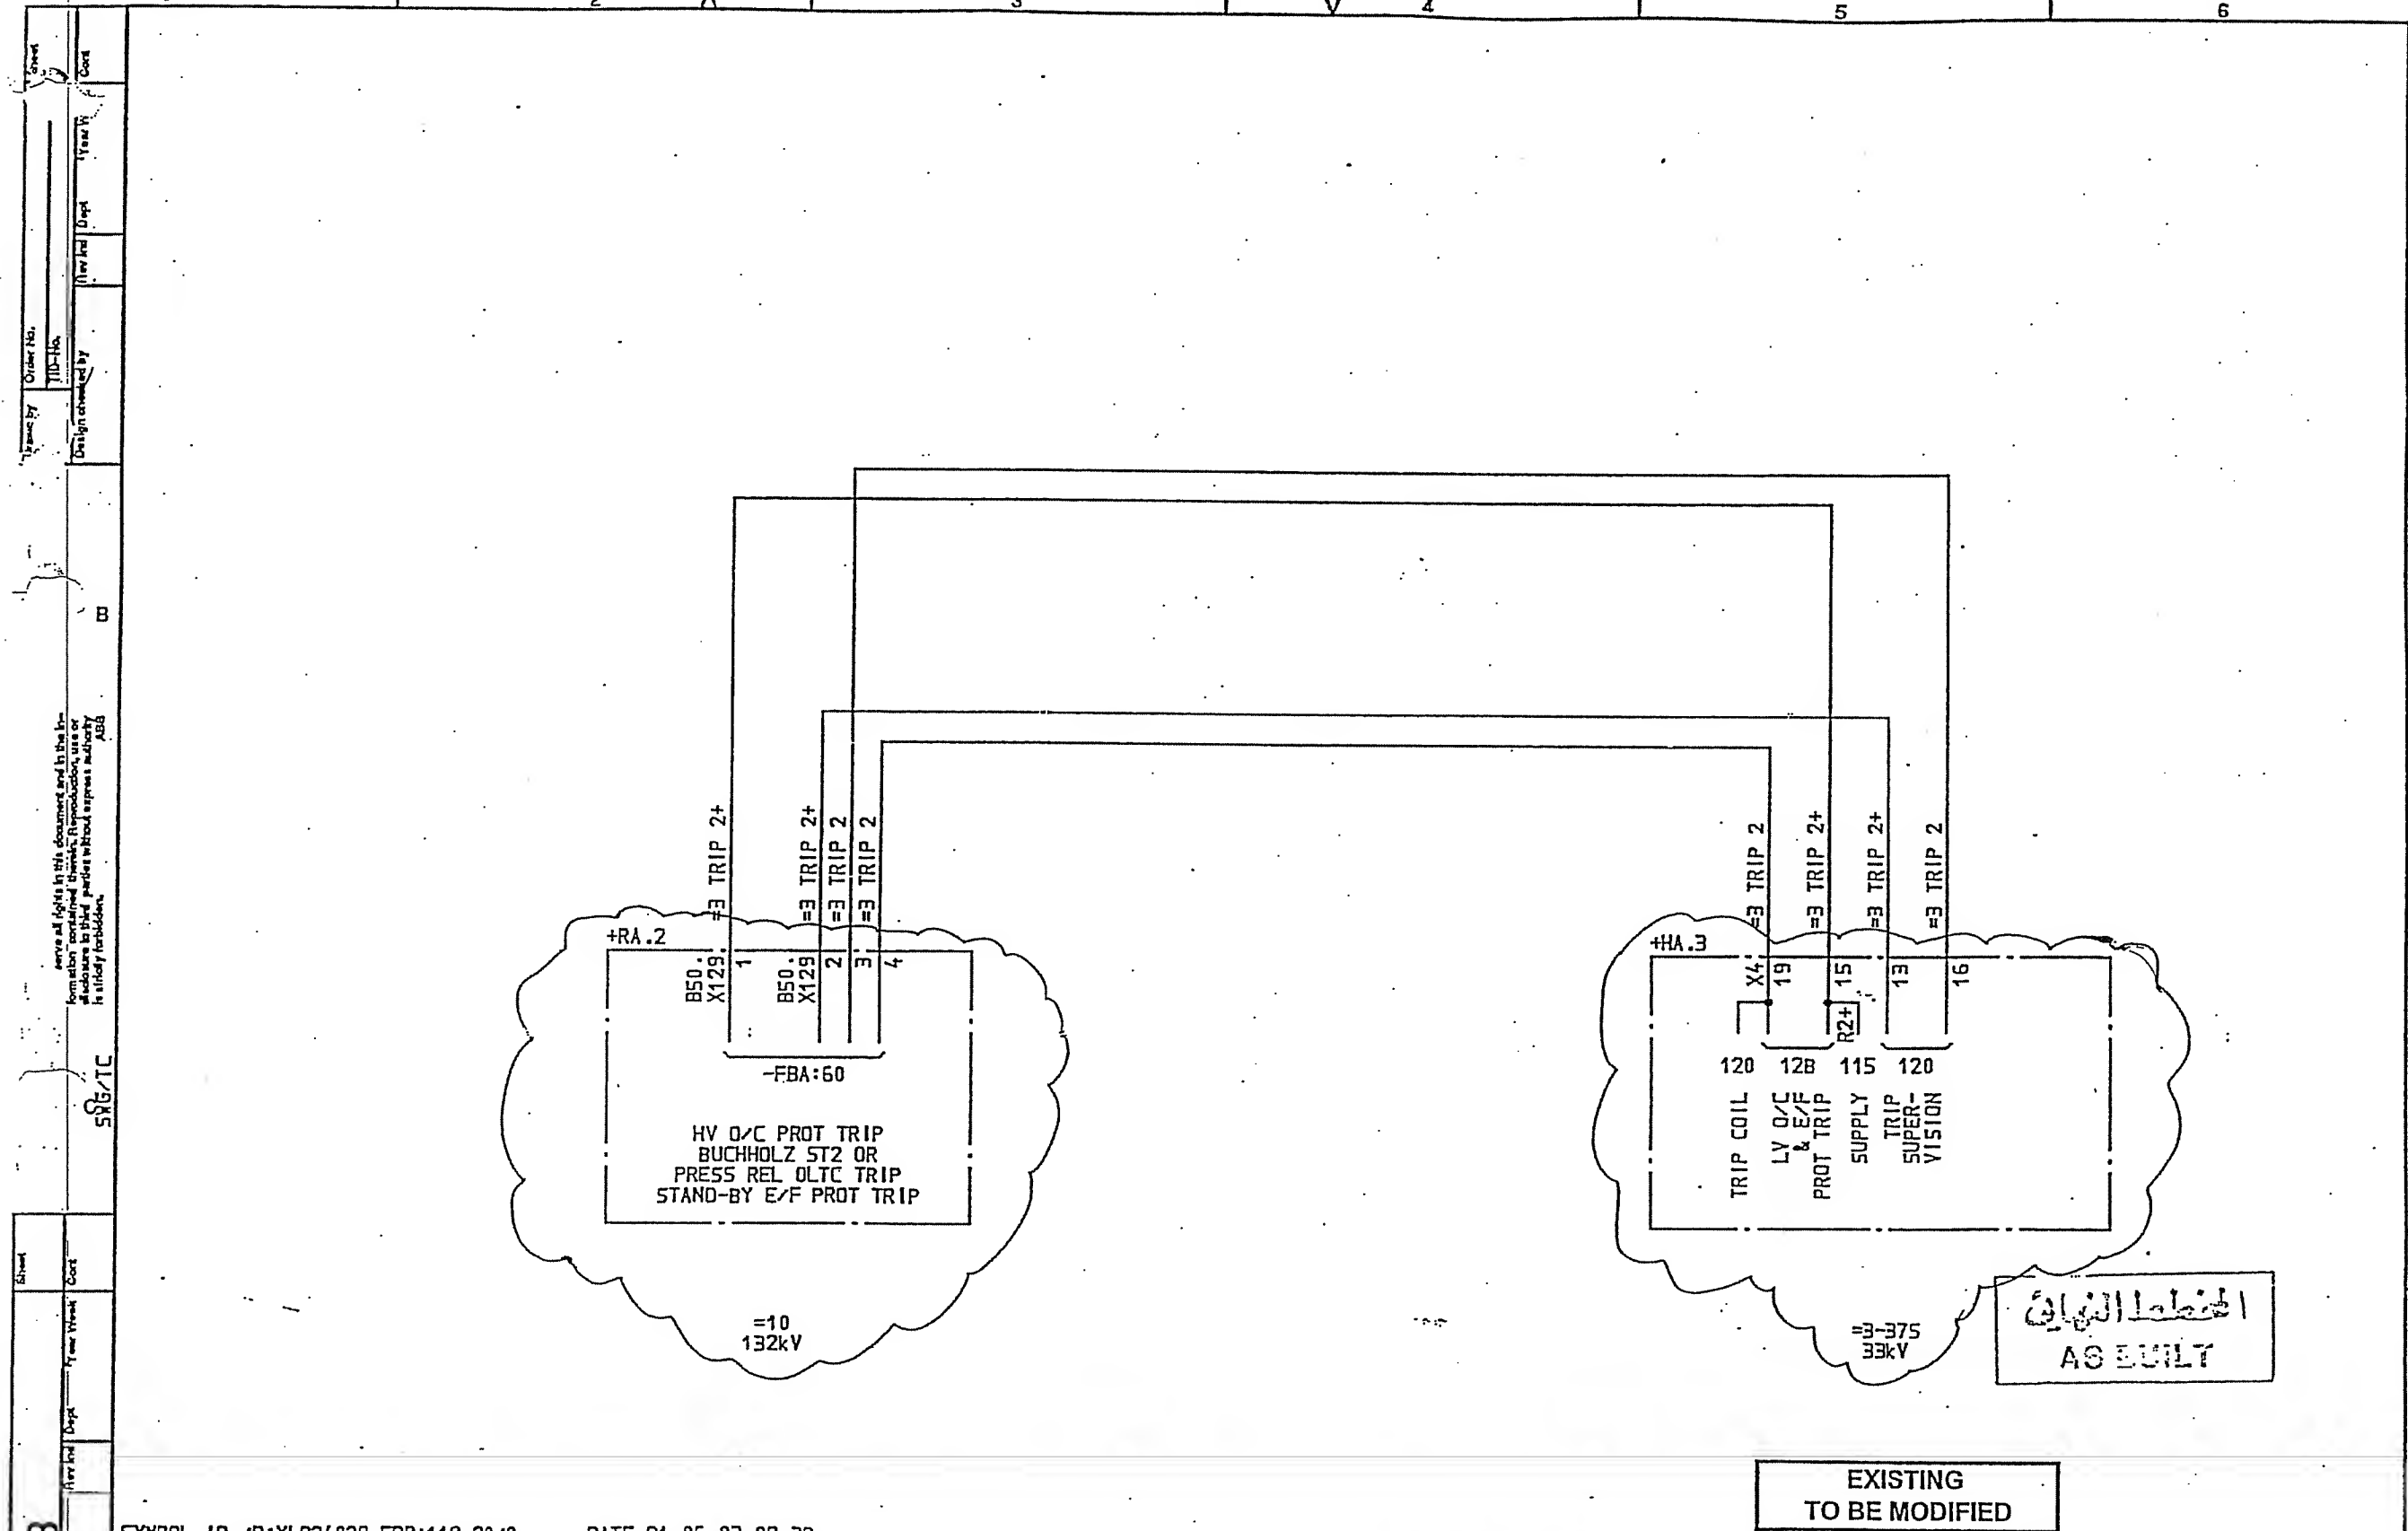



المخطط النهائي
AS BUILT


EXISTING
TO BE MODIFIED

SYMBOL ID /D:XL824028-FBR:118.20/0 DATE 91-06-03 08.38

| | | | | | |
|------------------------|--|--|---|-------------------------------|---------------------------|
| 1 AS BUILT 15 91 21 | =3 33kV INCOMING TRANSFORMER BAY GT1 PROTECTION TRIP CIRCUIT TRIP 2 | Design checked by B NILSSON Drawing checked by L SVENSSON Drawn by SK | CIRCUIT DIAGRAM S/S B501 132/33kV SCECO CENTRAL SAUDI ARABIA ABB HV SWITCHGEAR | L 9743.1017 XL 824 028-FBR | Rev 1 118.20 119 |
|------------------------|--|--|---|-------------------------------|---------------------------|

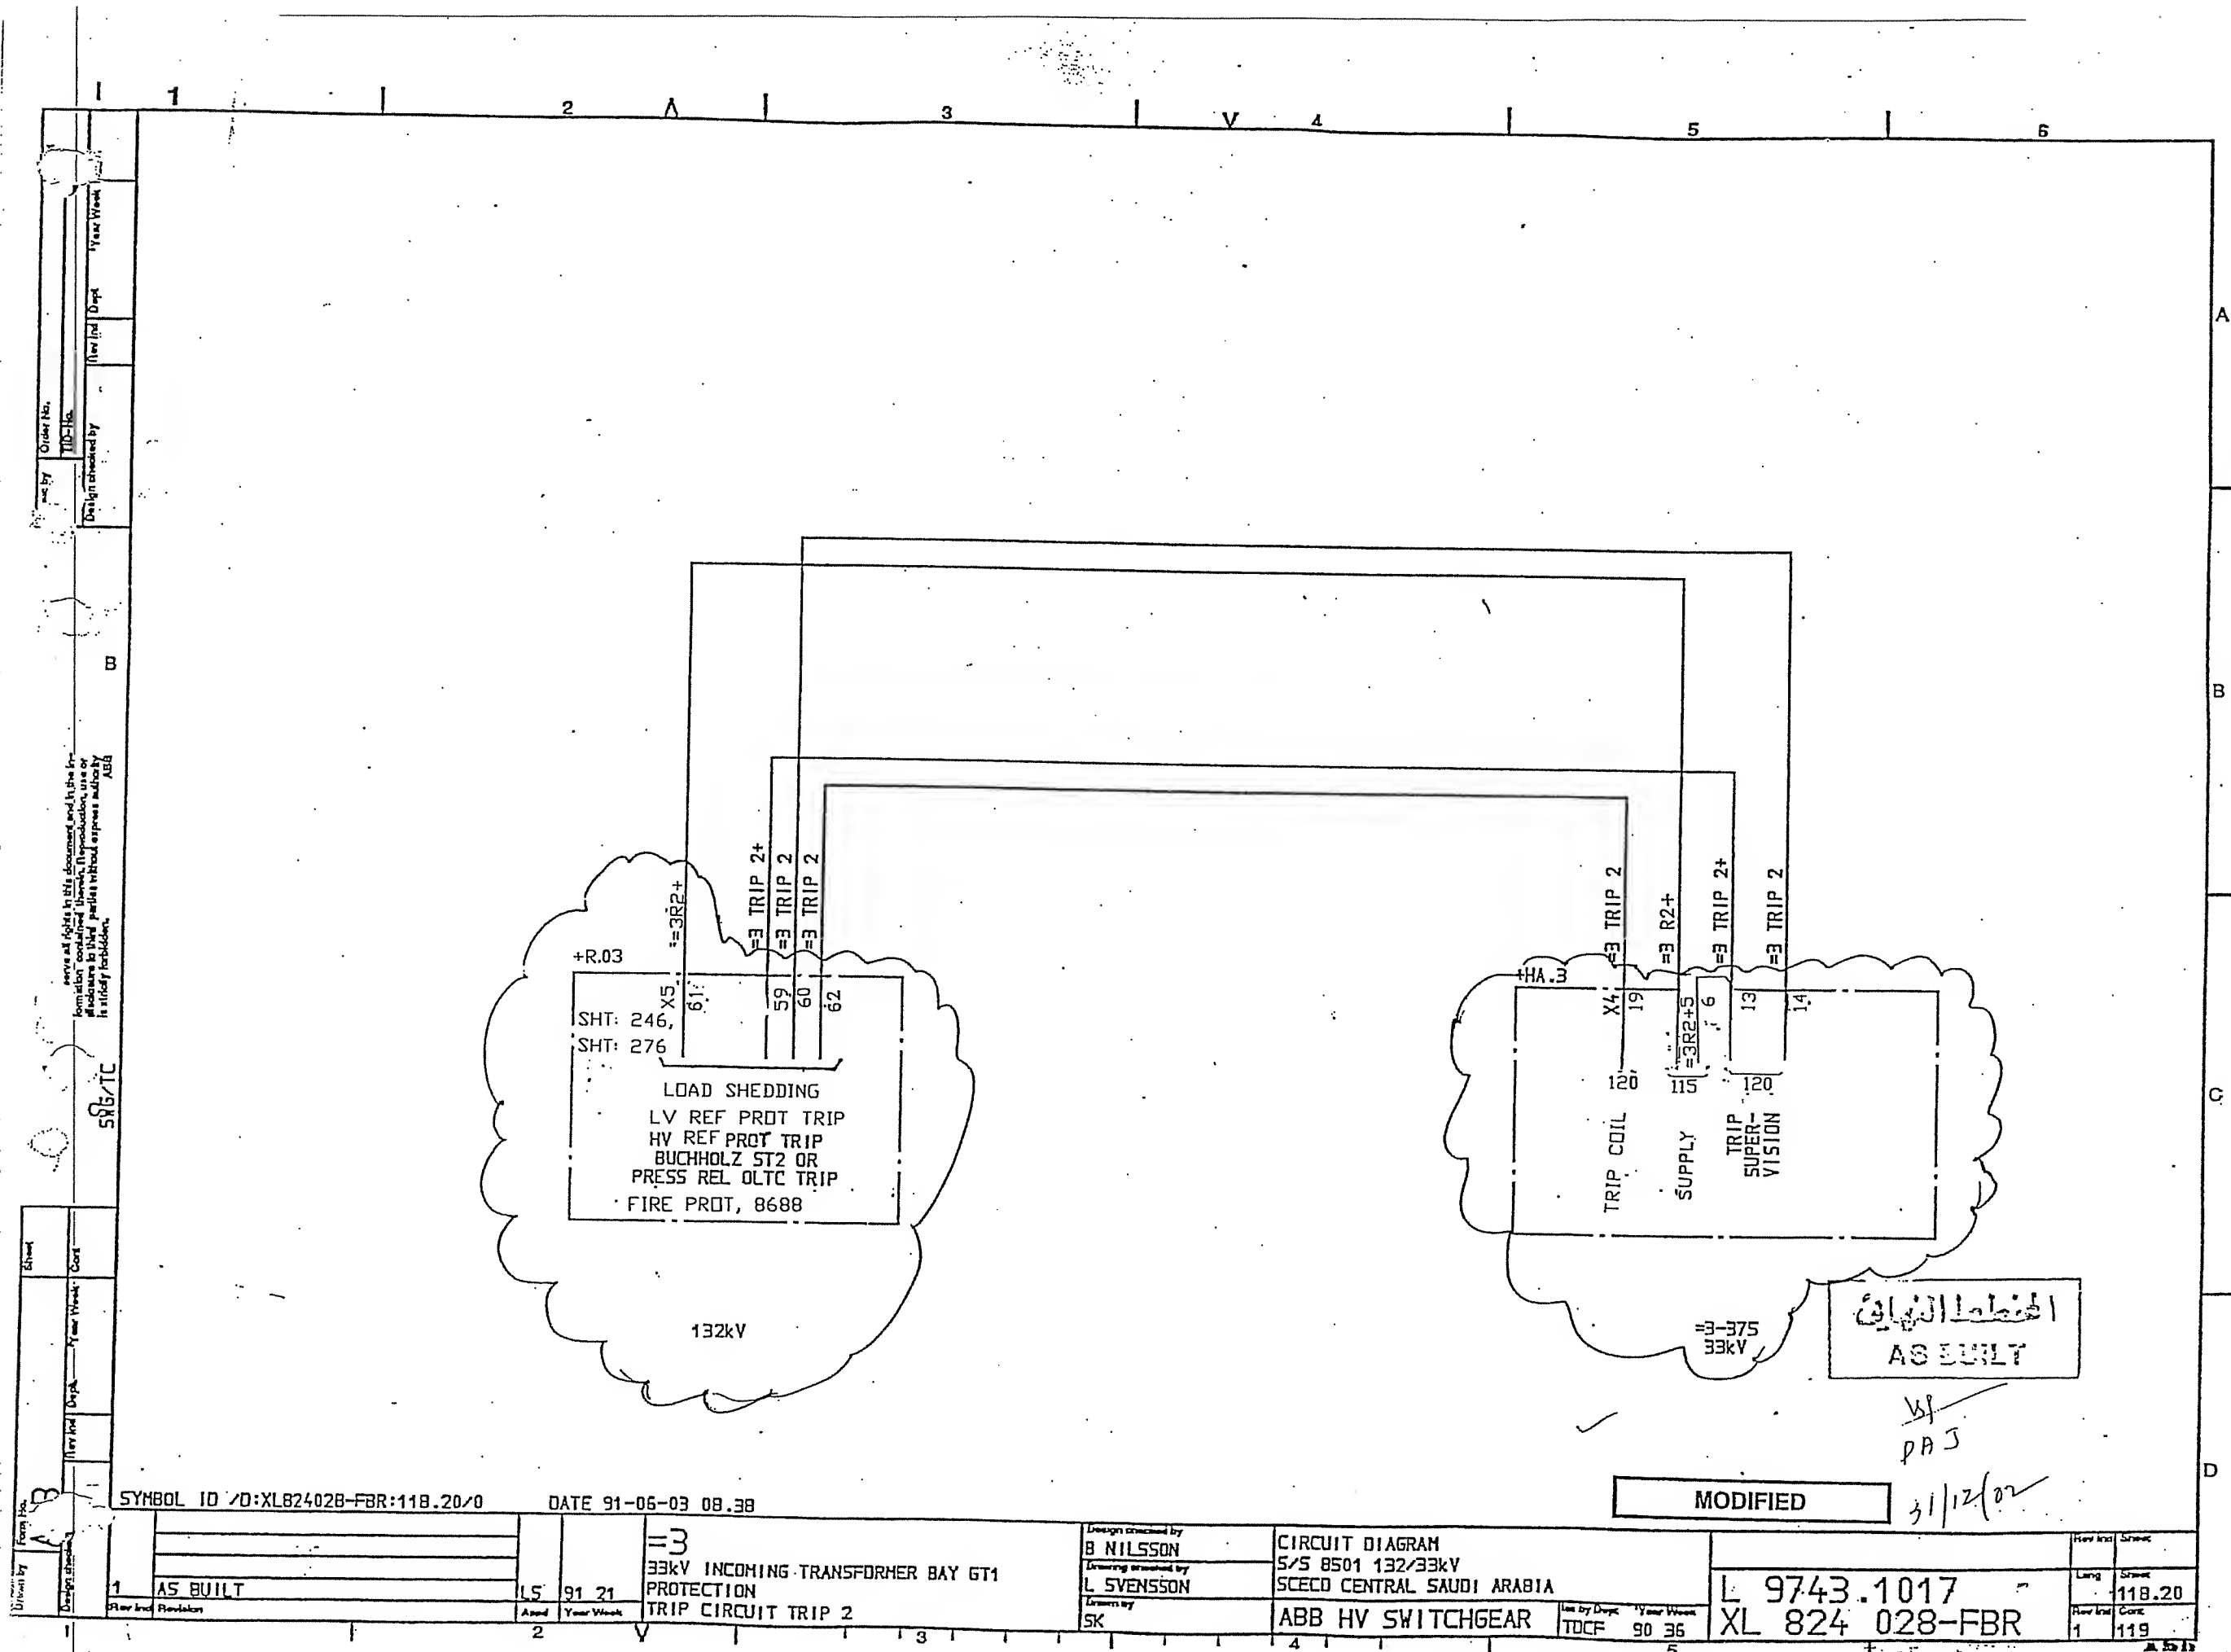

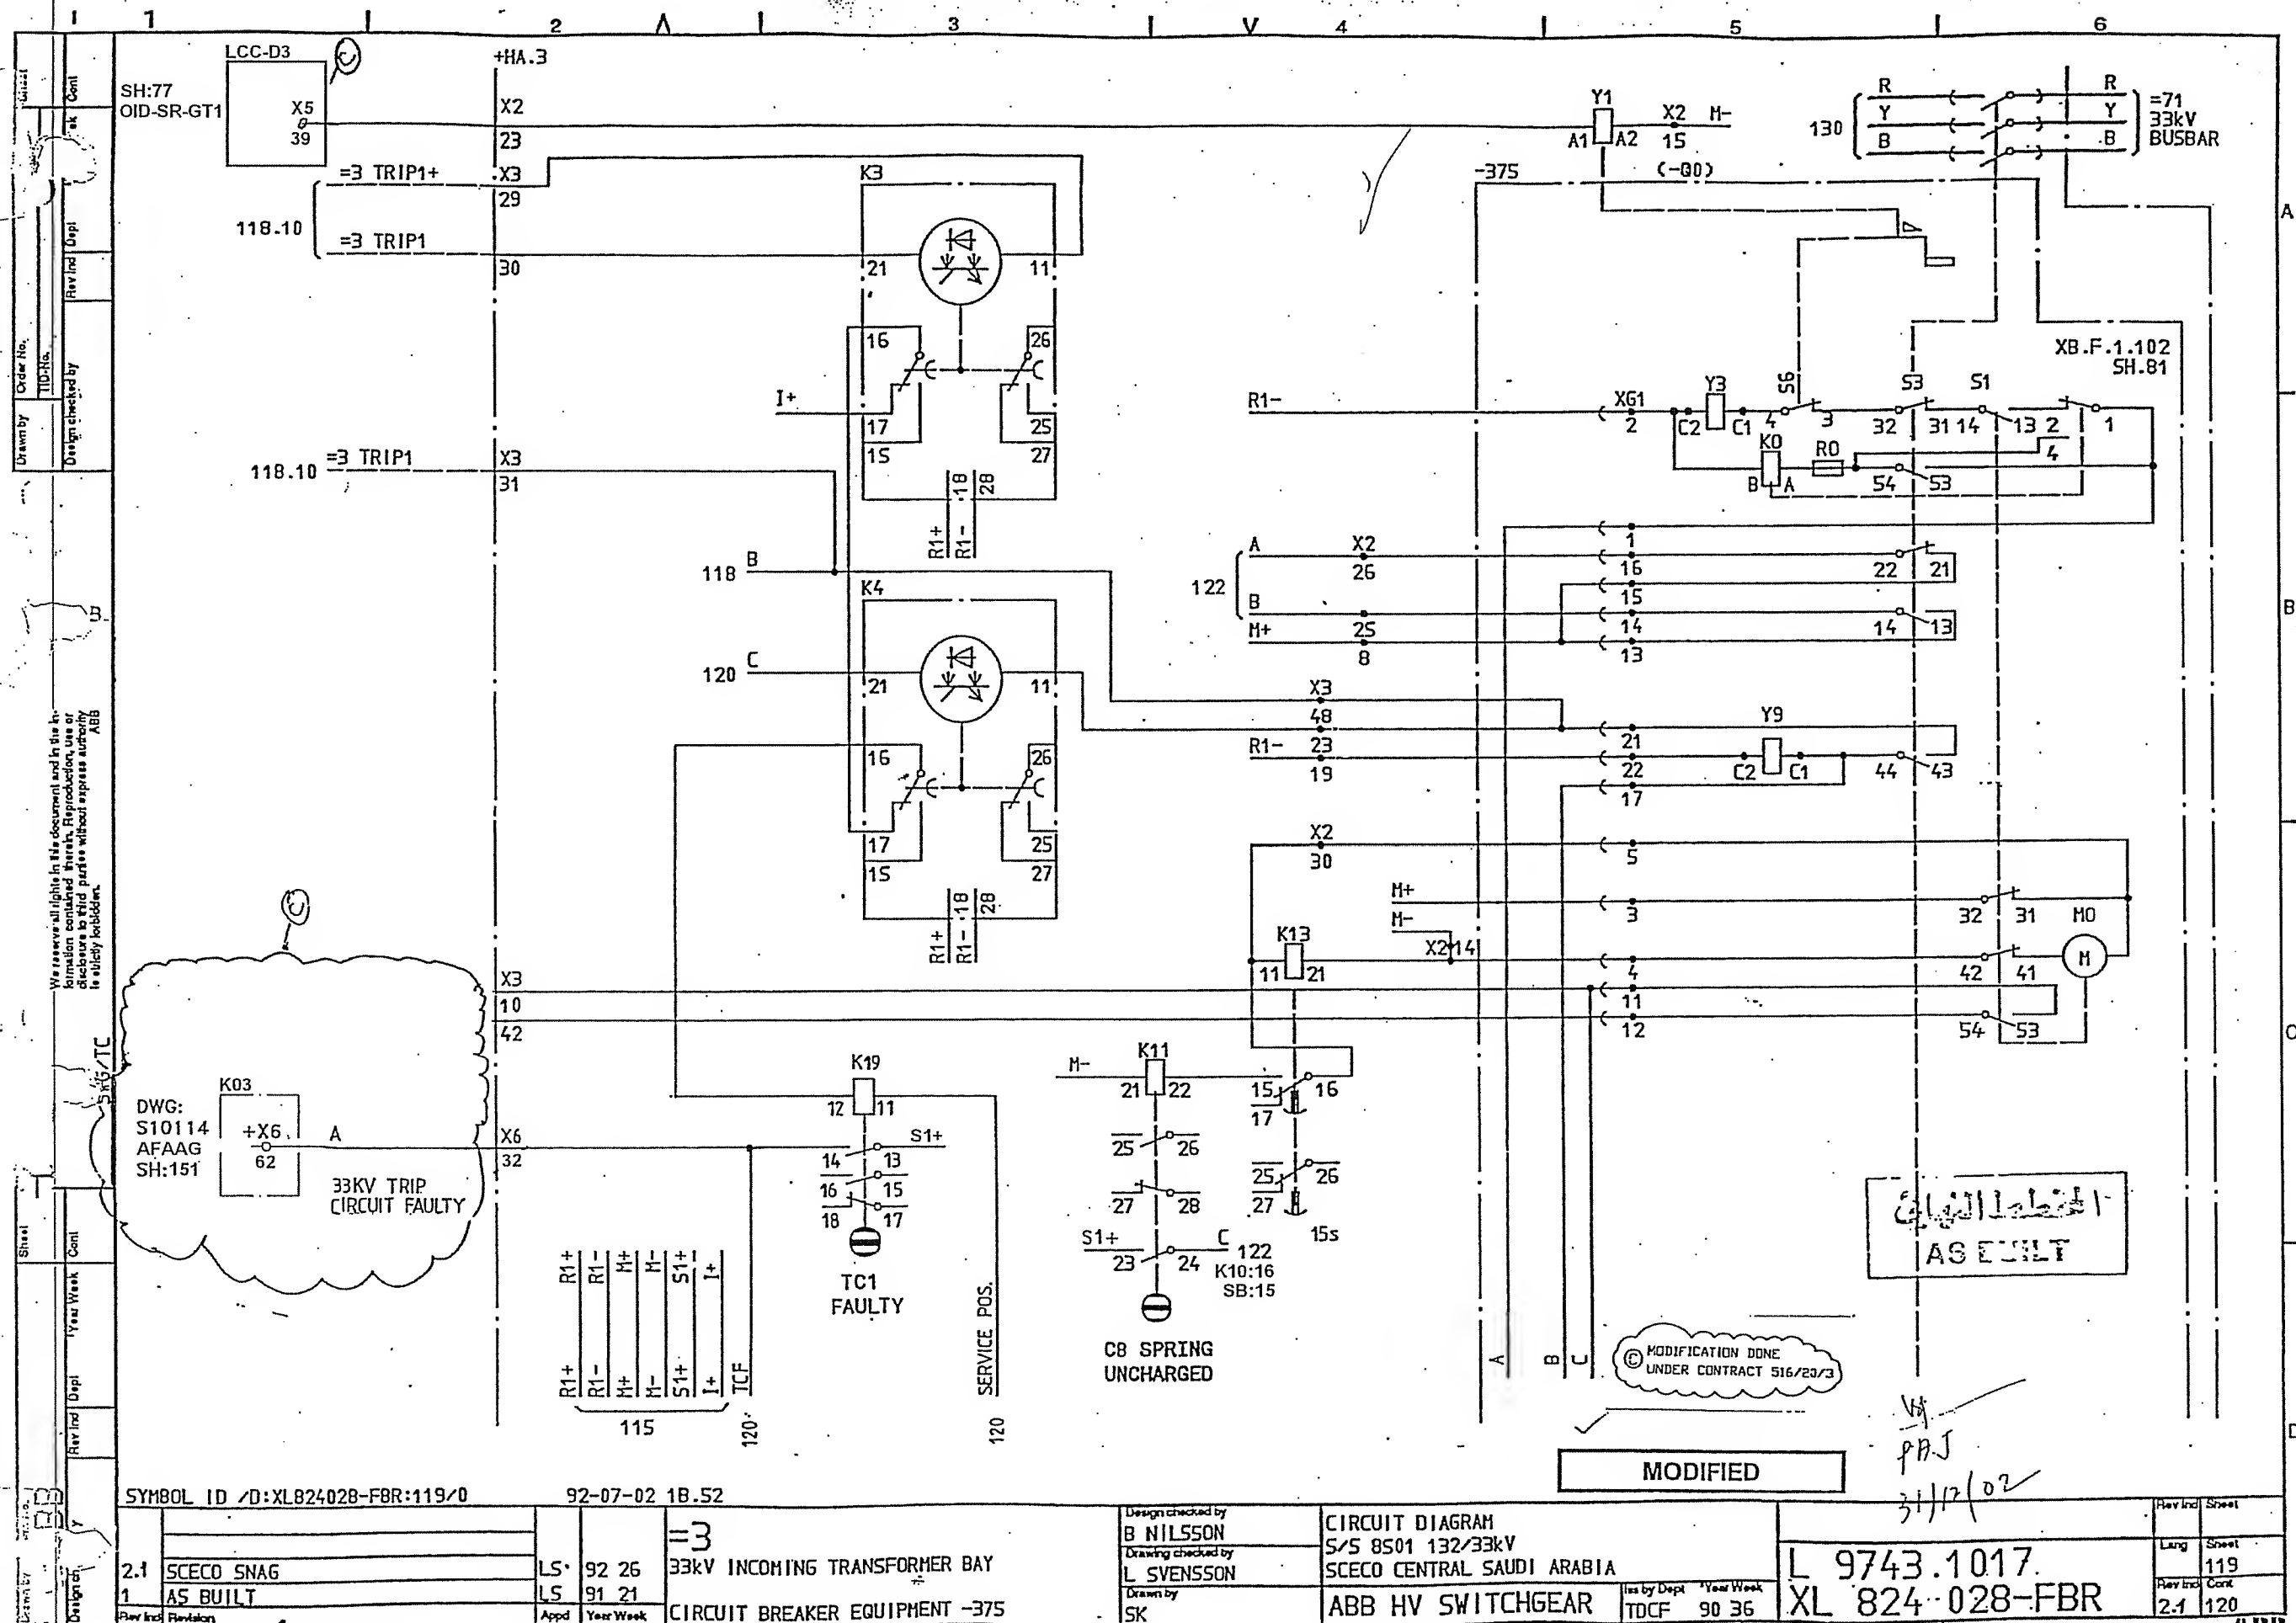

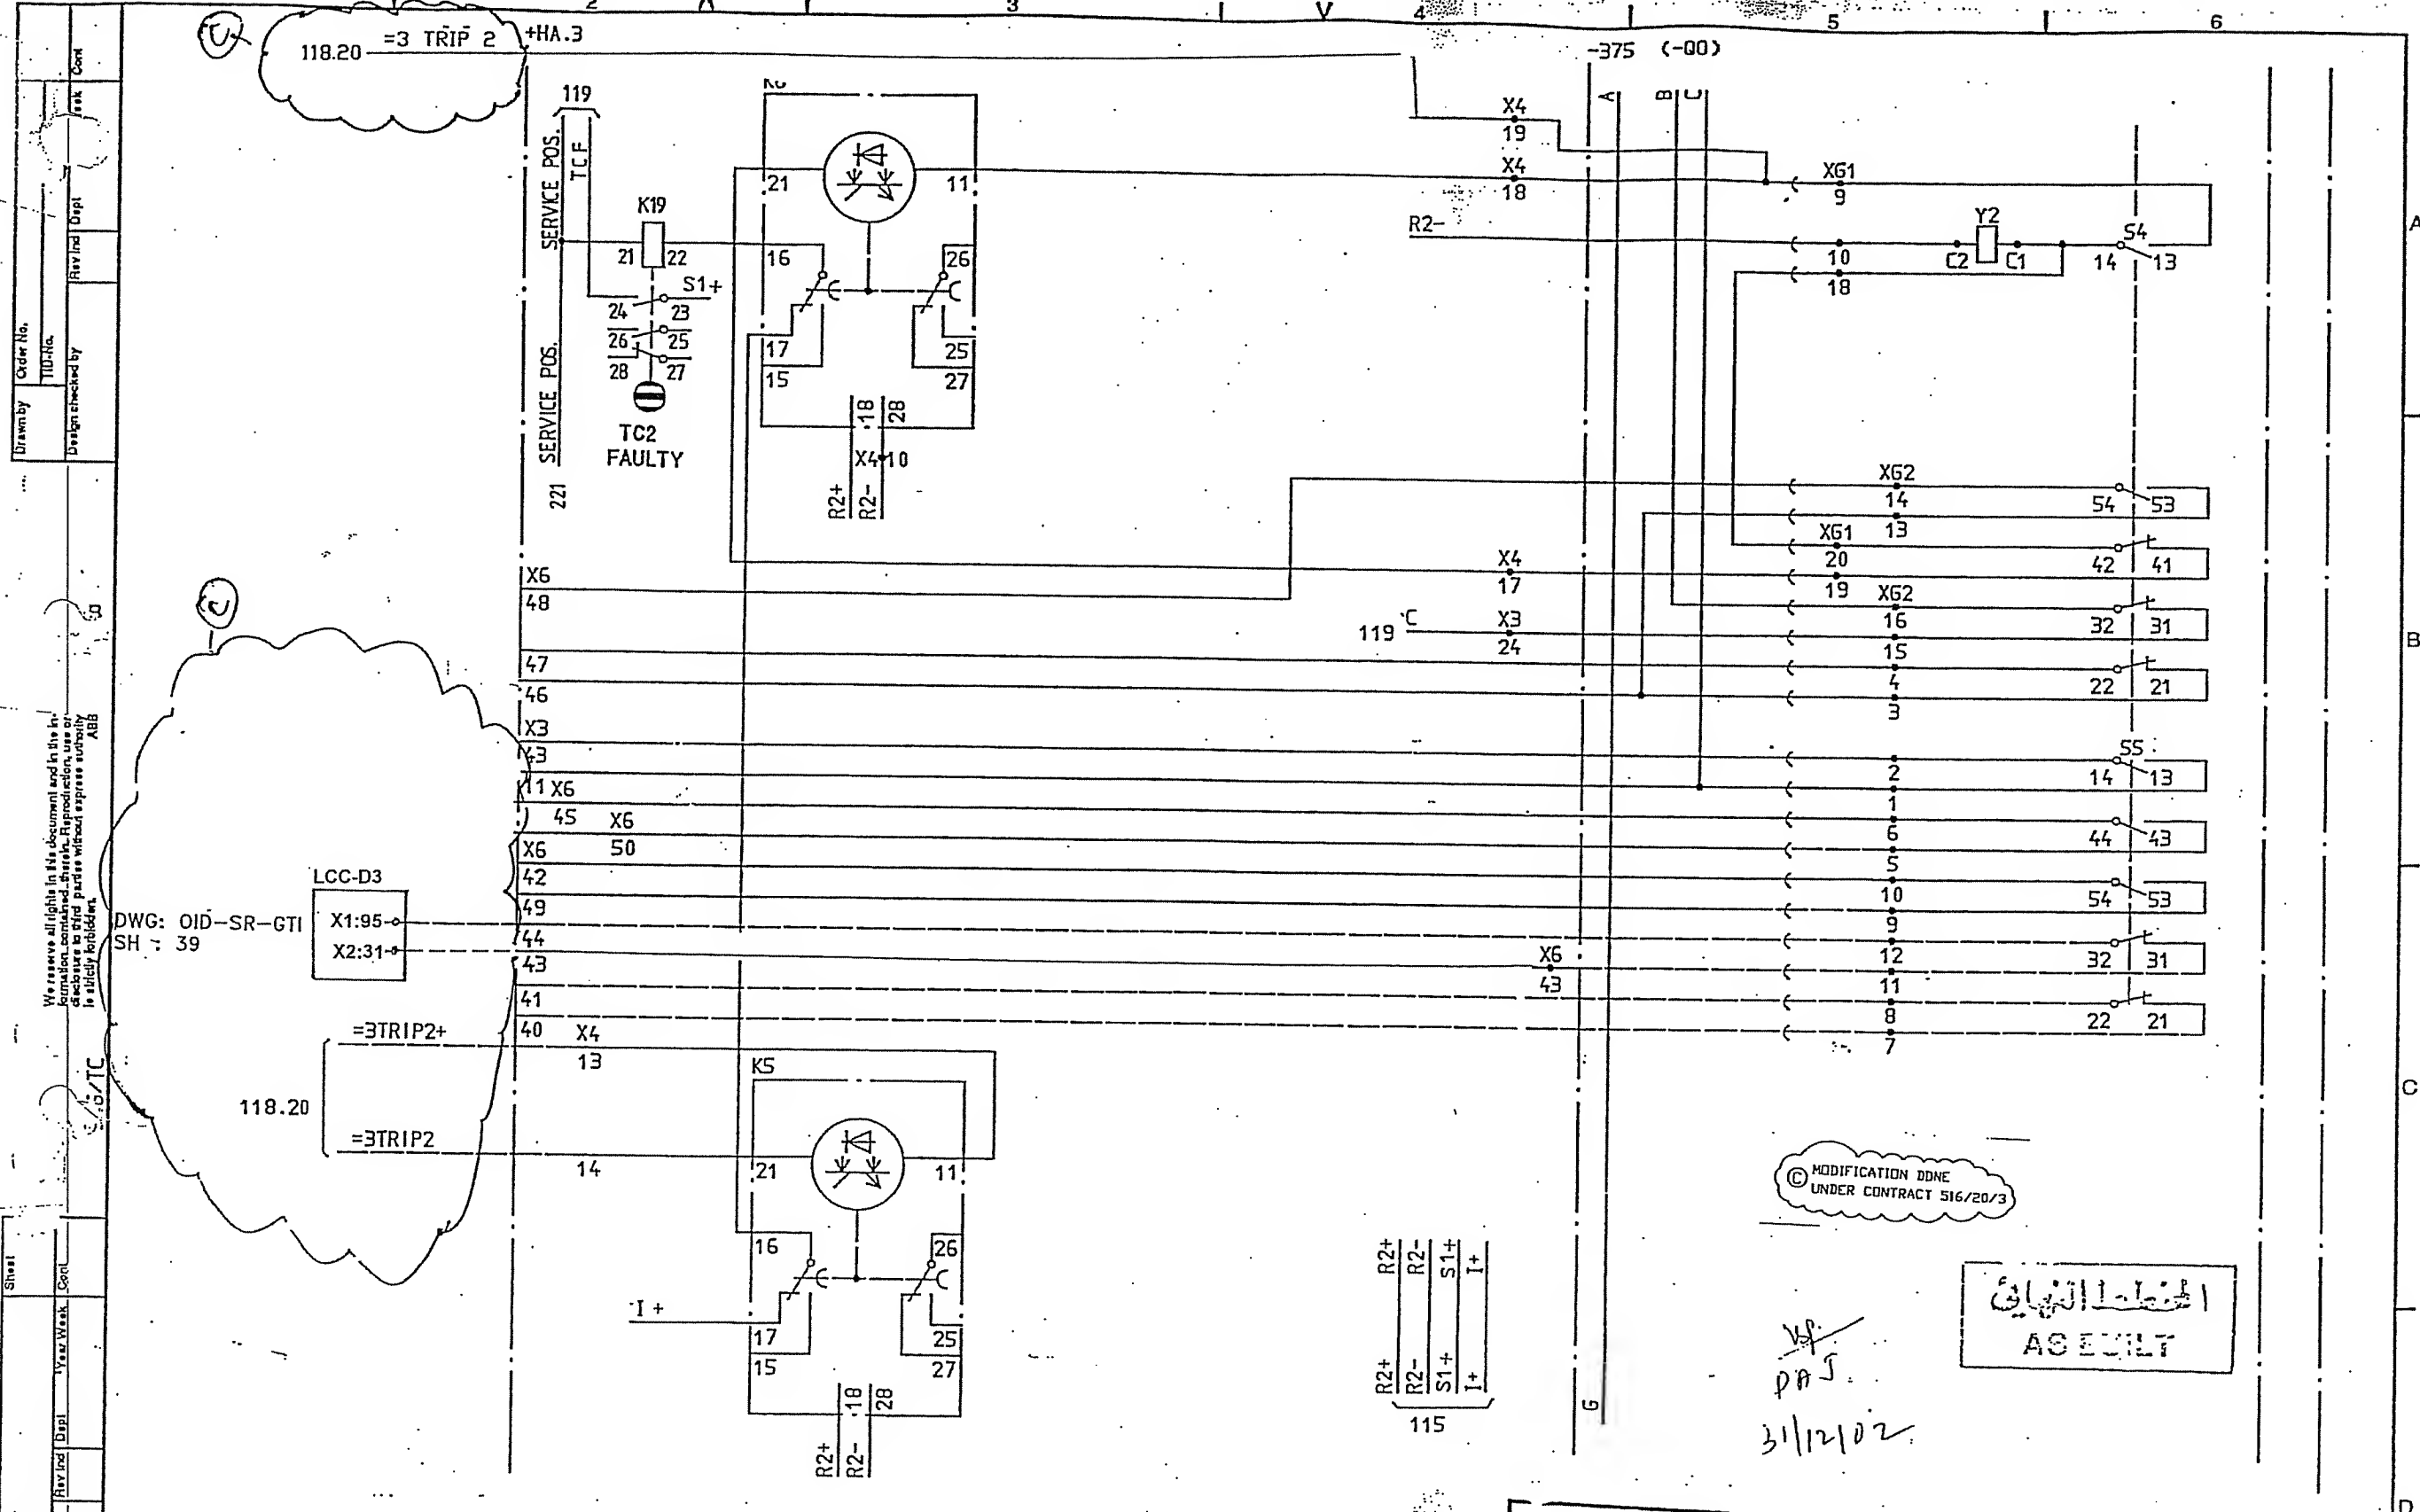

© MODIFICATION DDNE
UNDER CONTRACT 516/20/3

الهيئة العامة للغذاء والدواء
AS ECUIT

31/12/02

MODIFIED


SYMBOL ID /D:XL824028-FBR:120/0


92-07-02 18.52

| | | | | | | | | |
|---------|------------|------|-----------|--------------------------------|----------------------------------|---|---------|-------|
| 2.1 | SCECO SNAG | LS | 92 26 | 33kV INCOMING TRANSFORMER BAY | Design checked by B NILSSON | CIRCUIT DIAGRAM | Rev Ind | Sheet |
| 1 | AS BUILT | LS | 91 21 | CIRCUIT BREAKER EQUIPMENT -375 | Drawing checked by L SVENSSON | S/S 8501 132/33kV SCECO CENTRAL SAUDI ARABIA | Long | Sheet |
| Rev Ind | Revision | Appd | Year Week | | Drawn by SK | ABB HV SWITCHGEAR | Rev Ind | Cont |
| | | | | | | Use by Dept TDCF | 90 36 | 120 |
| | | | | | | | | 121 |

L 9743.1017
XL 824 028-FBR

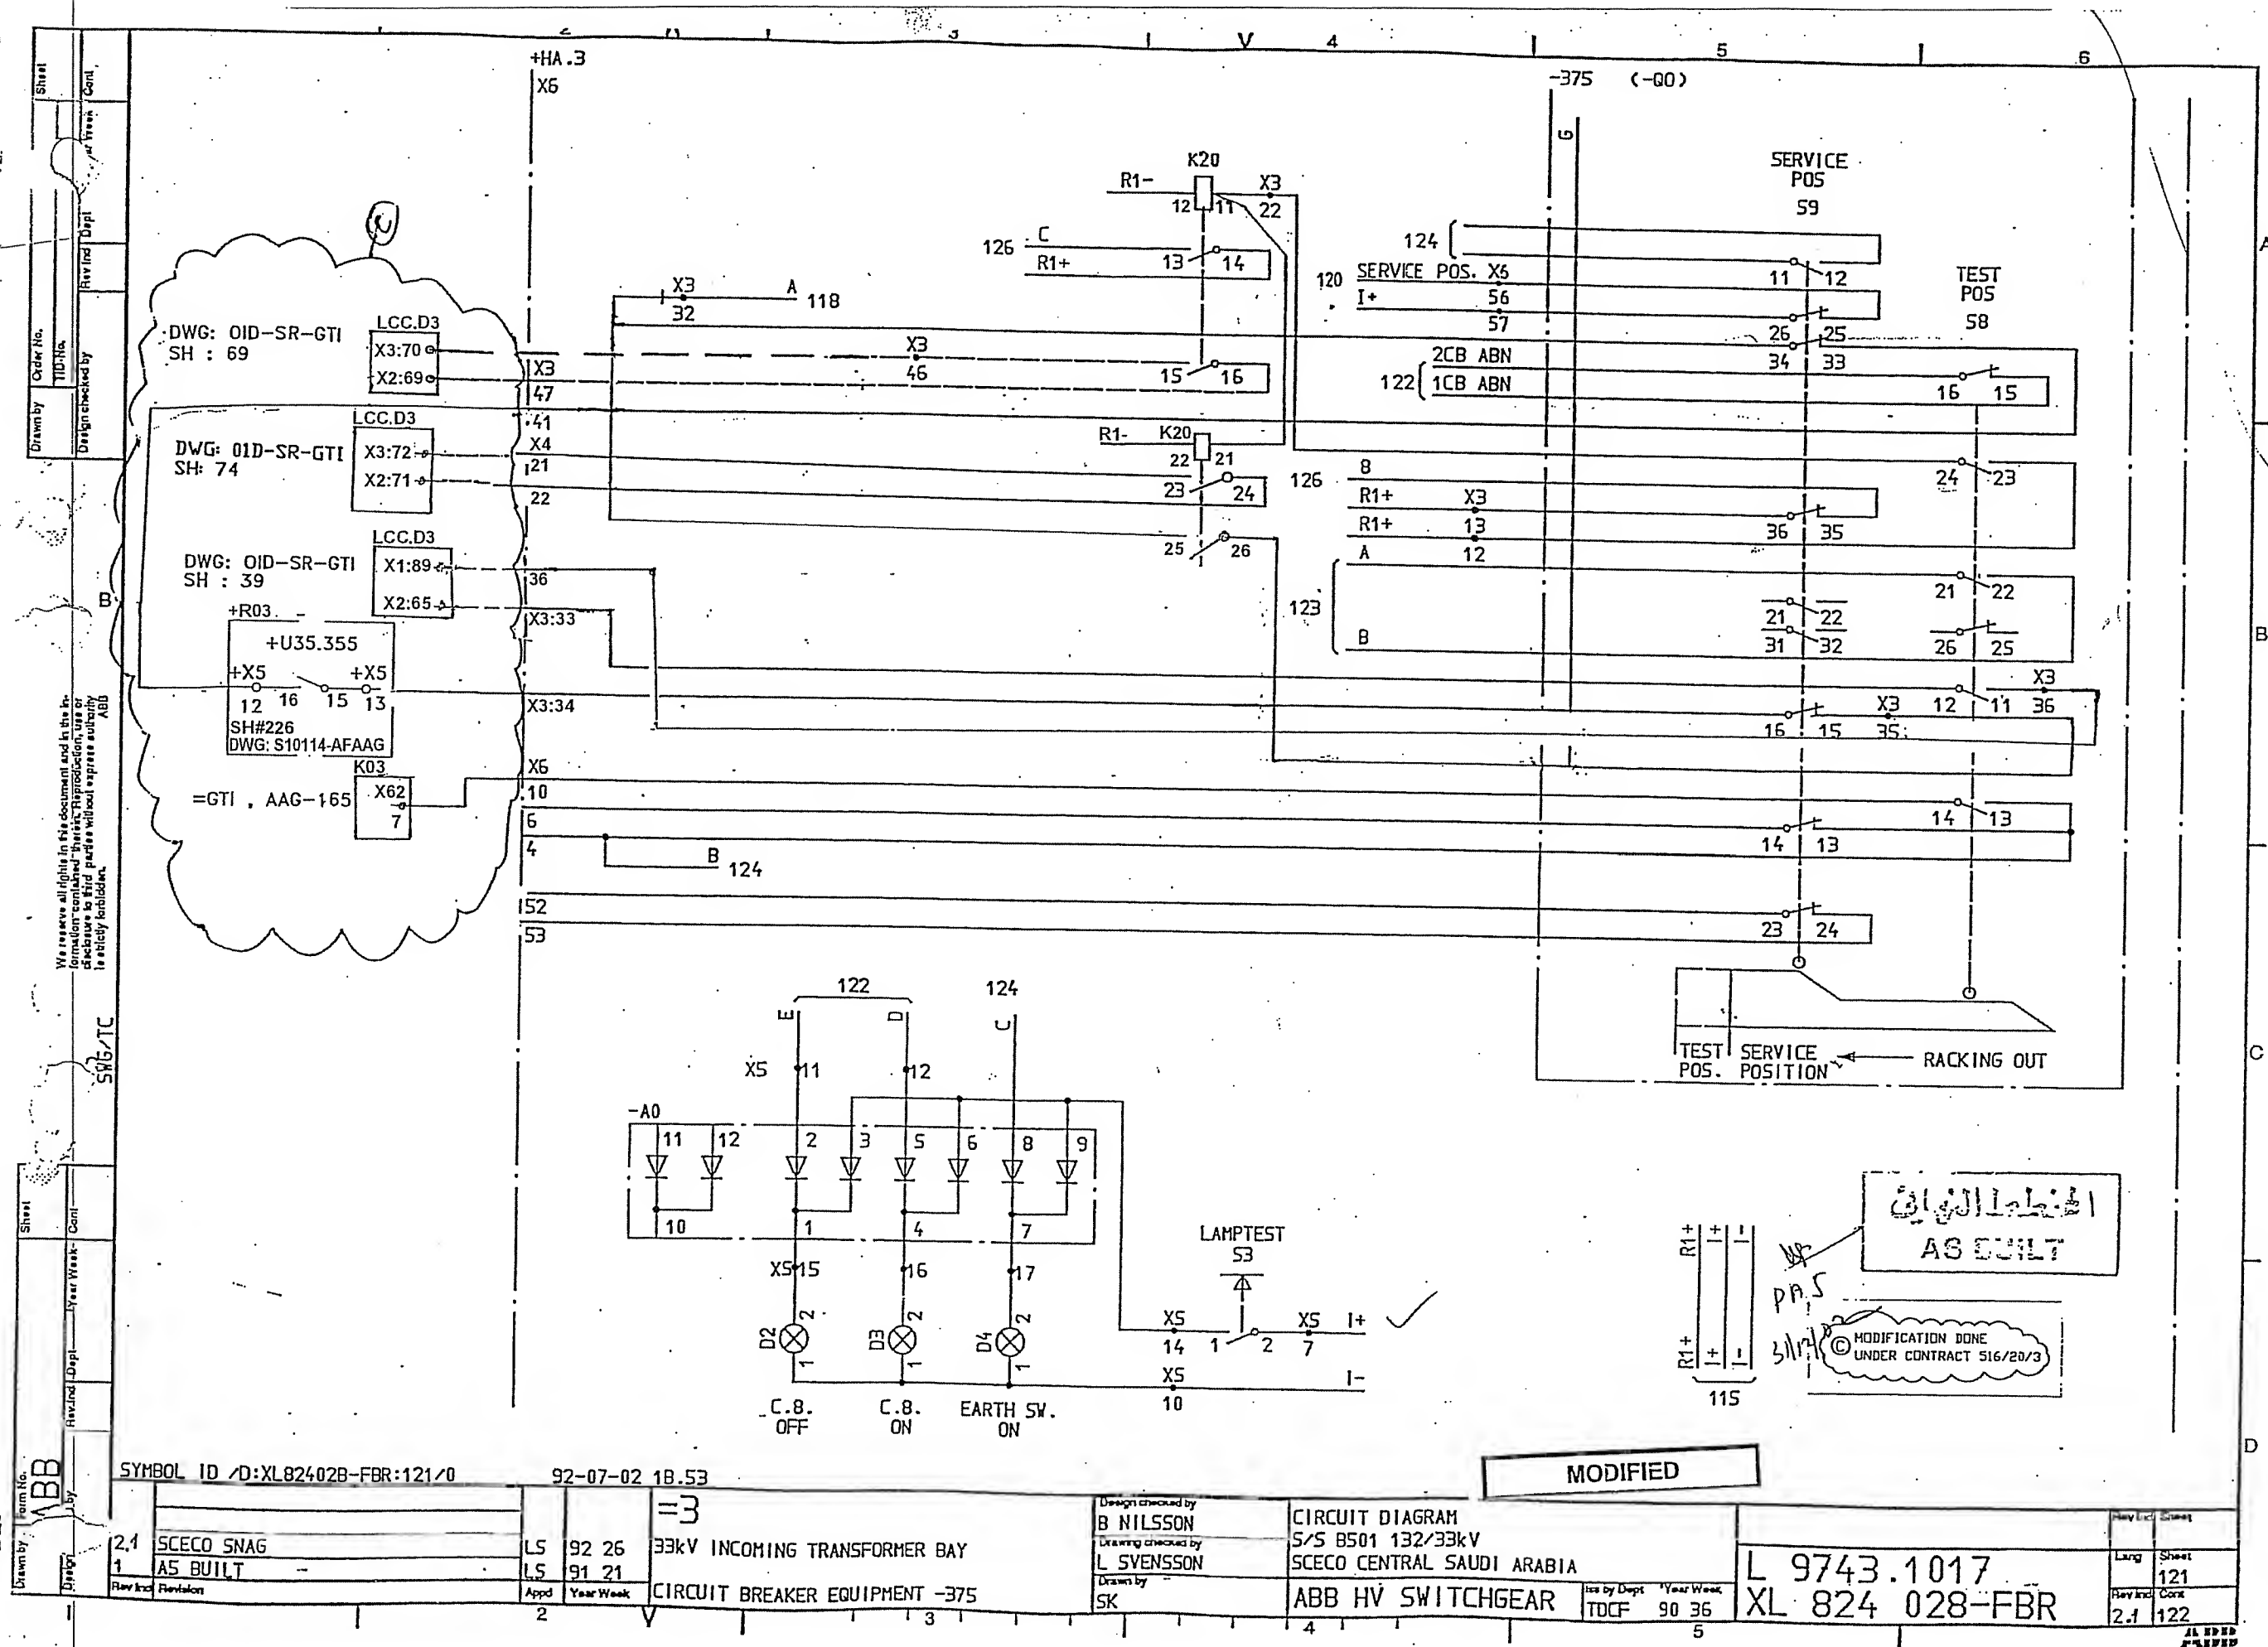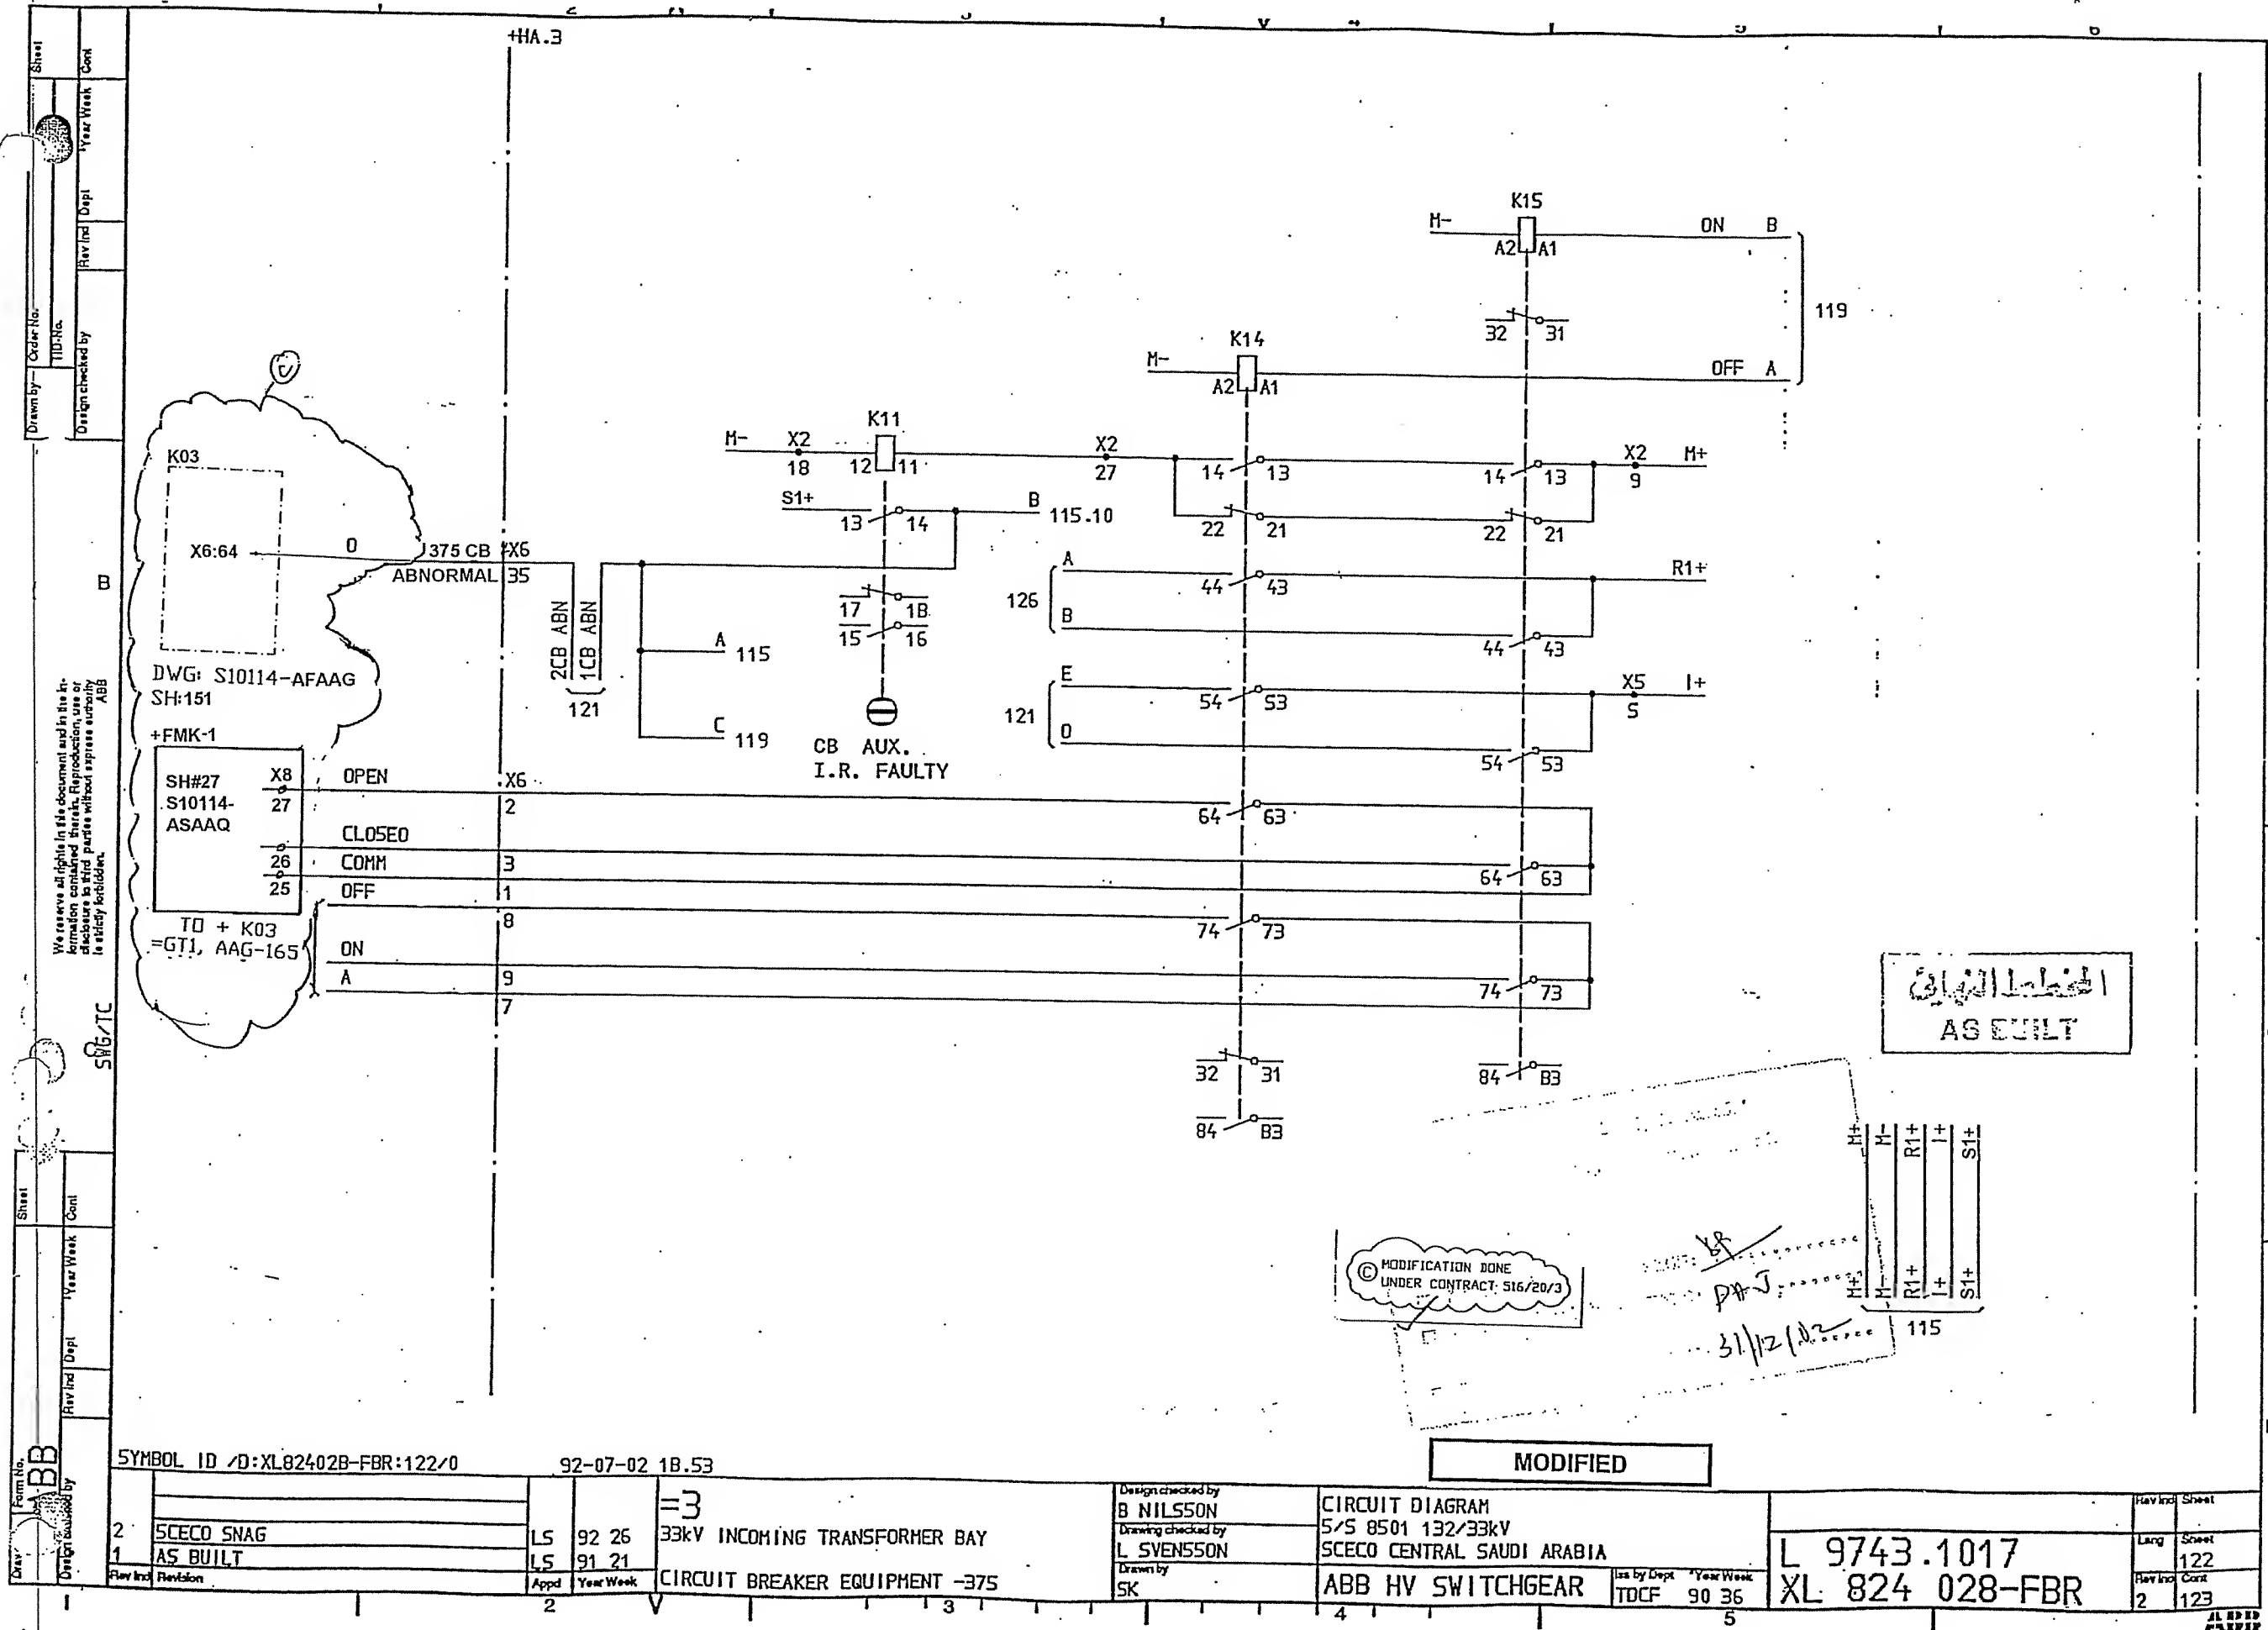ADD PART





الخطة النهائية
AS BUILT

SYMBOL ID /D:XL82402B-FBR:122/0

92-07-02 1B.53


MODIFIED

| | | | | | |
|-----|------------|----------|-------|----------|--------------------------------|
| 2 | SCECO SNAG | LS | 92 26 | 3 | 33kV INCOMING TRANSFORMER BAY |
| 1 | AS BUILT | LS | 91 21 | | |
| Rev | Ind | Revision | Appd | YearWeek | CIRCUIT BREAKER EQUIPMENT -375 |
| | | | 2 | | |


| | | |
|--------------------|------------|----------------------------|
| Design checked by | B NILSSON | CIRCUIT DIAGRAM |
| Drawing checked by | L SVENSSON | 5/S 8501 132/33kV |
| Drawn by | SK | SCECO CENTRAL SAUDI ARABIA |
| Iss by Dept | TDCF | ABB HV SWITCHGEAR |
| YearWeek | 90 36 | |


| | | |
|-----|-----|-------|
| Rev | Ind | Sheet |
| | | Lang |
| | | Sheet |
| | | Cont |
| 2 | | 123 |

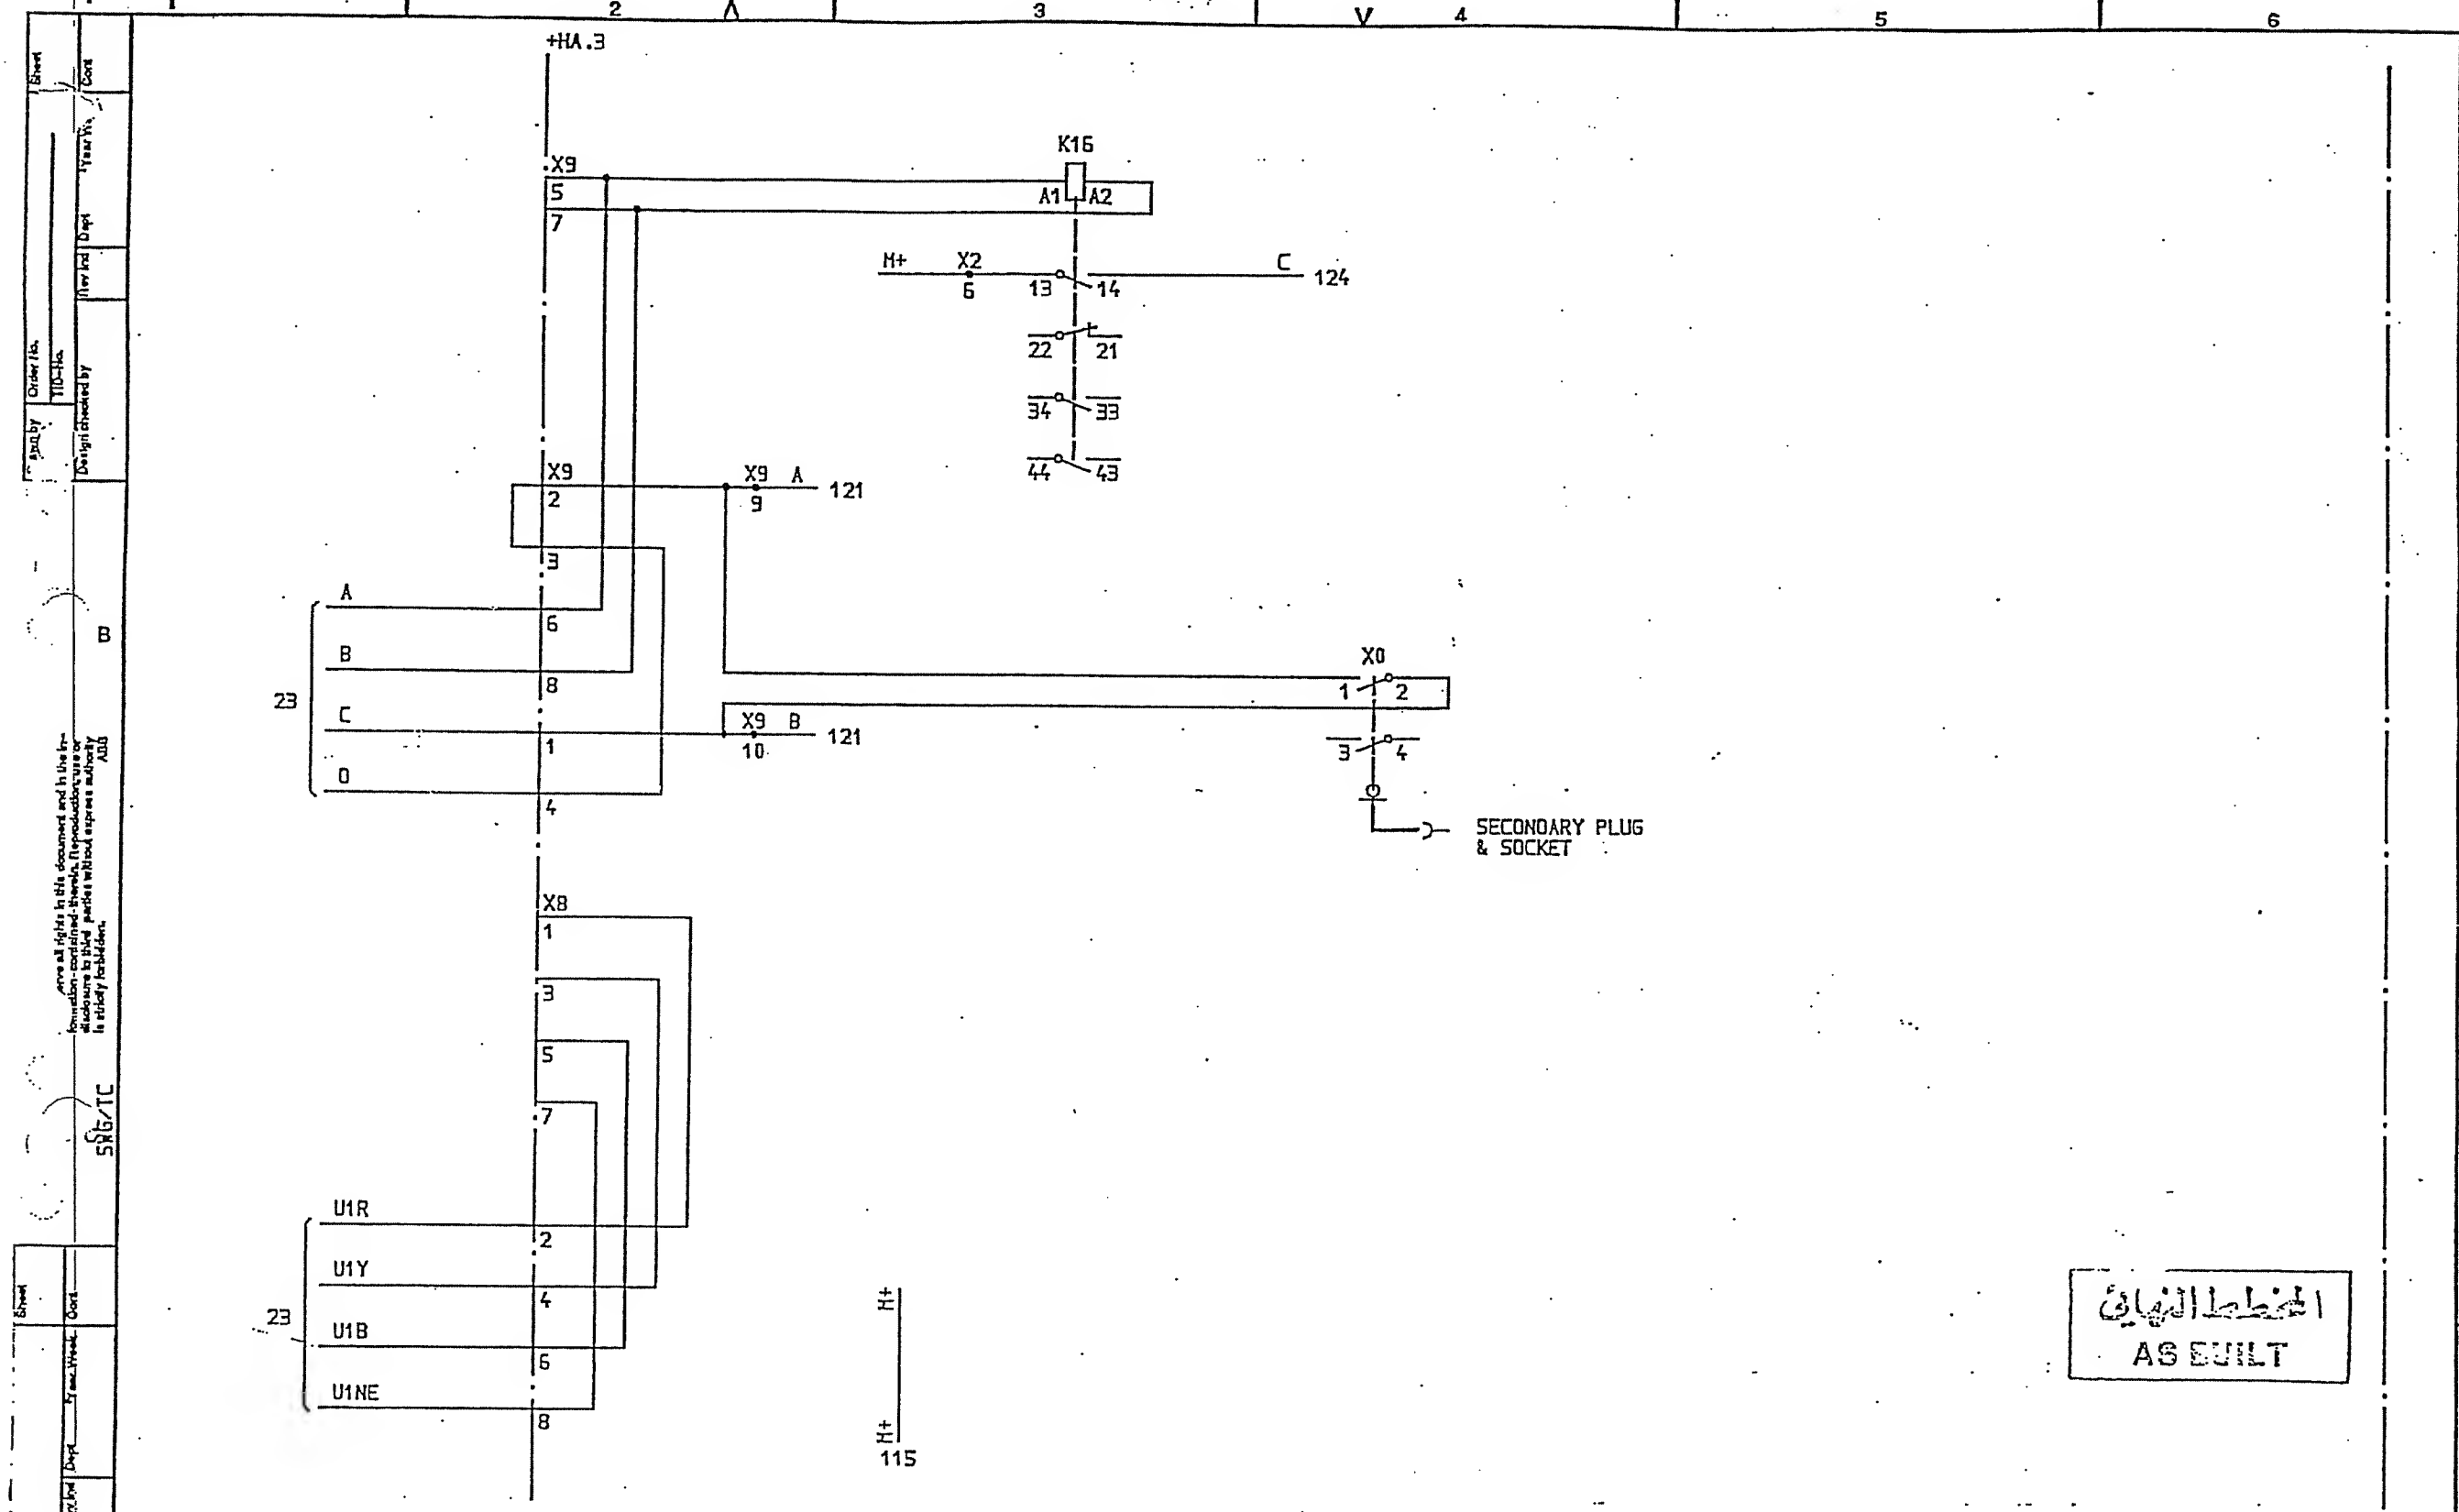L 9743.1017
XL 824 028-FBR





| | | | | | | | | | |
|-----------------------------------|--|-------------------------------|--|----------------------------------|--|--|--|---------------|--|
| SYMBOL 10 /D:XL824028-FBR:123/0 | | DATE 91-06-03 08.39 | | Design checked by B NILSSON | | CIRCUIT DIAGRAM S/S 8501 132/33kV SCECO CENTRAL SAUDI ARABIA | | Rev Int Sheet | |
| A5 BUILT | | L5 91 21 | | Drawing checked by L SVENSSON | | L 9743.1017 | | Lang Sheet | |
| INTERLOCKING RELAY FOR C.B. TRUCK | | 33kV INCOMING TRANSFORMER BAY | | Drawn by SK | | ABB HV SWITCHGEAR | | Rev Int Sheet | |
| | | | | | | TDCF 90 36 | | 1 123 | |
| | | | | | | | | 1 124 | |

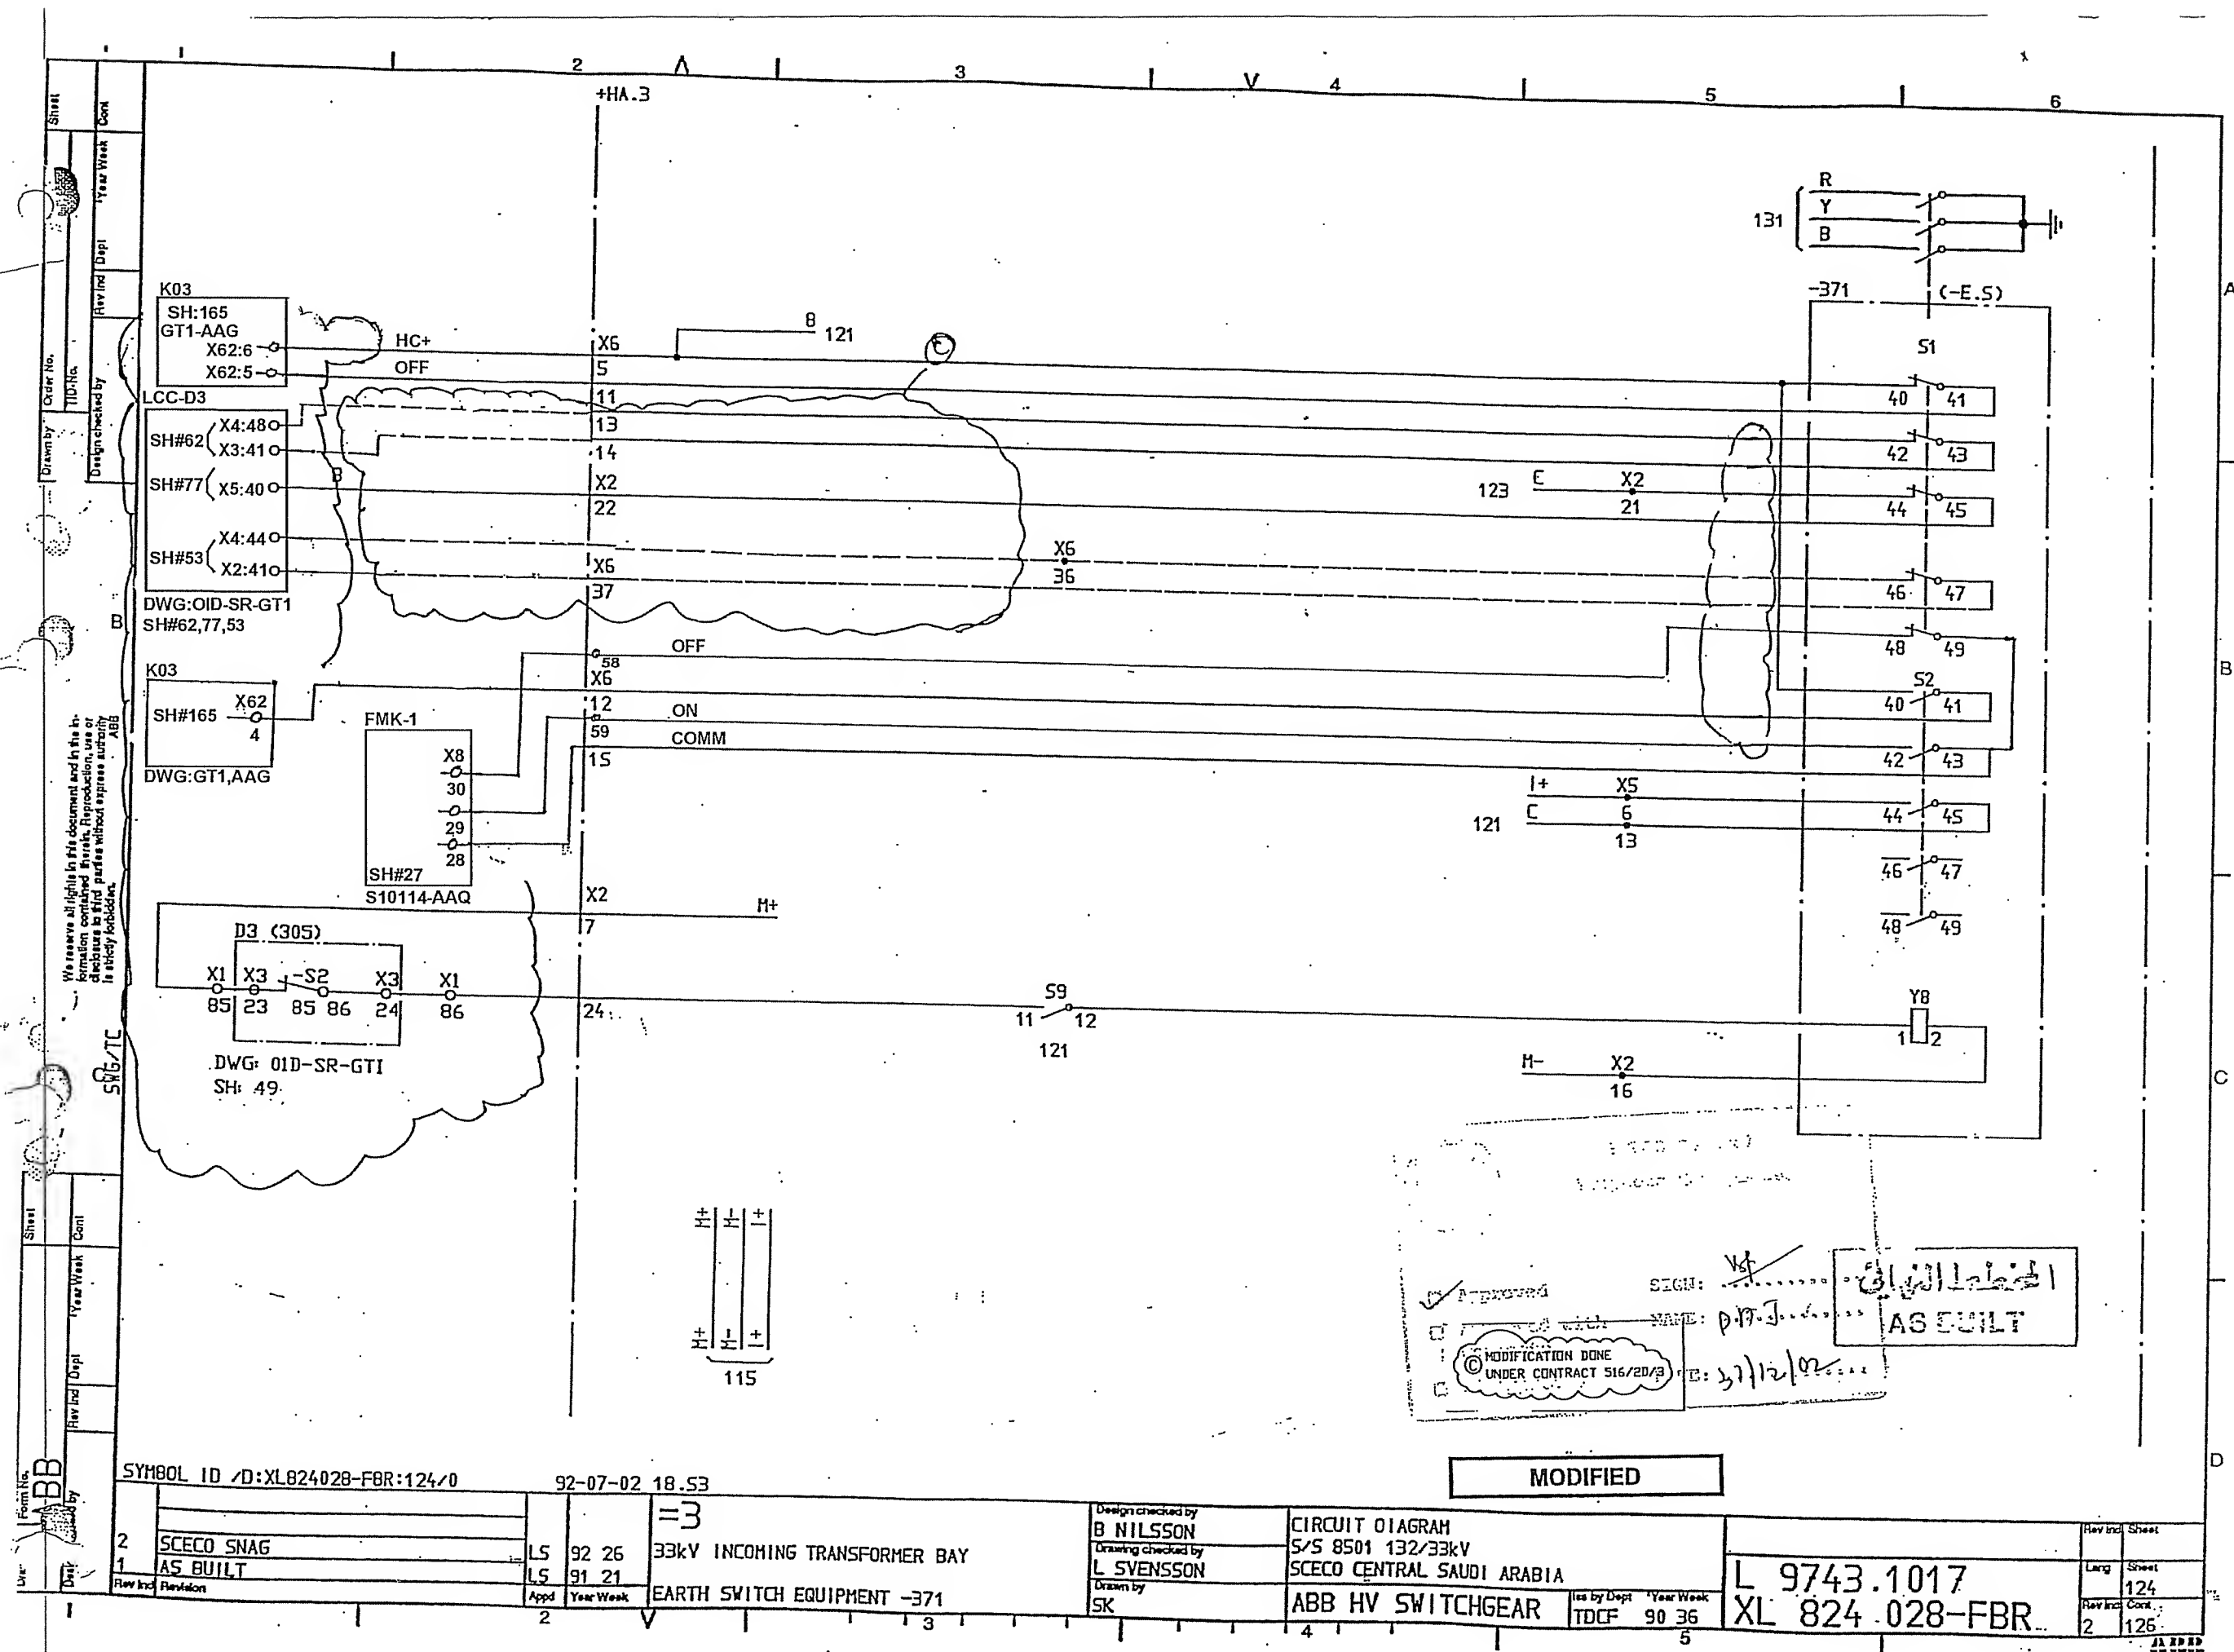

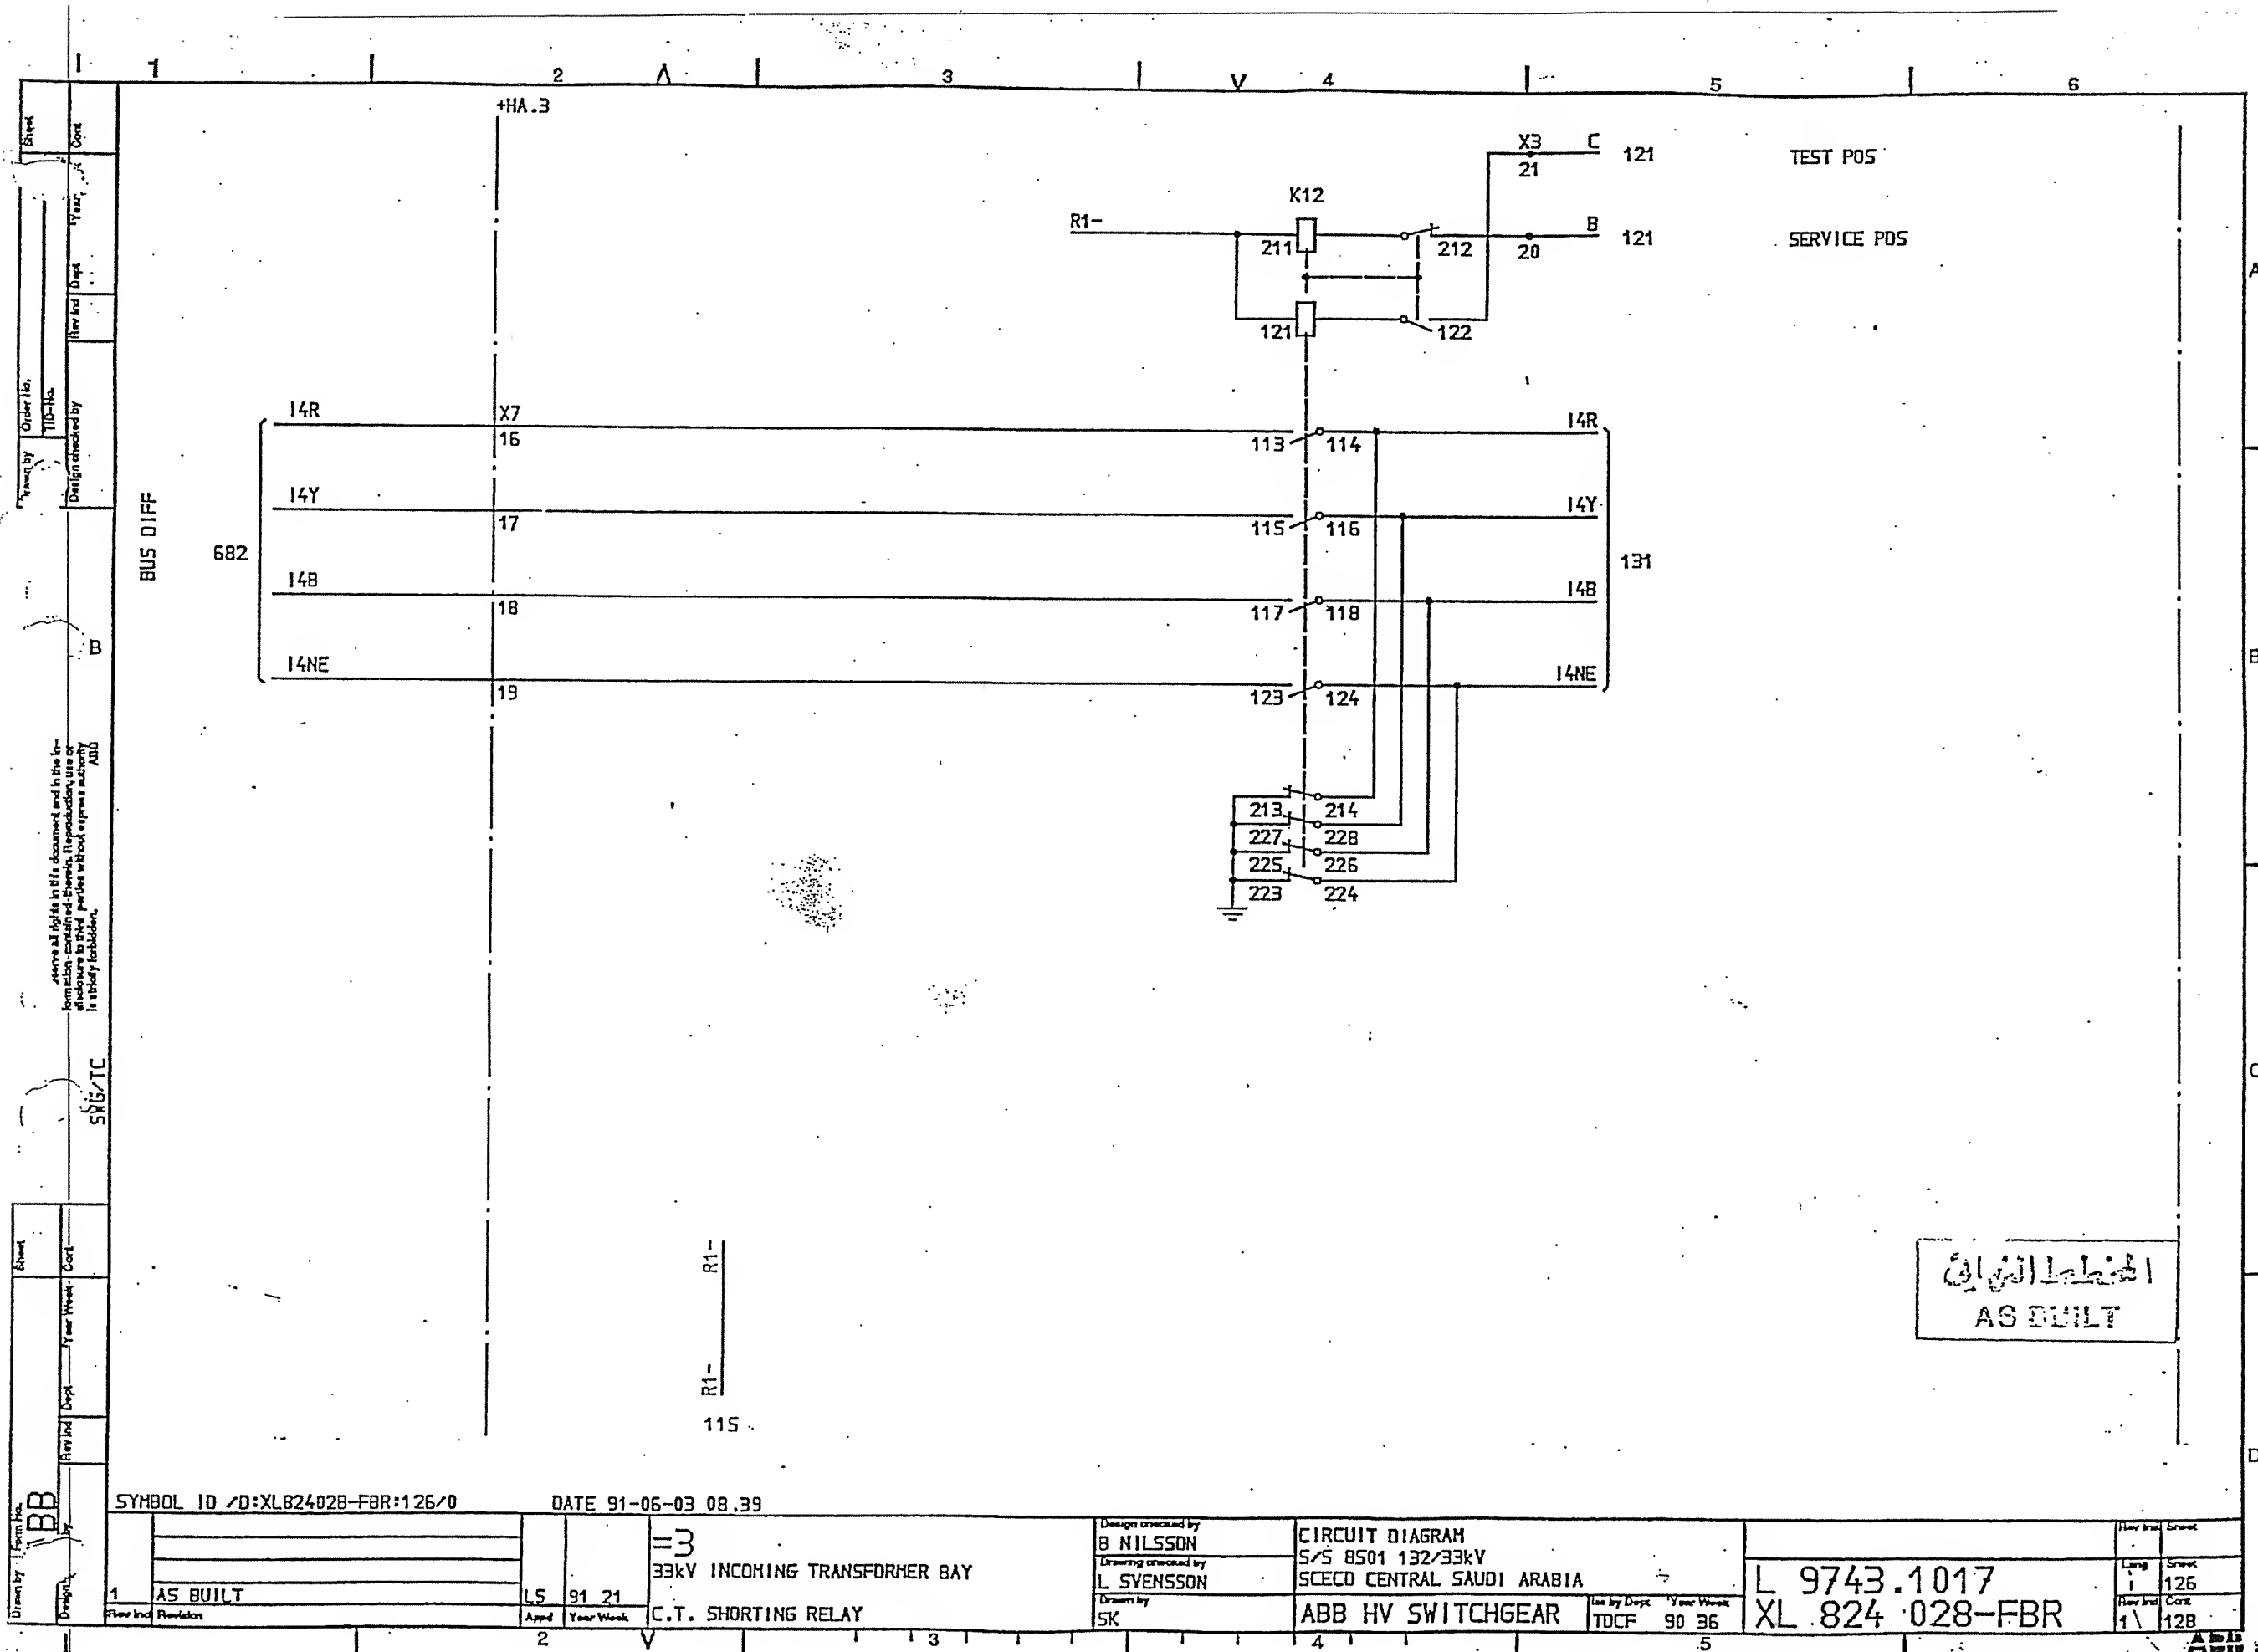

| | | | | | |
|---------------------------------|----------|---------------------|----------|----------------------------------|--------|
| Drawn by: JBB | Sheet: 1 | Order No.: | Year: 91 | Week: 21 | Cont.: |
| Design checked by: B NILSSON | Sheet: 1 | Order No.: | Year: 91 | Week: 21 | Cont.: |
| Design checked by: L SYENSSON | Sheet: 1 | Order No.: | Year: 91 | Week: 21 | Cont.: |
| Design checked by: SK | Sheet: 1 | Order No.: | Year: 91 | Week: 21 | Cont.: |
| SYMBOL ID /D:XL824028-FBR:126/0 | | DATE 91-06-03 08.39 | | | |
| 1 AS BUILT | | LS 91 21 | | =3 33kV INCOMING TRANSFORMER BAY | |
| 2 | | V | | C.T. SHORTING RELAY | |
| 3 | | V | | CIRCUIT DIAGRAM | |
| 4 | | V | | S/S 8501 132/33kV | |
| 5 | | V | | SCECO CENTRAL SAUDI ARABIA | |
| 6 | | V | | ABB HV SWITCHGEAR | |
| 7 | | V | | TDCF 90 36 | |
| 8 | | V | | L 9743.1017 | |
| 9 | | V | | XL 824 028-FBR | |
| 10 | | V | | 128 | |

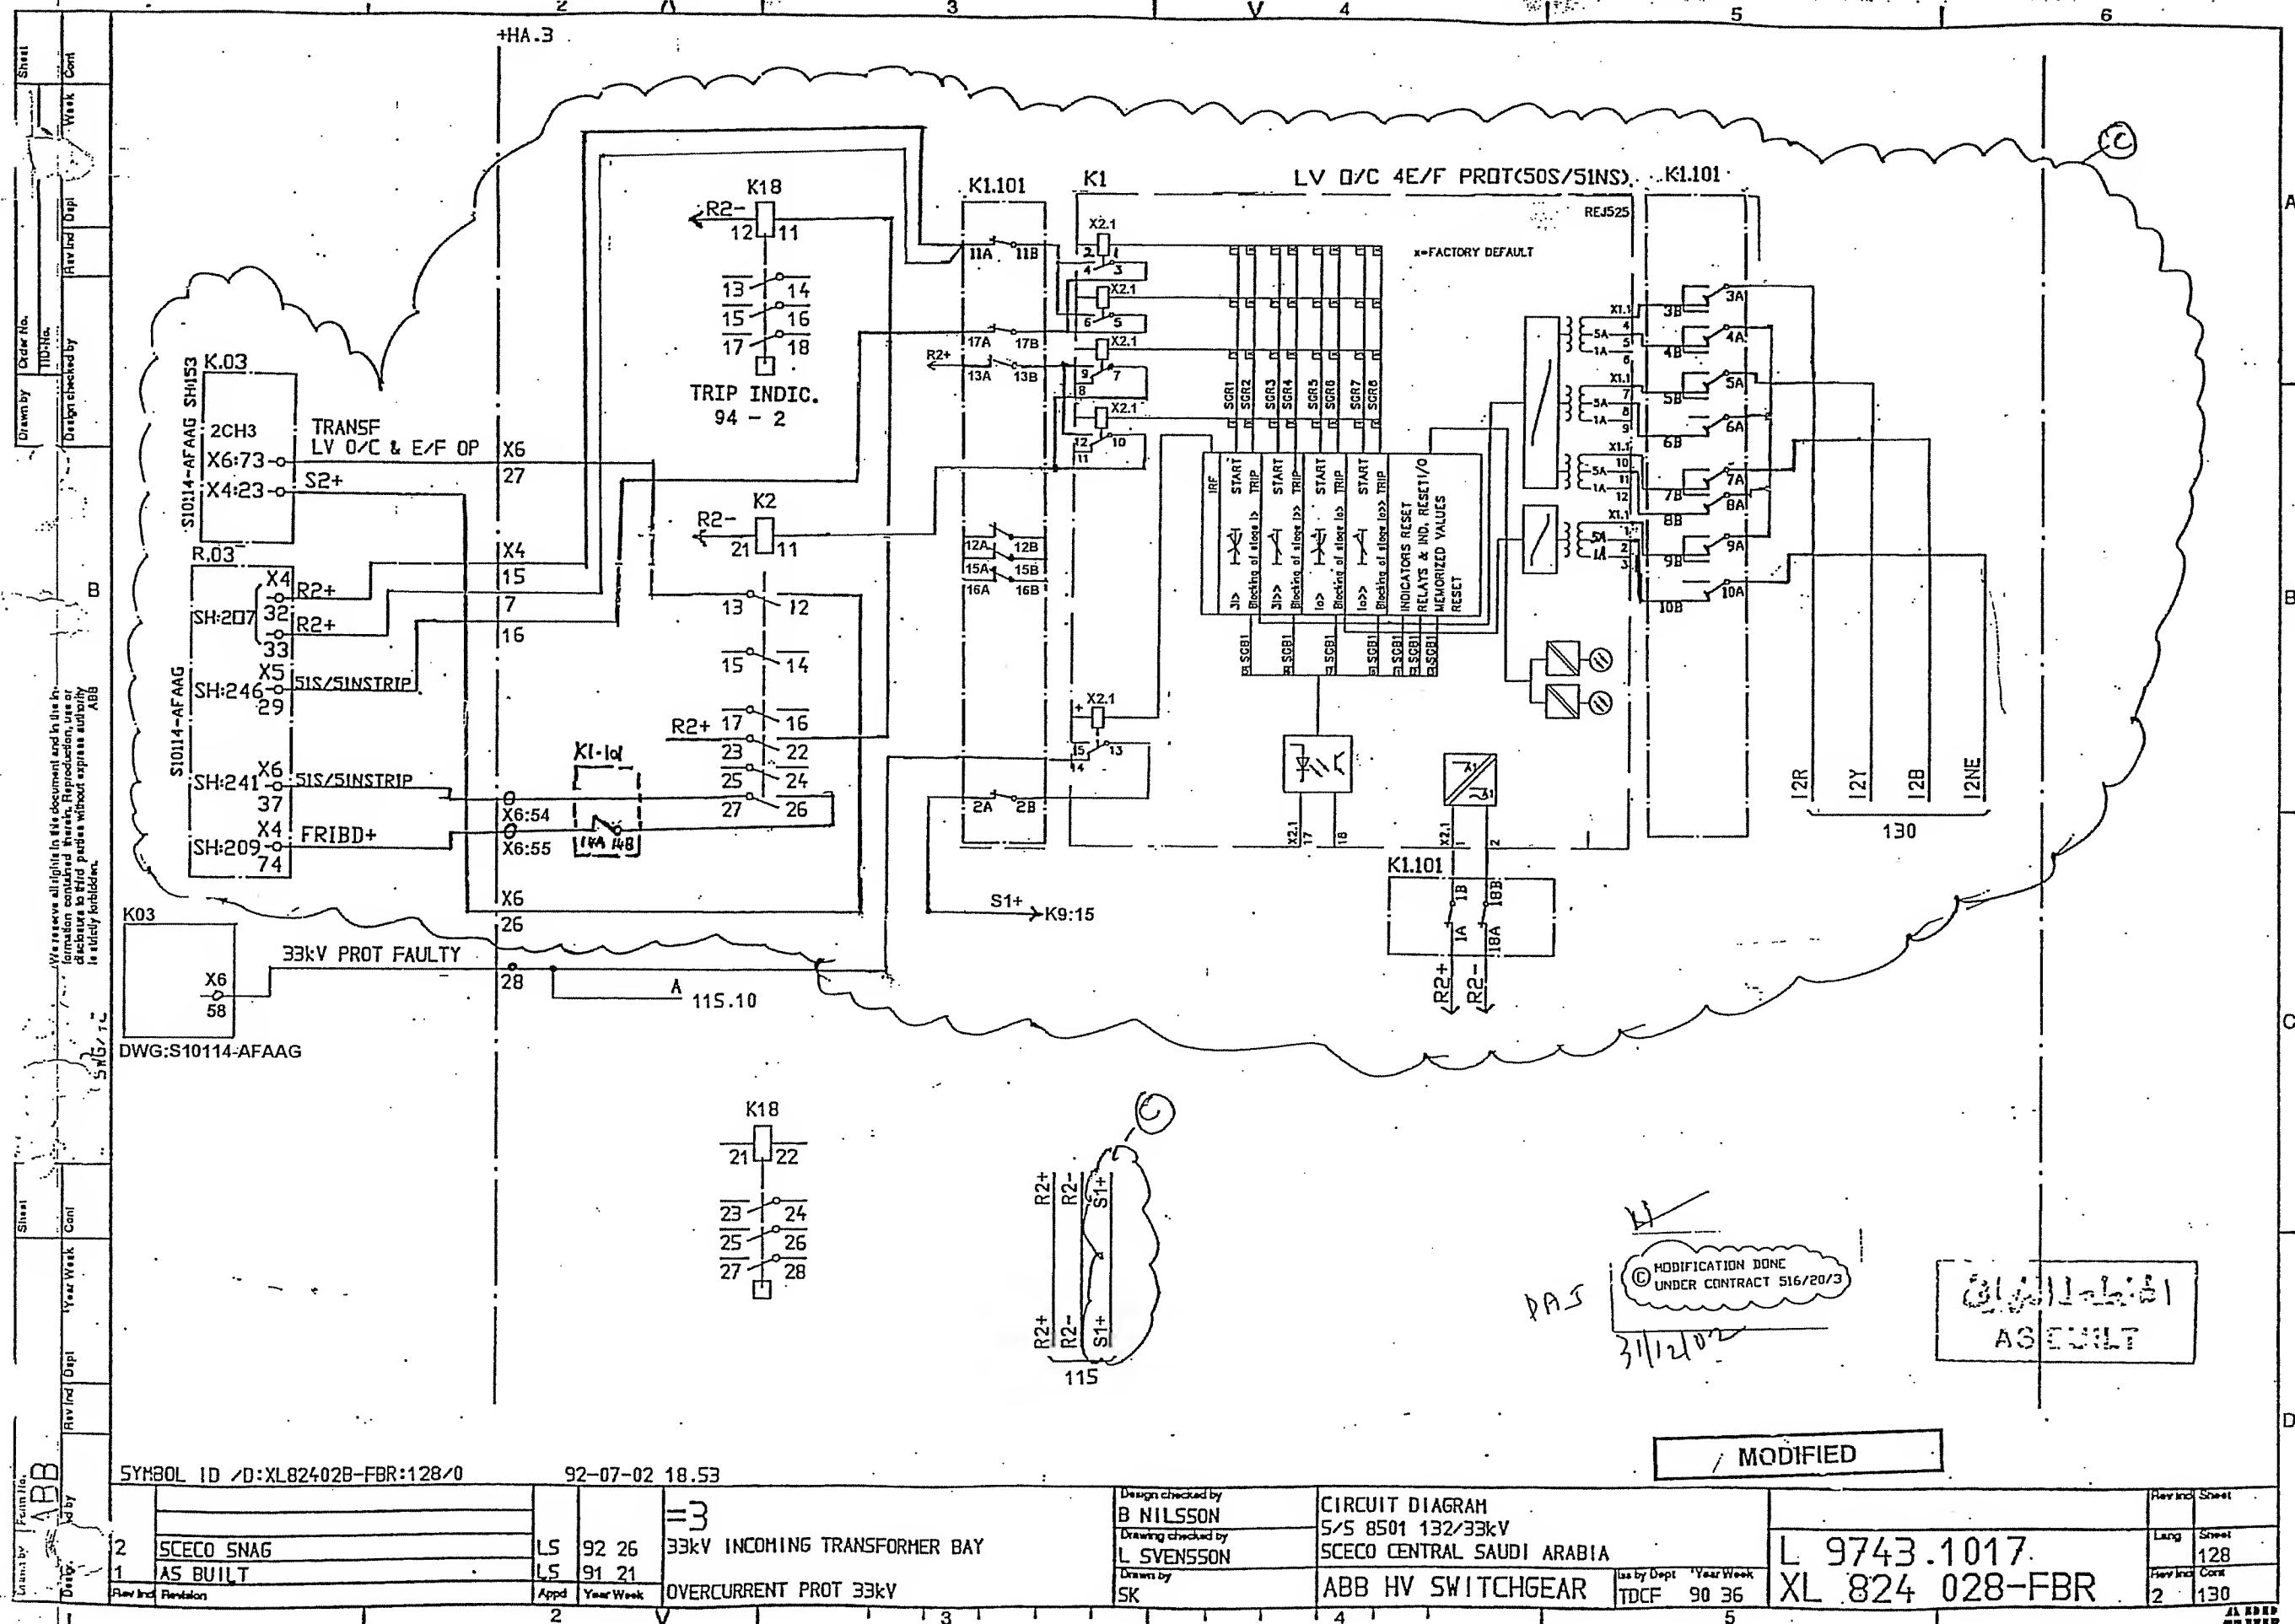

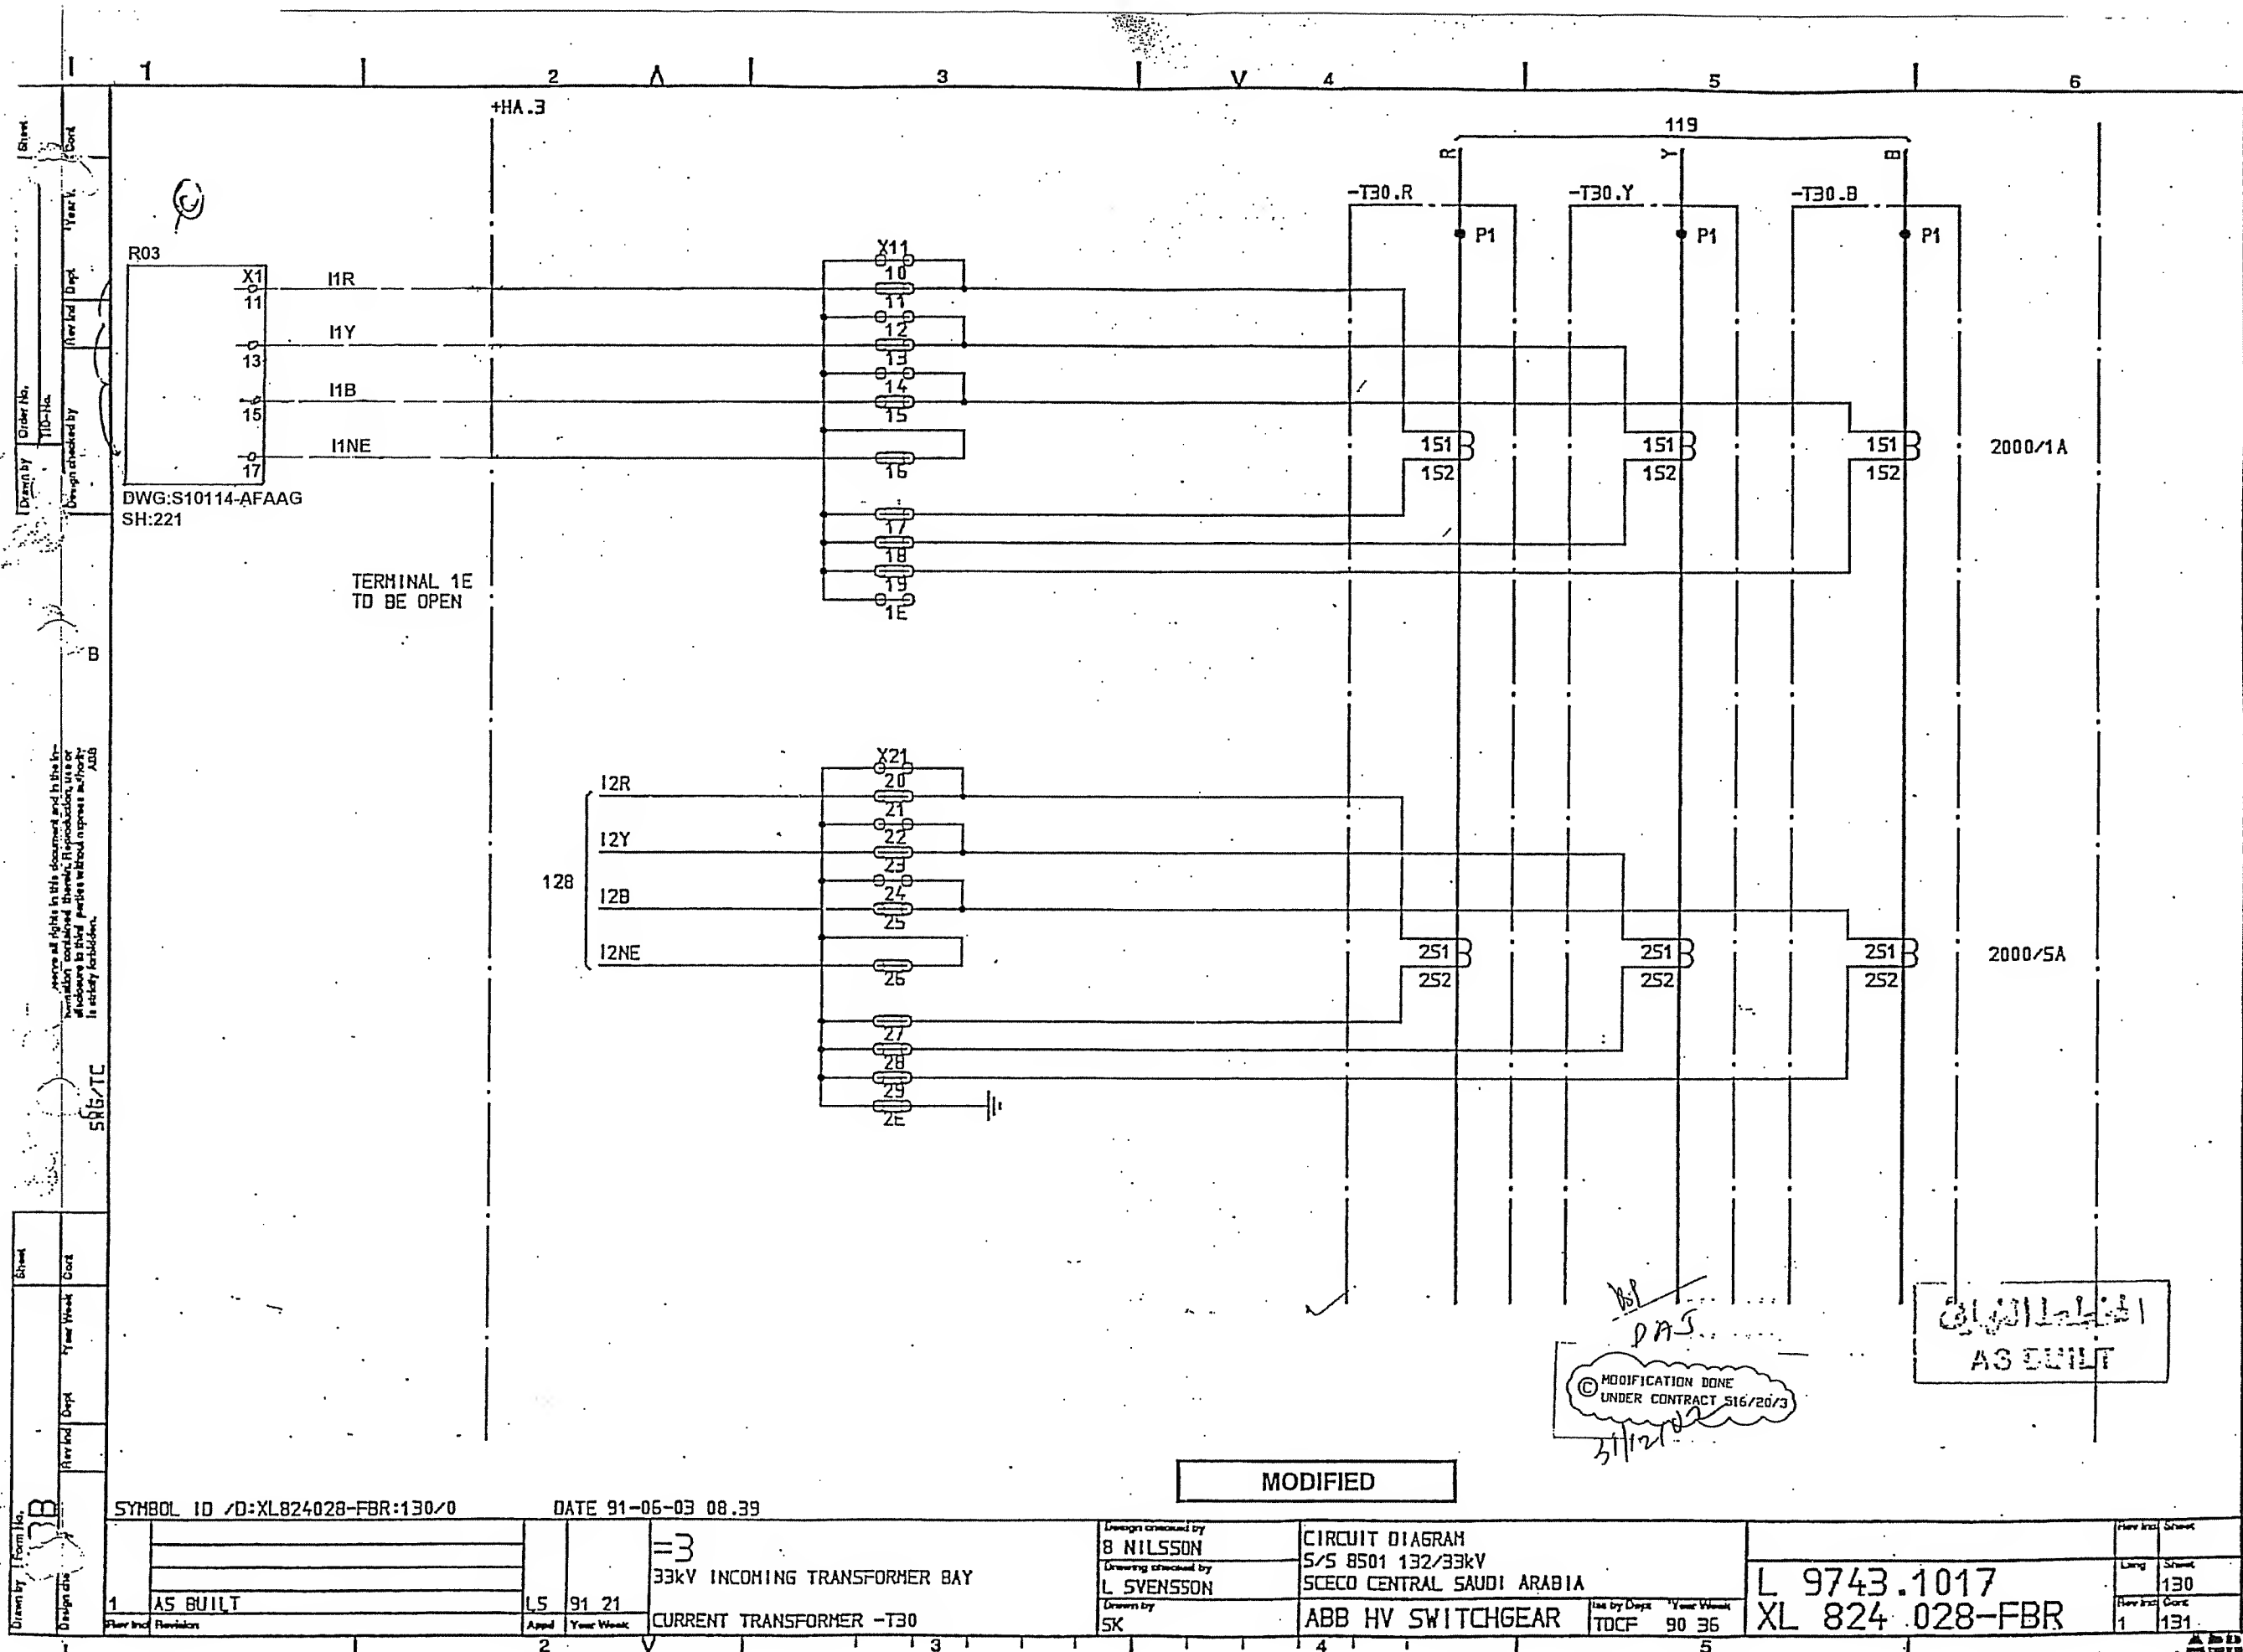

31/12/02
 P.A.S.
 MODIFICATION DONE
 UNDER CONTRACT 516/20/3

31/12/02
 AS BUILT

MODIFIED

SYMBOL ID /D:XL824028-FBR:130/0 DATE 91-06-03 08.39

| | | | | |
|---|----------|----|-------|-------------------------------|
| 1 | AS BUILT | L5 | 91 21 | 33kV INCOMING TRANSFORMER BAY |
| 2 | | | | CURRENT TRANSFORMER -T30 |


Design created by
 8 NILSSON
 Drawing checked by
 L SVENSSON
 Drawn by
 SK

CIRCUIT DIAGRAM
 S/S 8501 132/33kV
 SCECO CENTRAL SAUDI ARABIA
 ABB HV SWITCHGEAR


Iss by Dept
 TDCF 90 36

L 9743.1017
 XL 824.028-FBR

| | | |
|-----|-----|-------|
| Rev | Int | Sheet |
| 1 | 130 | 131 |

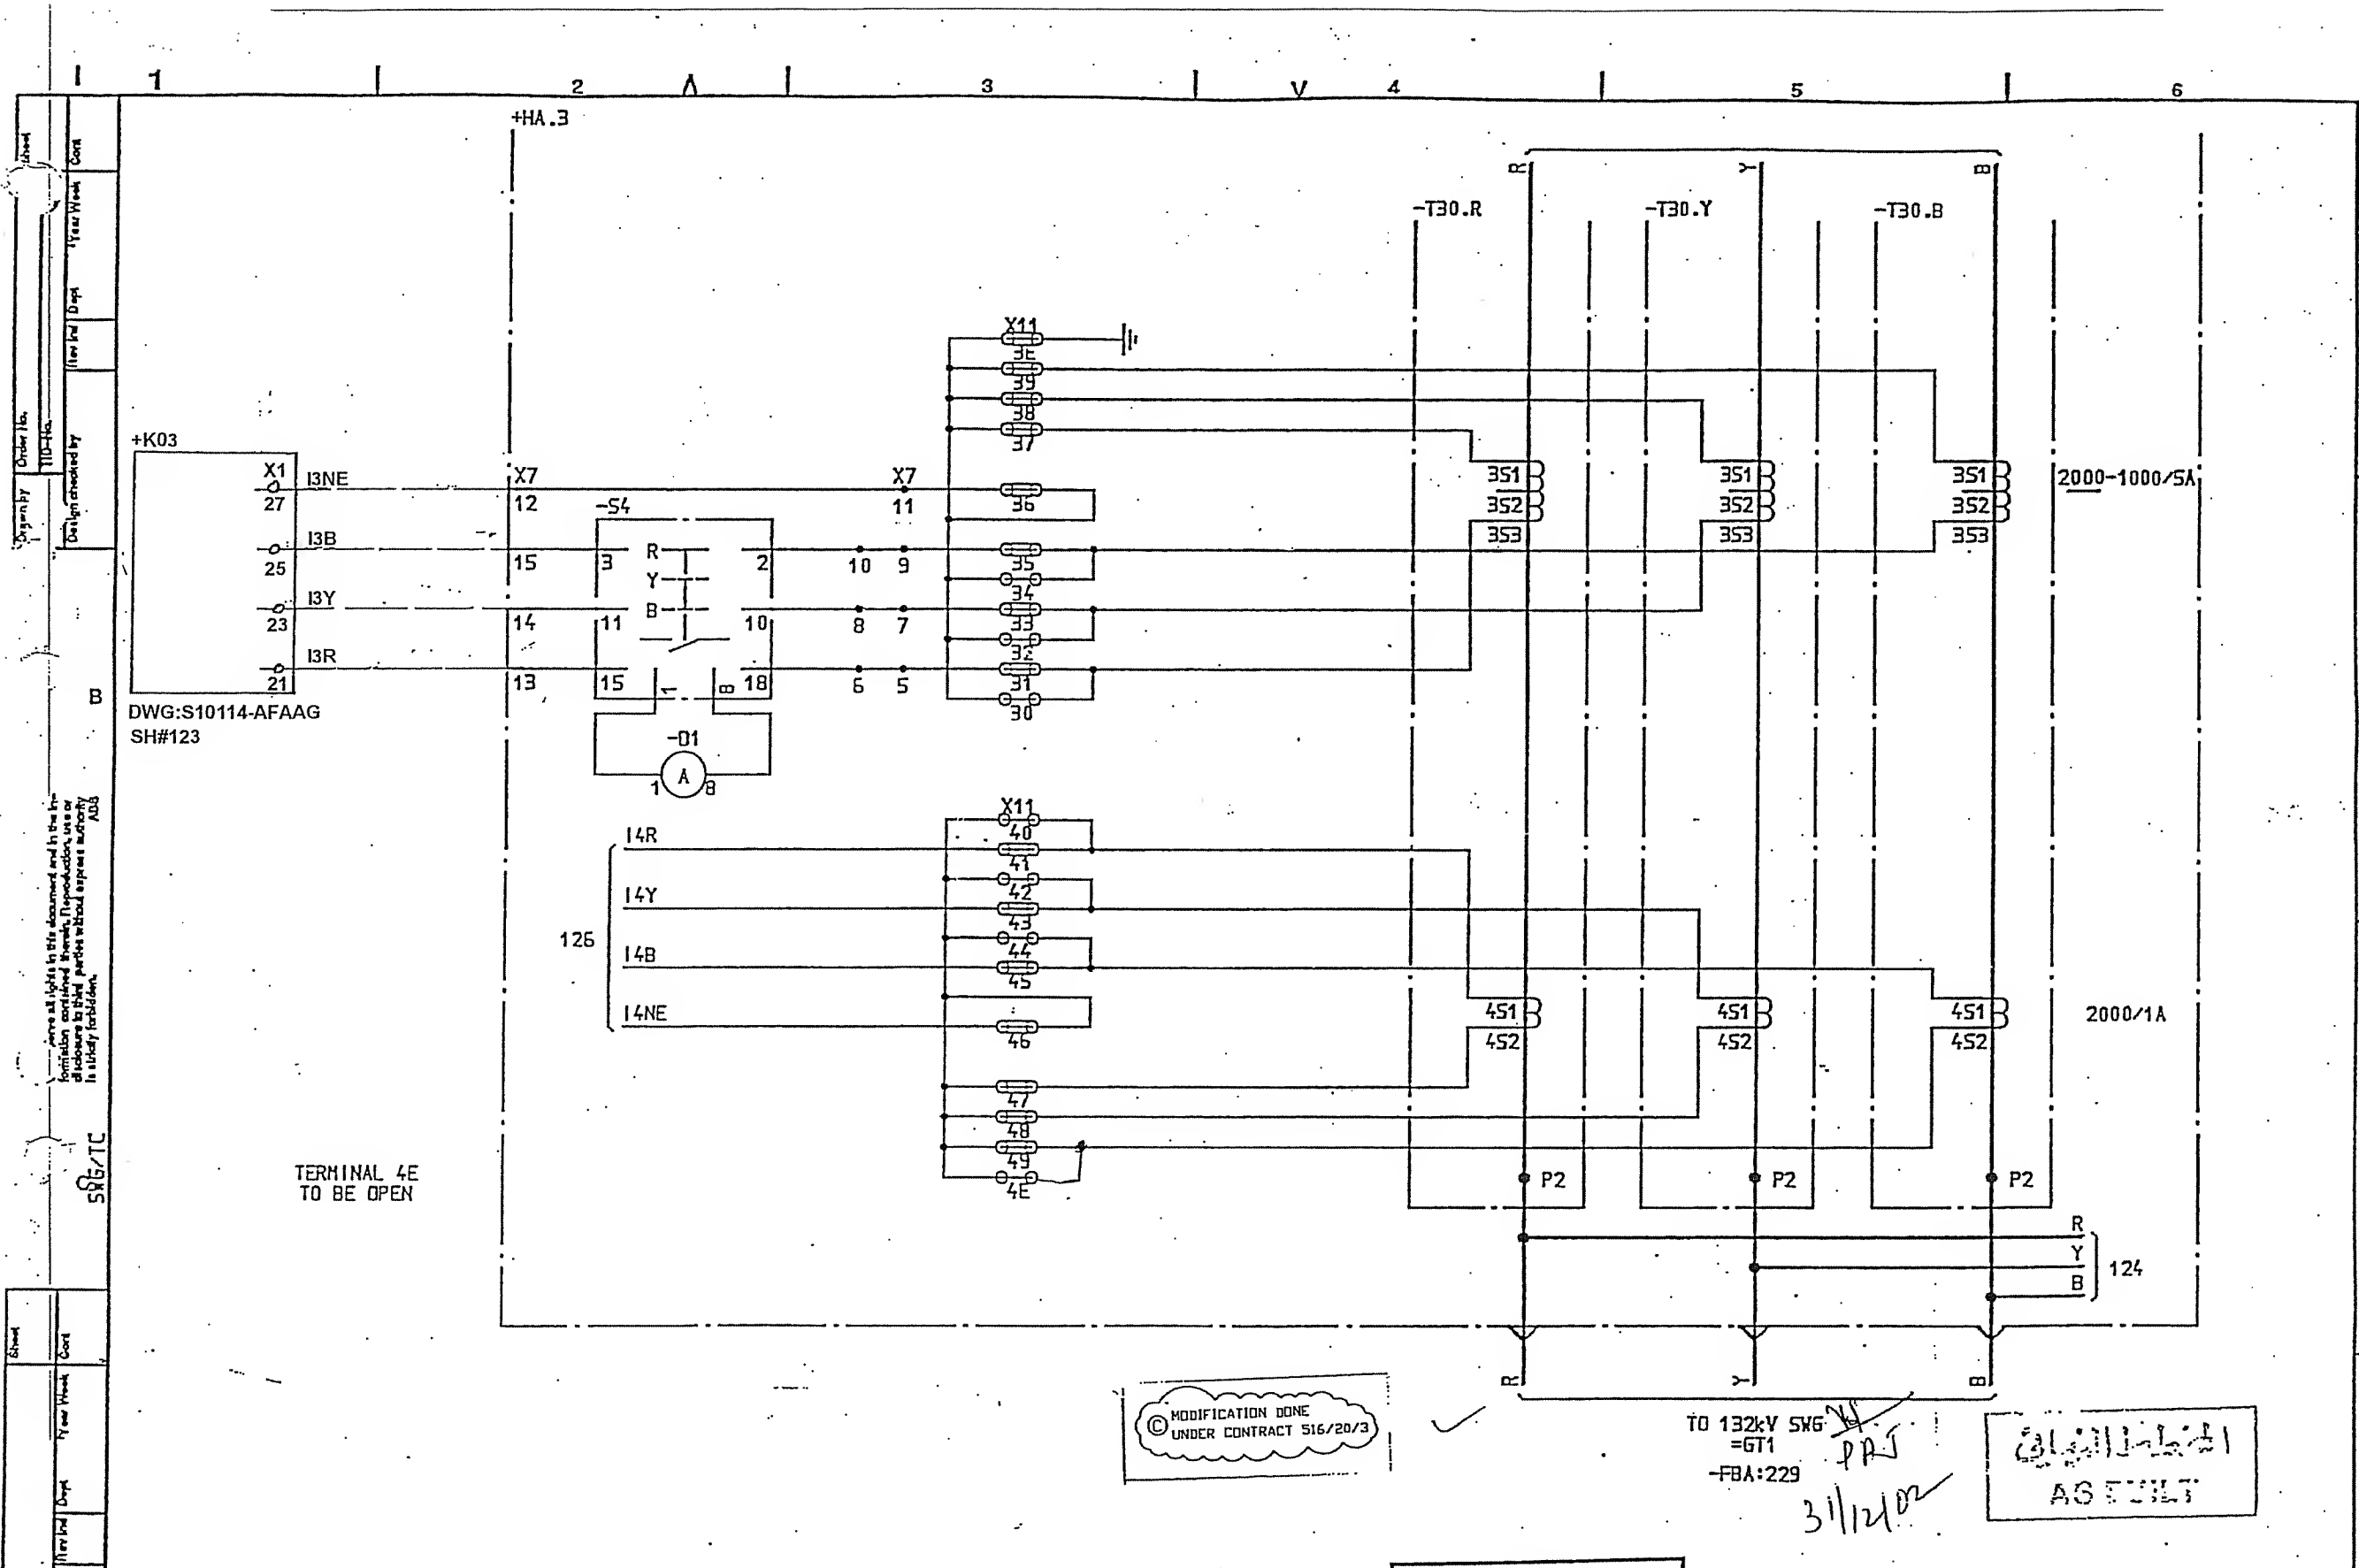

| | | | | | |
|---------------------------------|--|-------------------------------|--|----------------------------|--|
| SYMBOL ID /D:XL824028-FBR:131/0 | | DATE 91-06-03 08.39 | | MODIFIED | |
| AS BUILT | | 33kV INCOMING TRANSFORMER BAY | | CIRCUIT DIAGRAM | |
| L5 91 21 | | CURRENT TRANSFORMER -T30 | | S/S 8501 132/33kV | |
| 2 | | 3 | | SCECO CENTRAL SAUDI ARABIA | |
| 4 | | 5 | | ABB HV SWITCHGEAR | |
| 6 | | 7 | | L 9743.1017 | |
| 8 | | 9 | | XL 824 028-FBR | |
| 10 | | 11 | | 135 | |

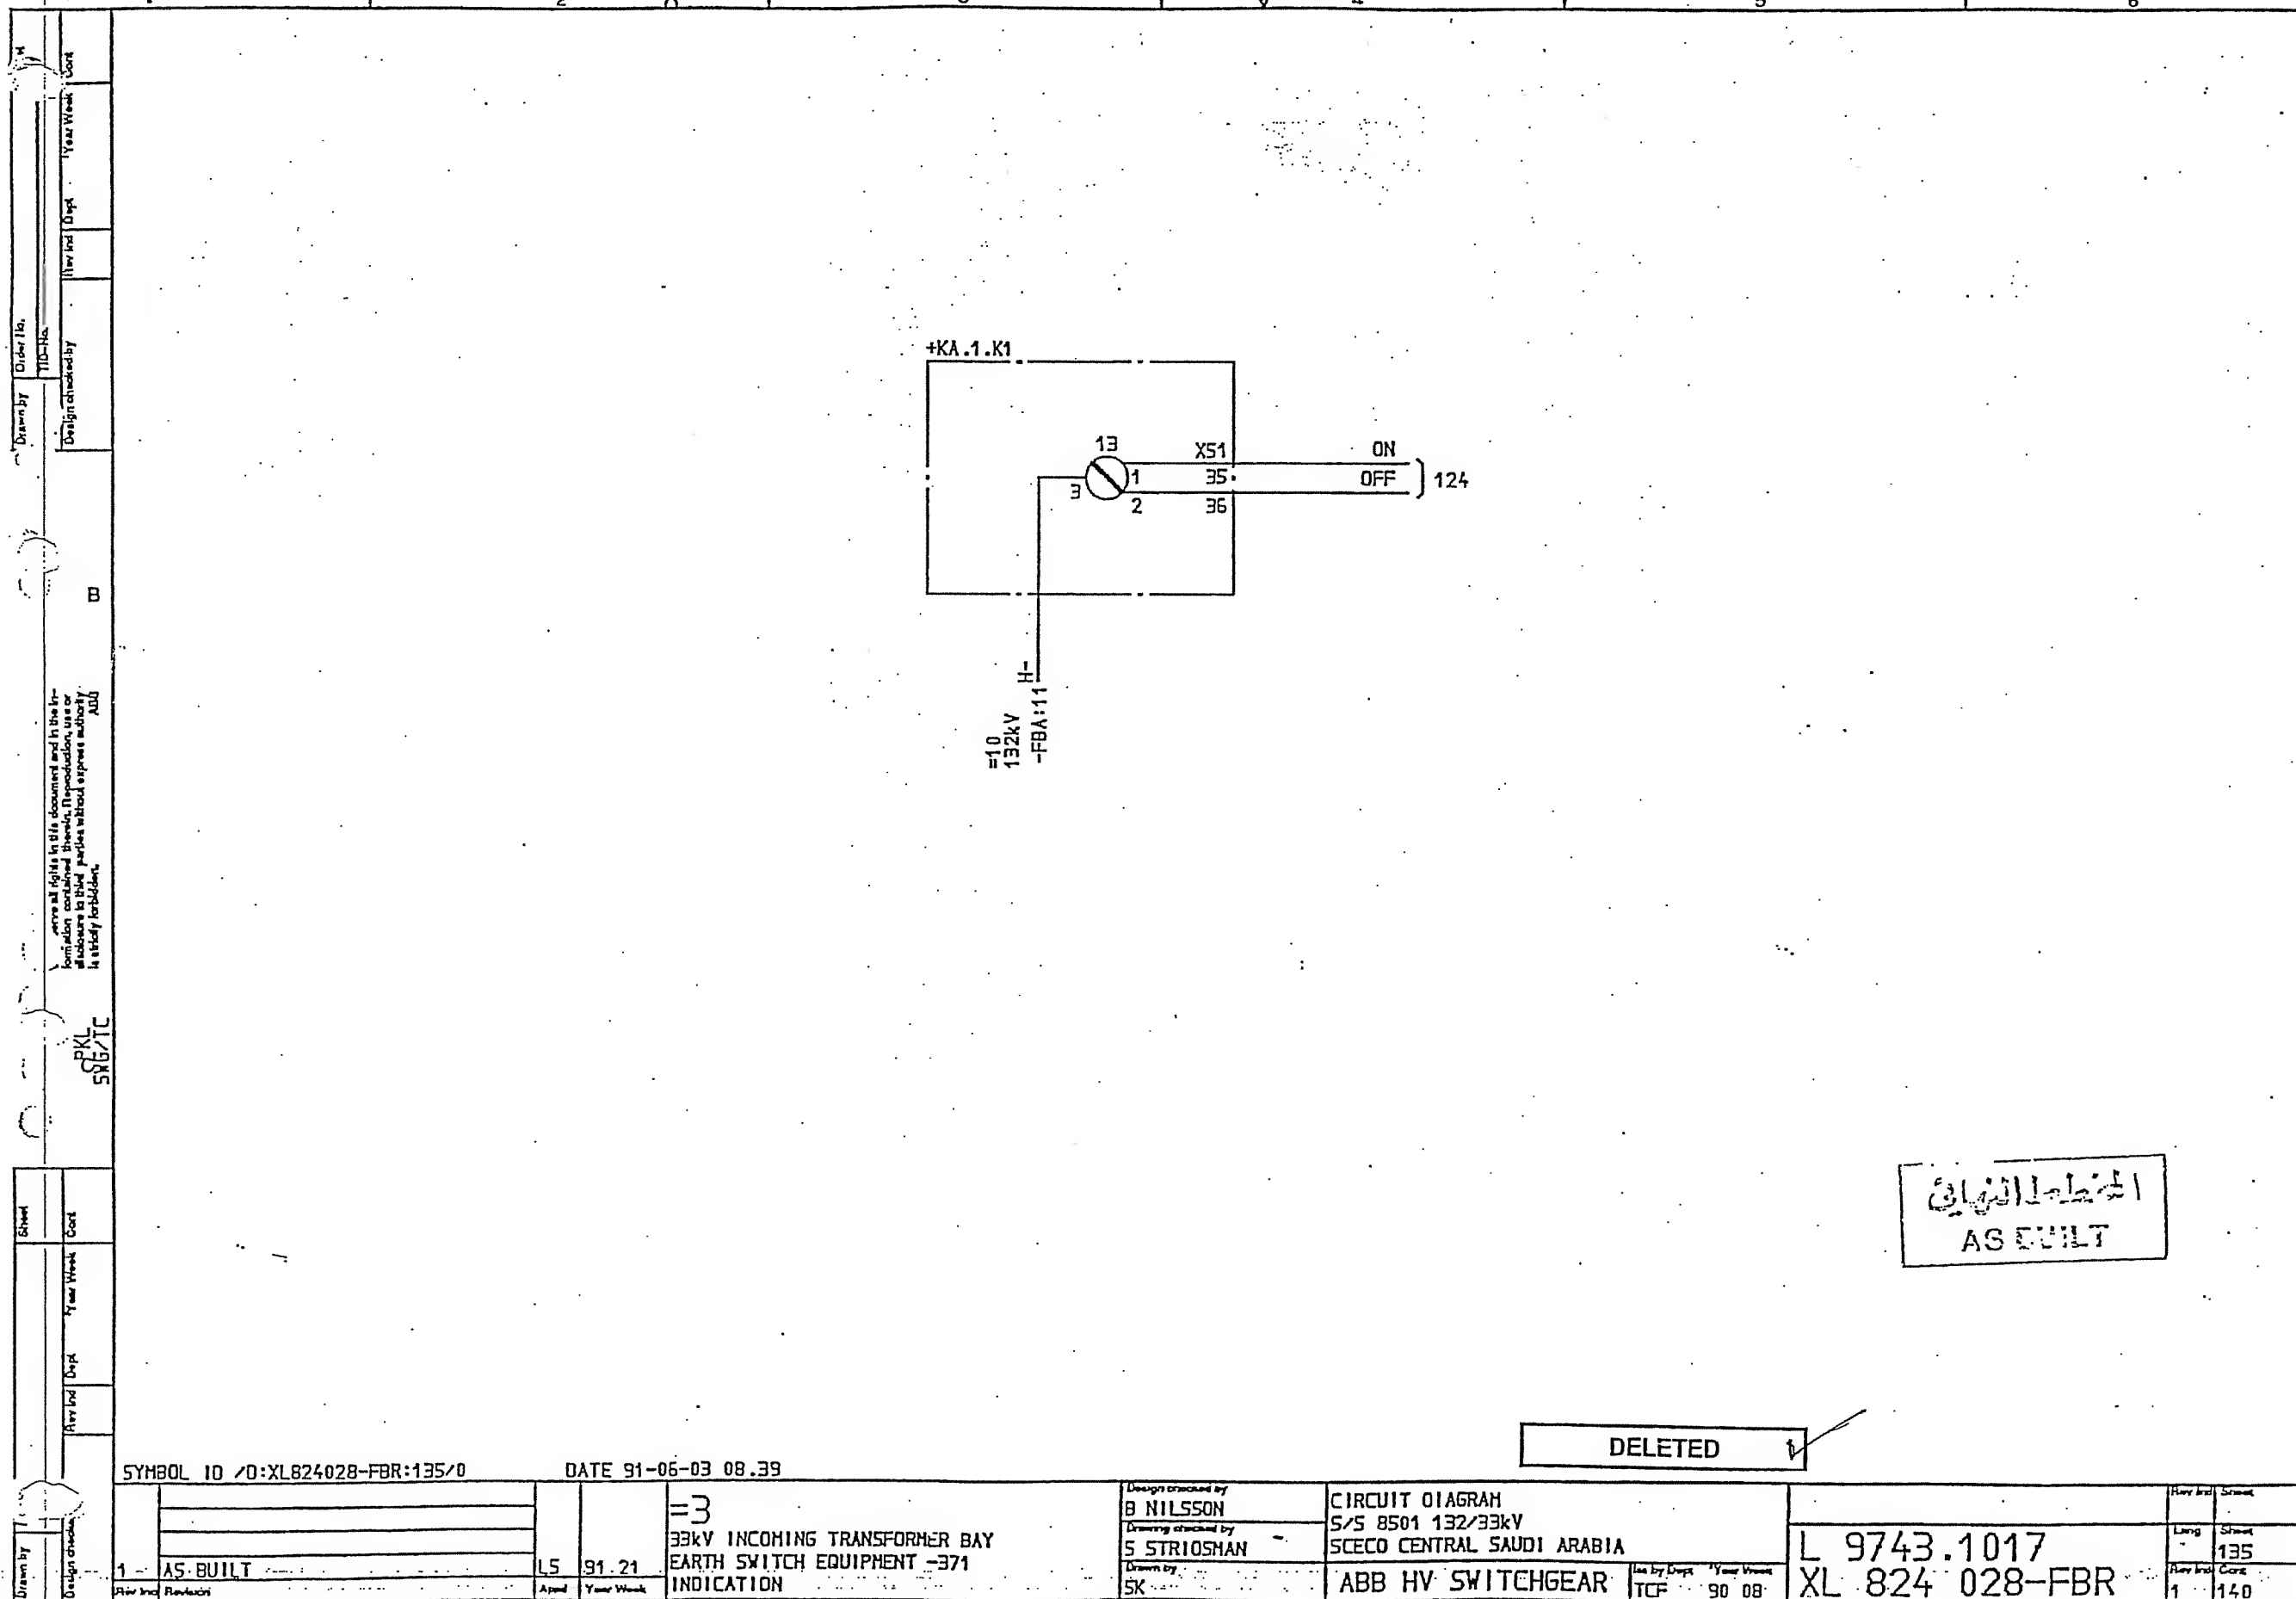

المنطقة النهائية
AS EULT


DELETED

SYMBOL ID /0:XL824028-FBR:135/0

DATE 91-06-03 08.39


| | | | | | | | | | |
|----------|--|----|-------|--|--|--|--|----------------|--|
| AS-BUILT | | L5 | 91.21 | =3 33kV INCOMING TRANSFORMER BAY EARTH SWITCH EQUIPMENT -371 INDICATION | | CIRCUIT DIAGRAM S/S 8501 132/33kV SCECO CENTRAL SAUDI ARABIA | | L 9743.1017 | |
| AS-BUILT | | L5 | 91.21 | =3 33kV INCOMING TRANSFORMER BAY EARTH SWITCH EQUIPMENT -371 INDICATION | | ABB HV SWITCHGEAR | | XL 824 028-FBR | |
| AS-BUILT | | L5 | 91.21 | =3 33kV INCOMING TRANSFORMER BAY EARTH SWITCH EQUIPMENT -371 INDICATION | | TCE 90 08 | | 140 | |

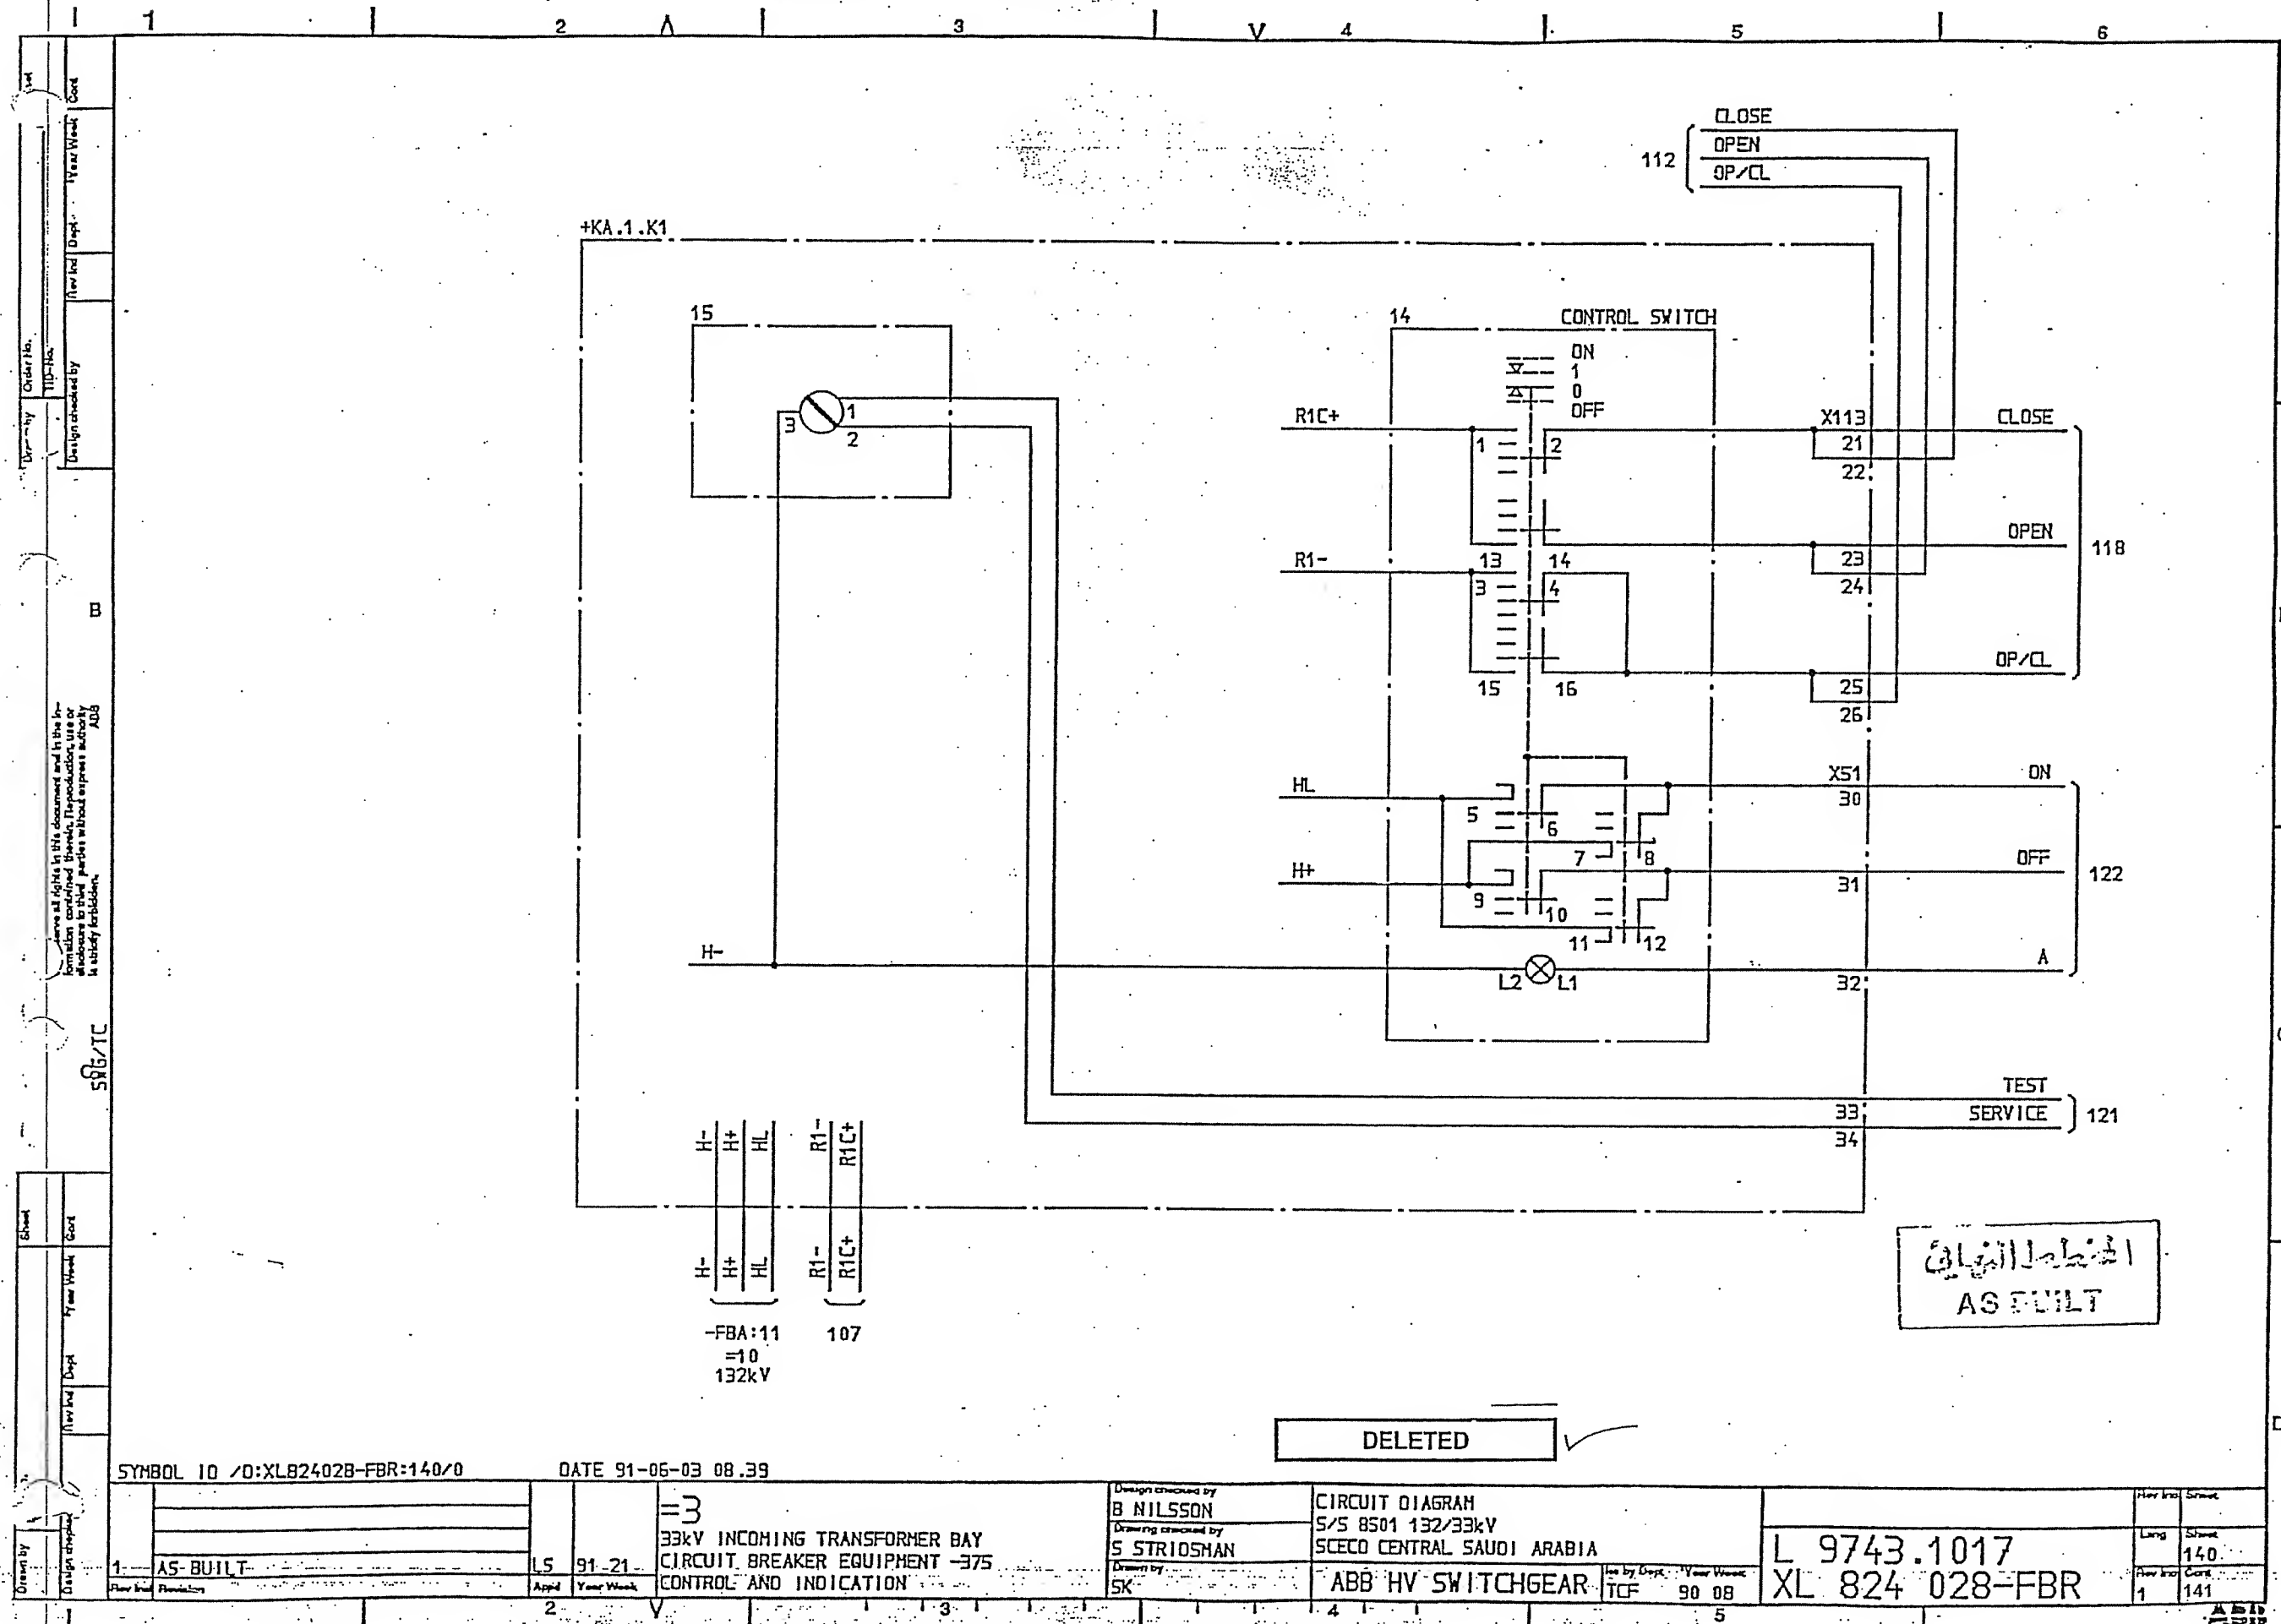AS EULT



الجنحة النفاية
AS BUILT

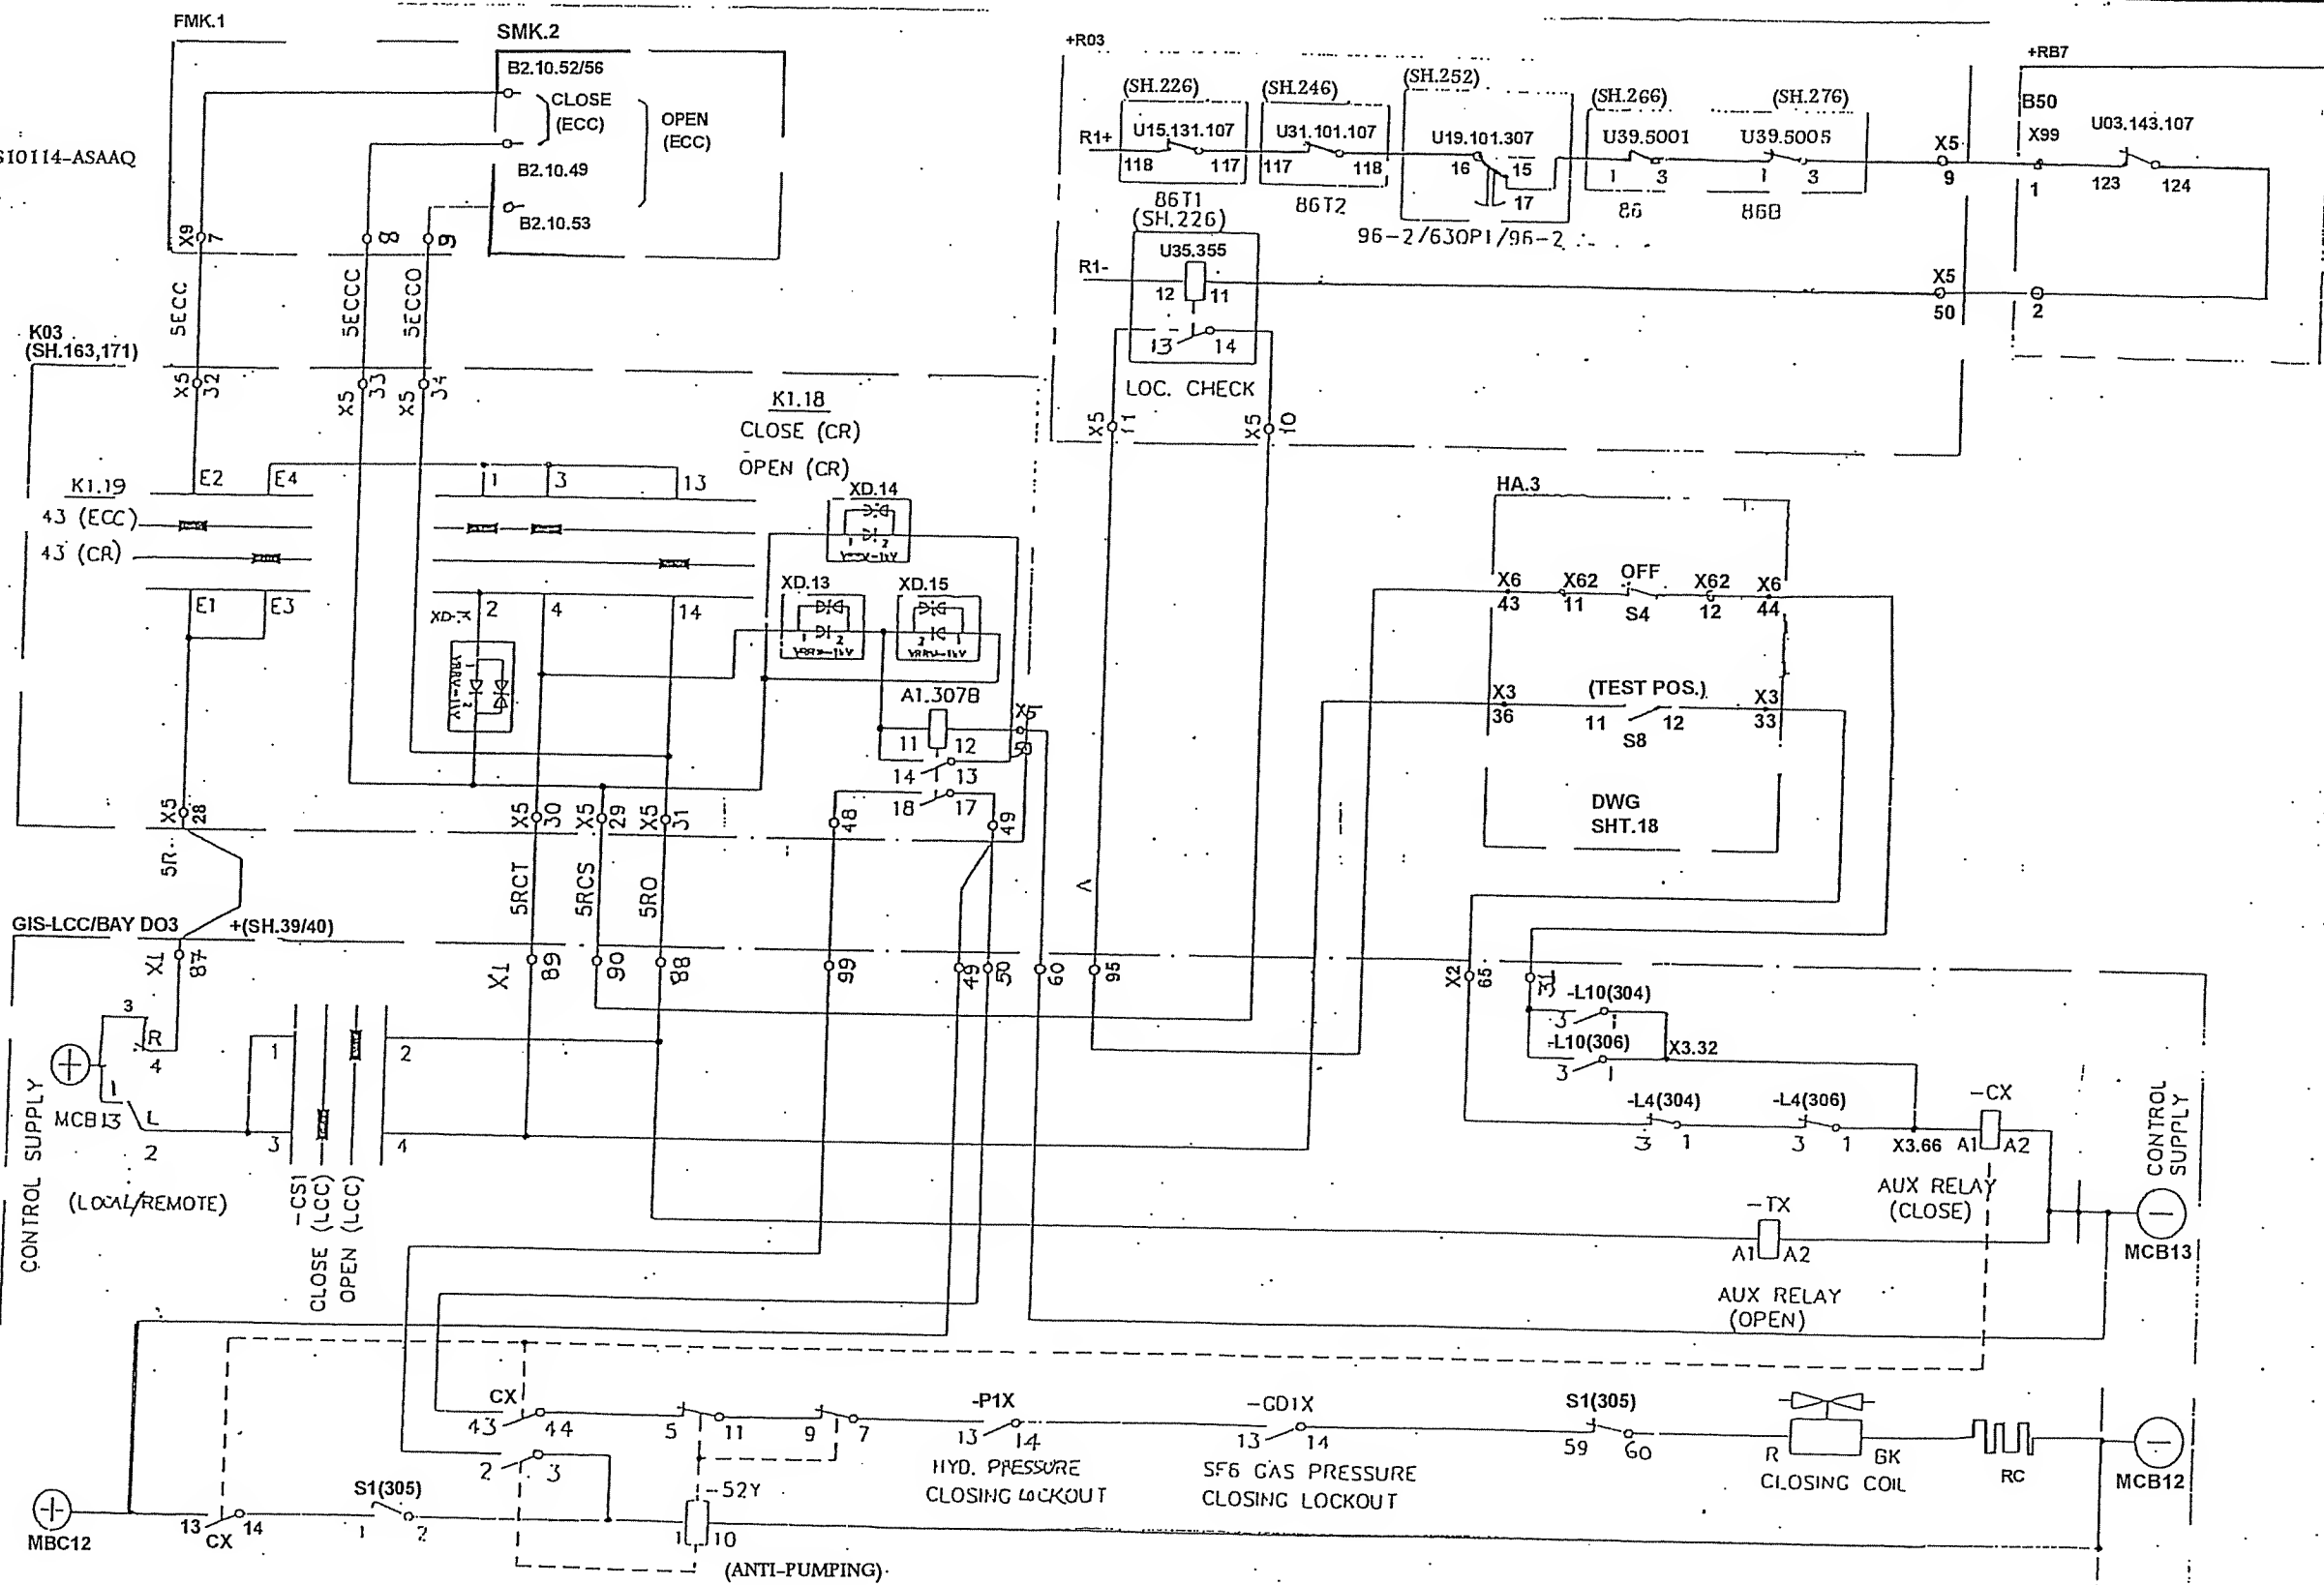DWG: S10114-ASAAQ
SH:27




SYMBOL

DATE 91-05-03 08.39


| | | | | |
|-----------------|--|---|---|---------------------------------------|
| <p>AS-BUILT</p> | <p>132/33kV GRID TRANSFORMER 132kV CB.305 CLOSING CIRCUIT =GT1</p> | <p>Design checked by B NILSSON Drawing checked by S STRIDSMAN Drawn by SK</p> | <p>CIRCUIT DIAGRAM S/S 8501 132/33kV SCECD CENTRAL SAUDI ARABIA ABB HV SWITCHGEAR</p> | <p>L 9743.1017 XL 824 028-FBR</p> |
|-----------------|--|---|---|---------------------------------------|

| | | |
|-----|-----|-------|
| Rev | Int | Sheet |
| 1 | 1 | 141 |
| 1 | 1 | 142 |

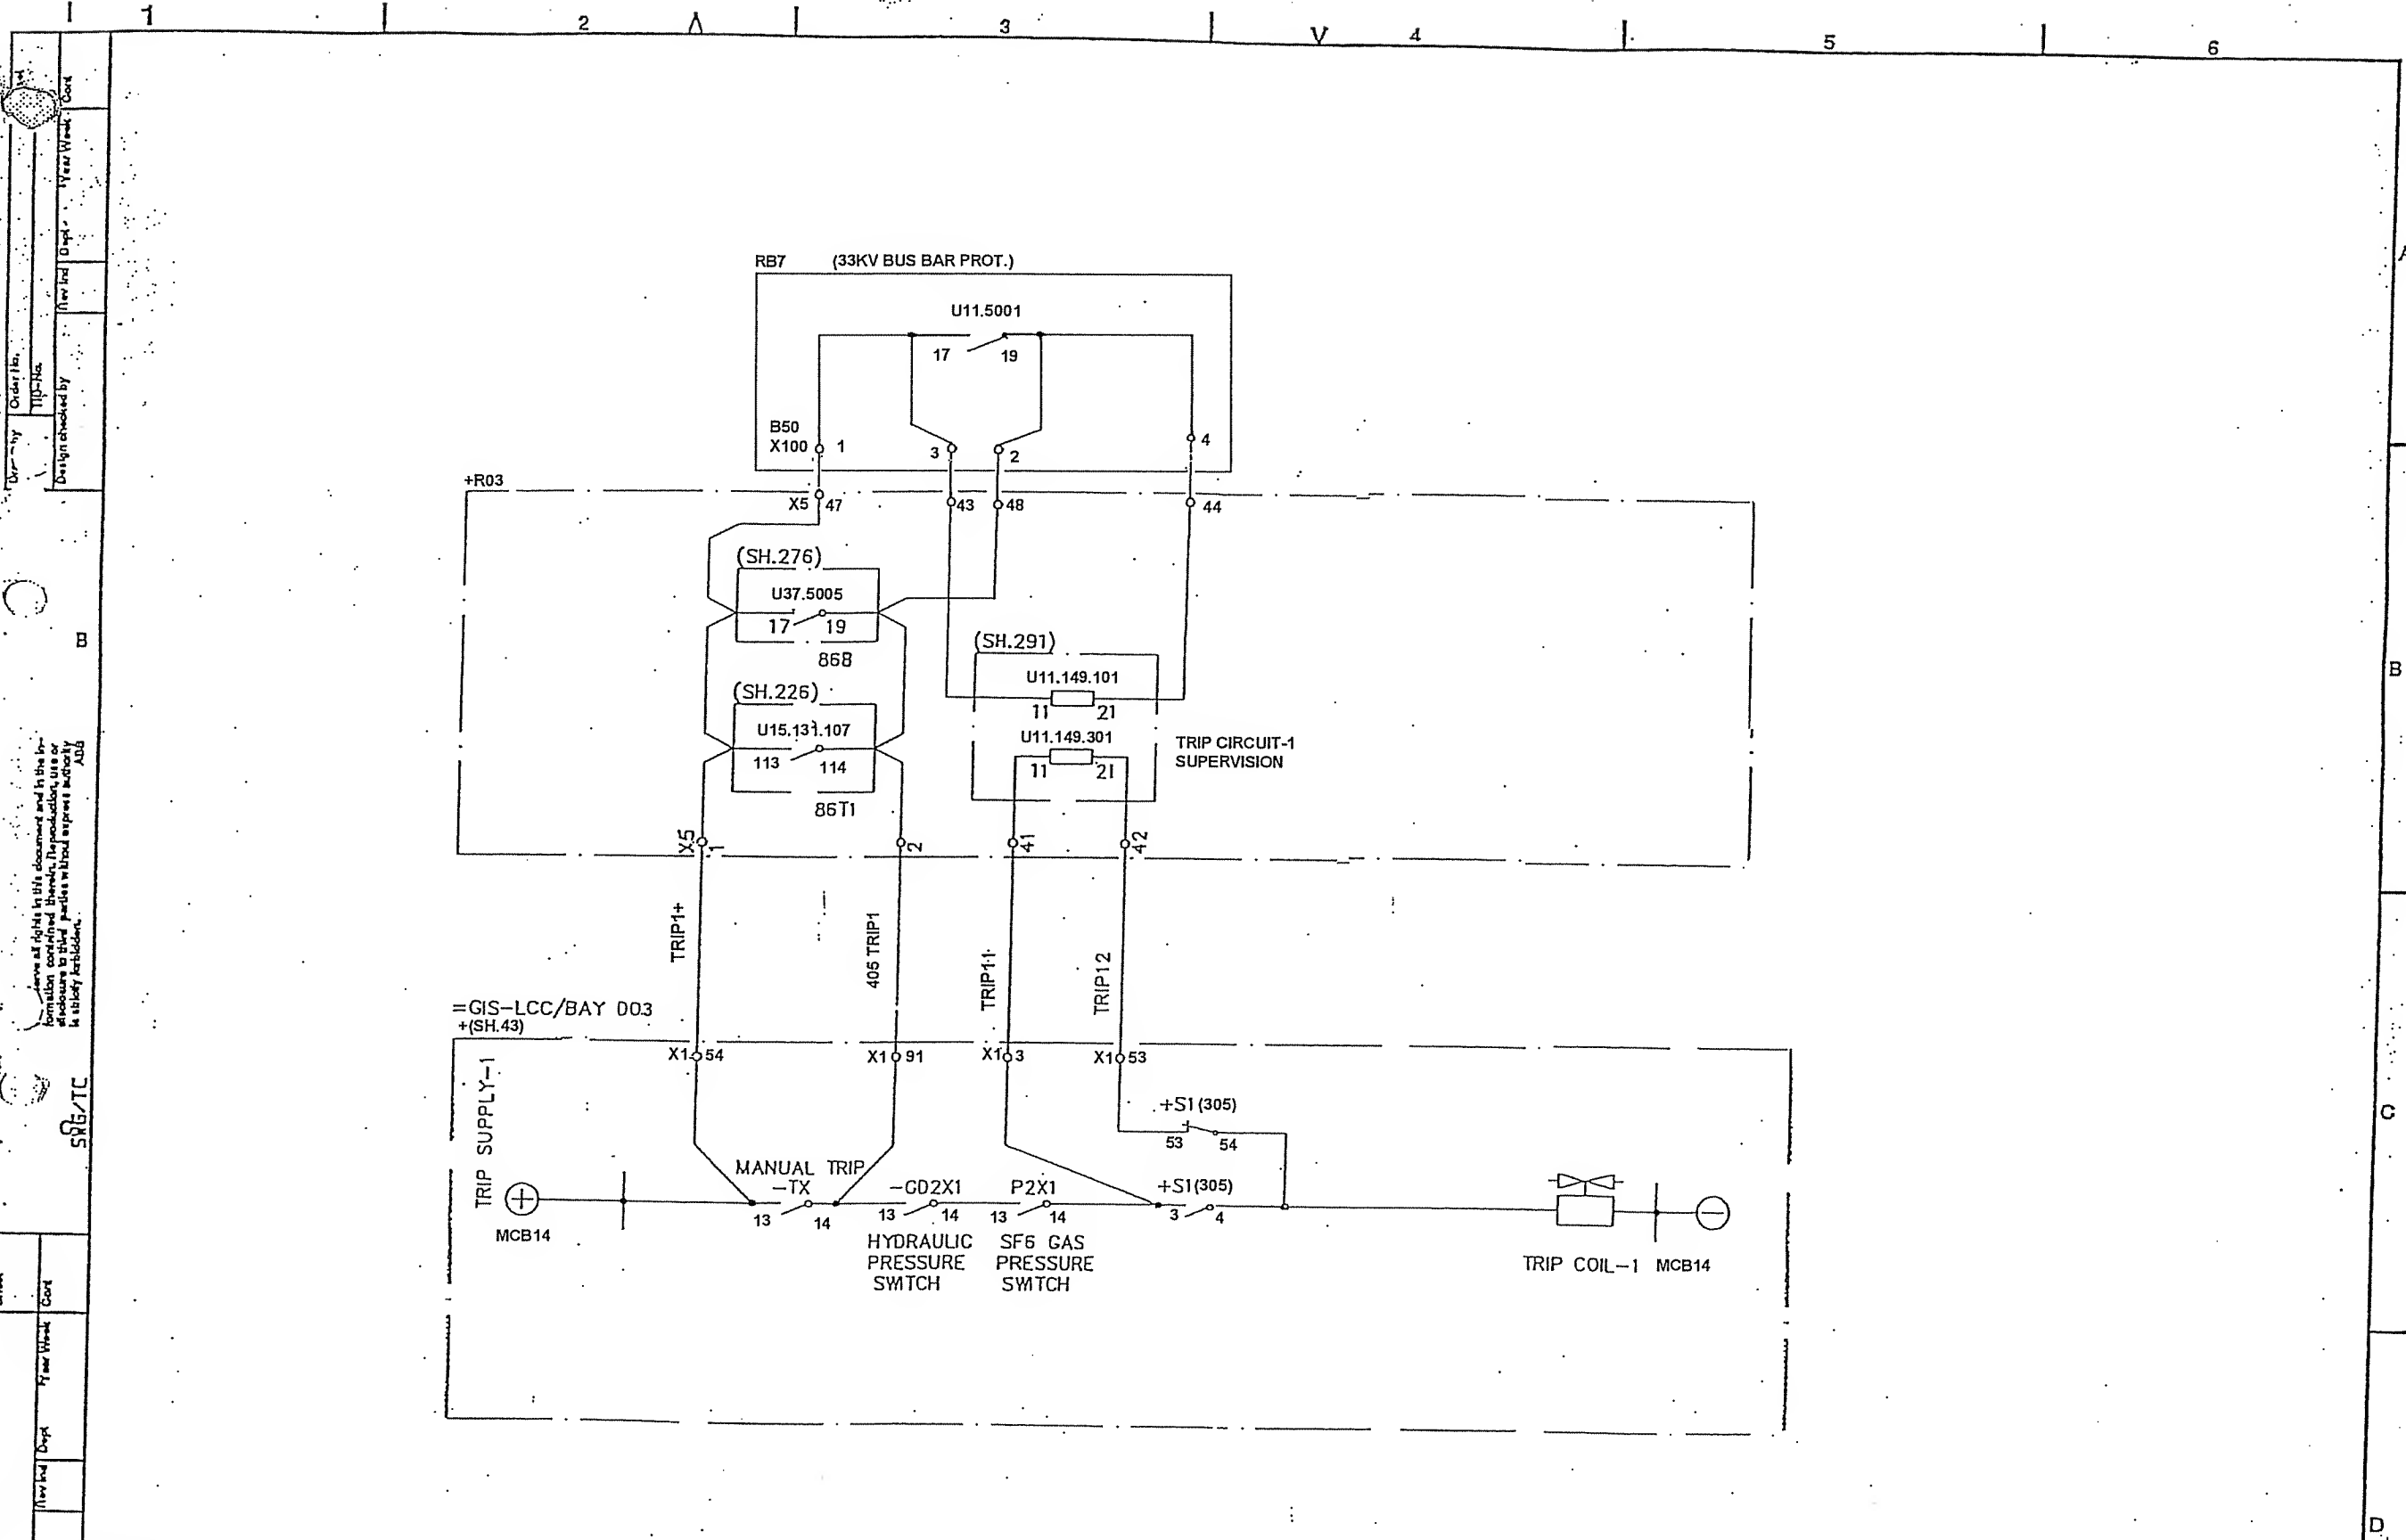

| | | | | | | | | | | | | | | | | | | | |
|--------|--|---------------------|--|----|--|-----------------------------|--|----------------------------------|--|-----------------------------------|--|-------------------|--|-------------------|--|----------------------------|--|----------------|--|
| SYNBDL | | DATE 91-05-03 08.39 | | =3 | | 132/33kV GRID TRANSFORMER-1 | | BREAKER-305 TRIPPING COIL-1 =GT1 | | Design checked by B NILSSON | | CIRCUIT DIAGRAM | | S/S 8501 132/33kV | | SCECO CENTRAL SAUDI ARABIA | | Rev Int. Sheet | |
| 1 | | AS-BUILT | | LS | | 91-21 | | | | Drawing checked by S STRIDSHAN | | ABB HV SWITCHGEAR | | Tcf 90 DB | | L 9743.1017 | | Lang Sheet | |
| | | | | | | | | | | | | | | | | XL 824 028-FBR | | 142 | |
| | | | | | | | | | | | | | | | | | | 143 | |

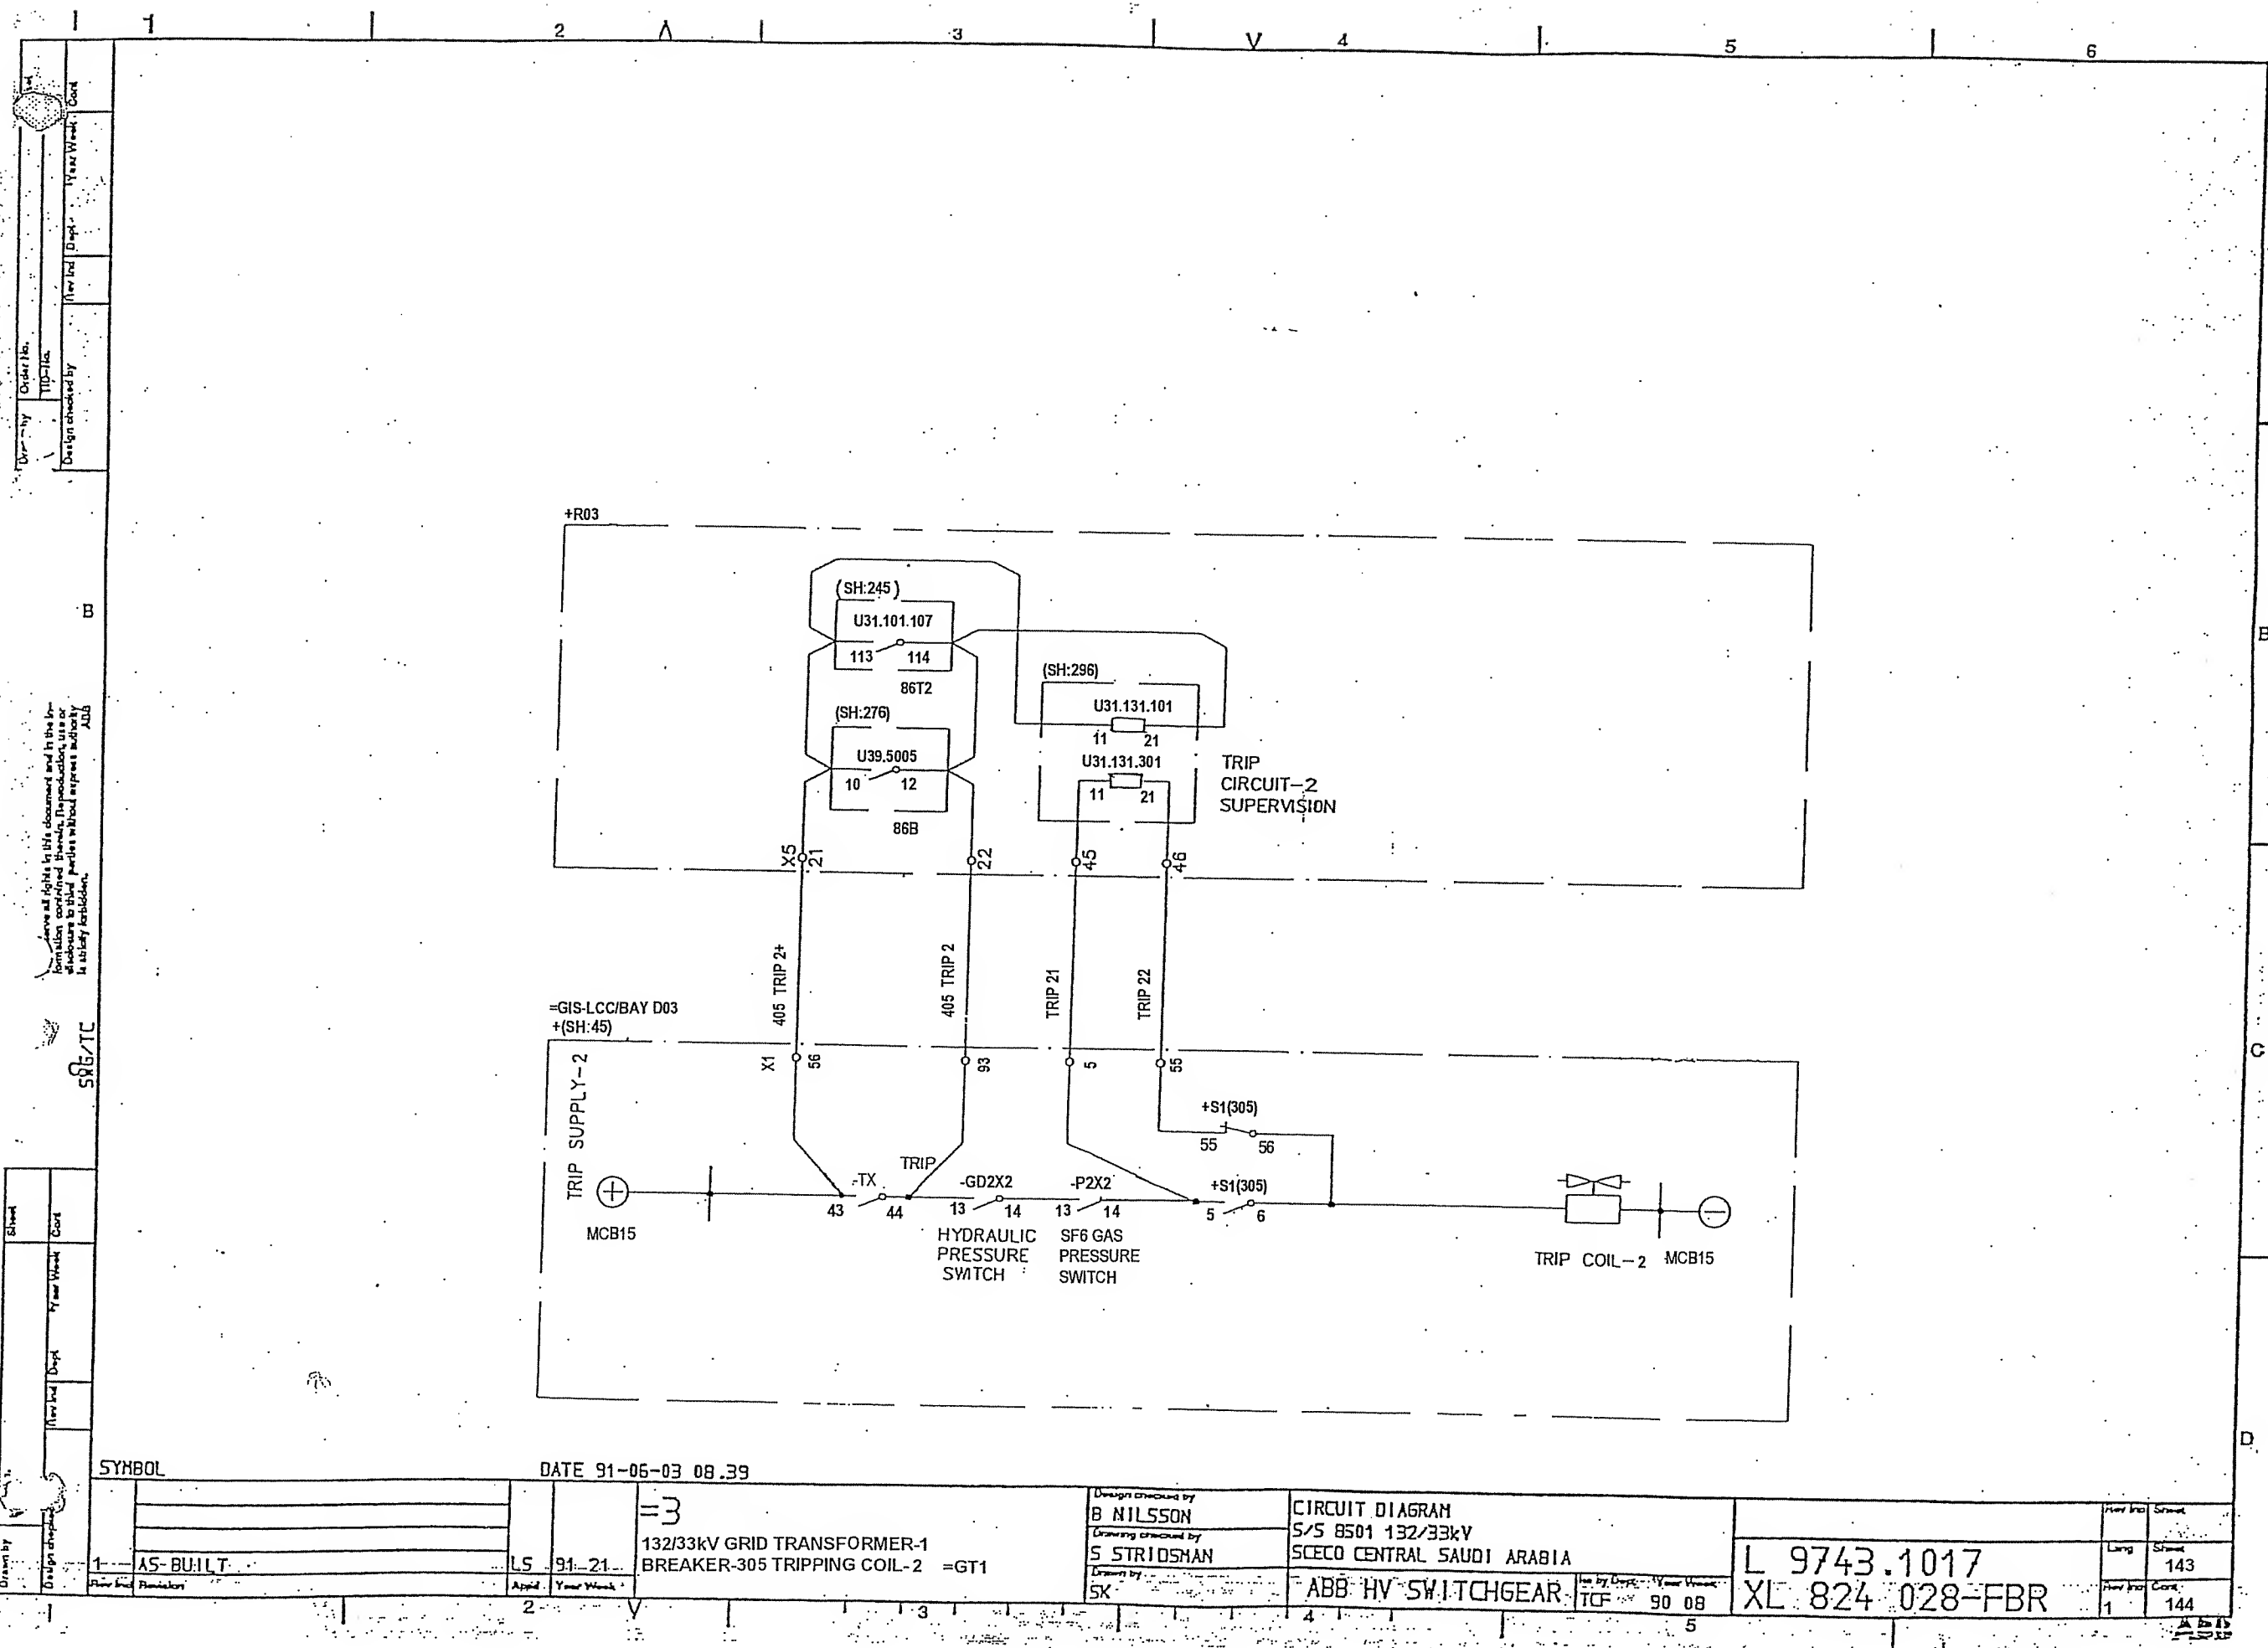
ASB





SYMBOL

DATE 91-06-03 08.39

| | | | | | | | | | | | | | |
|-------------|--|----------|--|---|--|---|--|-----------------------------------|--|--|--|----------------|--|
| 1- AS-BUILT | | LS 91-21 | | 3 | | 132/33kV GRID TRANSFORMER-1 BREAKER-305 TRIPPING COIL-2 =GT1 | | Design checked by B NILSSON | | CIRCUIT DIAGRAM S/S 8501 132/33kV SCECO CENTRAL SAUDI ARABIA | | Rev Ino Sheet | |
| | | | | | | | | Drawing checked by S STRIDSHAN | | ABB HV SWITCHGEAR | | L 9743.1017 | |
| | | | | | | | | Drawn by SK | | TCE 90 08 | | XL 824 028-FBR | |
| | | | | | | | | | | | | 143 | |
| | | | | | | | | | | | | 144 | |

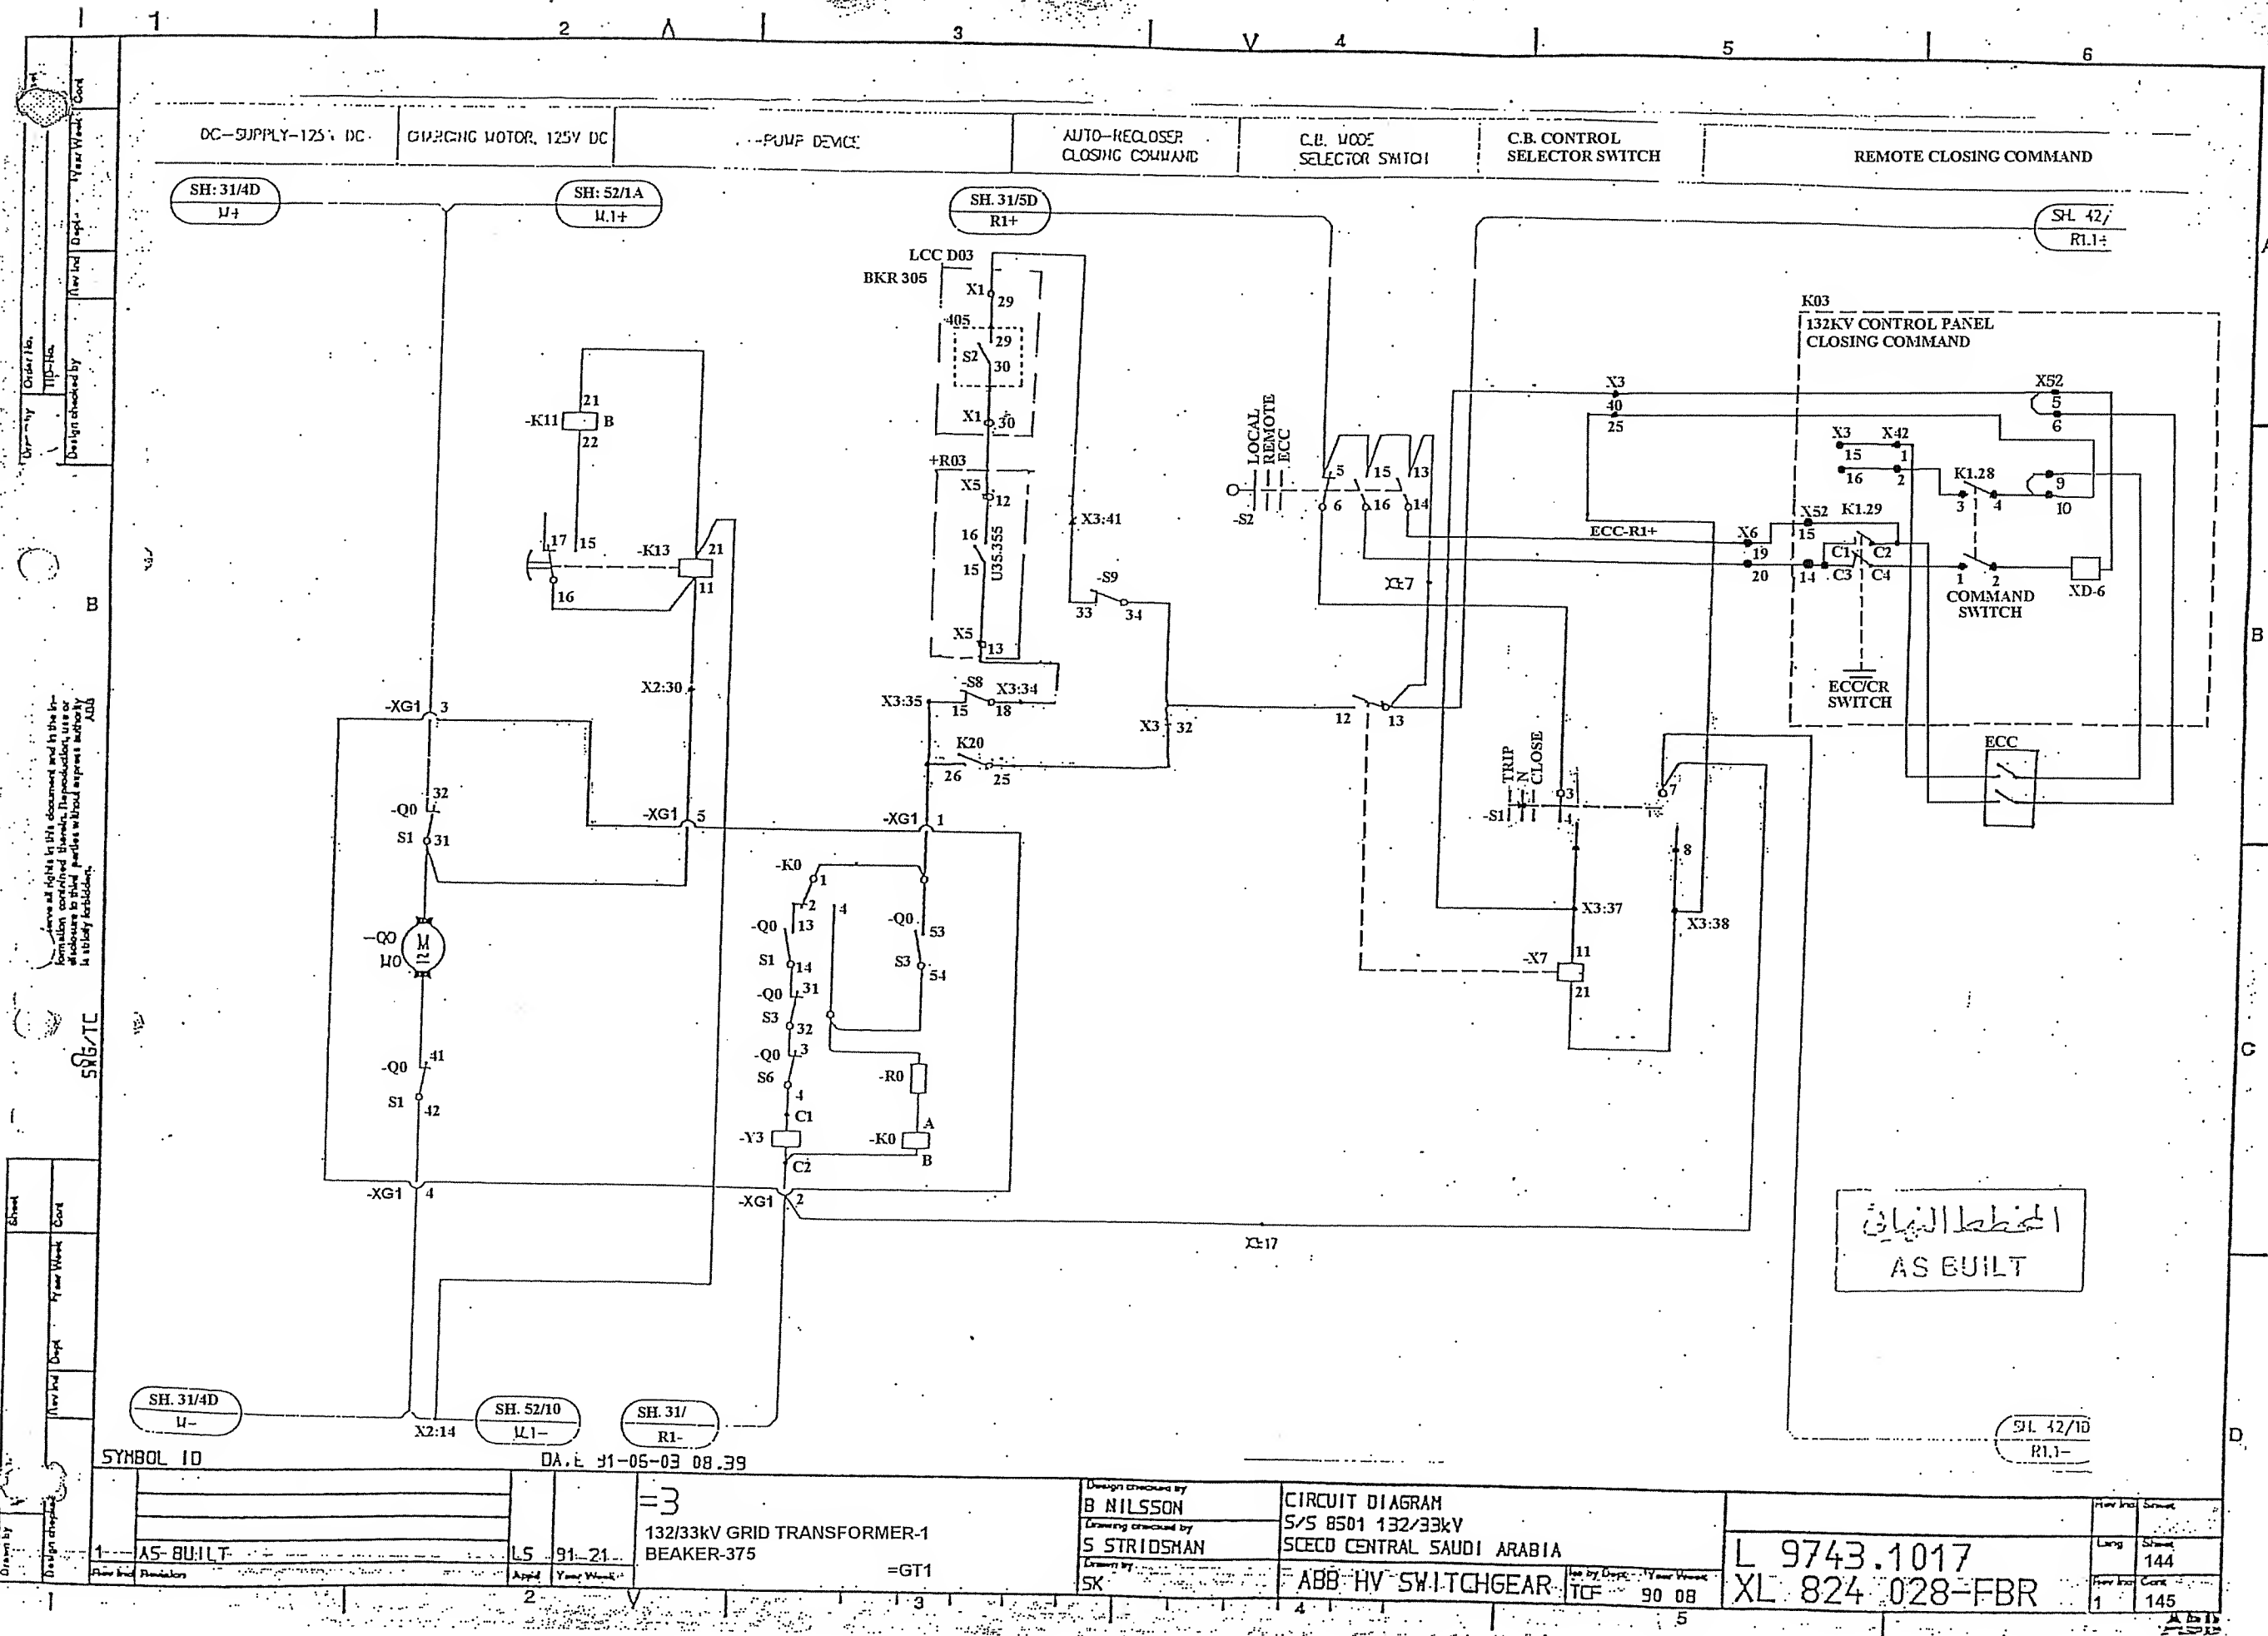

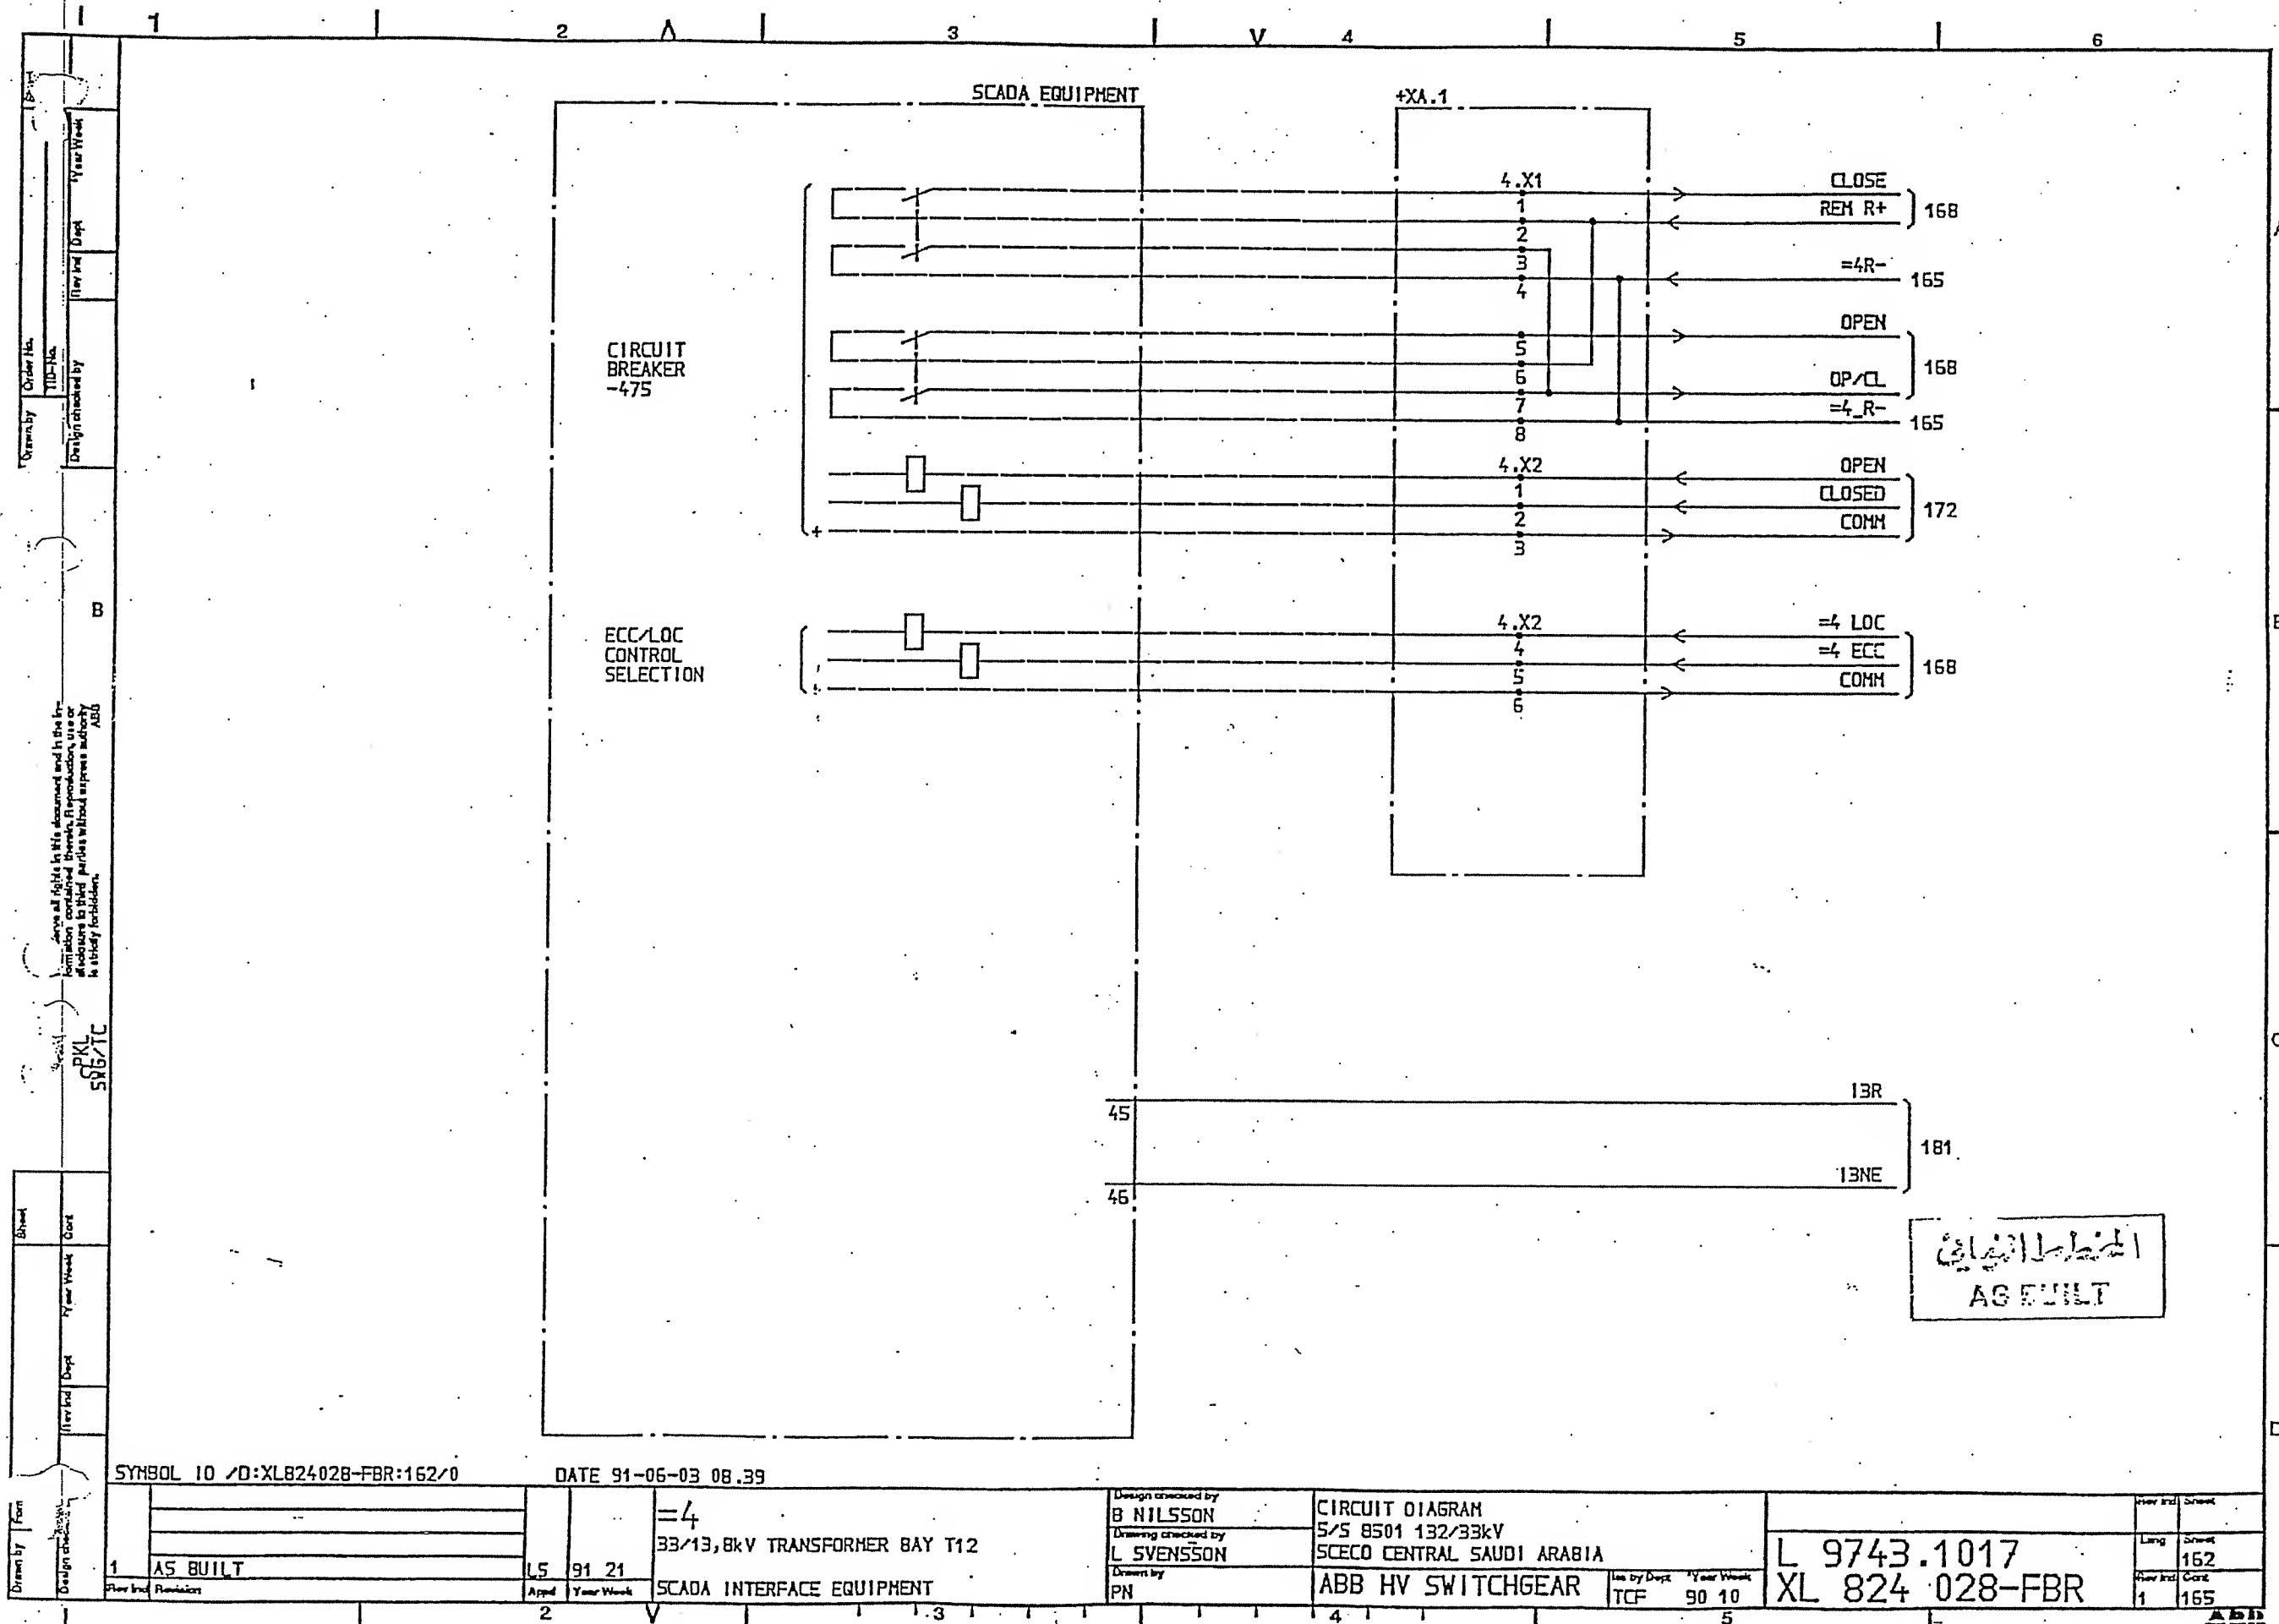


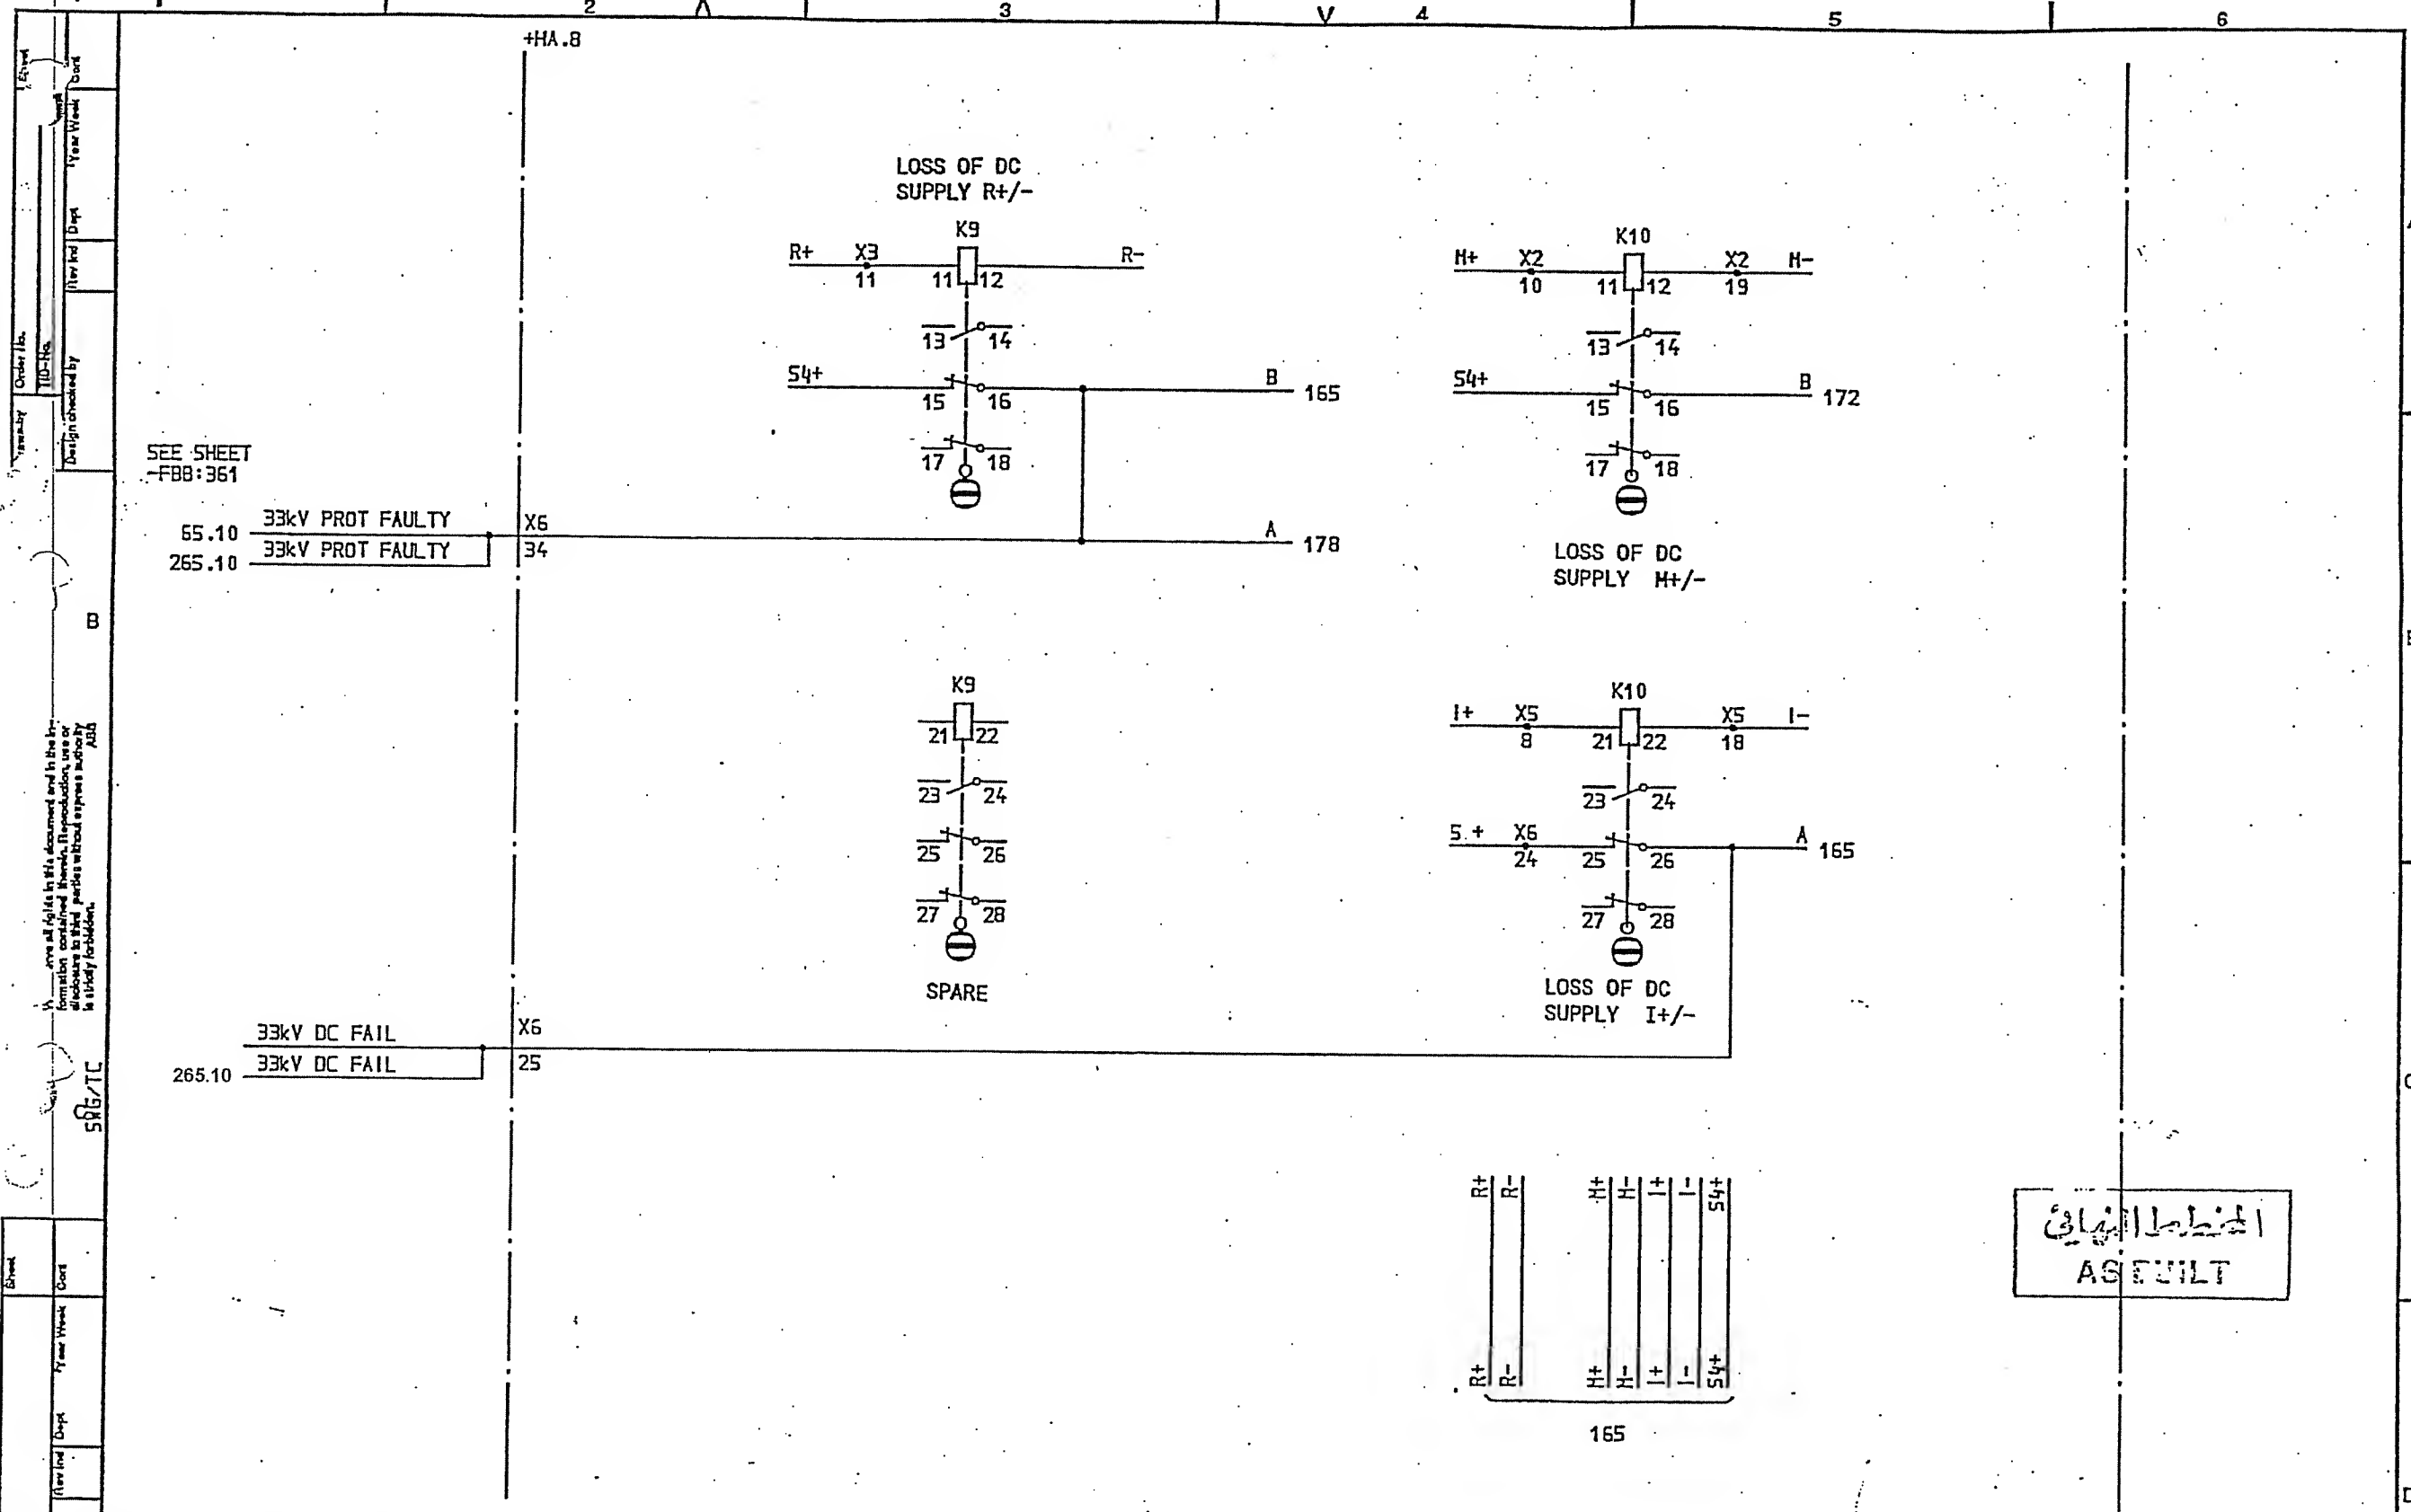


SYMBOL ID /0:XL824028-FBR:165.10/0 DATE 91-06-03 08.40

| | | | | | | | | | | | | |
|------------------------|--|------|-----------|-------------------------------------|--|----------------------------------|--|--|--|------|-------|-------|
| AS BUILT | | LS | 91 21 | =4 33/13,8kV TRANSFORMER BAY T12 | | Design checked by B NILSSON | | CIRCUIT DIAGRAM S/S 8501 132/33kV SCECO CENTRAL SAUDI ARABIA | | Rev | Int | Sheet |
| DC AUX. VOLTAGE SUPPLY | | Appd | Year Week | PN | | Drawing checked by L SVENSSON | | ABB HV SWITCHGEAR | | Lang | Sheet | |
| | | | | | | Drawn by PN | | TDCF 90 36 | | Rev | Int | Sheet |
| | | | | | | | | L 9743.1017 | | 1 | 165 | |
| | | | | | | | | XL 824 028-FBR | | | | |

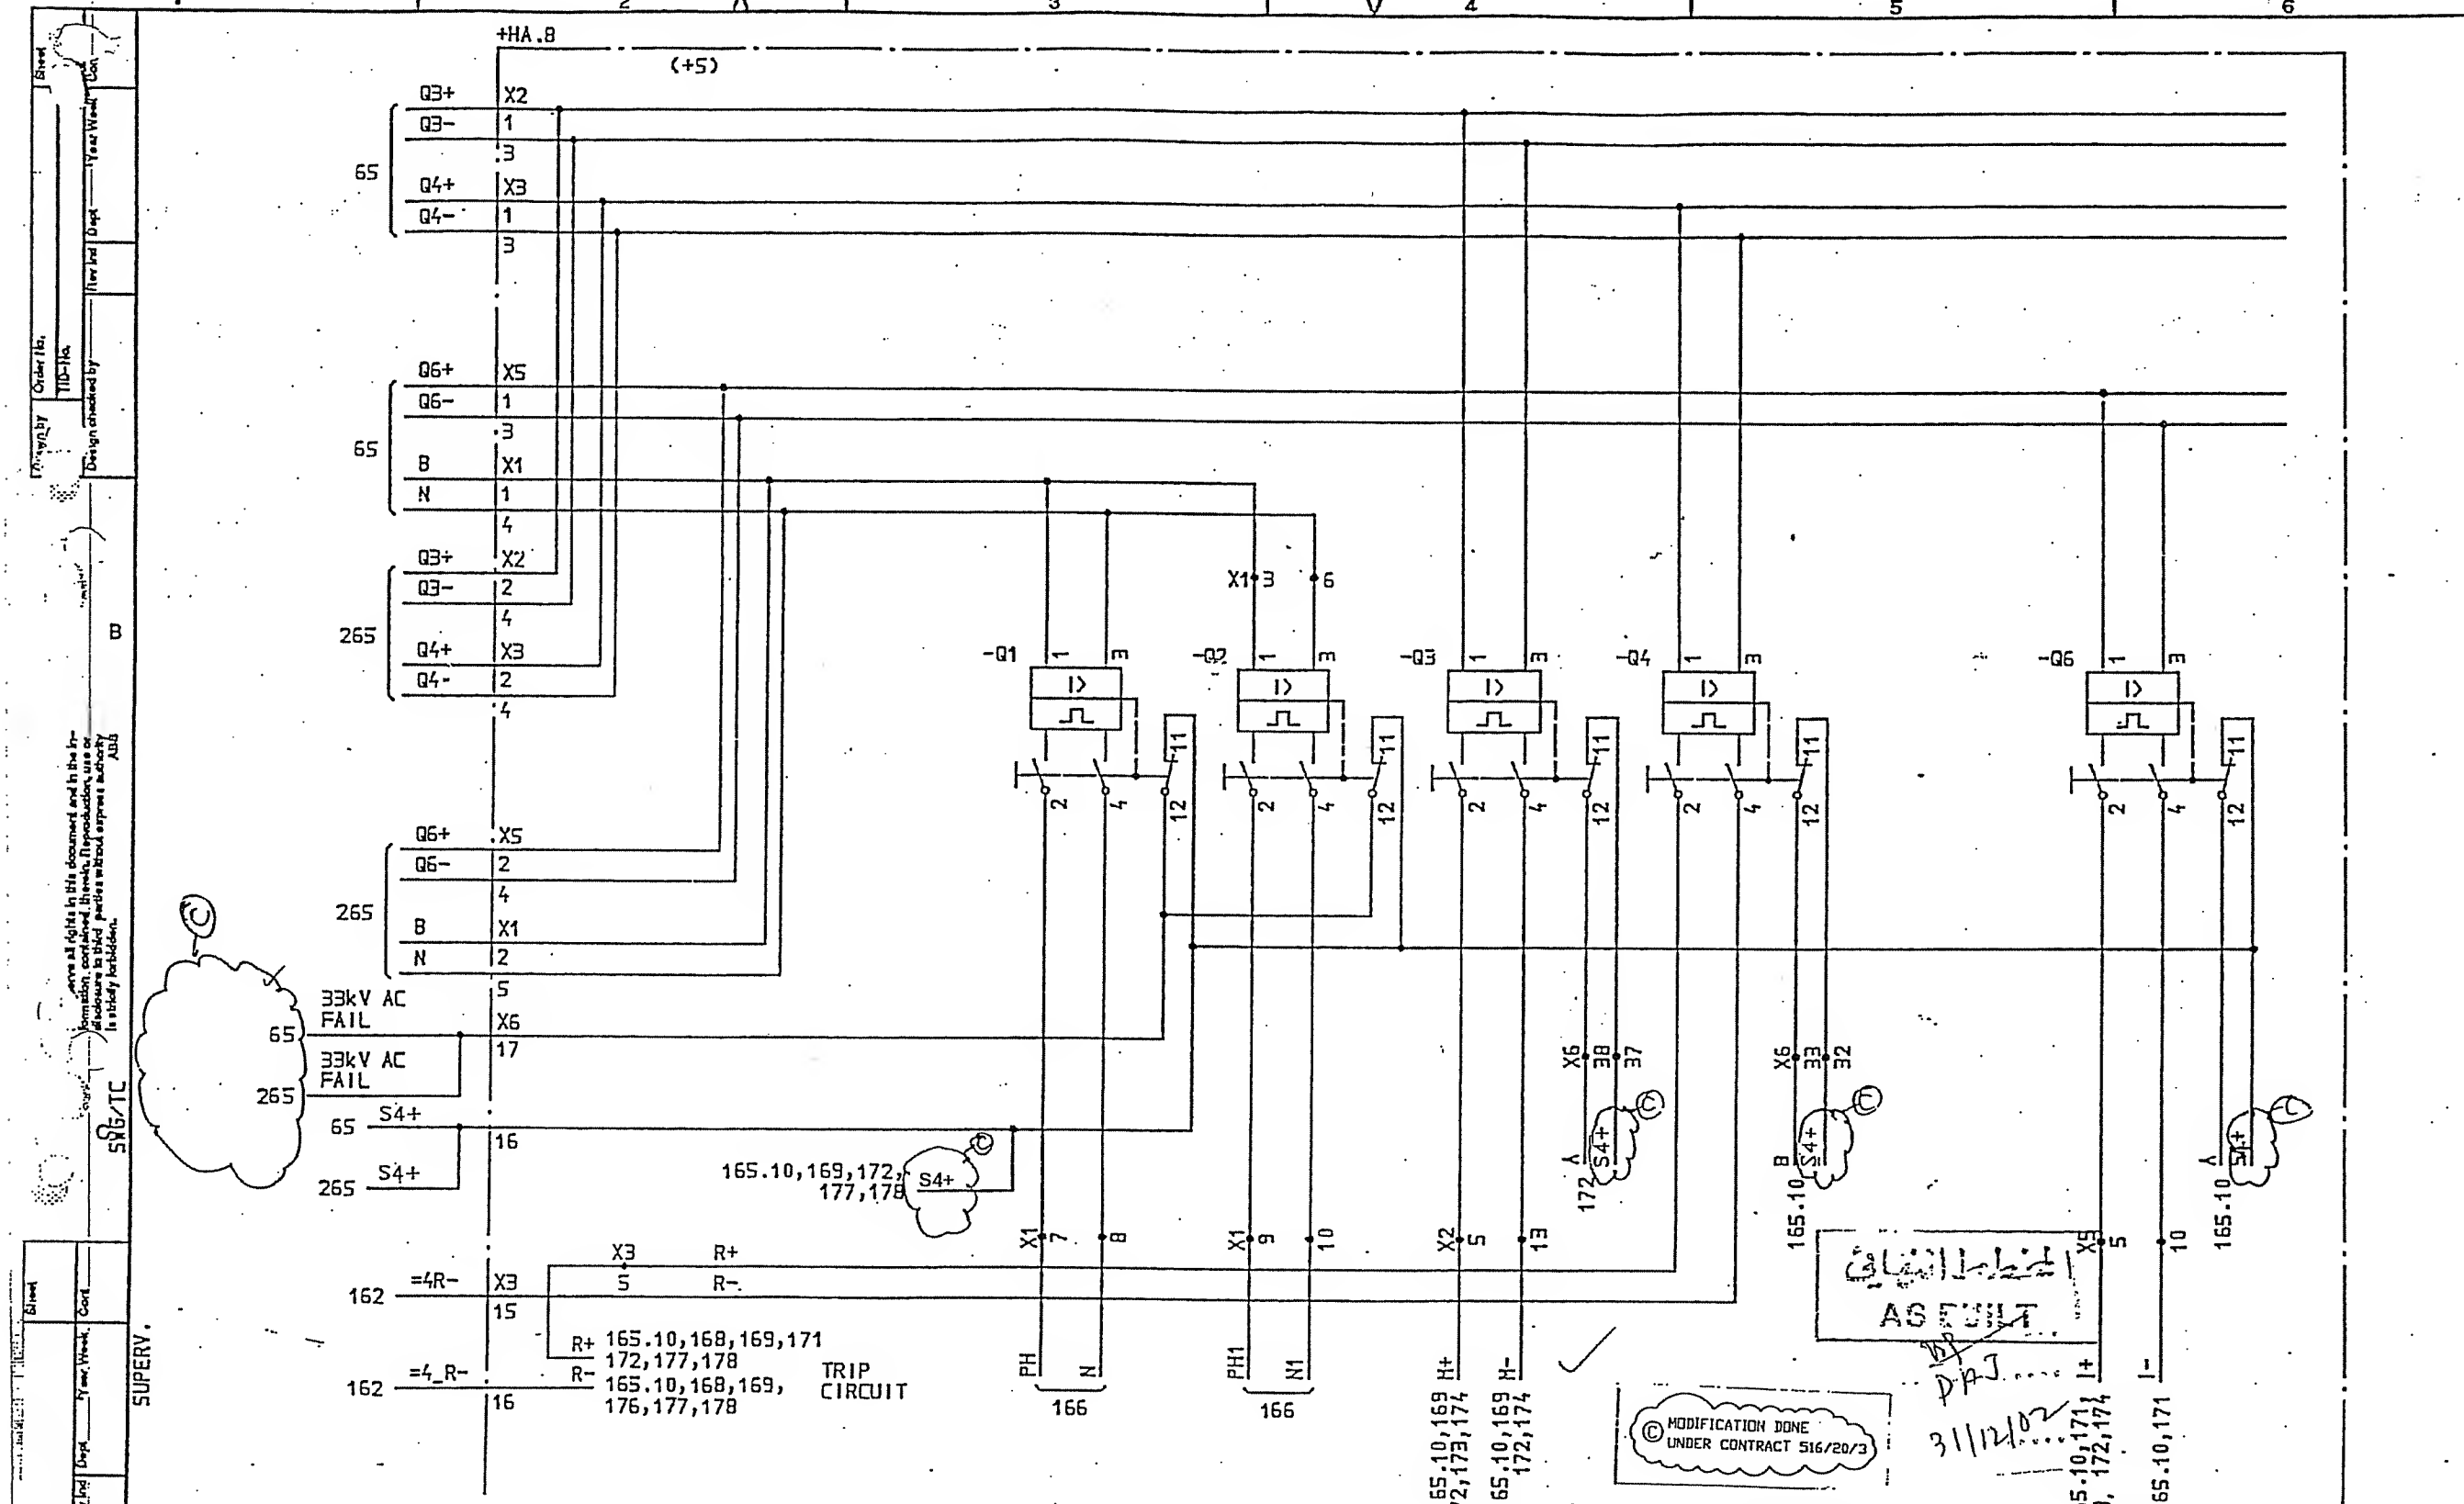ABB




| | | | | | | | | | | | | | |
|---------------------------------|--|-------------------------------|--|----------------------------------|--|----------------------------|--|-------------------|--|----------------|--|------------|--|
| SYMBOL ID /D:XL824028-FBR:165/0 | | DATE 91-06-03 08.39 | | LIGHTING PANEL | | HEATING PANEL | | MOTOR SUPPLY | | MODIFIED | | INDICATION | |
| =4 | | 33/13,8kV TRANSFORMER BAY T12 | | Design checked by B NILSSON | | CIRCUIT DIAGRAM | | S/S 8501 132/33kV | | L 9743.1017 | | Lang Sheet | |
| AS BUILT | | LS 91 21 | | Drawing checked by L SVENSSON | | SCECO CENTRAL SAUDI ARABIA | | ABB HV SWITCHGEAR | | XL 824 028-FBR | | 165 | |
| DC AUX. VOLTAGE SUPPLY | | PN | | Im by Dept TOCF 90 36 | | Year Work | | 02 | | 165.10 | | A B L | |

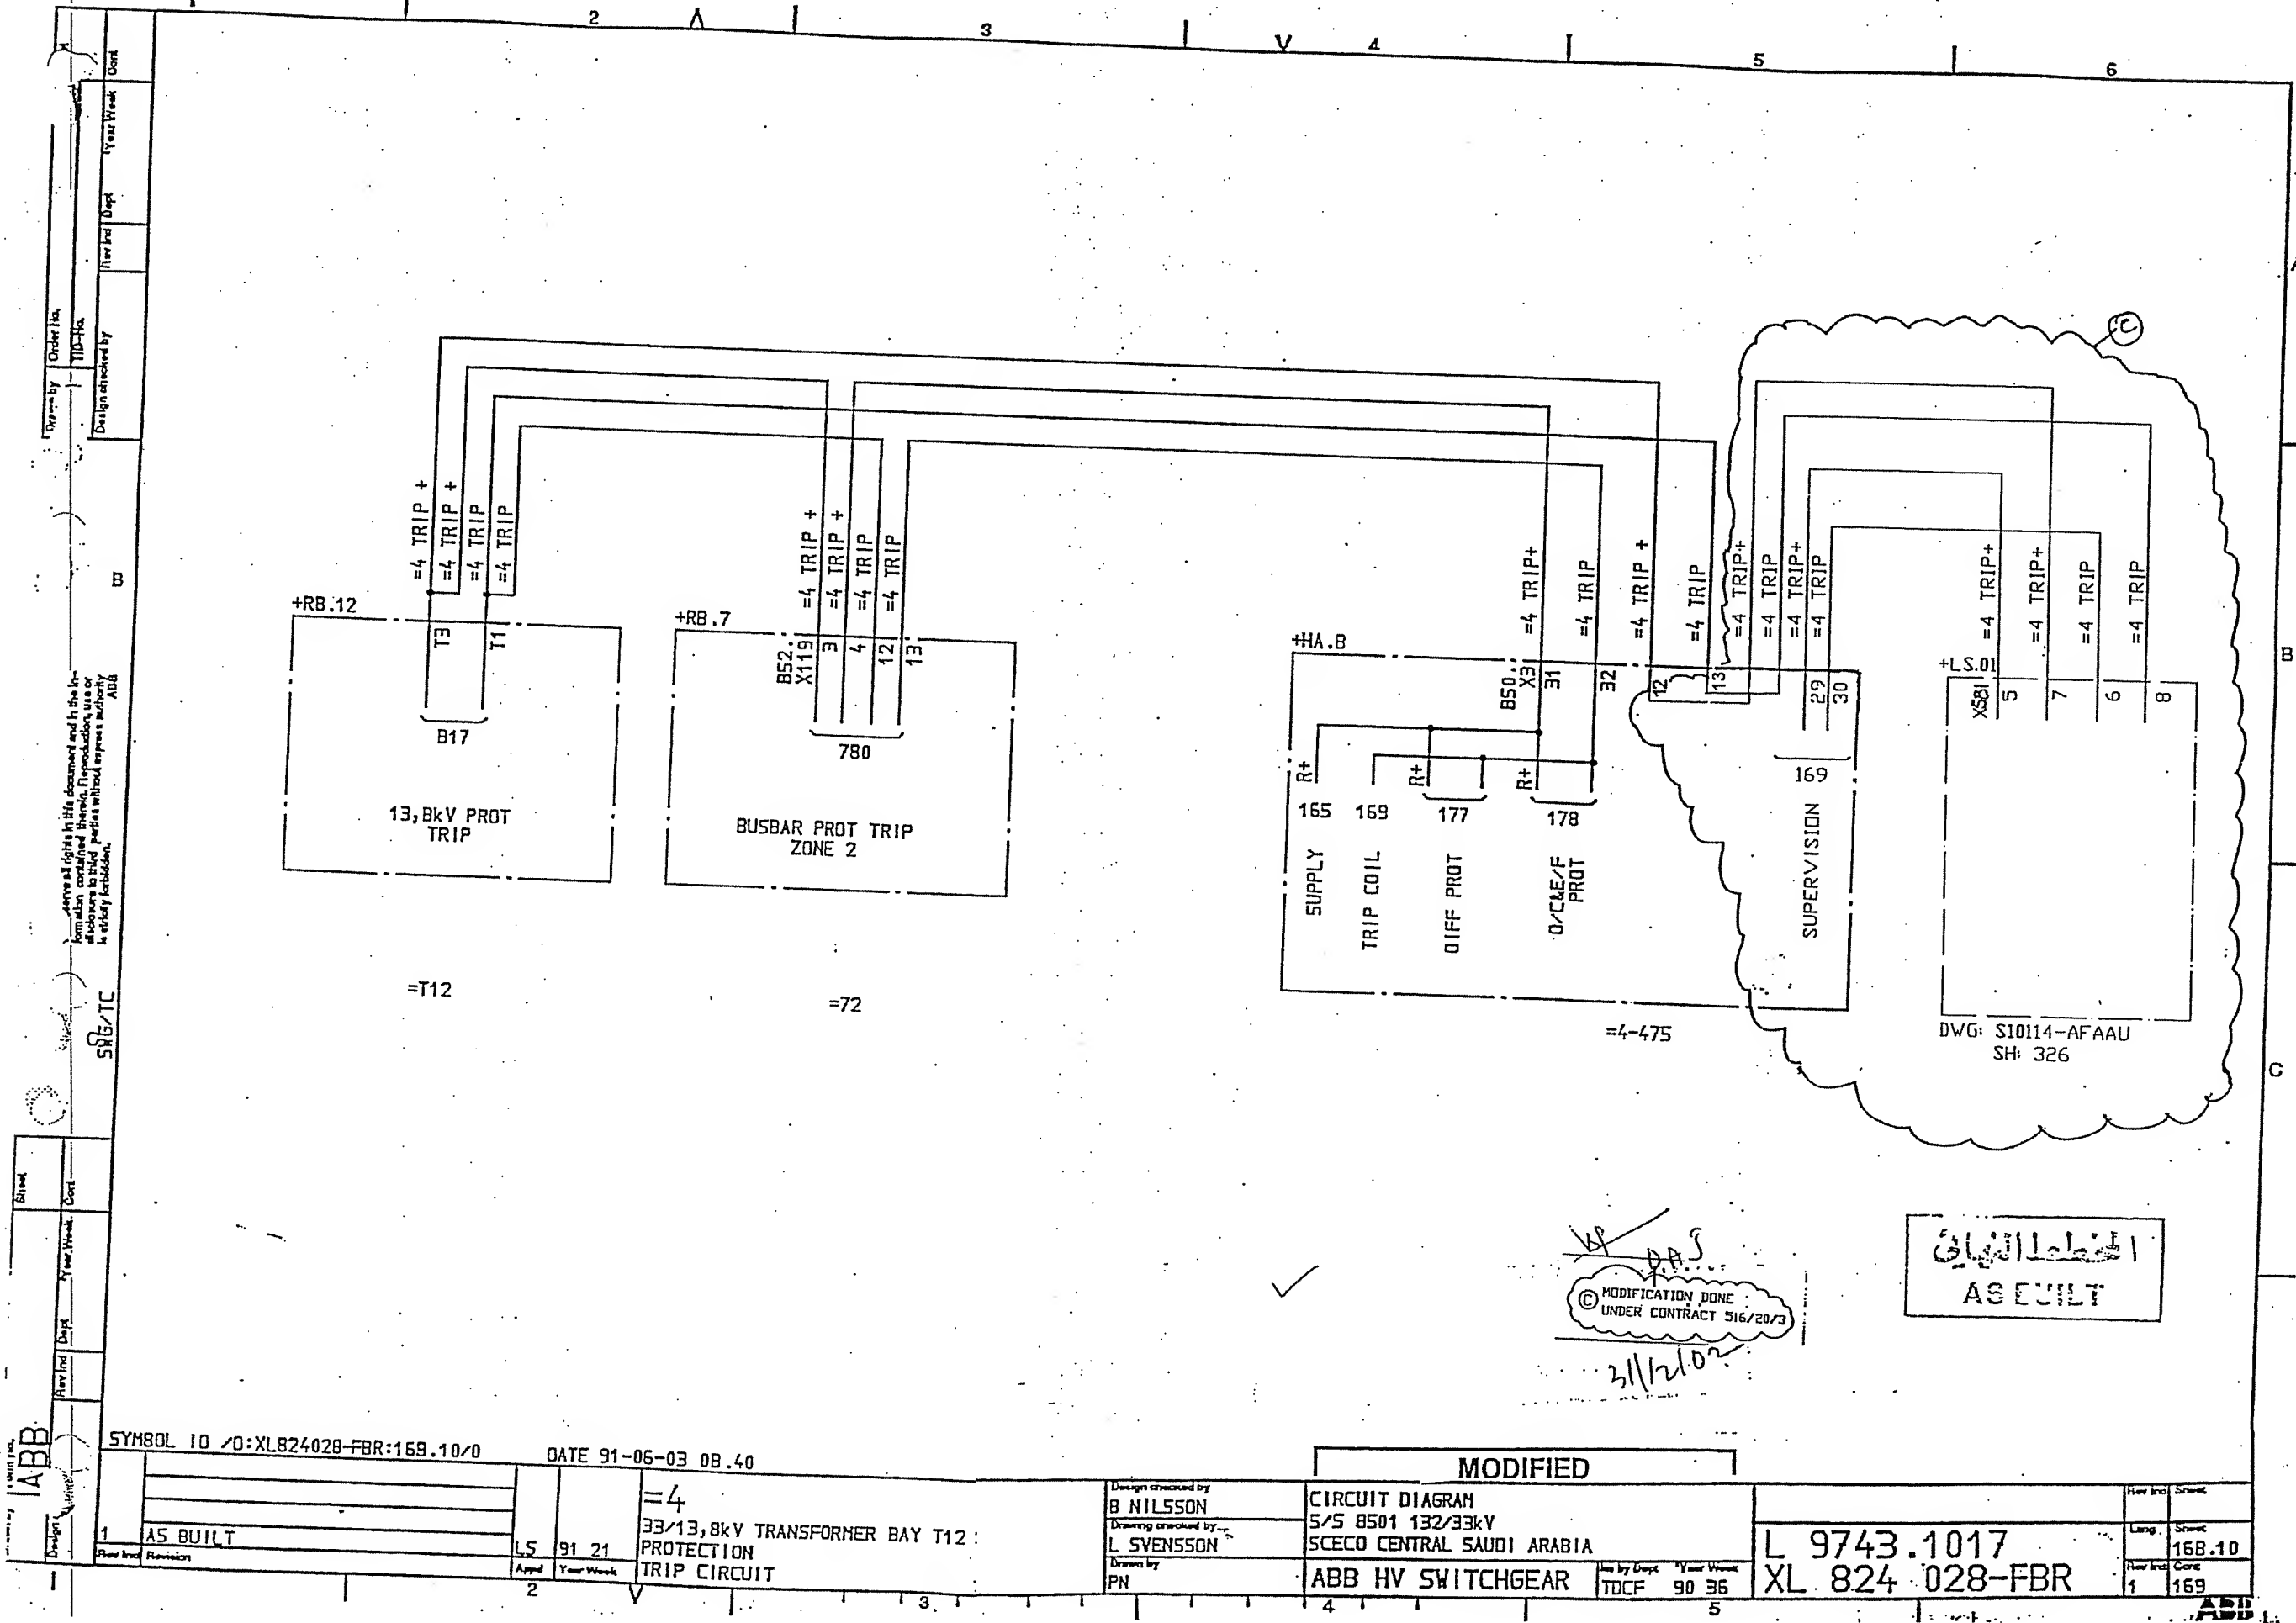

| | | | | | | | |
|----------------------------------|--|--|--|--------------------------------|--|--|--|
| SYMBOL ID: XL824028-FBR:169.10/0 | | | | DATE 91-06-03 08.40 | | | |
| 1 AS BUILT | | | | =4 | | | |
| LS 91 21 | | | | 33/13,8kV TRANSFORMER BAY T12: | | | |
| 2 | | | | PROTECTION TRIP CIRCUIT | | | |
| Design checked by: B NILSSON | | | | CIRCUIT DIAGRAM | | | |
| Drawing checked by: L SVENSSON | | | | 5/5 8501 132/33kV | | | |
| Drawn by: PN | | | | SCECO CENTRAL SAUDI ARABIA | | | |
| Modified by: TDCF | | | | ABB HV SWITCHGEAR | | | |
| Year Week: 90 36 | | | | L 9743.1017 | | | |
| | | | | XL 824 028-FBR | | | |
| | | | | Lang: 168.10 | | | |
| | | | | Rev: 169 | | | |

31/12/02
 MODIFICATION DONE
 UNDER CONTRACT 516/20/3

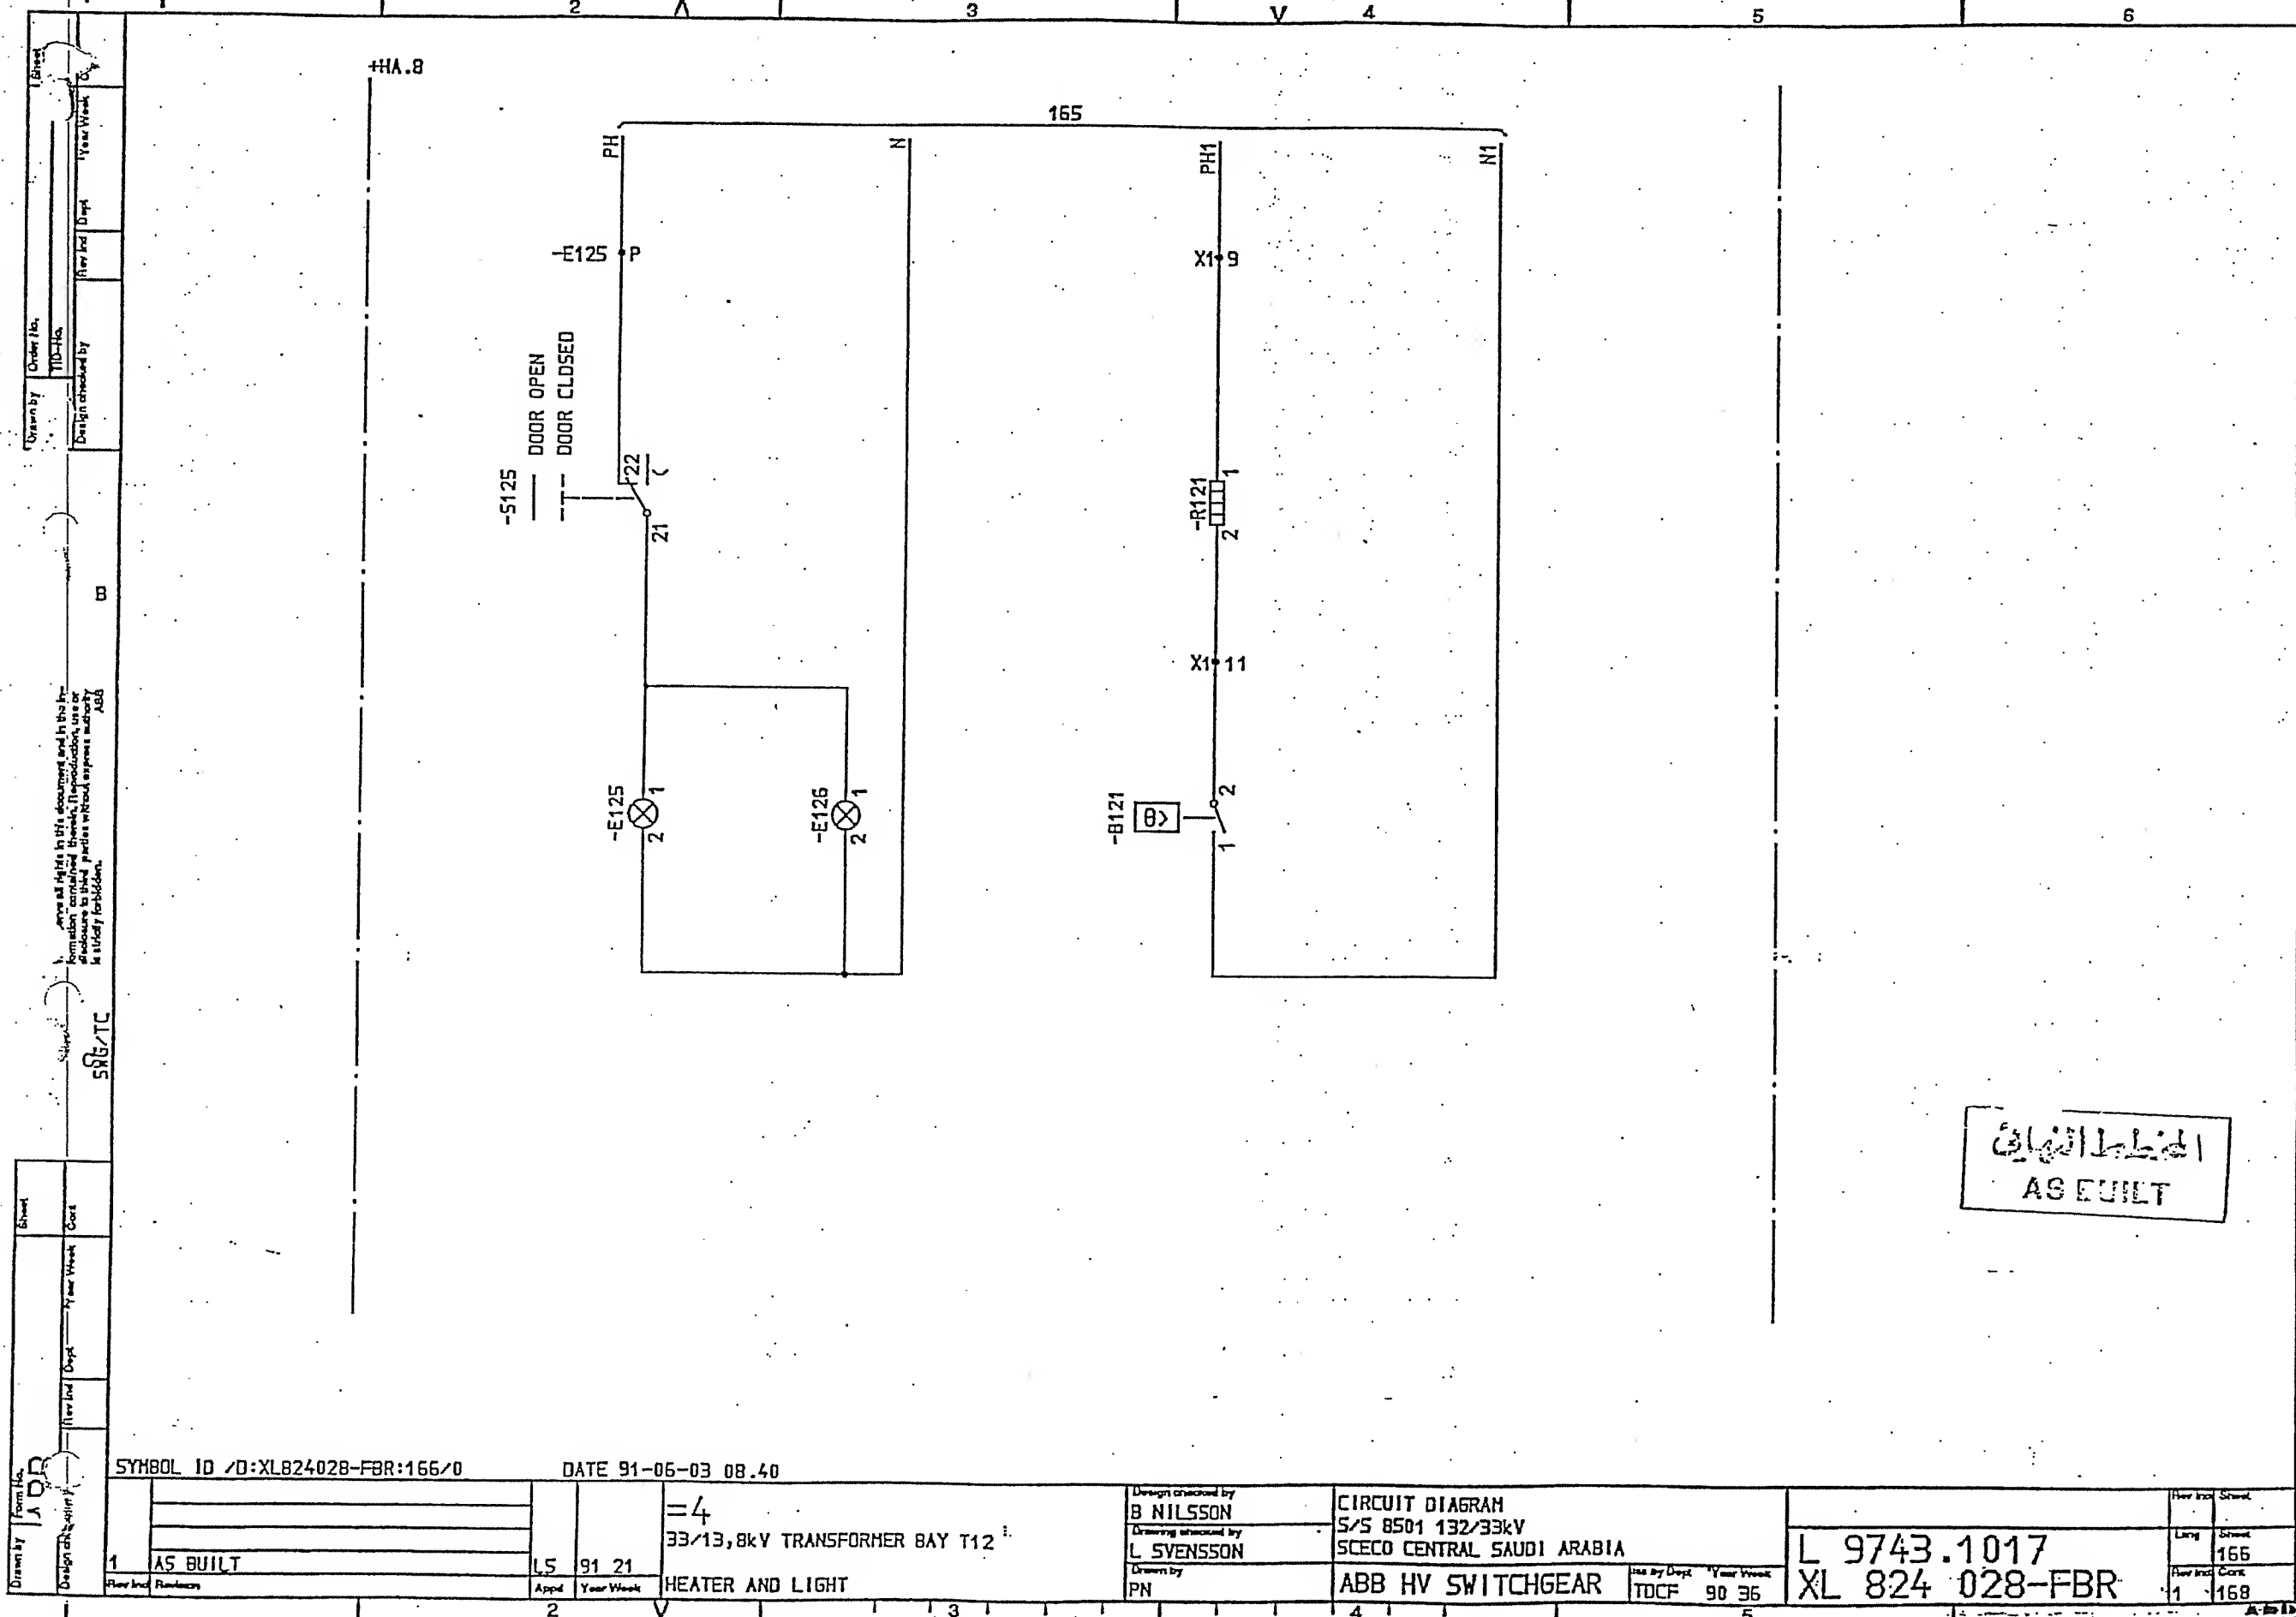المخطط النهائي
 ASEULT



المخطط النهائي
AS BUILT

SYMBOL ID /D:XL824028-FBR:165/0

DATE 91-06-03 08.40

1 AS BUILT

LS 91 21

=4
33/13,8kV TRANSFORMER BAY T12
HEATER AND LIGHT

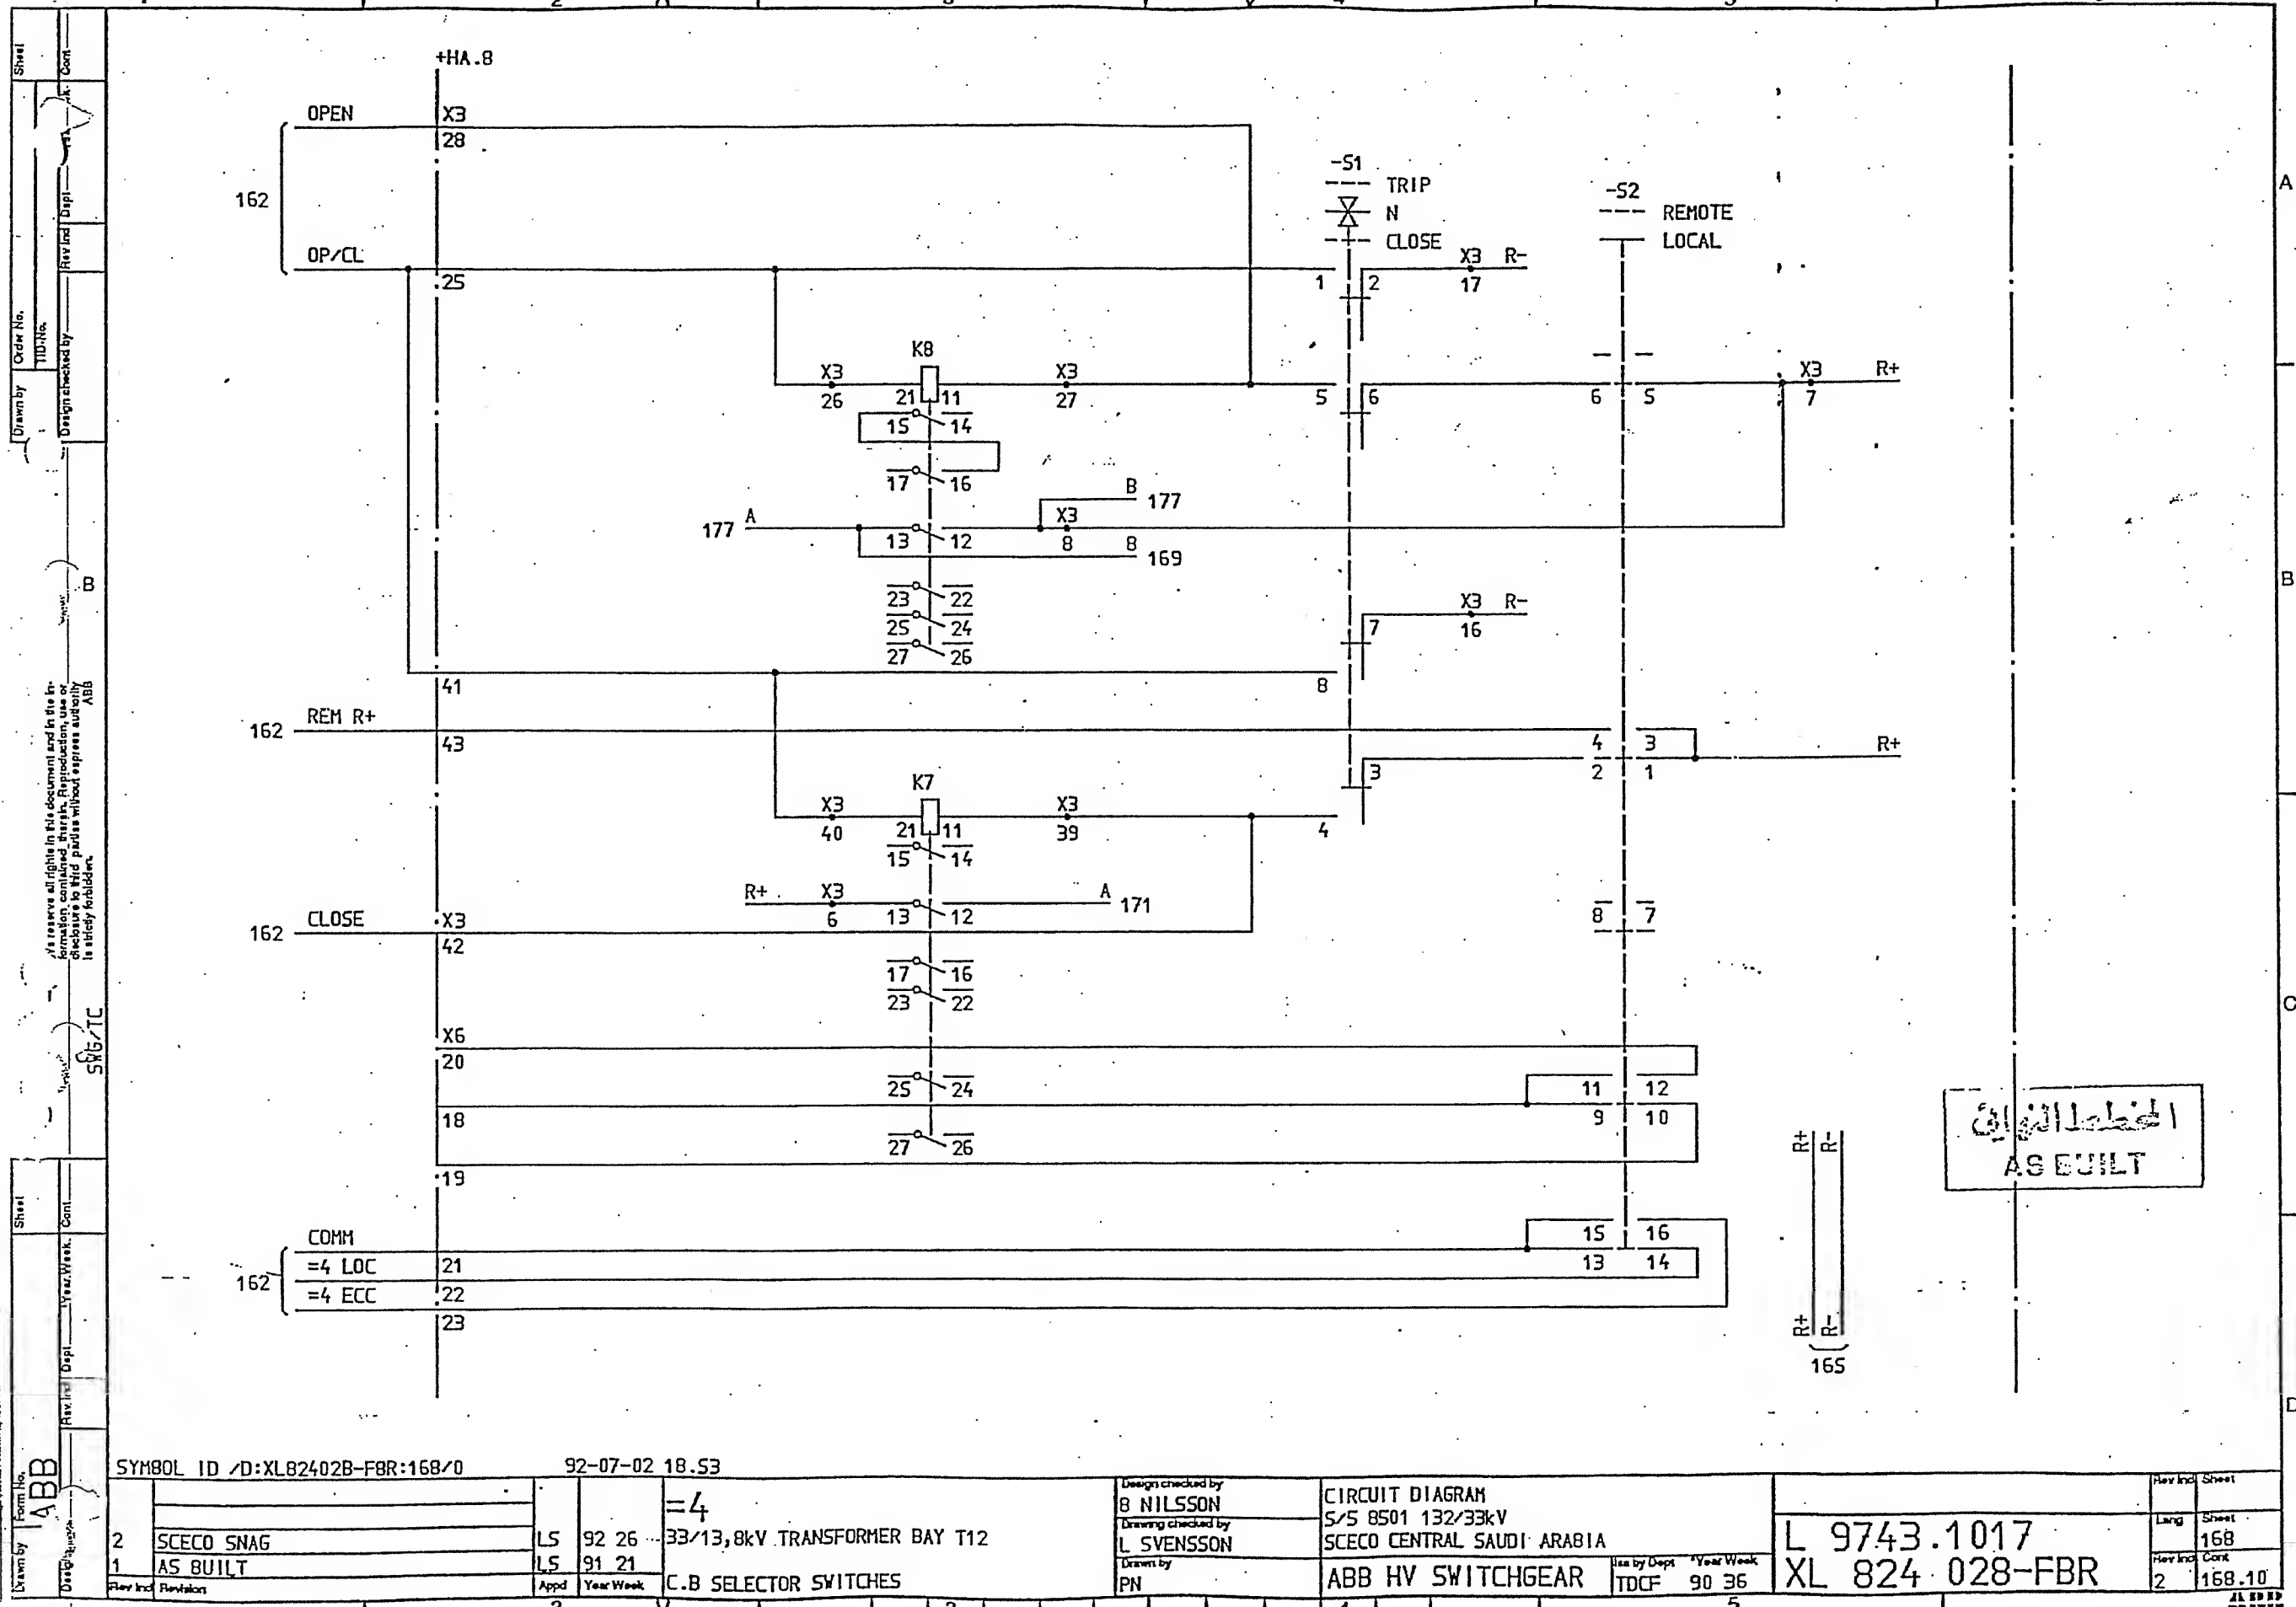
Design checked by
B NILSSON
Drawing checked by
L SVENSSON
Drawn by
PN

CIRCUIT DIAGRAM
S/S 8501 132/33kV
SCECO CENTRAL SAUDI ARABIA
ABB HV SWITCHGEAR

Iss By Dept Year Week
TDCF 90 36

L 9743.1017
XL 824 028-FBR


Rev Issd Sheet
Long Sheet
1 165
1 168



الخط المخطط
AS BUILT

| | | | | | | | | | | | |
|-------------------------------|--|--|--|--|--|---|--|-------------------------------|--|---|--|
| SYMBOL ID: XLB24028-FBR:254/0 | | DATE 91-06-04 09.07 | | Design checked by B NILSSON Drawing checked by J SKOVGAARD Drawn by CL | | CIRCUIT DIAGRAM 5/5 8501 132/33kV SCECO CENTRAL SAUDI ARABIA ABB HV SWITCHGEAR | | L 9743.1017 XI 824 028-FBR | | Rev Int Sheet Lang Sheet 254 Rev Int Cont 1 | |
| AS BUILT 15 91 21 | | =6 33kV INTERCONNECTOR LINE AC AND TELEPHONE JACKET CIRCUITS VOLTAGE DISTRIBUTION | | | | | | | | | |



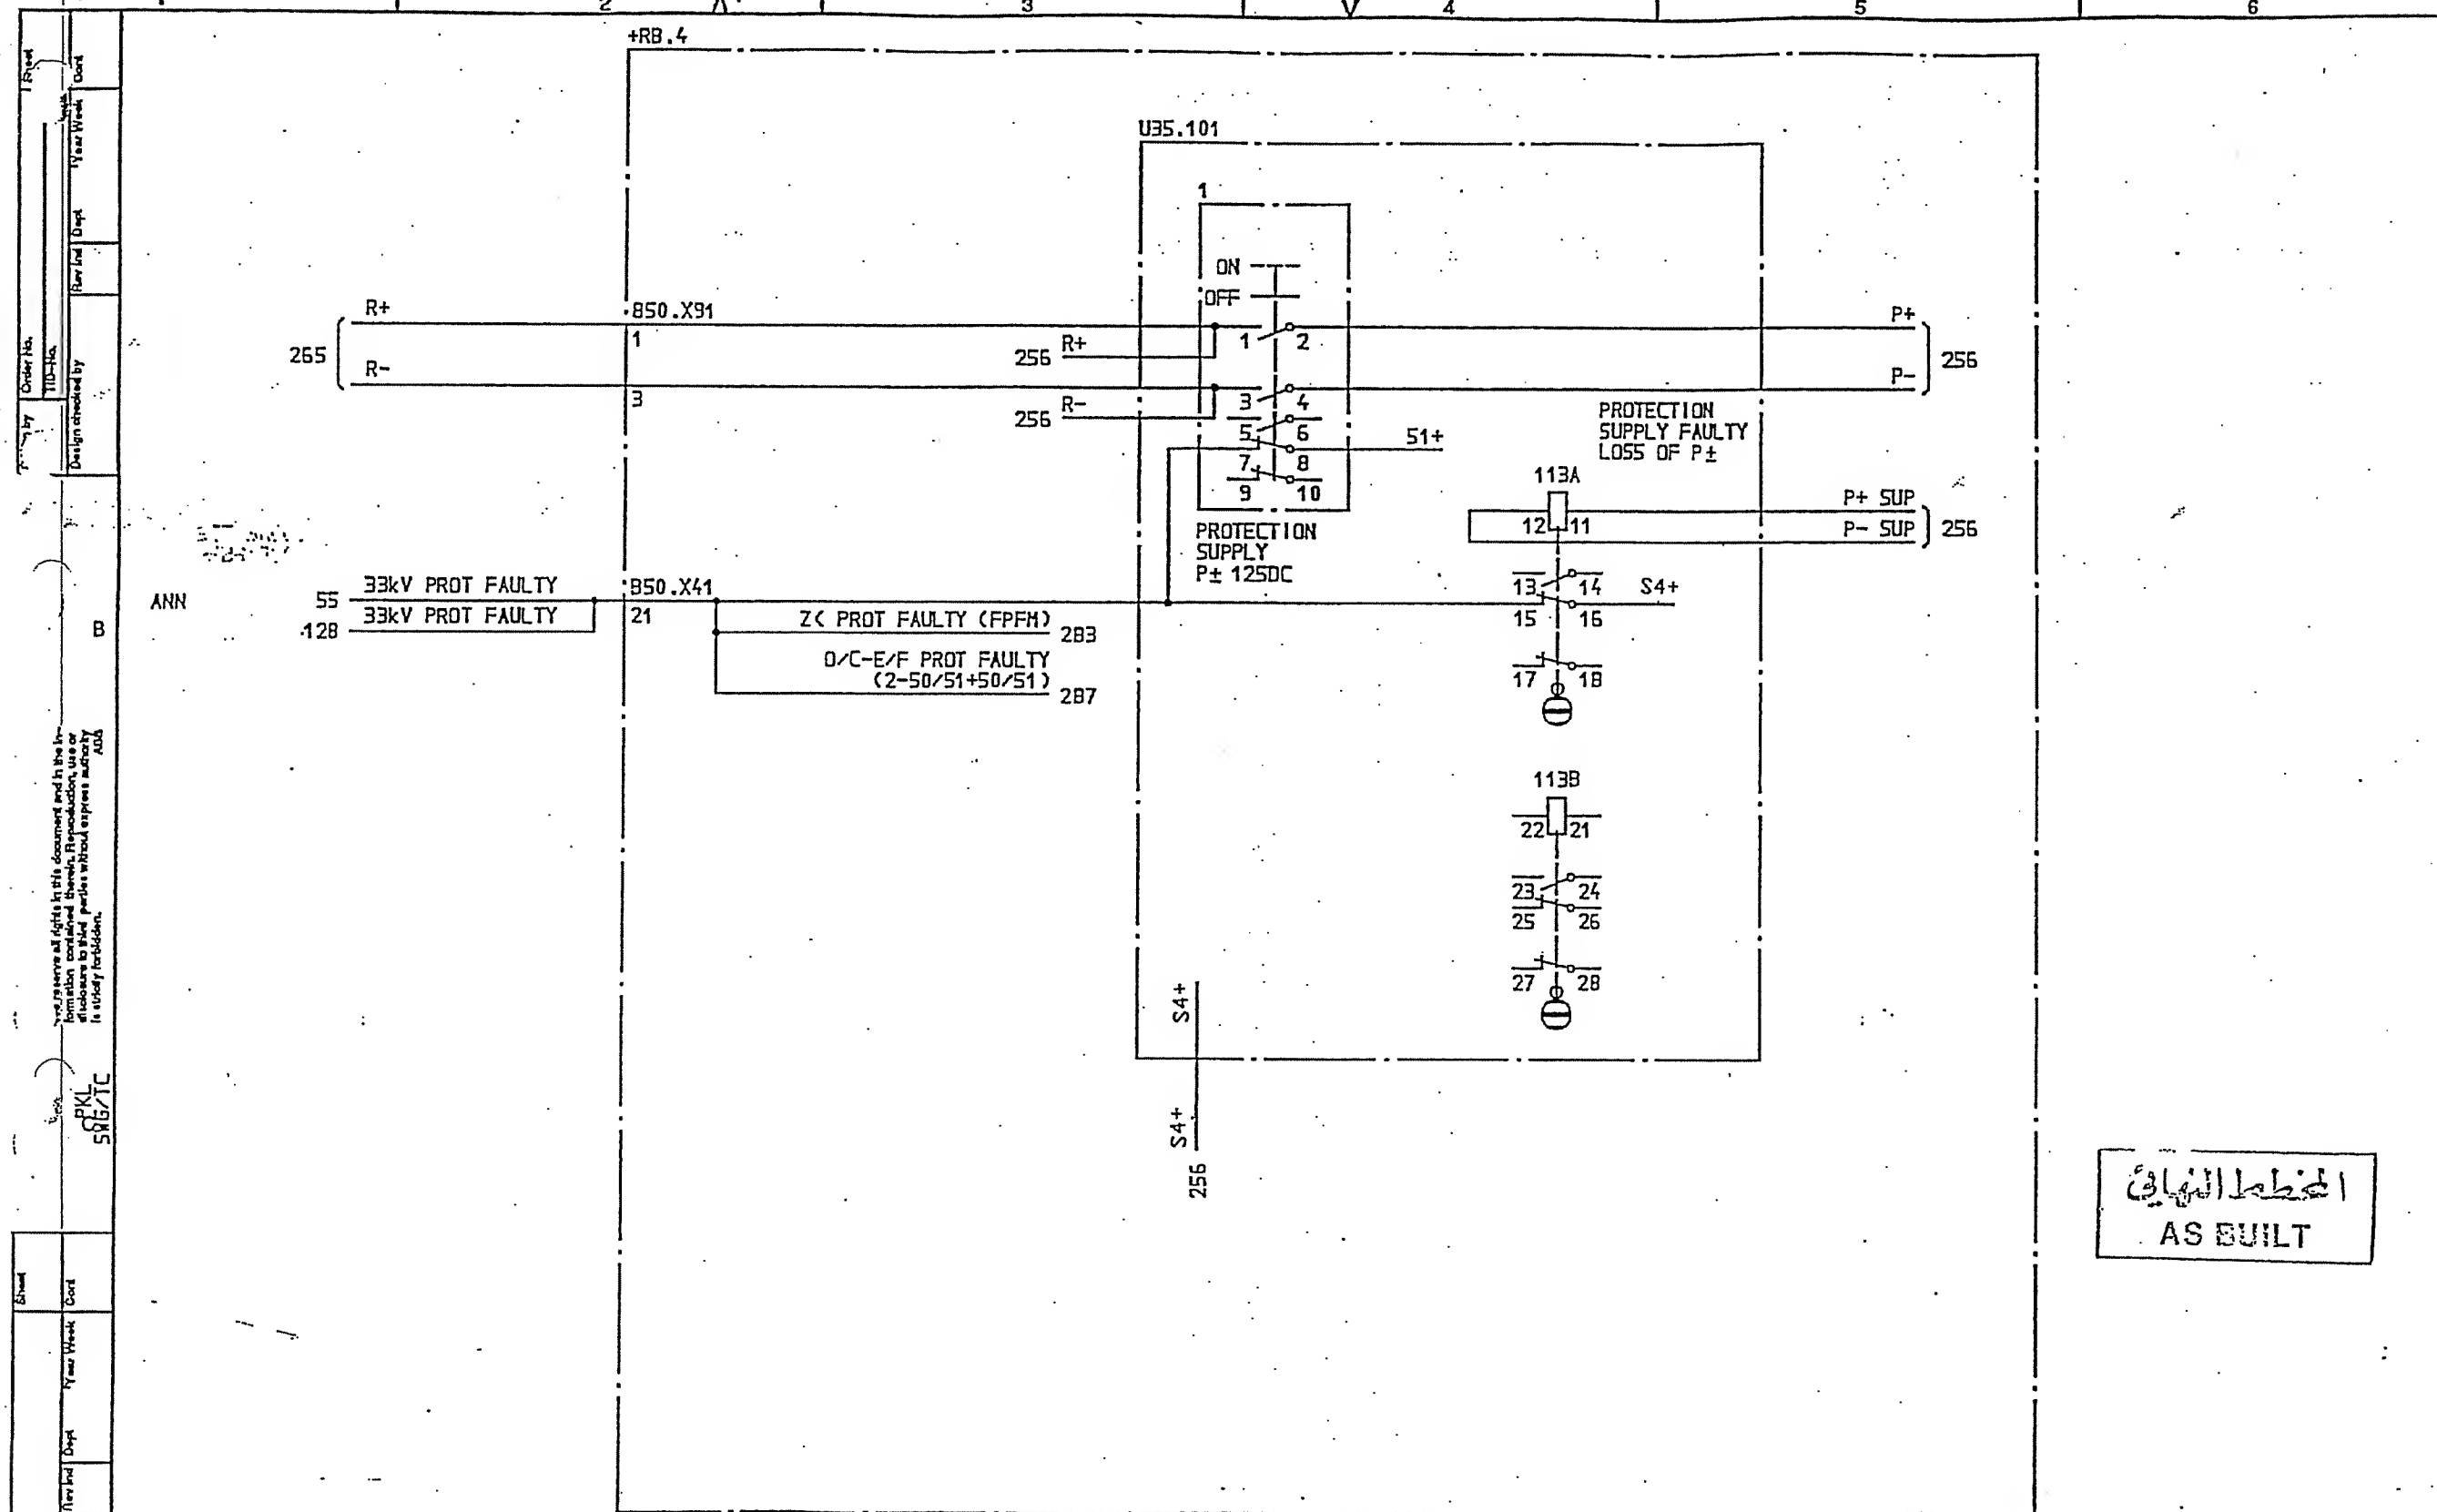

SYMBOL ID /0:XL824028-FBR:255/0

DATE 91-06-04 09.07

| Drawn by | Form No. | Sheet | Cont | Year Week | Cont |
|----------|----------|-------|-------|-----------|------|
| 1 | AS BUILT | L5 | 91 21 | | |

=6
33kV INTERCONNECTOR LINE
PROTECTION SUPPLY
VOLTAGE DISTRIBUTION

Design checked by
B NILSSON
Drawing checked by
J SKOVGAARD
Drawn by
IA

CIRCUIT DIAGRAM
S/S 8501 132/33kV
SCECO CENTRAL SAUDI ARABIA

Iss by Dept Year Week
TDCF 90 15 5

L 9743.1017
XL 824 028-FBR

| Rev | Incl | Sheet |
|-----|------|-------|
| 1 | 255 | 256 |

AS BUILT

| Drawn by | Checked by | Design checked by | Year | Week | Cont |
|--------------------------------|---------------------|-------------------|------|------|------|
| PKL | SRG/TC | | | | |
| SYMBOL ID 0:XL824028-FBR:256/0 | DATE 91-06-04 09.07 | | | | |
| 1 | AS BUILT | 15 | 91 | 21 | |
| 2 | | | | | |
| 3 | | | | | |
| 4 | | | | | |
| 5 | | | | | |
| 6 | | | | | |

33kV INTERCONNECTOR LINE
PROTECTION AND ALARM SUPPLY
VOLTAGE DISTRIBUTION

255

283

285

286

287

| | | | | | | |
|----------------------------------|---------------------|-------------------|-----------|-----------|-----------|-----------|
| Drawn by | Sheet | Order No. | Year Week | Year Week | Year Week | Year Week |
| Design checked by | Year Week | Year Week | Year Week | Year Week | Year Week | Year Week |
| PKL | 556/TC | Design checked by | Year Week | Year Week | Year Week | Year Week |
| SYMBOL ID / 0:XL824028-FBR:256/0 | DATE 91-06-04 09.07 | Design checked by | Year Week | Year Week | Year Week | Year Week |
| 1 | AS BUILT | Design checked by | Year Week | Year Week | Year Week | Year Week |
| 2 | AS BUILT | Design checked by | Year Week | Year Week | Year Week | Year Week |
| 3 | AS BUILT | Design checked by | Year Week | Year Week | Year Week | Year Week |
| 4 | AS BUILT | Design checked by | Year Week | Year Week | Year Week | Year Week |
| 5 | AS BUILT | Design checked by | Year Week | Year Week | Year Week | Year Week |
| 6 | AS BUILT | Design checked by | Year Week | Year Week | Year Week | Year Week |

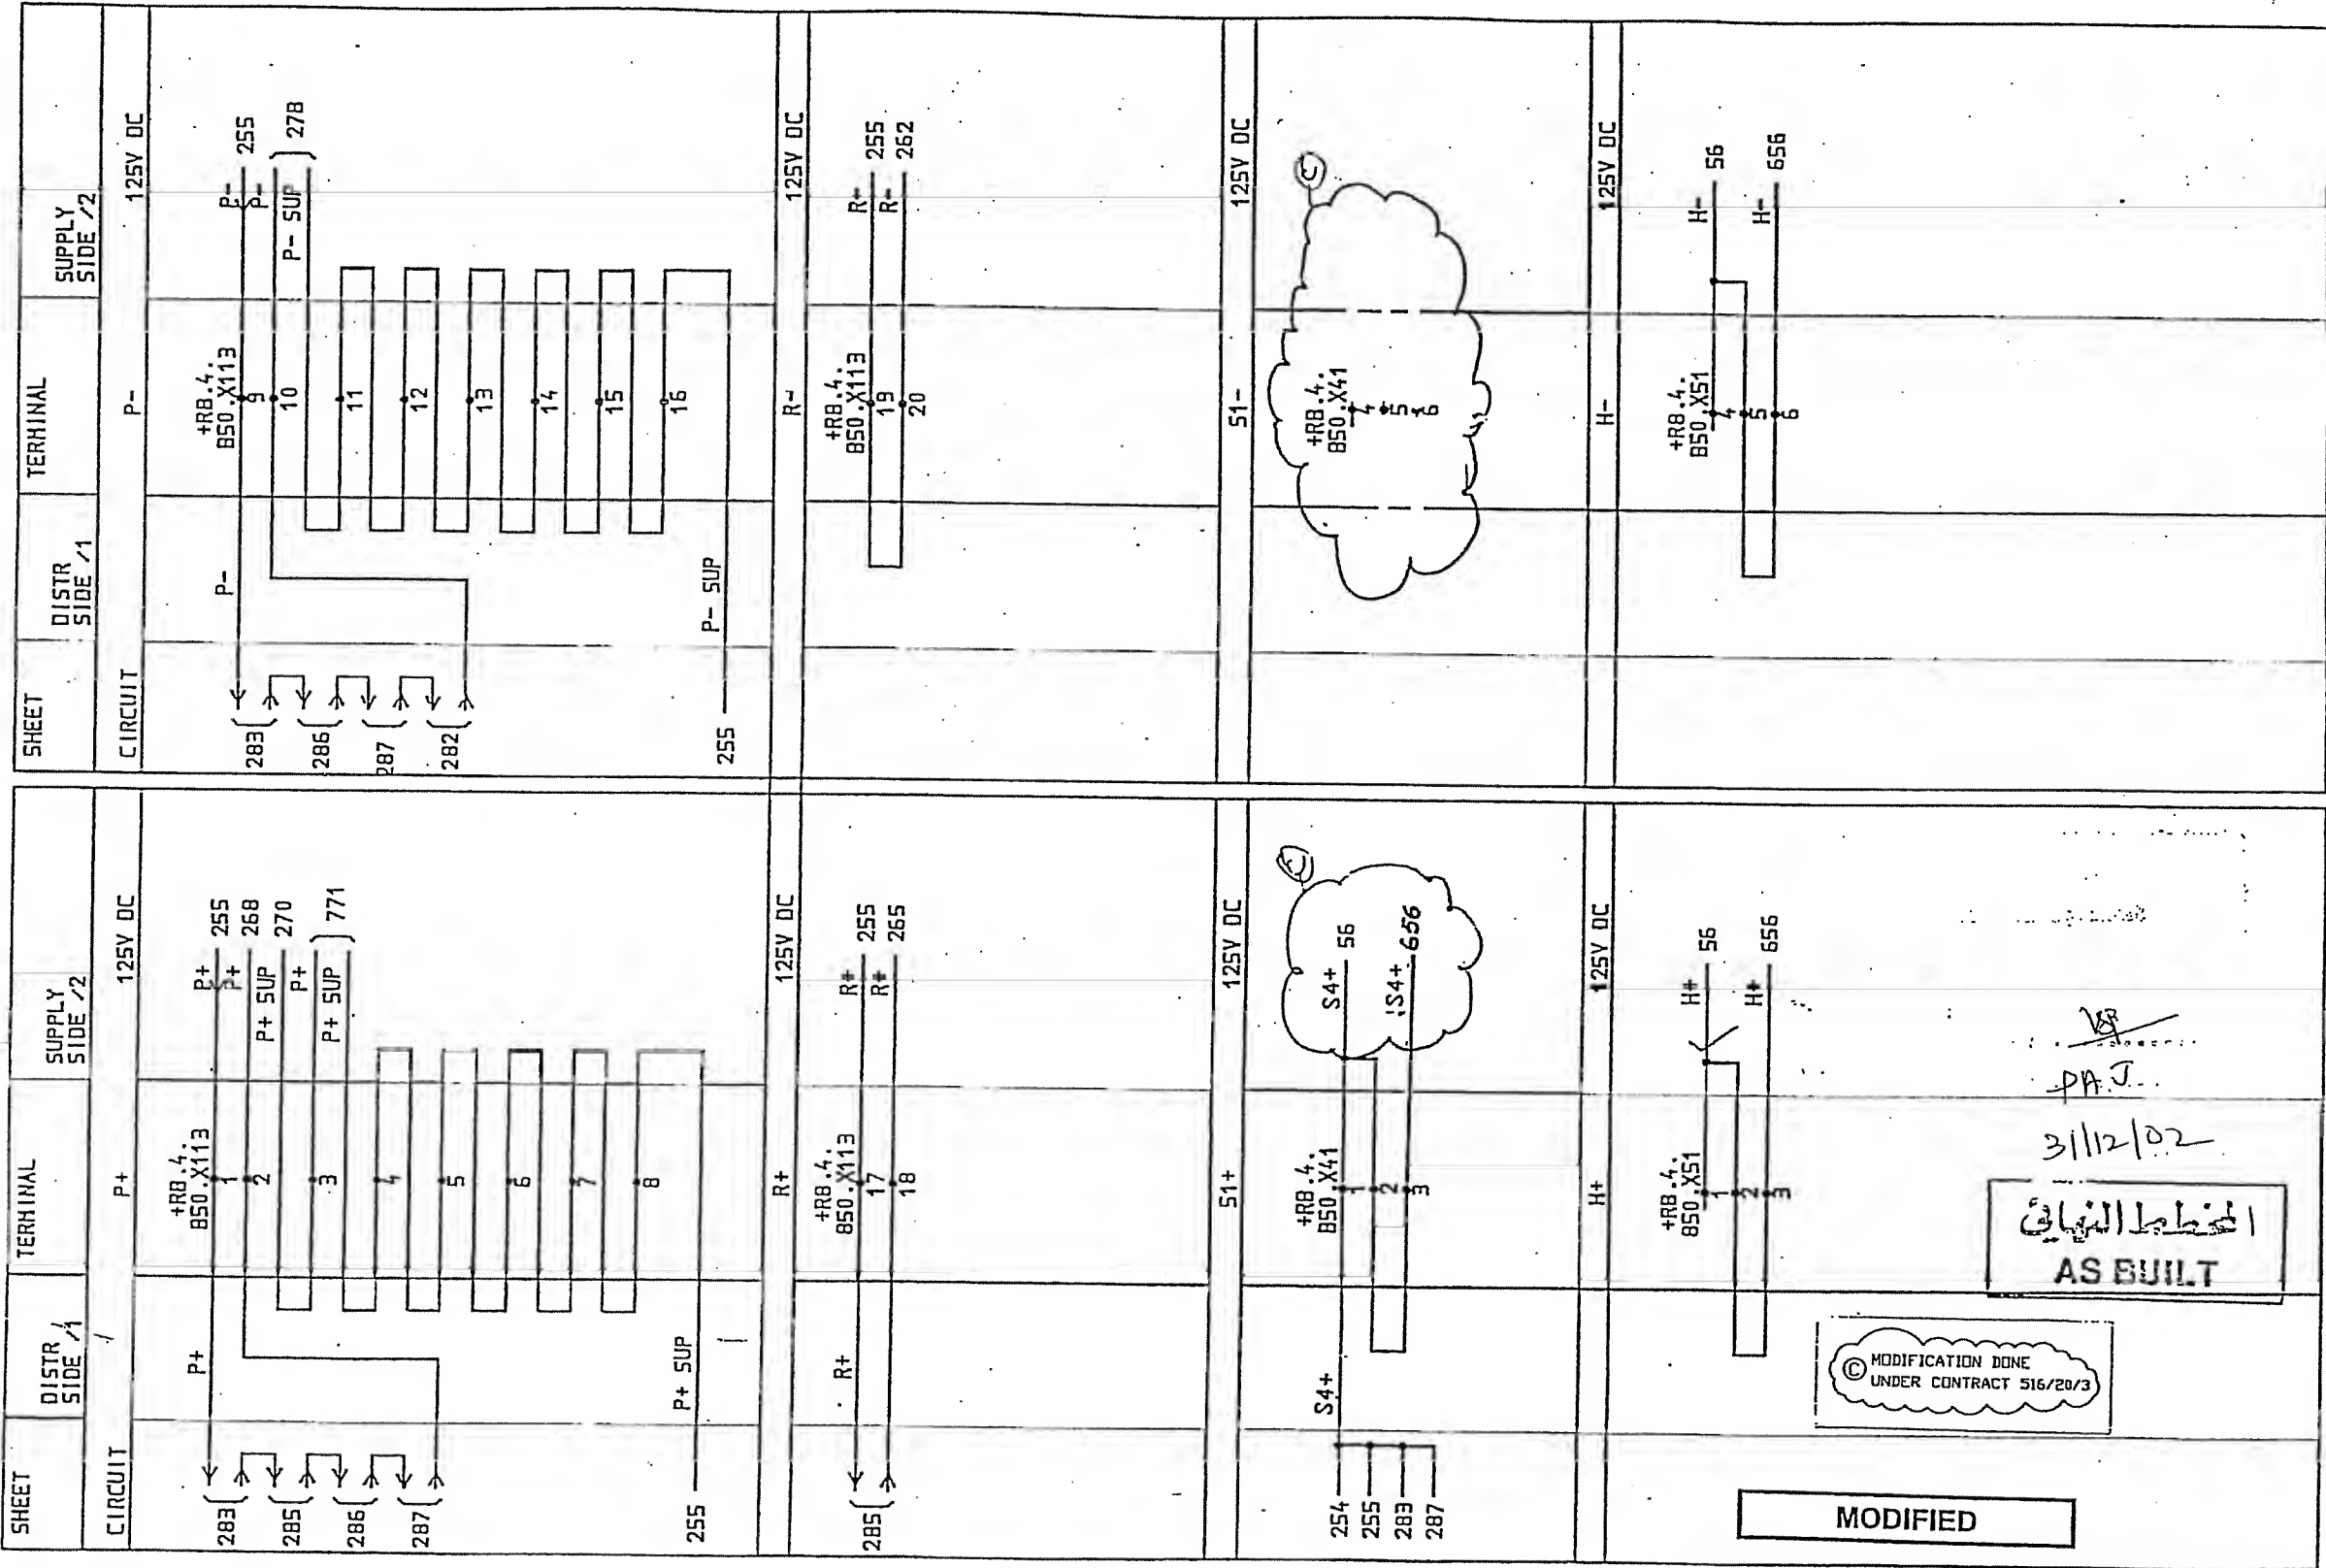

© MODIFICATION DONE
UNDER CONTRACT 516/20/3

المخطط النهائي
AS BUILT

3/11/02

PAJ


MODIFIED

| | | | |
|----------------------------------|--|-------------------------|-------------------------|
| Design created by B NILSSON | CIRCUIT DIAGRAM 5/5 8501 132/33kV SCECO CENTRAL SAUDI ARABIA | Year Week TDCF 90 16 | Year Week TDCF 90 16 |
| Design checked by J SKOVGAARD | ABB HV SWITCHGEAR | Year Week TDCF 90 16 | Year Week TDCF 90 16 |
| Drawn by IA | | | |


L 9743.1017
XL 824 028-FBR


| | |
|-------------------------|-------------------------|
| Year Week TDCF 90 16 | Year Week TDCF 90 16 |
| Year Week TDCF 90 16 | Year Week TDCF 90 16 |

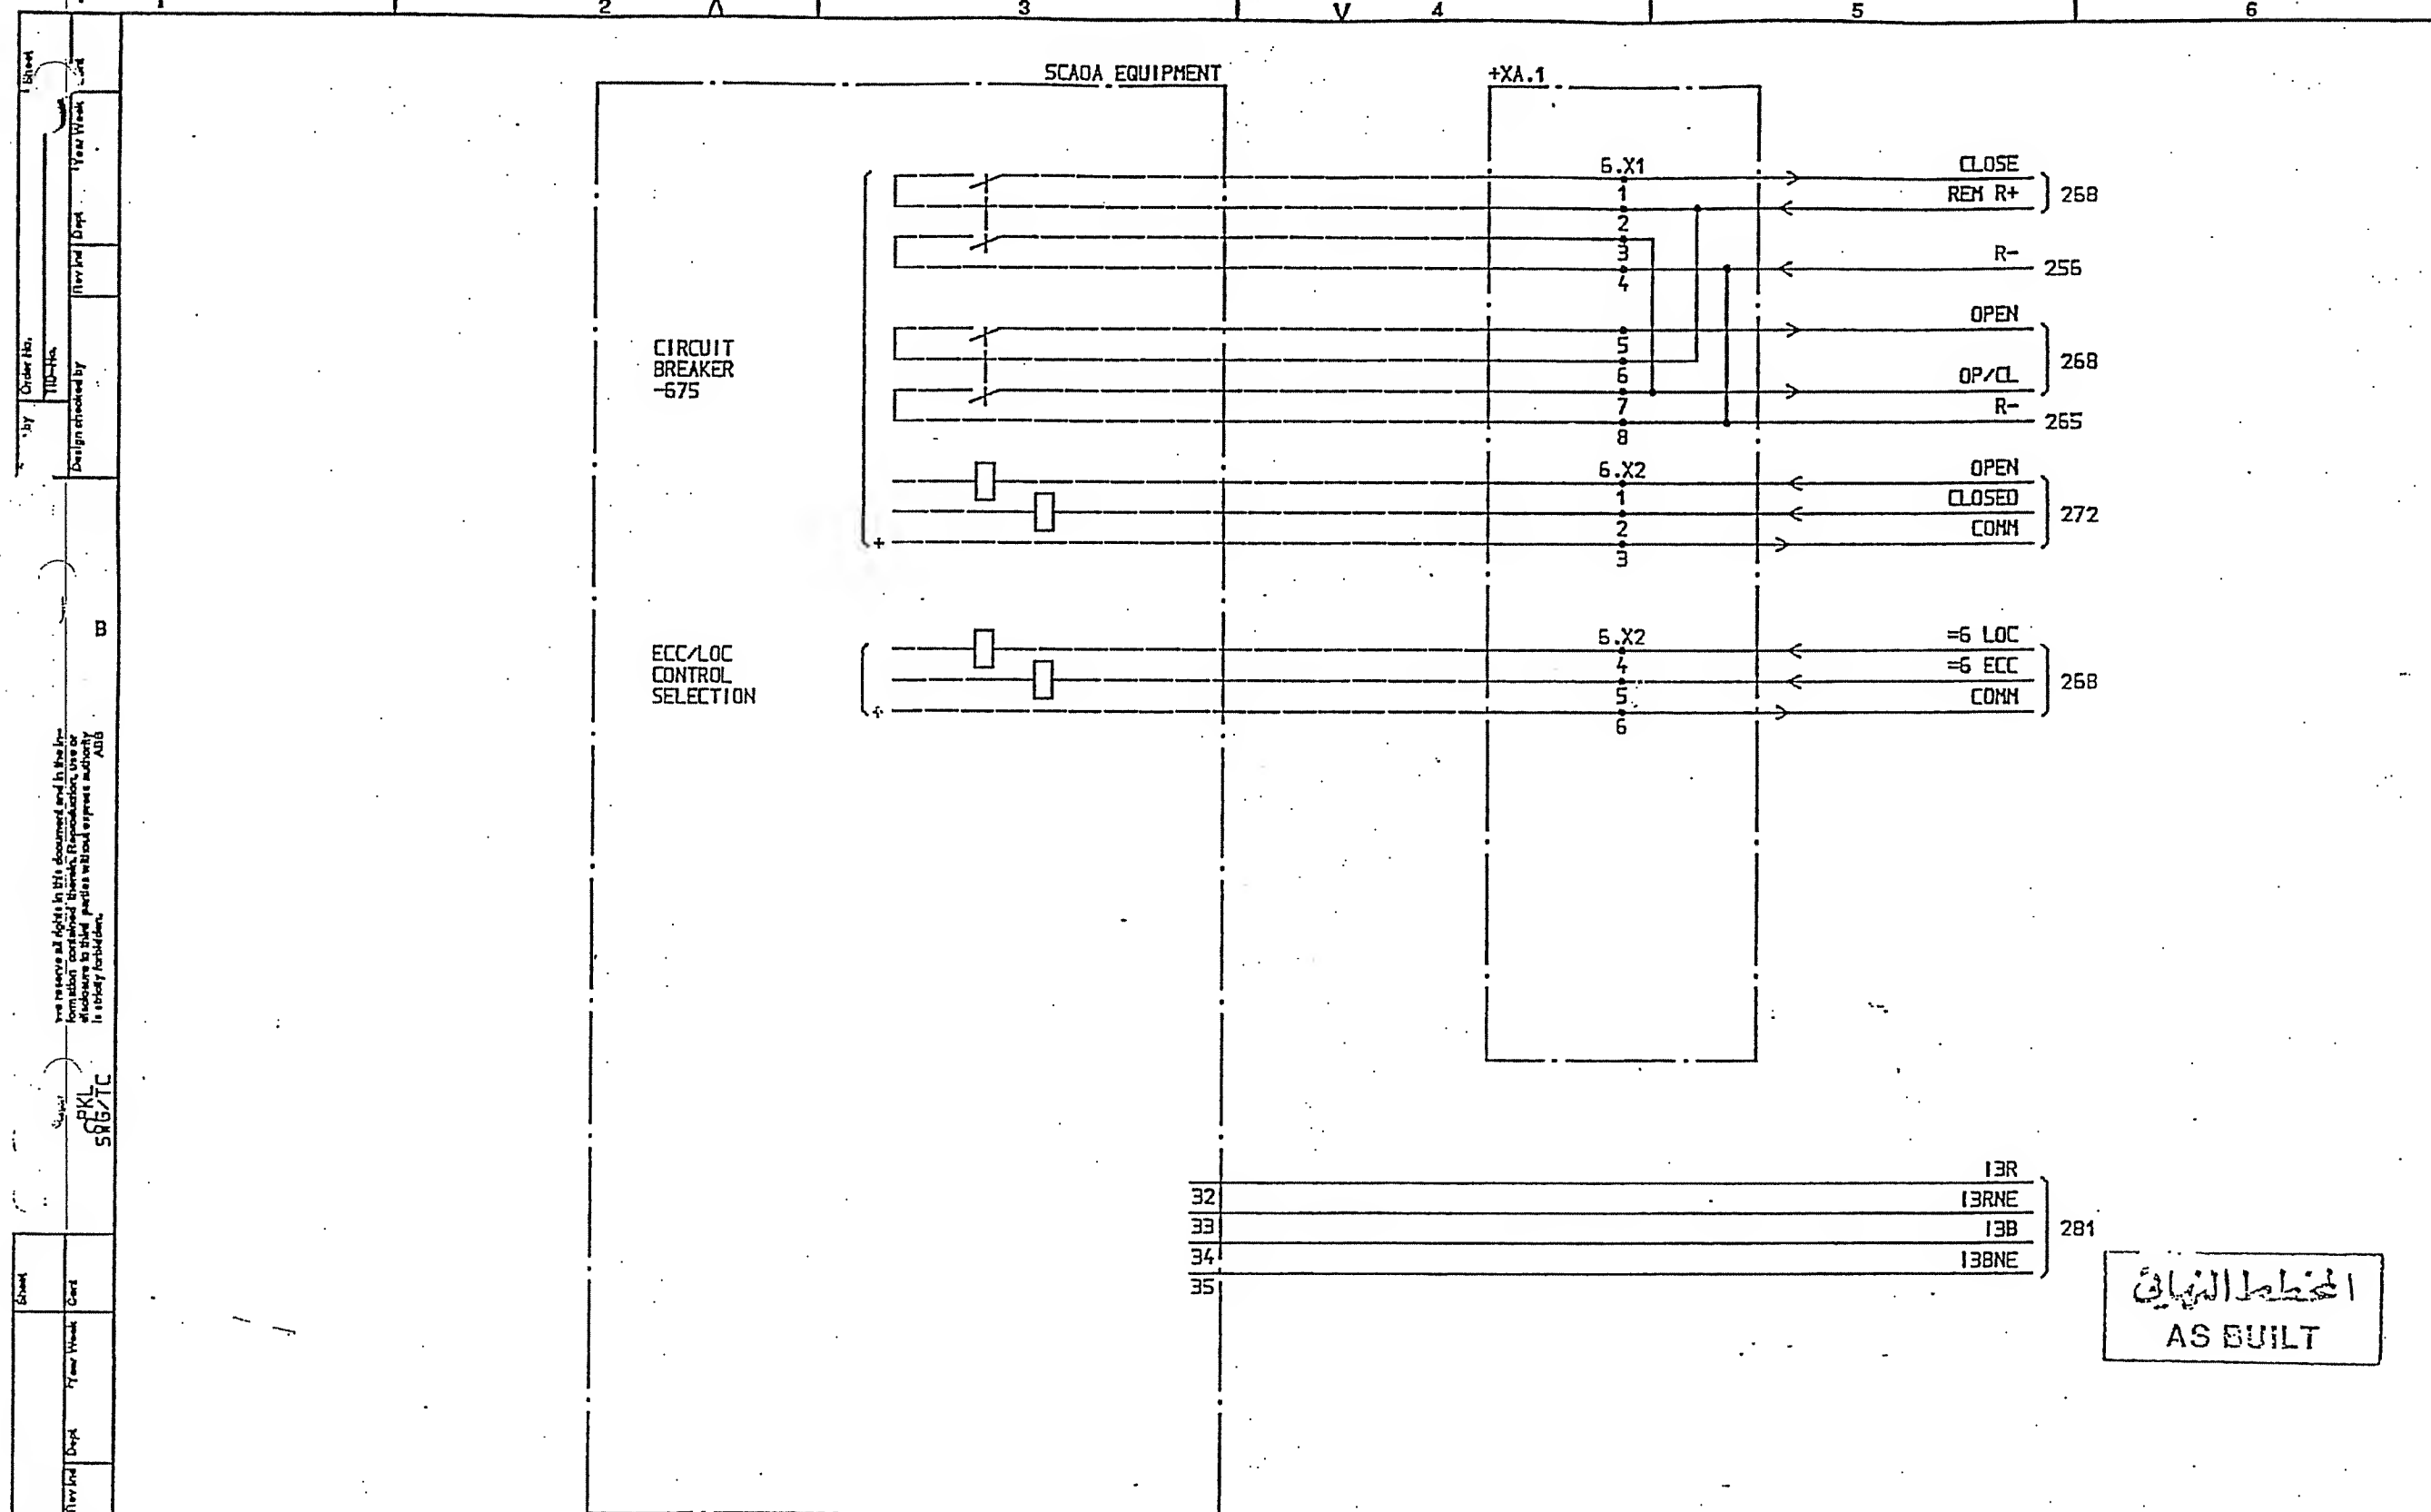ABB



| | | | | | | | | | | | |
|---------------------------------|--|--------------------------|--|-----------------------------------|--|-------------------|--|----------------------------|--|----------------|--|
| SYMBOL ID /D:XL824028-FBR:262/0 | | DATE 91-05-04 09.07 | | Design checked by B NILSSON | | CIRCUIT DIAGRAM | | Drawn by IA | | L 9743.1017 | |
| =6 | | 33kV INTERCONNECTOR LINE | | Drawing checked by S STRIDSMAN | | S/S 8501 132/33kV | | SCECO CENTRAL SAUDI ARABIA | | XL 824 028-FBR | |
| AS BUILT | | LS 91 21 | | SCAOA INTERFACE EQUIPMENT | | ABB HV SWITCHGEAR | | TGF 90 10 | | 1 | |
| 1 | | 2 | | 3 | | 4 | | 5 | | 6 | |

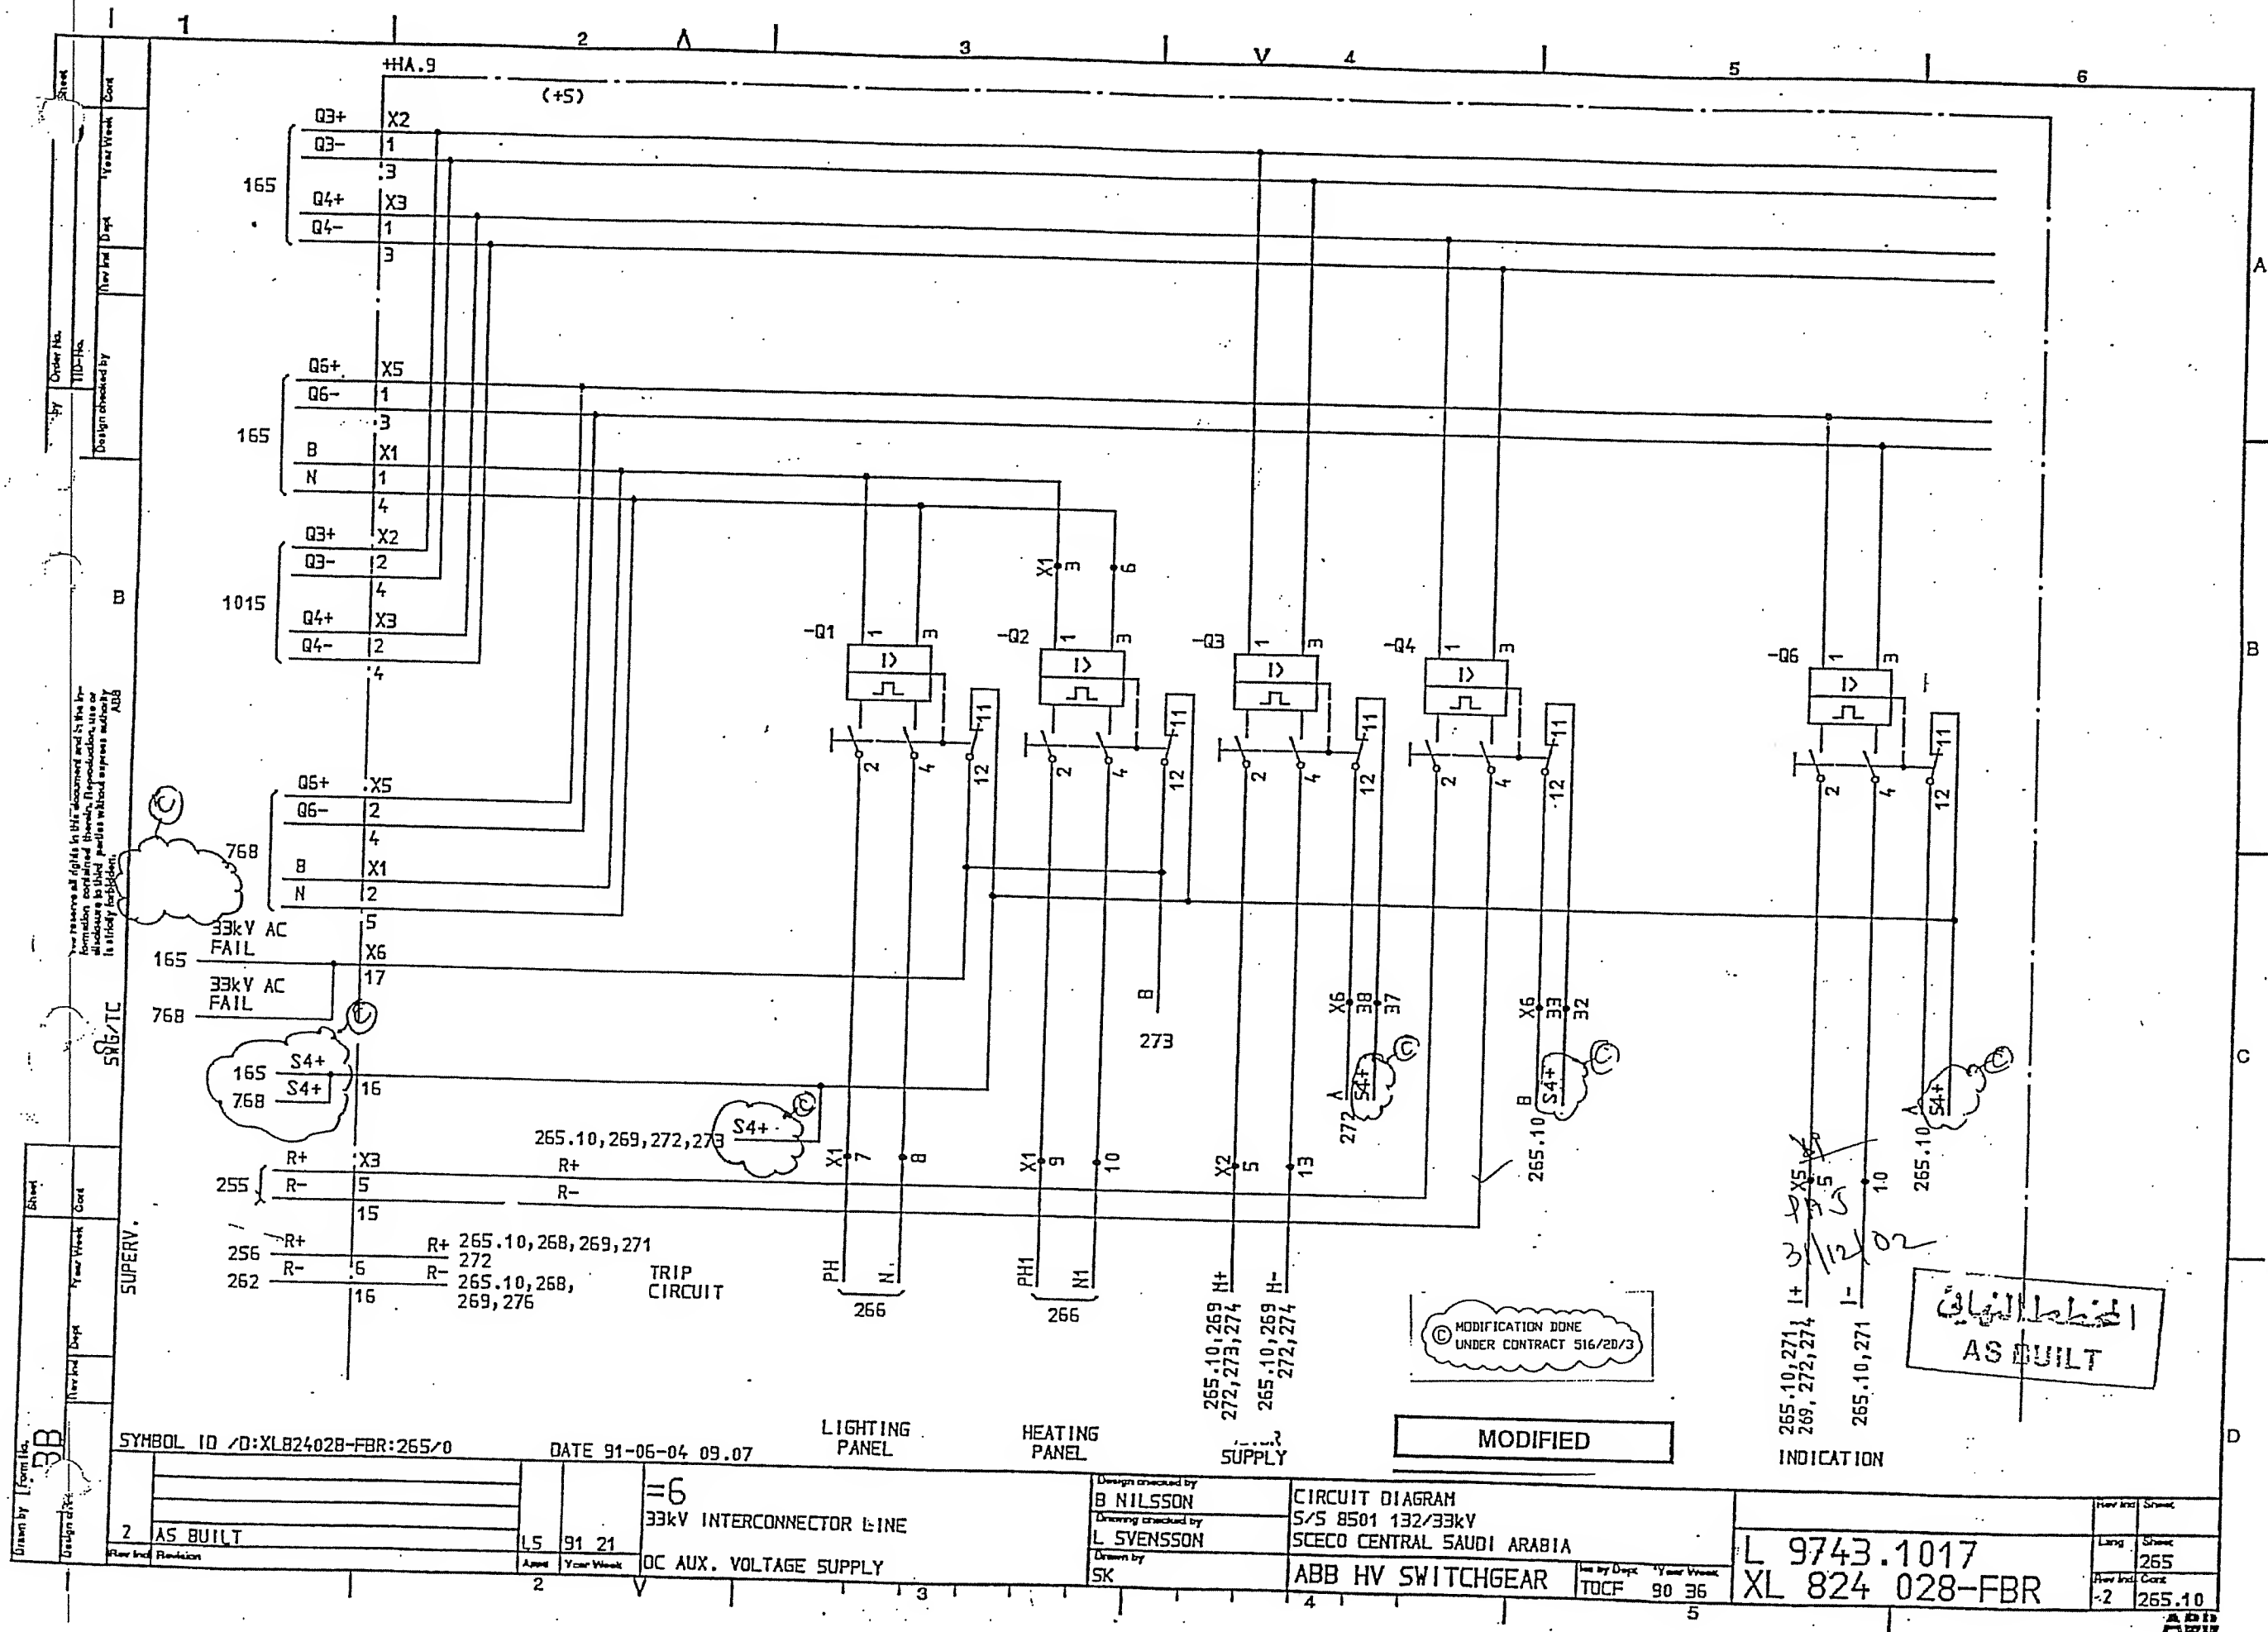

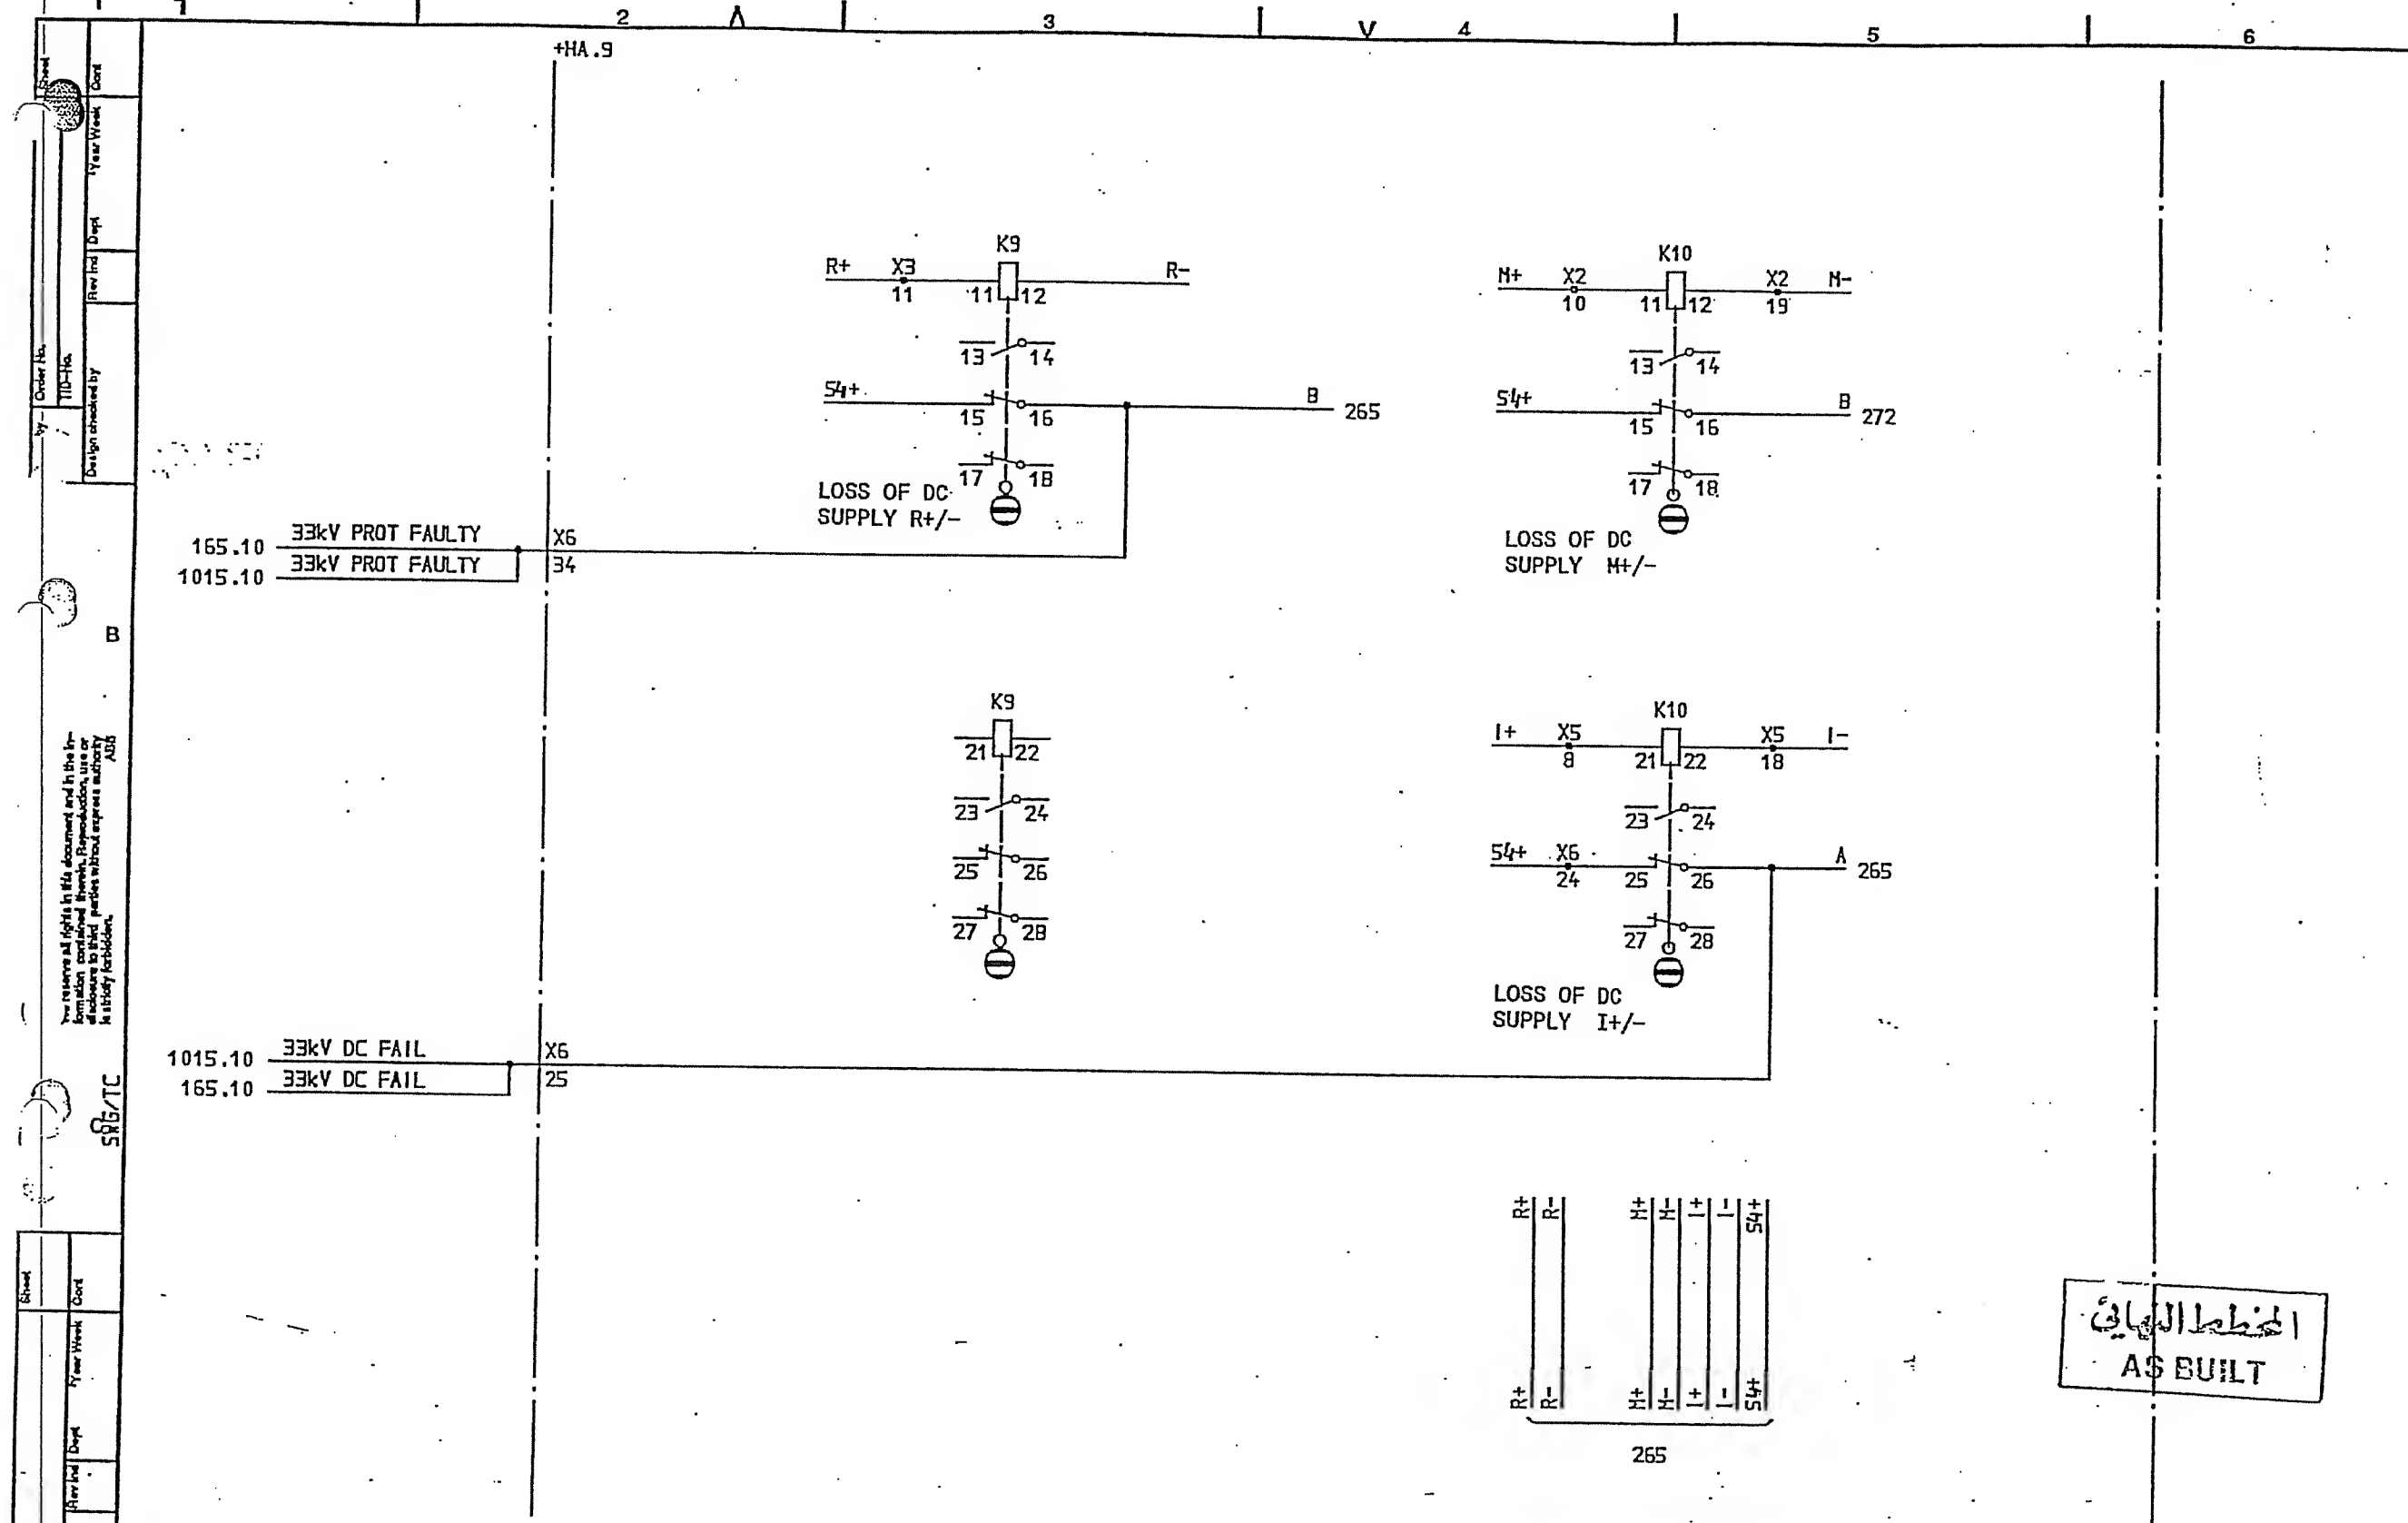


المخطط النهائي
AS BUILT

SYMBOL ID /D:XL824028-FBR:265.10/0 DATE 91-06-04 09.07

| | | | | | | | | | | | |
|--------------------------|--|------------------------|--|-----------------|--|-------------------|--|----------------------------|--|-------------|--|
| 1 | | 2 | | 3 | | 4 | | 5 | | 6 | |
| AS BUILT | | LS | | 91 21 | | SK | | 5K | | TOCF | |
| 33kV INTERCONNECTOR LINE | | DC AUX. VOLTAGE SUPPLY | | CIRCUIT DIAGRAM | | S/5 8501 132/33kV | | SCECO CENTRAL SAUDI ARABIA | | L 9743.1017 | |
| XL 824 028-FBR | | 265.10 | | 1 | | 265 | | 1 | | 265 | |

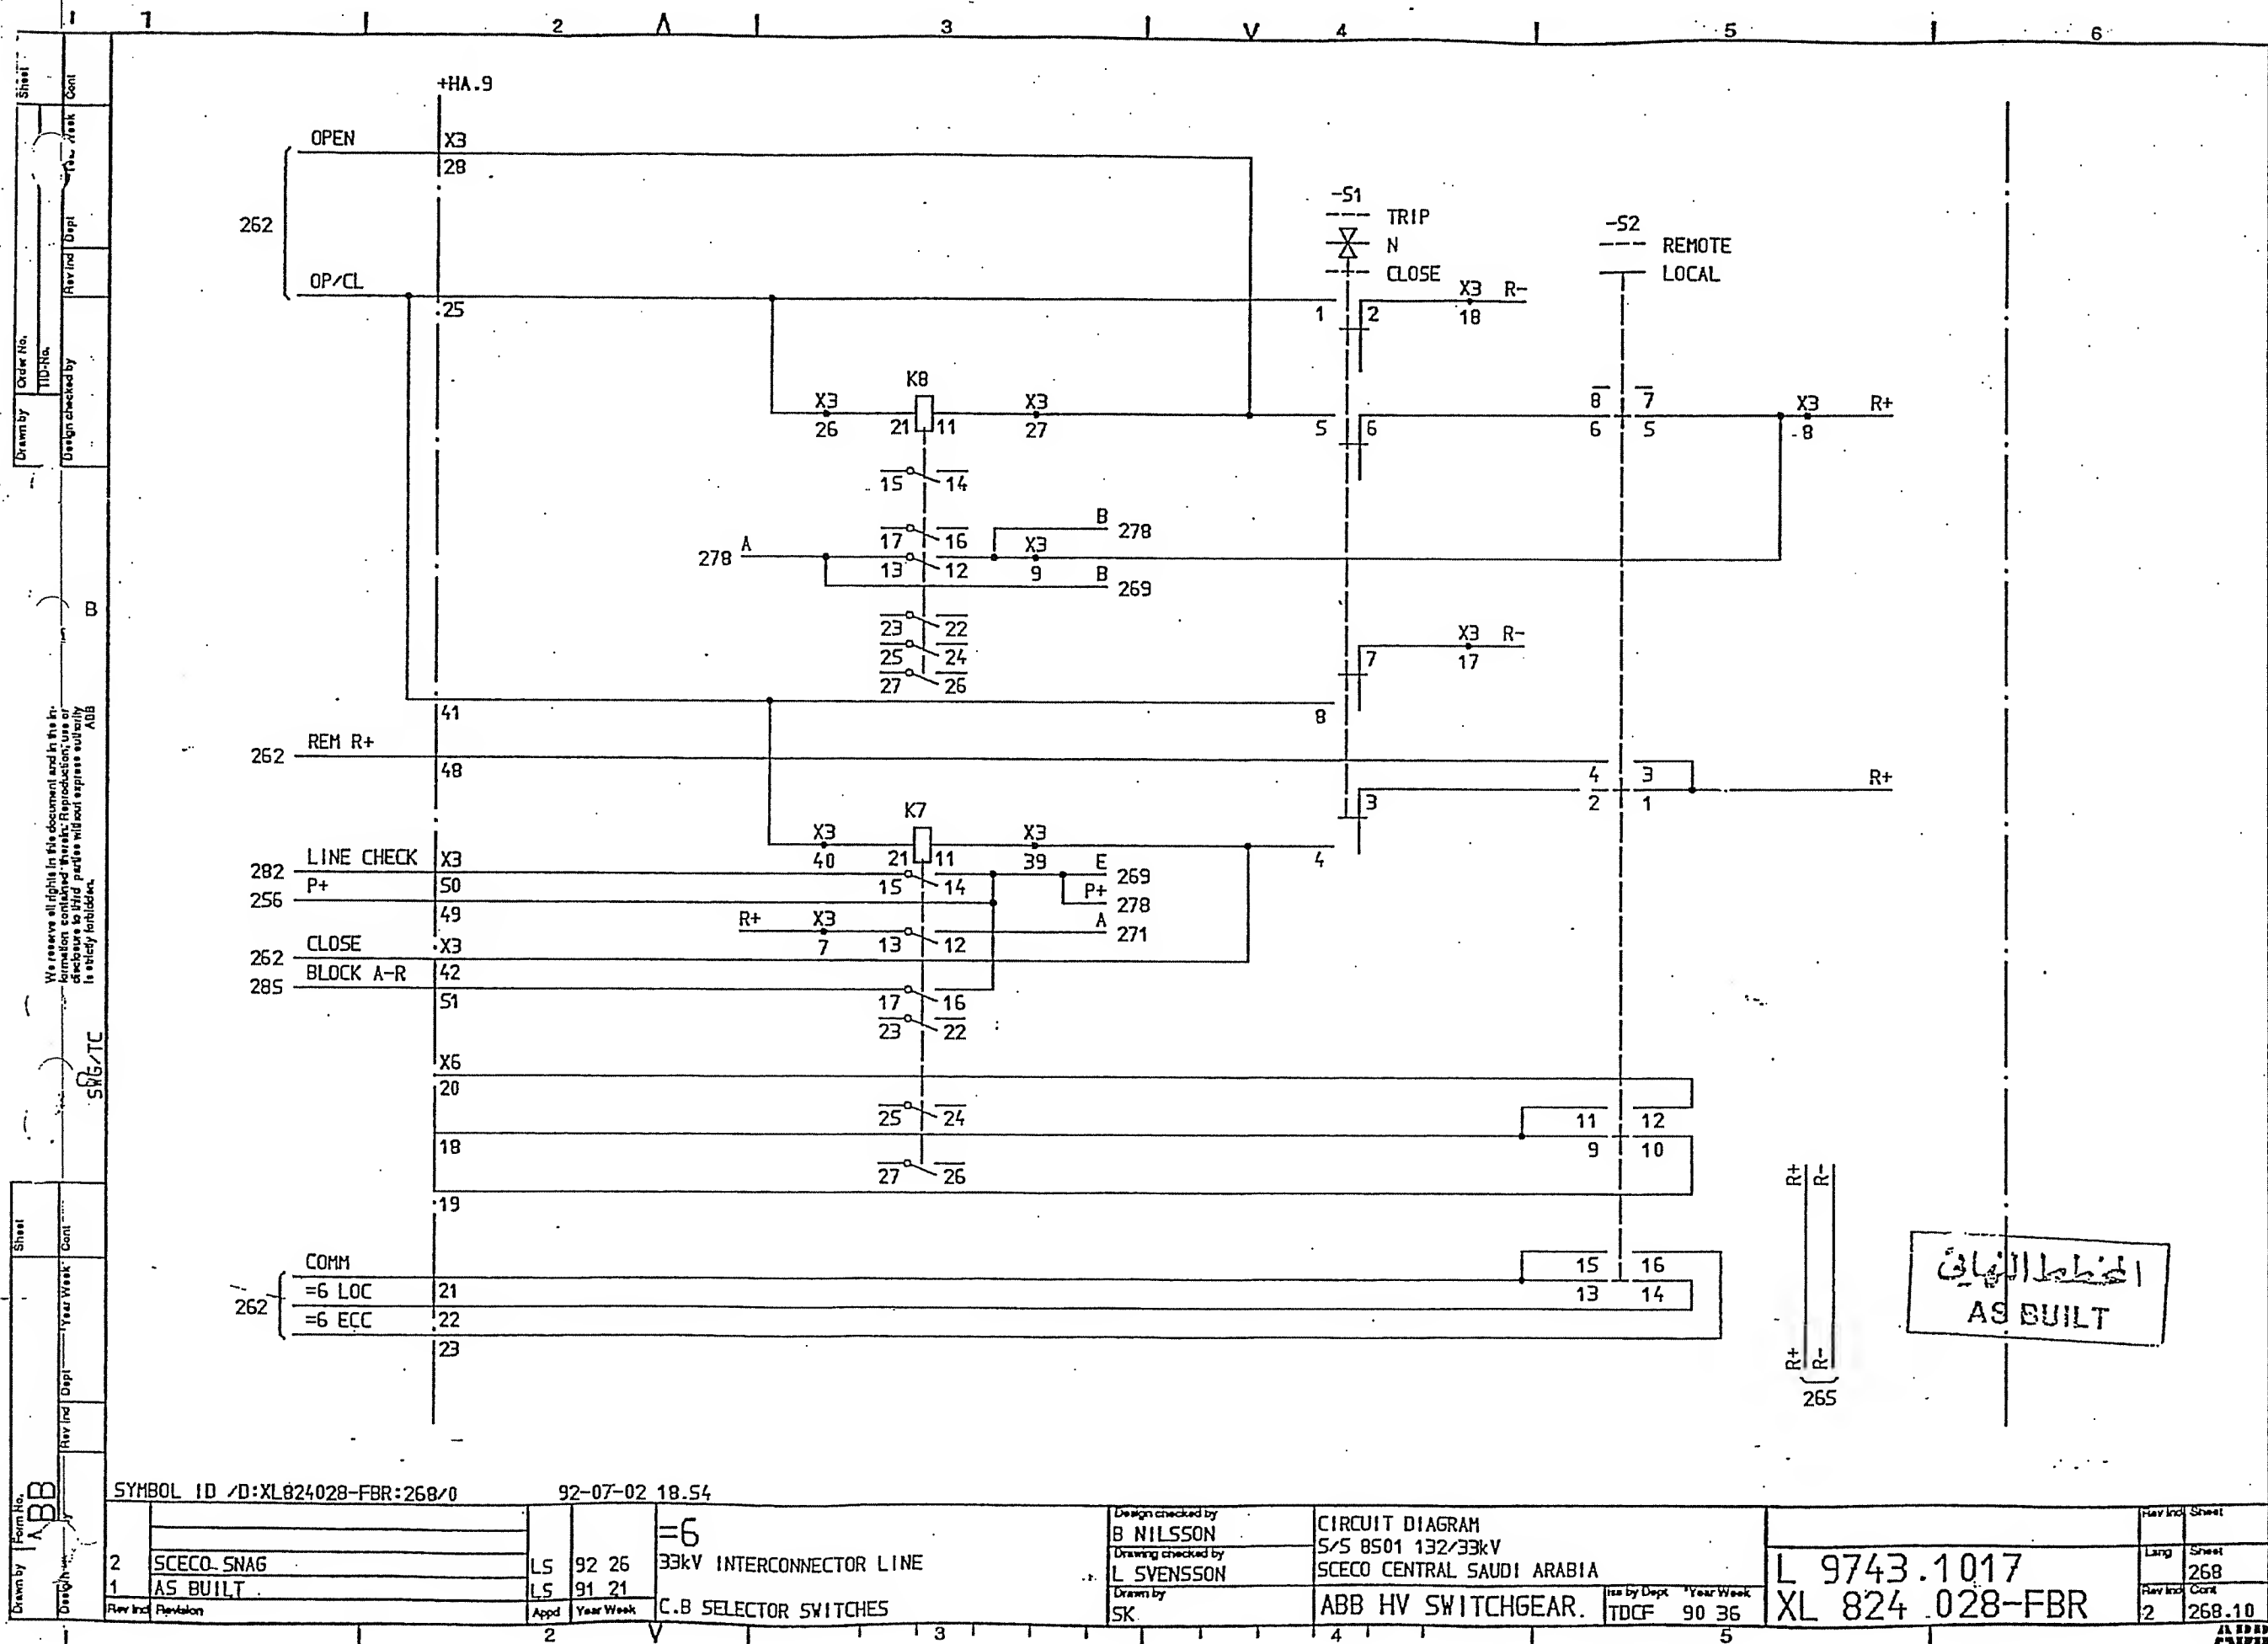ABB



SYMBOL ID /D:XL824028-FBR:268/0

92-07-02 18.54

| | | | | | |
|-----|------------|----------|-------|-----------|--------------------------|
| 2 | SCECO SNAG | LS | 92 26 | =6 | 33kV INTERCONNECTOR LINE |
| 1 | AS BUILT | LS | 91 21 | | |
| Rev | Inc | Revision | Appd | Year Week | C.B SELECTOR SWITCHES |


Design checked by
B NILSSON
Drawing checked by
L SVENSSON
Drawn by
SK

CIRCUIT DIAGRAM
S/S 8501 132/33kV
SCECO CENTRAL SAUDI ARABIA
ABB HV SWITCHGEAR.

Iss by Dept Year Week
TDCF 90 36

L 9743.1017
XL 824 028-FBR

| | | |
|------|-------|--------|
| Rev | Inc | Sheet |
| Lang | Sheet | 268 |
| Rev | Inc | Cont |
| 2 | | 268.10 |

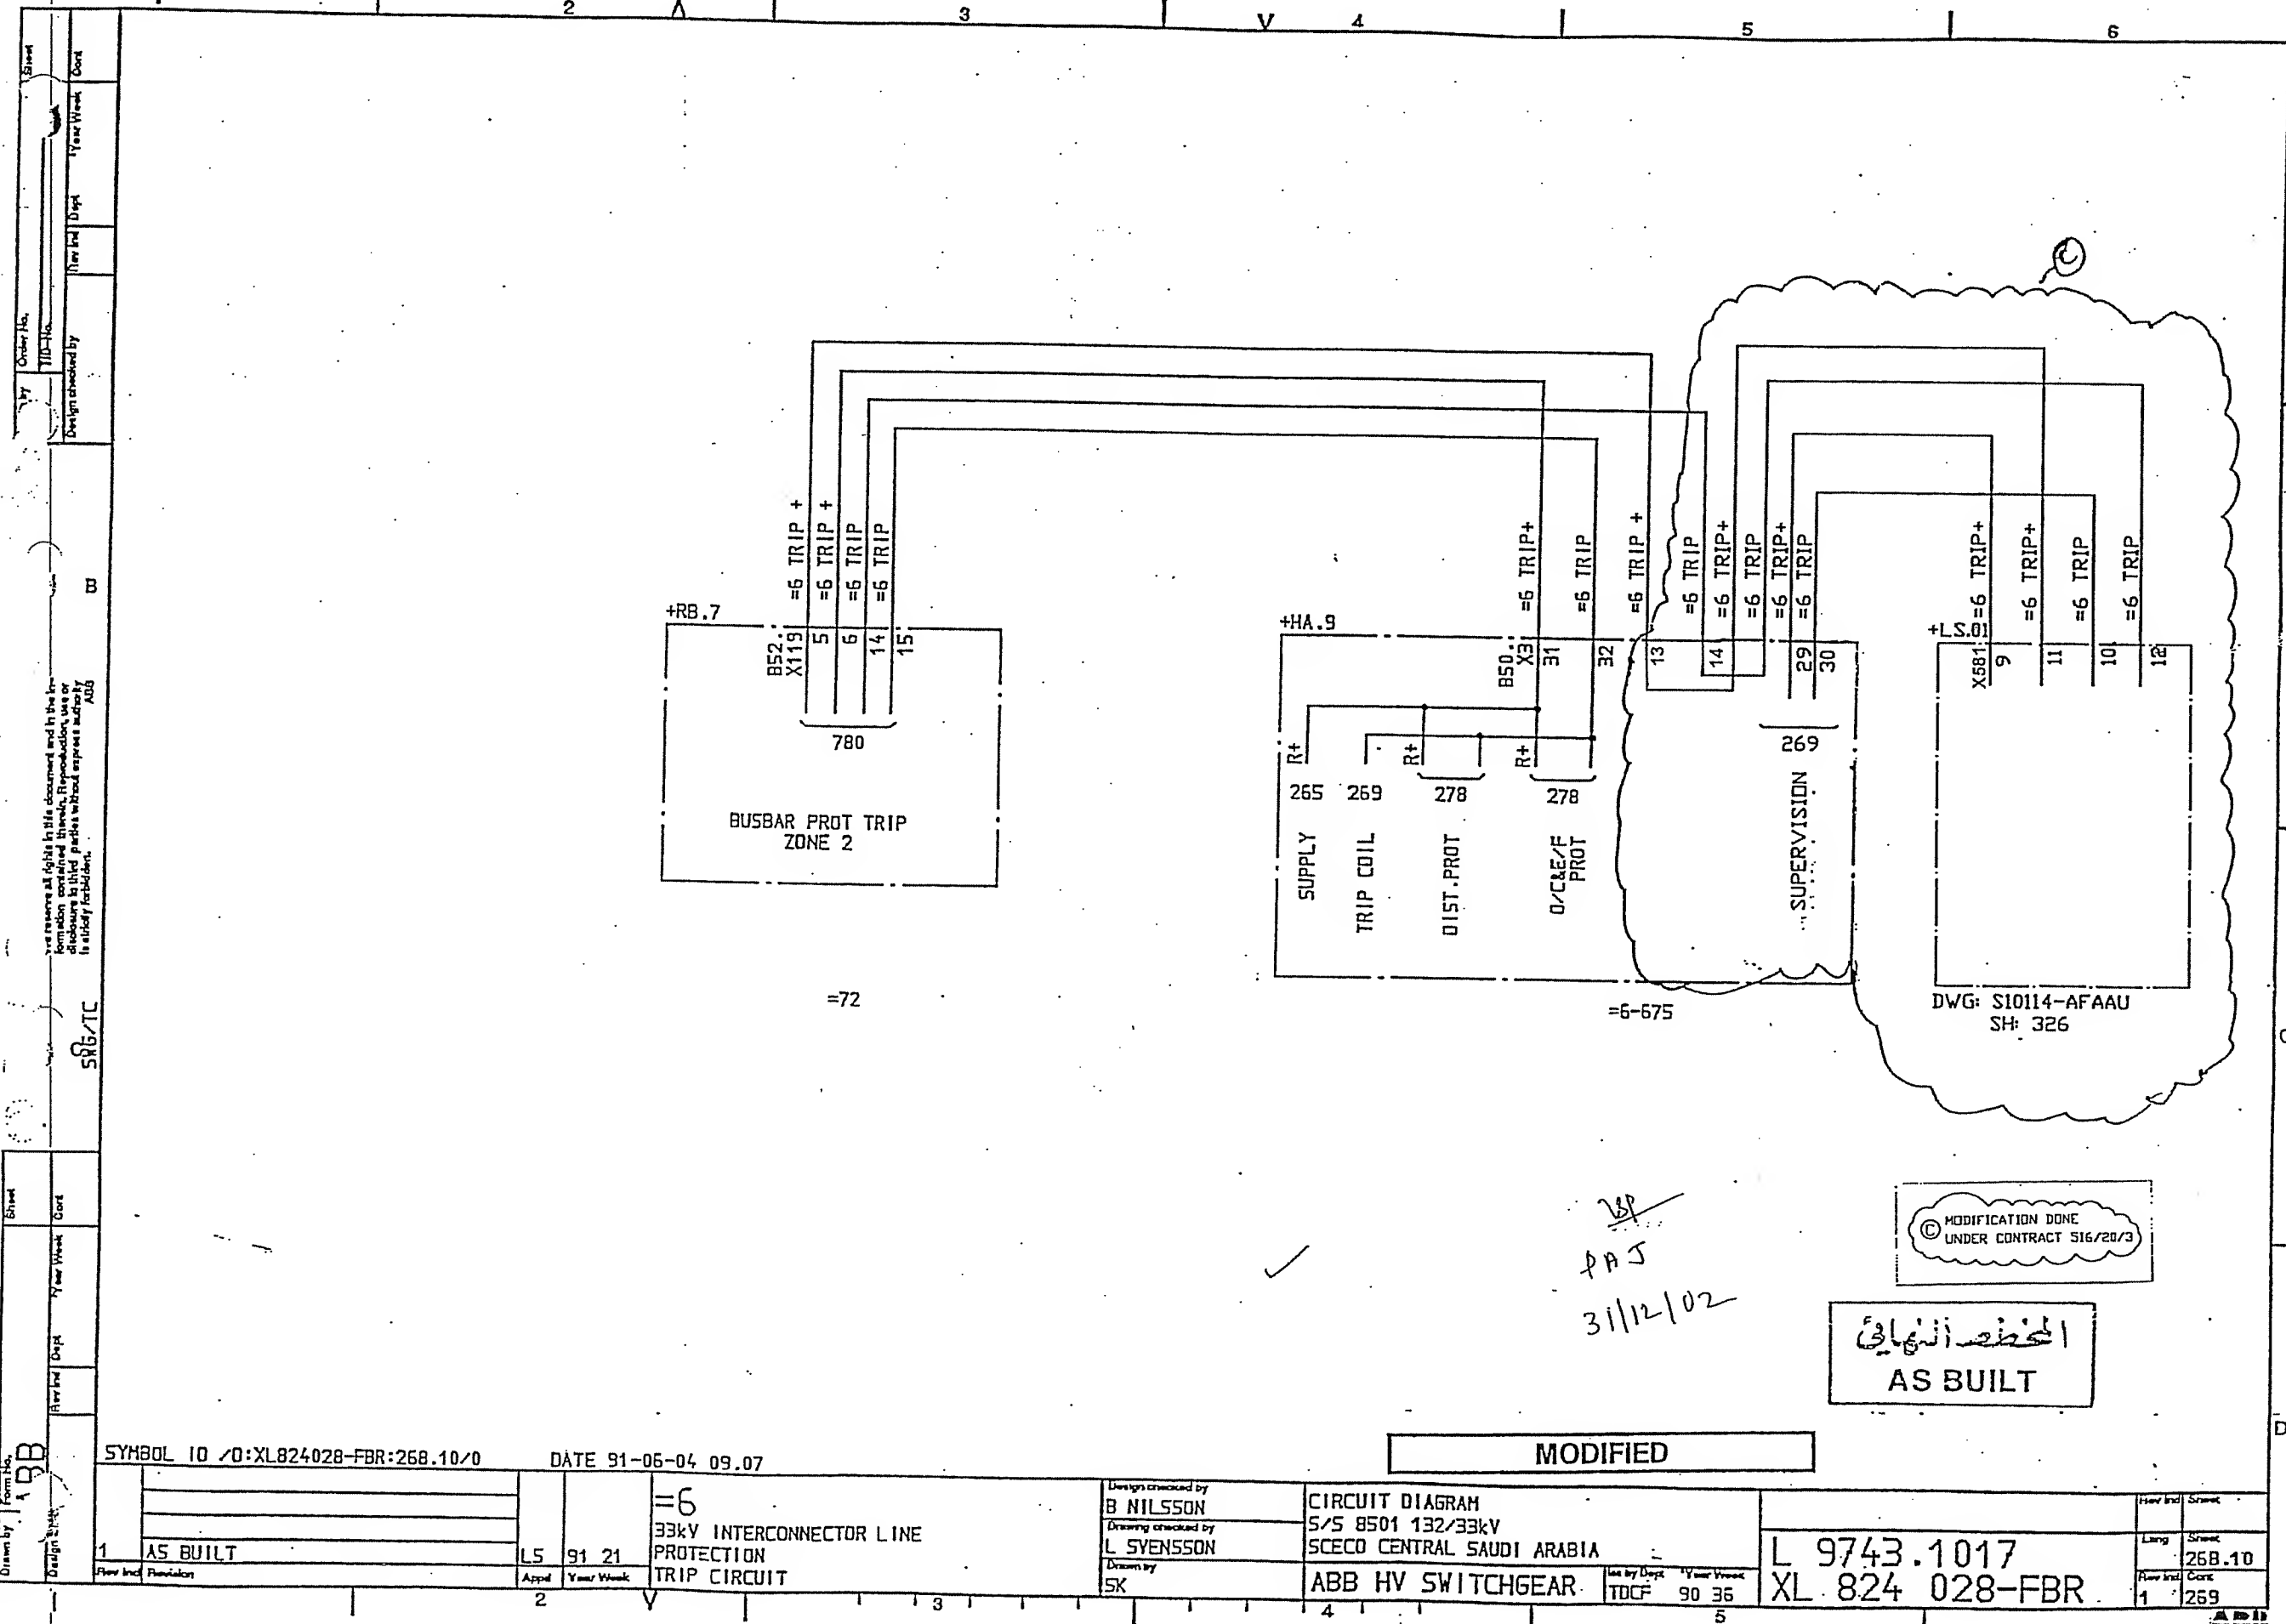

MODIFICATION DONE
UNDER CONTRACT 516/20/3


المخطط النهائي
AS BUILT

MODIFIED

SYMBOL ID /D:XL824028-FBR:268.10/0 DATE 91-06-04 09.07

| | | | | | | | | | | | | | | | | | | | |
|----------|--|----|--|-------|--|------------|--|--------------------------|--|--------------------|--|----------------------------|--|----------------|--|--------|--|-------|--|
| 1 | | L5 | | 91 21 | | =6 | | 33kV INTERCONNECTOR LINE | | DESIGN CHECKED BY | | CIRCUIT DIAGRAM | | L 9743.1017 | | Liang | | Sheet | |
| AS BUILT | | | | | | PROTECTION | | TRIP CIRCUIT | | B NILSSON | | S/S 8501 132/33kV | | XL 824 028-FBR | | 268.10 | | | |
| | | | | | | | | | | DRAWING CHECKED BY | | SCECO CENTRAL SAUDI ARABIA | | | | | | | |
| | | | | | | | | | | DESIGNED BY | | ABB HV SWITCHGEAR | | | | | | | |
| | | | | | | | | | | TDCF | | 90 36 | | | | | | | |

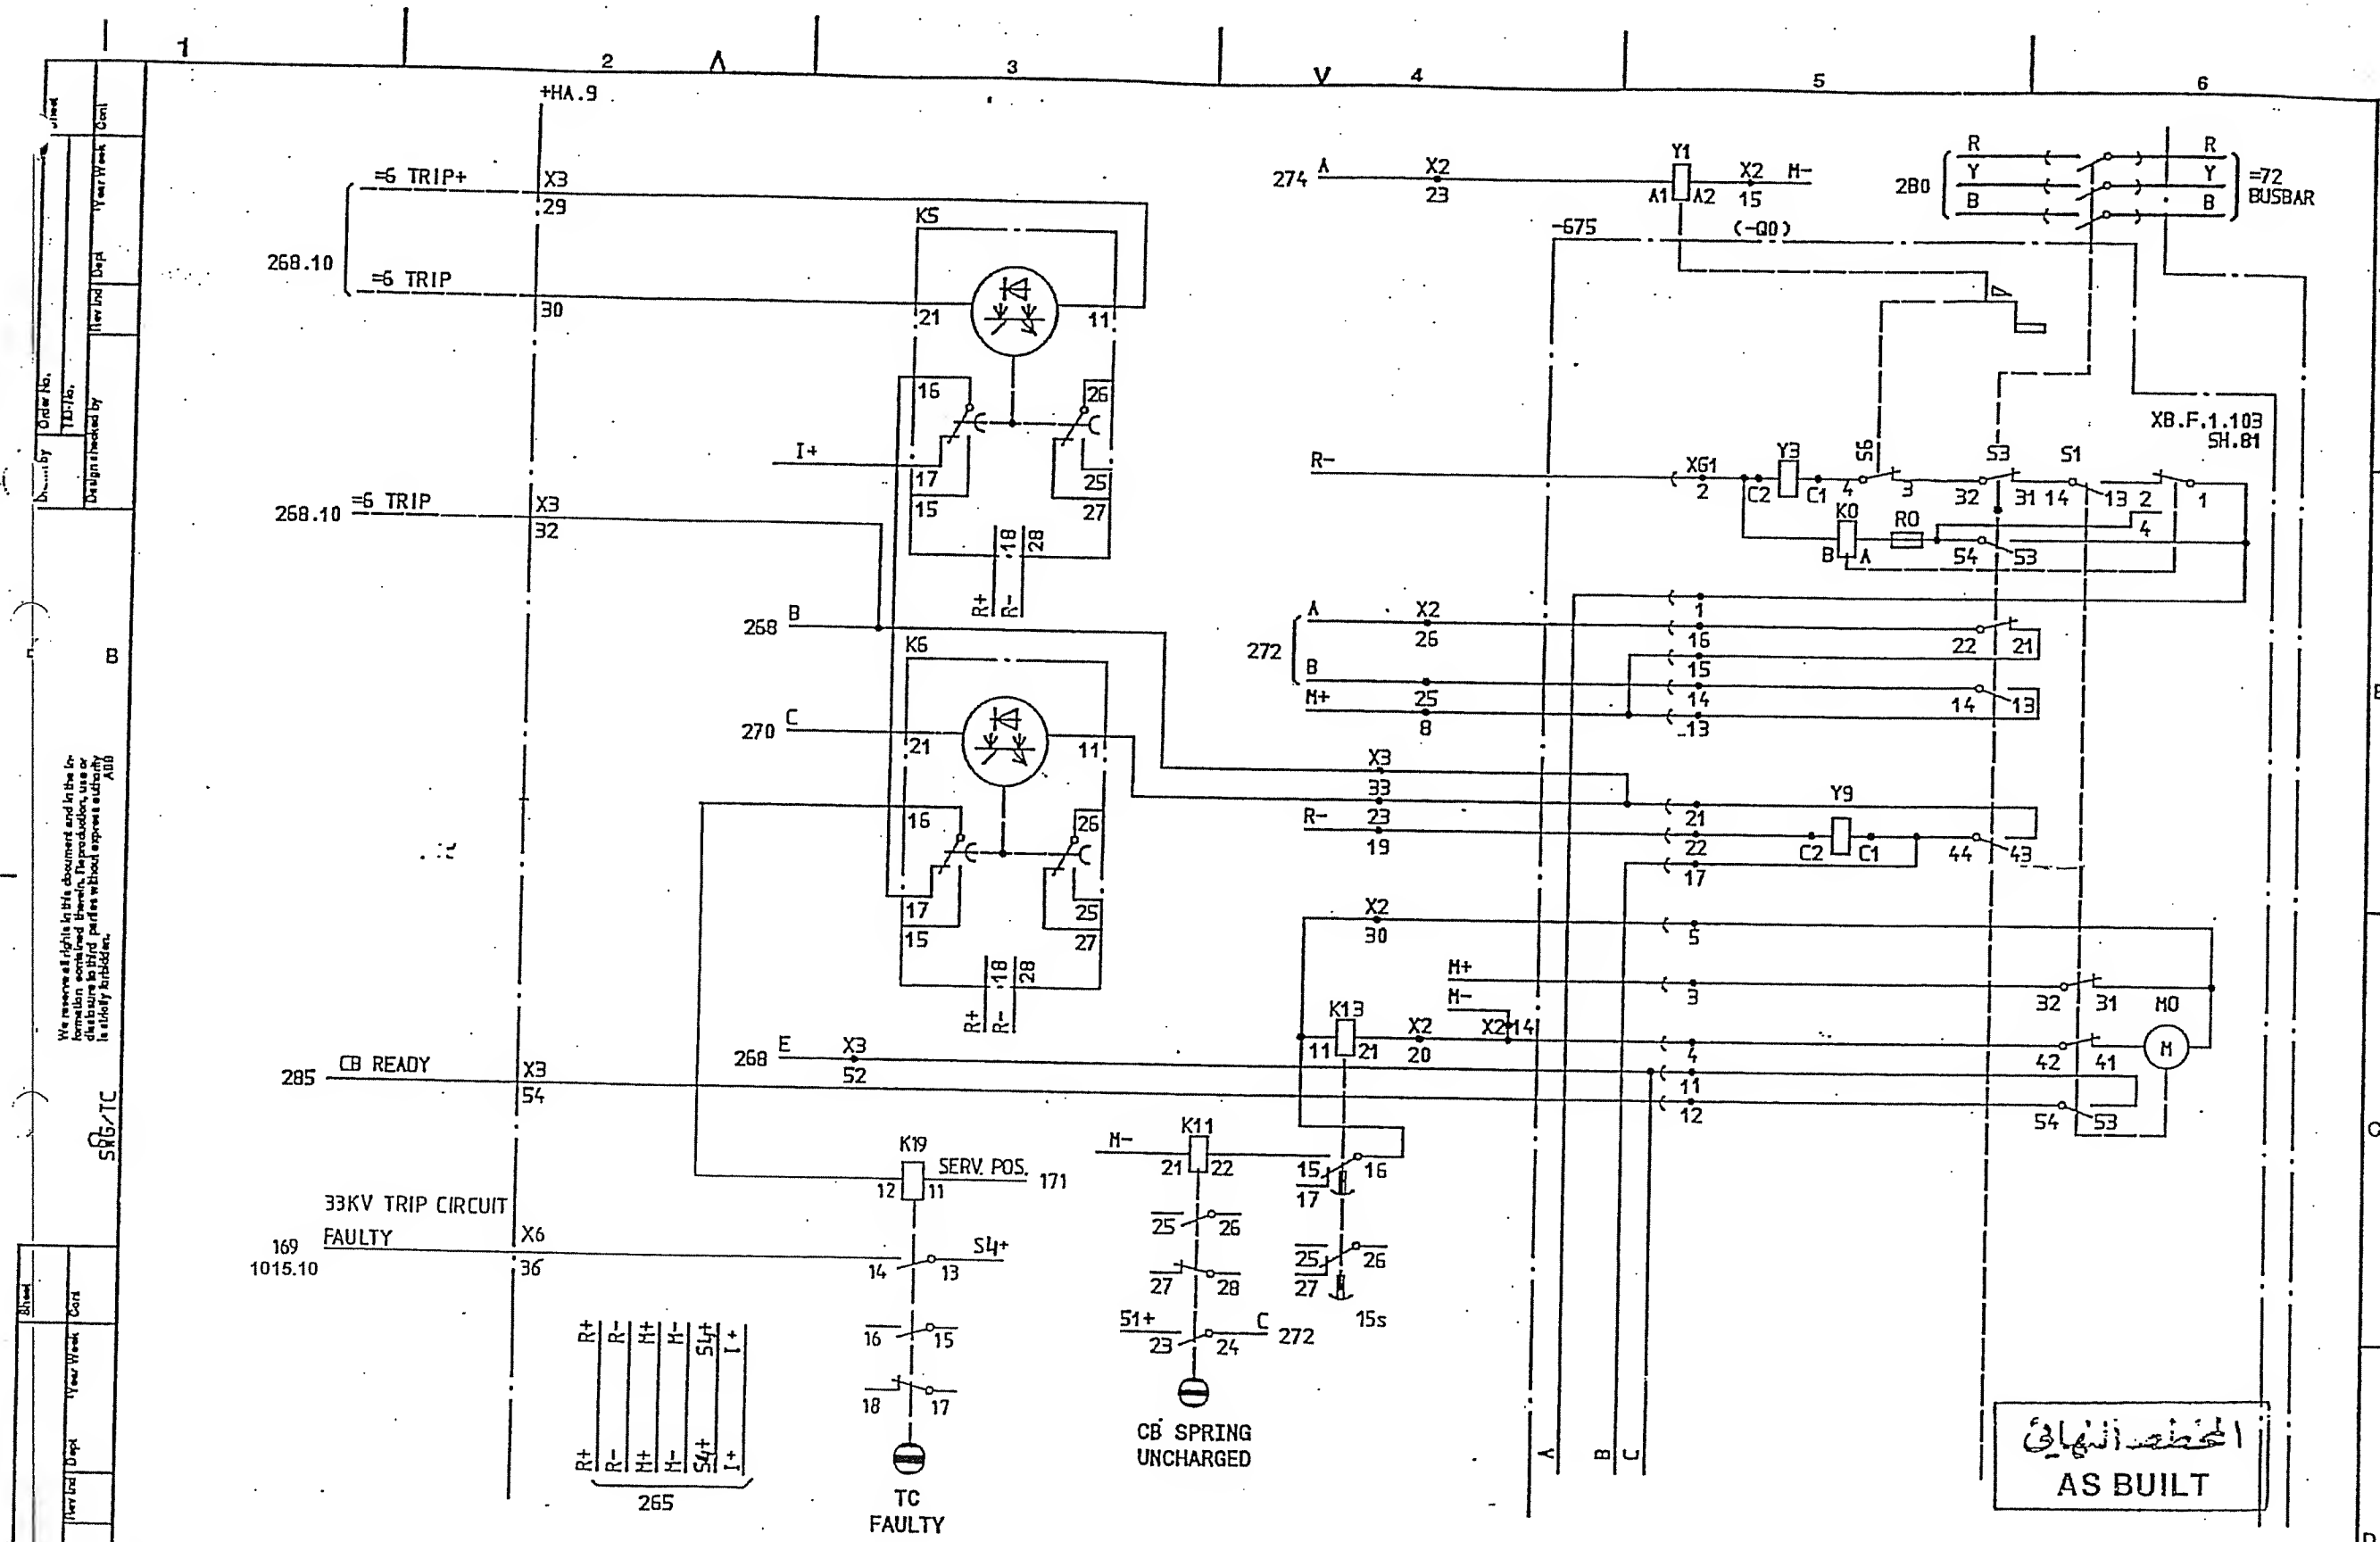ABB




المخطط النهائي
AS BUILT

SYMBOL ID: XL824028-FBR:269/0 92-09-09 07.33

| | | | | | |
|-----|------------|------|-----------|----|--------------------------------|
| 2.1 | SCECO SHAG | LS | 92 26 | =6 | 33kV INTERCONNECTOR LINE |
| 1 | AS BUILT | LS | 91 21 | | |
| Rev | Issued | Appd | Year Week | | |
| 2 | | | | | CIRCUIT BREAKER EQUIPMENT -675 |

| | | | |
|-------------|------------|-----------------|----------------------------|
| Designed by | B NILSSON | Circuit diagram | S/S 8501 132/33kV |
| Drawn by | L SVENSSON | | SCECO CENTRAL SAUDI ARABIA |
| Checked by | SK | | ABB HV SWITCHGEAR |
| Issued by | TDCE | 90 36 | |



| | | |
|----------------|-------|-----|
| L 9743.1017 | Long | 269 |
| XL 824 028-FBR | Short | 270 |

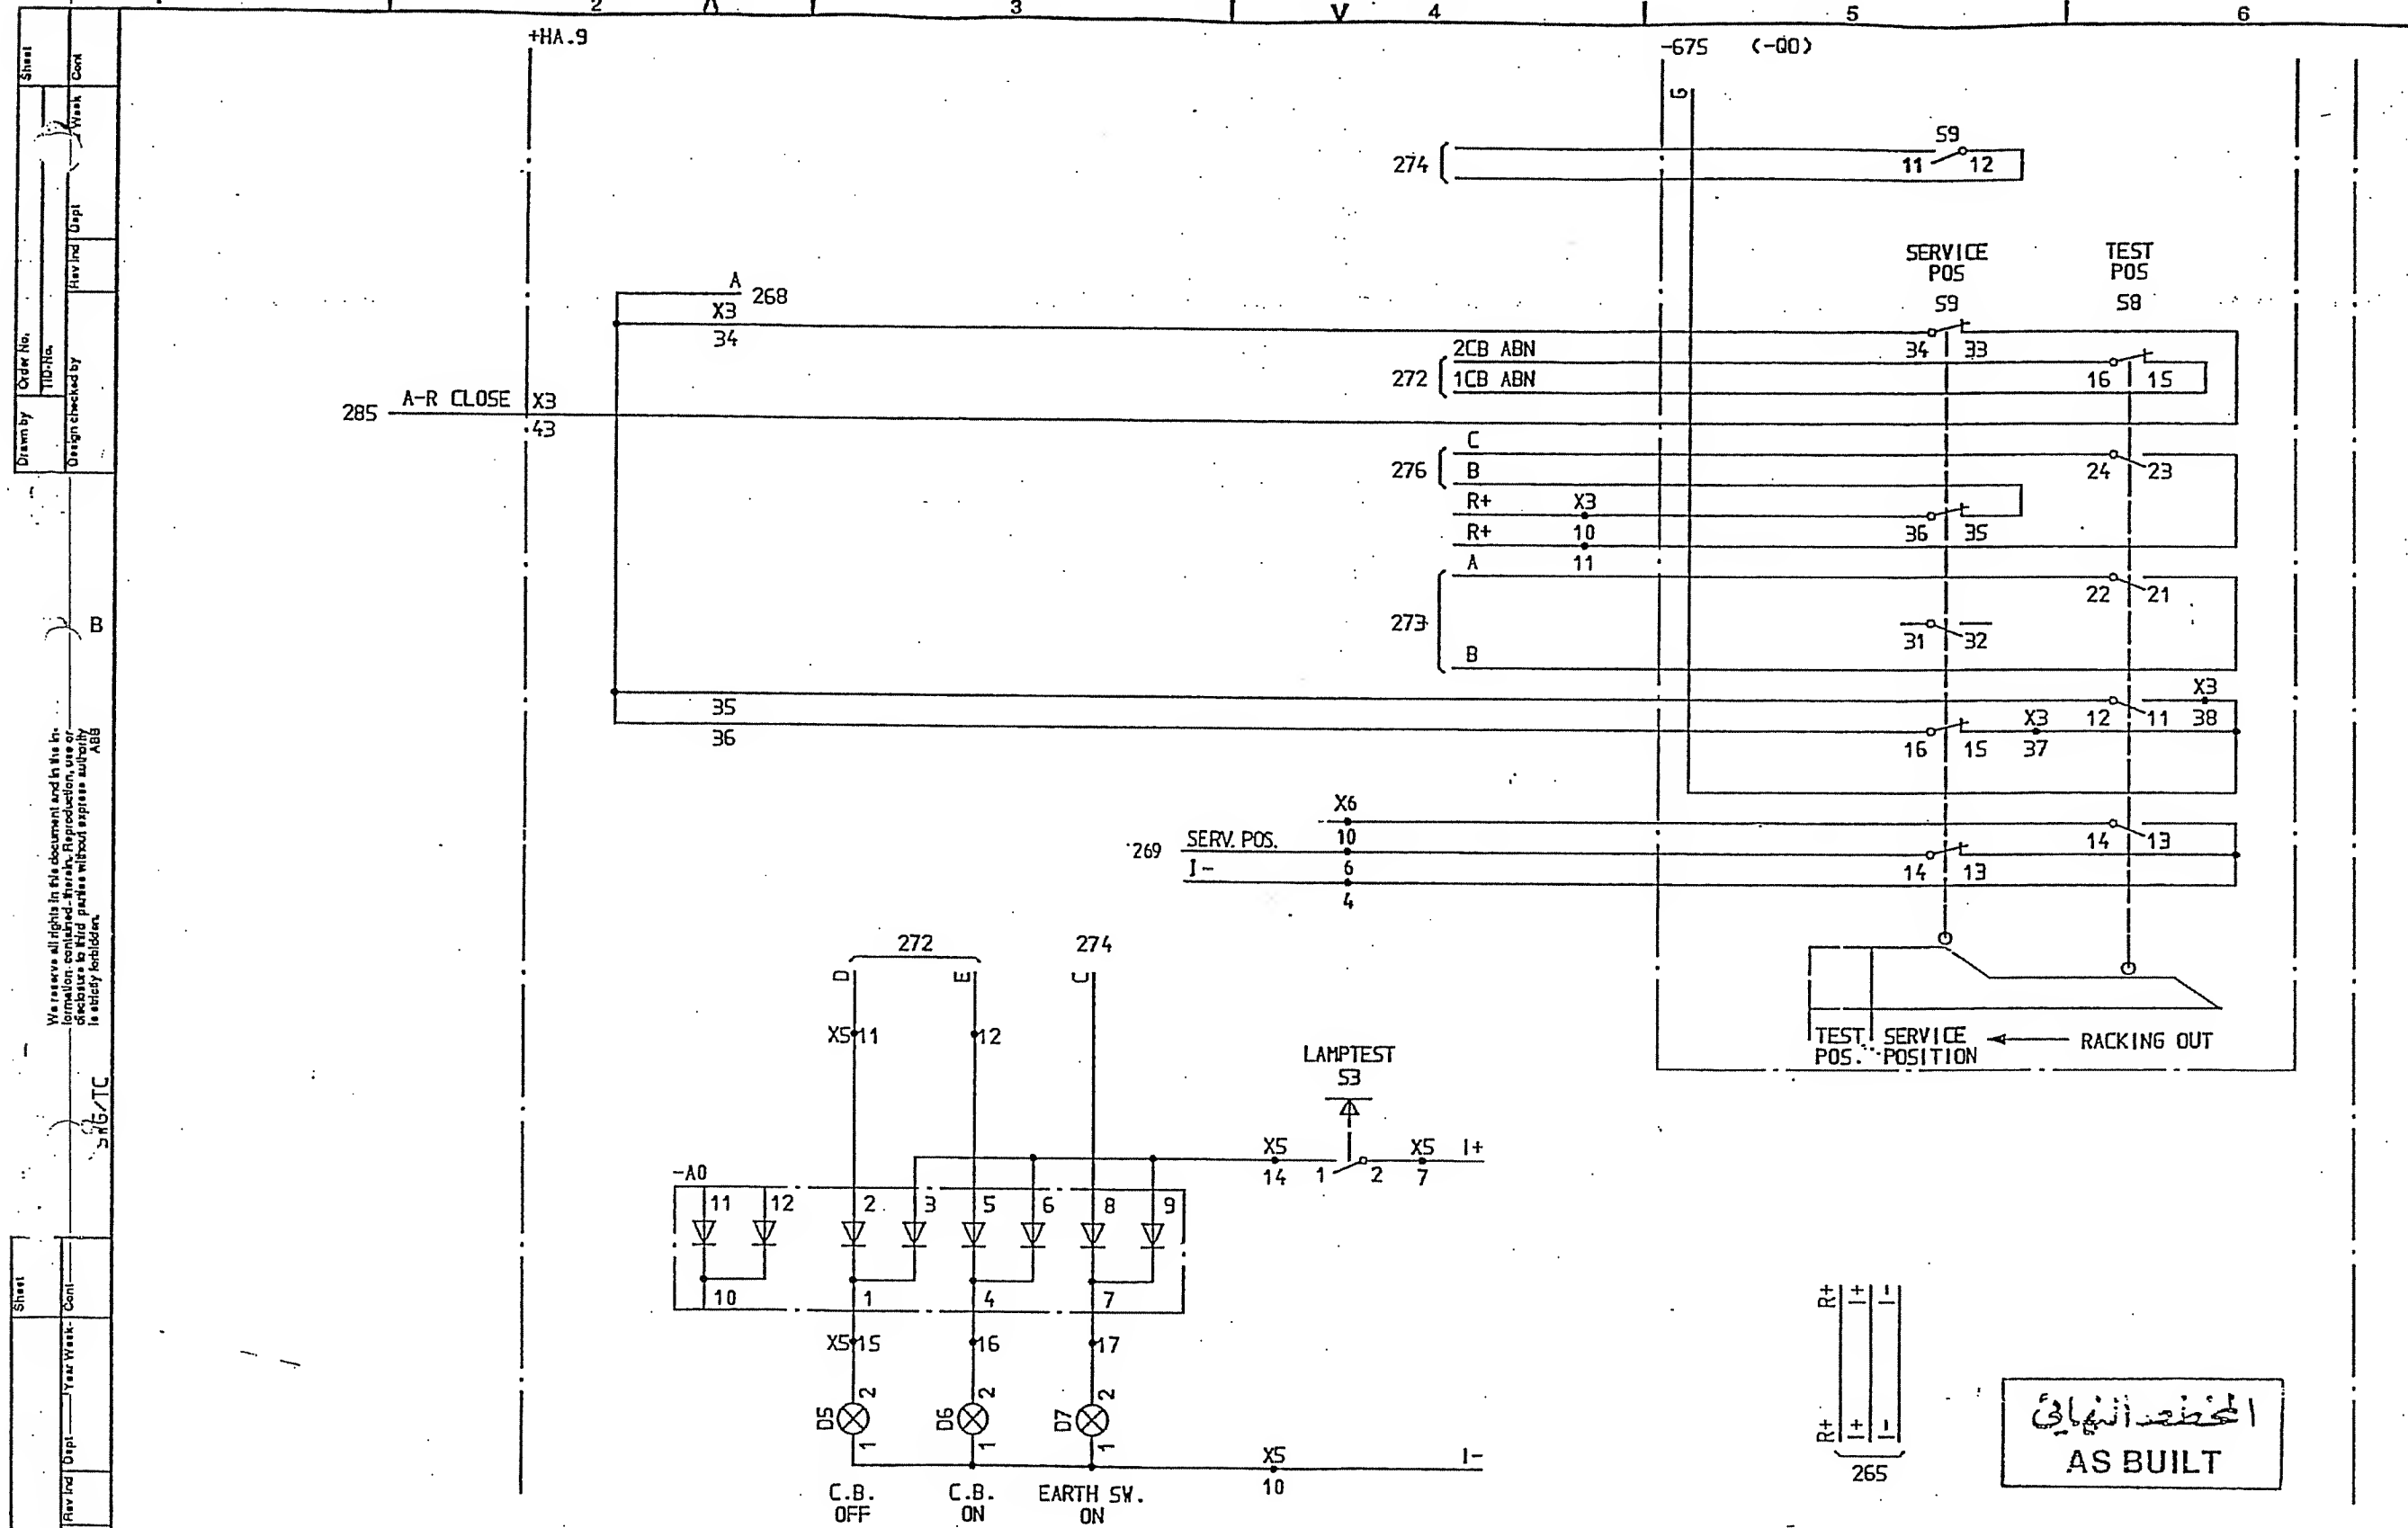

المخطط النهائي
AS BUILT

| | | | | | | | | | | | | | | | |
|---------------------------------|------------|----------------|-------|---------------|-------|--------------------------|-------|--------------------------------|-------|--|-------|-------------------------------|-------|---------------|-------|
| SYMBOL ID /D:XL824028-FBR:271/0 | | 92-07-02 1B.54 | | =6 | | 33kV INTERCONNECTOR LINE | | CIRCUIT BREAKER EQUIPMENT -675 | | CIRCUIT DIAGRAM S/S BS01 132/33kV SCECO CENTRAL SAUDI ARABIA | | L 9743.1017 XL 824 028-FBR | | Rev Ind Sheet | |
| 2.1 | SCECO SNAG | LS | 92 26 | LS | 91 21 | LS | 91 21 | LS | 91 21 | LS | 91 21 | LS | 91 21 | LS | 91 21 |
| 1 | AS BUILT | LS | 91 21 | LS | 91 21 | LS | 91 21 | LS | 91 21 | LS | 91 21 | LS | 91 21 | LS | 91 21 |
| Rev Ind Revision | | Appd YearWeek | | Appd YearWeek | | Appd YearWeek | | Appd YearWeek | | Appd YearWeek | | Appd YearWeek | | Appd YearWeek | |
| | | | | | | | | | | | | | | | |

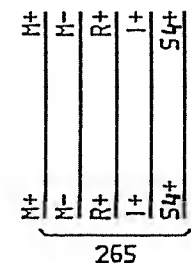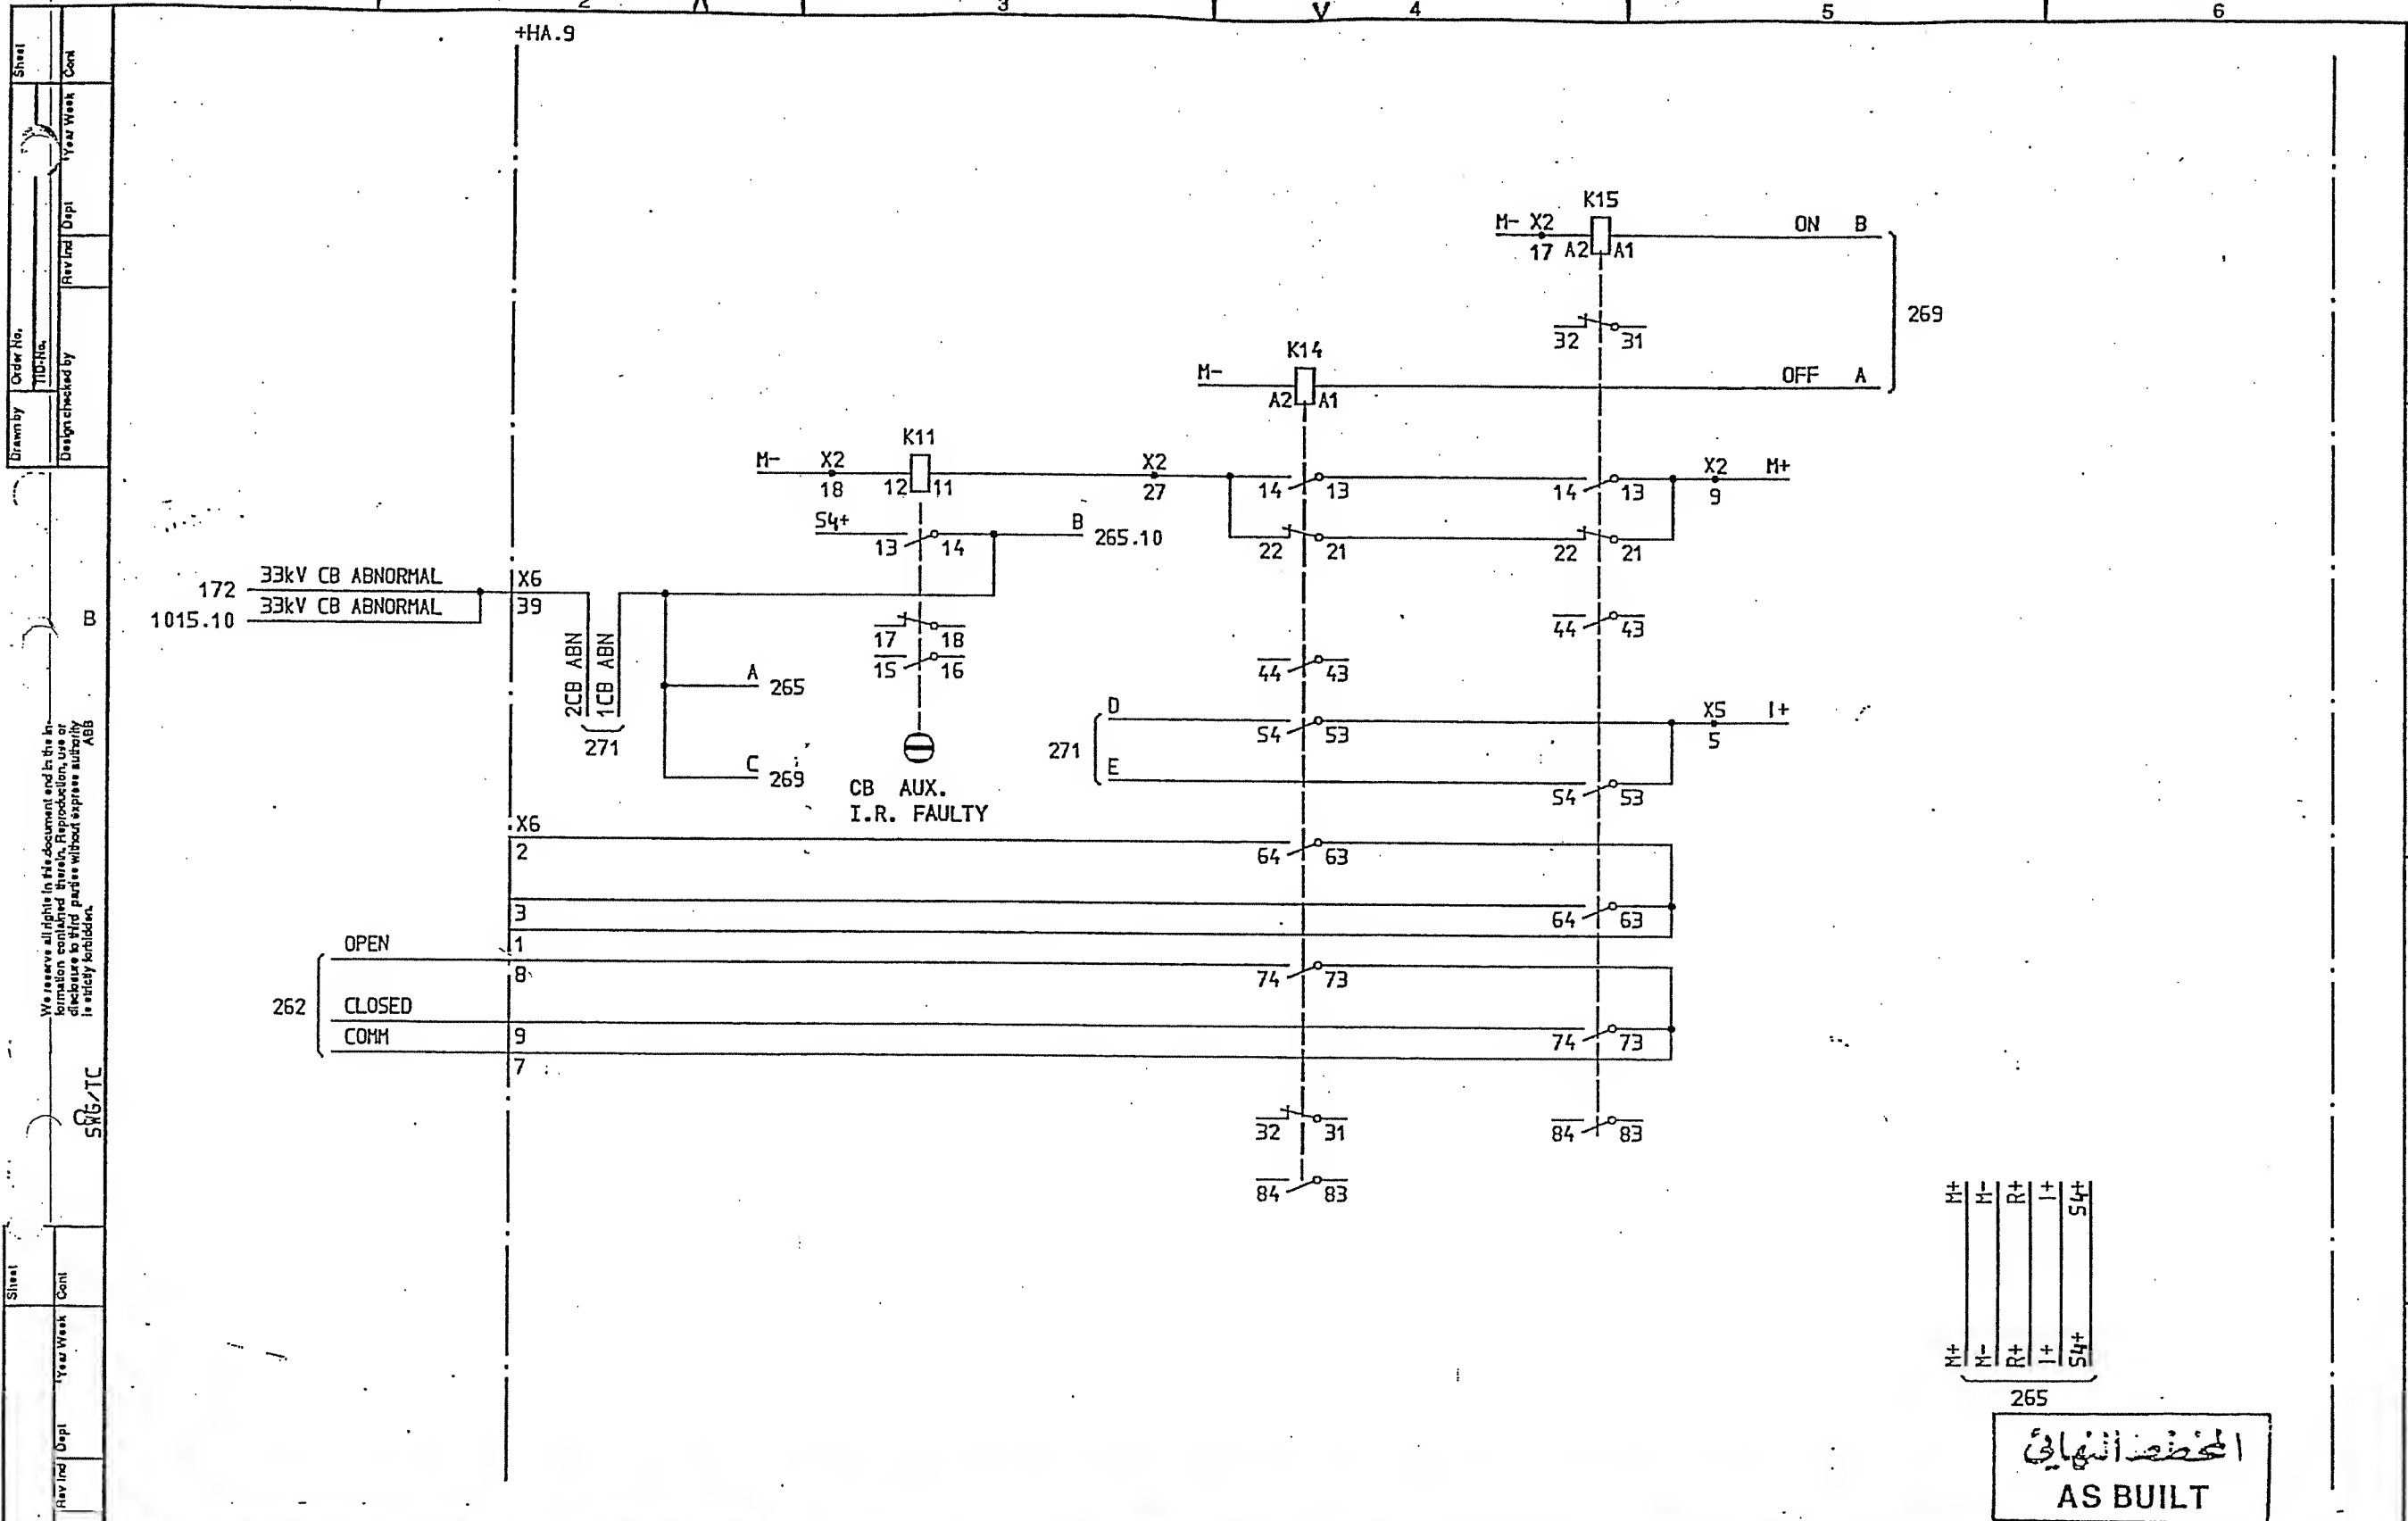AS BUILT




المحطة النهائية
AS BUILT

SYMBOL TO /D: XL824028-FBR:272/0

92-07-02 18.54

| | | | | | | | | | |
|---|------------|----|-------|----|--------------------------------|----------------------------------|--|----------------|-------------------------------------|
| 2 | SCECO SNAG | LS | 92 26 | =6 | 33kV INTERCONNECTOR LINE | Design checked by B NILSSON | CIRCUIT DIAGRAM S/S 8501 132/33kV SCECD CENTRAL SAUDI ARABIA | L 9743.1017 | Rev Incl Sheet Lang Sheet 272 |
| 1 | AS BUILT | LS | 91 21 | | CIRCUIT BREAKER EQUIPMENT -675 | Drawing checked by L SVENSSON | SCECD HV SWITCHGEAR | XL 824 028-FBR | Rev Incl Sheet Lang Sheet 273 |
| | | | | | | Drawn by SK | Iss by Dept TDCF 90 36 | | |

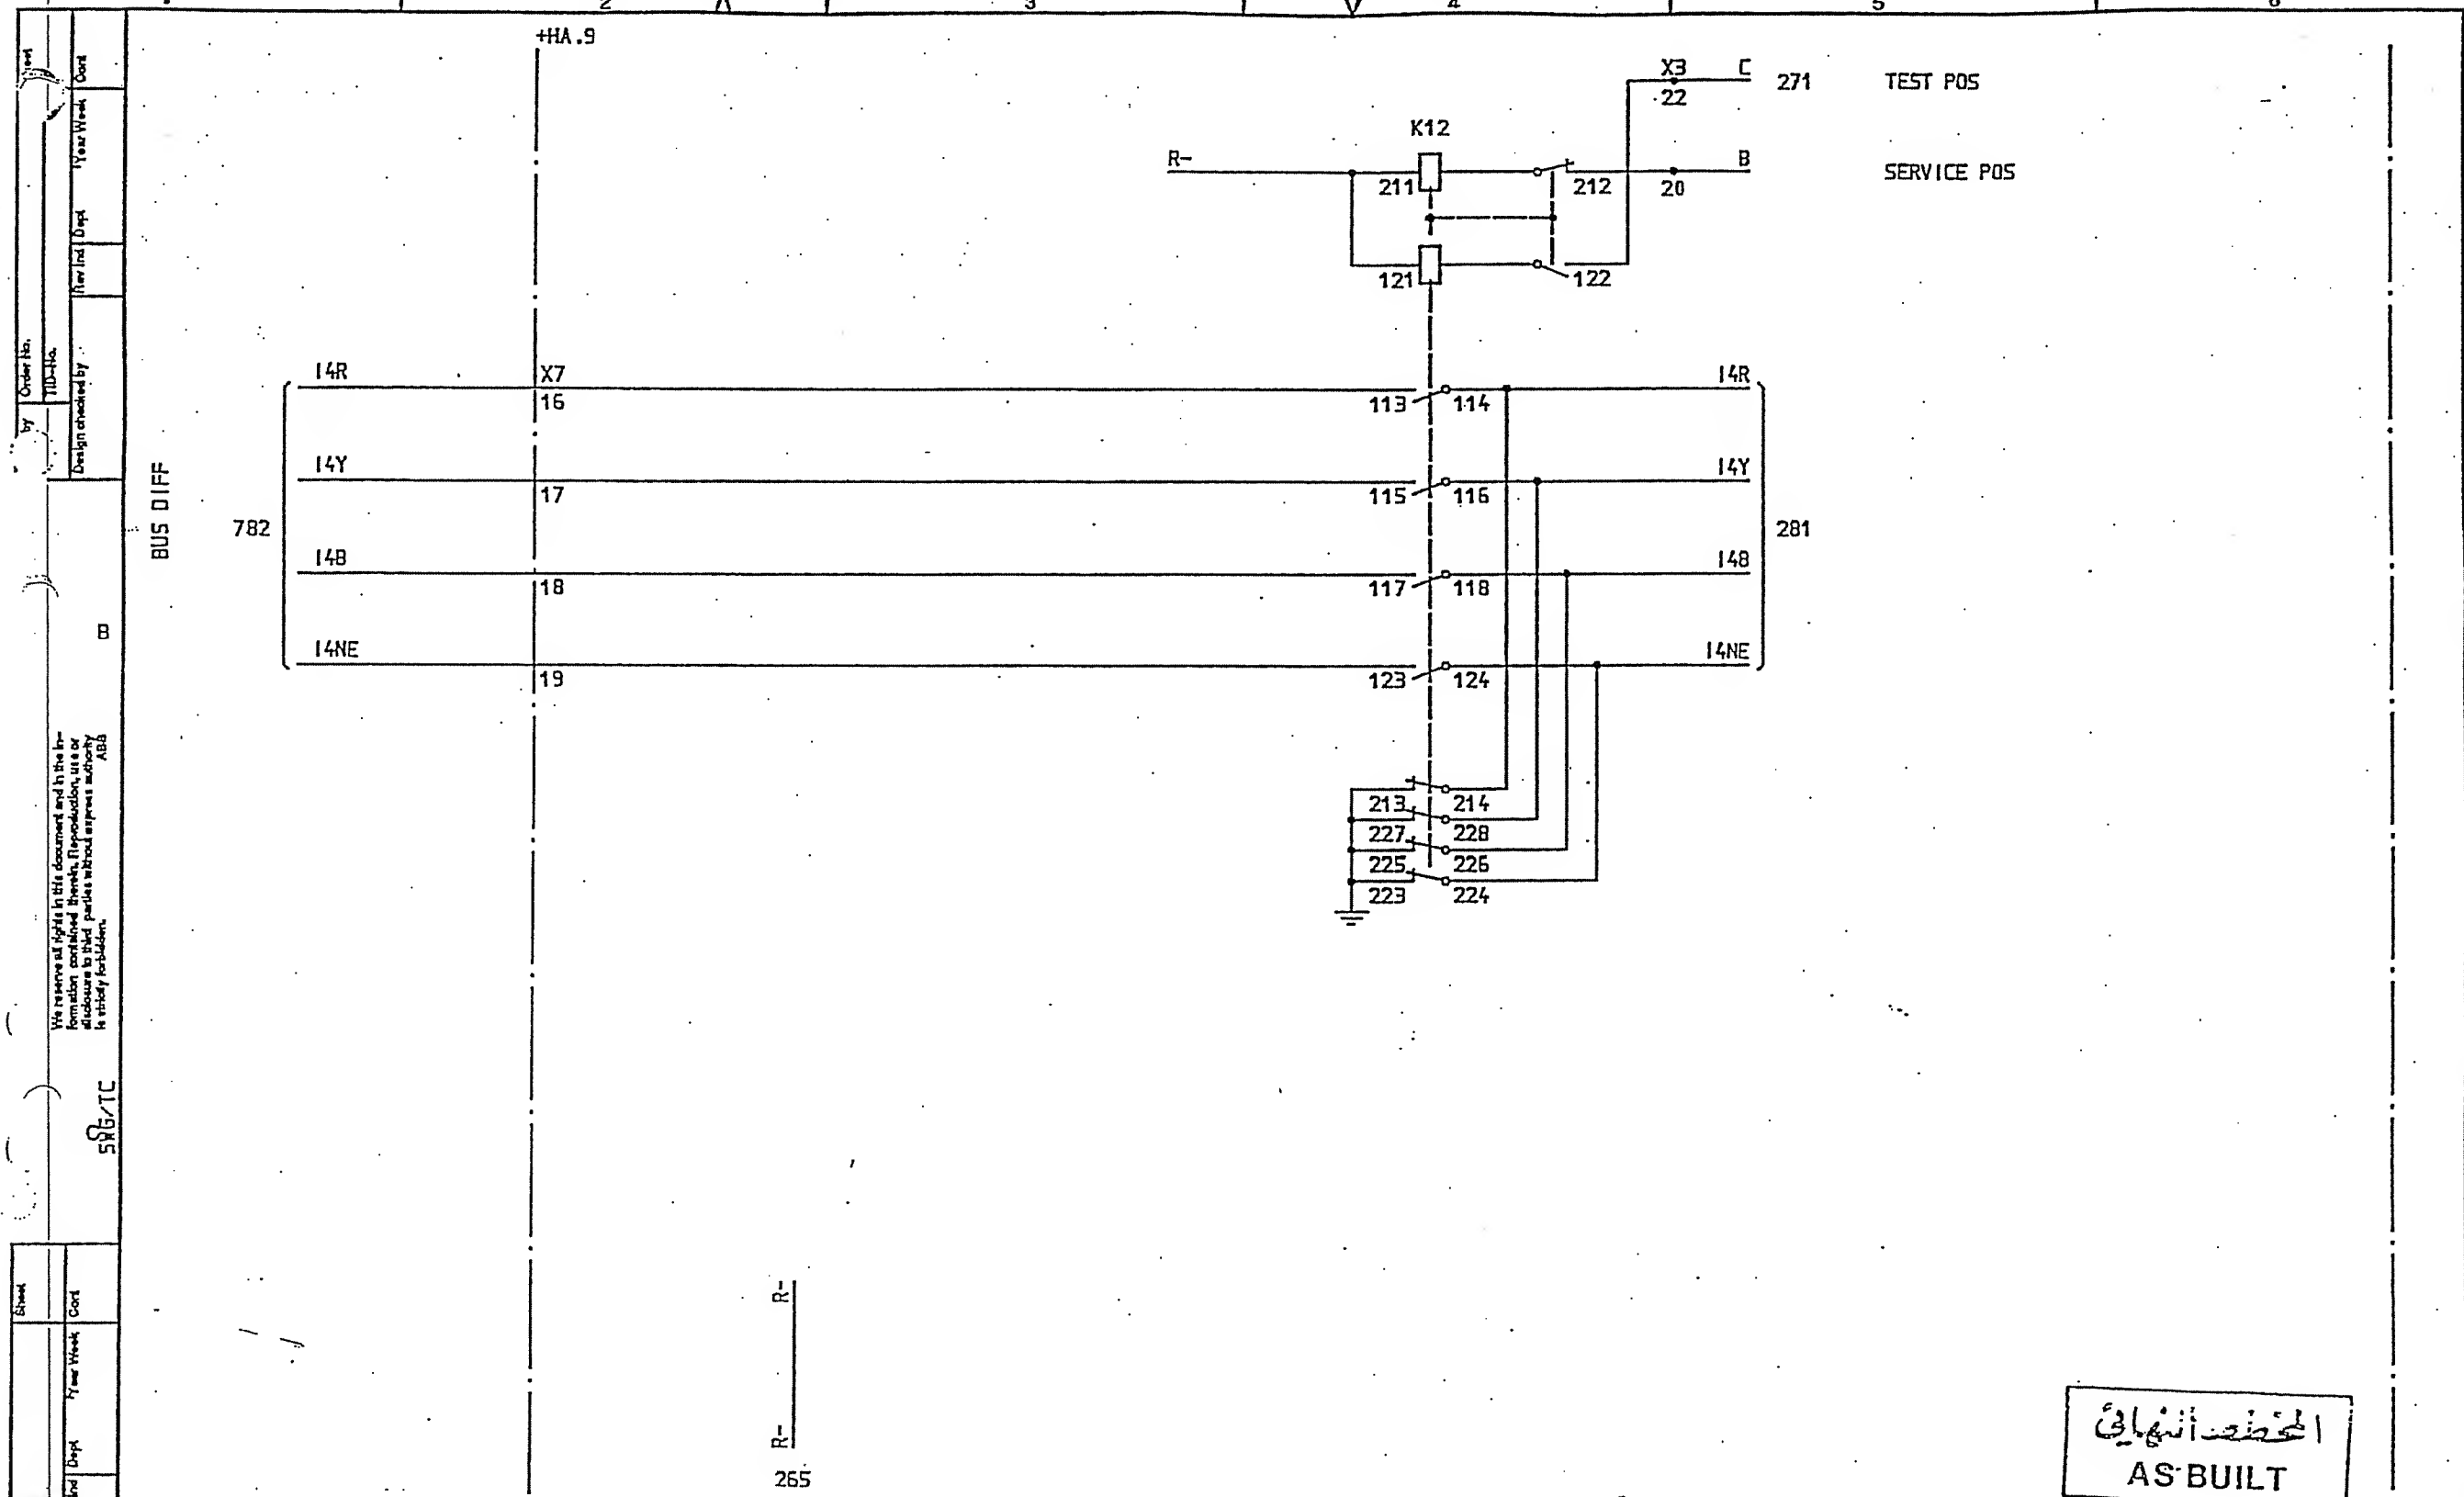

المخطط النهائي
AS-BUILT

SYMBOL ID /D:XL824028-FBR:276/0

DATE 91-06-04 09.08

| | | | | |
|---|----------|----|-------|---|
| 1 | AS BUILT | 15 | 91 21 | =6 33kV INTERCONNECTOR LINE C.T. SHORTING RELAY |
|---|----------|----|-------|---|

| | | | |
|----------------------------------|----------------------------|---------|-------|
| Design checked by B NILSSON | CIRCUIT DIAGRAM | Rev Ind | Sheet |
| Drawing checked by L SVENSSON | S/S 8501 132/33kV | Link | Sheet |
| Drawn by SK | SCECO CENTRAL SAUDI ARABIA | Rev Ind | Sheet |
| | ABB HV SWITCHGEAR | 1 | 276 |
| | TOCF 90 36 | | 27B |

L 9743.1017
XL 824 028-FBR

AS-BUILT

21 & 1

1

2

3

V

4

5

6

01ST. PROT

283 MAIN PROT TRIP

+HA.9

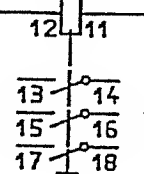
X3
44

TRIP INDIC.
94 - 1

256 P-

45


K18



268.10 =2TRIP+


X3
31

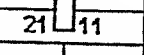K2



32

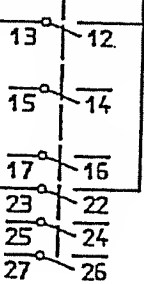
268 P+



287 BACK-UP PROT TRIP

X3
46

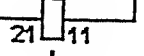K3



268 A

13 12

B 268

15 14

268 P+

17 16

23 22

25 24

27 26

256 P-SUP

47

K18

22 21

23 24

25 26

27 28

TRIP INDIC.
94 - BU

المحطة النهائية
AS BUILT

SYMBOL ID /D:XL824028-FBR:278/0

92-09-09 07.35

| | | | |
|---|------------|----|-------|
| 2 | SCECO SNA6 | LS | 92 26 |
| 1 | AS BUILT | LS | 91 21 |

=6
33kV INTERCONNECTOR LINE
TRIP RELAYS 33kV

Design checked by
B NILSSON
Drawing checked by
L SVENSSON
Drawn by
SK


CIRCUIT DIAGRAM
S/S 8501 132/33kV
SCECO CENTRAL SAUDI ARABIA
ABB HV SWITCHGEAR

Iss by Dept Year Week
TDCF 90 36

L 9743.1017
XL 824 028-FBR


| | | |
|-----|-----|-------|
| Rev | Int | Sheet |
| 2 | 278 | 280 |

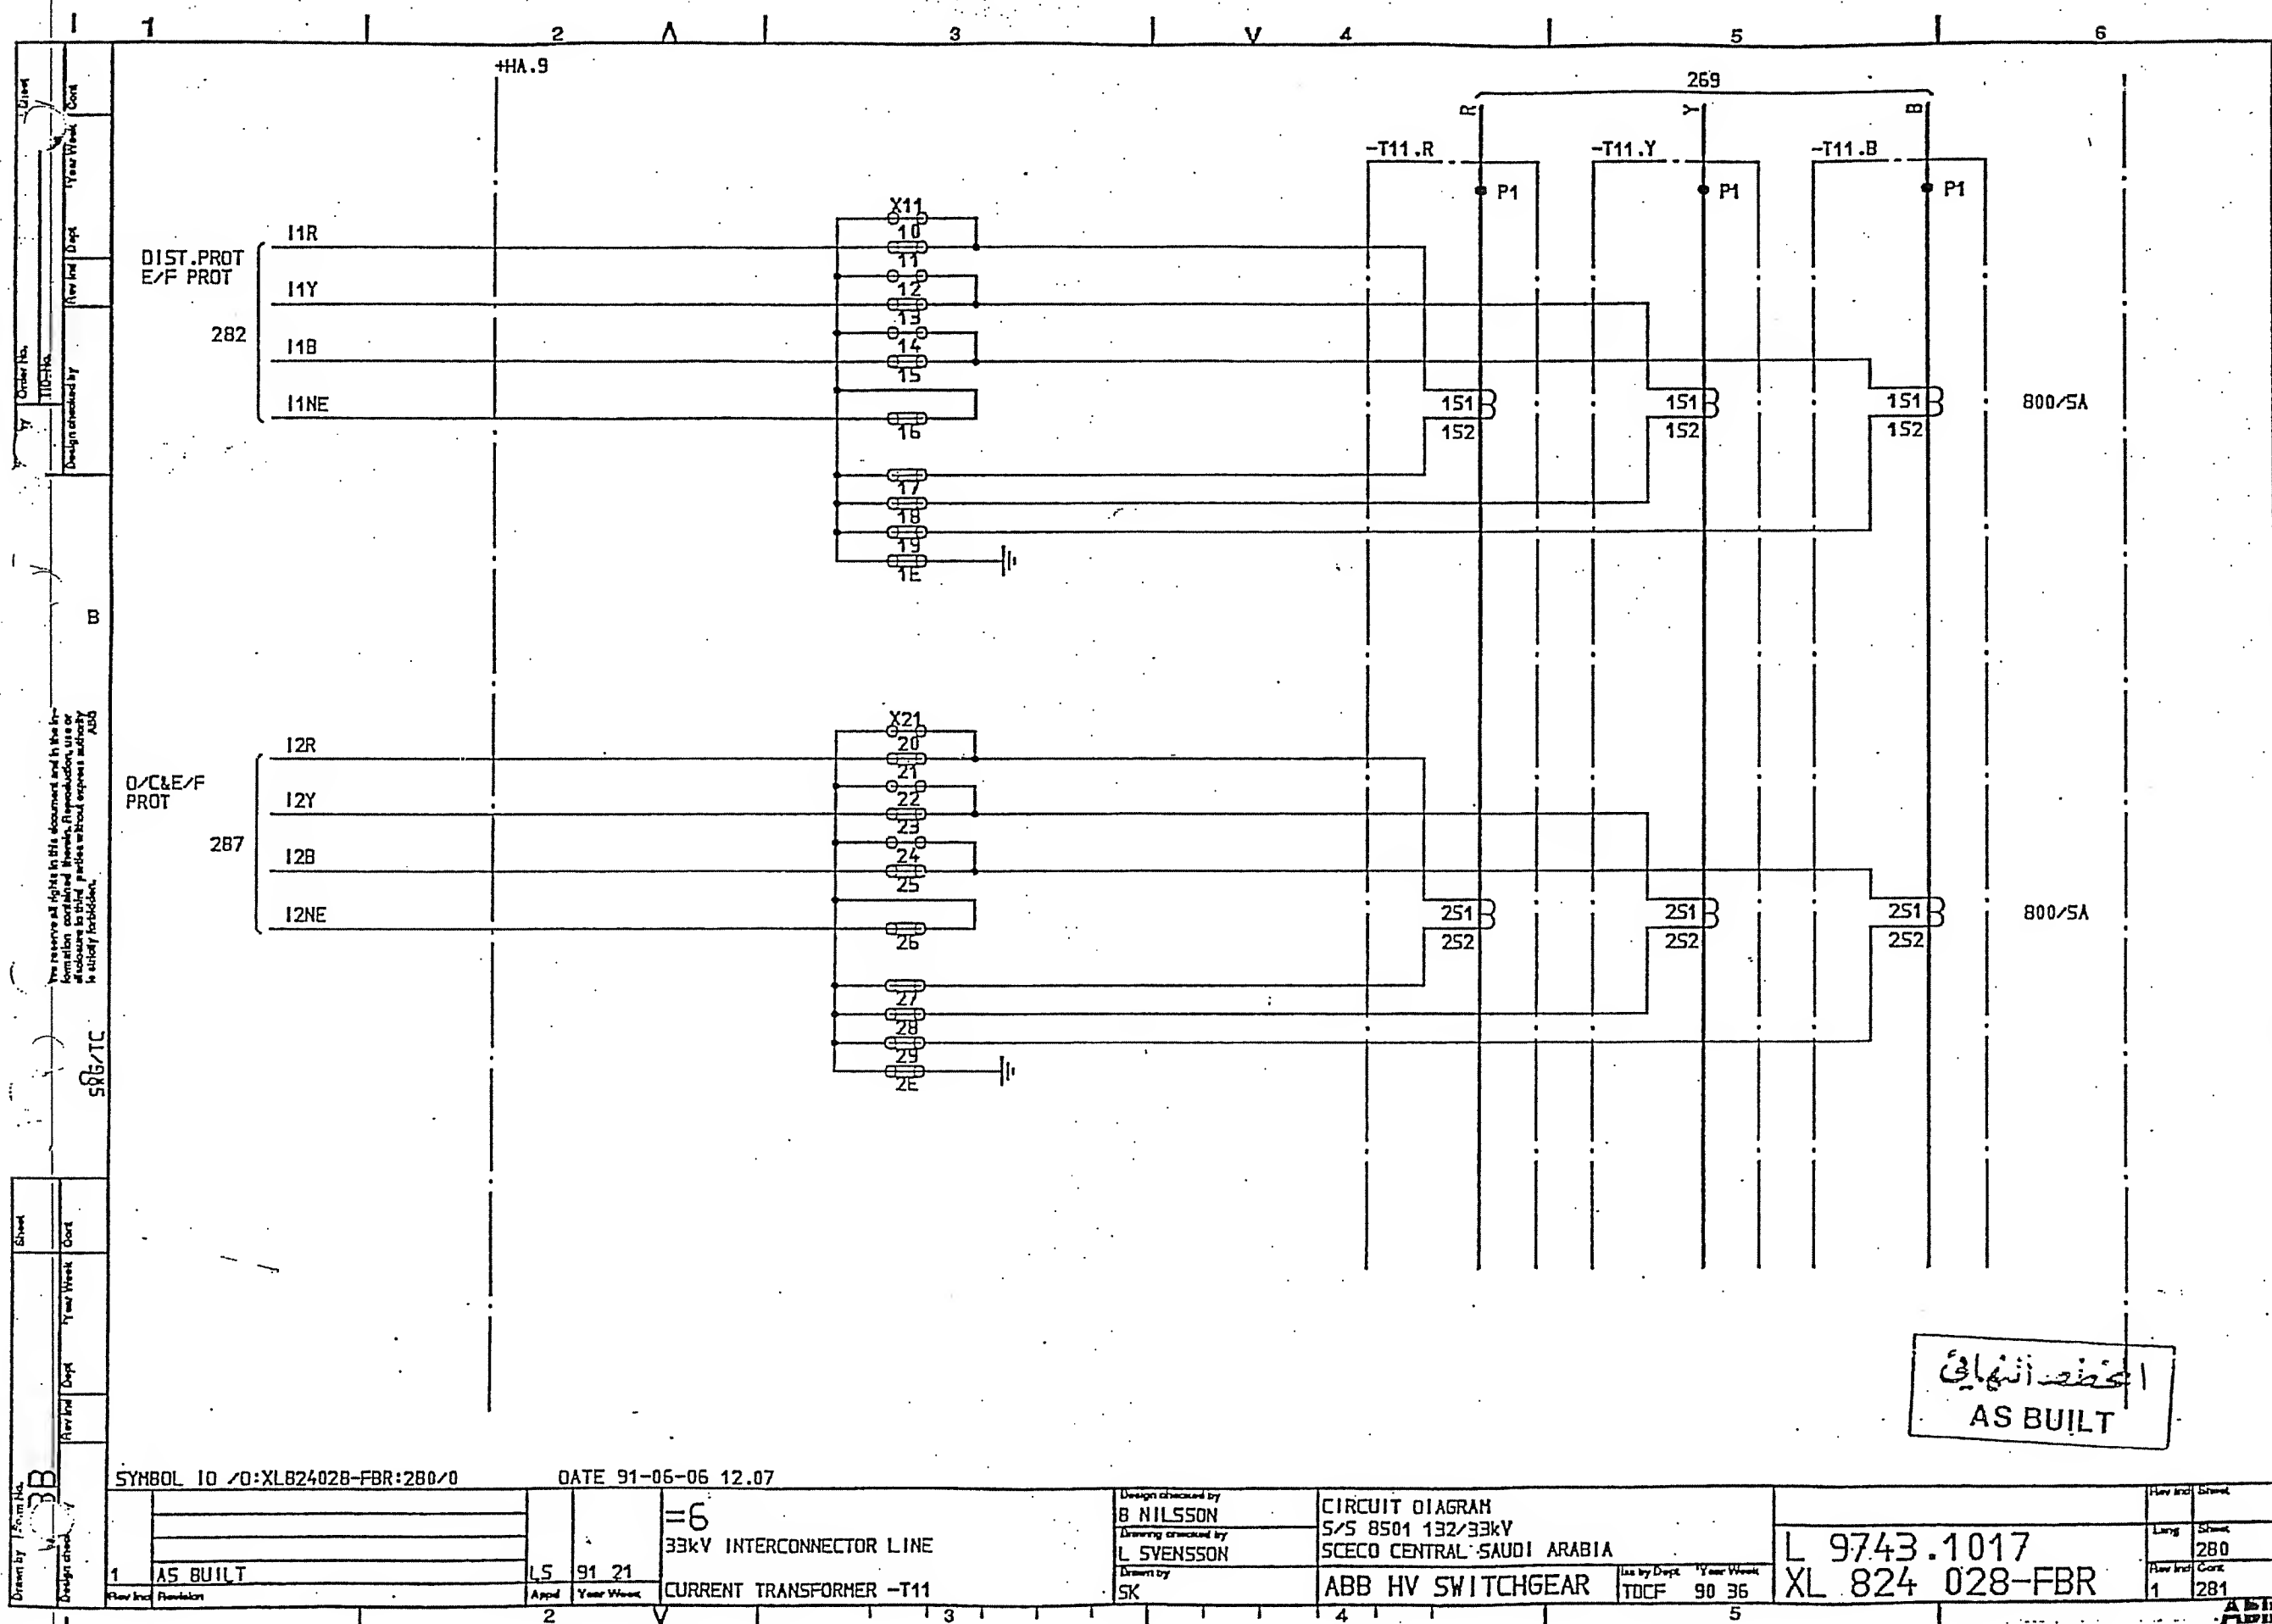AS BUILT




المحطة النهائية
AS BUILT

| | | | | | | | | | | | | | | | |
|---------------------------------|--|------------------|--|--------------------------|--|--------------------------|--|-------------------|--|-------------------|--|----------------|--|-------------|--|
| SYMBOL IO /O:XL824028-FBR:280/0 | | DATE 91-06-12.07 | | =6 | | 33kV INTERCONNECTOR LINE | | CIRCUIT DIAGRAM | | S/S 8501 132/33kV | | L 9743.1017 | | Long Sheet | |
| AS BUILT | | LS 91 21 | | CURRENT TRANSFORMER -T11 | | SK | | ABB HV SWITCHGEAR | | TDCF 90 36 | | XL 824 028-FBR | | Short Sheet | |
| 1 | | 2 | | 3 | | 4 | | 5 | | 6 | | 7 | | 8 | |

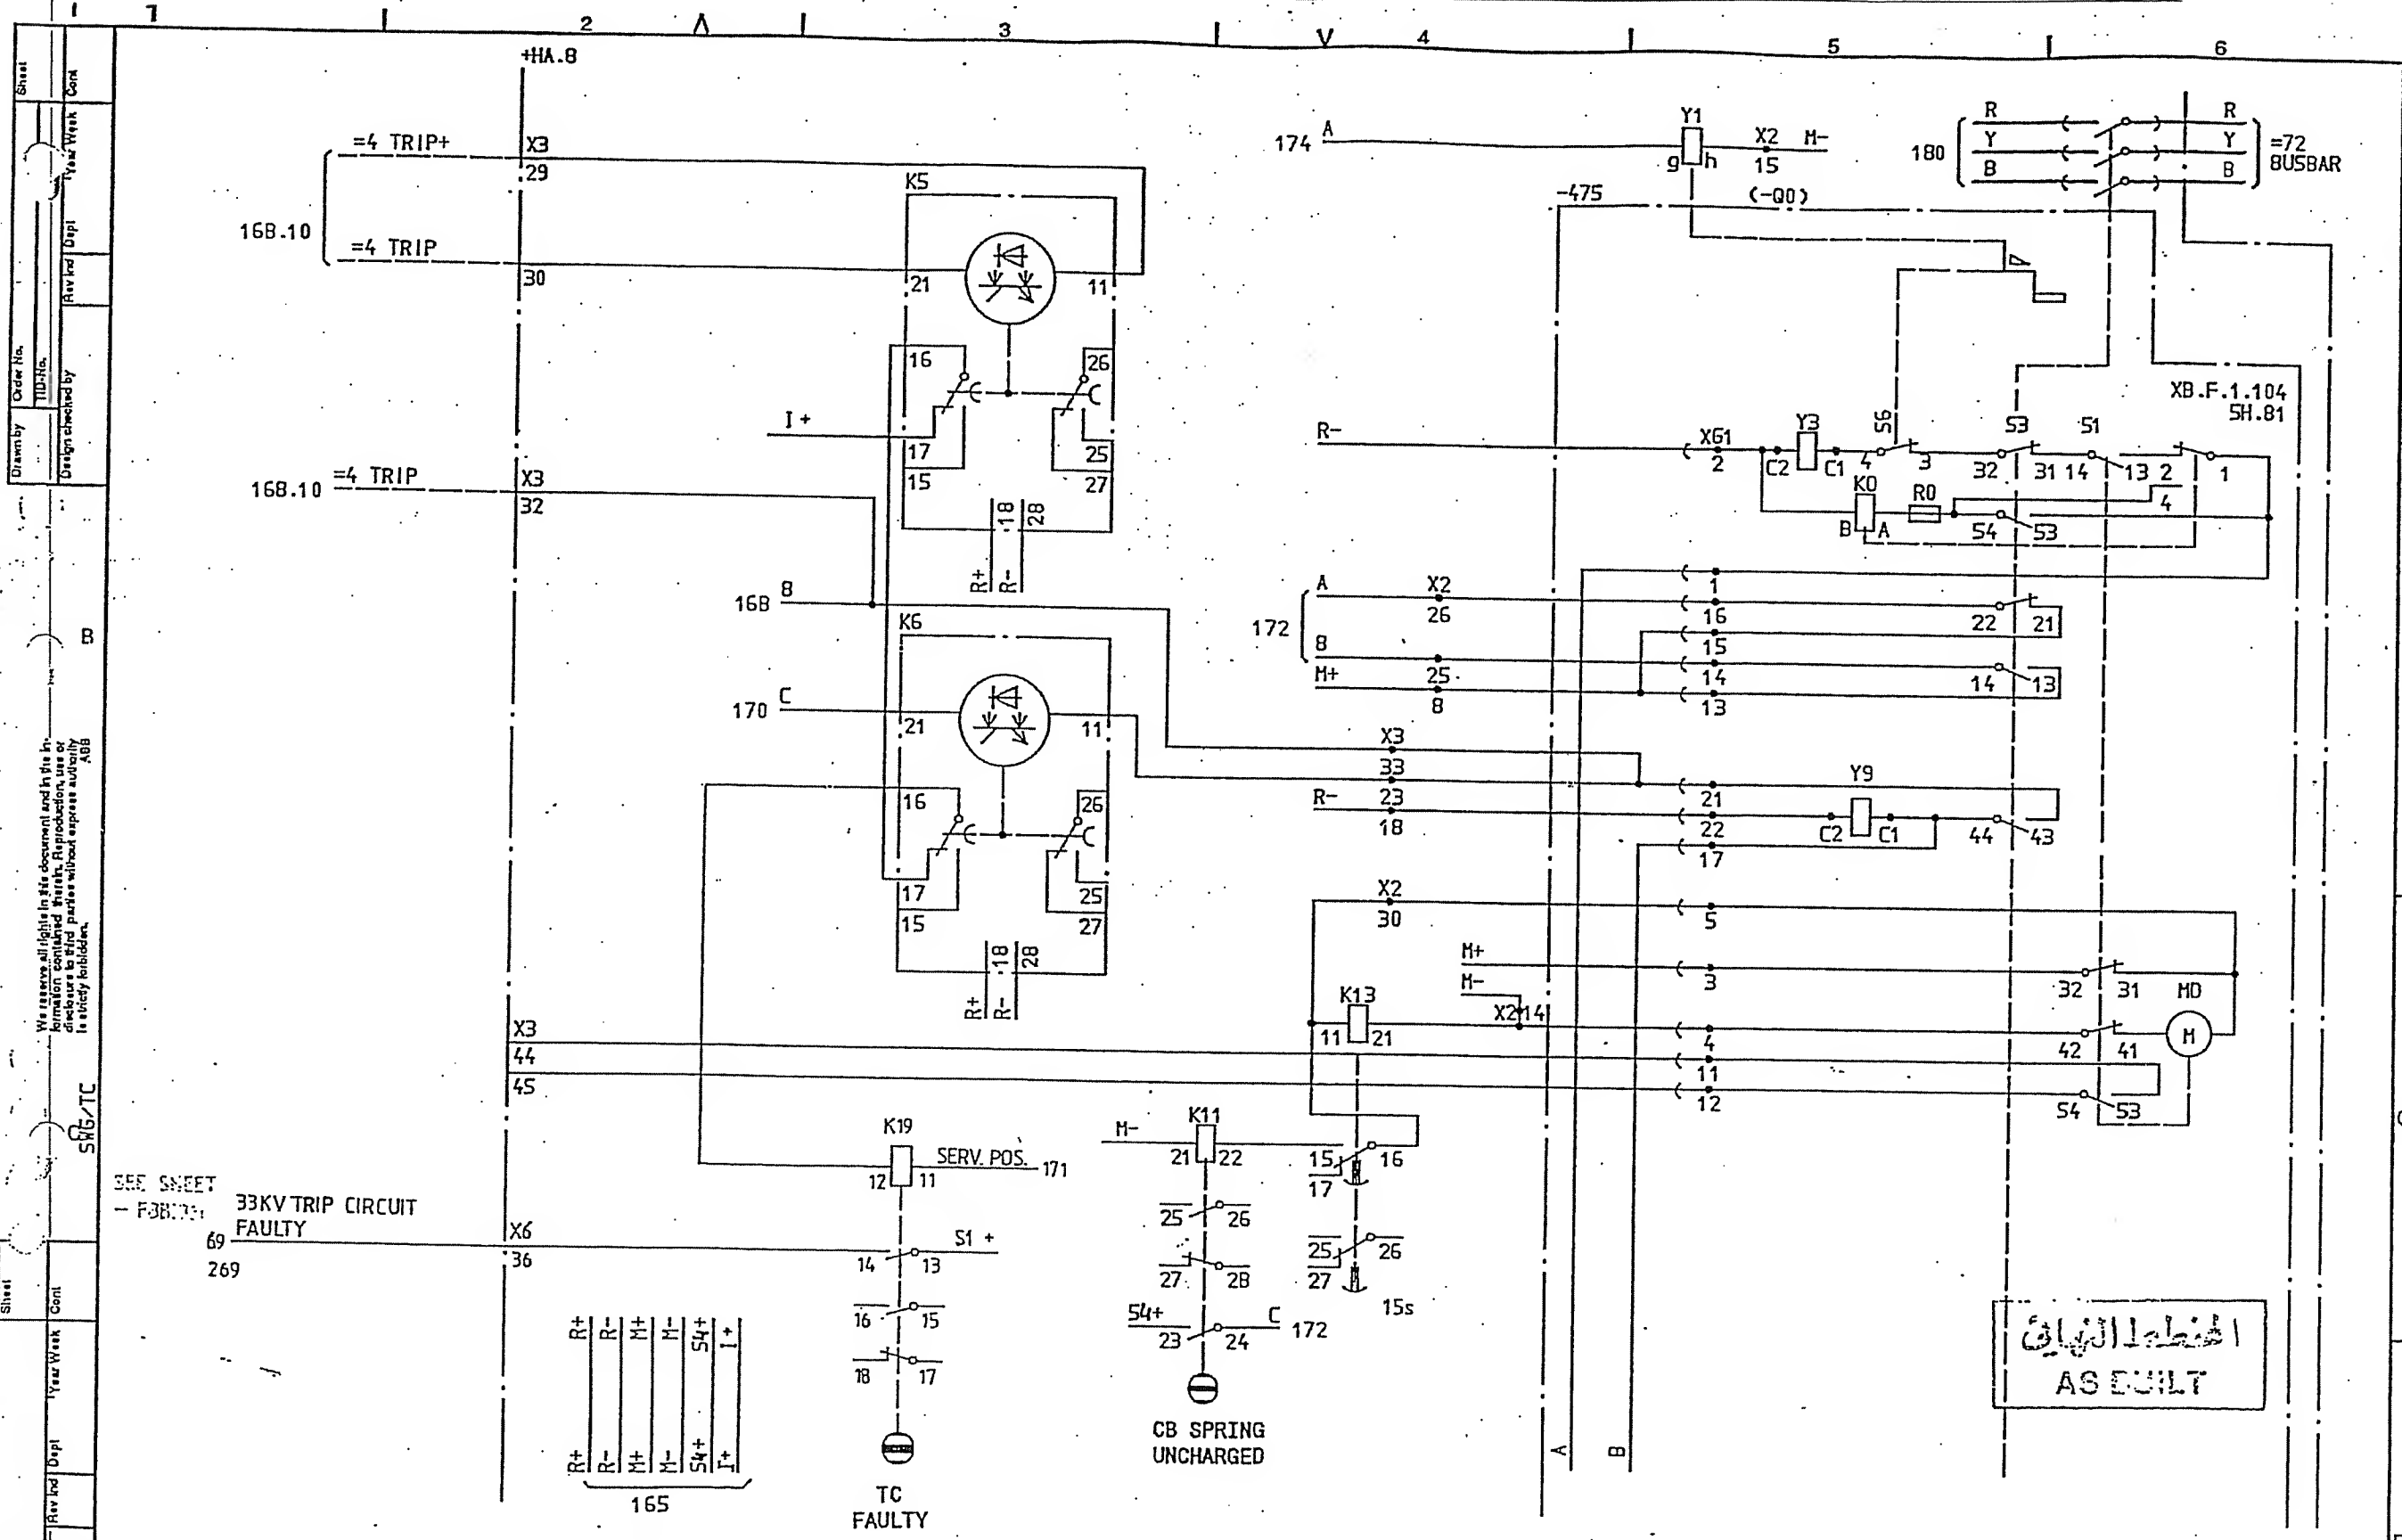

الخطة الكهربائية
AS BUILT

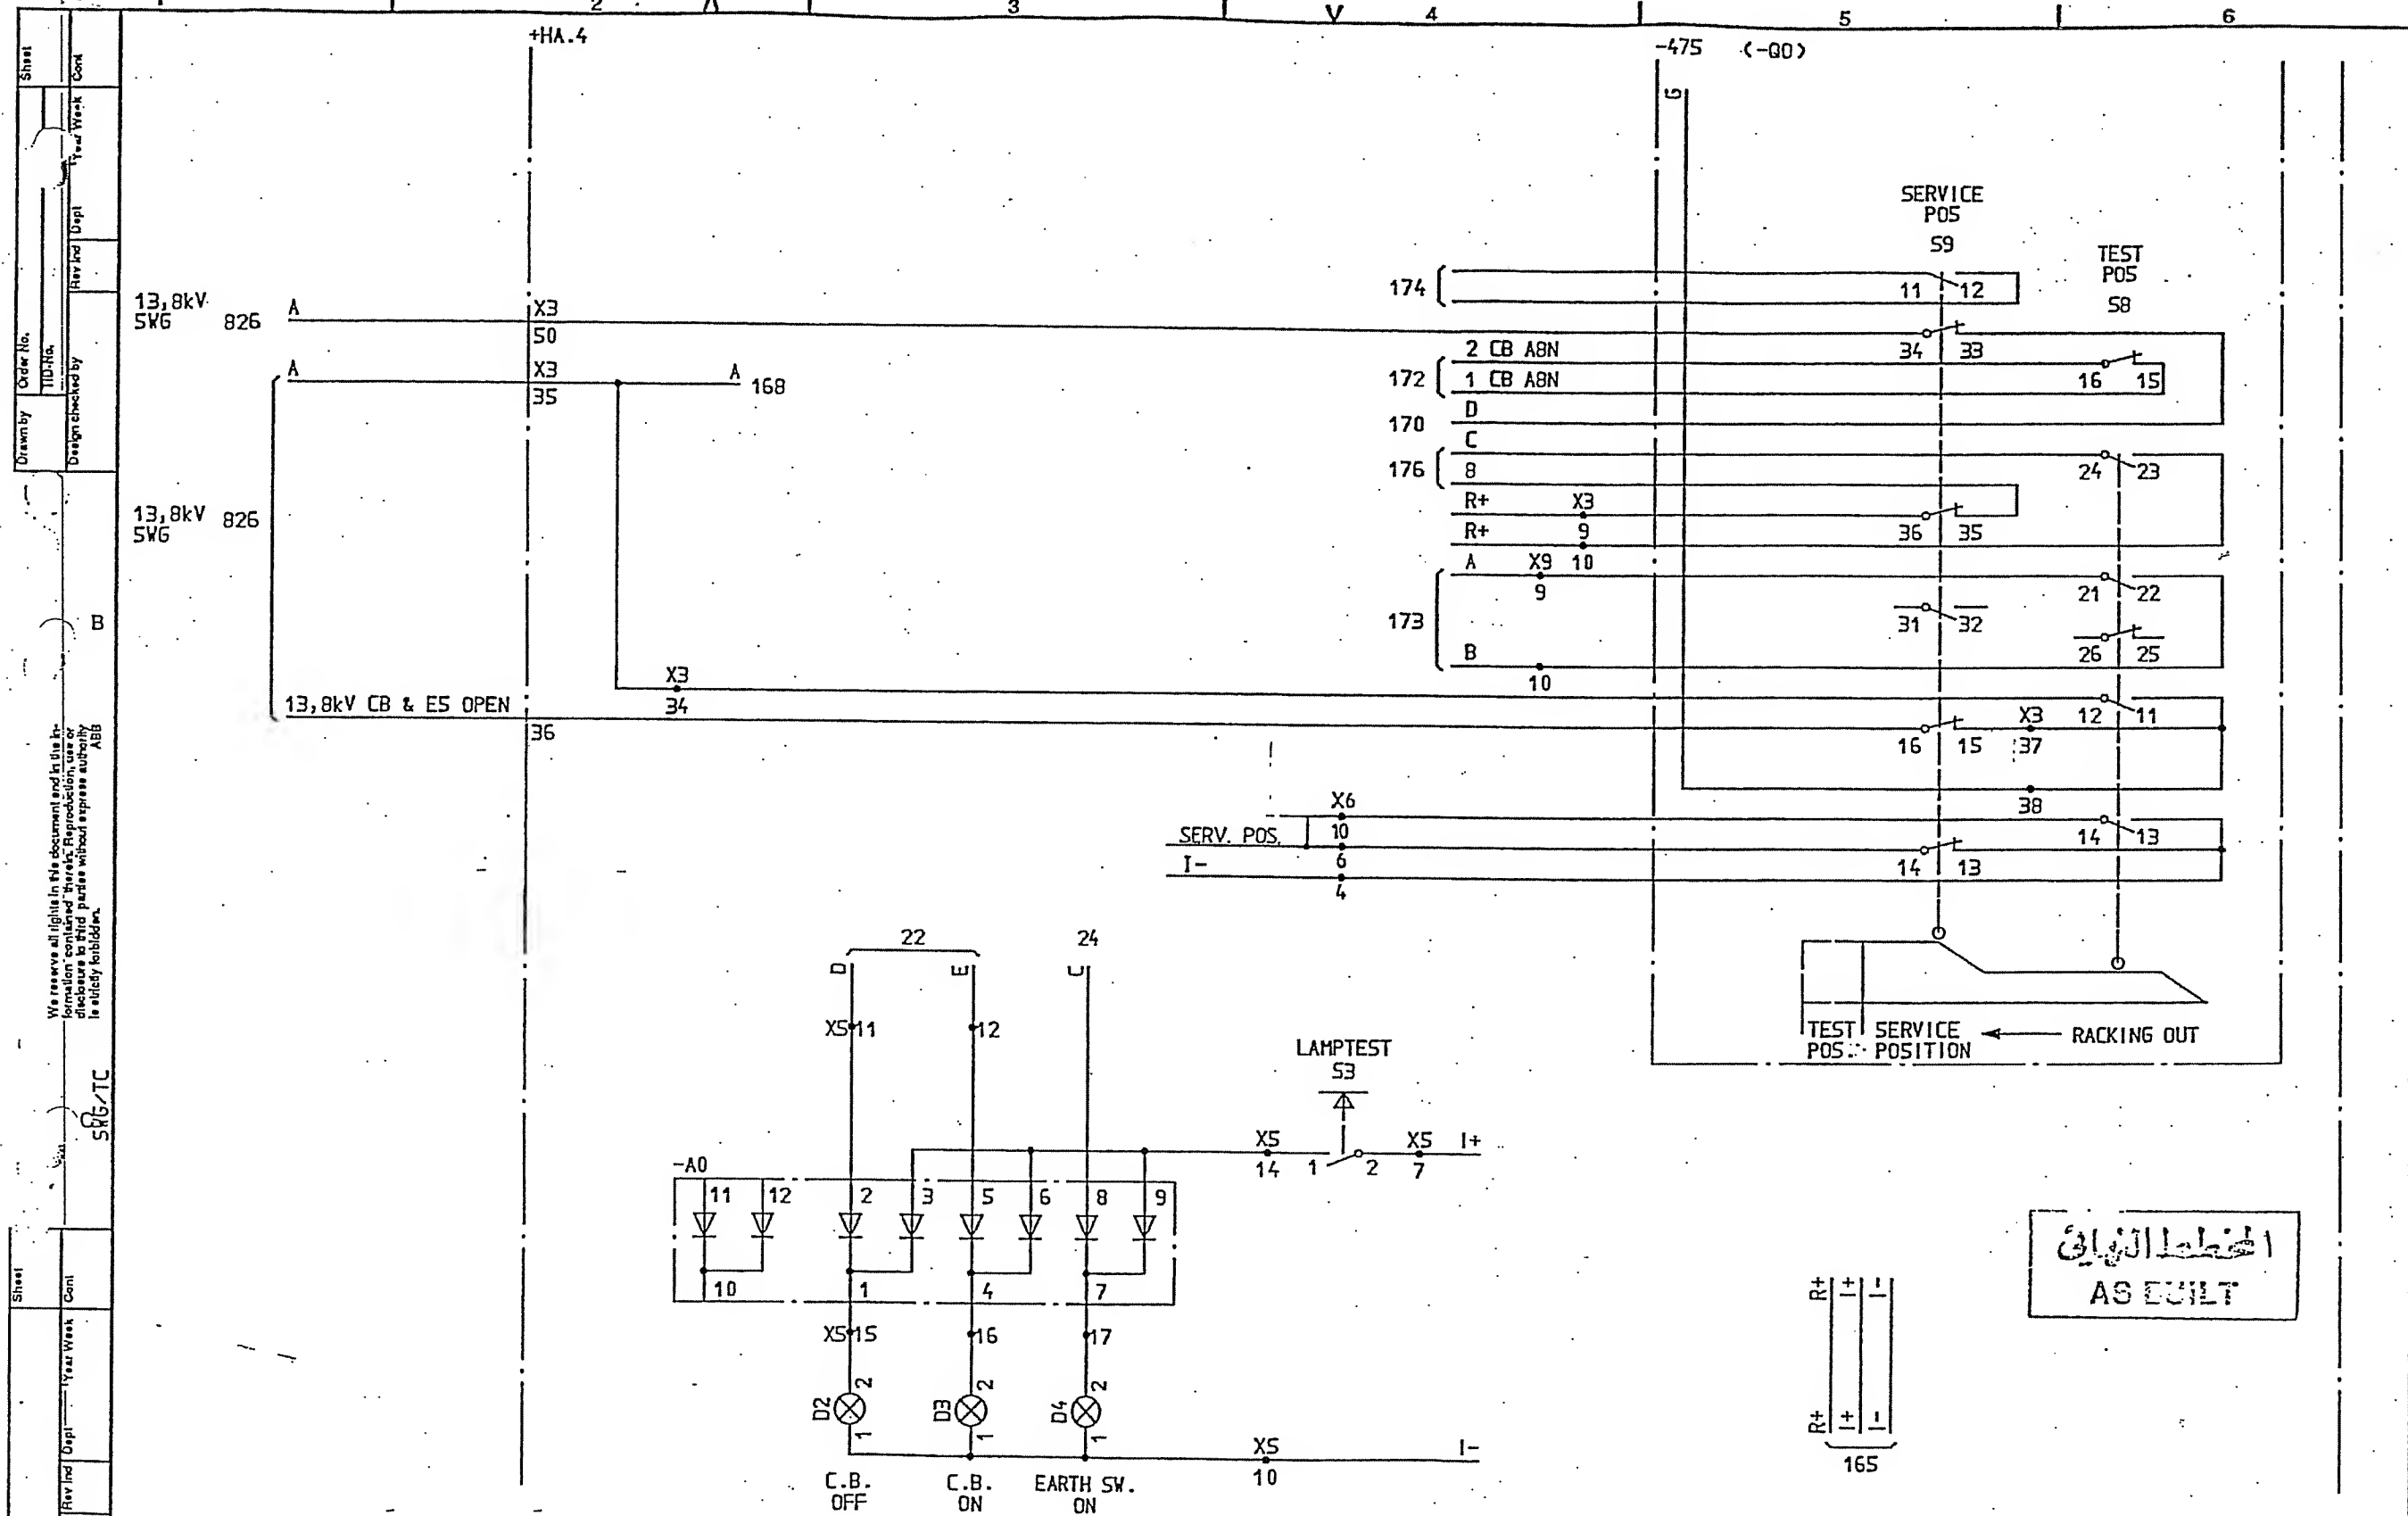

الخطة الكهربائية
AS BUILT

SYMBOL ID /D:XL824028-FBR:171/0


92-07-02 18.53

| | | | | | |
|-----|------------|----|-------|----|--------------------------------|
| 2.1 | SCECO SNAG | L5 | 92 26 | =4 | 33/13.8kV TRANSFORMER 8AY T12 |
| 1 | AS BUILT | L5 | 91 21 | | CIRCUIT BREAKER EQUIPMENT -475 |


| | | |
|--------------------|------------|----------------------------|
| Design checked by | 8 NILSSON | CIRCUIT DIAGRAM |
| Drawing checked by | L SVENSSON | S/S 8501 132/33kV |
| Drawn by | SK | SCECO CENTRAL SAUDI ARABIA |
| | | ABB HV SWITCHGEAR |

| | | | |
|---------|-------|------|-------|
| Rev Ind | Sheet | Long | Sheet |
| 21 | 171 | 21 | 172 |

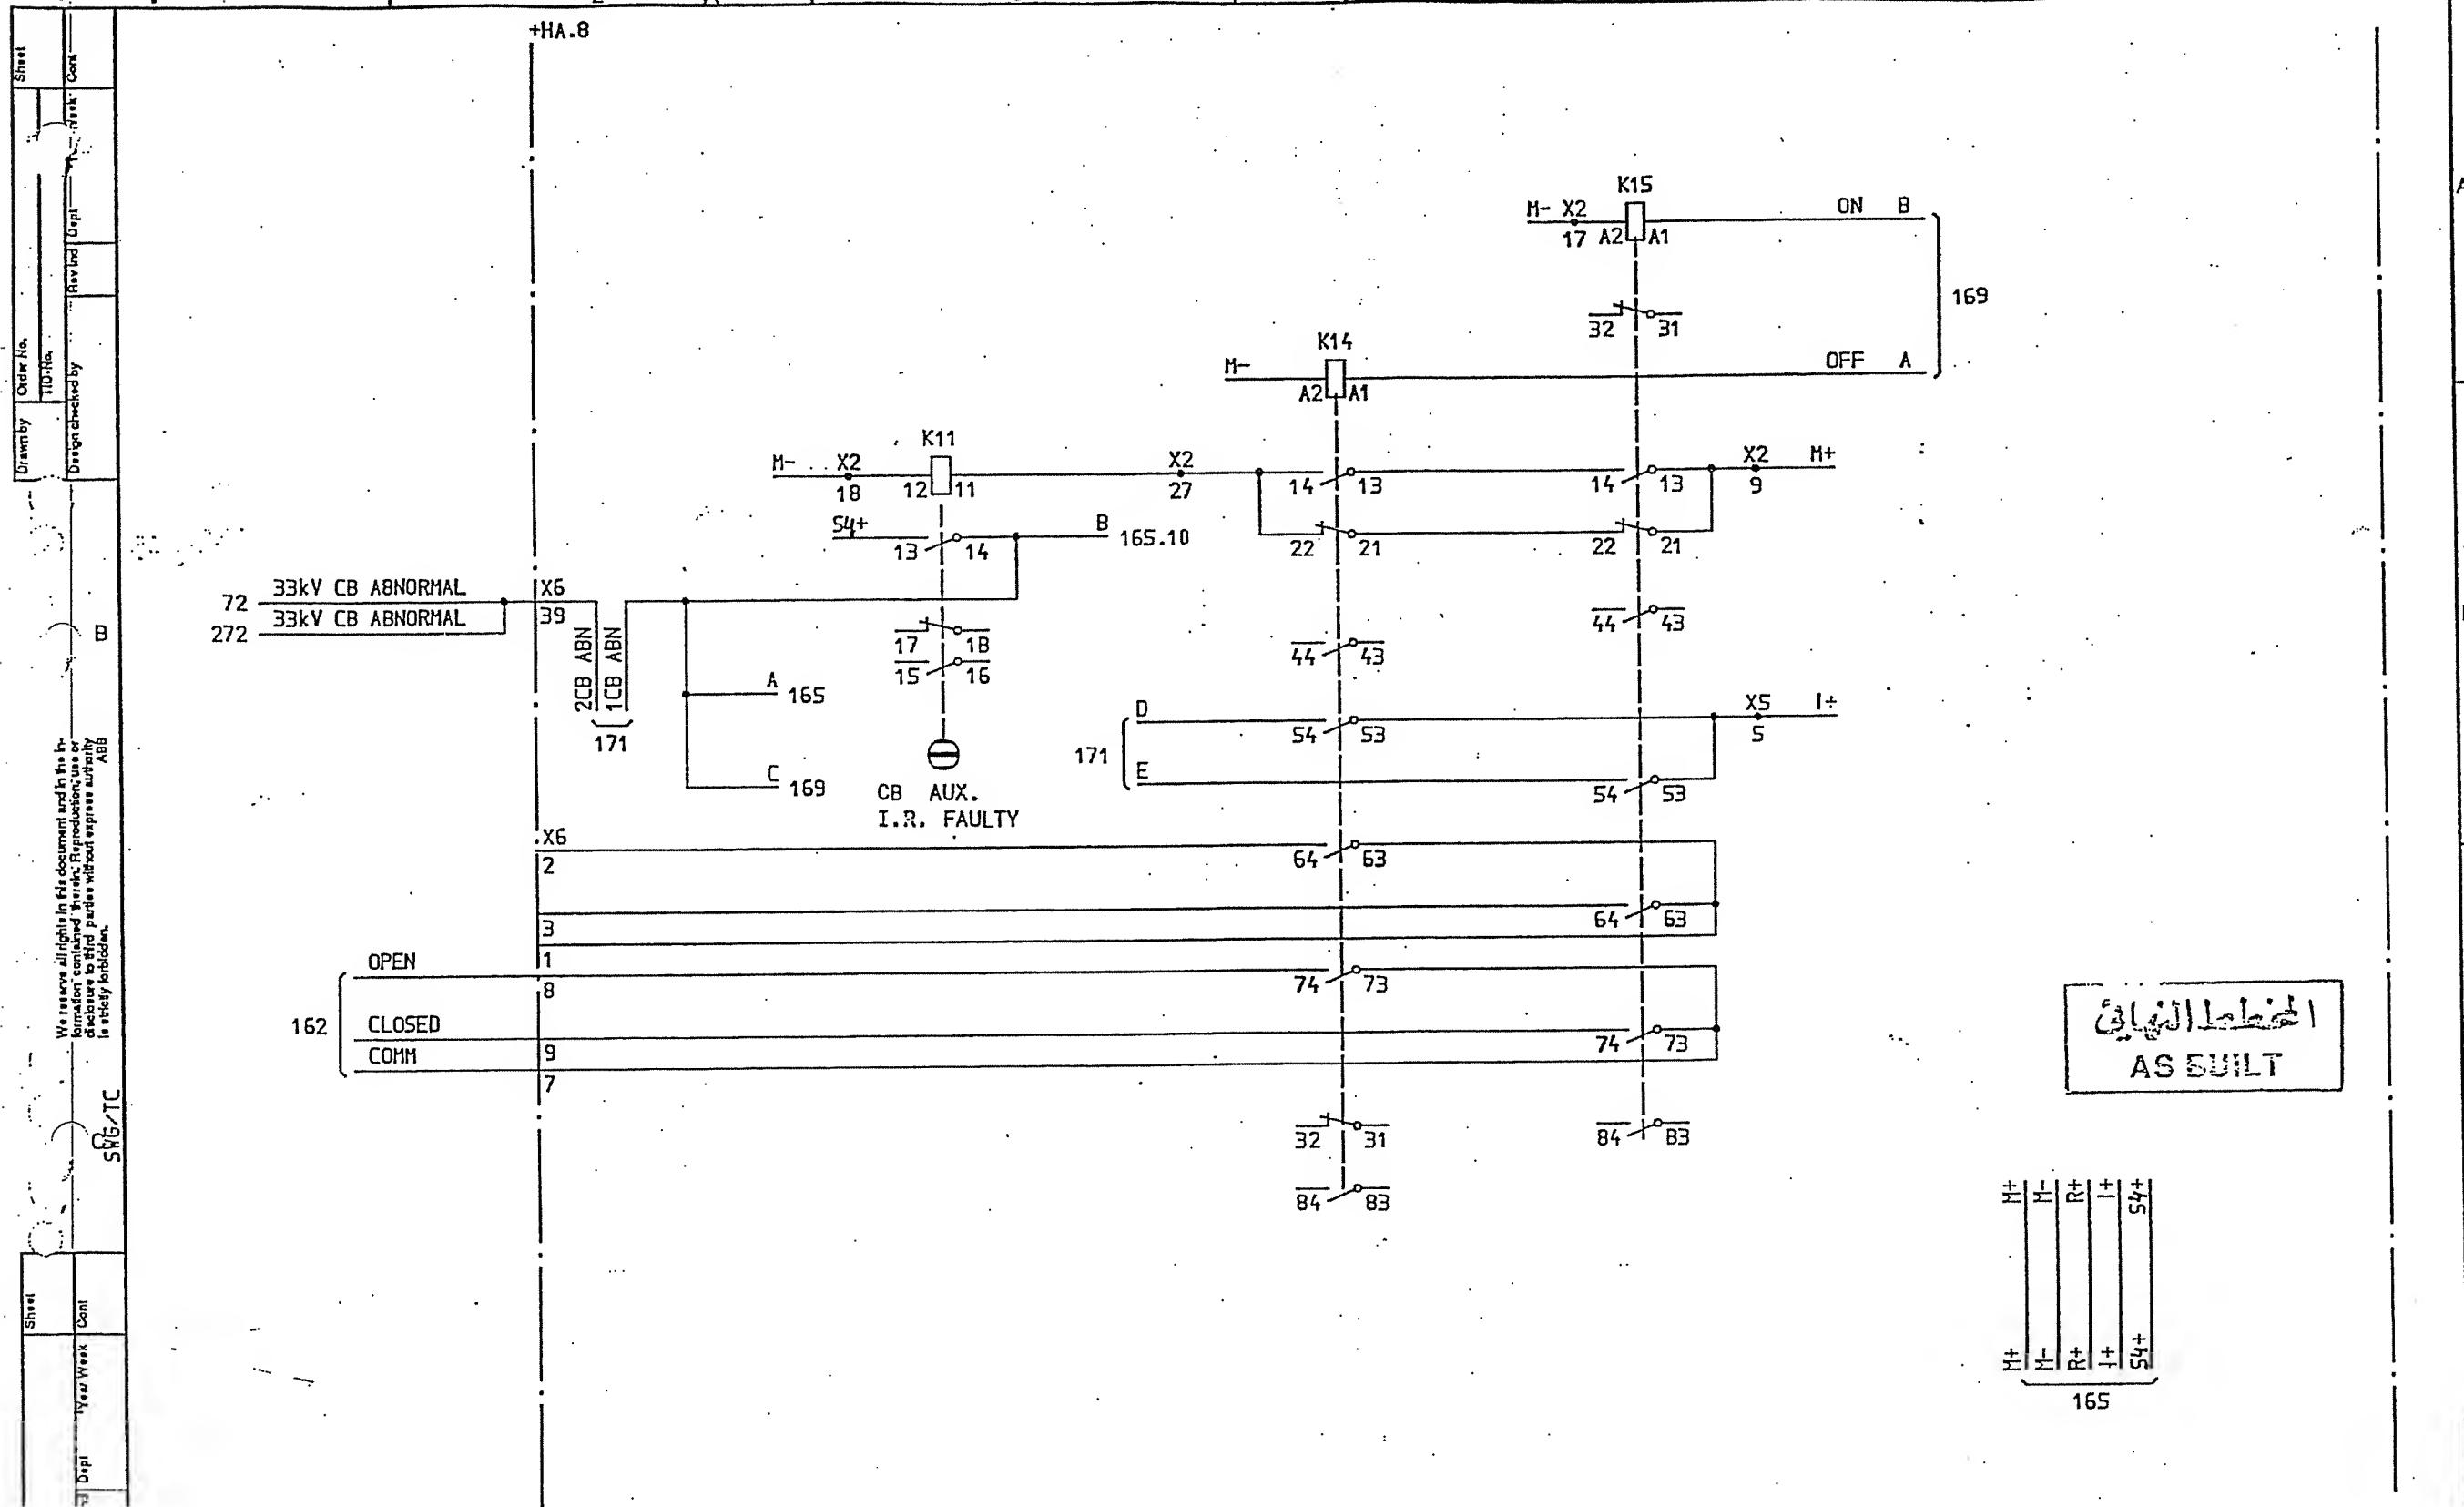L 9743.1017
XL 824 028-FBR



المخطط النهائي
AS BUILT

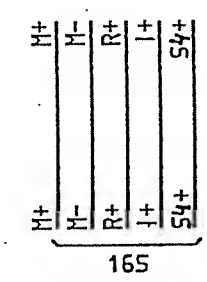

SYM80L 10 /D:XL824028-FBR:172/0

92-07-02 18.53

| | | | | |
|---|------------|----|-------|--------------------------------|
| 2 | SCECO SNAG | LS | 92 26 | 33/13,8kV TRANSFORMER 8AY T12 |
| 1 | AS BUILT | LS | 91 21 | CIRCUIT BREAKER EQUIPMENT -475 |


Design checked by
B NILSSON
Drawing checked by
L SVENSSON
Drawn by
PN

CIRCUIT DIAGRAM
S/S B501 132/33kV
SCECO CENTRAL SAUDI ARABIA
ABB HV SWITCHGEAR

Iss by Dept Year Week
TDCF 90 36

L 9743.1017
XL 824 028-FBR

| | | |
|-----|-----|-------|
| Rev | Inc | Sheet |
| 2 | 172 | 173 |

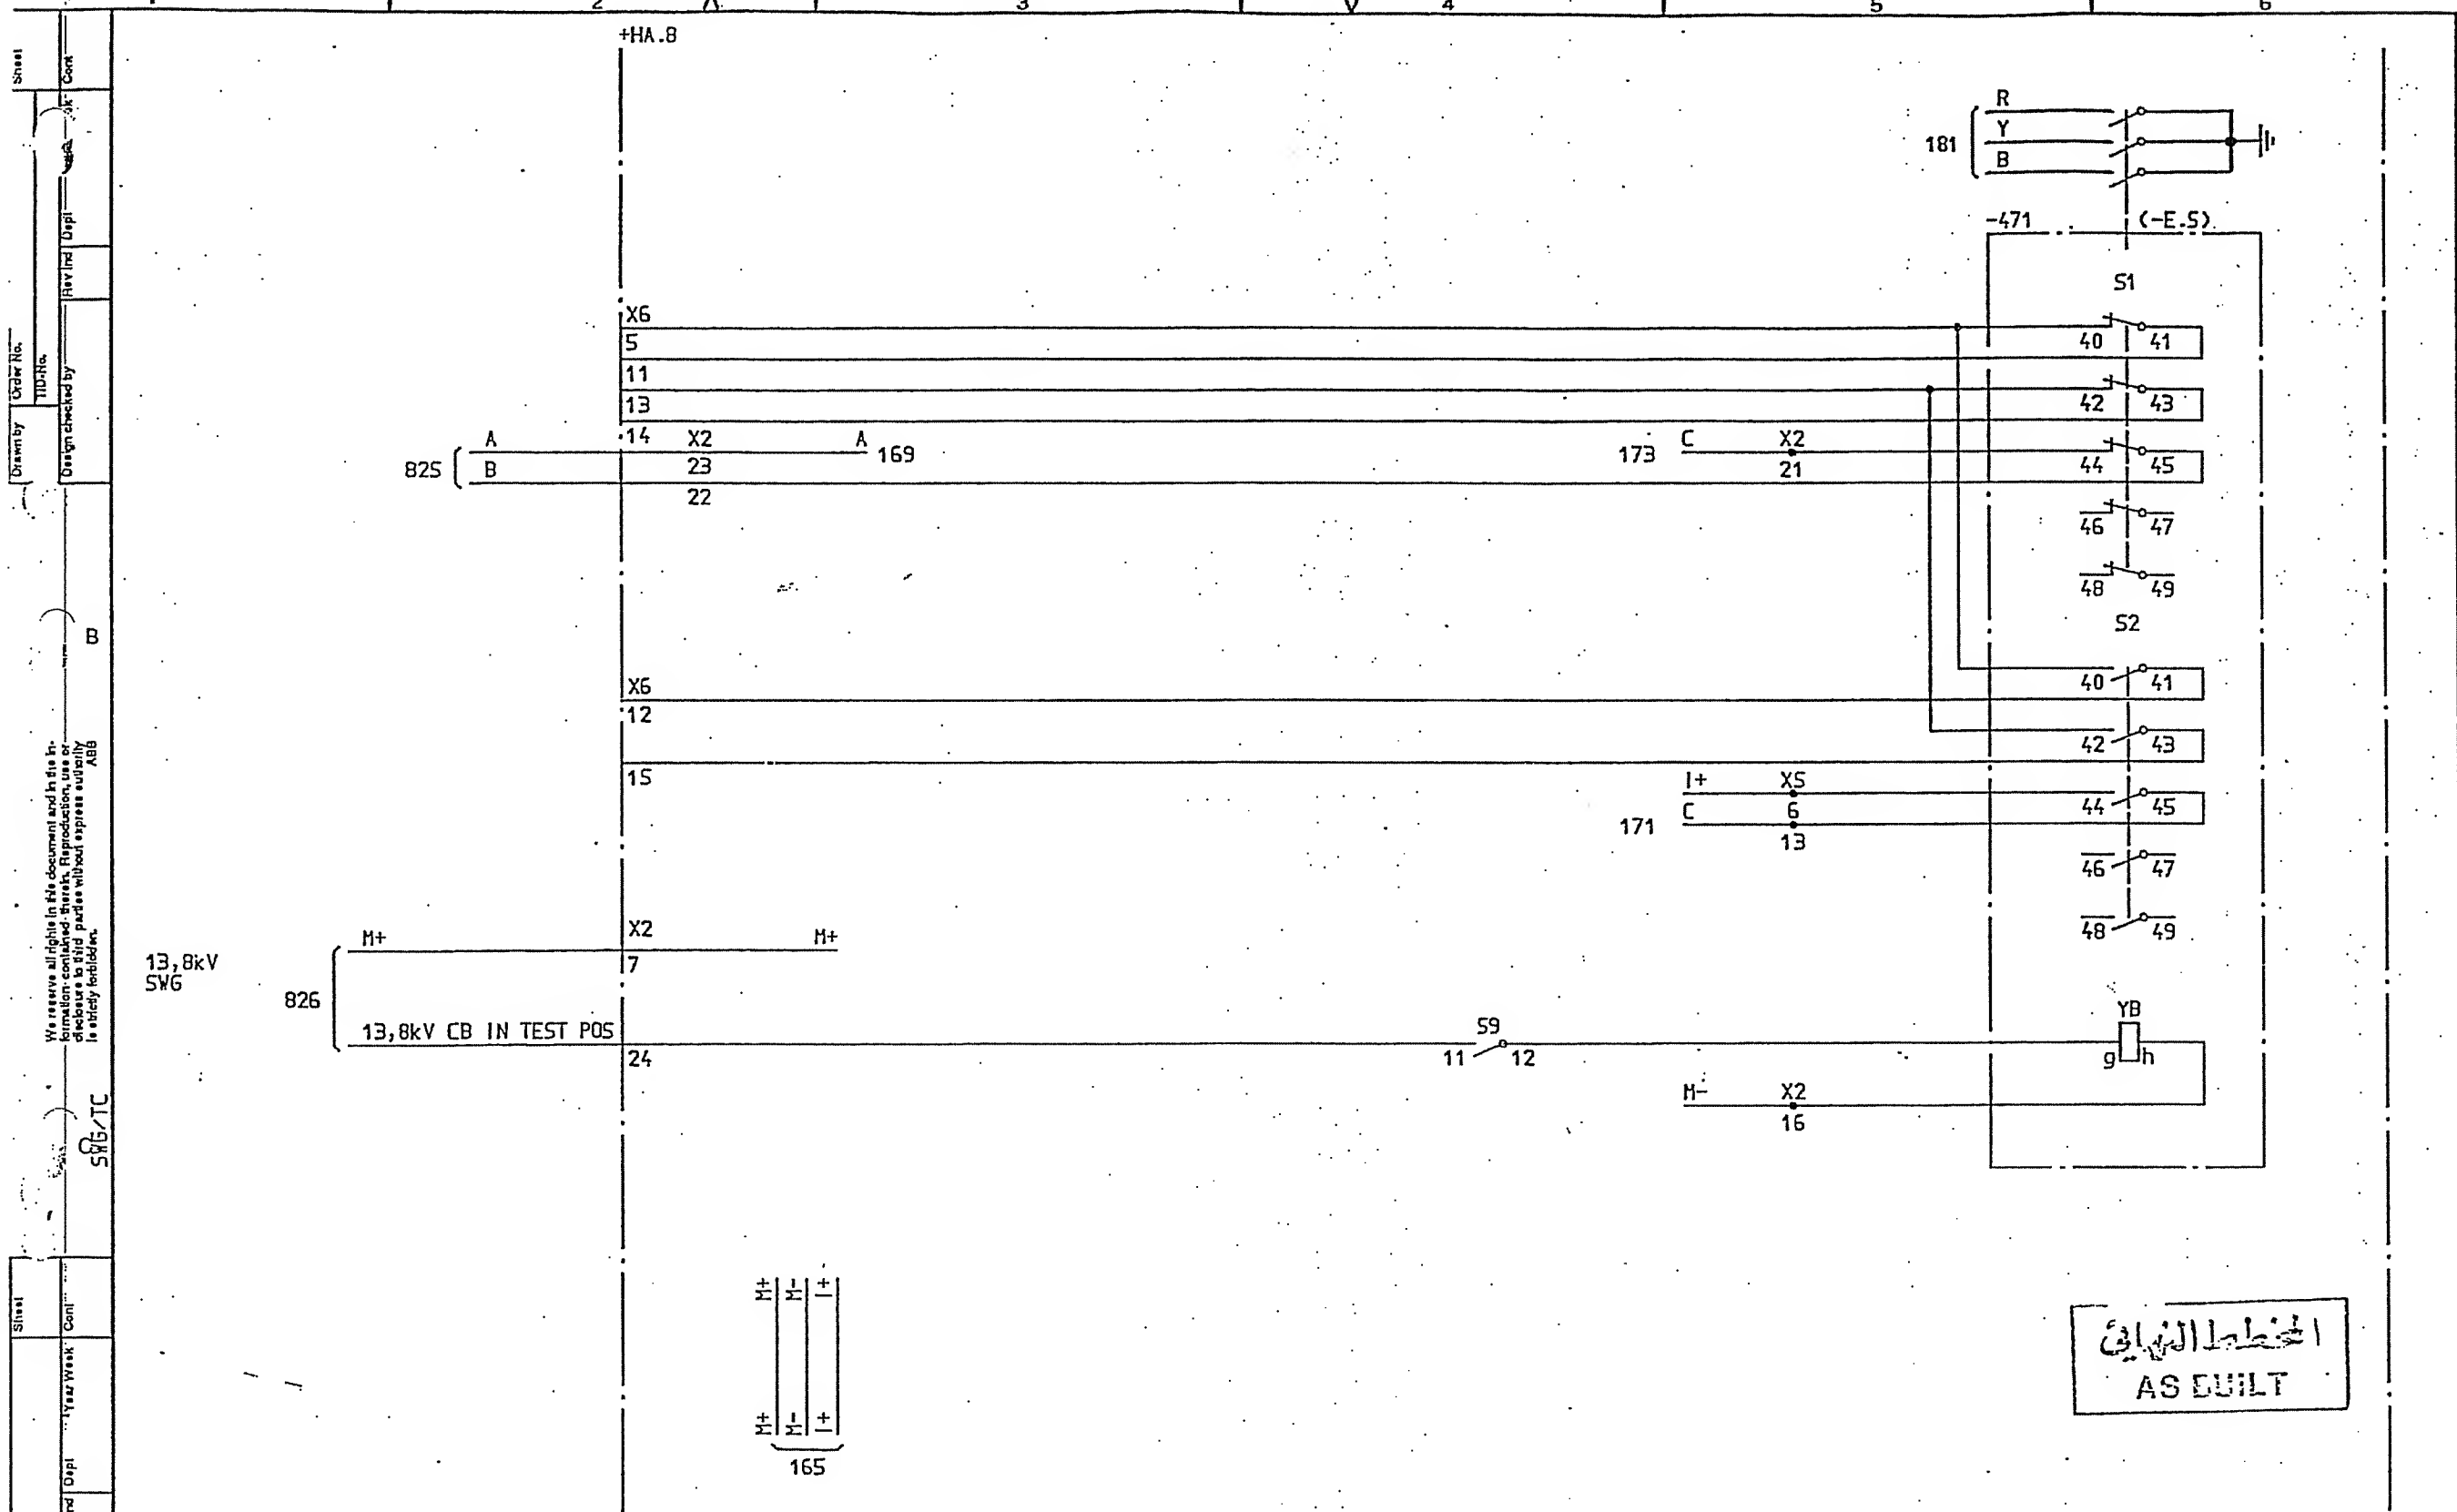

| | | | | | | | | | |
|---------------------------------|------------|----------------|-----------|--------------------------------|-------------------------------|--|-----------|----------------|--------------|
| SYMBOL ID /D:XL824028-FBR:174/0 | | 92-07-02 18.53 | | Design checked by B NILSSON | | CIRCUIT DIAGRAM S/S 8501 132/33kV SCECO CENTRAL SAUDI ARABIA | | Rev Ind Sheet | |
| 2 | SCECO SNAG | LS | 92 26 | =4 | 33/13,8kV TRANSFORMER BAY T12 | Drawing checked by L SVENSSON | | L 9743:1017 | Lang Sheet |
| 1 | AS BUILT | LS | 91 21 | | | Drawn by PN | | XL 824 028-FBR | Rev Ind Cont |
| Rev Ind Revision | | Appd | Year Week | EARTH SWITCH EQUIPMENT -471 | | Iss by Dept | Year Week | 2 | 175 |
| | | 2 | V | | | TDCF | 90 36 | | |


Drawn by J. BB

Sheet 174

We reserve all rights in this document and in the information contained therein. Reproduction, use or disclosure to third parties without express authority is strictly forbidden.

Design checked by
TDCF

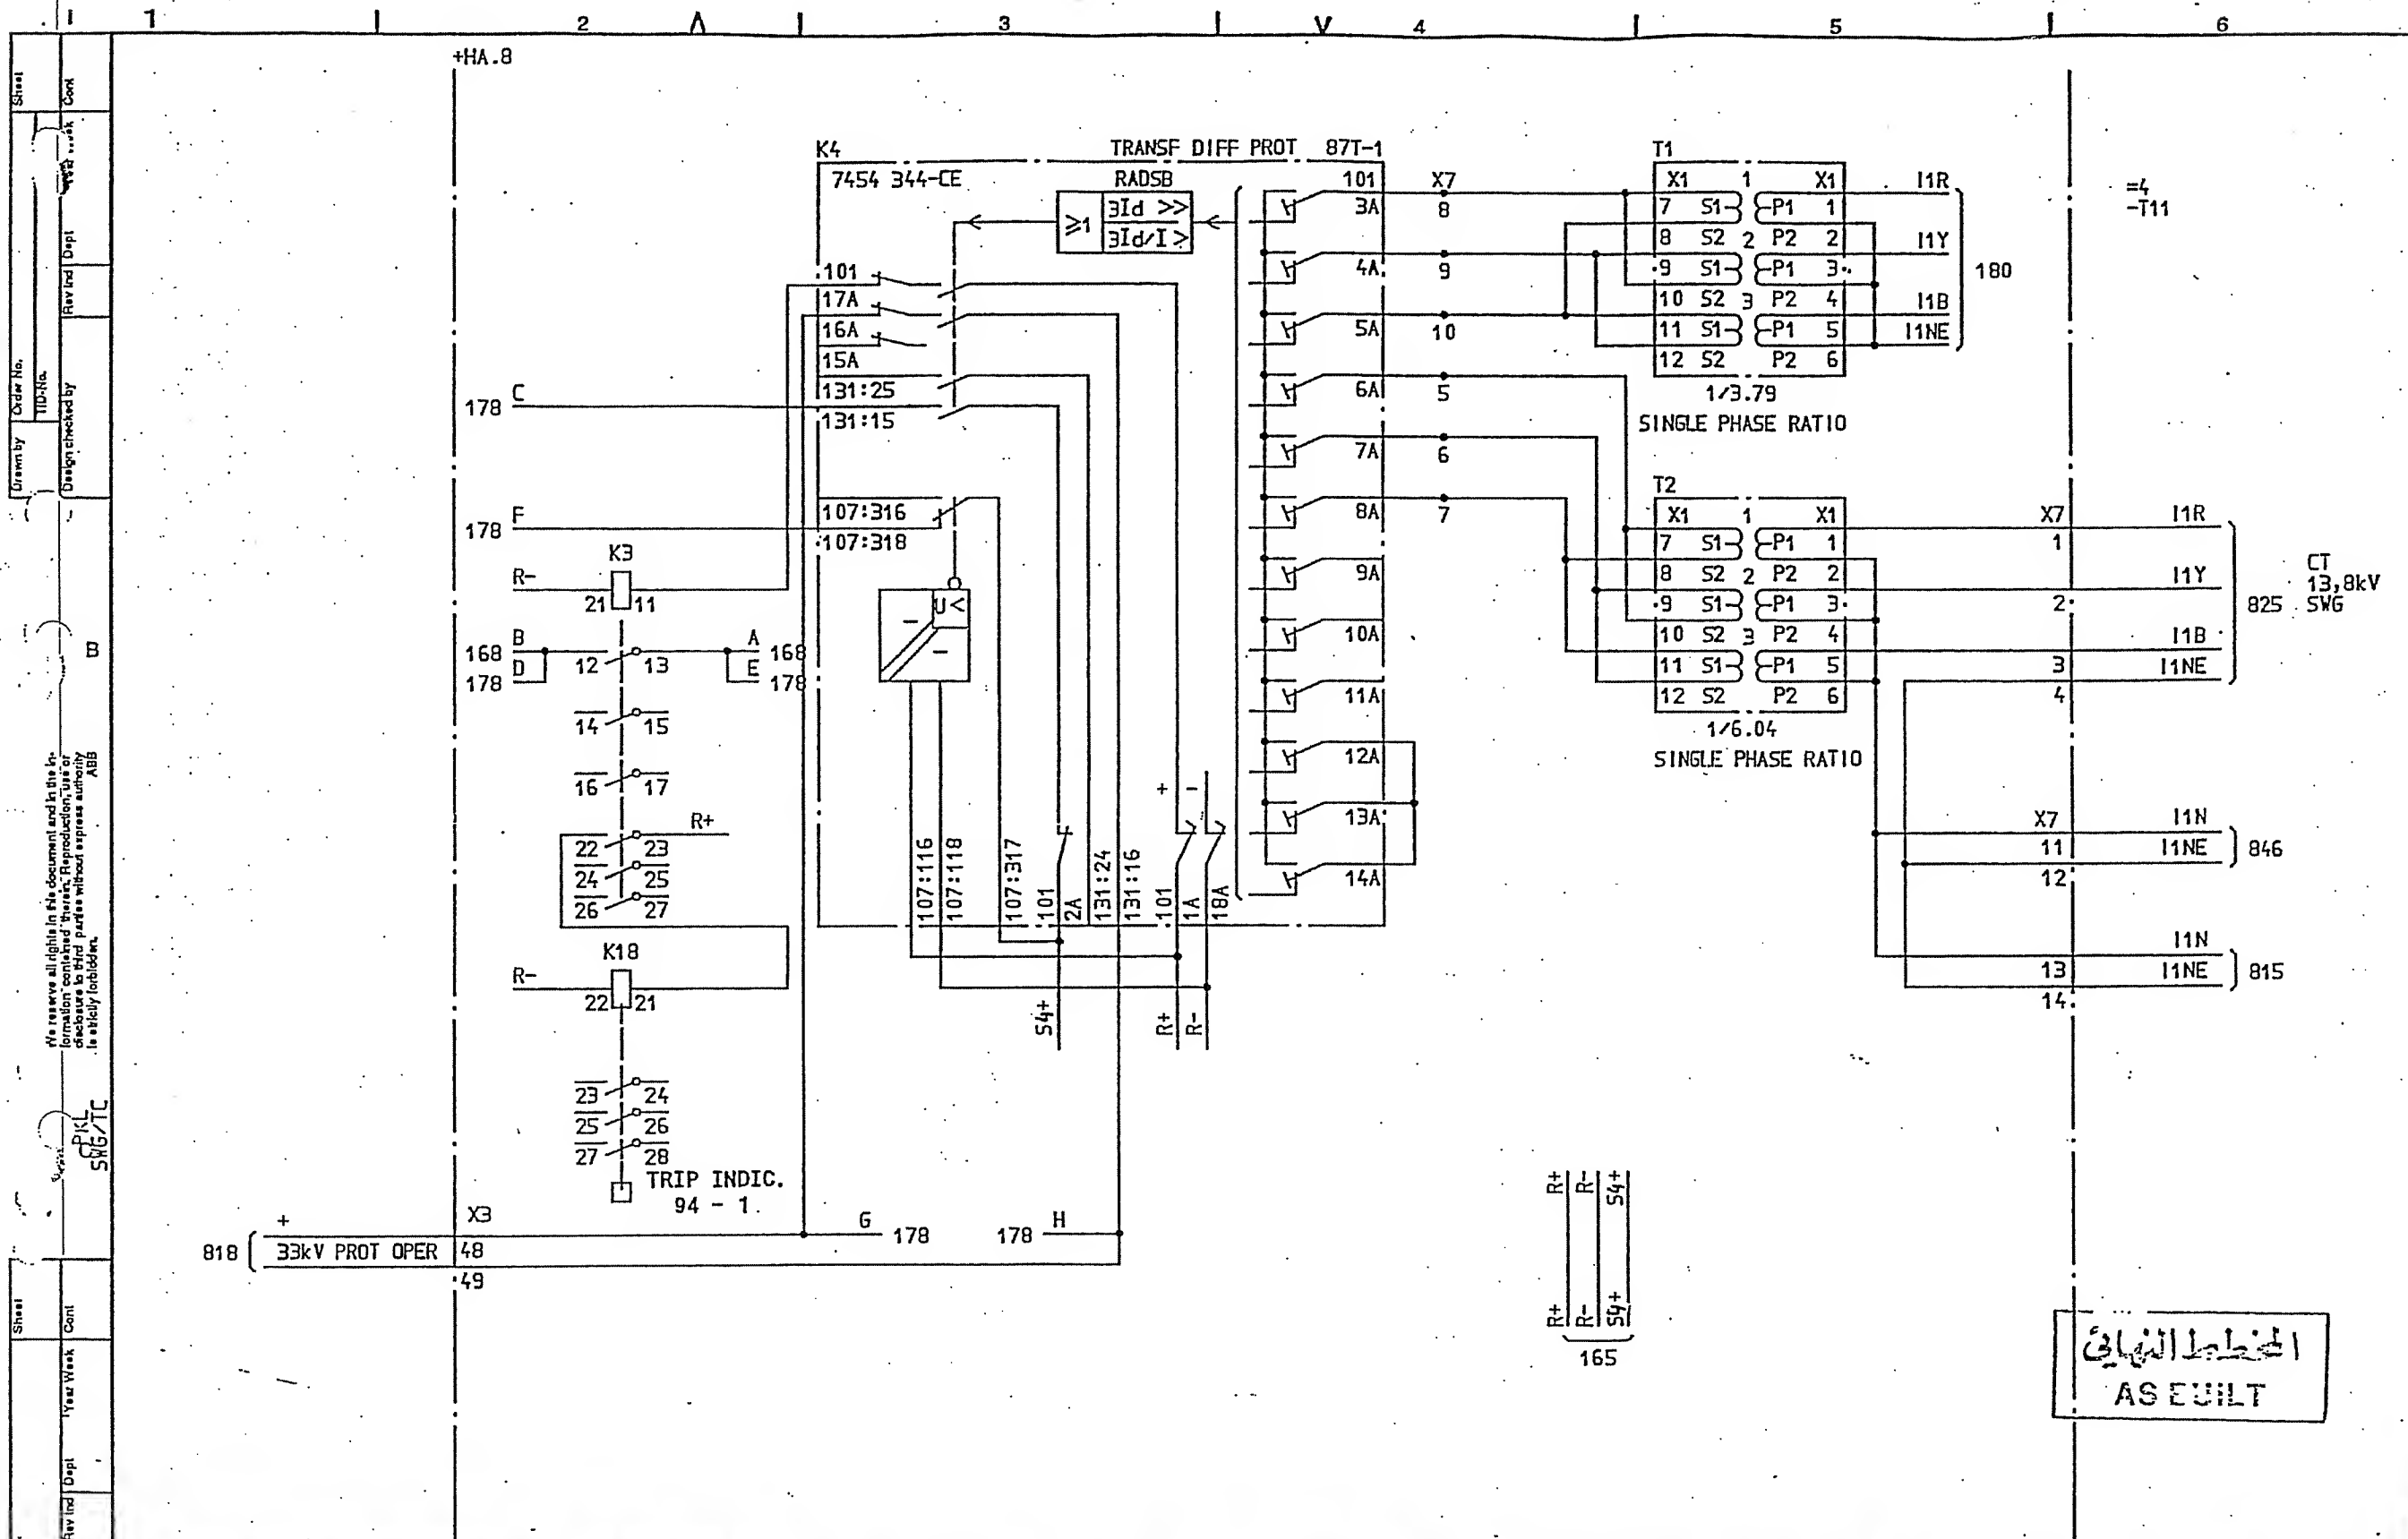Sheet 174



SYMBOL ID 20:XL924028-FBR:177/0

92-07-02 19.54

| | | | | |
|---------|------------|------|-----------|-------------------------------|
| 2 | SCECO SNAG | LS | 92 26 | 33/13,8kV TRANSFORMER BAY T12 |
| 1 | AS BUILT | LS | 91 21 | TRANSFORMER DIFFERENTIAL PROT |
| Rev Ind | Revision | Appd | Year Week | |

Design checked by
B NILSSON
Drawing checked by
L SVENSSON
Drawn by
SK


CIRCUIT DIAGRAM
S/S 8501 132/33kV
SCECO CENTRAL SAUDI ARABIA

ABB HV SWITCHGEAR

Iss by Dept Year Week
TDCF 90 16


L 9743.1017
XL 824 028-FBR

| | |
|---------|-------|
| Rev Ind | Sheet |
| Lang | 177 |
| Rev Ind | Cont |
| 2 | 178 |

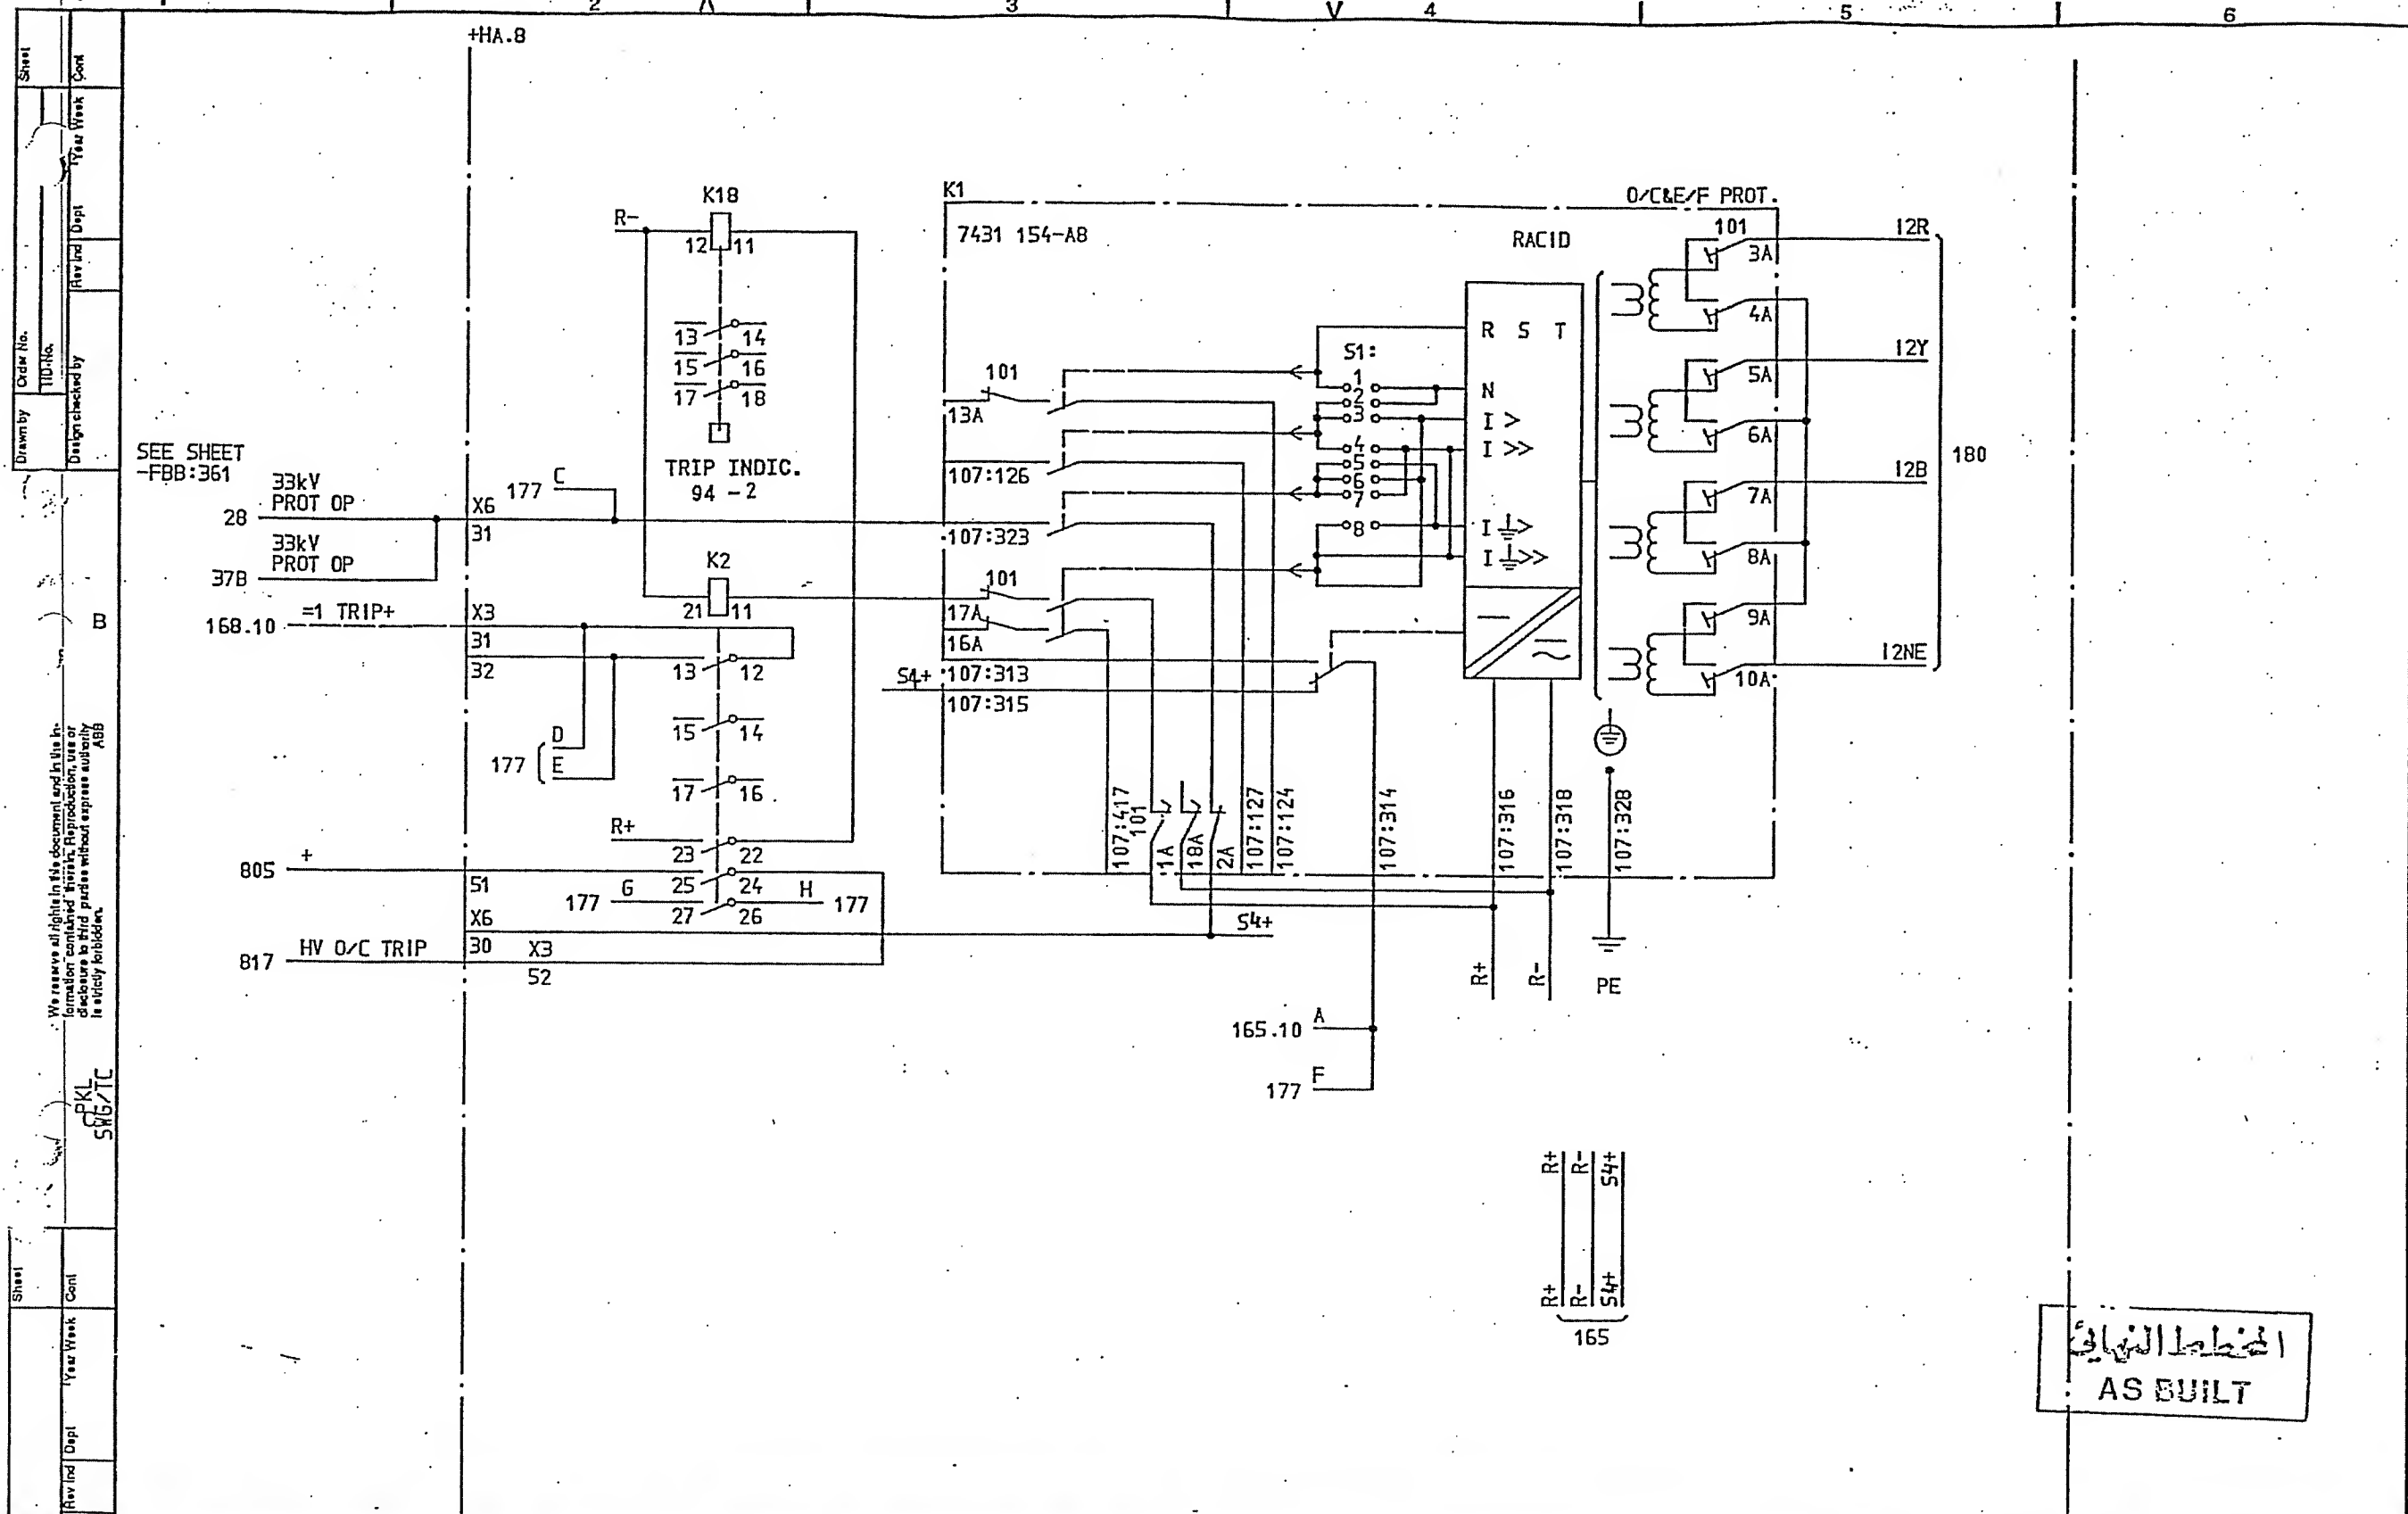


الخط النهائي
AS BUILT

| | | | | | |
|---------------------------------|------------|----------------|-------|-------------------------------|--|
| SYMBOL ID /D:XL824028-FBR:178/0 | | 92-07-02 18.54 | | =4 | |
| 2 | SCECO SNAG | LS | 92 26 | 33/13,8kV TRANSFORMER BAY T12 | |
| 1 | AS BUILT | LS | 91 21 | OVERCURRENT PROT 33kV | |
| Design checked by | | B NILSSON | | CIRCUIT DIAGRAM | |
| Drawing checked by | | L SVENSSON | | S/S 8501 132/33kV | |
| Drawn by | | SK | | SCECO CENTRAL SAUDI ARABIA | |
| Rev Ind | | Revision | | ABB HV SWITCHGEAR TDCF 90 16 | |
| 2 | | 2 | | L 9743.1017 | |
| | | | | XL 824 028-FBR | |
| | | | | 2 180 | |

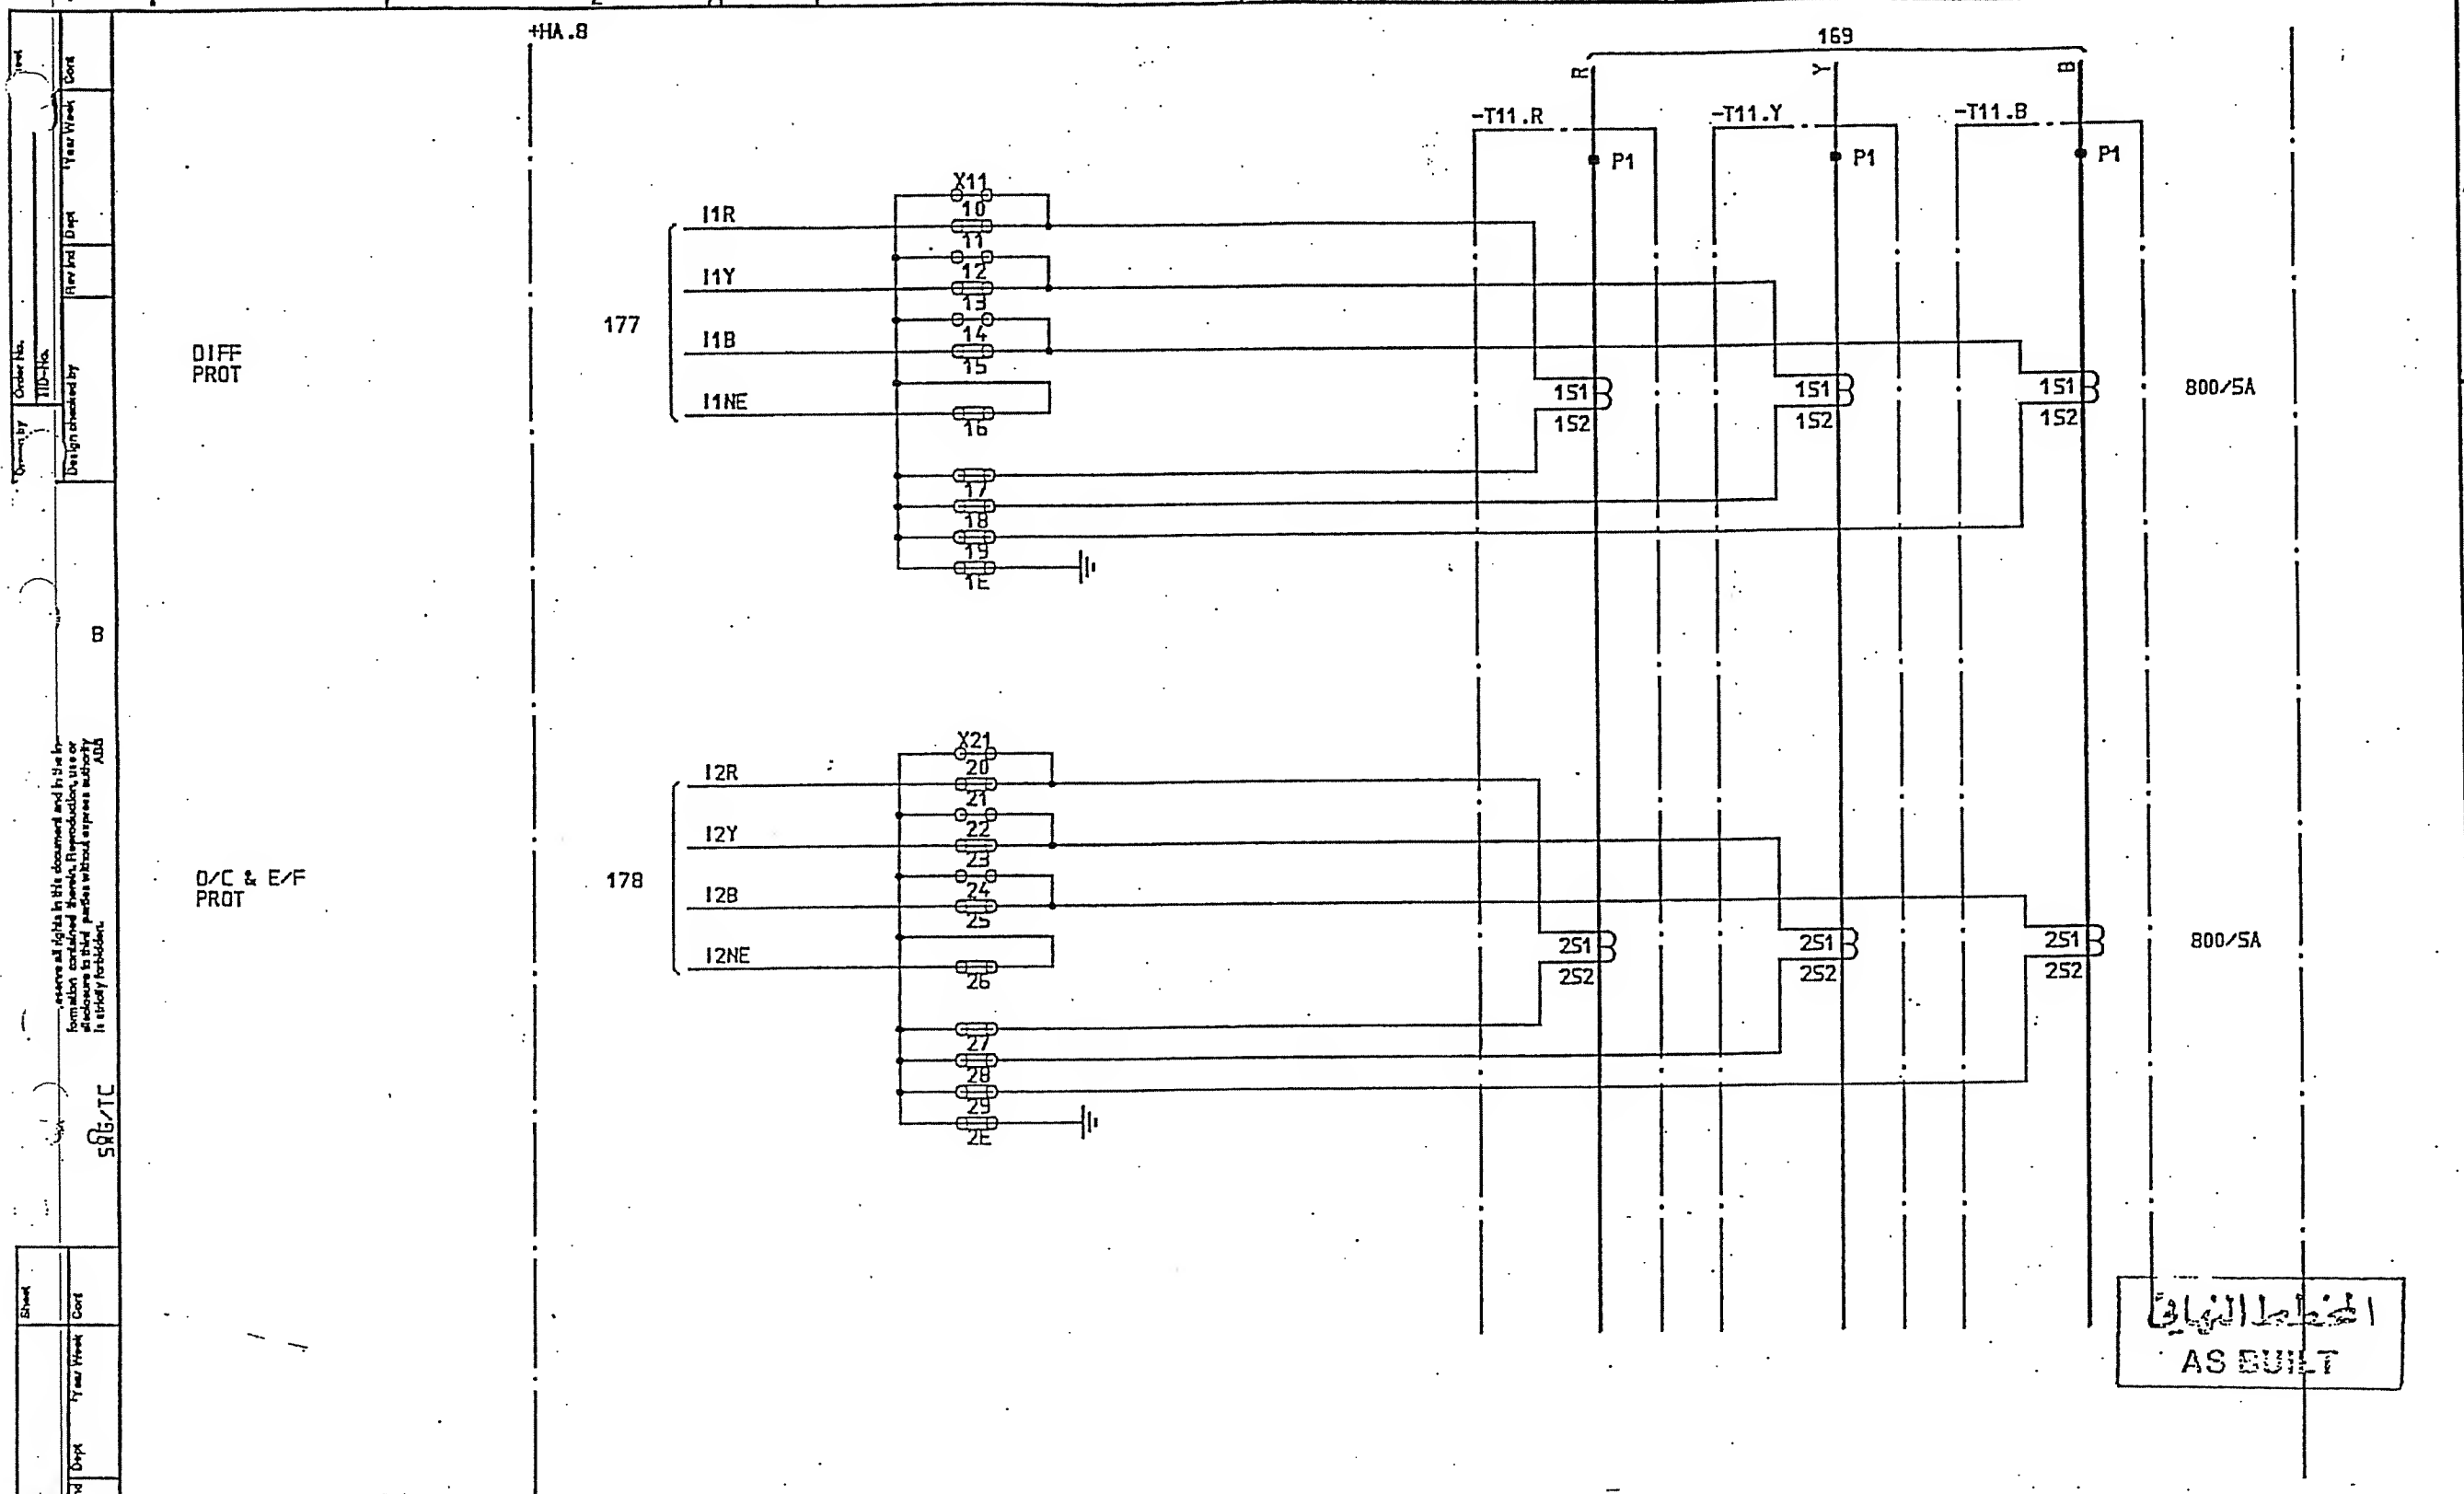


المخطط الكهربائي
AS BUILT

| | | | | | | | | | |
|---------------------------------|--|-------------------------------|--|----------------------------------|--|----------------------------|--|---------------|--|
| SYMBOL 10 /D:XL824028-FBR:180/0 | | DATE 91-06-04 09.07 | | Design checked by B NILSSON | | CIRCUIT DIAGRAM | | Rev Ind Sheet | |
| =4 | | 33/13,8kV TRANSFORMER 8AY T12 | | Drawing checked by L SVENSSON | | S/S 8501 132/33kV | | Lang Sheet | |
| 1 AS BUILT | | L5 91 21 | | Drawn by PN | | SCECO CENTRAL SAUDI ARABIA | | 180 | |
| CURRENT TRANSFORMER -T11 | | 2 | | PN | | ABB HV SWITCHGEAR | | 181 | |
| | | | | | | TOCF 90 36 | | | |

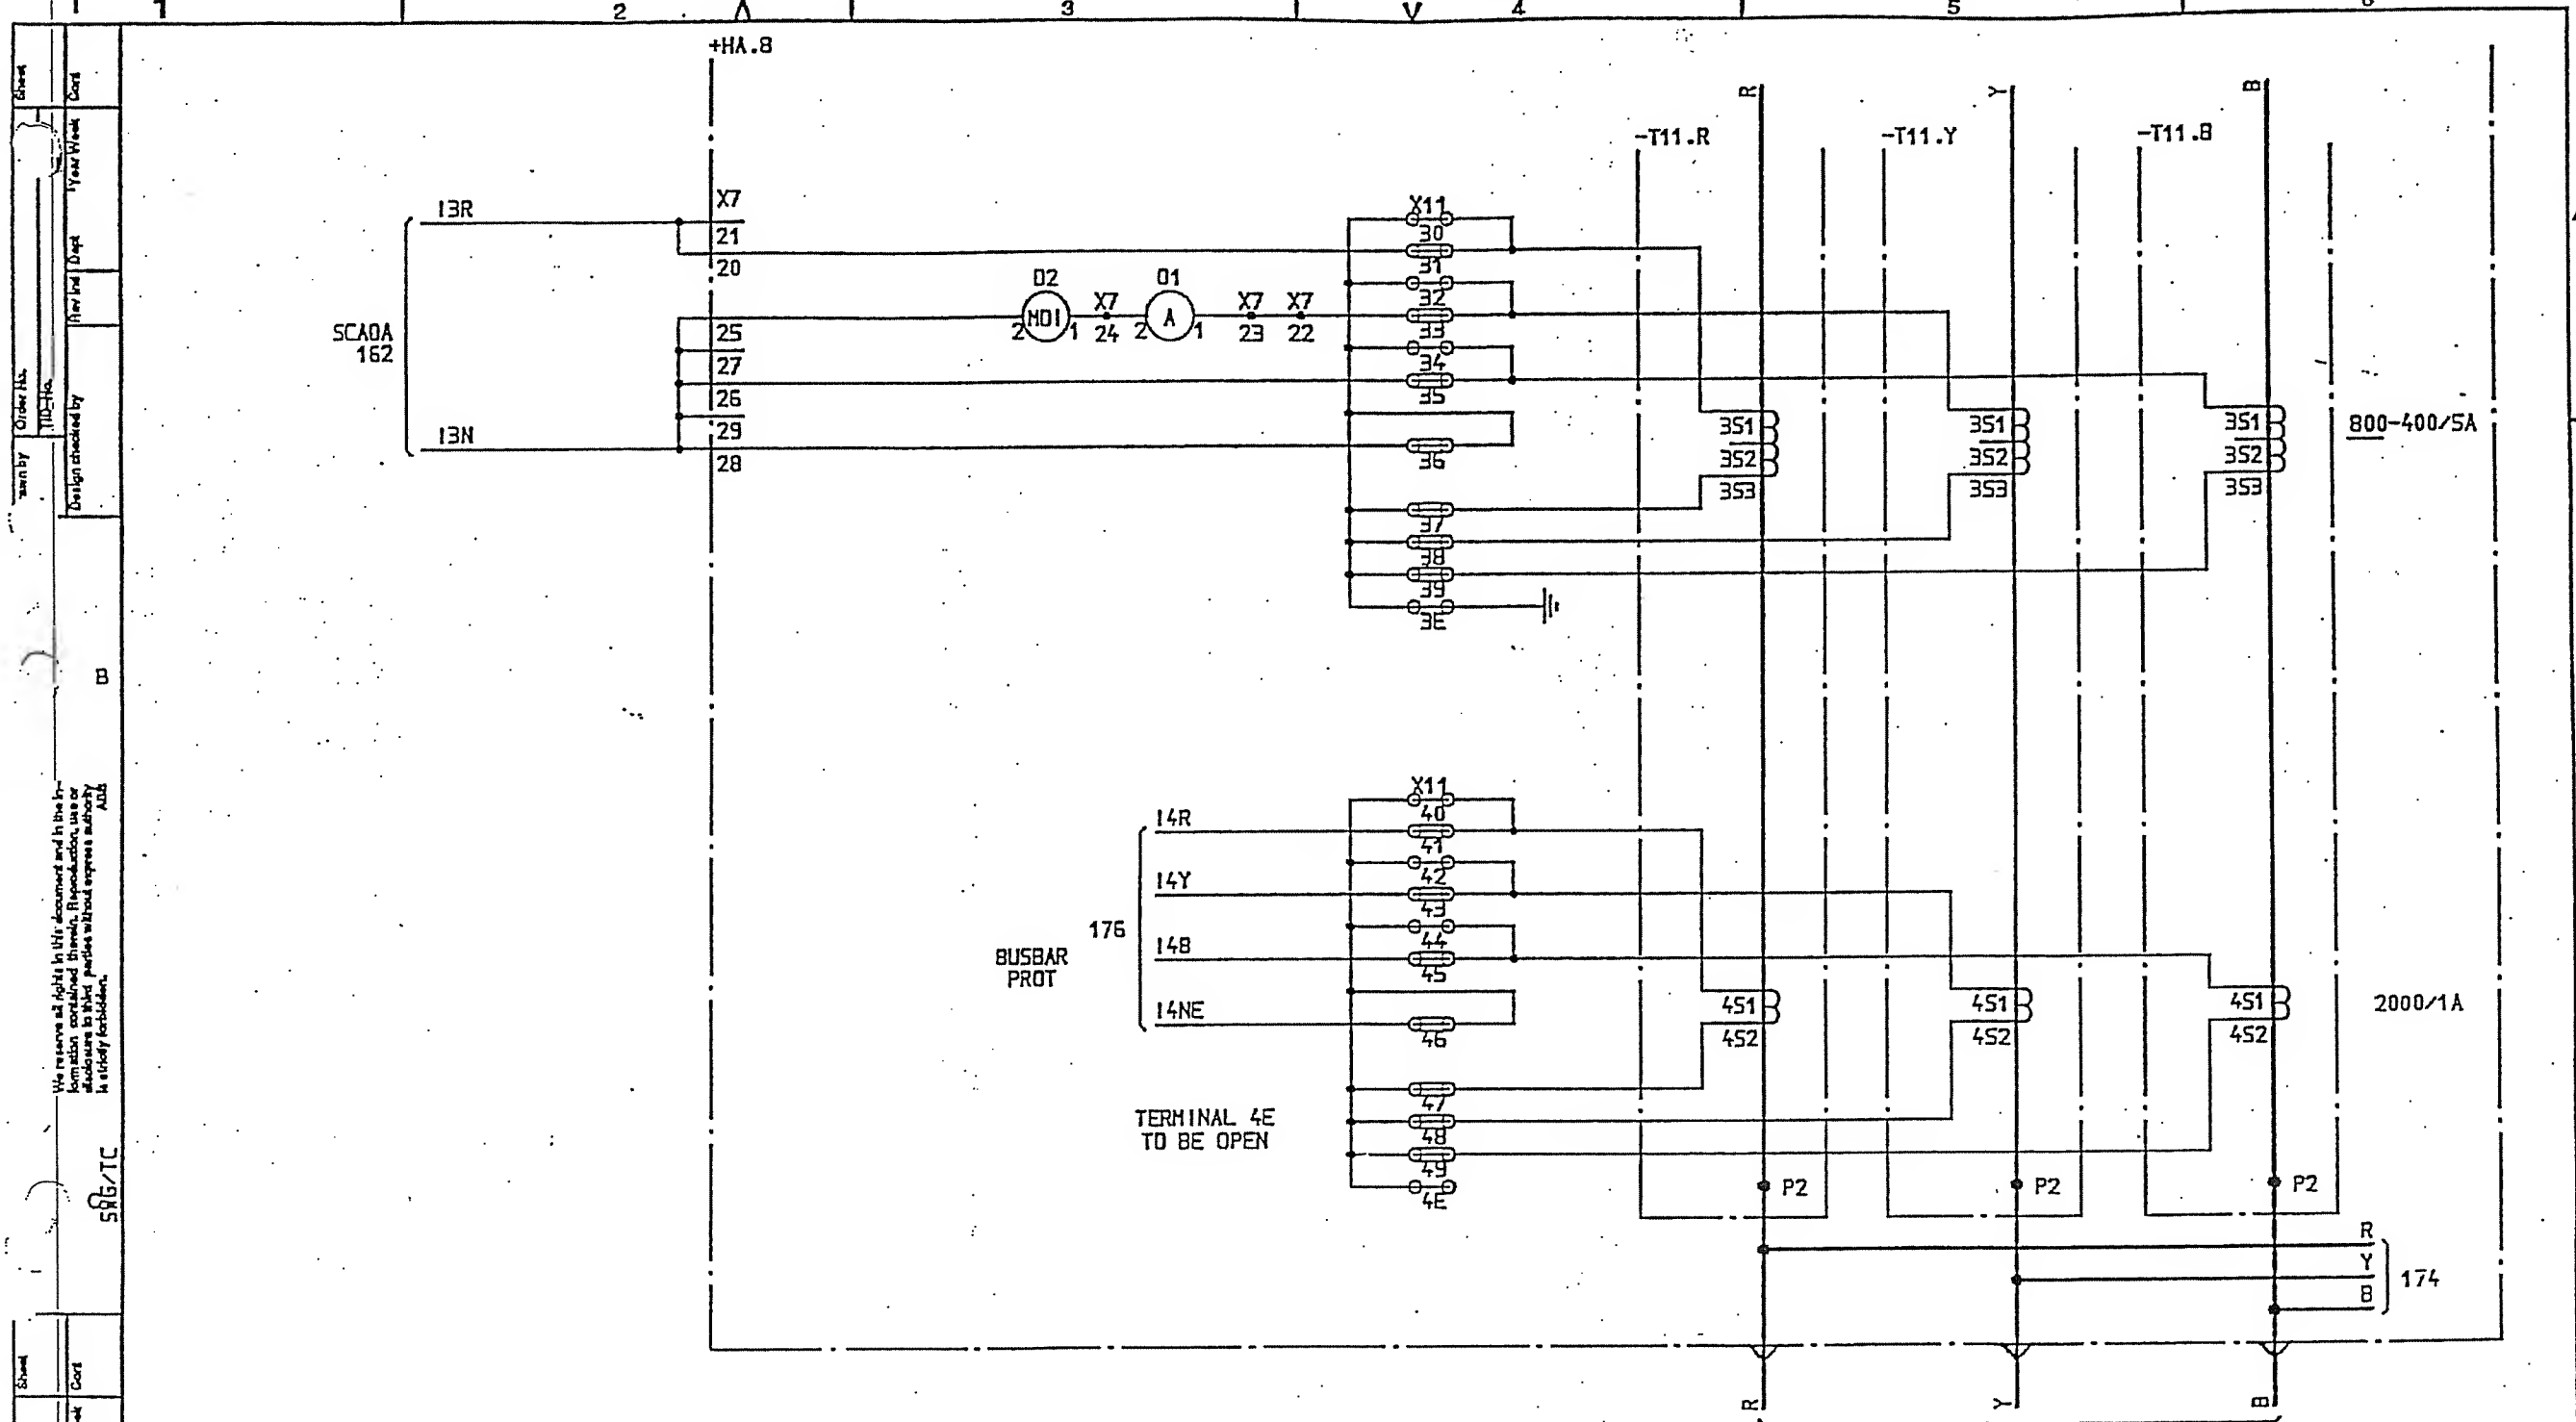

المخطط النهائي
AS BUILT

| | | | | | | | | | |
|---------------------------------|--|-------------------------------|--|----------------------------------|--|--|--|------------------------------------|--|
| SYMBOL ID /0:XL824028-FBR:181/0 | | DATE 91-06-06 12.03 | | Design checked by B NILSSON | | CIRCUIT DIAGRAM S/S 8501 132/33kV SCECO CENTRAL SAUDI ARABIA | | Rev No. Sheet Lang Sheet 181 | |
| AS BUILT | | LS 91 21 | | Drawing checked by L SVENSSON | | SCECO CENTRAL SAUDI ARABIA | | L 9743.1017 | |
| =4 | | 33/13,8kV TRANSFORMER BAY T12 | | Drawn by PN | | ABB HV SWITCHGEAR | | XL 824 028-FBR | |
| CURRENT TRANSFORMER -T11 | | Appd Year Week | | Rev No. Sheet | | 1 212 | | ABB | |

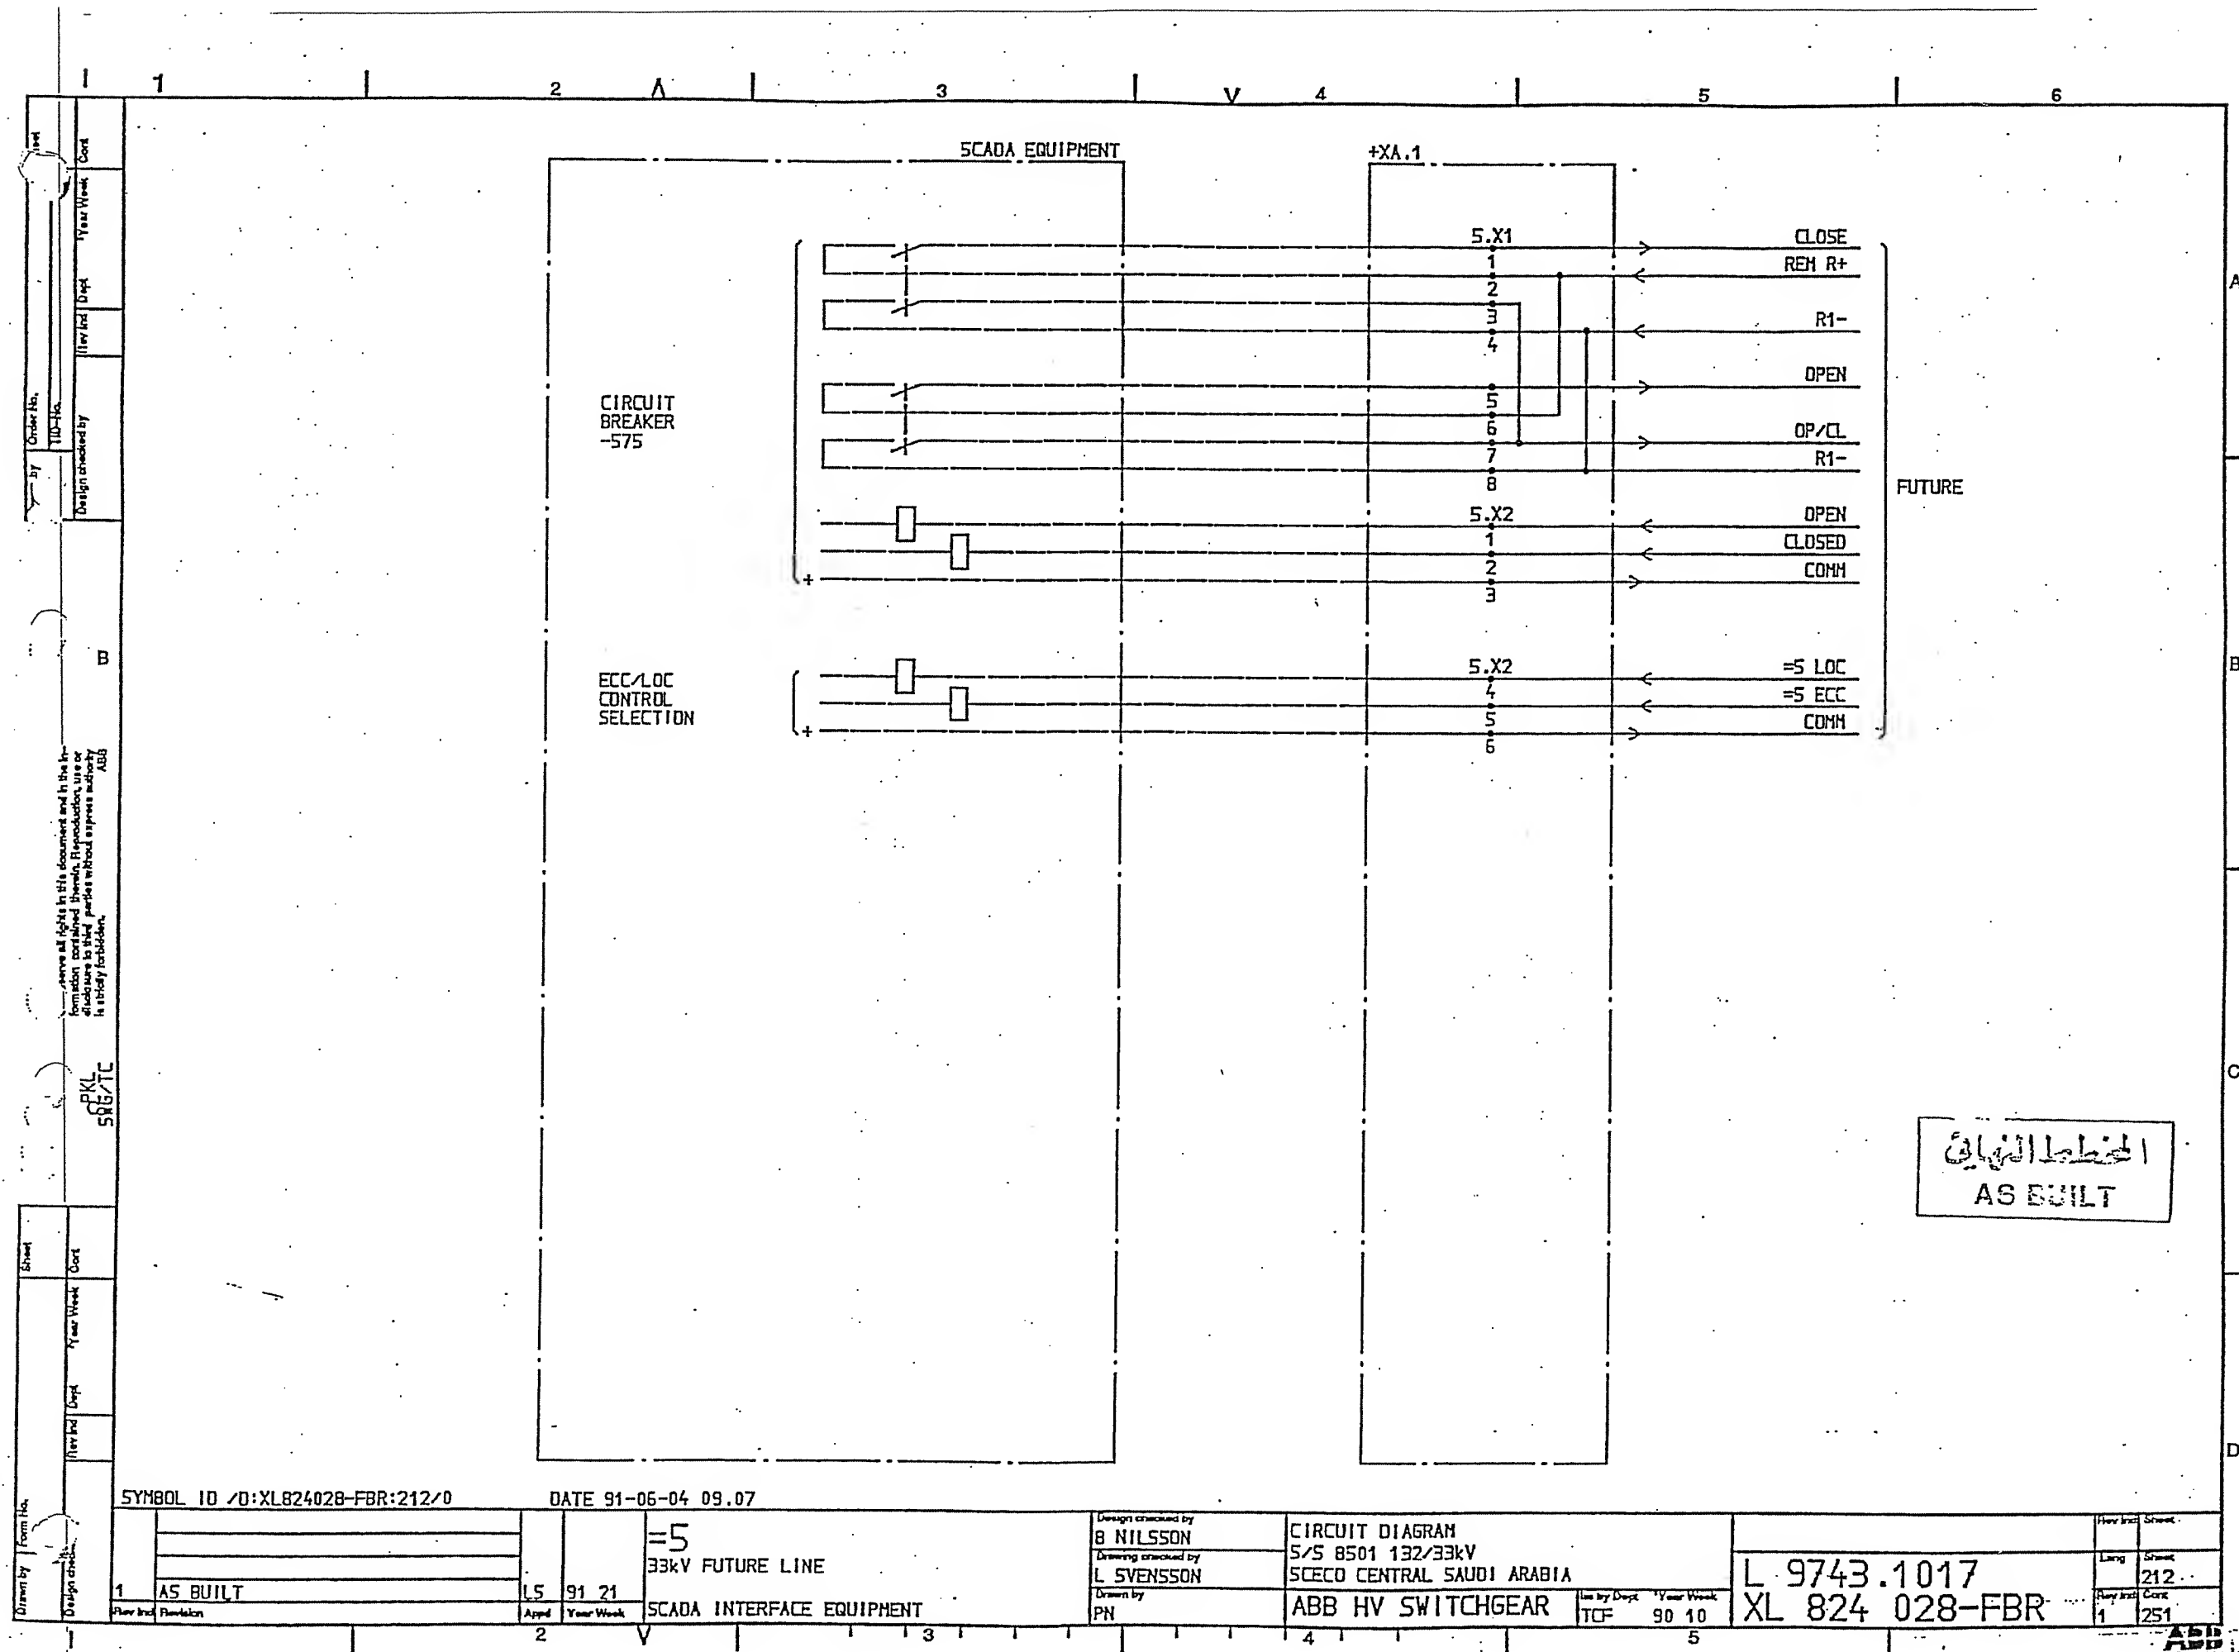

| | | | | | | | | | | | | | |
|---------------------------------|--|---------------------|--|------------------|--|----------------------------------|--|--------------------------------|--|----------------------------|--|----------------|--|
| SYMBOL ID /0:XL824028-F8R:251/0 | | DATE 91-06-04 09.07 | | =6 | | 33kV INTERCONNECTOR LINE | | Design checked by B NILSSON | | CIRCUIT DIAGRAM | | How Incl Sheet | |
| 1 AS BUILT | | 15 91 21 | | LIST OF CONTENTS | | Design checked by S STRIOSHAN | | S/S 8501 132/33kV | | SCECO CENTRAL SAUDI ARABIA | | Lang Sheet | |
| 1 | | 15 | | 1 | | 1A | | ABB HV SWITCHGEAR | | TCF 90 10 | | How Incl Sheet | |
| 1 | | 15 | | 1 | | 1A | | 5 | | 5 | | 1 251 | |
| 1 | | 15 | | 1 | | 1A | | 5 | | 5 | | 1 254 | |

المخطط النهائي

AS BUILT

| ITEM | DESIGNATION | SHEET |
|-------|------------------------------------|-------|
| +R8.4 | HEATING AND LIGHTING RELAY CUBICLE | 254 |
| | VOLTAGE DISTRIBUTION RELAY CUBICLE | 255 |
| +XA.1 | SCADA INTERFACE EQUIPMENT | 262 |
| +HA.9 | AUX. VOLTAGE SUPPLY | 265 |
| | HEATING AND LIGHTING | 266 |
| | C.B. OPERATION CIRCUITS | 268 |
| -575 | CIRCUIT BREAKER EQUIPMENT | 269 |
| | INTERLOCKING | 273 |
| -571 | EARTH SWITCH EQUIPMENT | 274 |
| | TRIP RELAYS | 278 |
| -T11 | CURRENT TRANSFORMER | 280 |
| +R8.4 | DISTANCE PROTECTION | 282 |
| | AUTO RECLOSE RELAY | 285 |
| | OVERCURRENT AND EARTH FAULT PROT | 287 |

| | | | |
|--|--|---------------------------|--|
| Order No. _____ TID No. _____ Design checked by _____ Rev Ind Dept Year Week Cont | | Sheet _____ Cont _____ | |
| We reserve all rights in this document and in the information contained therein. Reproduction, use or disclosure in third parties without express authority is strictly forbidden. | | | |
| B PKL SBE/TC | | AS BUILT | |

| ITEM | DESIGNATION | SHEET |
|--------|-------------------------------|-------|
| +XA.1 | SCADA INTERFACE EQUIPMENT | 362 |
| +HA.12 | AUX. VOLTAGE SUPPLY | 365 |
| | HEATING AND LIGHTING | 366 |
| | C.B. OPERATION CIRCUITS | 368 |
| -875 | CIRCUIT BREAKER EQUIPMENT | 369 |
| | INTERLOCKING | 373 |
| -871 | EARTH SWITCH EQUIPMENT | 374 |
| | TRANSFORMER DIFFERENTIAL PROT | 377 |
| | OVERCURRENT PROT | 378 |
| -T11 | CURRENT TRANSFORMER | 380 |

المحطة النهائية
 AS BUILT

| | | | |
|---|--|---|--|
| SYMBOL ID /D:XL824028-FBR:351/0 | | DATE 91-06-04 09.09 | |
| 1 AS BUILT Rev Ind Revision | | 2 LS 91 21 Appd Year Week =8 33/13,8kV TRANSFORMER BAY T13 LIST OF CONTENTS | |
| Design checked by B NILSSON Drawing checked by S STRIDSHAN Drawn by IA | | CIRCUIT DIAGRAM S/S 8501 132/33kV SCECO CENTRAL SAUDI ARABIA ABB HV SWITCHGEAR Iss by Dept Year Week TCF 90 10 5 | |
| L 9743.1017 XL 824 028-FBR | | Rev Ind Sheet Lang Sheet 1 351 Rev Ind Cont 1 352 | |

123456

ABCD

123456


ABCD

| ITEM | DESIGNATION | SHEET |
|--------|-------------------------------|-------|
| +XA.1 | SCADA INTERFACE EQUIPMENT | 362 |
| +HA.12 | AUX. VOLTAGE SUPPLY | 365 |
| | HEATING AND LIGHTING | 366 |
| | C.B. OPERATION CIRCUITS | 368 |
| -B75 | CIRCUIT BREAKER EQUIPMENT | 369 |
| | INTERLOCKING | 373 |
| -B71 | EARTH SWITCH EQUIPMENT | 374 |
| | TRANSFORMER DIFFERENTIAL PROT | 377 |
| | OVERCURRENT PROT | 378 |
| -T11 | CURRENT TRANSFORMER | 380 |


المخطط النهائي
AS BUILT

SYMBOL ID /0:XL824028-FBR:361/0
DATE 91-06-04 09.09

| | | | | | | | | |
|---|----------|----|-------|-------------------------------------|---|---|-------------------------------|----------------------|
| 1 | AS BUILT | 15 | 91 21 | =8 33/13,8kV TRANSFORMER BAY T13 | Design checked by B NILSSON Drawing checked by S STRIDSHAN Drawn by IA | CIRCUIT DIAGRAM S/S 8501 132/33kV SCECO CENTRAL SAUDI ARABIA ABB HV SWITCHGEAR | L 9743.1017 XL 824 028-FBR | Rev Indl 1 362 |
|---|----------|----|-------|-------------------------------------|---|---|-------------------------------|----------------------|

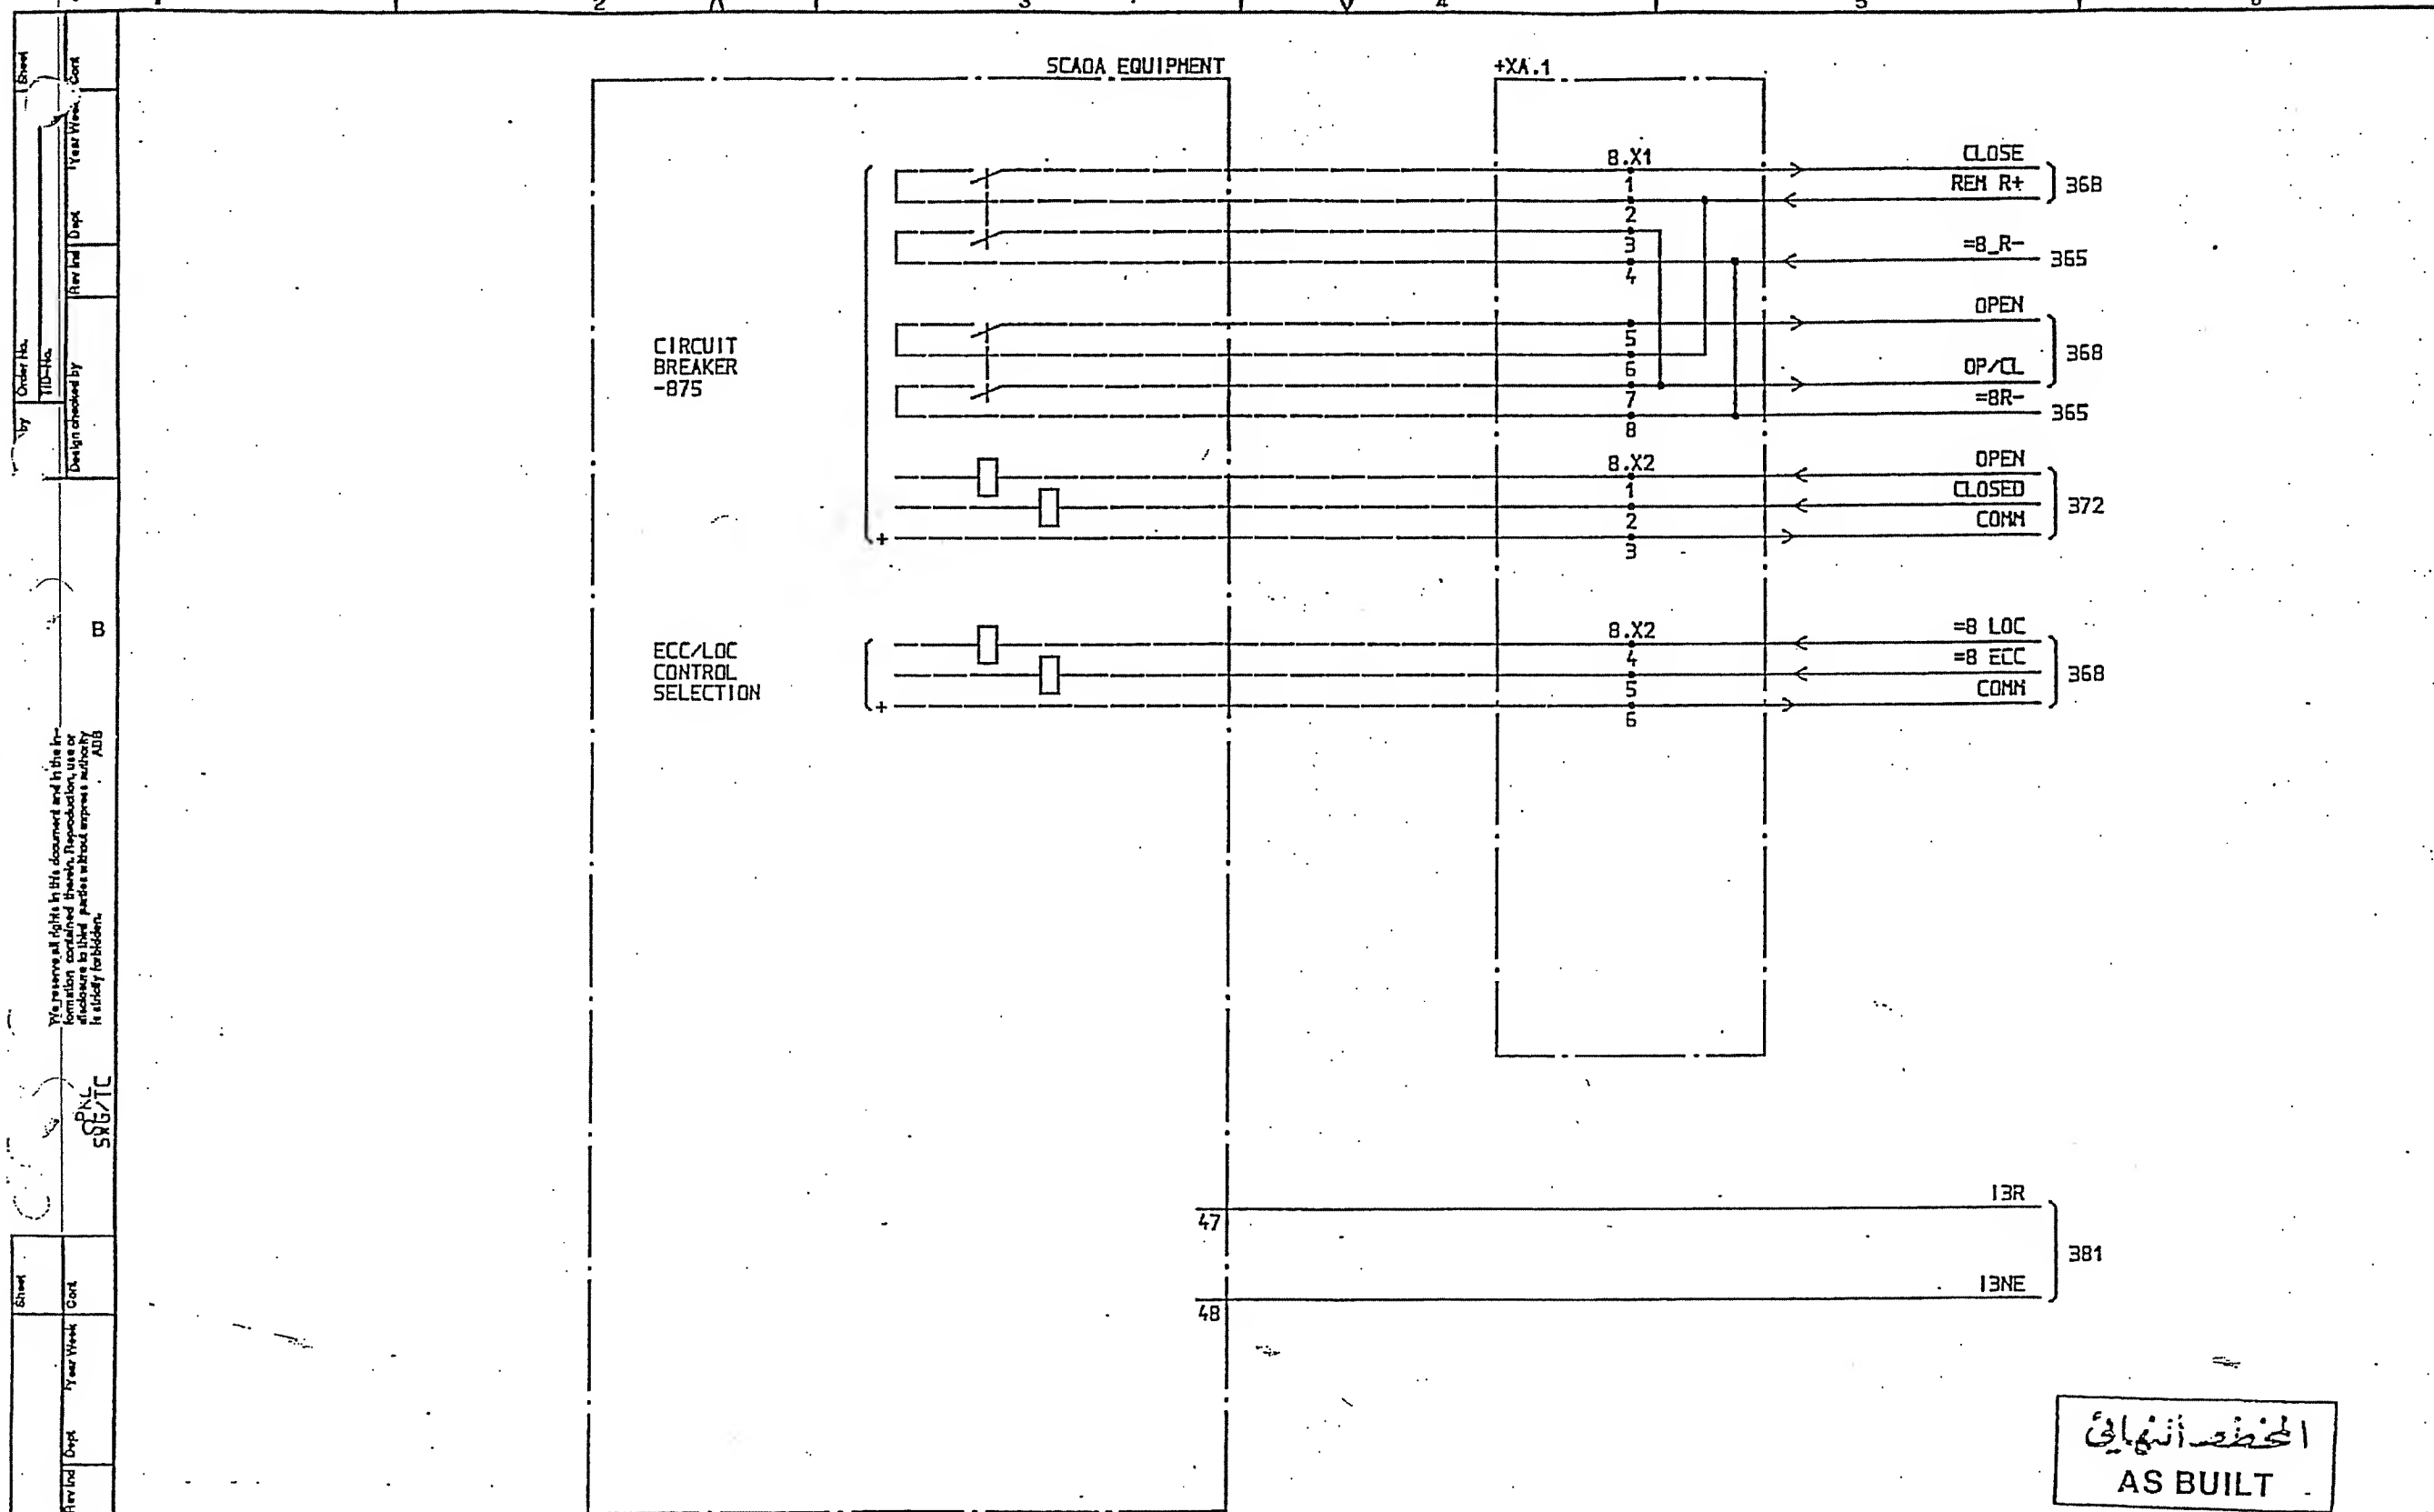

| | | | | | | | | | |
|---------------------------------|--|-------------------------------|--|-----------------------------------|--|--------------------|--|-----------------|--|
| SYMBOL 10 /0:XL824028-FBR:362/0 | | DATE 91-06-04 09.09 | | Design checked by B NILSSON | | CIRCUIT DIAGRAM | | How Incl. Sheet | |
| =9 | | 33/13,8kV TRANSFORMER BAY T13 | | Drawing checked by S STRIDSMAN | | S/S 8501 132/33kV | | Lang Sheet | |
| SCADA INTERFACE EQUIPMENT | | Drawn by IA | | Line by Dept TCF | | Year Week 90 10 | | Rev Incl. Cont | |
| 1 AS BUILT | | LS 91 21 | | L+9743.1017 | | XL 824 028-FBR | | 1 365 | |

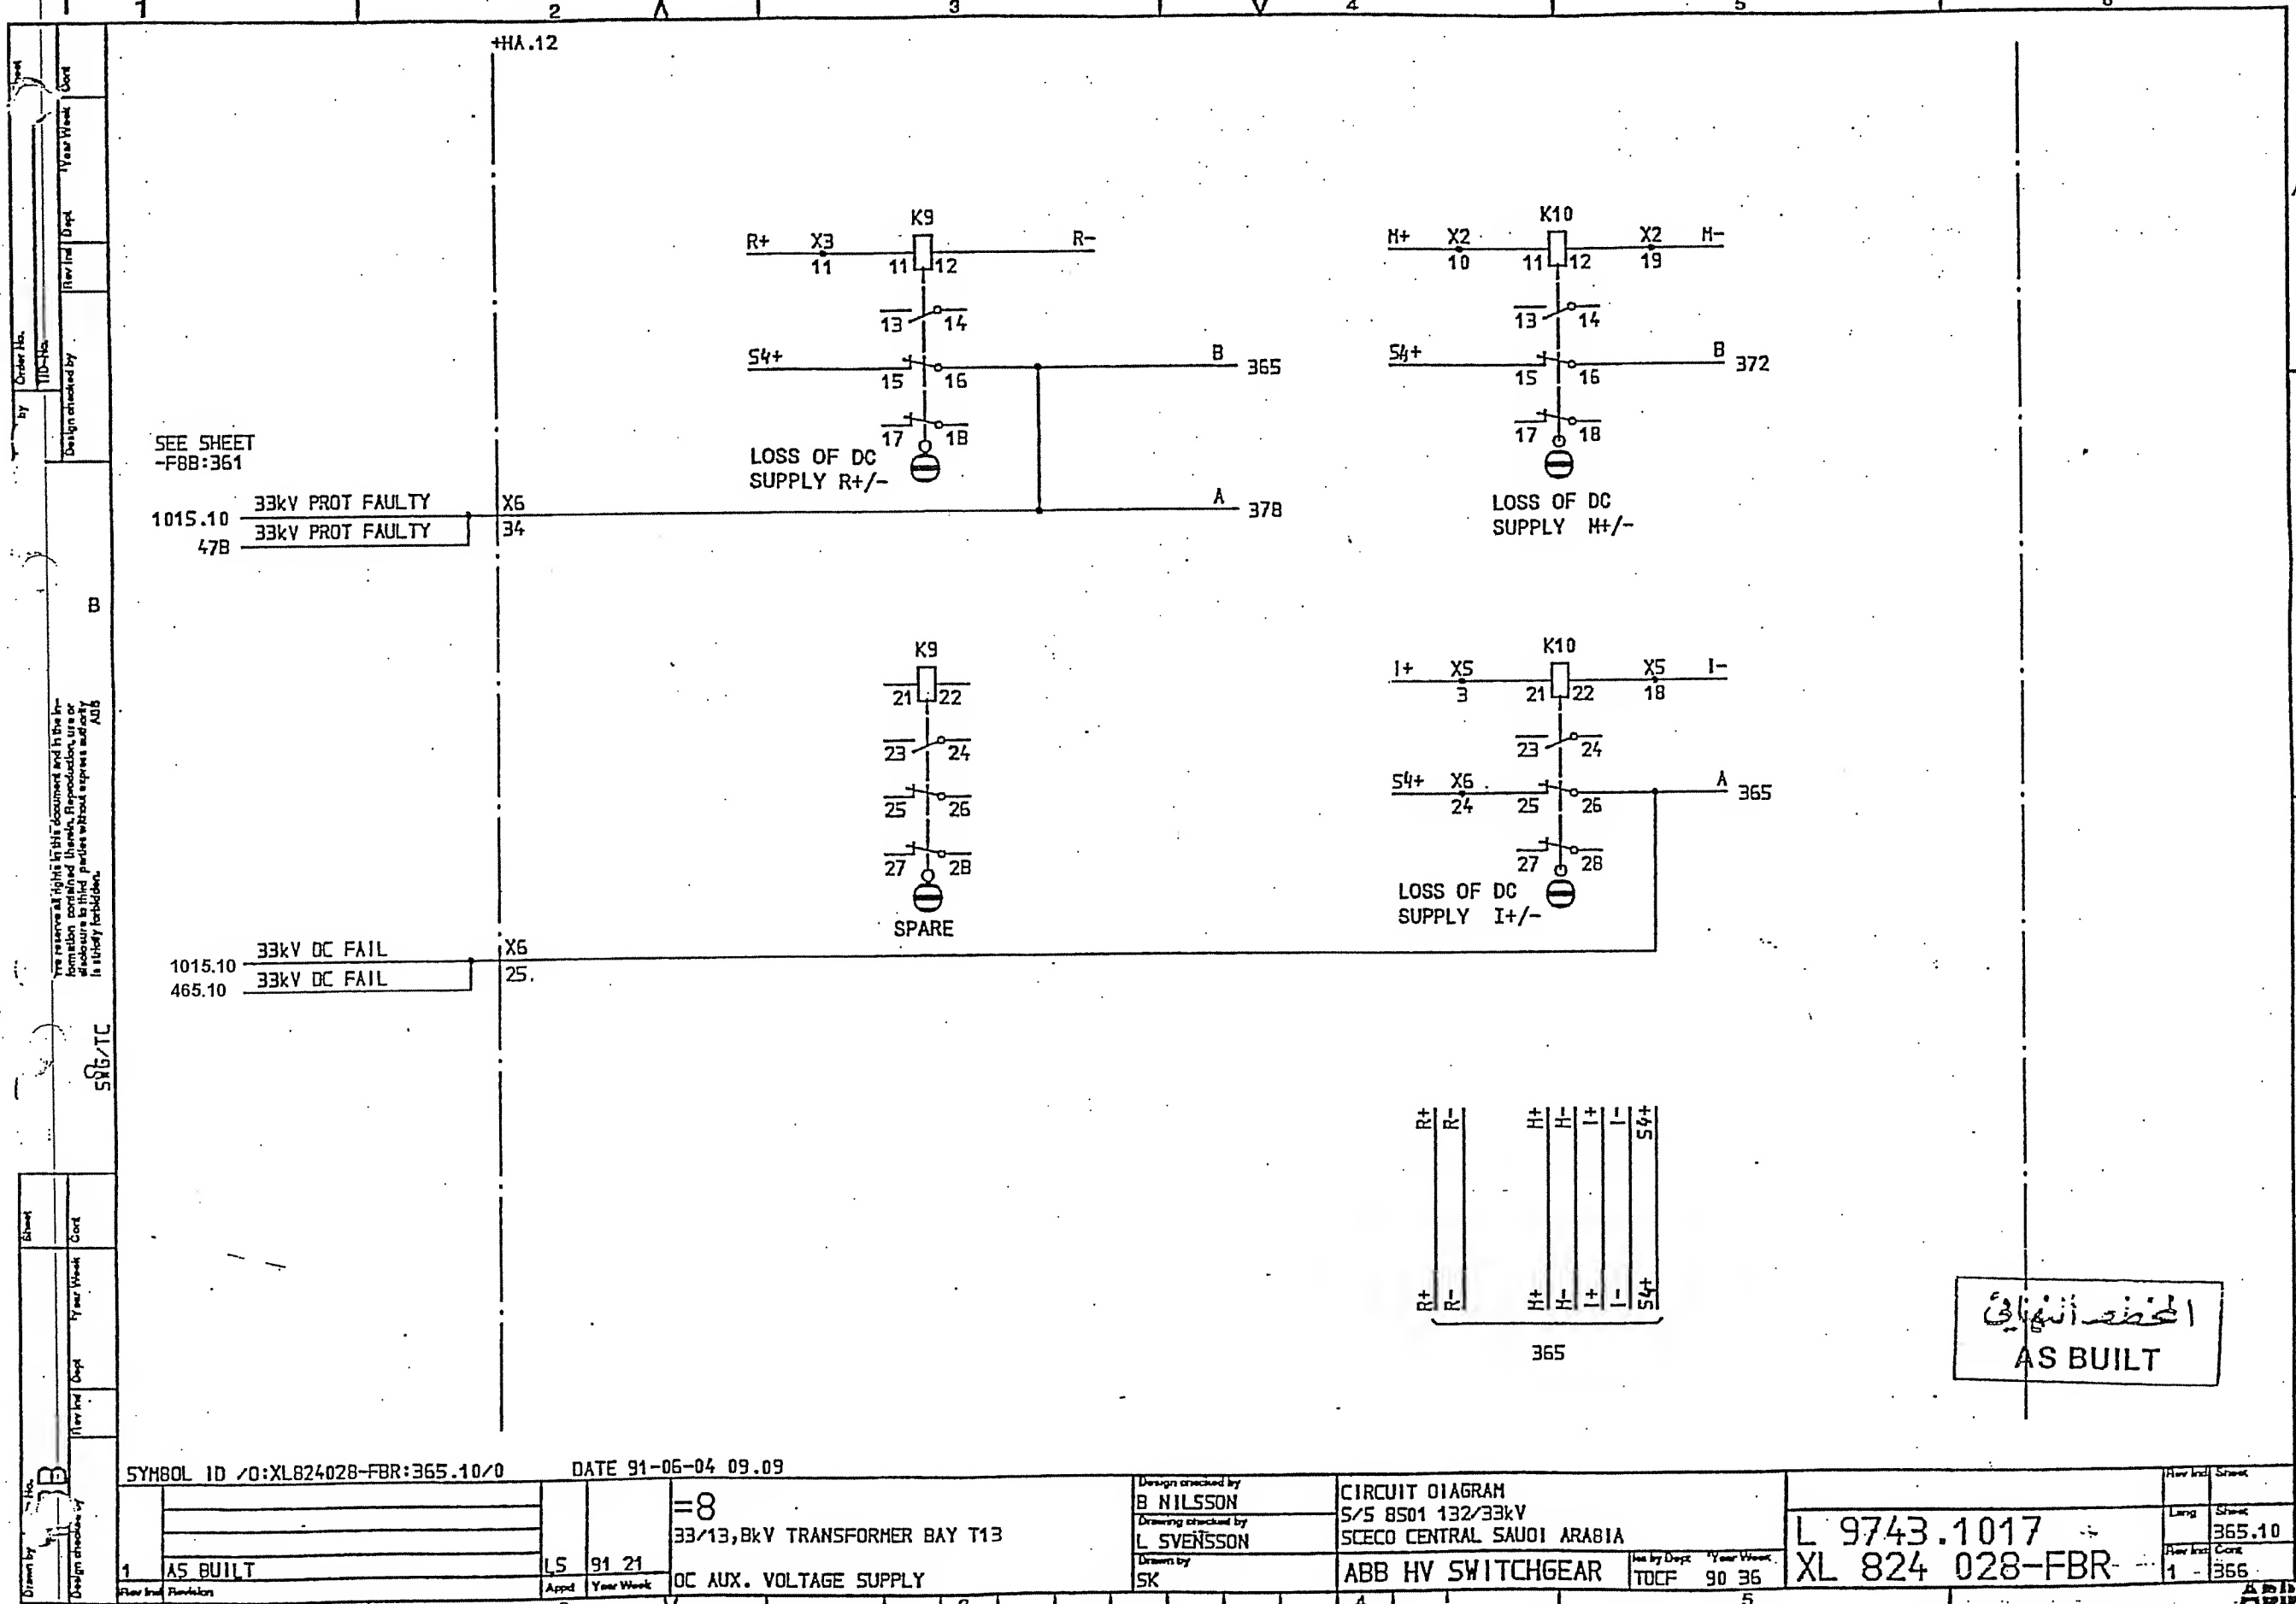

SYMBOL ID /O:XL824028-FBR:365.10/0

DATE 91-06-04 09.09

=8
 33/13,8kV TRANSFORMER BAY T13

DC AUX. VOLTAGE SUPPLY

Design checked by
 B NILSSON
 Drawing checked by
 L SVENSSON
 Drawn by
 SK


CIRCUIT DIAGRAM
 S/S 8501 132/33kV
 SCECO CENTRAL SAUDI ARABIA

ABB HV SWITCHGEAR

Iss by Dept Year Week
 TDCP 90 36

L 9743.1017
 XL 824 028-FBR

| Rev | Int | Sheet |
|-----|--------|-------|
| 1 | 365.10 | 366 |

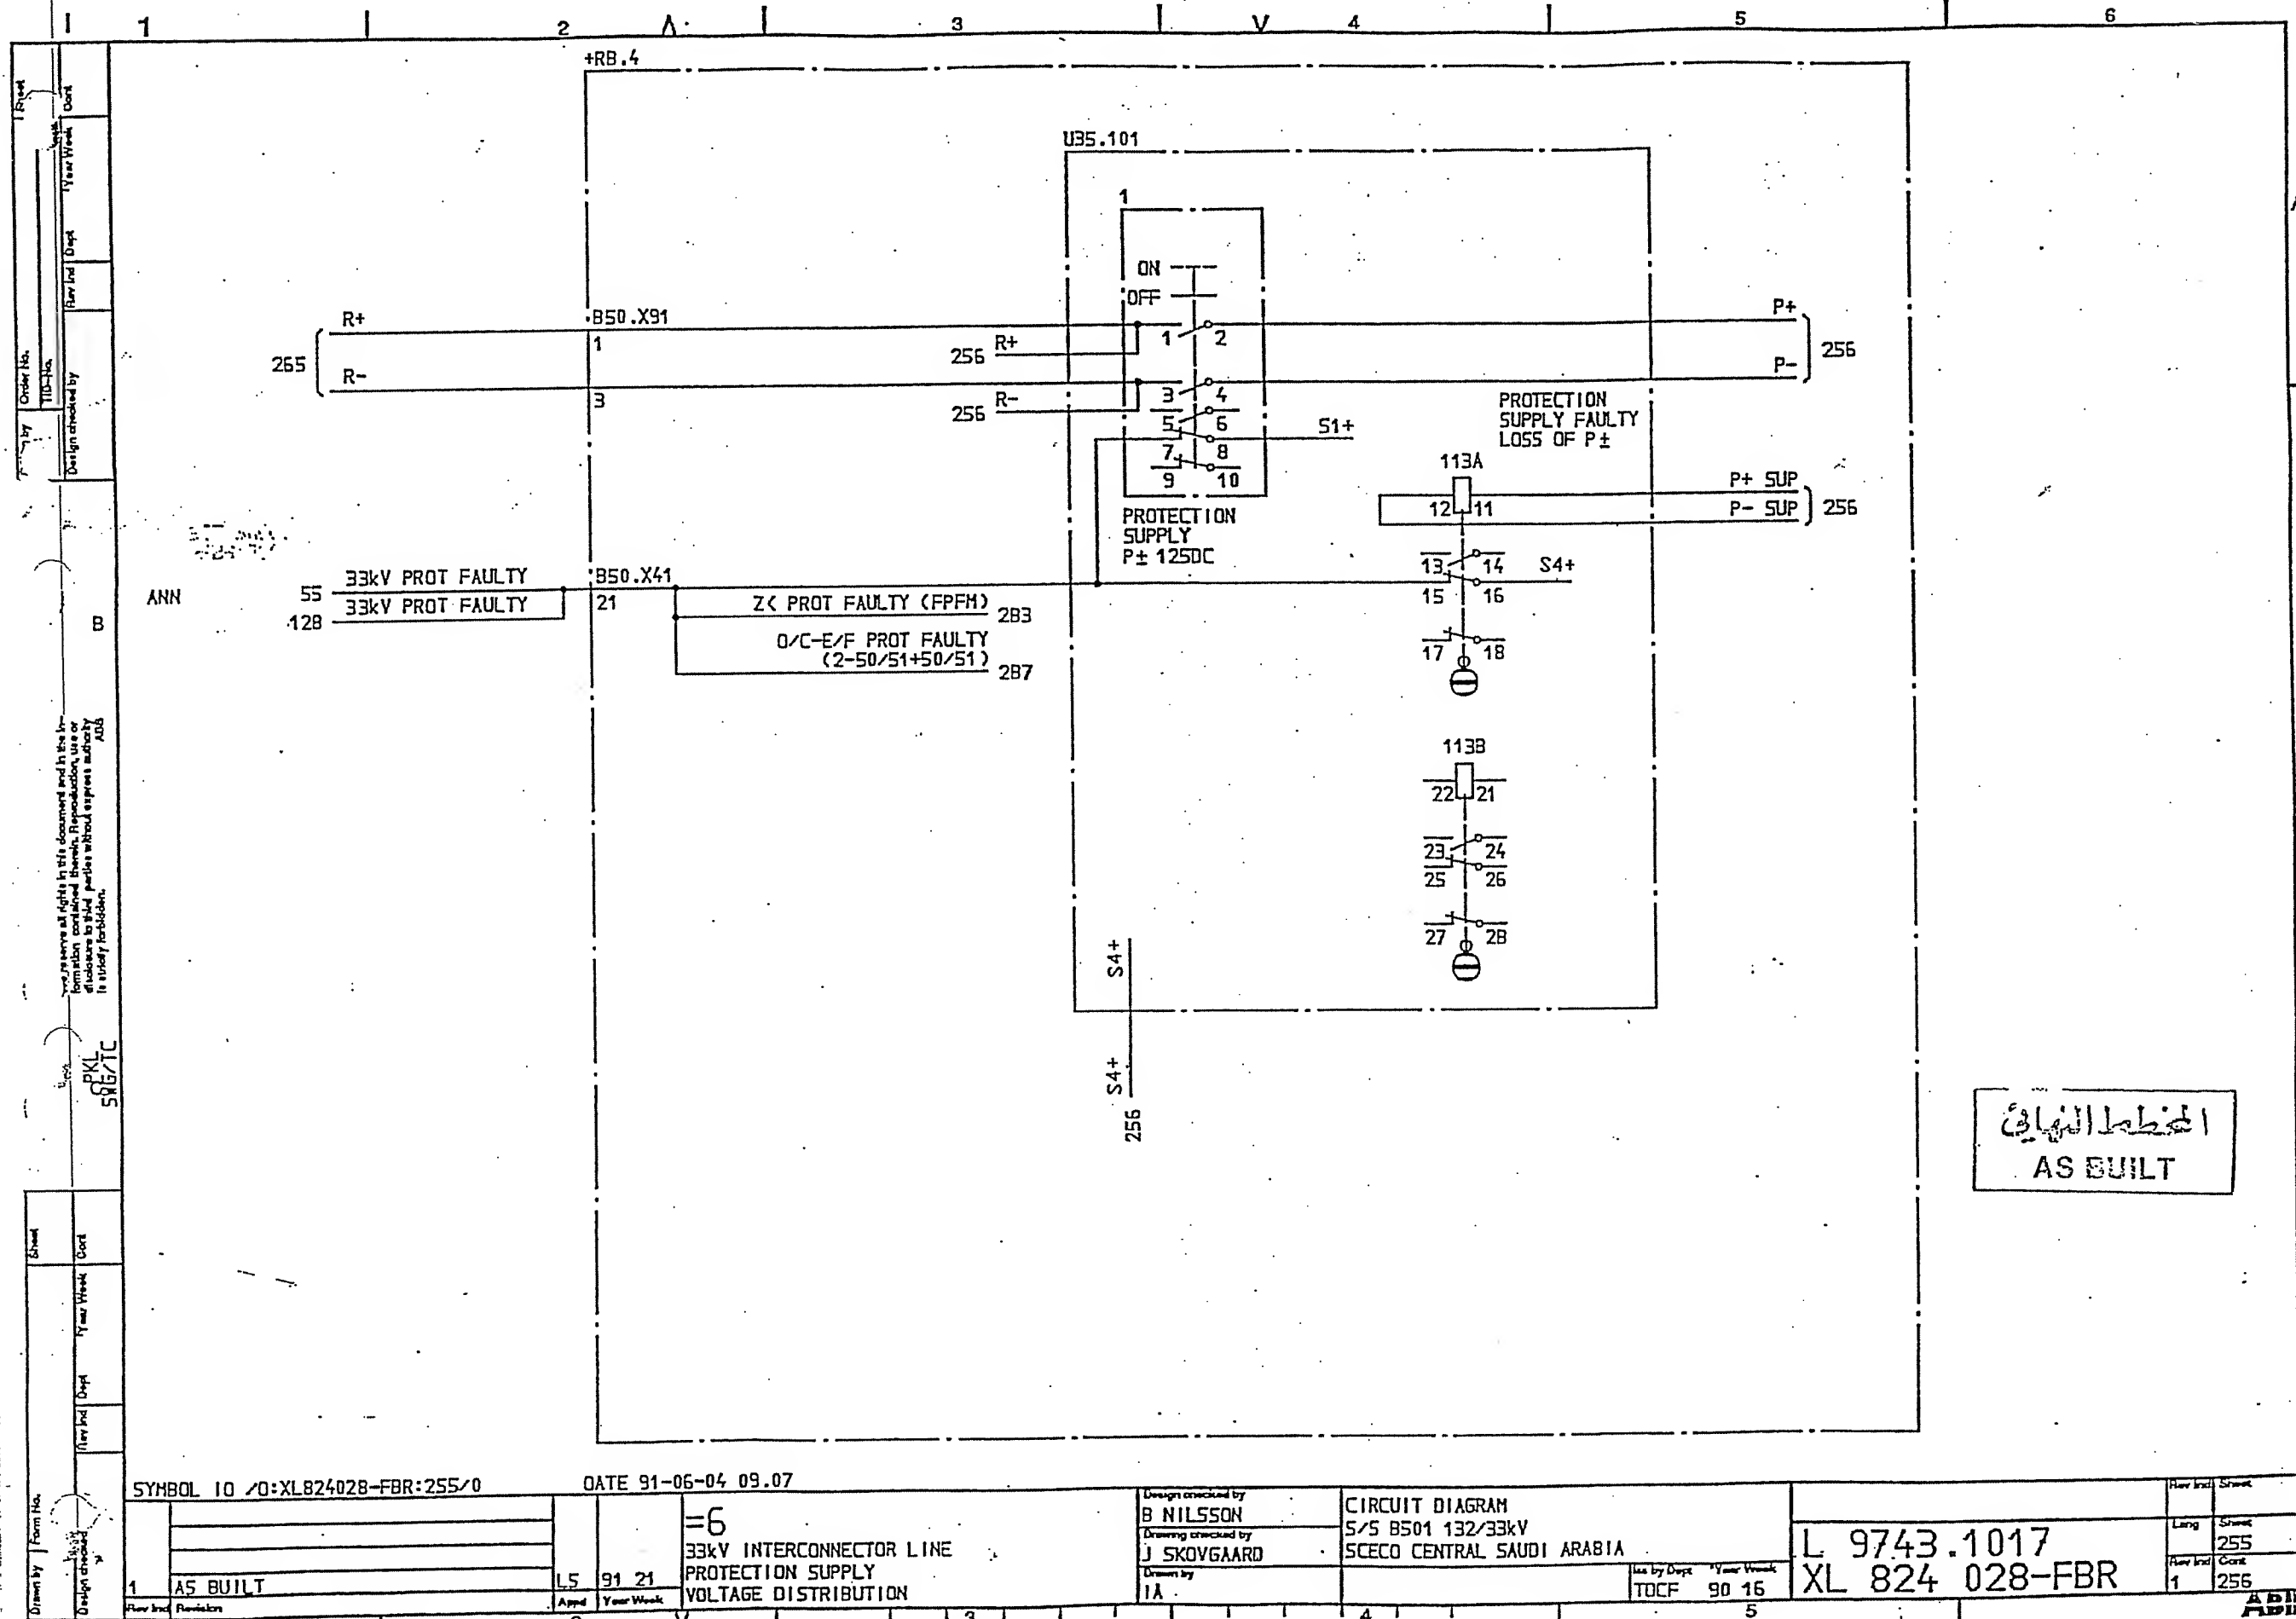

| | | | |
|--|--|--|--|
| Drawn by: PKL Design checked by: 596/TC Order No. YID-116 Design checked by: Year Week: Cont. | Sheet: 1 Year Week: Cont. | SHEET: 1 DISTR SIDE: 1 TERMINAL: P+ SUPPLY SIDE: 2 125V DC CIRCUIT: 283, 285, 286, 287 255 | SHEET: 1 DISTR SIDE: 1 TERMINAL: P- SUPPLY SIDE: 2 125V DC CIRCUIT: 283, 285, 286, 287 255 |
| SHEET: 1 DISTR SIDE: 1 TERMINAL: P+ SUPPLY SIDE: 2 125V DC CIRCUIT: 283, 285, 286, 287 255 | SHEET: 1 DISTR SIDE: 1 TERMINAL: P- SUPPLY SIDE: 2 125V DC CIRCUIT: 283, 285, 286, 287 255 | SHEET: 1 DISTR SIDE: 1 TERMINAL: P+ SUPPLY SIDE: 2 125V DC CIRCUIT: 283, 285, 286, 287 255 | SHEET: 1 DISTR SIDE: 1 TERMINAL: P- SUPPLY SIDE: 2 125V DC CIRCUIT: 283, 285, 286, 287 255 |

SYMBOL ID / 0:XL824028-FBR:256/0

DATE 91-06-04 09.07

1 AS BUILT

15 91 21

2

33kV INTERCONNECTOR LINE
PROTECTION AND ALARM SUPPLY
VOLTAGE DISTRIBUTION

256

Design checked by: B NILSSON
Drawing checked by: J SKOVGAARD
Drawn by: 1A


CIRCUIT DIAGRAM
5/5 8501 132/33kV
SCECO CENTRAL SAUDI ARABIA
ABB HV SWITCHGEAR

100% TDCF 90 15

L 9743.1017
XL 824 028-FBR

1 256

| Drawn by | | Form No. | | Sheet | | Design checked by | | Year Week | | Cont | |
|---|
| J. SKOVGAARD | | 1A | | 1 | | TDC-Ha | | Year Week | | Cont | |
| SYMBOL ID /D:XL82402B-FBR:256/0 DATE 91-06-04 09.07 | |
| <div style="display: flex; justify-content: space-between;"> <div> <p>AS BUILT</p> <p>LS 91 21</p> </div> <div> <p>=6</p> <p>33kV INTERCONNECTOR LINE</p> <p>PROTECTION AND ALARM SUPPLY</p> <p>VOLTAGE DISTRIBUTION</p> </div> <div> <p>Design created by B NILSSON</p> <p>Design checked by J SKOVGAARD</p> <p>Drawn by 1A</p> </div> <div> <p>CIRCUIT DIAGRAM</p> <p>S/S 8501 132/33kV</p> <p>SCECO CENTRAL SAUDI ARABIA</p> <p>ABB HV SWITCHGEAR</p> <p>TDCF 90 16</p> </div> <div> <p>L 9743.1017</p> <p>XL 824 028-FBR</p> </div> <div> <p>Flow sheet</p> <p>Long</p> <p>Sheet</p> <p>256</p> <p>Flow sheet</p> <p>Cont</p> <p>252</p> </div> </div> | |
| <table border="1"> <thead> <tr> <th>SHEET</th> <th>DISTR SIDE /1</th> <th>TERMINAL</th> <th>SUPPLY SIDE /2</th> </tr> </thead> <tbody> <tr> <td>CIRCUIT</td> <td>P+</td> <td>P+</td> <td>125V DC</td> </tr> <tr> <td>283</td> <td>←</td> <td>+RB.4. 850.X113 1</td> <td>P+ 255</td> </tr> <tr> <td>285</td> <td>←</td> <td>2</td> <td>P+ SUP 268</td> </tr> <tr> <td>286</td> <td>←</td> <td>3</td> <td>P+ 270</td> </tr> <tr> <td>287</td> <td>←</td> <td>4</td> <td>P+ SUP 771</td> </tr> <tr> <td></td> <td></td> <td>5</td> <td></td> </tr> <tr> <td></td> <td></td> <td>6</td> <td></td> </tr> <tr> <td></td> <td></td> <td>7</td> <td></td> </tr> <tr> <td></td> <td></td> <td>8</td> <td></td> </tr> <tr> <td>255</td> <td>P+ SUP</td> <td></td> <td></td> </tr> <tr> <td colspan="4">125V DC</td> </tr> <tr> <td></td> <td>R+</td> <td>R+</td> <td>125V DC</td> </tr> <tr> <td>285</td> <td>←</td> <td>+RB.4. 850.X113 17</td> <td>R+ 255</td> </tr> <tr> <td></td> <td></td> <td>18</td> <td>R+ 265</td> </tr> <tr> <td colspan="4">125V DC</td> </tr> <tr> <td></td> <td>S4+</td> <td>S4+</td> <td>125V DC</td> </tr> <tr> <td>254</td> <td>←</td> <td>+RB.4. 850.X41 1</td> <td>S4+ 56</td> </tr> <tr> <td>255</td> <td>←</td> <td>2</td> <td>S4+ 656</td> </tr> <tr> <td>283</td> <td>←</td> <td>3</td> <td></td> </tr> <tr> <td>287</td> <td>←</td> <td></td> <td></td> </tr> <tr> <td colspan="4">125V DC</td> </tr> <tr> <td></td> <td>H+</td> <td>H+</td> <td>125V DC</td> </tr> <tr> <td></td> <td></td> <td>+RB.4. 850.X51</td> <td>H+ 56</td> </tr> <tr> <td></td> <td></td> <td></td> <td>H+ 656</td> </tr> <tr> <td colspan="4">125V DC</td> </tr> </tbody> </table> | | | | | | | | | | | | SHEET | DISTR SIDE /1 | TERMINAL | SUPPLY SIDE /2 | CIRCUIT | P+ | P+ | 125V DC | 283 | ← | +RB.4. 850.X113 1 | P+ 255 | 285 | ← | 2 | P+ SUP 268 | 286 | ← | 3 | P+ 270 | 287 | ← | 4 | P+ SUP 771 | | | 5 | | | | 6 | | | | 7 | | | | 8 | | 255 | P+ SUP | | | 125V DC | | | | | R+ | R+ | 125V DC | 285 | ← | +RB.4. 850.X113 17 | R+ 255 | | | 18 | R+ 265 | 125V DC | | | | | S4+ | S4+ | 125V DC | 254 | ← | +RB.4. 850.X41 1 | S4+ 56 | 255 | ← | 2 | S4+ 656 | 283 | ← | 3 | | 287 | ← | | | 125V DC | | | | | H+ | H+ | 125V DC | | | +RB.4. 850.X51 | H+ 56 | | | | H+ 656 | 125V DC | | | SHEET | DISTR SIDE /1 | TERMINAL | SUPPLY SIDE /2 | |
| CIRCUIT | P+ | P+ | 125V DC | |
| 283 | ← | +RB.4. 850.X113 1 | P+ 255 | |
| 285 | ← | 2 | P+ SUP 268 | |
| 286 | ← | 3 | P+ 270 | |
| 287 | ← | 4 | P+ SUP 771 | |
| | | 5 | |
| | | 6 | |
| | | 7 | |
| | | 8 | |
| 255 | P+ SUP | |
| 125V DC | |
| | R+ | R+ | 125V DC | |
| 285 | ← | +RB.4. 850.X113 17 | R+ 255 | |
| | | 18 | R+ 265 | |
| 125V DC | |
| | S4+ | S4+ | 125V DC | |
| 254 | ← | +RB.4. 850.X41 1 | S4+ 56 | |
| 255 | ← | 2 | S4+ 656 | |
| 283 | ← | 3 | |
| 287 | ← | |
| 125V DC | |
| | H+ | H+ | 125V DC | |
| | | +RB.4. 850.X51 | H+ 56 | |
| | | | H+ 656 | |
| 125V DC | |
| <table border="1"> <thead> <tr> <th>SHEET</th> <th>DISTR SIDE /1</th> <th>TERMINAL</th> <th>SUPPLY SIDE /2</th> </tr> </thead> <tbody> <tr> <td>CIRCUIT</td> <td>P-</td> <td>P-</td> <td>125V DC</td> </tr> <tr> <td>283</td> <td>←</td> <td>+RB.4. 850.X113 9</td> <td>P- 255</td> </tr> <tr> <td>286</td> <td>←</td> <td>10</td> <td>P- SUP 278</td> </tr> <tr> <td>287</td> <td>←</td> <td>11</td> <td></td> </tr> <tr> <td>282</td> <td>←</td> <td>12</td> <td></td> </tr> <tr> <td></td> <td></td> <td>13</td> <td></td> </tr> <tr> <td></td> <td></td> <td>14</td> <td></td> </tr> <tr> <td></td> <td></td> <td>15</td> <td></td> </tr> <tr> <td></td> <td></td> <td>16</td> <td></td> </tr> <tr> <td>255</td> <td>P- SUP</td> <td></td> <td></td> </tr> <tr> <td colspan="4">125V DC</td> </tr> <tr> <td></td> <td>R-</td> <td>R-</td> <td>125V DC</td> </tr> <tr> <td></td> <td></td> <td>+RB.4. 850.X113 19</td> <td>R- 255</td> </tr> <tr> <td></td> <td></td> <td>20</td> <td>R- 262</td> </tr> <tr> <td colspan="4">125V DC</td> </tr> <tr> <td></td> </tr> <tr> <td colspan="4">125V DC</td> </tr> </tbody> </table> | | | | | | | | | | | | SHEET | DISTR SIDE /1 | TERMINAL | SUPPLY SIDE /2 | CIRCUIT | P- | P- | 125V DC | 283 | ← | +RB.4. 850.X113 9 | P- 255 | 286 | ← | 10 | P- SUP 278 | 287 | ← | 11 | | 282 | ← | 12 | | | | 13 | | | | 14 | | | | 15 | | | | 16 | | 255 | P- SUP | | | 125V DC | | | | | R- | R- | 125V DC | | | +RB.4. 850.X113 19 | R- 255 | | | 20 | R- 262 | 125V DC | | | | | S1- | S1- | 125V DC | | | +RB.4. 850.X41 1 | | | | 2 | | | | 3 | | | | 4 | | | | 5 | | | | 6 | | 125V DC | | | | | H- | H- | 125V DC | | | +RB.4. 850.X51 1 | H- 56 | | | 2 | H- 656 | | | 3 | | | | 4 | | | | 5 | | | | 6 | | 125V DC | | | |
| SHEET | DISTR SIDE /1 | TERMINAL | SUPPLY SIDE /2 | |
| CIRCUIT | P- | P- | 125V DC | |
| 283 | ← | +RB.4. 850.X113 9 | P- 255 | |
| 286 | ← | 10 | P- SUP 278 | |
| 287 | ← | 11 | |
| 282 | ← | 12 | |
| | | 13 | |
| | | 14 | |
| | | 15 | |
| | | 16 | |
| 255 | P- SUP | |
| 125V DC | |
| | R- | R- | 125V DC | |
| | | +RB.4. 850.X113 19 | R- 255 | |
| | | 20 | R- 262 | |
| 125V DC | |
| | S1- | S1- | 125V DC | |
| | | +RB.4. 850.X41 1 | |
| | | 2 | |
| | | 3 | |
| | | 4 | |
| | | 5 | |
| | | 6 | |
| 125V DC | |
| | H- | H- | 125V DC | |
| | | +RB.4. 850.X51 1 | H- 56 | |
| | | 2 | H- 656 | |
| | | 3 | |
| | | 4 | |
| | | 5 | |
| | | 6 | |
| 125V DC | |
| <div style="display: flex; justify-content: space-between;"> <div> <p>MODIFIED</p> </div> <div> <p>31/12/02</p> <p>PAJ</p> <p>المخطط النهائي</p> <p>AS BUILT</p> </div> <div> <p>MODIFICATION DONE UNDER CONTRACT 516/20/3</p> </div> </div> | |

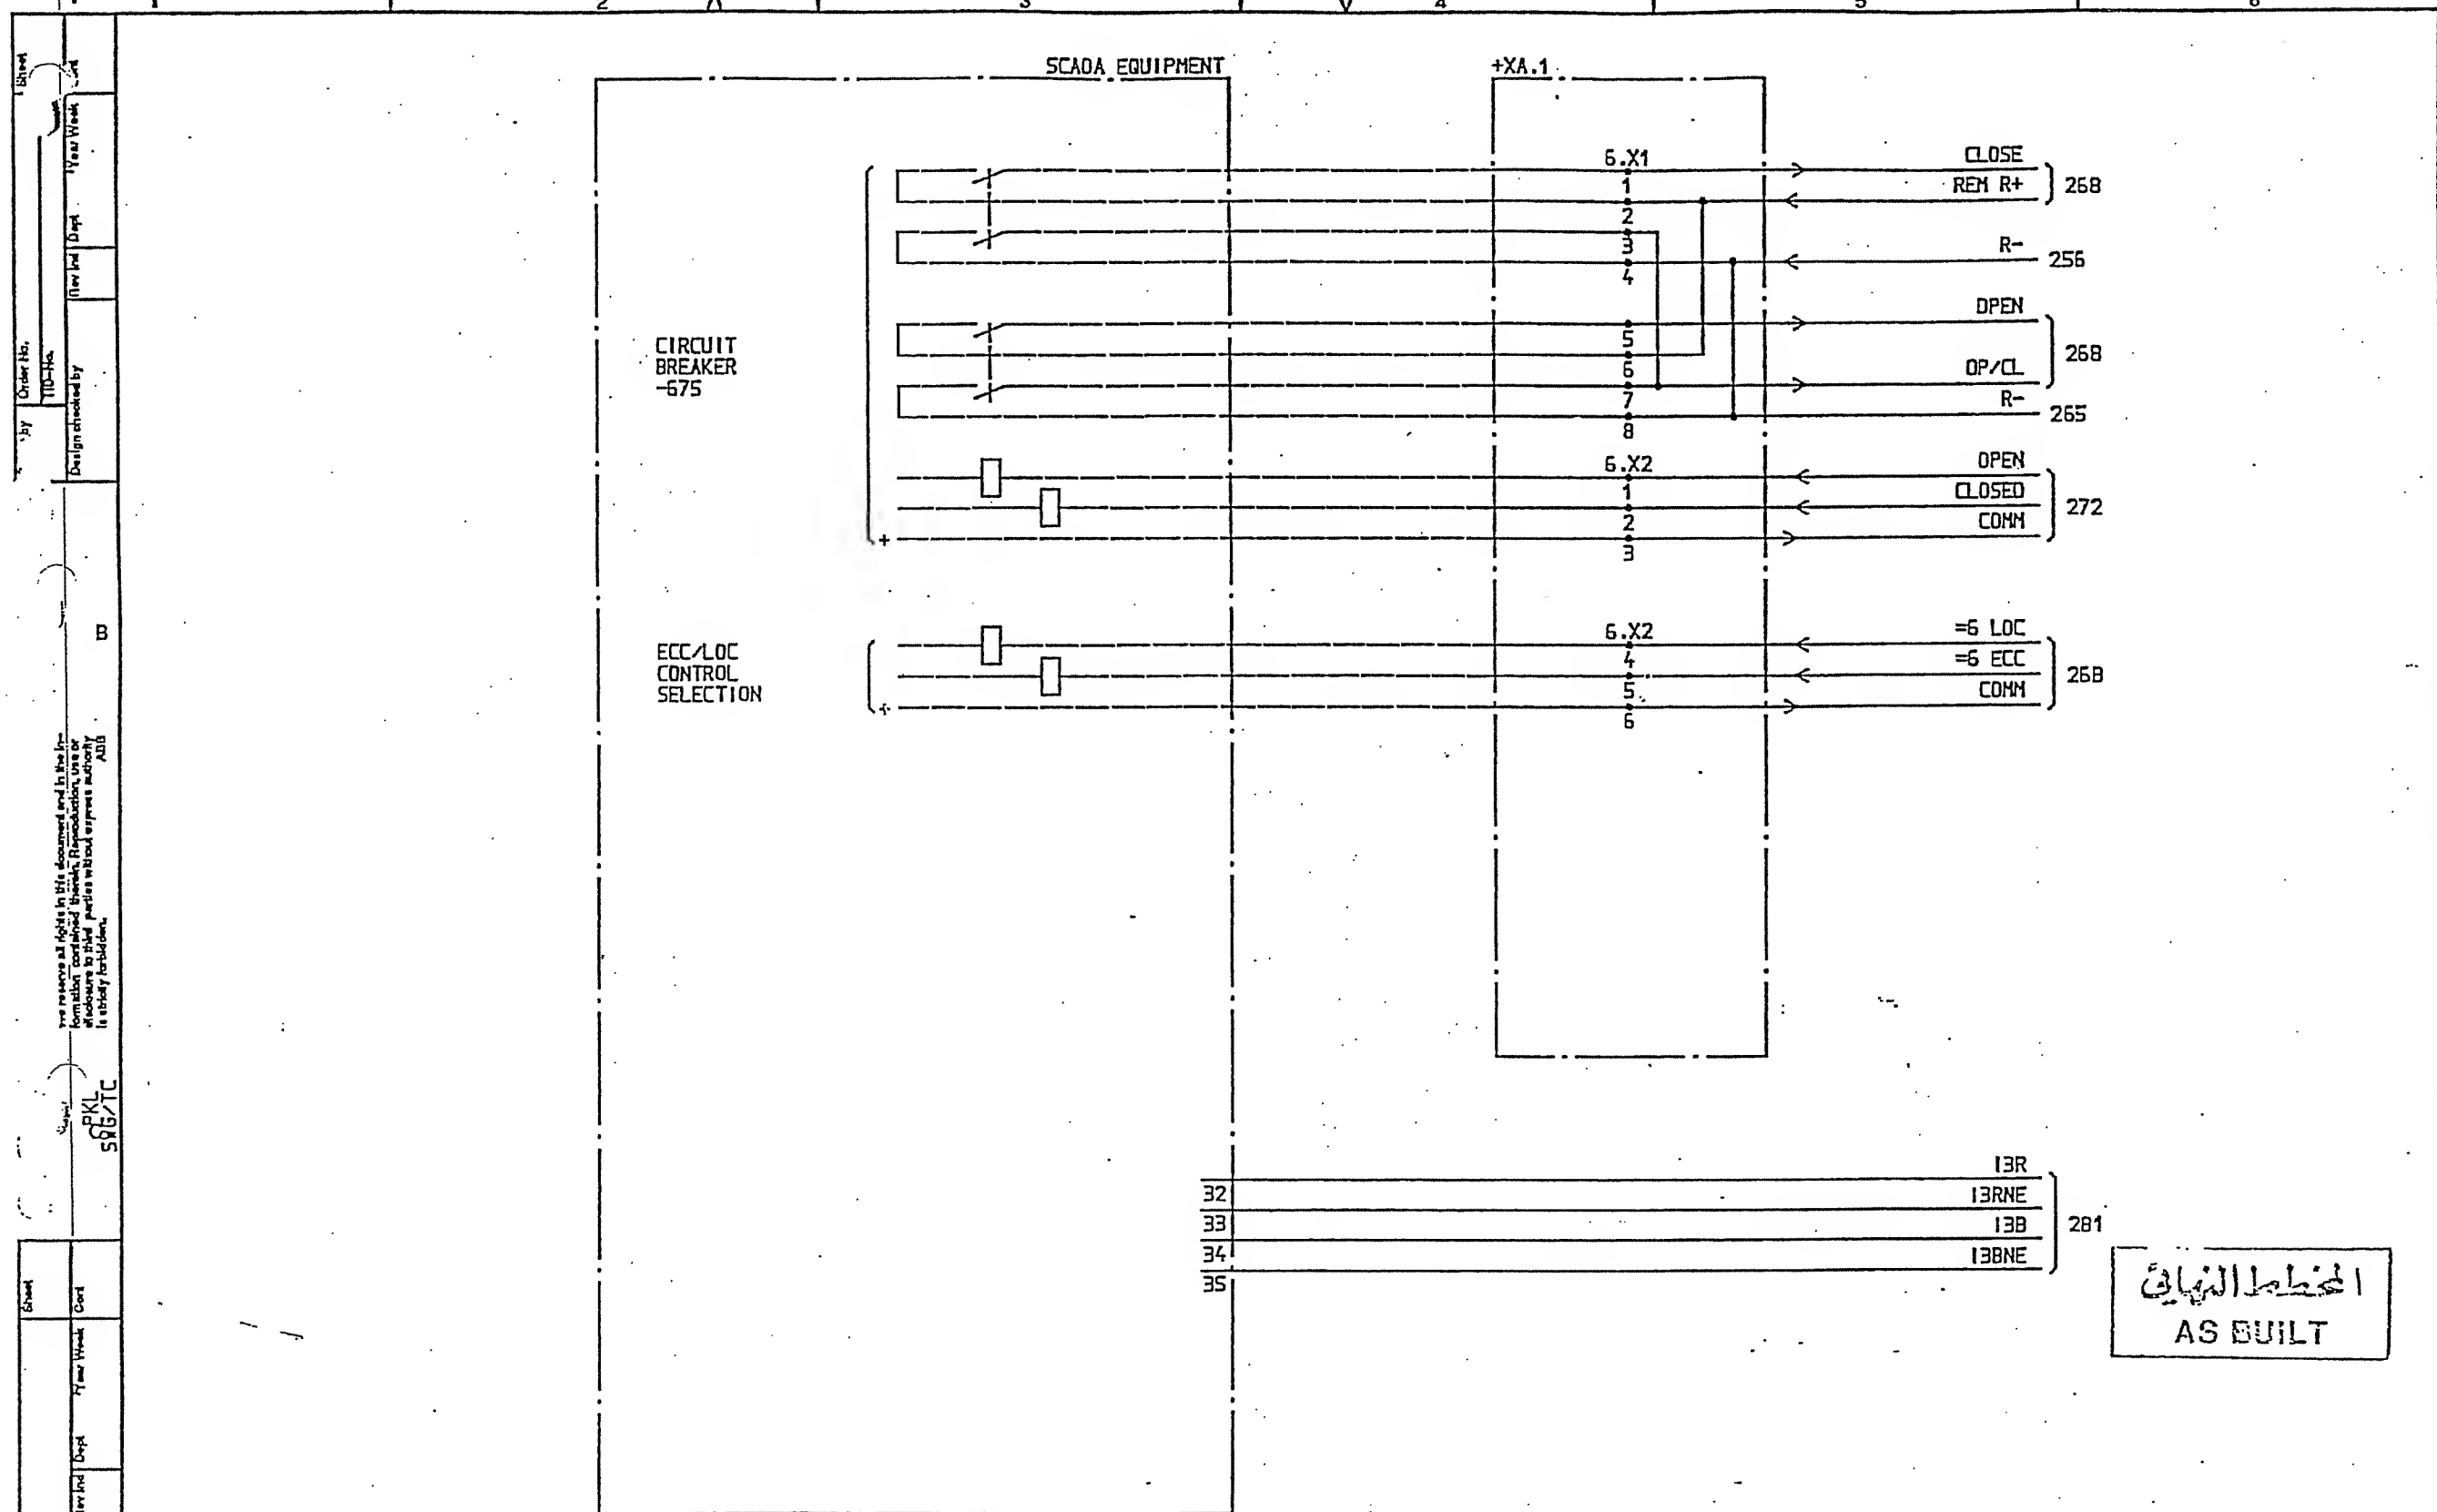


SYMBOL 10 /D:XL824028-FBR:262/0

DATE 91-05-04 09.07


| | | | | | | | | |
|---|----------|----|-------|--------------------------------|-----------------------------------|---|---------|-------|
| 1 | AS BUILT | LS | 91 21 | =6 33kV INTERCONNECTOR LINE | Design checked by B NILSSON | CIRCUIT DIAGRAM | Rev Int | Sheet |
| 2 | | | | SCAOA INTERFACE EQUIPMENT | Drawing checked by S STRIDSMAN | S/S BS01 132/33kV SCECO CENTRAL SAUDI ARABIA | Lang | Sheet |
| | | | | | Drawn by 1A | ABB HV SWITCHGEAR | Rev Int | Sheet |
| | | | | | | TCF 90 10 | 1 | 265 |

L 9743.1017
XL 824 028-FBR

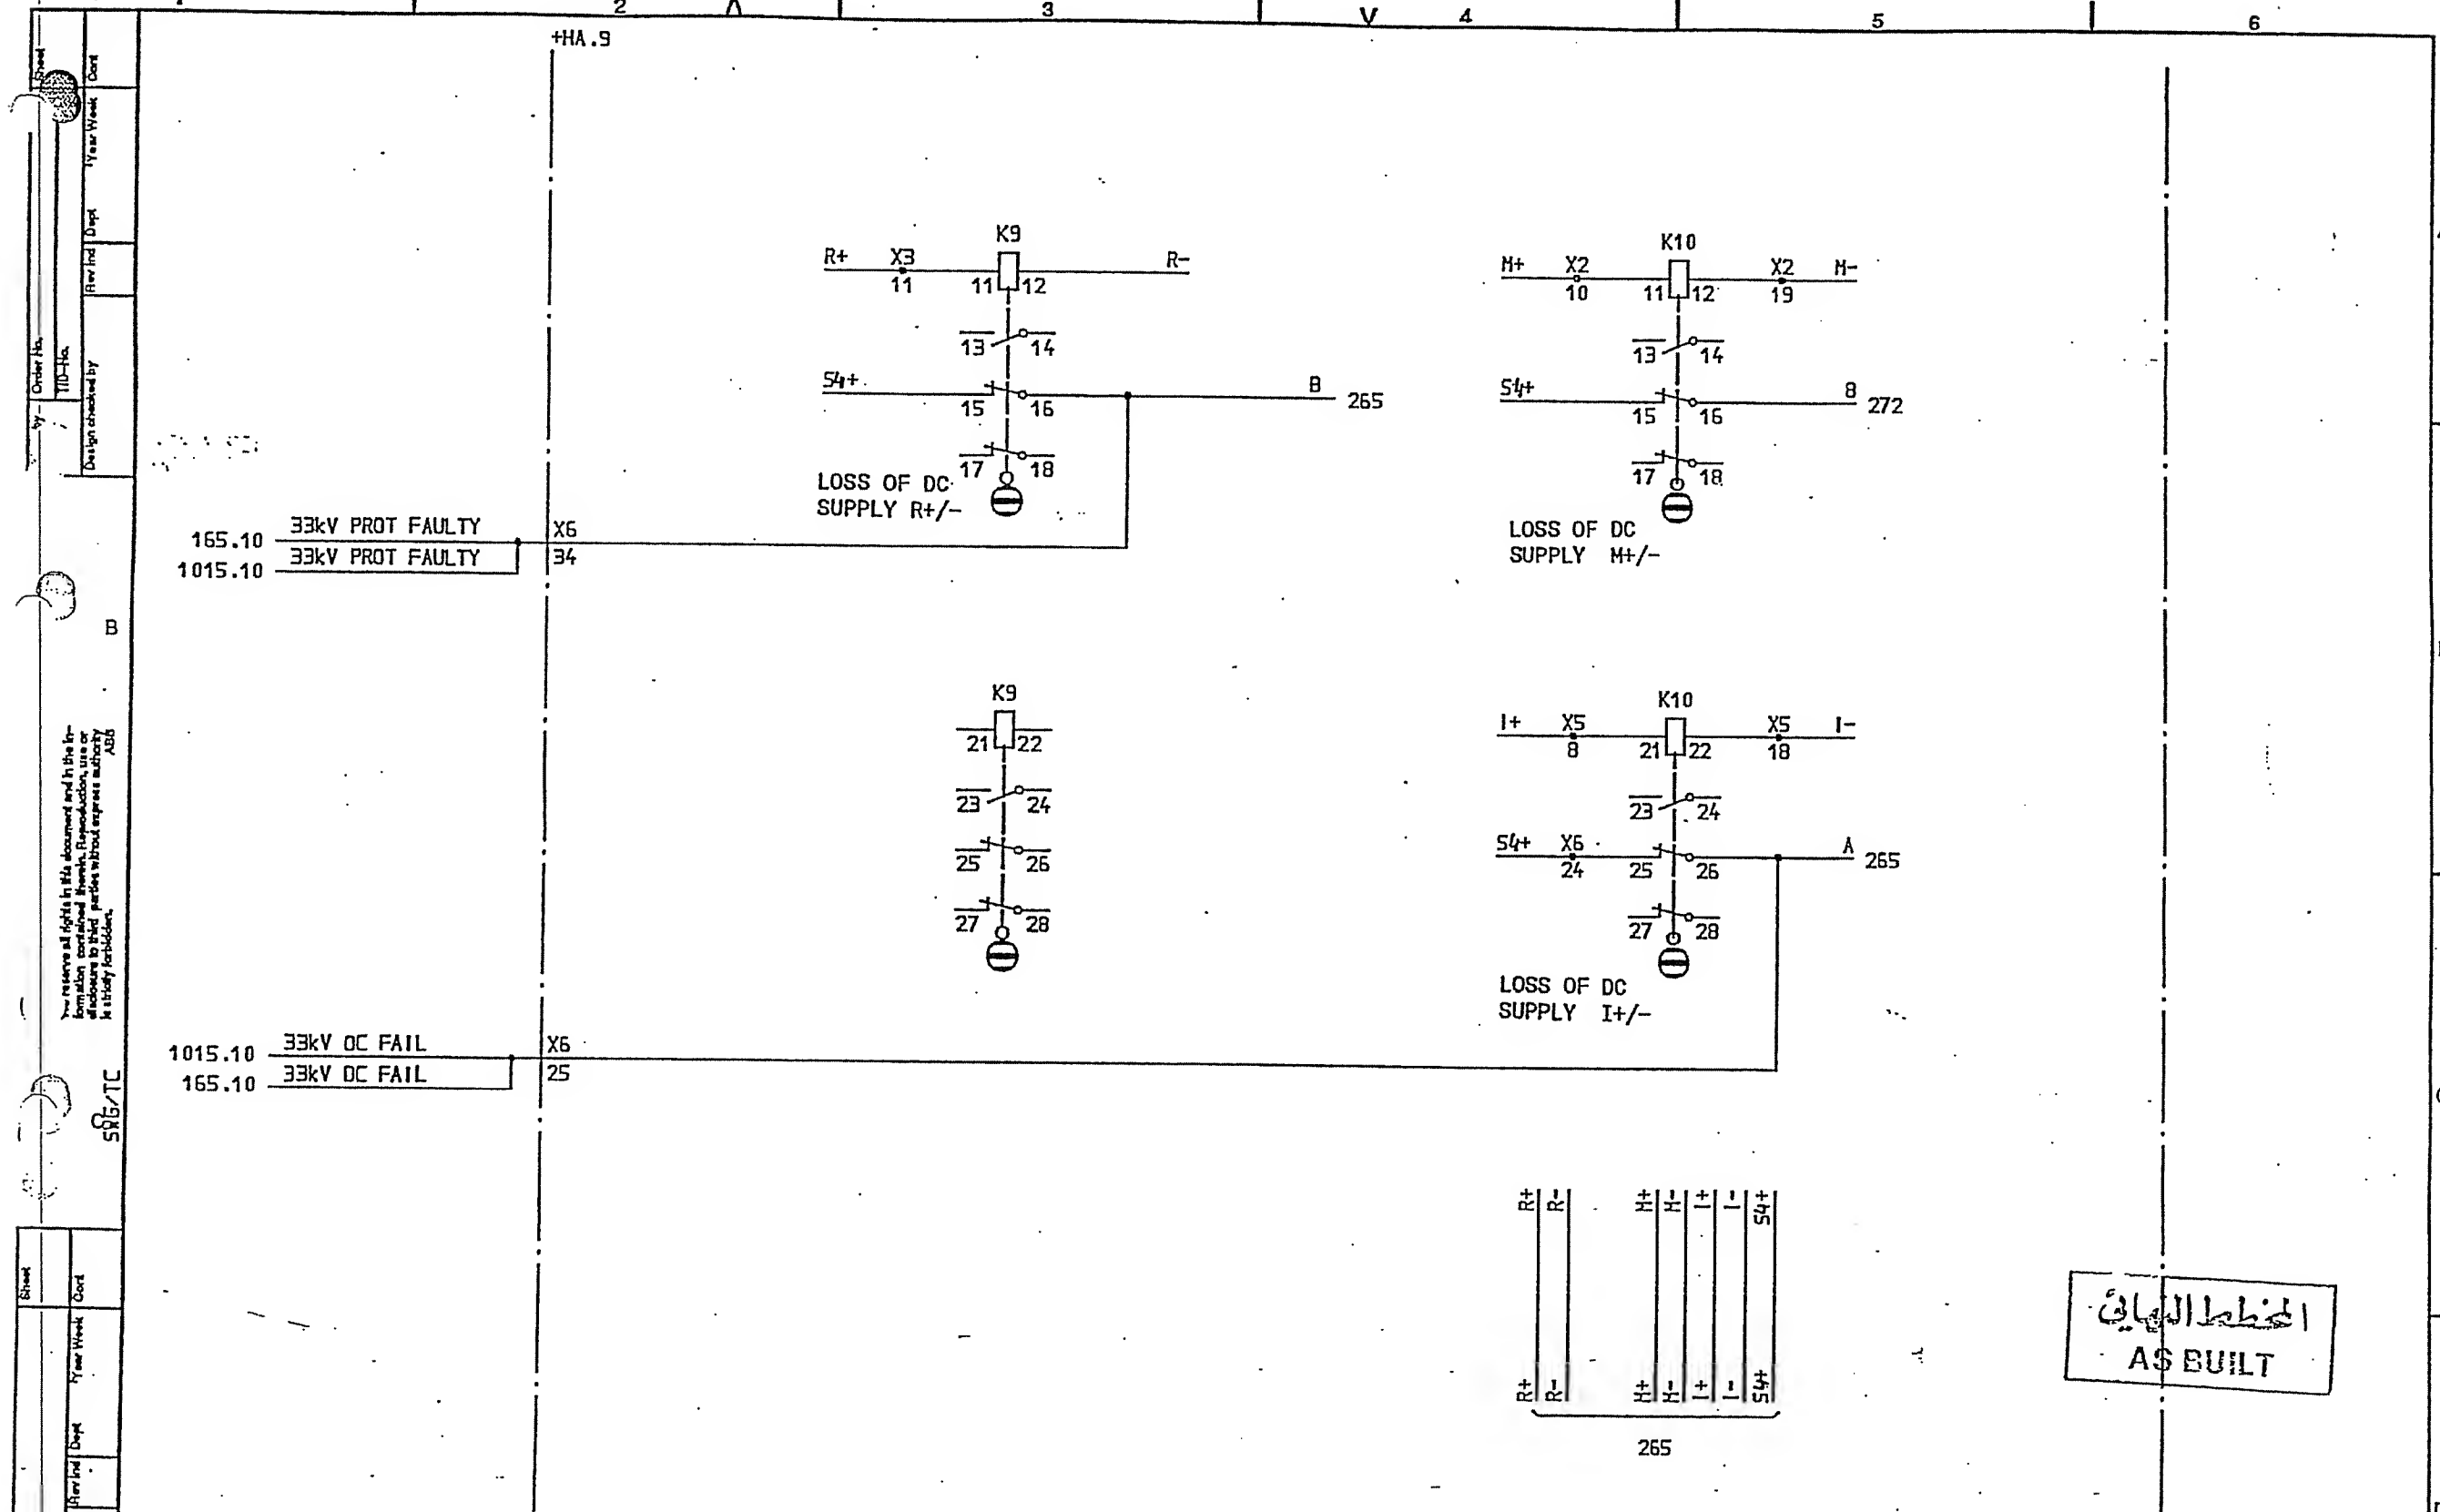ABB



| | | | | | | | | | | | | | | | | | | | |
|-------------------------------------|--|---------------------|--|----------|--|--------------------------|--|-----------------|--|-------------------|--|----------------------------|--|-------------|--|----------------|--|--------|--|
| SYMBOL ID / 0:XL824028-FBR:265.10/0 | | DATE 91-06-04 09.07 | | =6 | | 33kV INTERCONNECTOR LINE | | CIRCUIT DIAGRAM | | S/S 8501 132/33kV | | SCECO CENTRAL SAUDI ARABIA | | L 9743.1017 | | XL 824 028-FBR | | 265.10 | |
| 1 | | AS BUILT | | LS 91 21 | | DC AUX. VOLTAGE SUPPLY | | SK | | ABB HV SWITCHGEAR | | TDCF 90 36 | | 1 | | 266 | | 266 | |

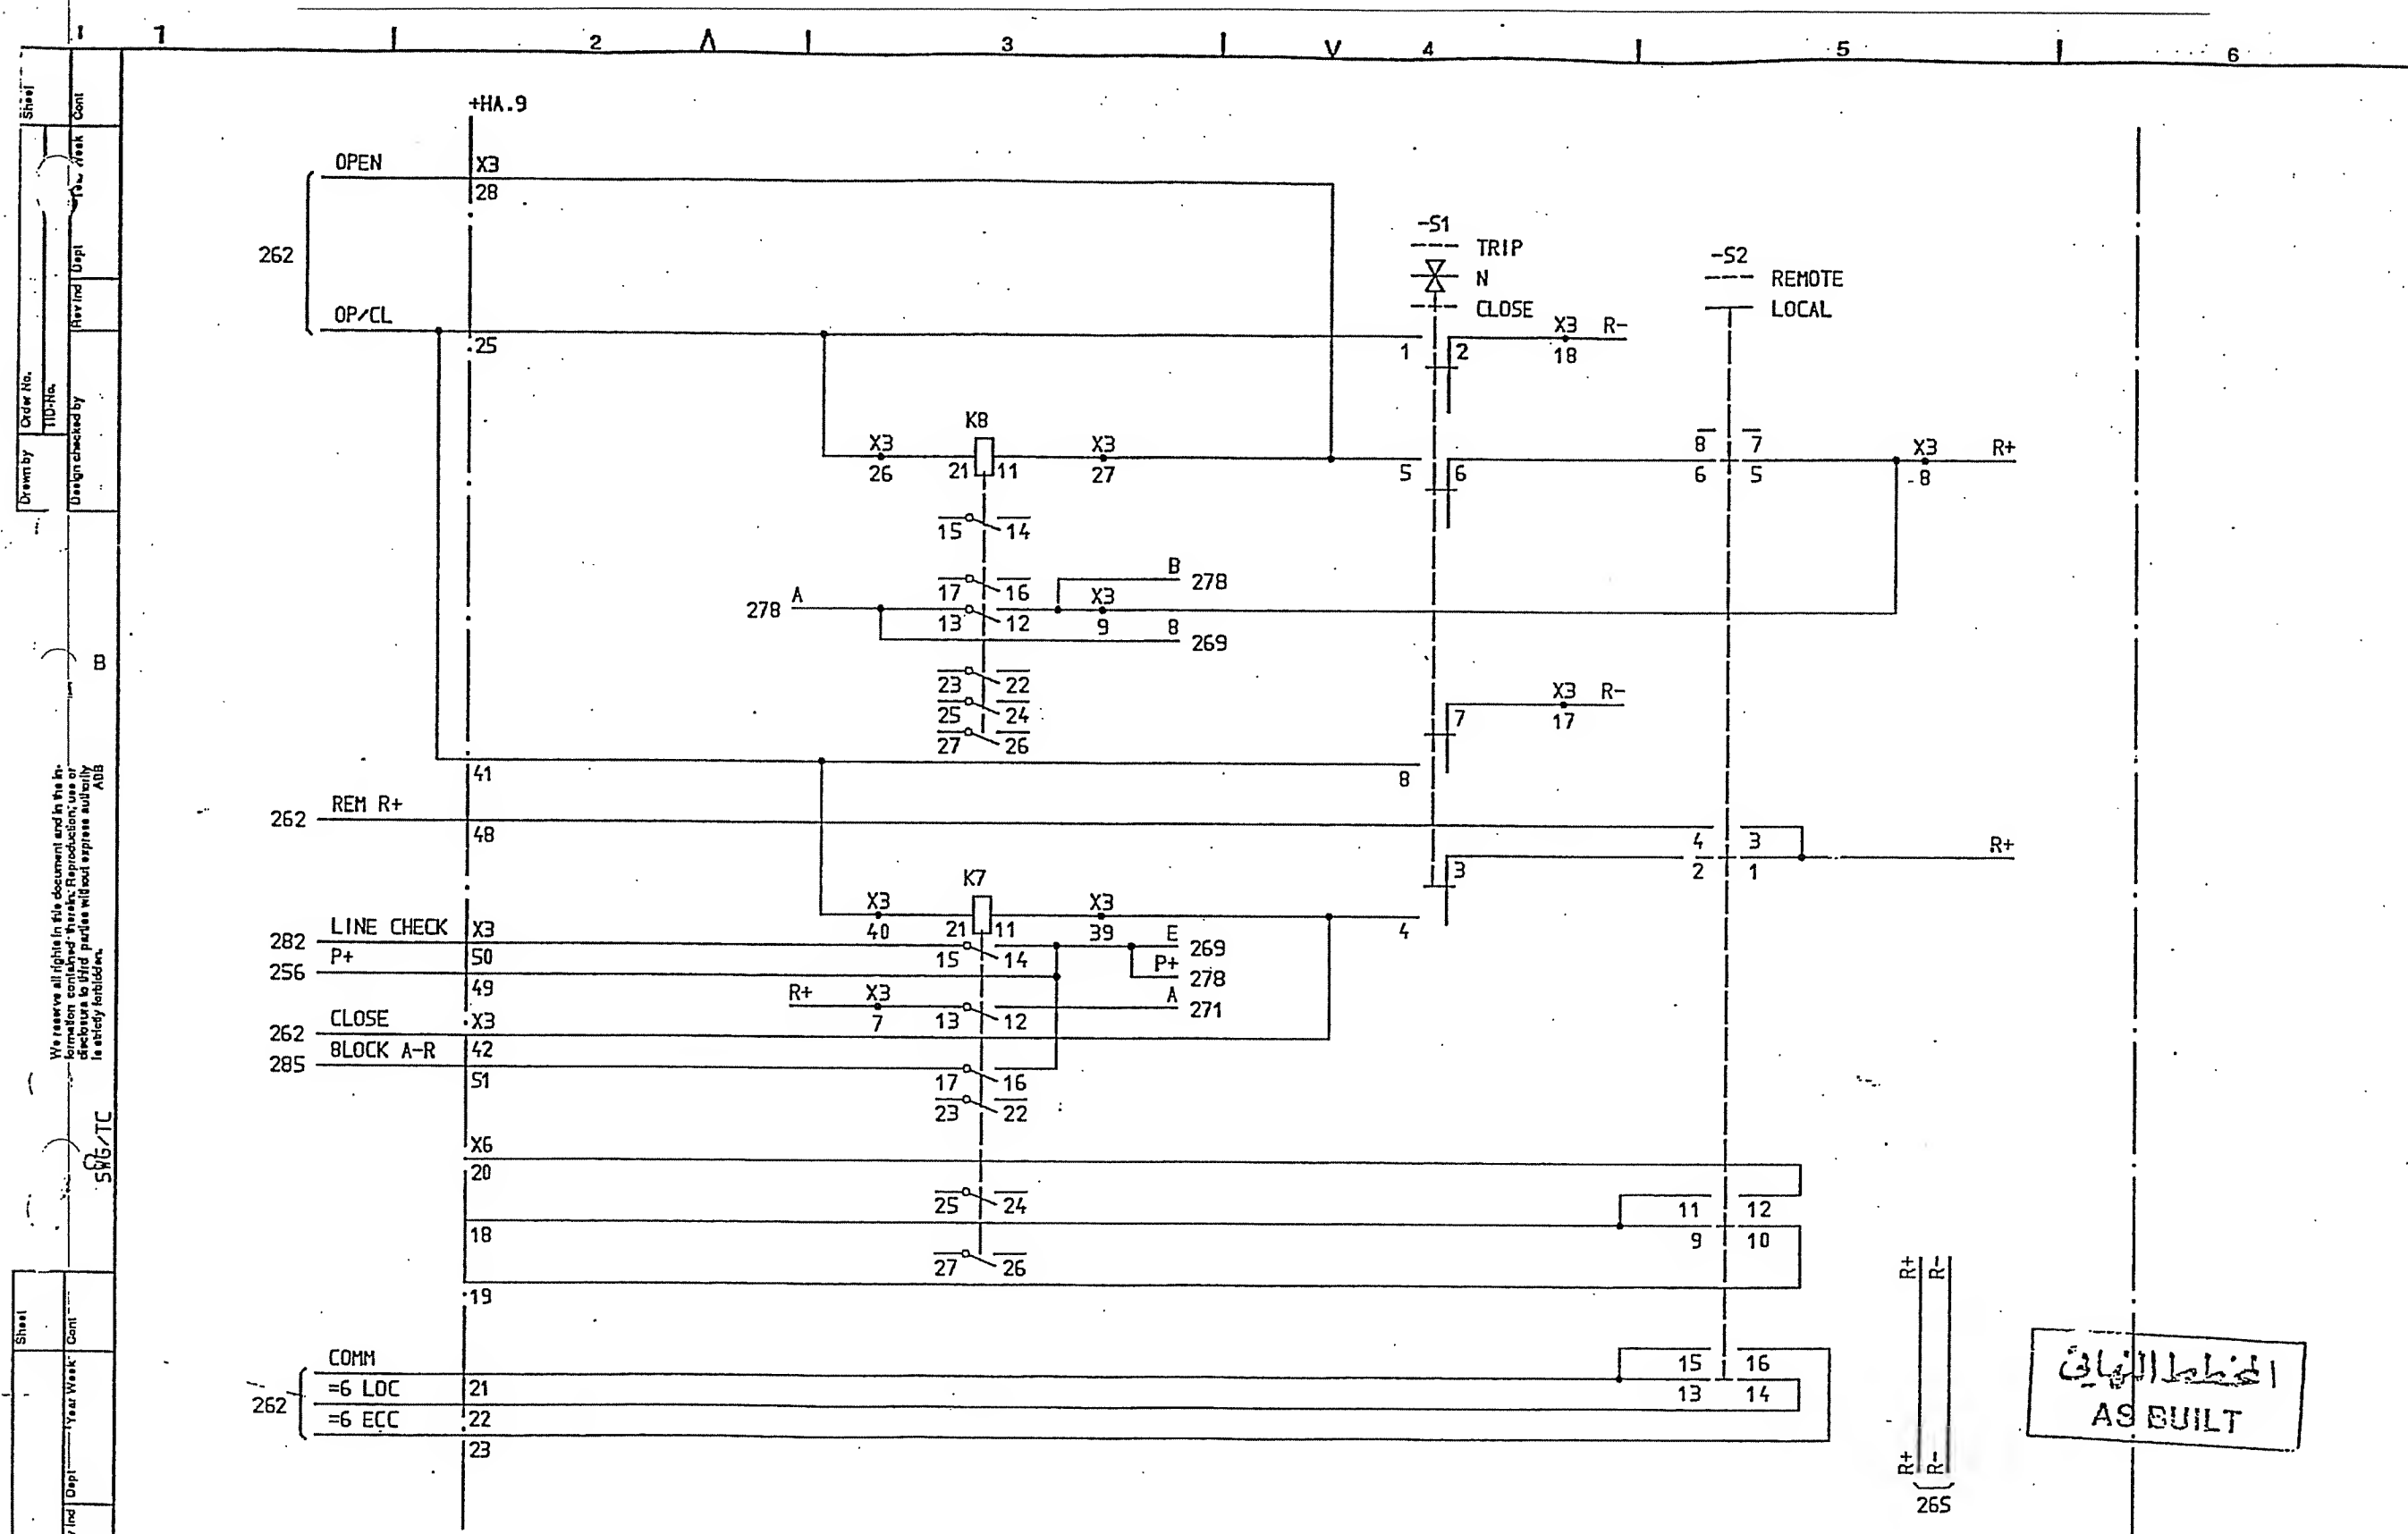


| | | | | | | | | | | | | | |
|---------------------------------|--|----------------|--|-----------|--|--------------------------|--|-----------------|--|----------------------------|--|-------------|--|
| SYMBOL ID /D:XL824028-F8R:268/0 | | 92-07-02 18.54 | | =6 | | 33kV INTERCONNECTOR LINE | | CIRCUIT DIAGRAM | | S/S 8501 132/33kV | | L 9743.1017 | |
| SCECO SNAG | | LS 92 26 | | AS BUILT | | C.8 SELECTOR SWITCHES | | B NILSSON | | SCECO CENTRAL SAUDI ARABIA | | Lang Sheet | |
| 1 | | LS 91 21 | | | | | | L SVENSSON | | ABB HV SWITCHGEAR. | | 268 | |
| Rev Ind | | Appd | | Year Week | | SK | | TDCF | | 90 36 | | 268.10 | |

| | |
|-------------------|-----------|
| Order No. | Sheet |
| TID No. | Year Week |
| Design checked by | Year Week |

| | |
|------------------------------------|---------------------|
| SYMBOL ID | DATE |
| SYMBOL ID /D:XL824028-FBR:268.10/0 | DATE 91-06-04 09.07 |

| | |
|----------|----------|
| Drawn by | Design |
| AS BUILT | AS BUILT |

| | |
|-----|-----|
| Rev | Rev |
| 1 | 1 |

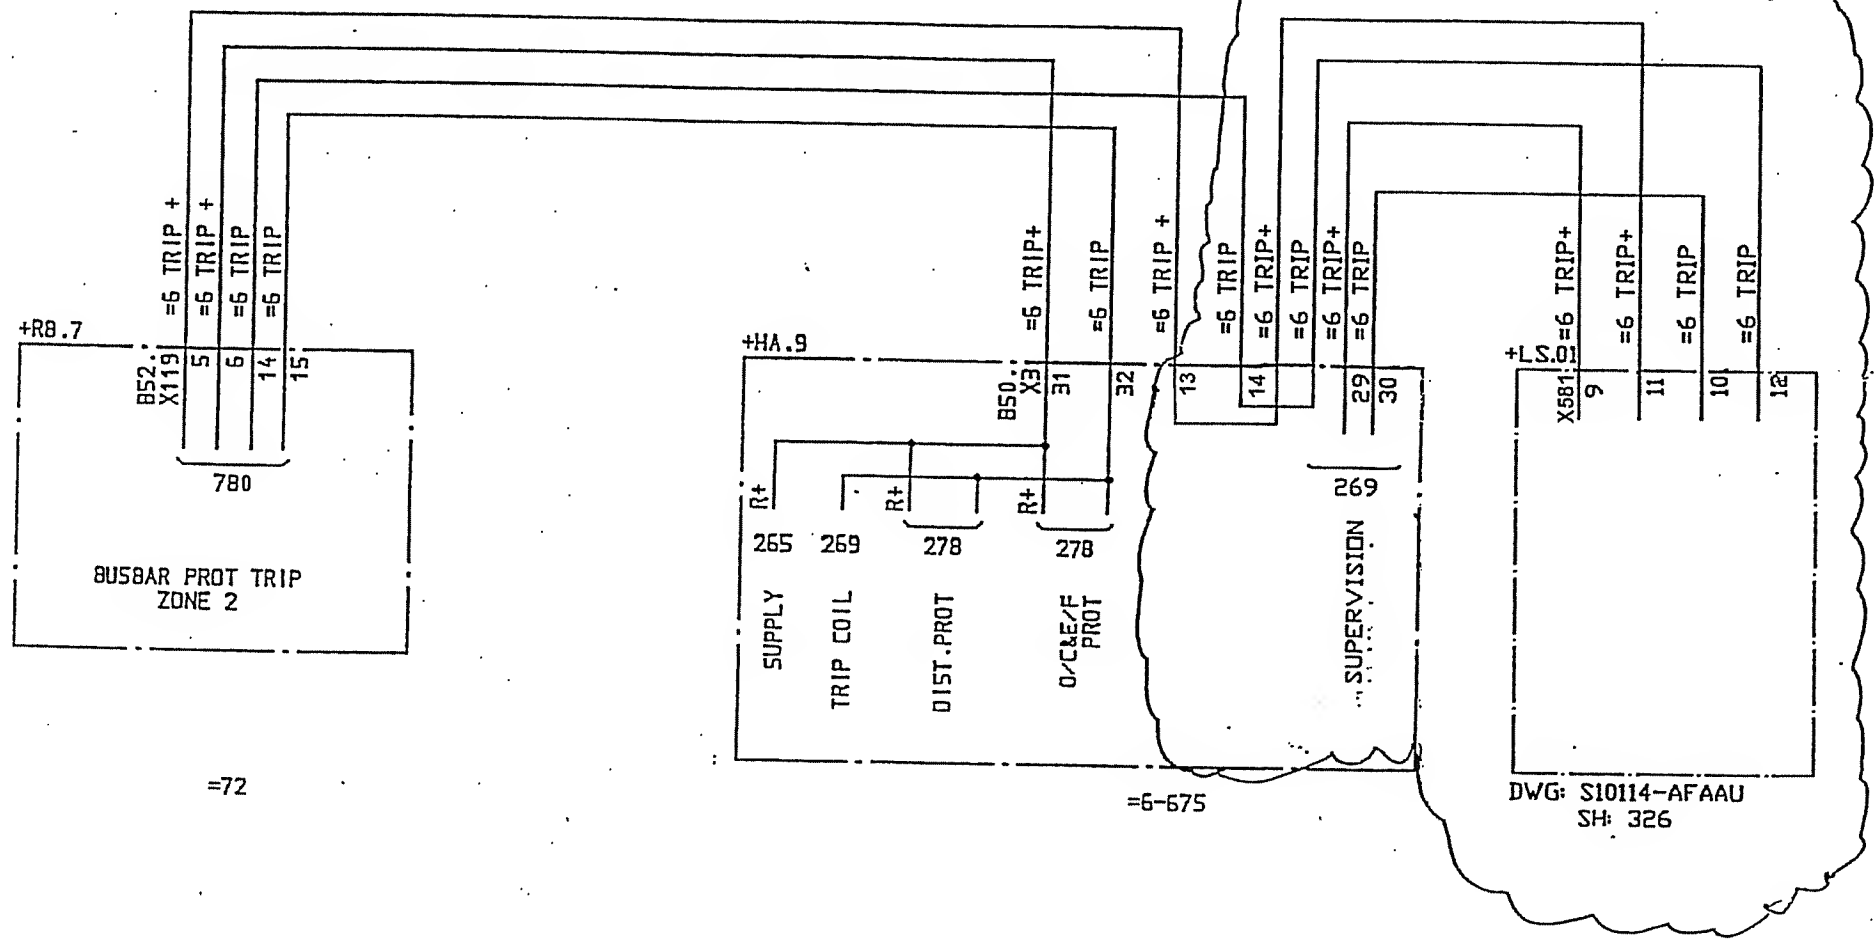

31/12/02

MODIFICATION DONE UNDER CONTRACT S16/20/3


المخطط النهائي
AS BUILT

MODIFIED


SYMBOL ID /D:XL824028-FBR:268.10/0 DATE 91-06-04 09.07

| | | | | | | | | | | | |
|---|----------|----|-------|--|--|---|-------------------|--------------------|-------------------------------|-----|-------|
| 1 | AS BUILT | LS | 91 21 | =6 33kV INTERCONNECTOR LINE PROTECTION TRIP CIRCUIT | Design checked by B NILSSON Drawing checked by L SYENSSON Drawn by SK | CIRCUIT DIAGRAM S/S 8501 132/33kV SCECO CENTRAL SAUDI ARABIA ABB HV SWITCHGEAR | Issued by TDCF | Year Week 90 35 | L 9743.1017 XL 824 028-FBR | Rev | Sheet |
| | | | | | | | | | | | |

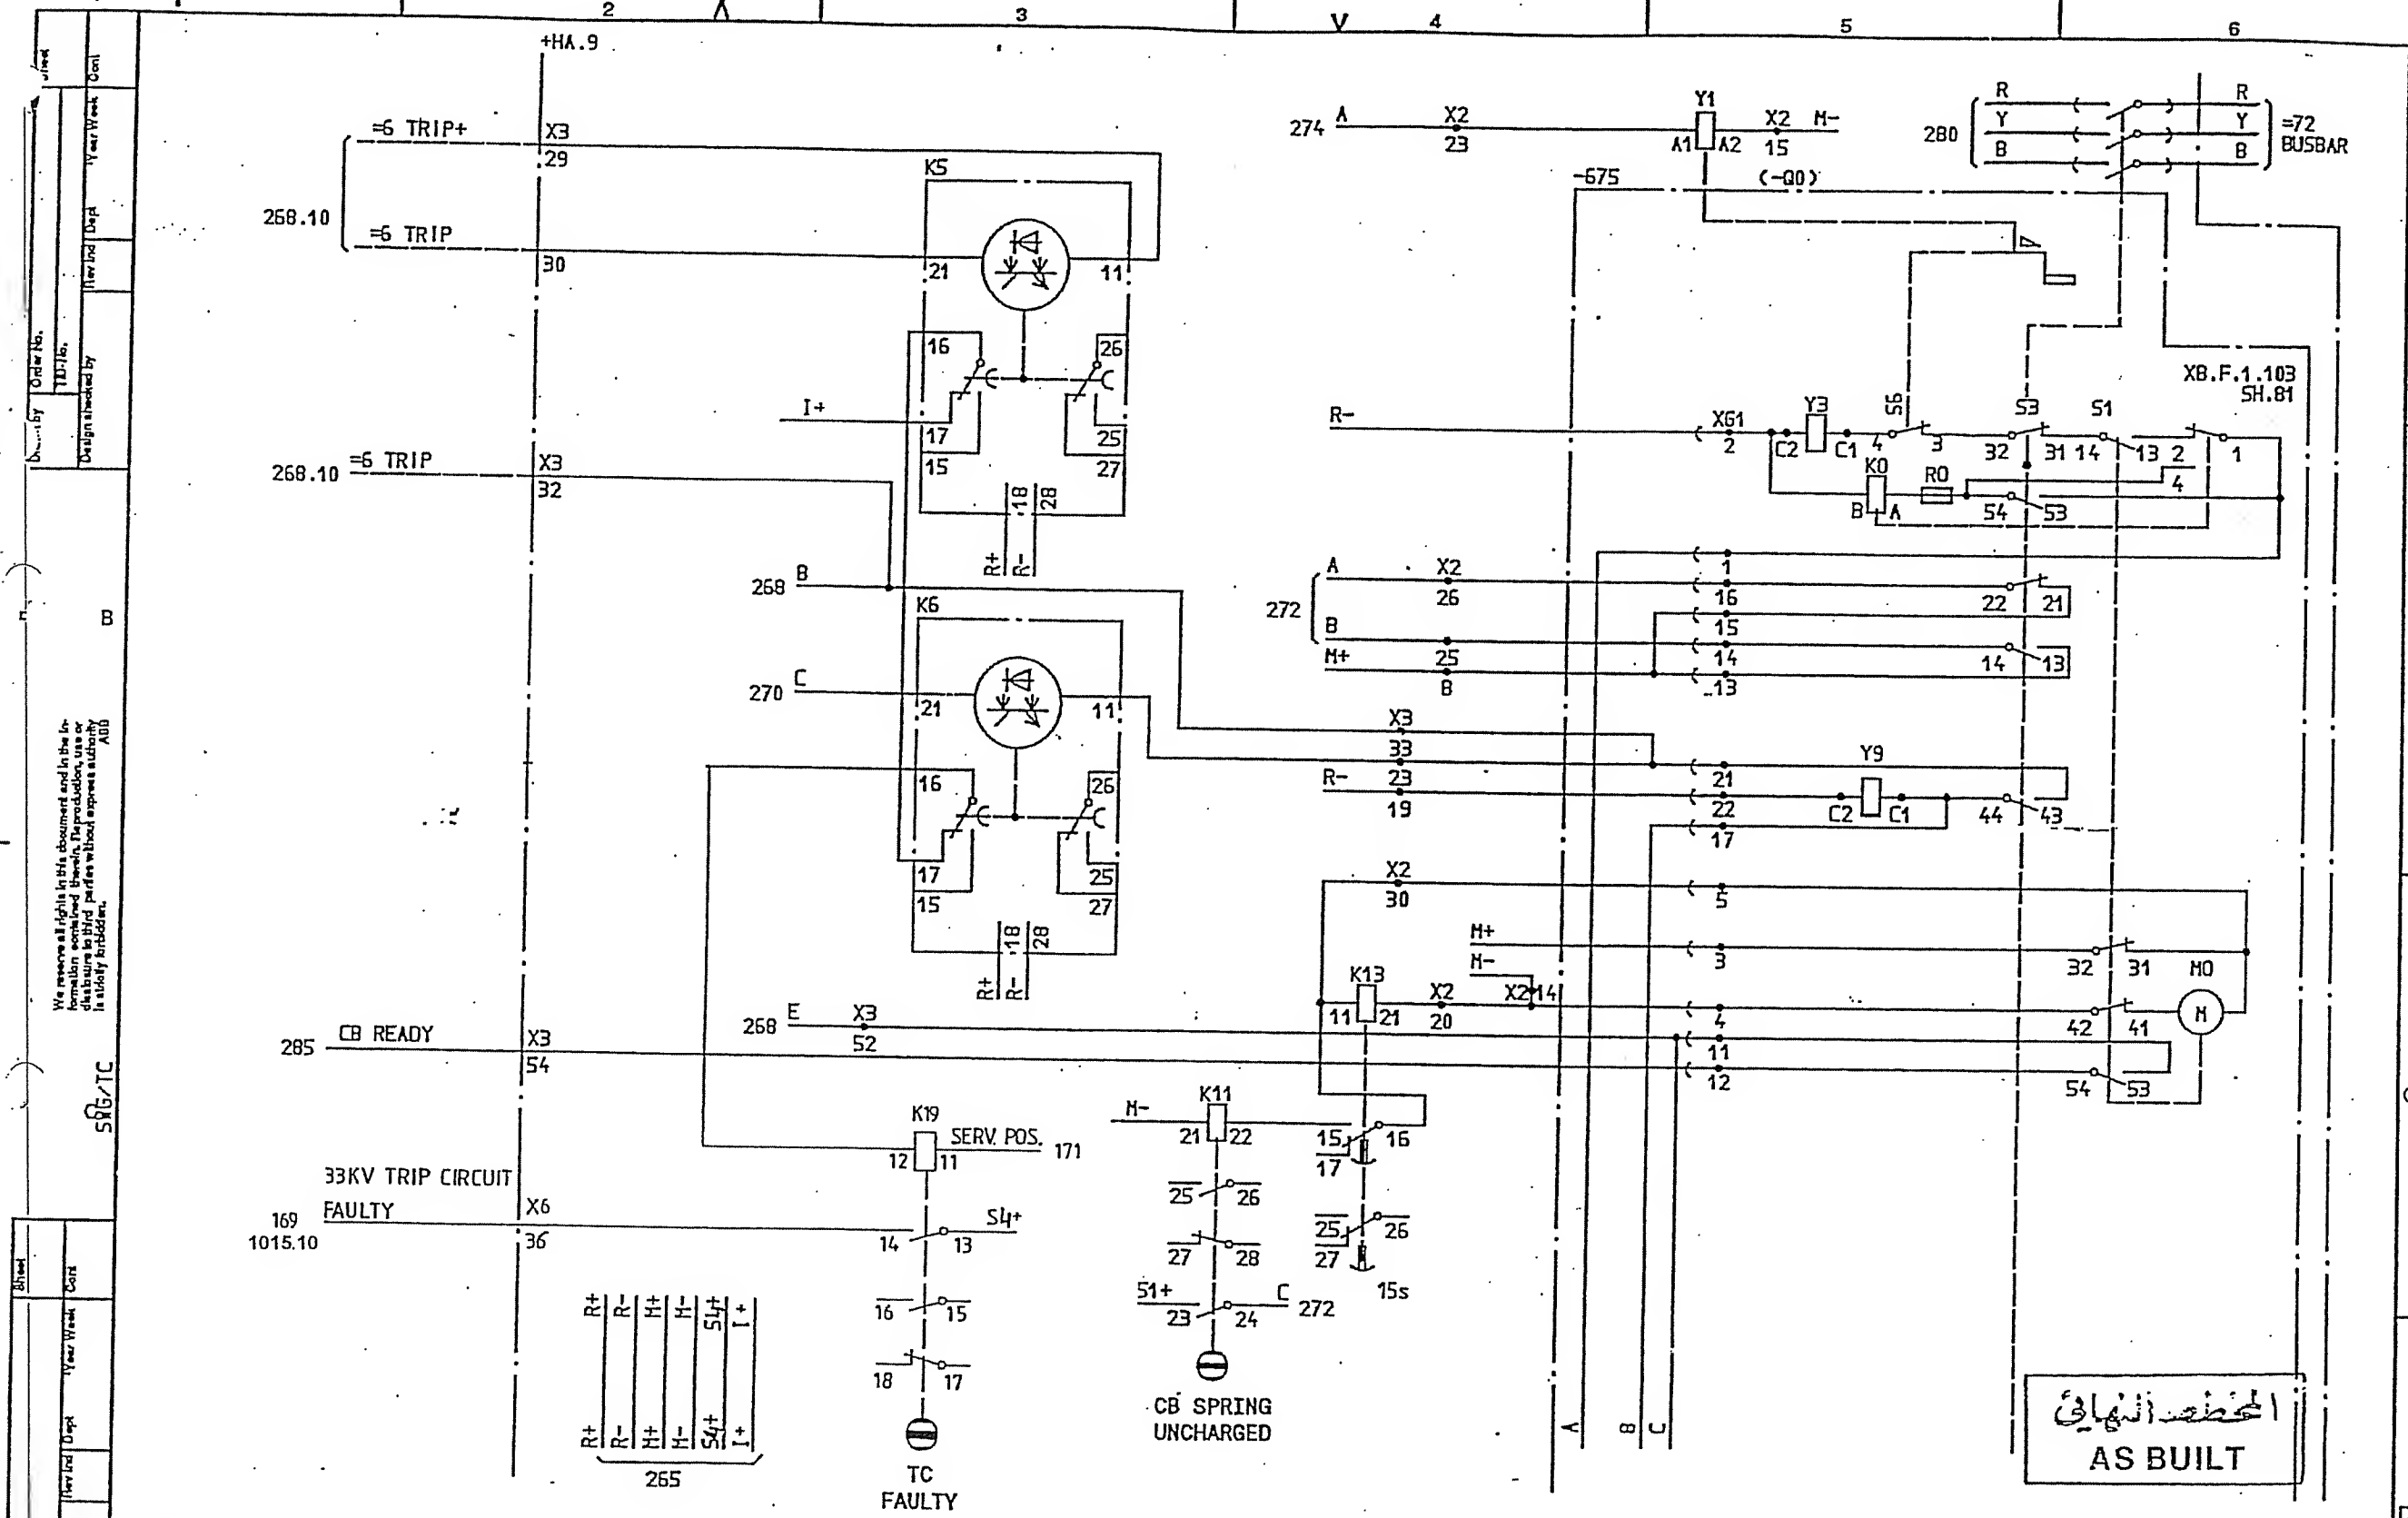269




| | | | | | | | | | | | | | | | | | |
|---------------------------------|--|--------------------------------|--|------|--|--------------------------|--|--------------------|--|-------------------|--|----------------------------|--|-------------|--|----------------|--|
| SYMBOL ID /D:XL824028-FBR:269/0 | | 92-09-09 07.33 | | =6 | | 33kV INTERCONNECTOR LINE | | CIRCUIT DIAGRAM | | S/S 8501 132/33kV | | SCECO CENTRAL SAUDI ARABIA | | L 9743.1017 | | XL 824 028-FBR | |
| 2.1 | | SCECO SNAG | | LS | | 92 26 | | Design checked by | | B NILSSON | | Circuit checked by | | L SVENSSON | | SK | |
| 1 | | AS BUILT | | LS | | 91 21 | | Drawing checked by | | L SVENSSON | | Circuit checked by | | SK | | TDCF | |
| 2 | | CIRCUIT BREAKER EQUIPMENT -675 | | Appd | | Year Week | | ABB HV SWITCHGEAR | | TDCF | | 90 36 | | L 9743.1017 | | XL 824 028-FBR | |
| 2 | | SCECO SNAG | | LS | | 92 26 | | Circuit checked by | | L SVENSSON | | Circuit checked by | | SK | | TDCF | |
| 1 | | AS BUILT | | LS | | 91 21 | | Circuit checked by | | L SVENSSON | | Circuit checked by | | SK | | TDCF | |
| 2 | | CIRCUIT BREAKER EQUIPMENT -675 | | Appd | | Year Week | | ABB HV SWITCHGEAR | | TDCF | | 90 36 | | L 9743.1017 | | XL 824 028-FBR | |
| 2 | | SCECO SNAG | | LS | | 92 26 | | Circuit checked by | | L SVENSSON | | Circuit checked by | | SK | | TDCF | |
| 1 | | AS BUILT | | LS | | 91 21 | | Circuit checked by | | L SVENSSON | | Circuit checked by | | SK | | TDCF | |
| 2 | | CIRCUIT BREAKER EQUIPMENT -675 | | Appd | | Year Week | | ABB HV SWITCHGEAR | | TDCF | | 90 36 | | L 9743.1017 | | XL 824 028-FBR | |

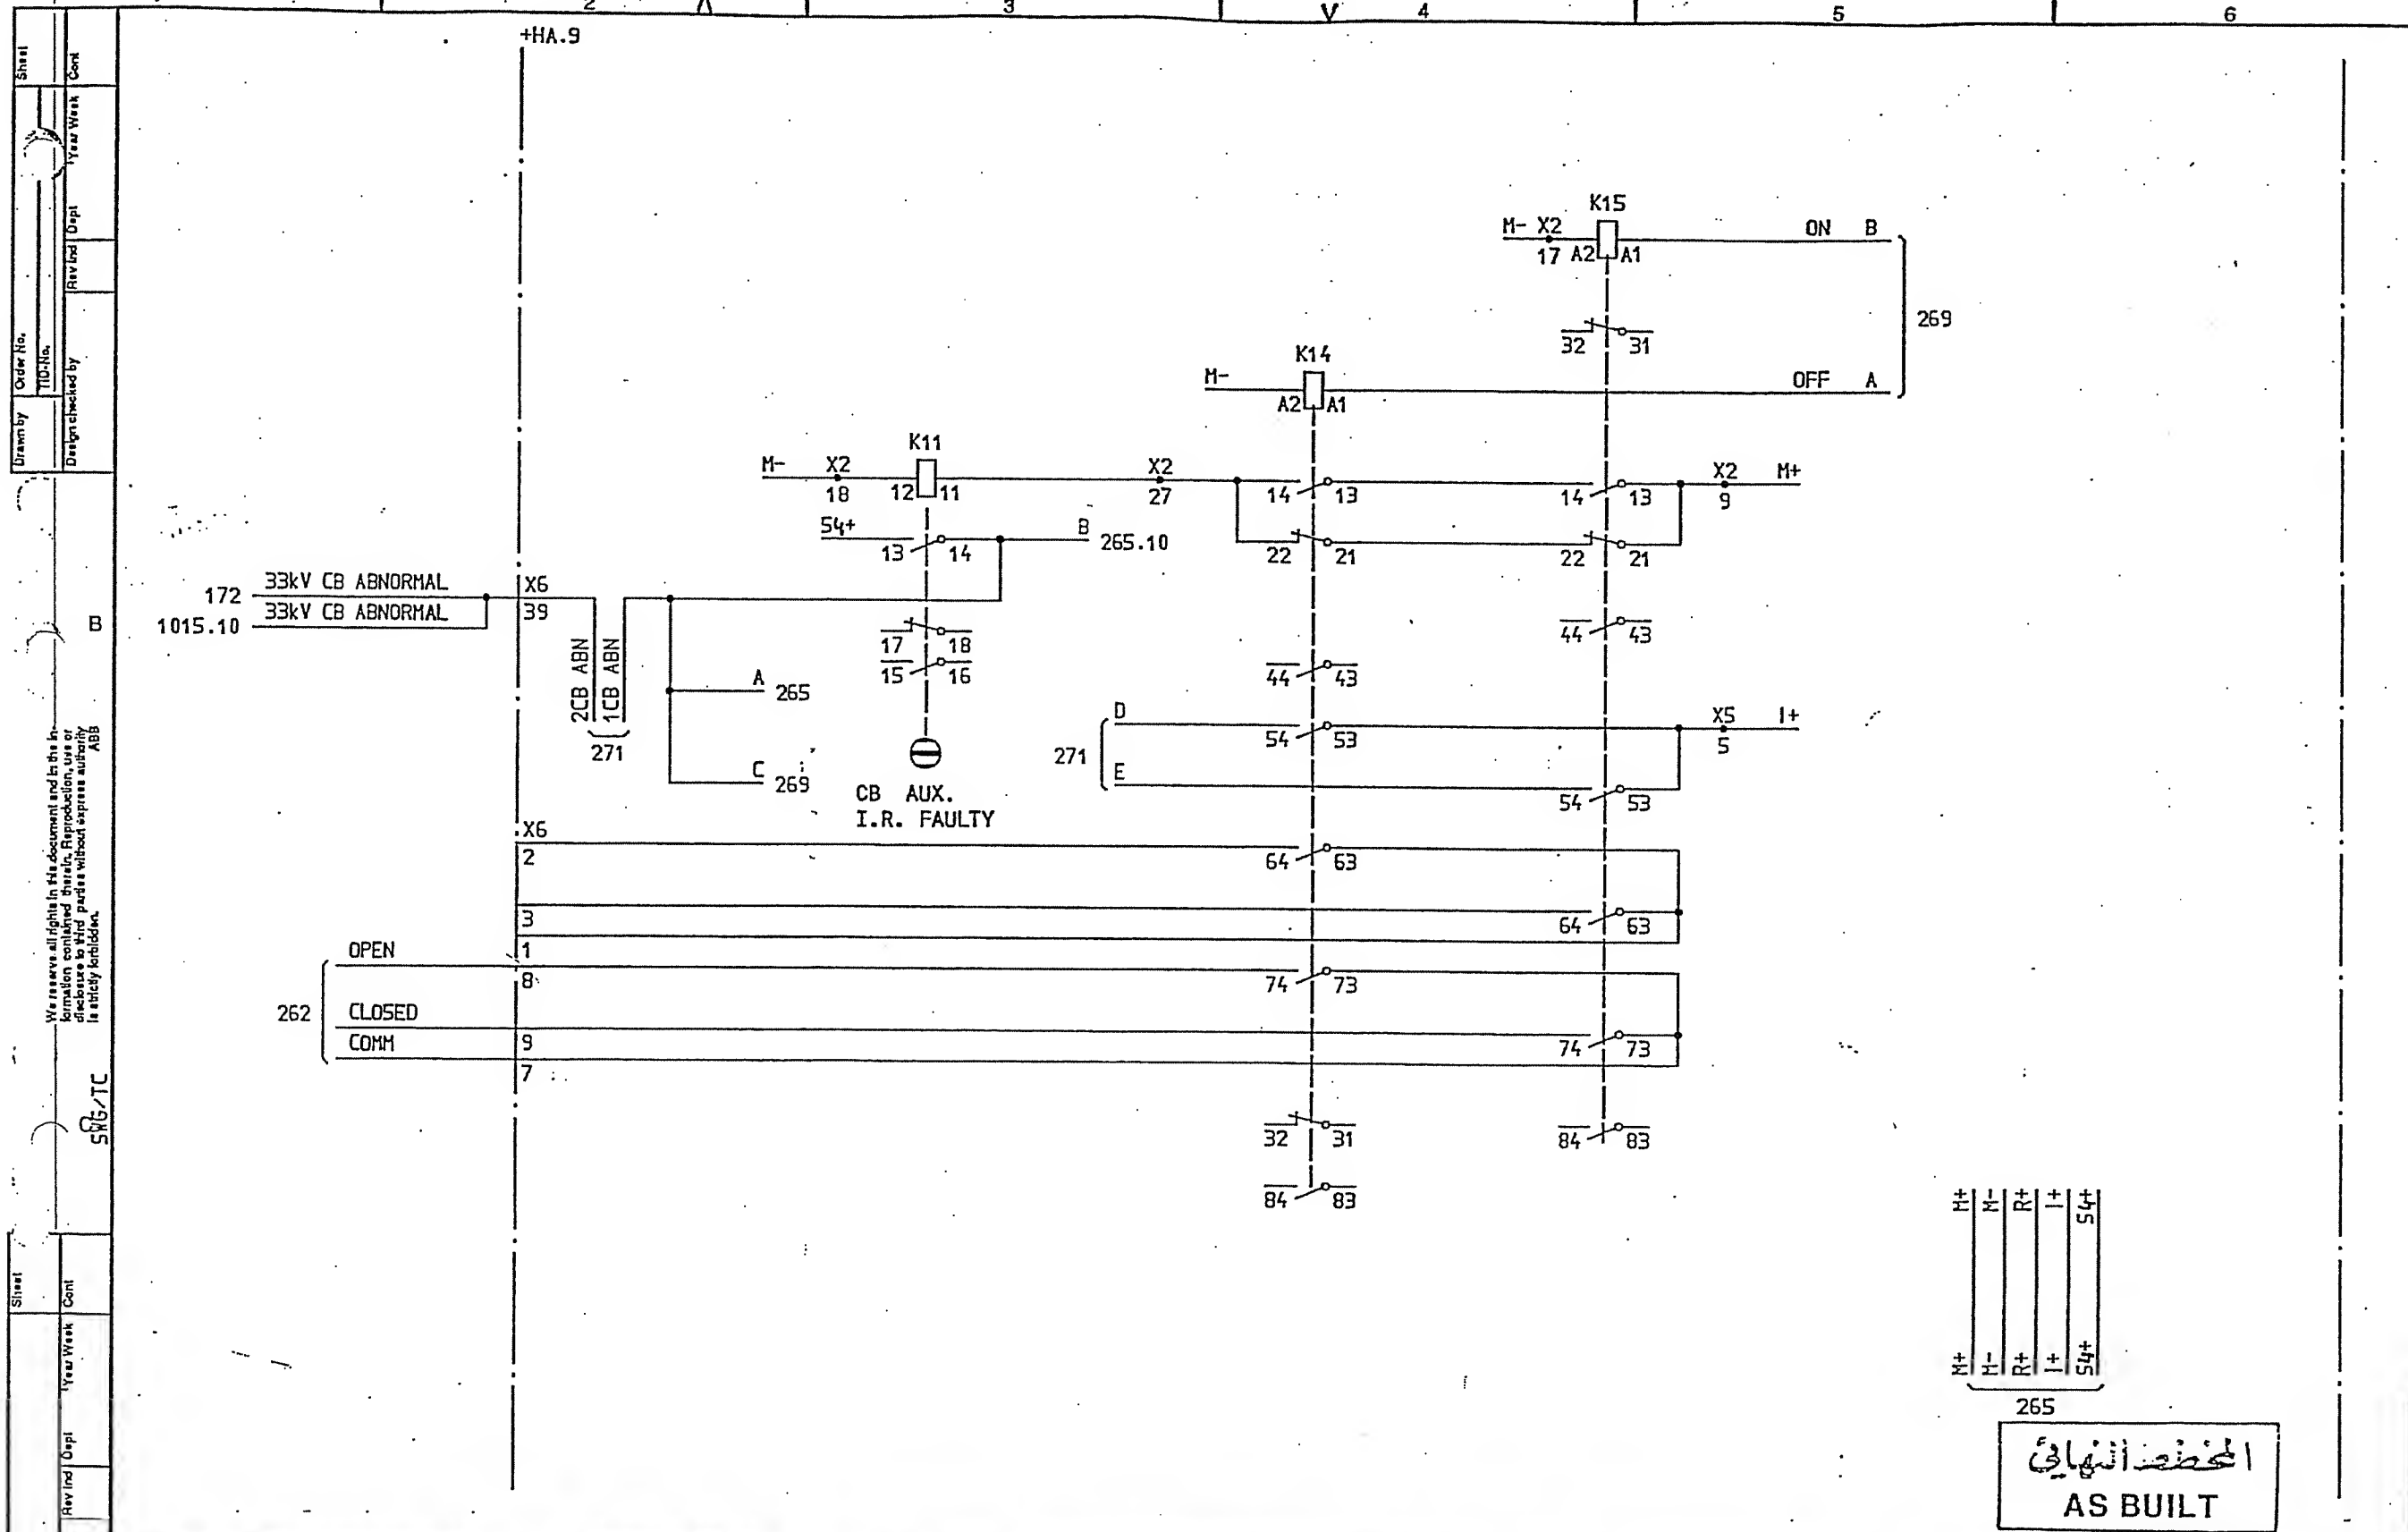


| | | | | | | | | | | | | | |
|---------------------------------|--|----------------|--|--------------------------------|--|--------------------------|--|----------------------------------|--|-------------------------------------|--|---------------|--|
| SYMBOL TO /D:XL824028-FBR:2/2/0 | | 92-07-02 18.54 | | =6 | | 33kV INTERCONNECTOR LINE | | Design checked by B NILSSON | | CIRCUIT DIAGRAM | | Rev Ind Sheet | |
| 2 SCECO SNAG | | LS 92 26 | | | | | | Drawing checked by L SVENSSON | | S/S 8501 132/33kV | | 272 | |
| 1 AS BUILT | | LS 91 21 | | | | | | Drawn by SK | | SCECO CENTRAL SAUDI ARABIA | | 273 | |
| Rev Ind Revision | | Appd Year Week | | CIRCUIT BREAKER EQUIPMENT -675 | | | | ABB HV SWITCHGEAR | | Iss by Dept Year Week TDCF 90 36 | | 2 | |

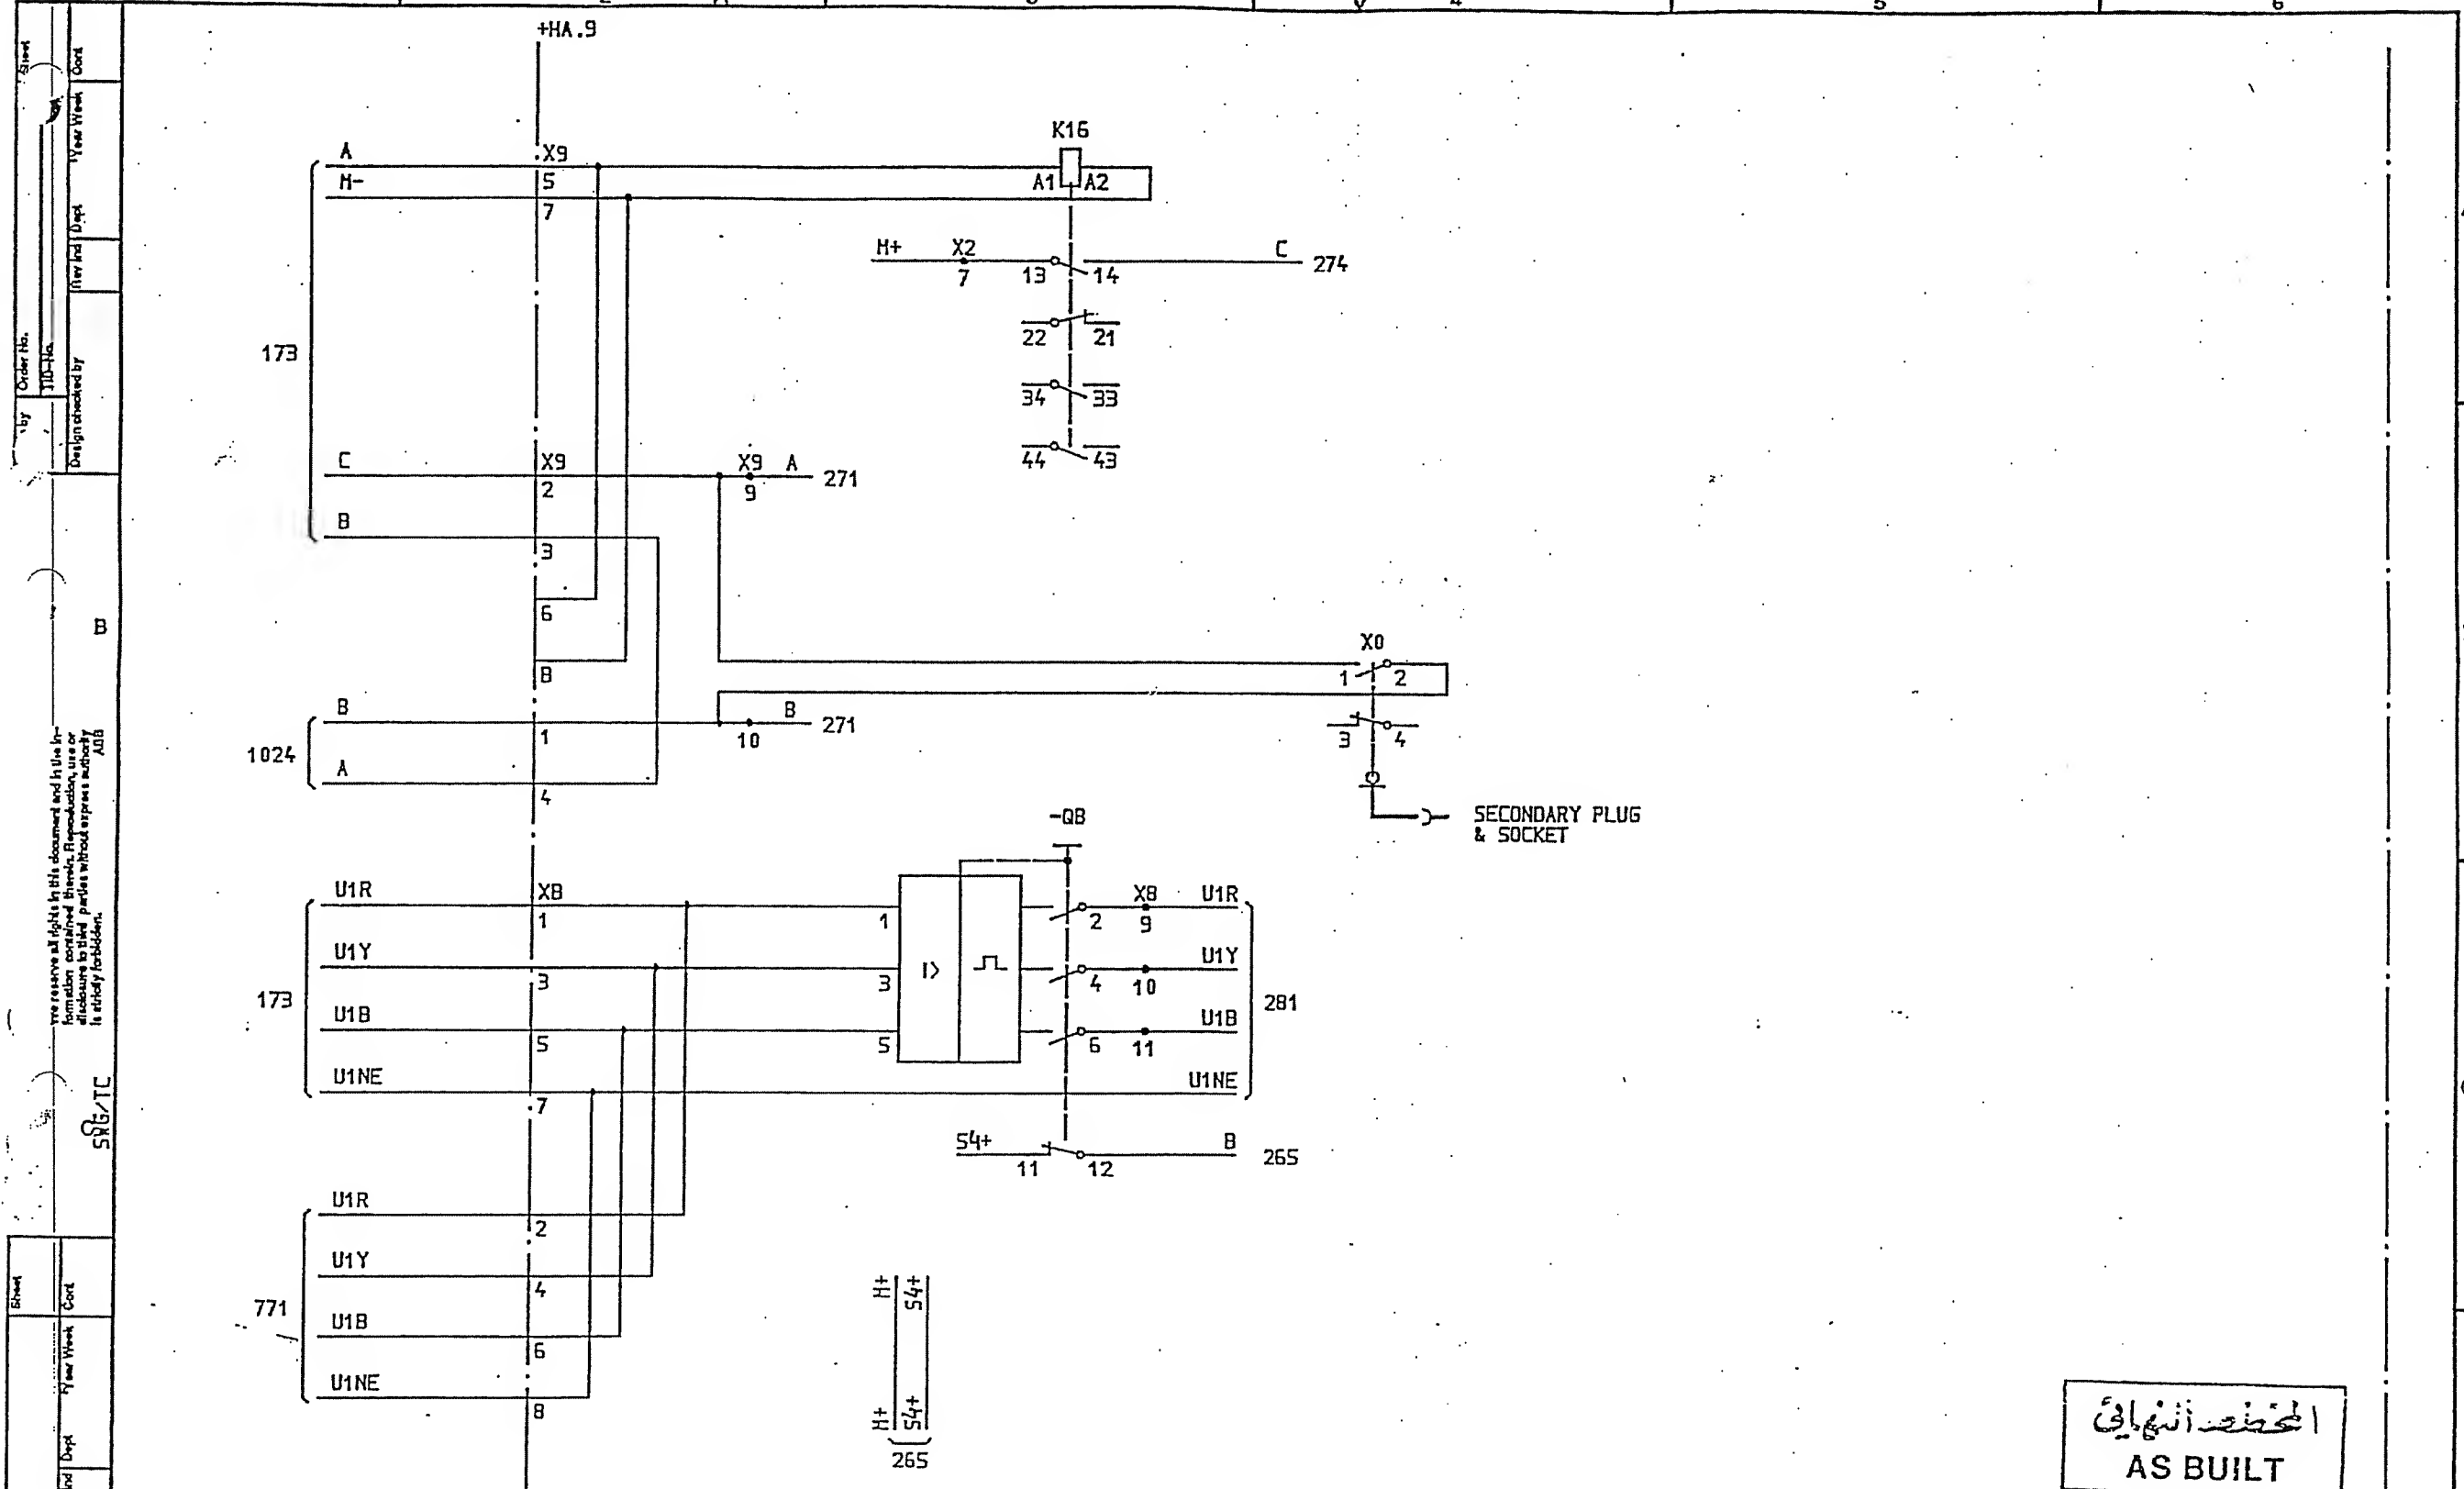L 9743.1017
XL 824 028-FBR




المخطط النهائي
AS BUILT

| | | | | | | | | | |
|---------------------------------|--|--------------------------|--|-----------------------------------|--|----------------------------|--|---------------|--|
| SYMBOL ID /D:XL824028-FBR:273/0 | | DATE 91-06-06 12.05 | | Design checked by B NILSSON | | CIRCUIT DIAGRAM | | Rev Ind Sheet | |
| =6 | | 33kV INTERCONNECTOR LINE | | Drawing checked by L SVENSSON | | S/S 8501 132/33kV | | Ling Sheet | |
| AS BUILT | | L5 91 21 | | Drawn by SK | | SCECO CENTRAL SAUDI ARABIA | | Rev Ind Sheet | |
| 1 | | 2 | | INTERLOCKING RELAY FOR C.B. TRUCK | | ABB HV SWITCHGEAR | | 1 273 | |
| Rev Ind Revision | | Appd Year Week | | Line by Dept Year Week | | TDCF 90 36 | | 1 274 | |

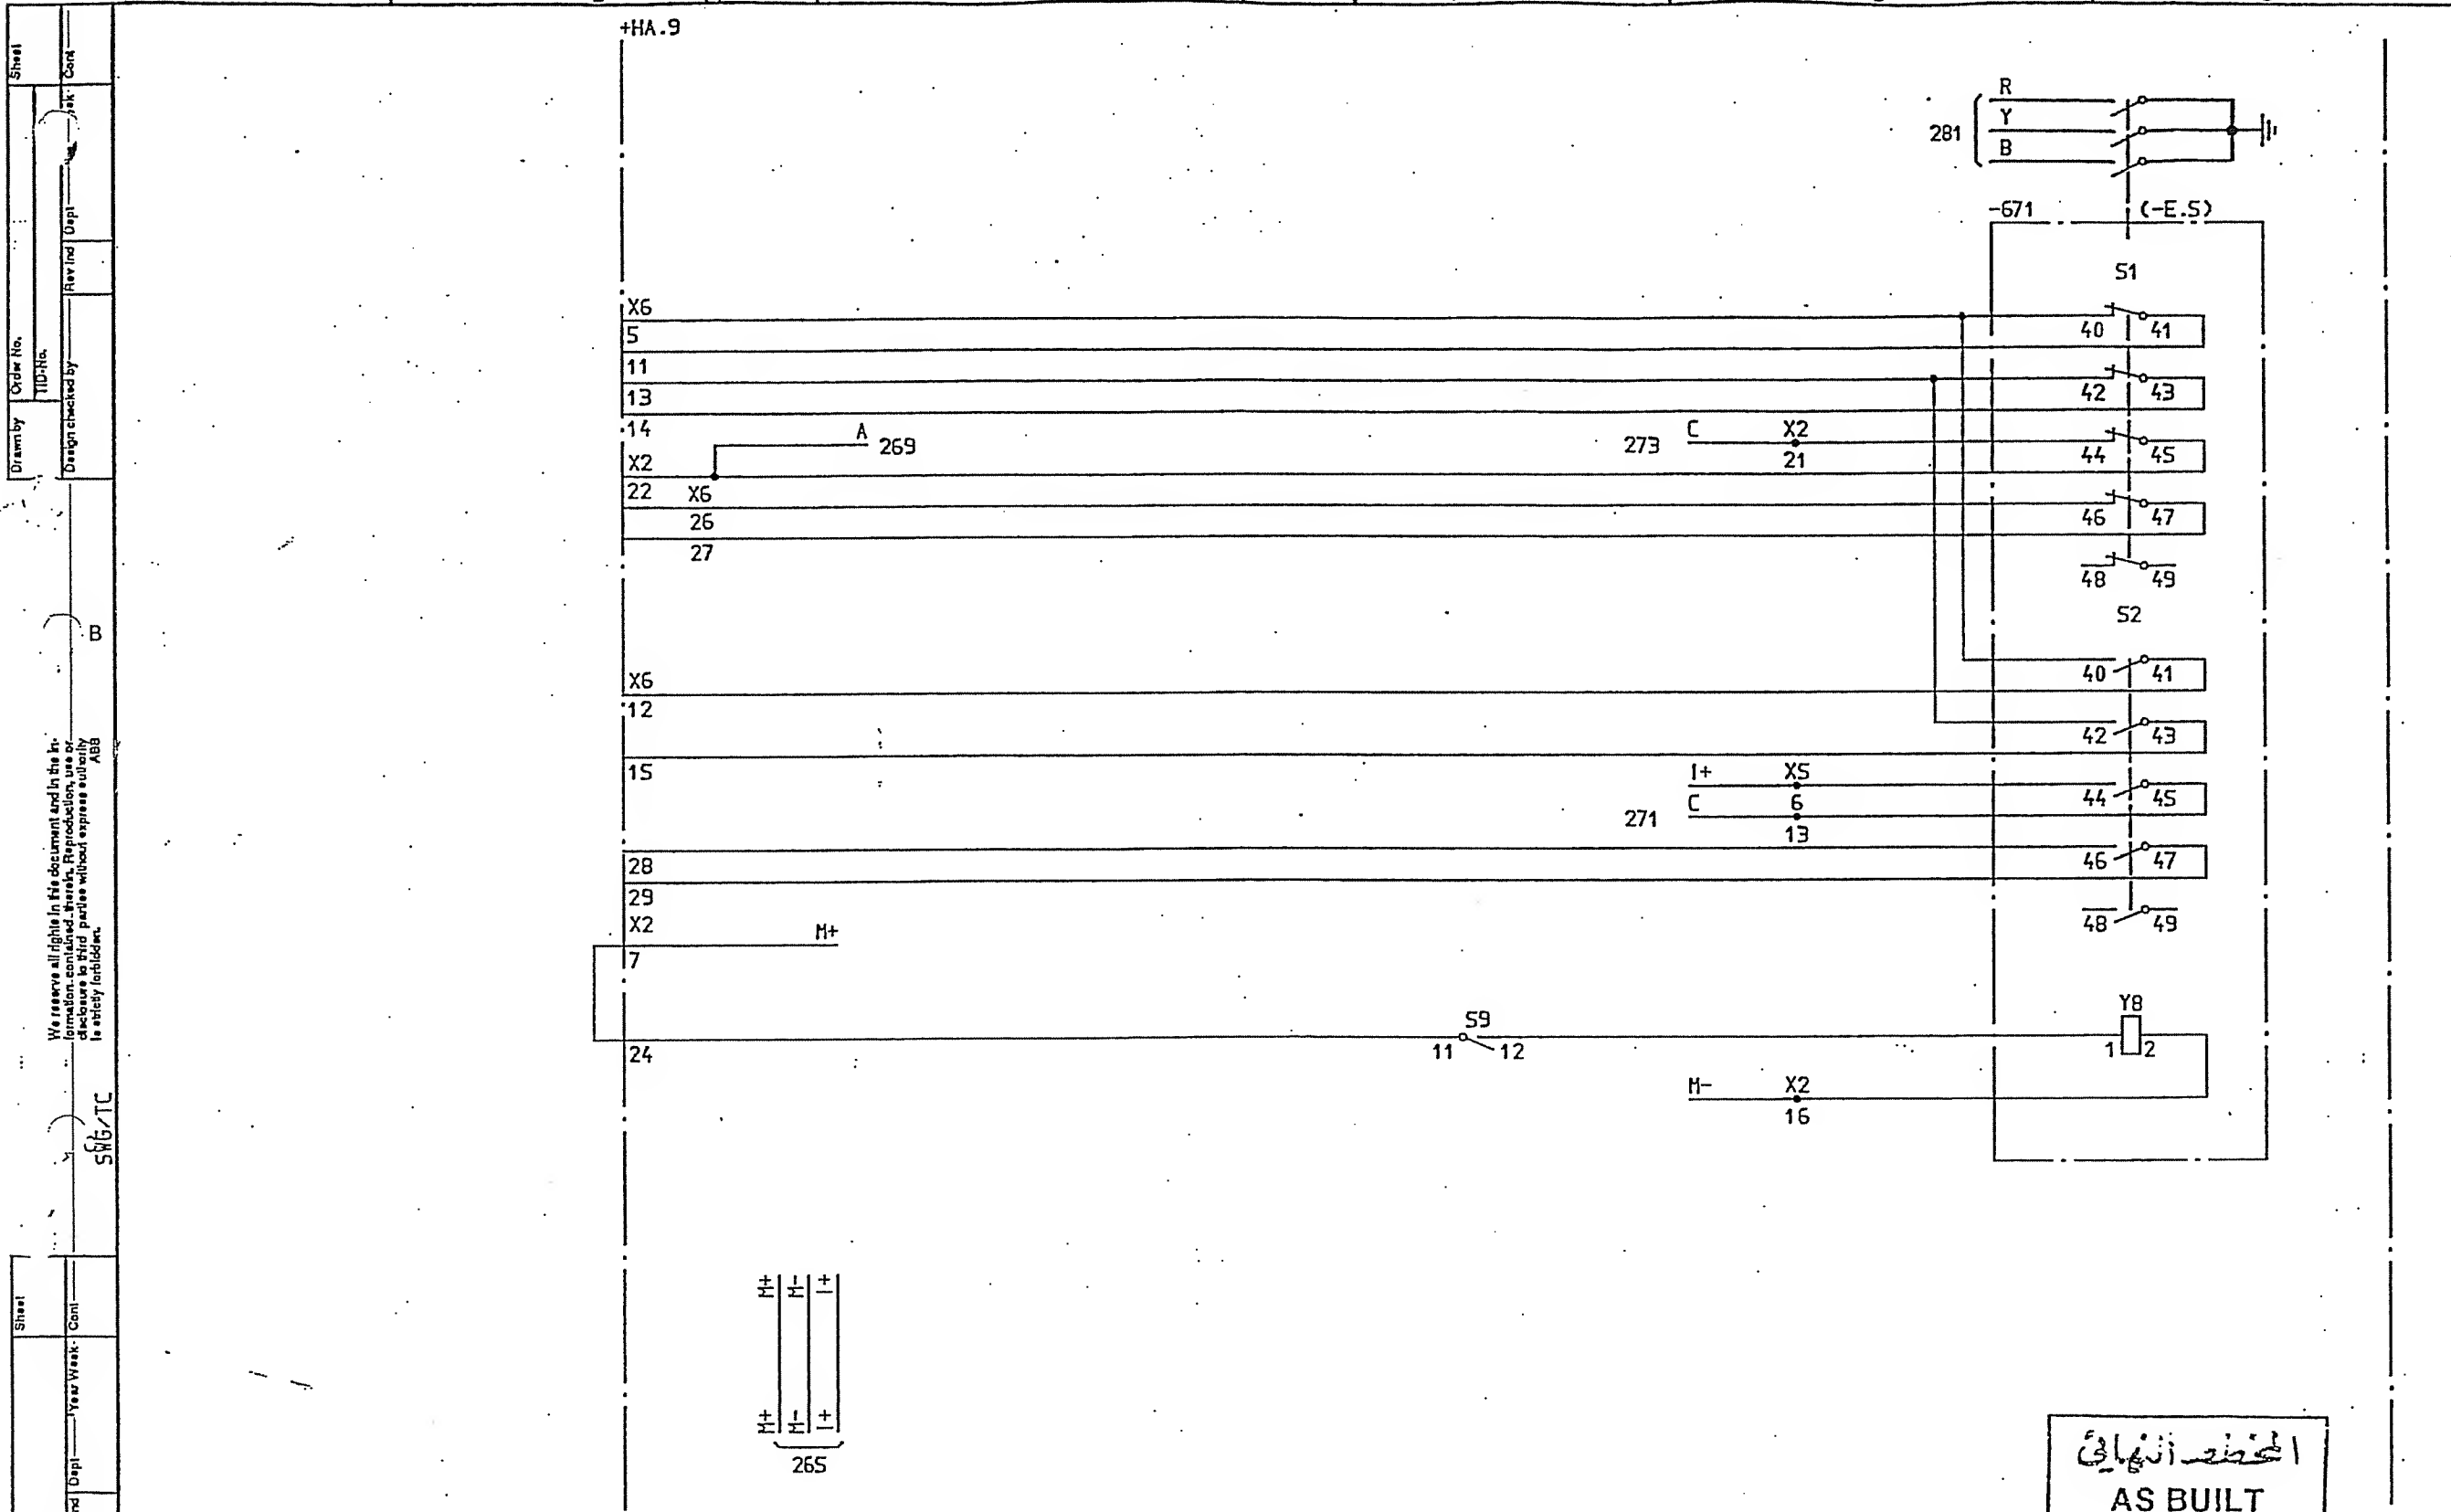

| | | | | | | | | | | | | | | | | | | | |
|---------------------------------|------------|----------------|-------|----|-------|--------------------------|-----------|-----------------------------|-----------|--------------------|------------|-------------------|----|----------------------------|------|-------------|-------|----------------|-------|
| SYMBOL ID /D:XL824028-FBR:274/0 | | 92-07-02 18.54 | | =6 | | 33kV INTERCONNECTOR LINE | | EARTH SWITCH EQUIPMENT -671 | | CIRCUIT DIAGRAM | | S/S 8501 132/33kV | | SCECO CENTRAL SAUDI ARABIA | | L 9743.1017 | | XL 824.028-FBR | |
| 2 | SCECO SNAG | LS | 92 26 | LS | 91 21 | Appd | Year Week | Design checked by | B NILSSON | Drawing checked by | L SVENSSON | Drawn by | SK | by Dept | TDCF | Year Week | 90 36 | Rev Ind | Sheet |
| 1 | AS BUILT | LS | 91 21 | LS | 91 21 | Appd | Year Week | Design checked by | B NILSSON | Drawing checked by | L SVENSSON | Drawn by | SK | by Dept | TDCF | Year Week | 90 36 | Rev Ind | Sheet |
| 2 | | LS | 92 26 | LS | 91 21 | Appd | Year Week | Design checked by | B NILSSON | Drawing checked by | L SVENSSON | Drawn by | SK | by Dept | TDCF | Year Week | 90 36 | Rev Ind | Sheet |
| 1 | | LS | 91 21 | LS | 91 21 | Appd | Year Week | Design checked by | B NILSSON | Drawing checked by | L SVENSSON | Drawn by | SK | by Dept | TDCF | Year Week | 90 36 | Rev Ind | Sheet |

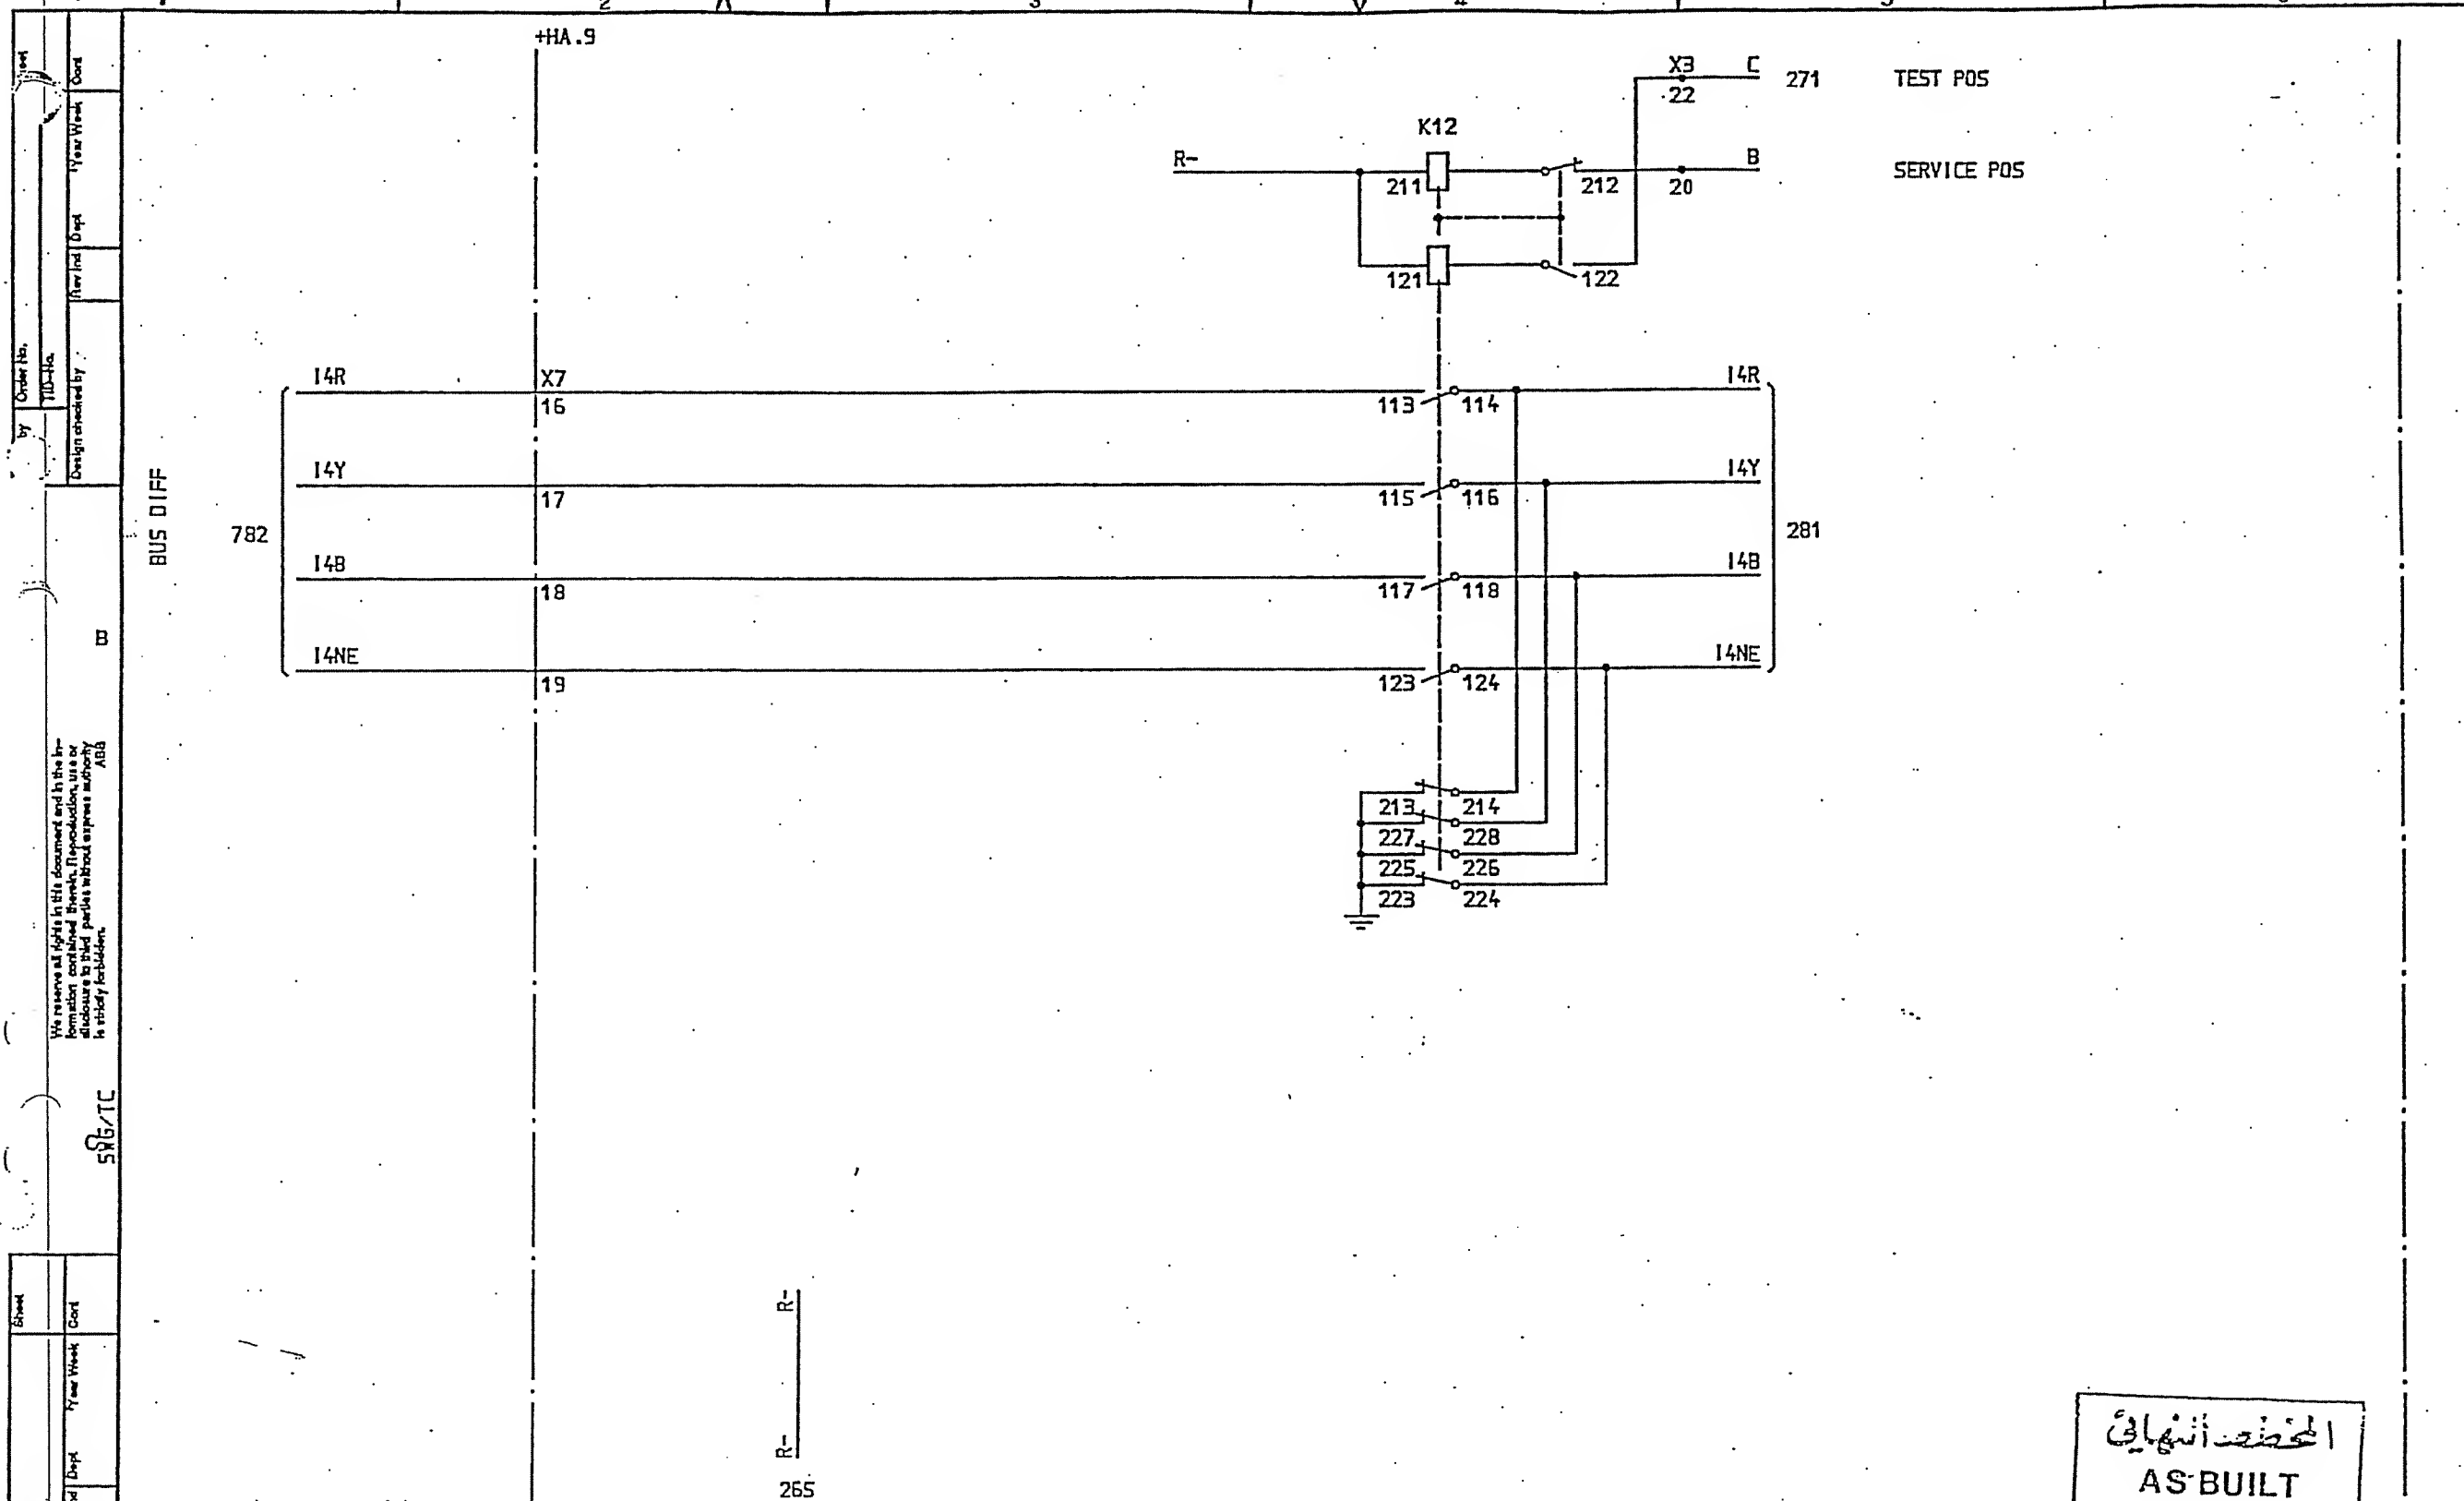

المخطط النهائي
AS BUILT

SYMBOL ID /D:XL824028-FBR:276/0

DATE 91-06-04 09.08

| Rev | Inc | Revision |
|-----|-----|----------|
| 1 | | AS BUILT |

| Appd | Year Week |
|------|-----------|
| LS | 91 21 |

=6
33kV INTERCONNECTOR LINE
C.T. SHORTING RELAY

| |
|----------------------------------|
| Design checked by B NILSSON |
| Drawing checked by L SVENSSON |
| Drawn by SK |


CIRCUIT DIAGRAM
S/S 8501 132/33kV
SCECO CENTRAL SAUDI ARABIA
ABB HV SWITCHGEAR

| Iss by Dept | Year Week |
|-------------|-----------|
| TDCF | 90 36 |

L 9743.1017
XL 824 028-FBR

| Rev | Inc | Sheet |
|-----|-----|-------|
| 1 | | 276 |

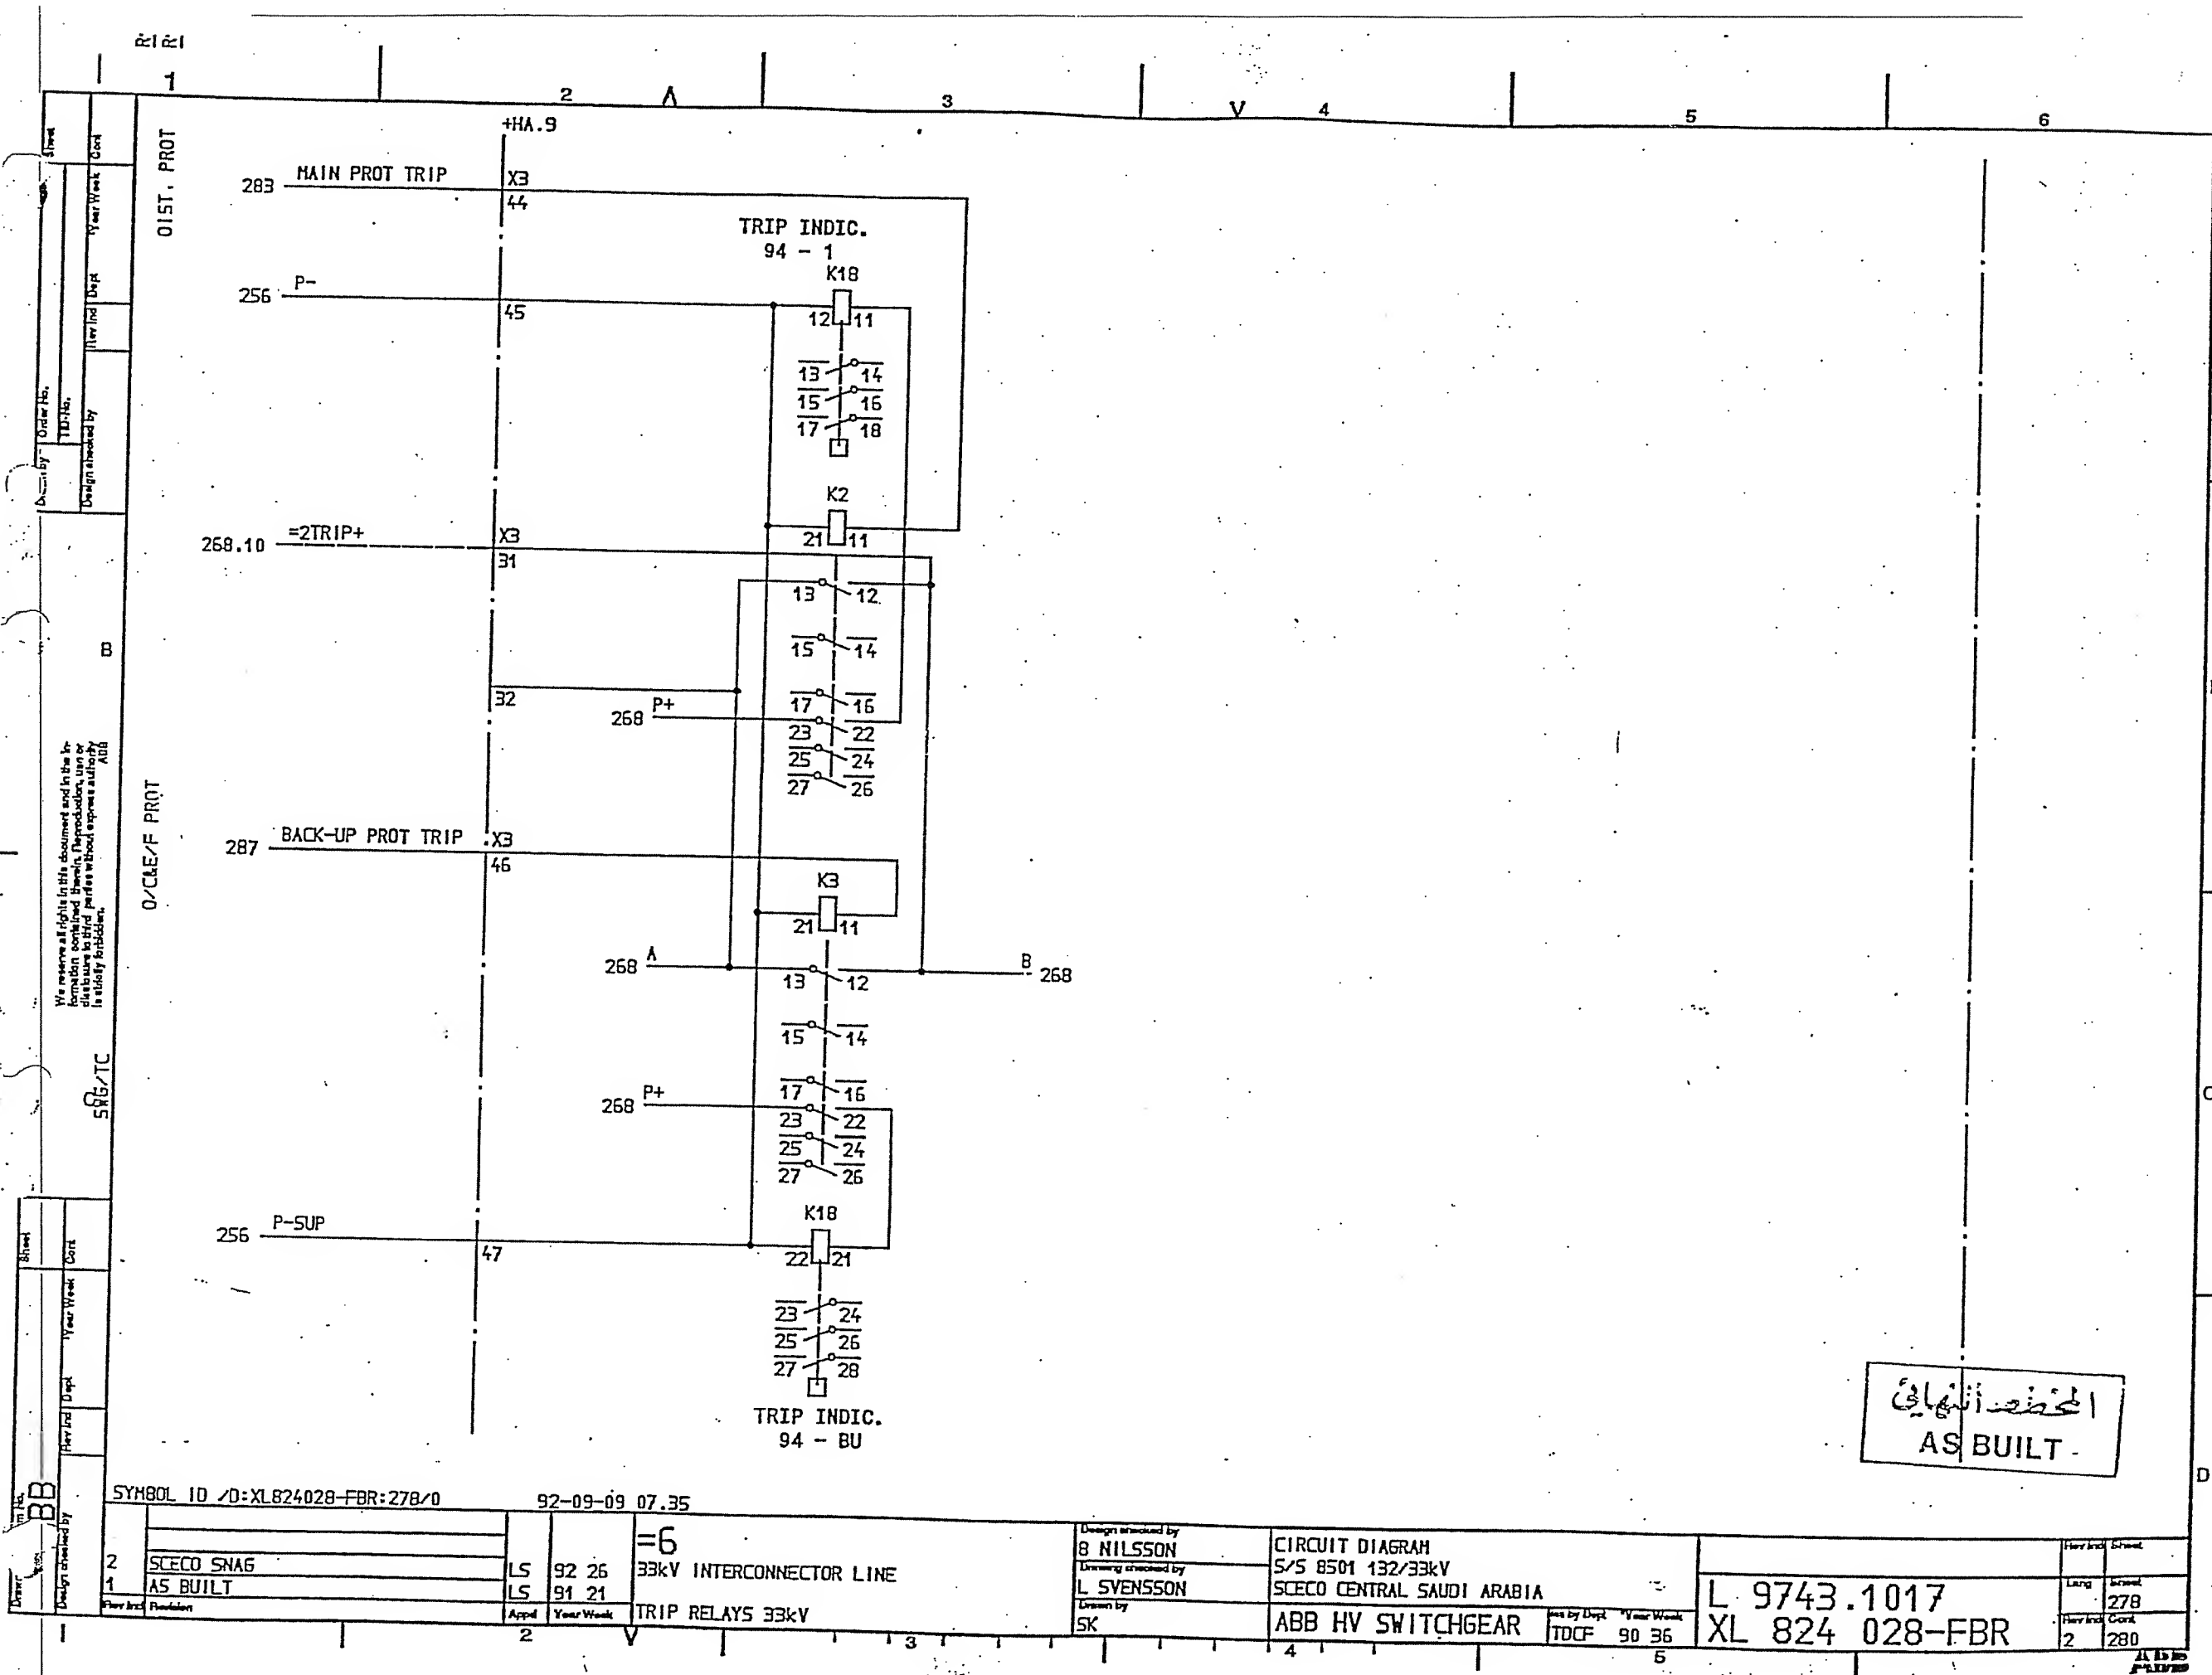ABB



المحطة النهائية
AS BUILT

SYH80L ID /D:XL824028-FBR:278/0

92-09-09 07.35

| | | | |
|---|----|-------|--------------------------|
| 2 | LS | 92 26 | =6 |
| 1 | LS | 91 21 | 33kV INTERCONNECTOR LINE |
| | | | TRIP RELAYS 33kV |

Design checked by
B NILSSON
Drawing checked by
L SVENSSON
Drawn by
SK


CIRCUIT DIAGRAM
S/S 8501 132/33kV
SCECO CENTRAL SAUDI ARABIA
ABB HV SWITCHGEAR

Issued by Dept. Year Week
TDCF 90 36 5

L 9743.1017
XL 824 028-FBR


| | |
|----------|-------|
| Drawn by | Sheet |
| 2 | 278 |
| 2 | 280 |

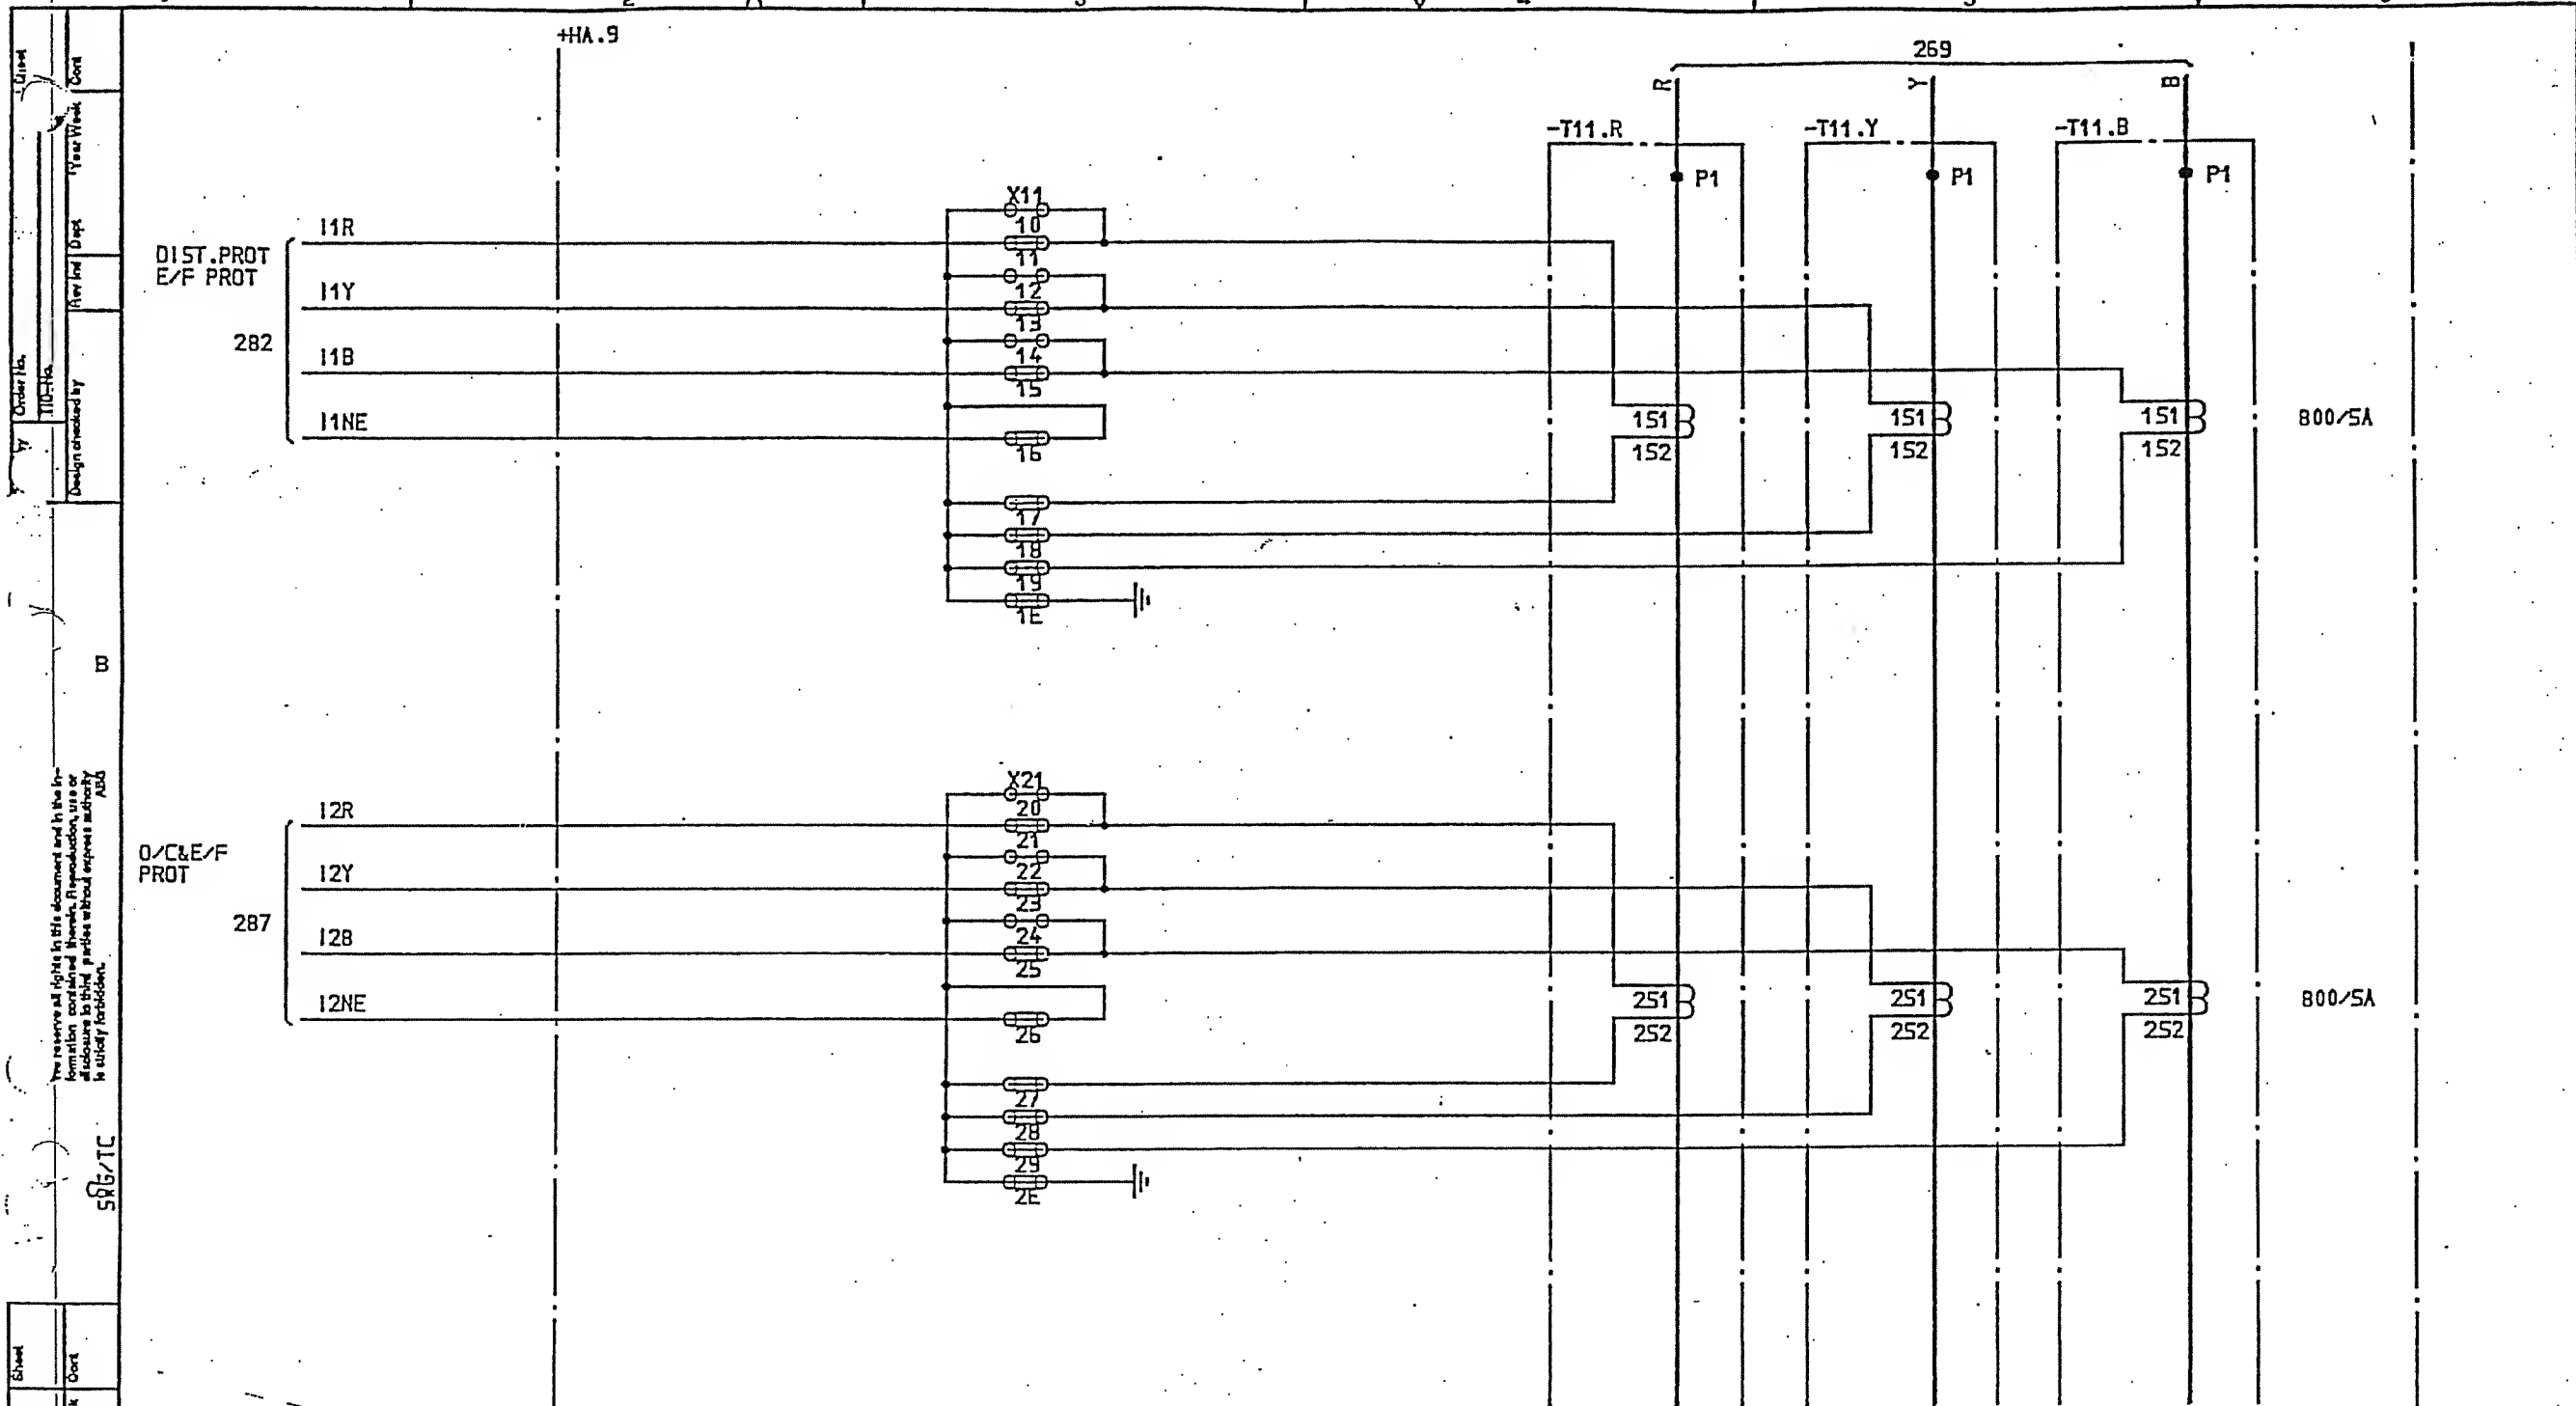
AS BUILT



الحظ النهائي
AS BUILT

| | | | | | | | | |
|---------------------------------|---------------------|--------------------------------|--|----------------------------------|---|--|---------|-------|
| SYMBOL ID /D:XL824028-FBR:280/0 | DATE 91-06-06 12.07 | =6 33kV INTERCONNECTOR LINE | | Design checked by B NILSSON | CIRCUIT DIAGRAM | | Rev Ind | Sheet |
| AS BUILT | L5 91 21 | CURRENT TRANSFORMER -T11 | | Drawing checked by L SVENSSON | S/S 8501 132/33kV SCECD CENTRAL SAUDI ARABIA | | Long | 280 |
| | | | | Drawn by SK | ABB HV SWITCHGEAR | | Rev Ind | 281 |
| | | | | | TUCF 90 36 | | Long | 280 |
| | | | | | L 9743.1017 XL 824 028-FBR | | Rev Ind | 281 |

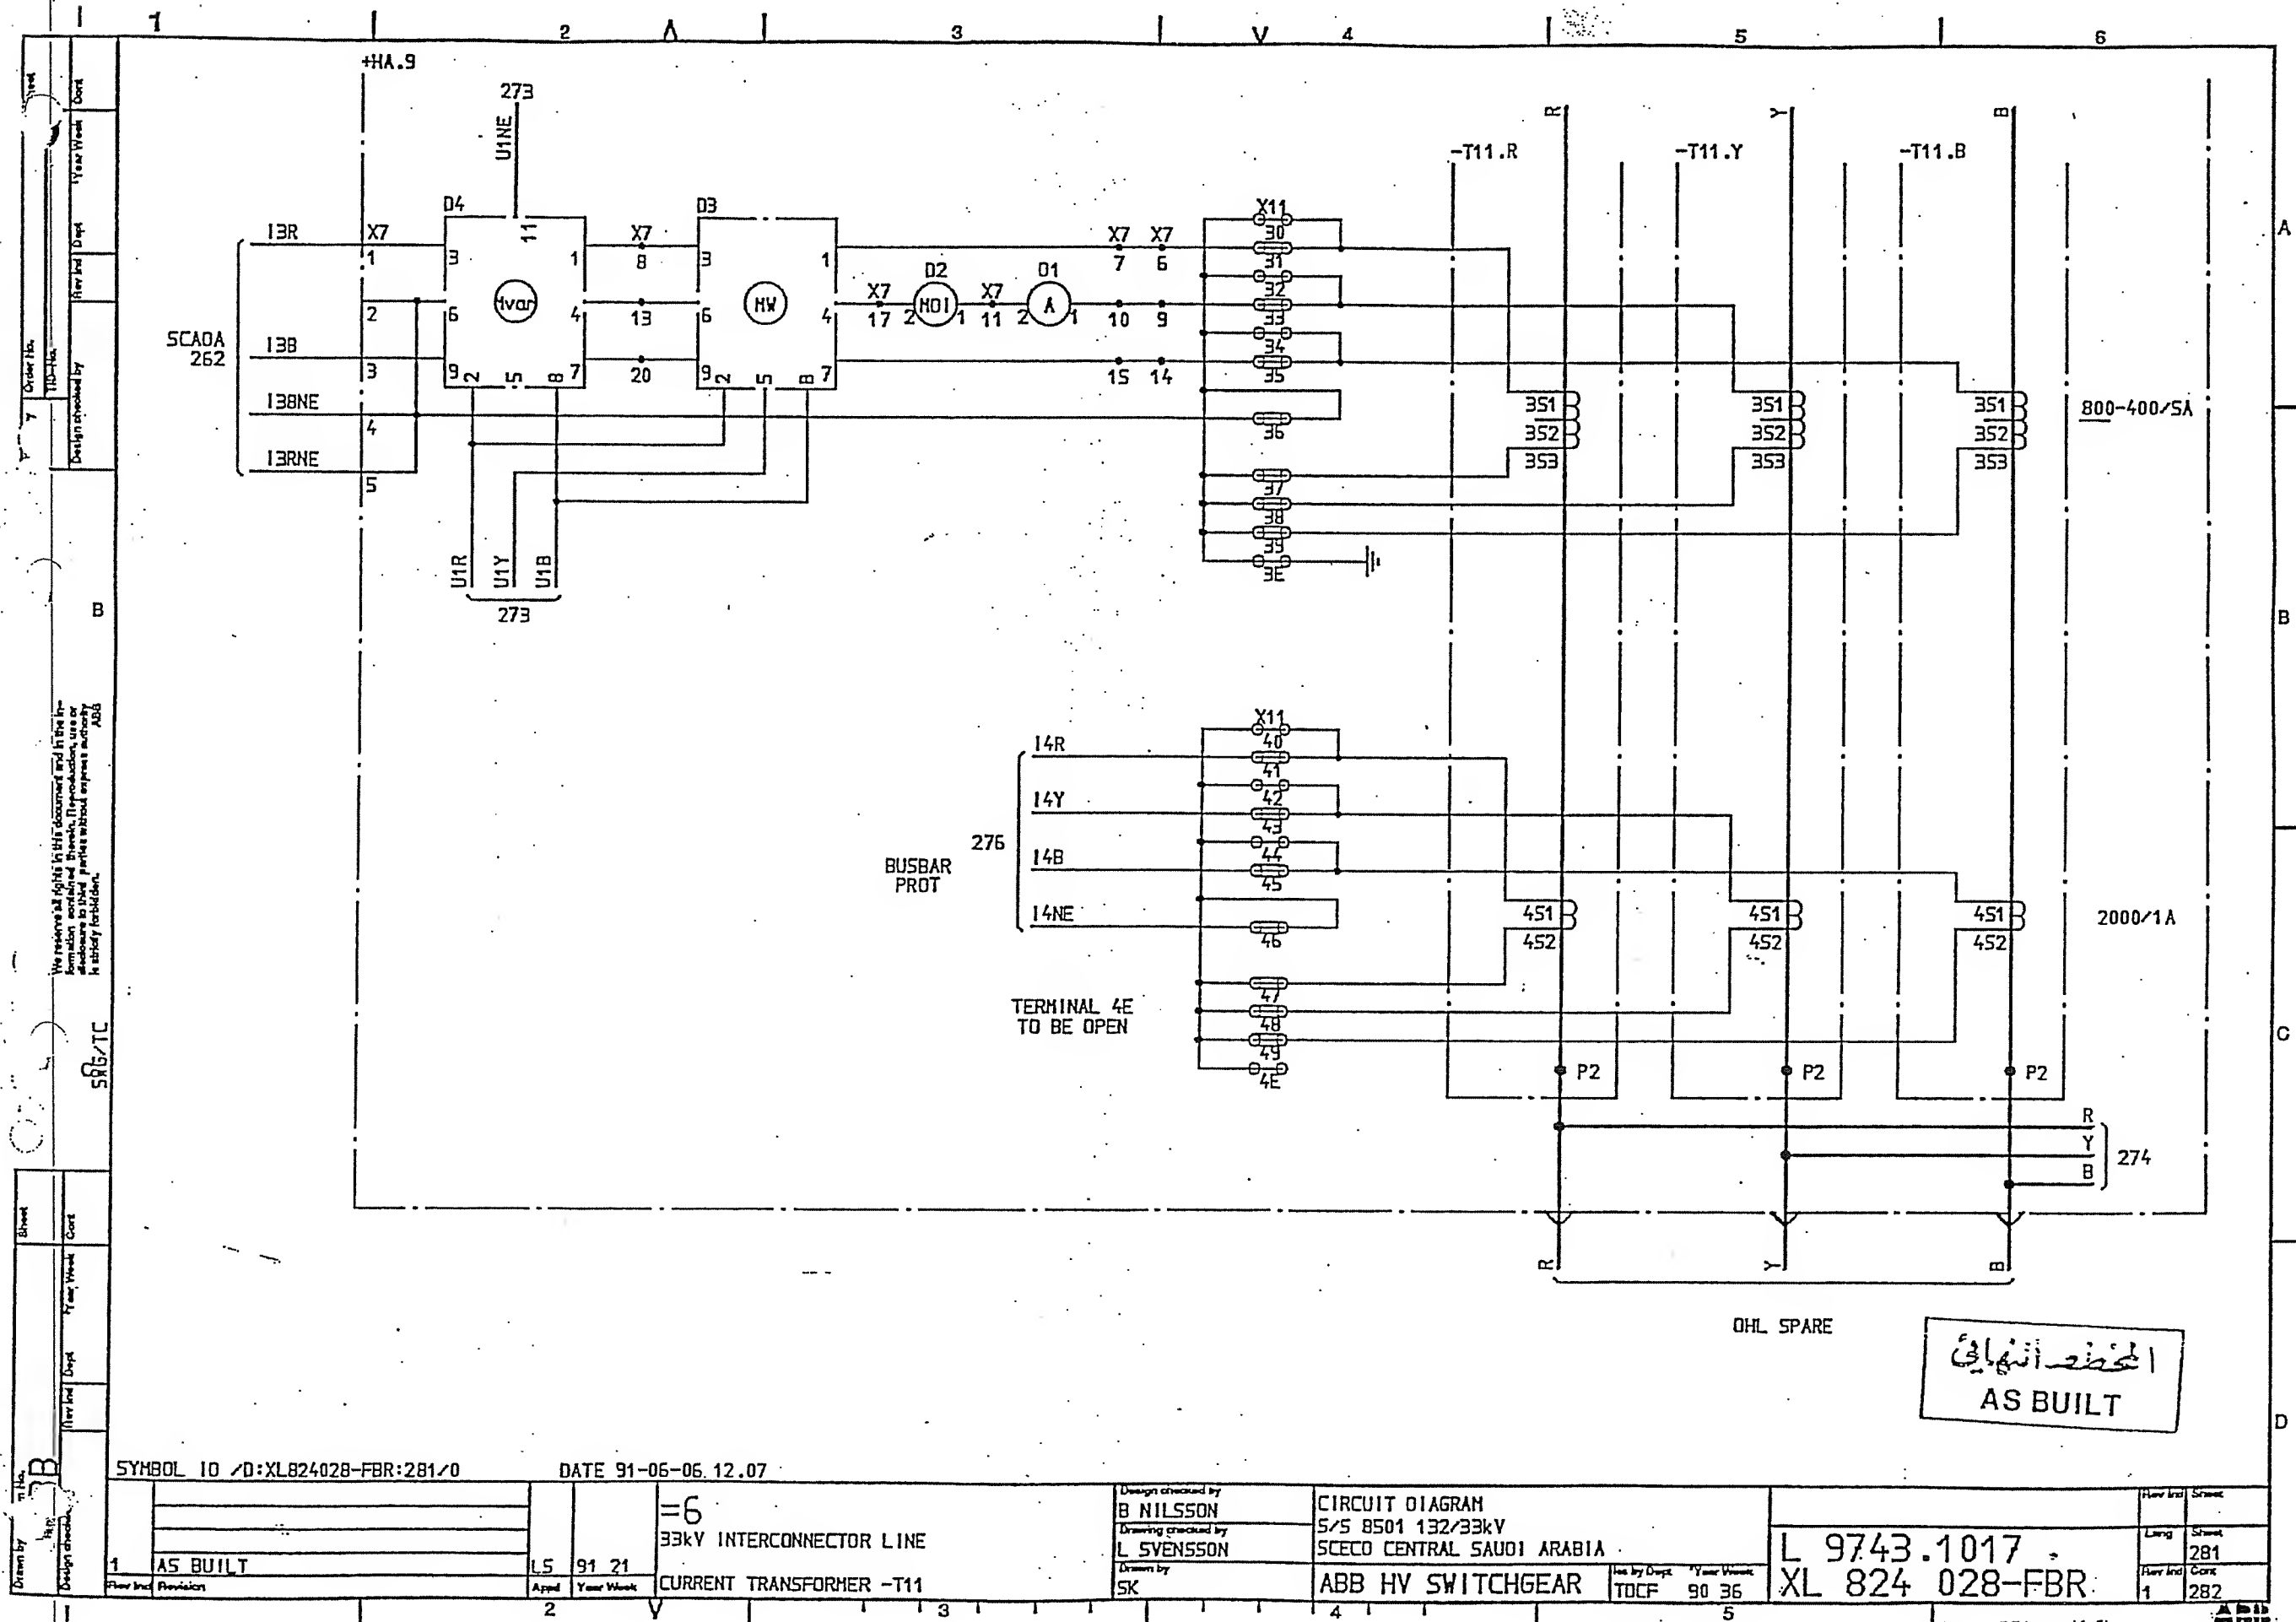

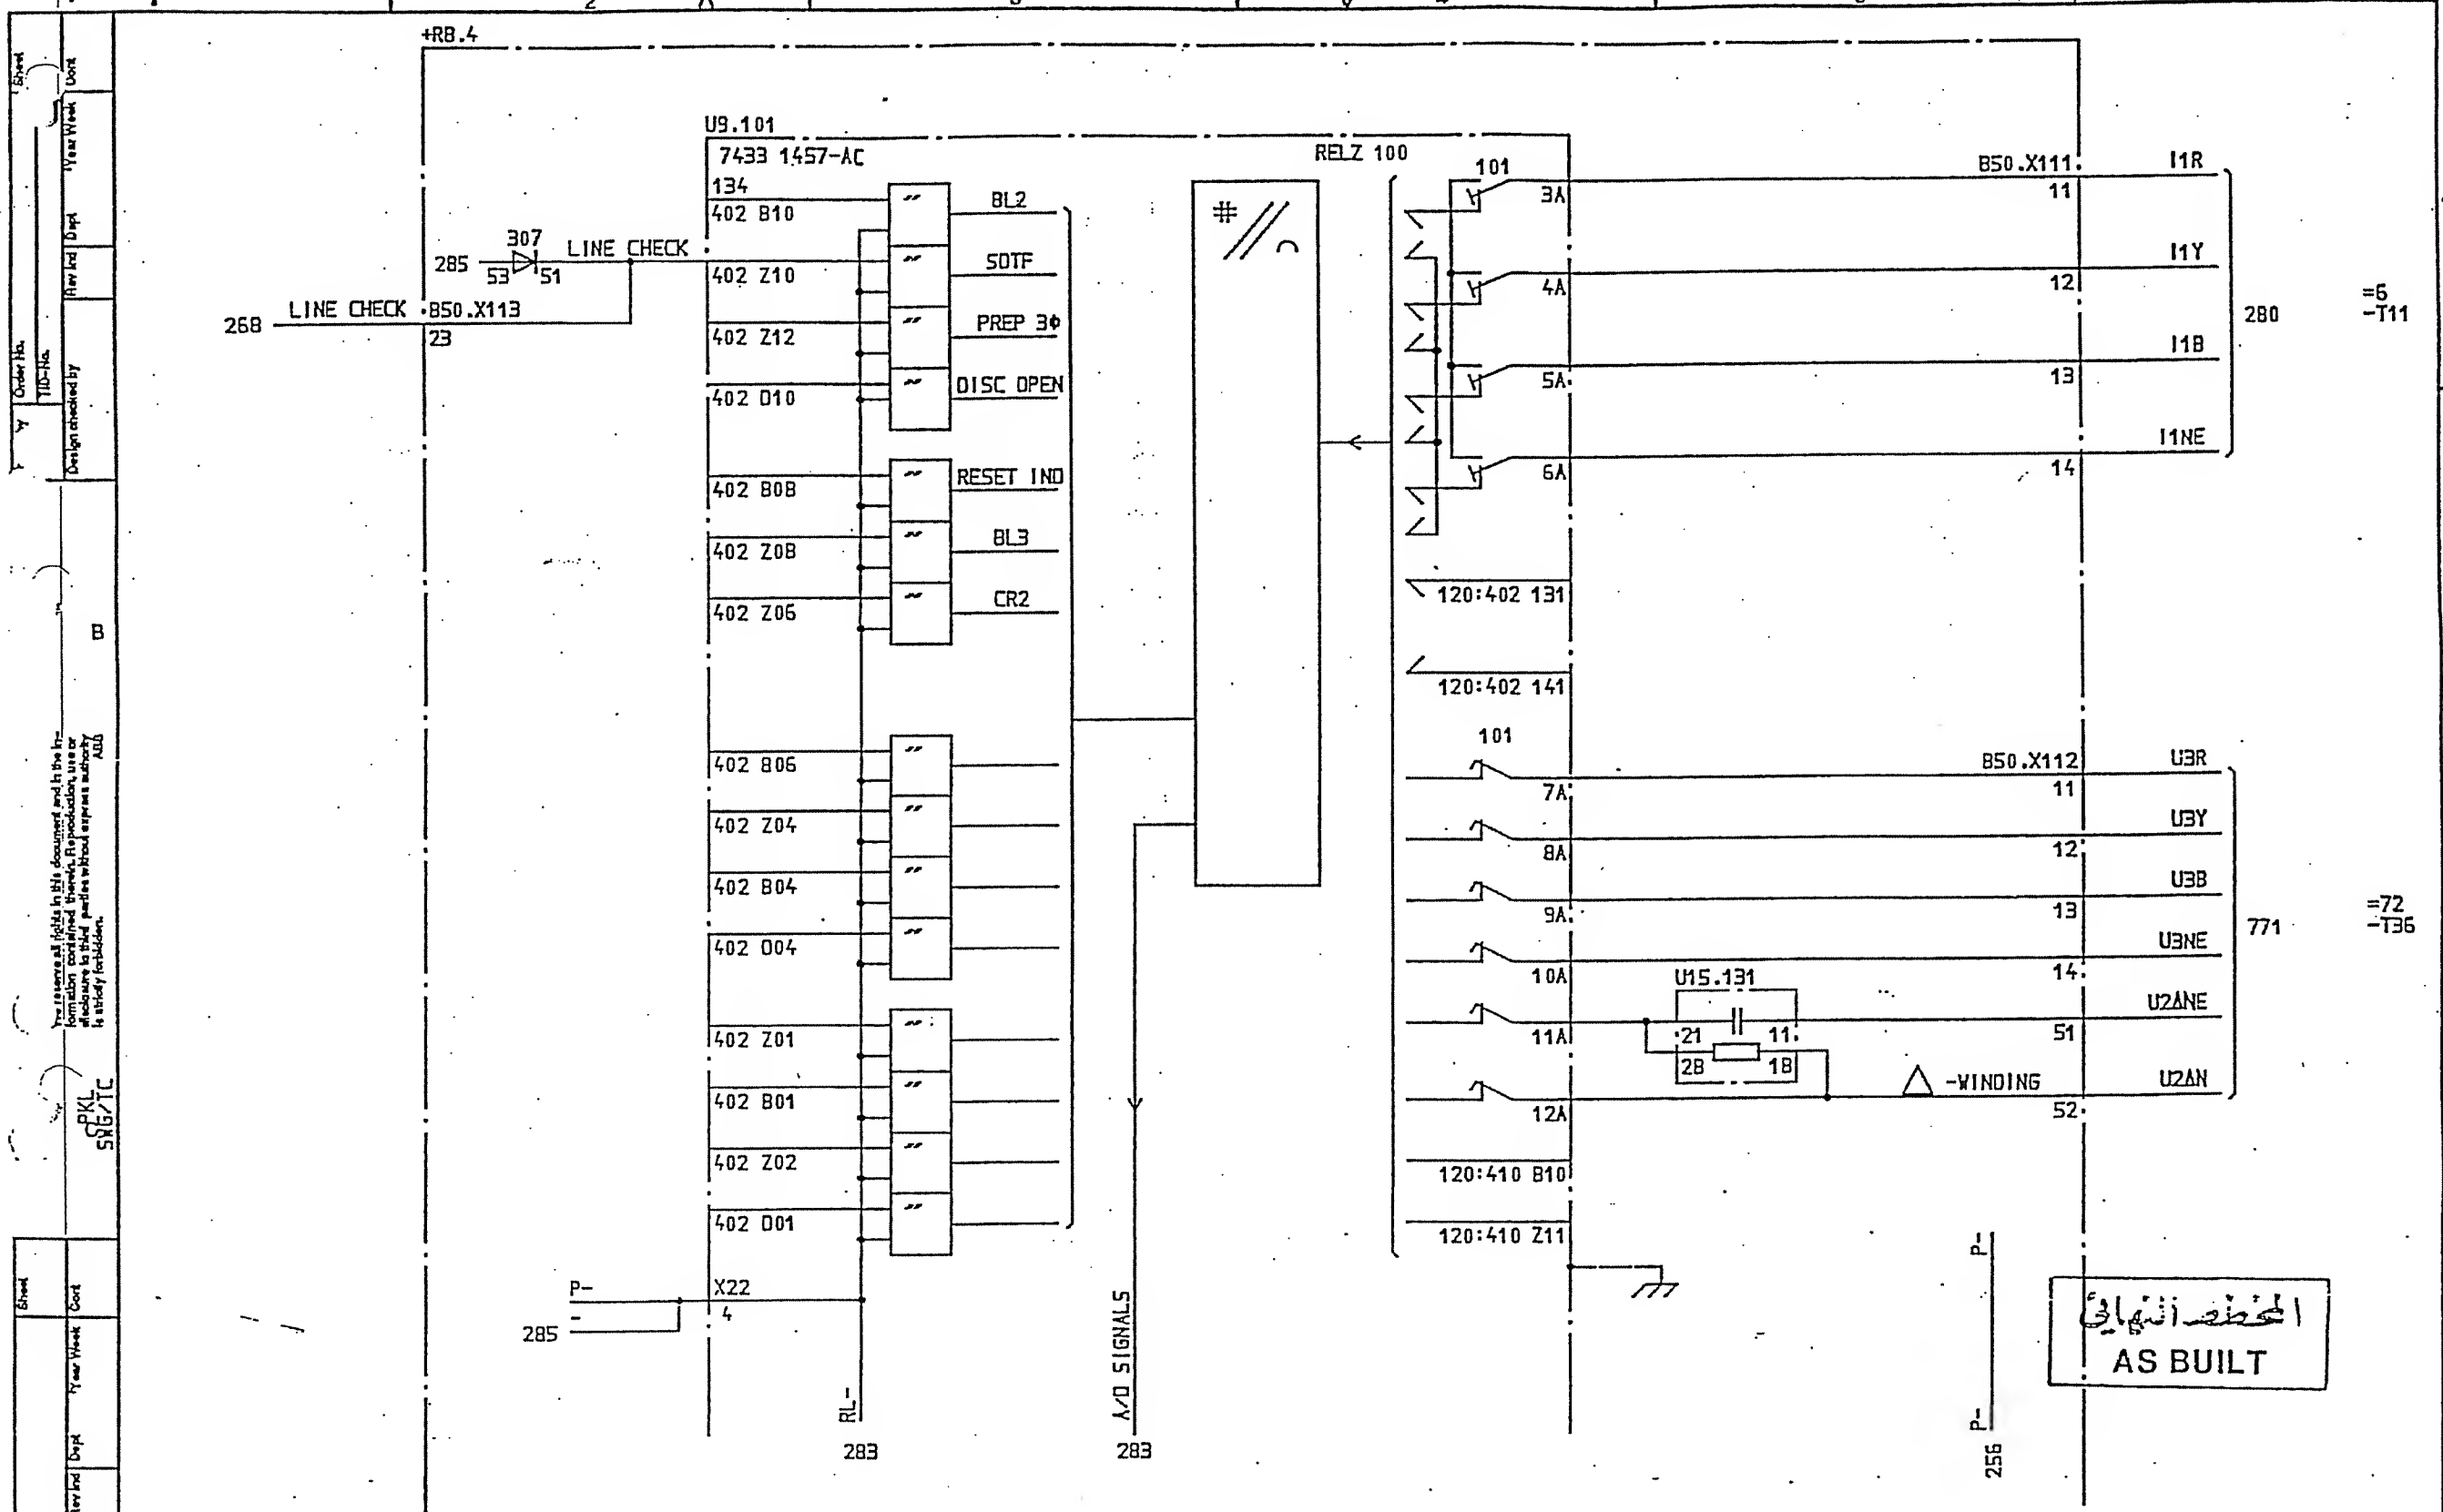

SYMBOL ID /D:XL824028-FBR:282/0

DATE 91-06-04 09.08

| | | | | | |
|---|----------|----|-------|-----|-----|
| 1 | AS BUILT | LS | 91.21 | 282 | 283 |
| 2 | | | | | |
| 3 | | | | | |
| 4 | | | | | |
| 5 | | | | | |
| 6 | | | | | |

Design checked by
B NILSSON
Drawing checked by
J SKOVGAARD
Drawn by
IA


CIRCUIT DIAGRAM
S/S 8501 132/33kV
SCECO CENTRAL SAUDI ARABIA

Iss by Dept Year Week
TDCF 90 16

L= 9743.1017
XL 824 028-FBR-

| | | |
|-----|-----|-------|
| Rev | Ind | Sheet |
| 1 | 282 | 283 |

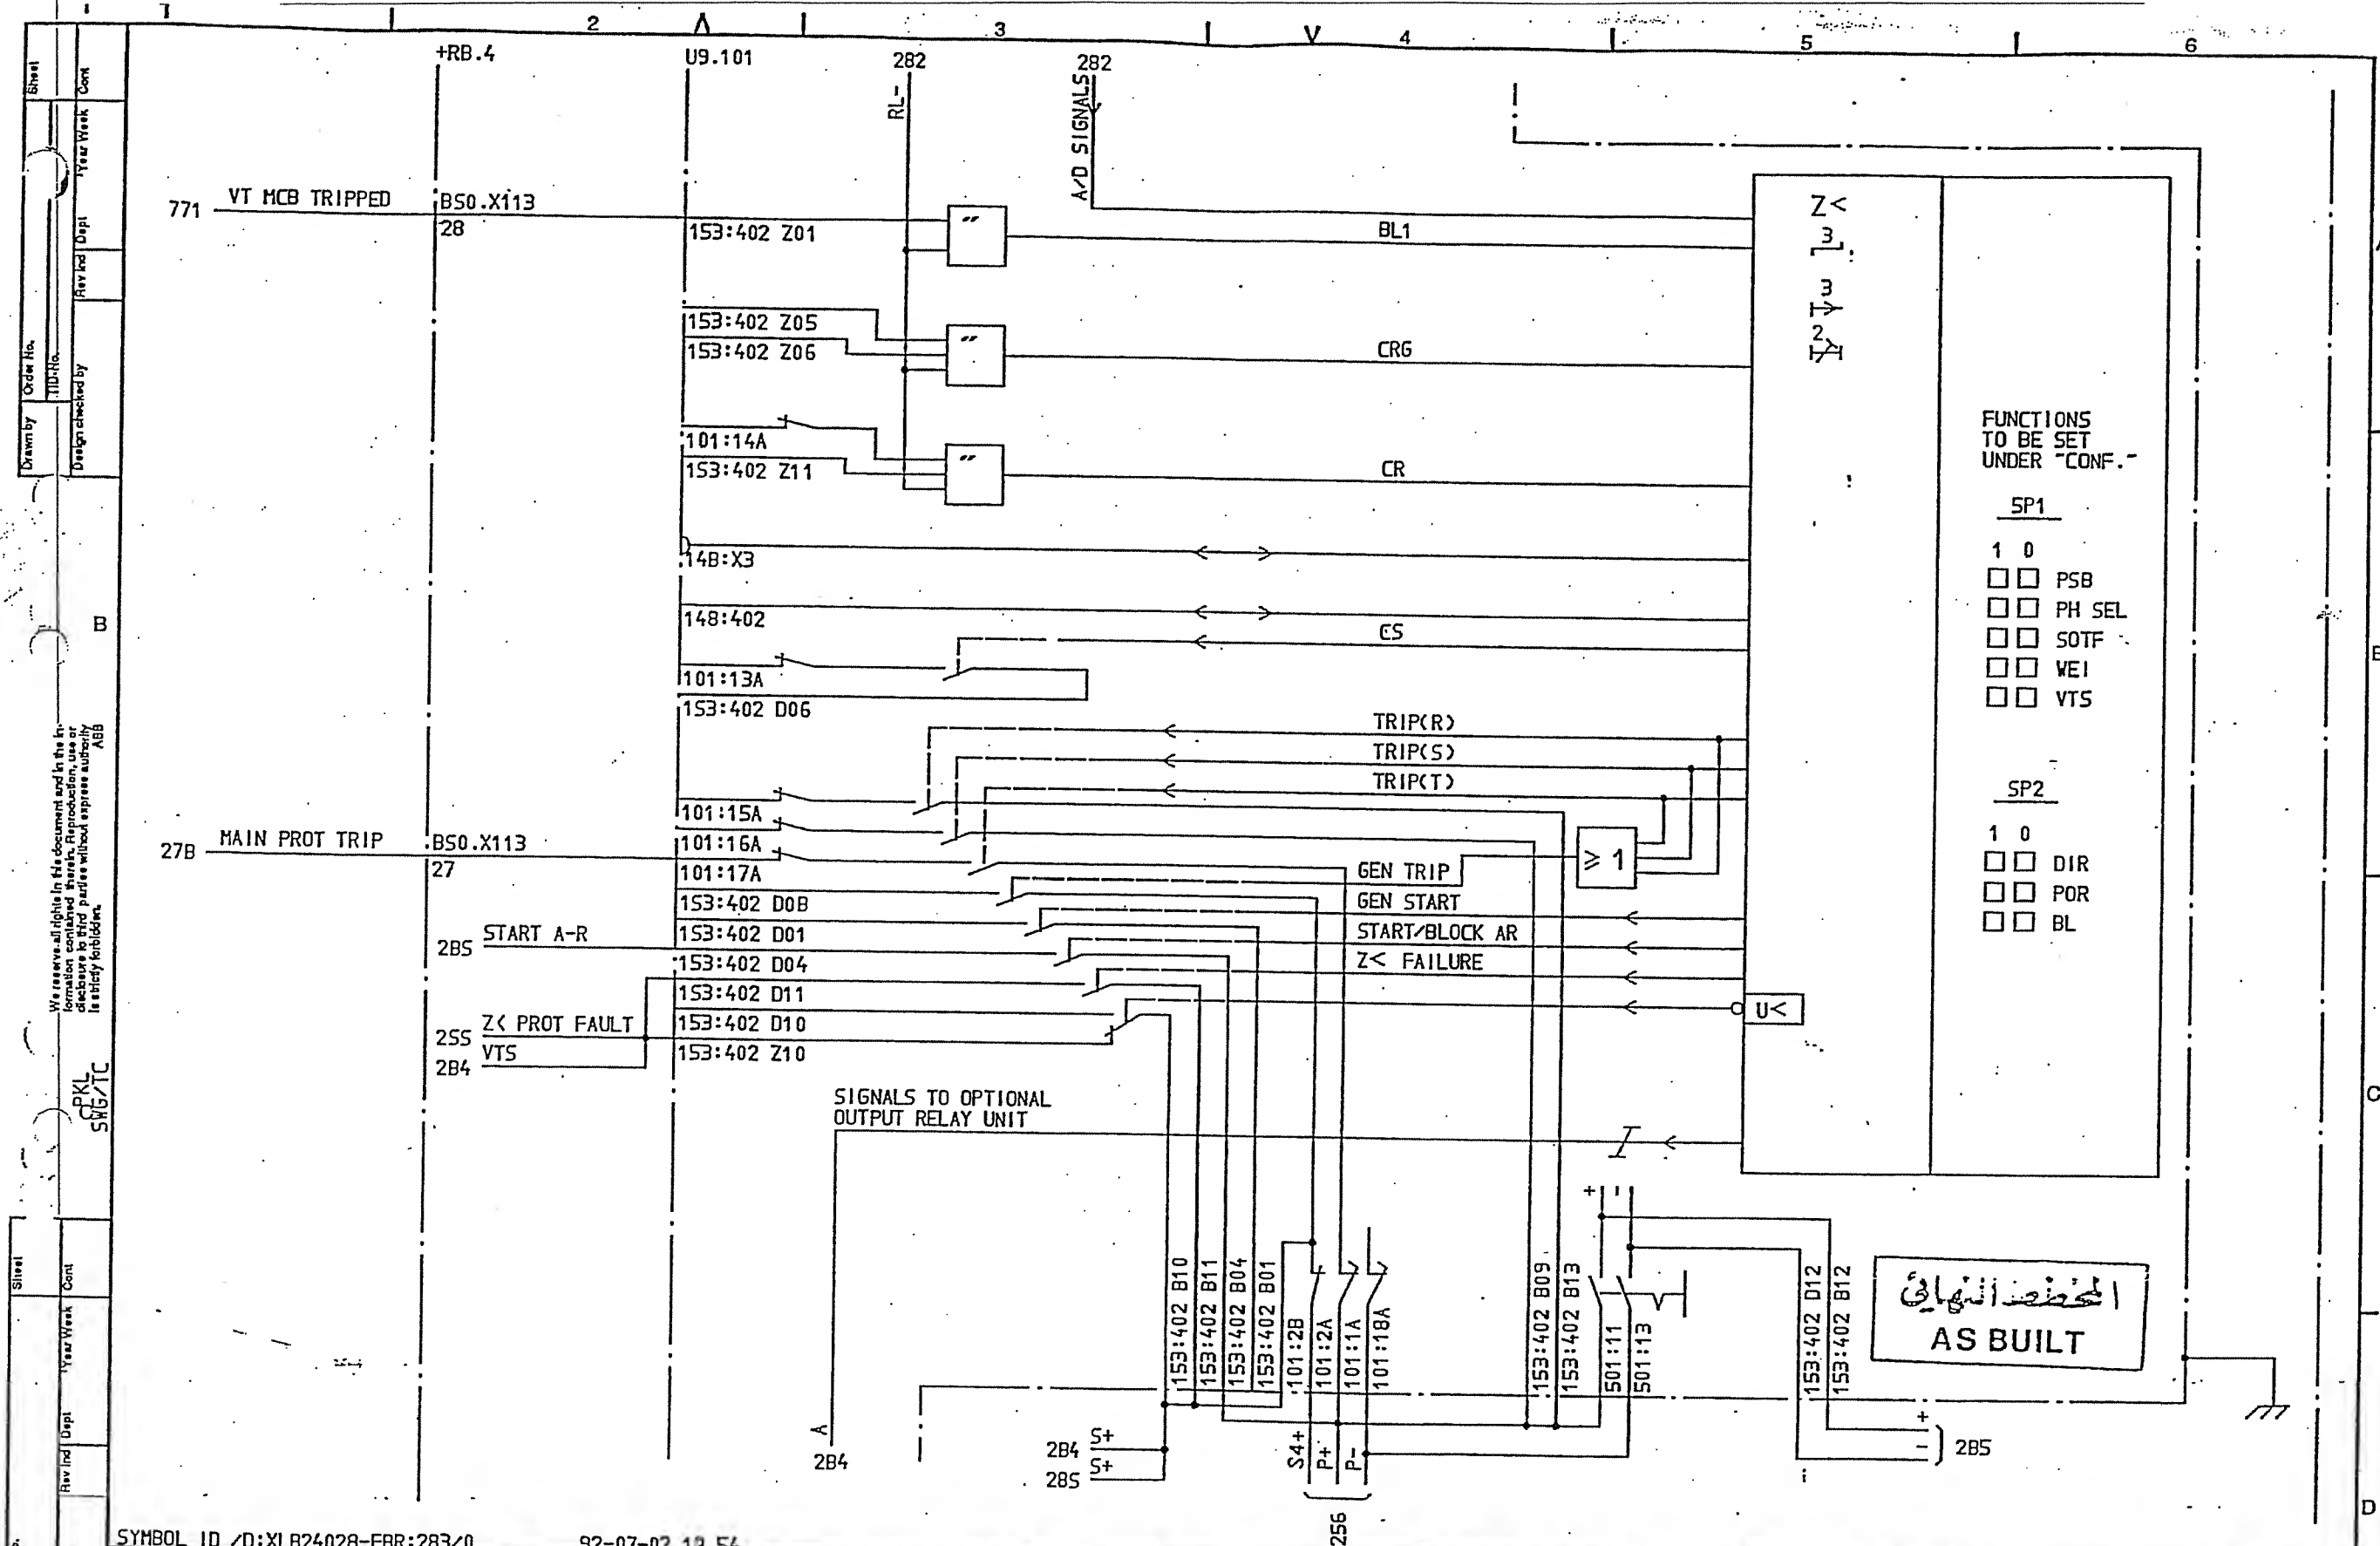ADD



- FUNCTIONS TO BE SET UNDER "CONF."
- SP1
- 1 0
- ☐ PSB
- ☐ PH SEL
- ☐ SOTF
- ☐ WEI
- ☐ VTS
- SP2
- 1 0
- ☐ DIR
- ☐ POR
- ☐ BL

SYMBOL ID /D:XL824028-FBR:283/0

92-07-02 18.54

=6
33kV INTERCONNECTOR LINE
DISTANCE PROTECTION

Design checked by
B NILSSON
Drawing checked by
J SKOVGAARD
Drawn by
IA

CIRCUIT DIAGRAM
S/S B501 132/33kV
SCECO CENTRAL SAUDI ARABIA

Iss by Dept
TDCF 90 16

L 9743.1017
XL 824 028-FBR

| | | | | | |
|-----|-----|------|------|------|-------|
| Rev | Inc | Year | Week | Cont | Sheet |
| 2 | 1 | 92 | 26 | 283 | 283 |
| 2 | 2 | 91 | 21 | 284 | 284 |

| | | | |
|-------------------|-----------|-----------|-----------|
| Drawn by | Order No. | Year Week | Cont |
| Design checked by | TID/HC | Rev Ind | Dept |
| Rev Ind | Revision | Appd | Year Week |
| 2 | | LS | 92 26 |
| 1 | | LS | 91 21 |

We reserve all rights in this document and in the information contained herein. Reproduction, use or disclosure to third parties without express authorisation is strictly forbidden.

B

CPKL
SFG/TC

| | | | |
|-------|----------|-----------|------|
| Sheet | Form No. | Year Week | Cont |
| 2 | | 92 26 | |
| 1 | | 91 21 | |

RB.4

U9.101


RLKG 100 OPTION

DIAGRAM (SETTING UNDER "CONF")

| RELAY | 1 | 2 | 3 | 4 | 5 | 6 | 7 | 8 | 9 | 10 |
|-------|---------|---------|---------|---------|---------|---------|---------|---------|---------|---------|
| K1 | BLCK | BLCK | T3U | TRI | TRWEI | TRI | BLCK | TRLC | TRLC | TRLC |
| K2 | TRLC | GS | VT5 | TRLC | TRLC | TRLC | ST3Io | ST3Io | GS | GS |
| K5 | TRC | PSB | ECHO | PSB | PSB | PSB | PSB | TRC | TRC | TRC |
| K8 | TRIP3PH | TRIP3PH | TRIP3PH | TRIP3PH | TRIP3PH | TRIP3PH | TRIP3PH | TRIP3PH | TRIP3PH | TRIP3PH |
| K10 | GS | FI1 | TRZ1 | TRIP3PH | SUP | TRIP3PH | TRZ1 | TRIP3PH | FI1 | TRIP3PH |
| K3 | ZM1 | TRZ1 | TRC | TRIPR | PSR | TRIPR | TRWEI | TRIPR | TRZ1 | ZM1 |
| K14 | ZM2 | TRZ2 | TRLC | TRIPS | PSS | TRIP5 | TRLC | TRIP5 | TRZ2 | ZM2 |
| K15 | ZM3 | TRZ3 | TRWEI | TRIPT | PST | TRIPT | TREF | TRIPT | TRZ3 | ZM3 |
| K9 | CS | CS | CS | CS | CS | CS | CS | CS | CS | CS |
| K6 | CR1 | CR1 | CR1 | CR1 | CR1 | CR1 | CR1 | CR1 | CR1 | CR1 |
| K7 | AR | SUPN | PSB | AR | CS | AR | CS2 | AR | CS | GT |
| K4 | NDS | SUPI | SUP | SUP | CR1 | SUPI | CR2 | SUP | SUP | AR |
| K11 | TRZ1 | PSR | PSR | TRZ1 | ZM1 | CS | CS2 | TREF | PSR | PSR |
| K13 | TRZ2 | PSS | PSS | TRZ2 | ZM2 | CR1 | CR2 | TREF | PSS | PSS |
| K12 | TREF | PST | PST | TRZ3 | ZM3 | TRC | SUPN | CS2 | PST | PST |
| K16 | VT5 | PSN | PSN | TRZ3R | ZM3R | TRZ1 | SUPI | CR2 | PSN | PSN |
| | X | | | | | | | | | |

PLANT ADAPTED PROGRAMMING
STANDARD PROGRAMMING AT DELIVERY

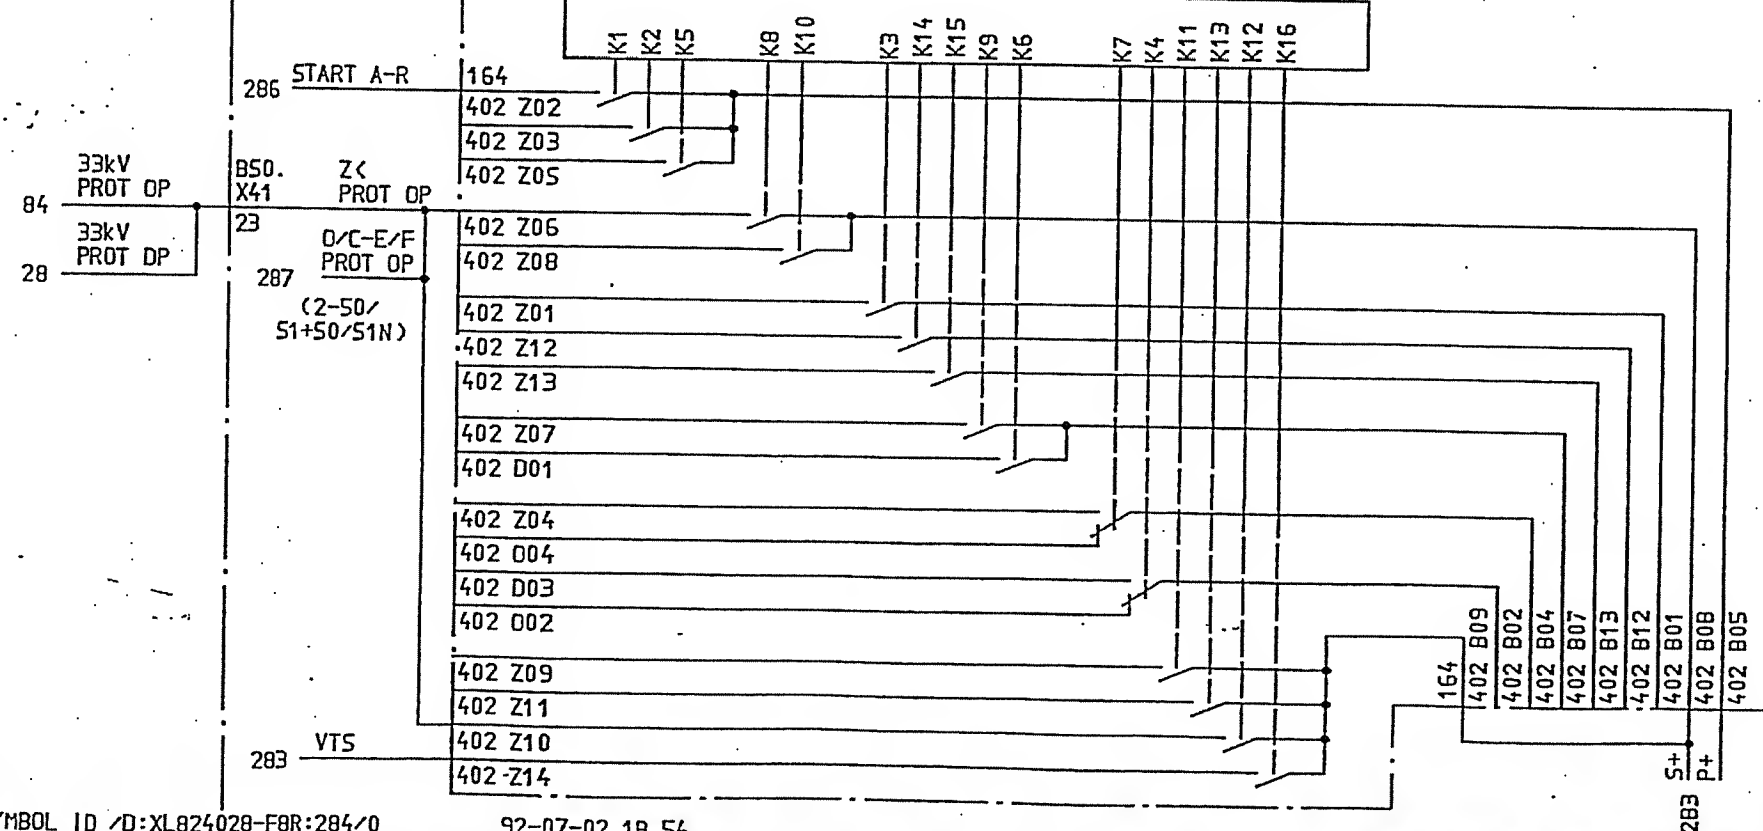RLKG 100



المخطط النهائي
AS BUILT

SYMBOL ID /D:XL824028-F8R:284/0

92-07-02 18.54

=6
33kV INTERCONNECTOR LINE
DISTANCE PROTECTION

Design checked by
B NILSSON
Drawing checked by
J SKOVGAARD
Drawn by
IA


CIRCUIT DIAGRAM
S/S 8501 132/33kV
SCECO CENTRAL SAUDI ARABIA


Use by Dept Year Week
TDCF 90 16

L 9743.1017
XL 824.028-FBR

| | |
|---------|-------|
| Rev Ind | Sheet |
| 2 | 285 |
| 1 | 284 |

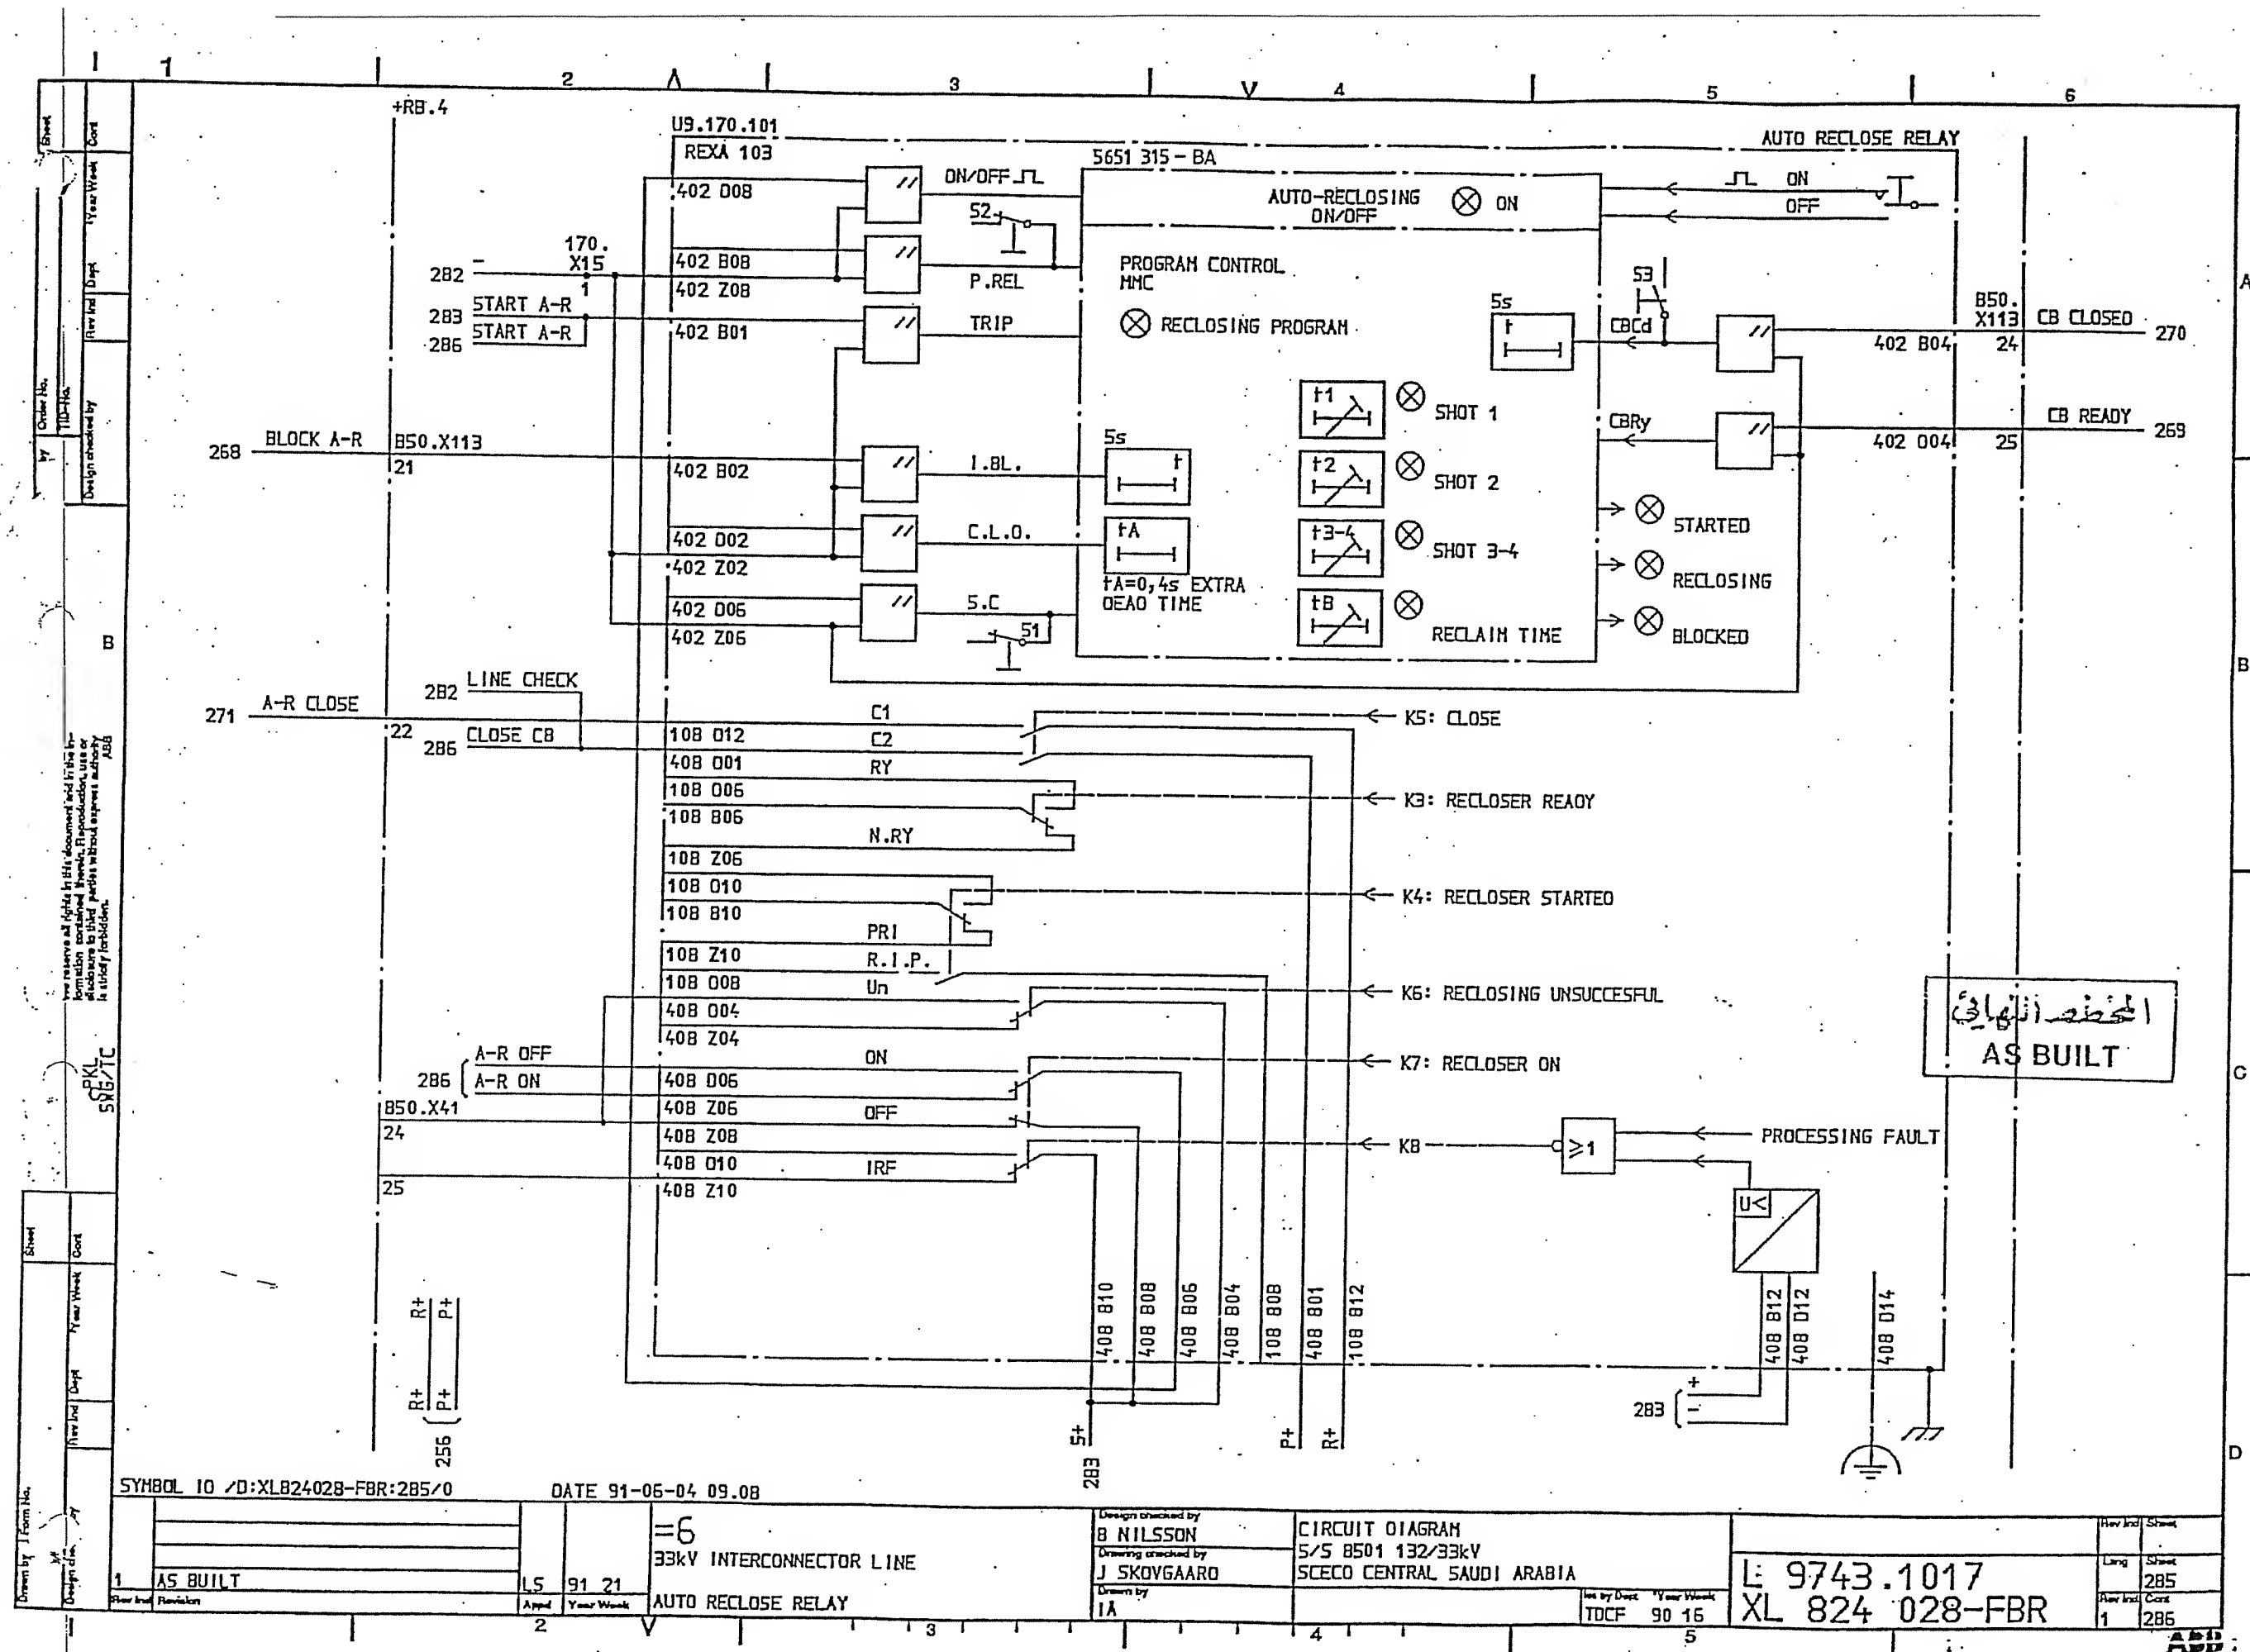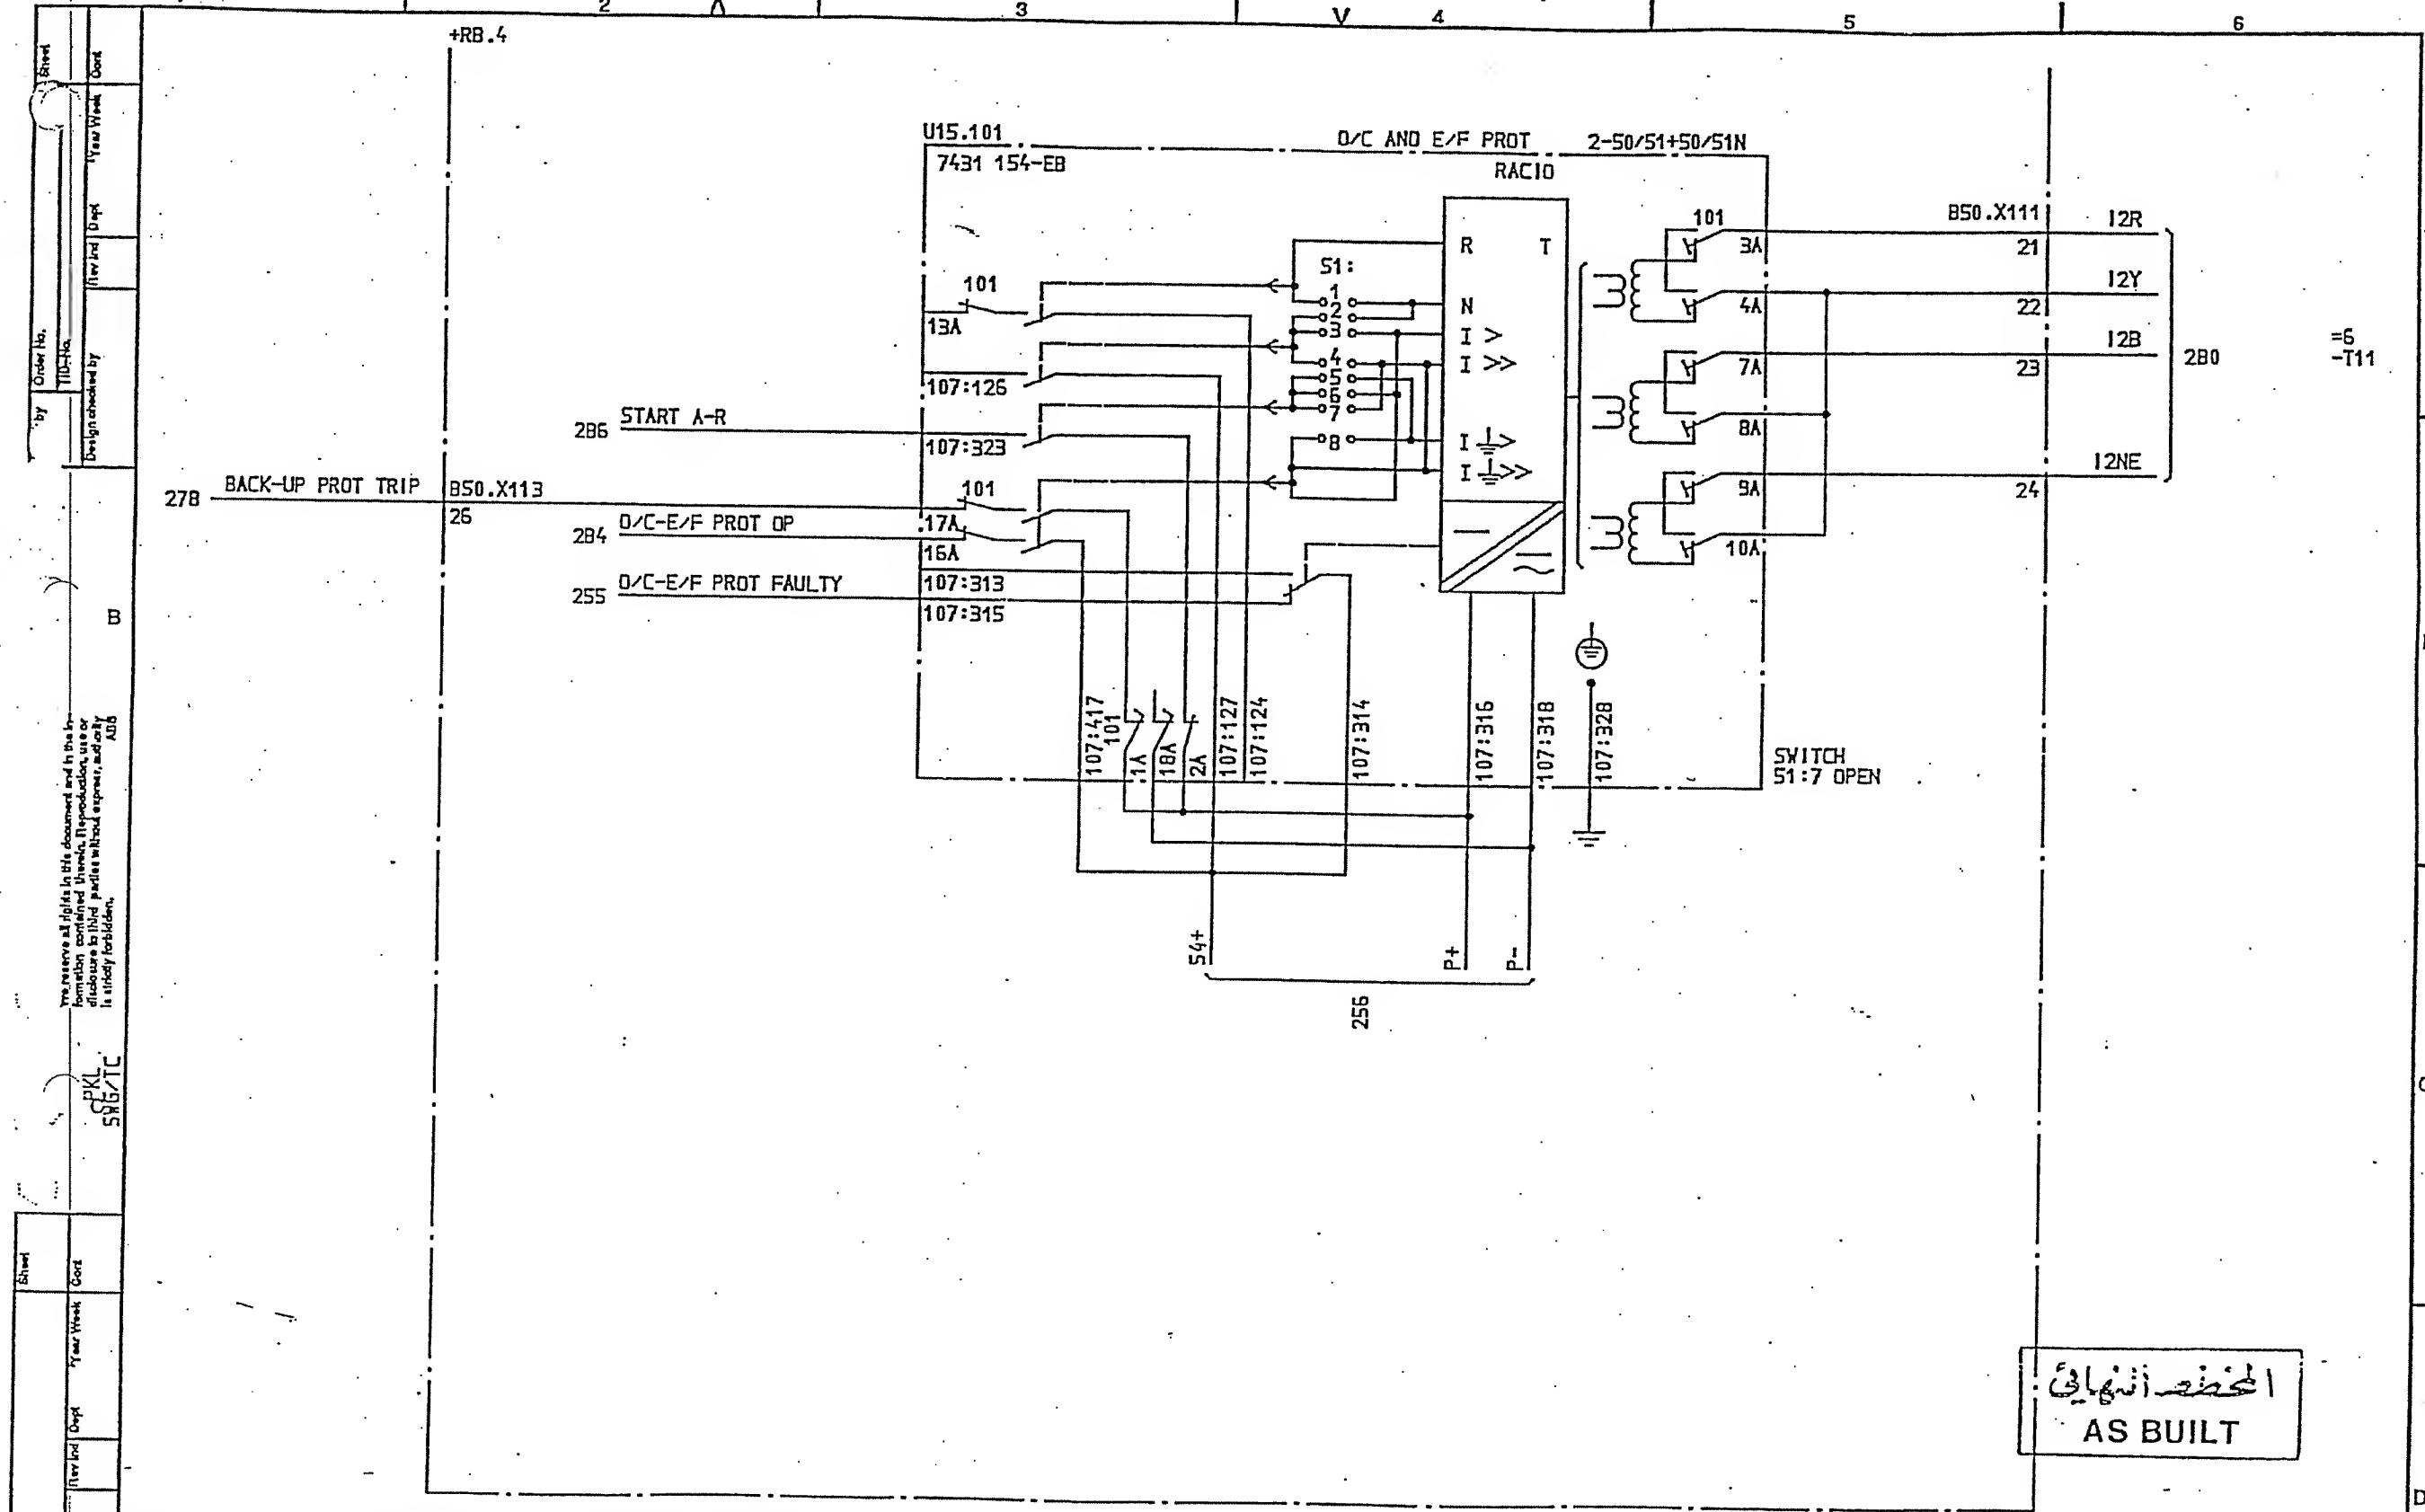
AS BUILT





| | | | | | |
|---------------------------------|--|--------------------------------|--|-----------------------------|--|
| SYMBOL 10 /D:XL824028-FBR:287/0 | | DATE 91-06-04 09.08 | | | |
| 1 AS BUILT | | L5 91 21 | | =6 33kV INTERCONNECTOR LINE | |
| OVERCURRENT AND EARTH FAULT | | Design checked by B NILSSON | | CIRCUIT DIAGRAM | |
| | | Drawing checked by J SKOVGAARD | | S/S 8501 132/33kV | |
| | | Drawn by IA | | SCECO CENTRAL SAUDI ARABIA | |
| | | Iss by Dept TDCF | | Year 90 16 | |
| | | | | L 9743.1017 | |
| | | | | XL 824 028-FBR | |
| | | | | Rev 1 312 | |

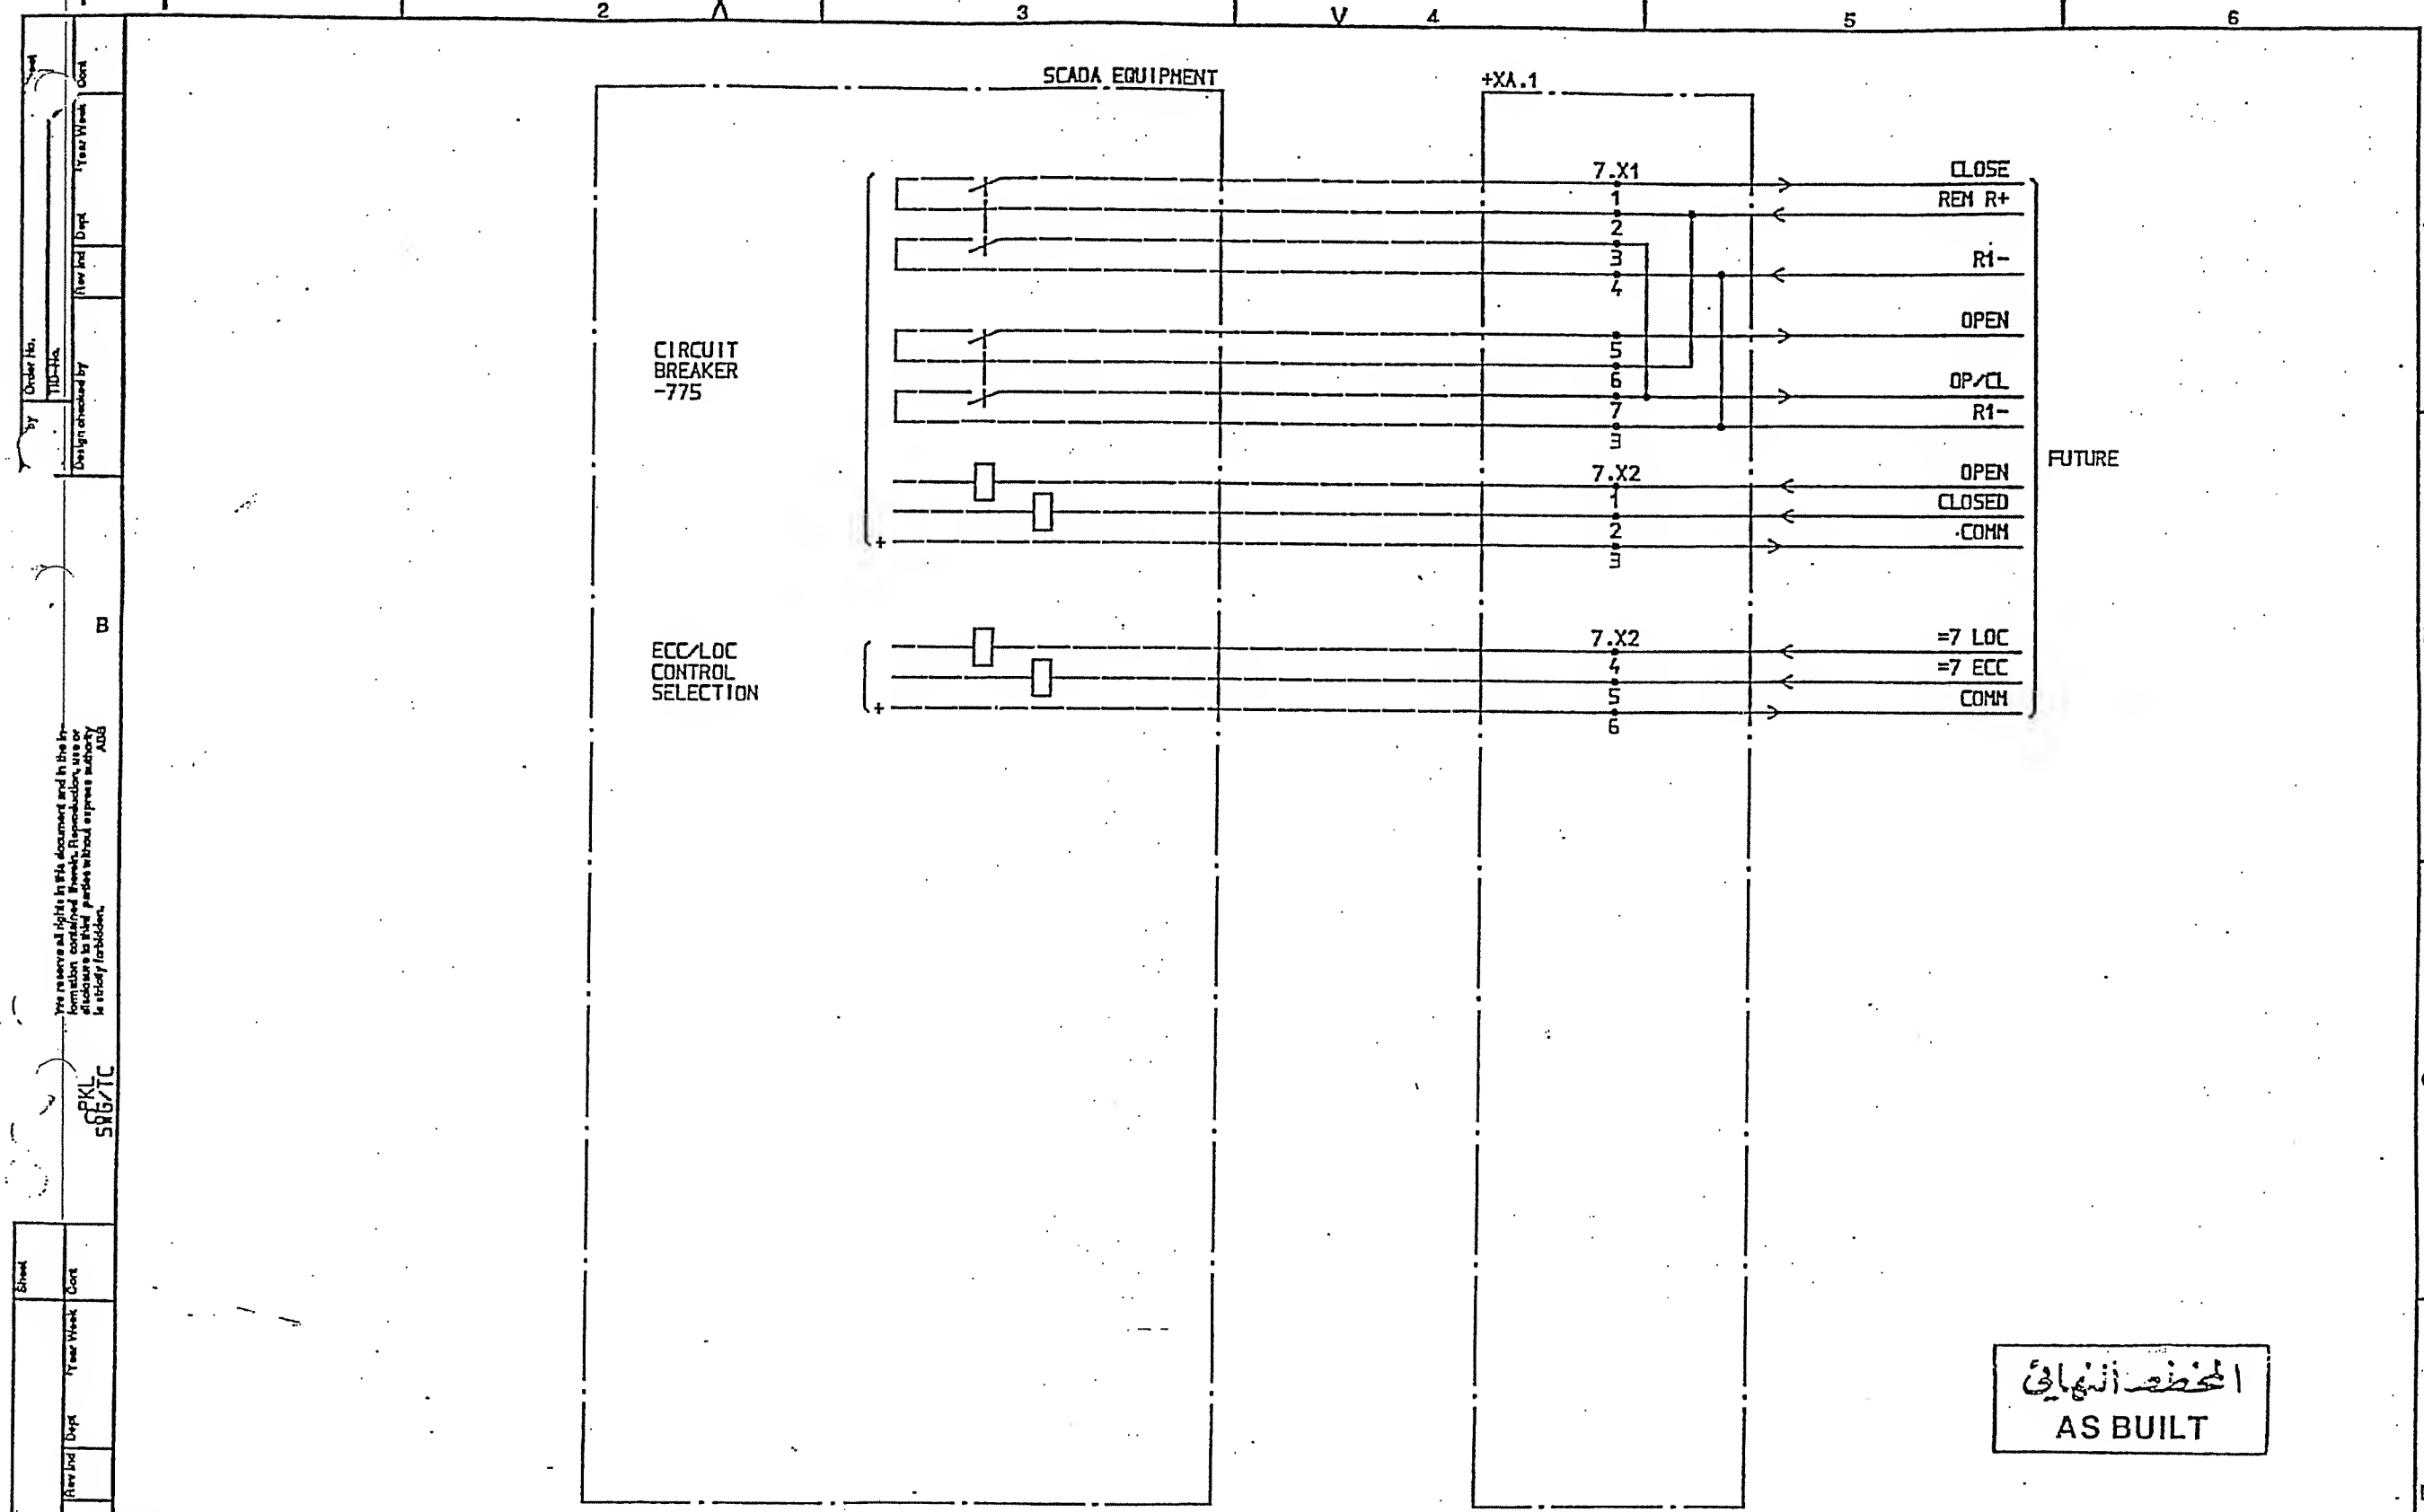ADD




المخطط النهائي
AS BUILT


SYMBOL ID /0:XL824028-FBR:312/0

DATE 91-06-04 .09.08


| | | | | | | | | | |
|----------|--|------|-----------|---------------------------|-----------------------------------|--|-------|-------|-------|
| AS BUILT | | LS | 91 21 | SCADA INTERFACE EQUIPMENT | Design checked by B NILSSON | CIRCUIT DIAGRAM S/S 8501 132/33kV SCECO CENTRAL SAUDI ARABIA | Rev | Int | Sheet |
| | | Appd | Year Week | | Drawing checked by S STRIOSHAN | | Lang | Sheet | |
| | | | | | Drawn by IA | Abb HV SWITCHGEAR | 1 | 351 | |
| | | | | | Iss by Dept | TCF | 90 10 | | |
| | | | | | Year Week | | | | |

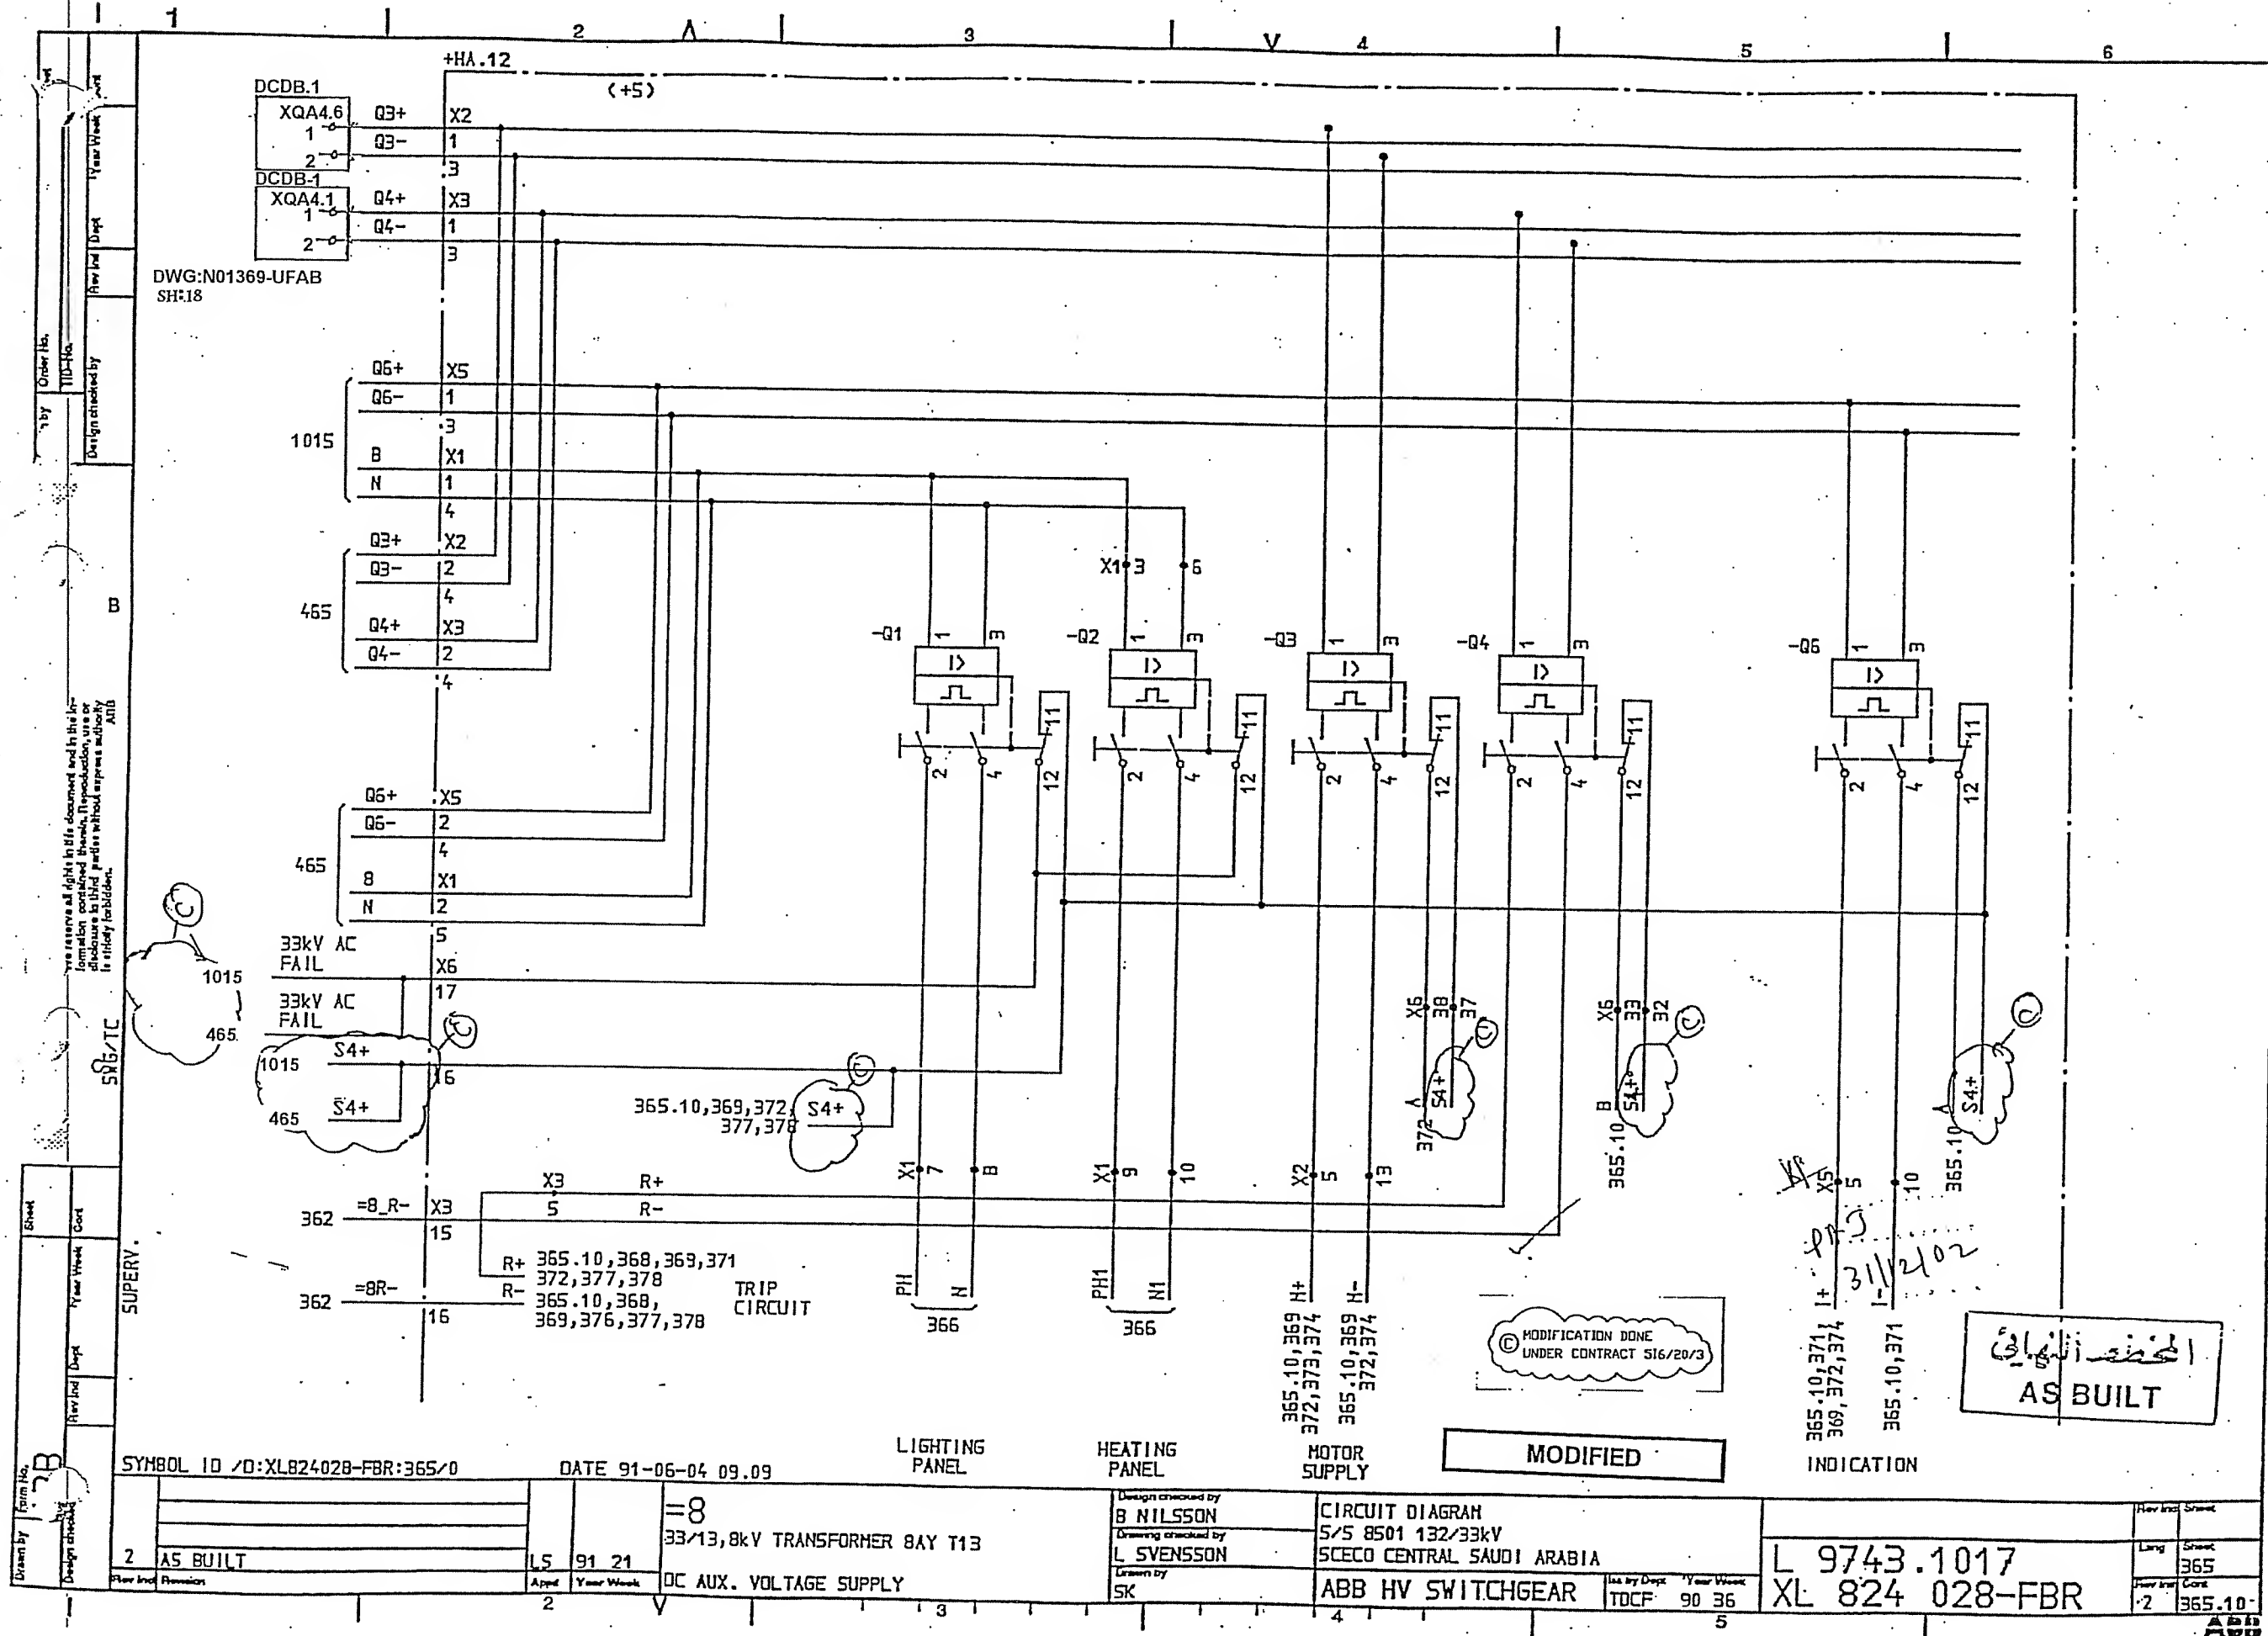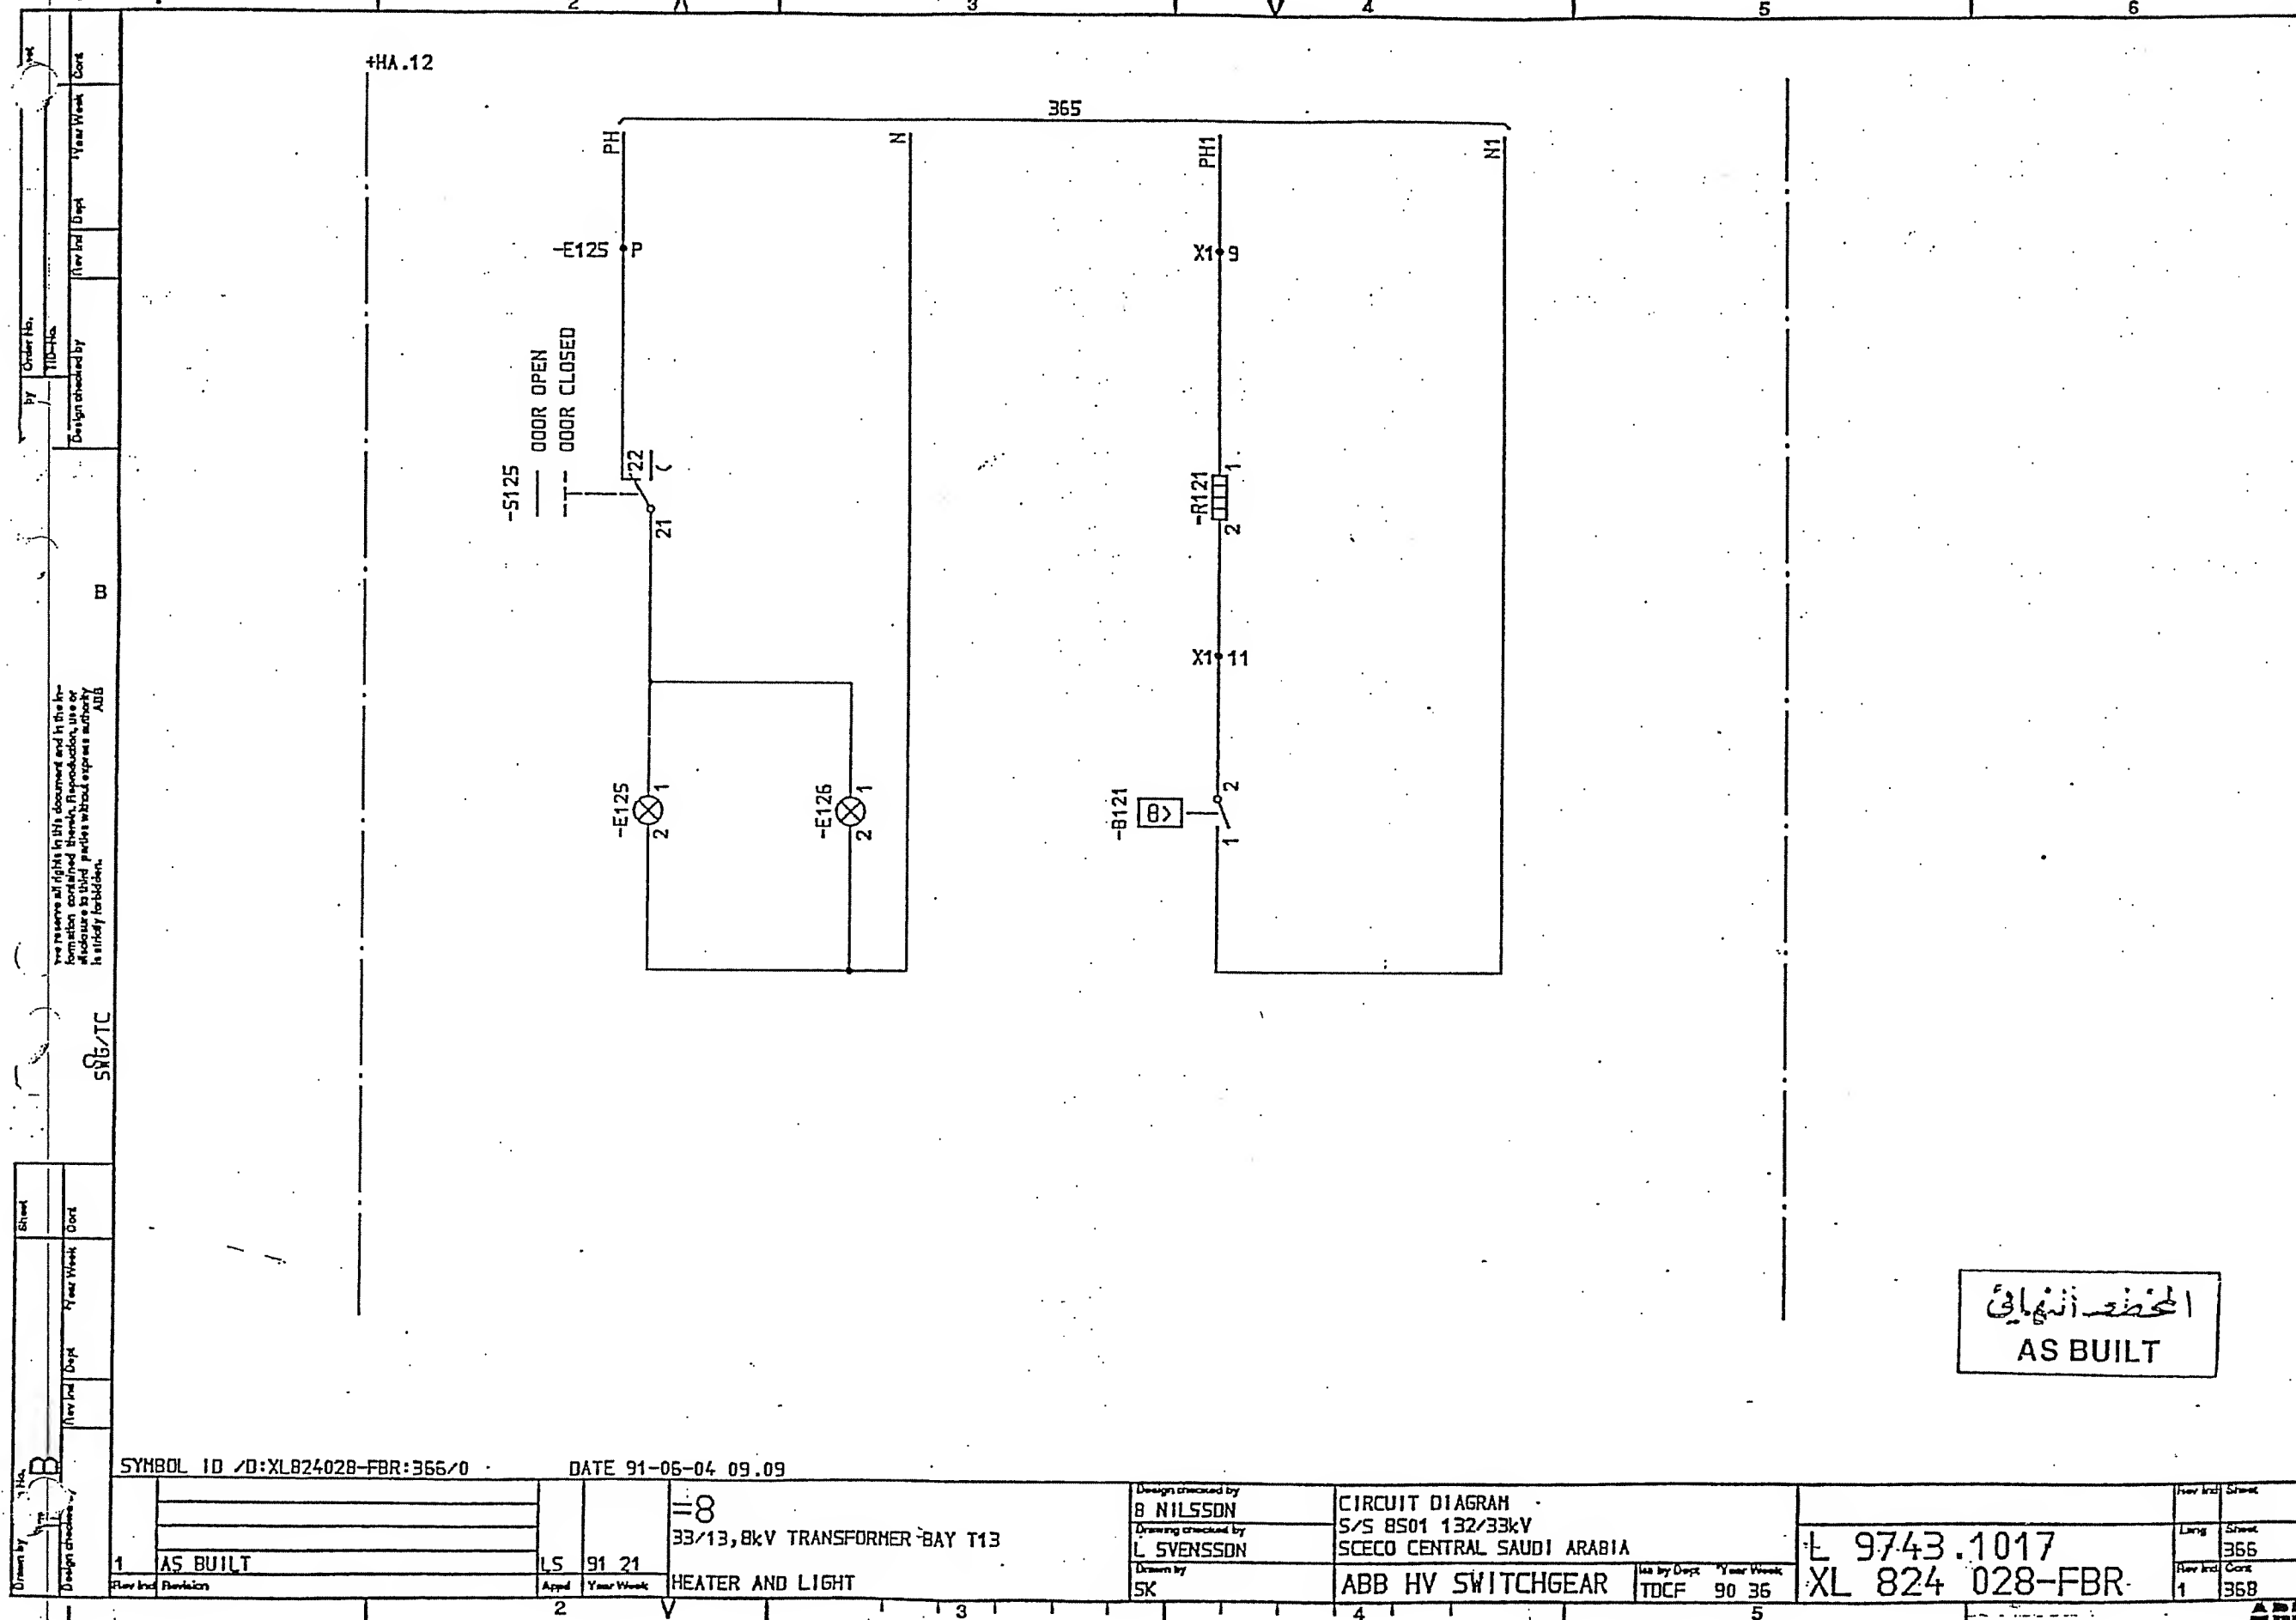L 9743.1017
XL 824 028-FBR






المحضر النهائي
AS BUILT

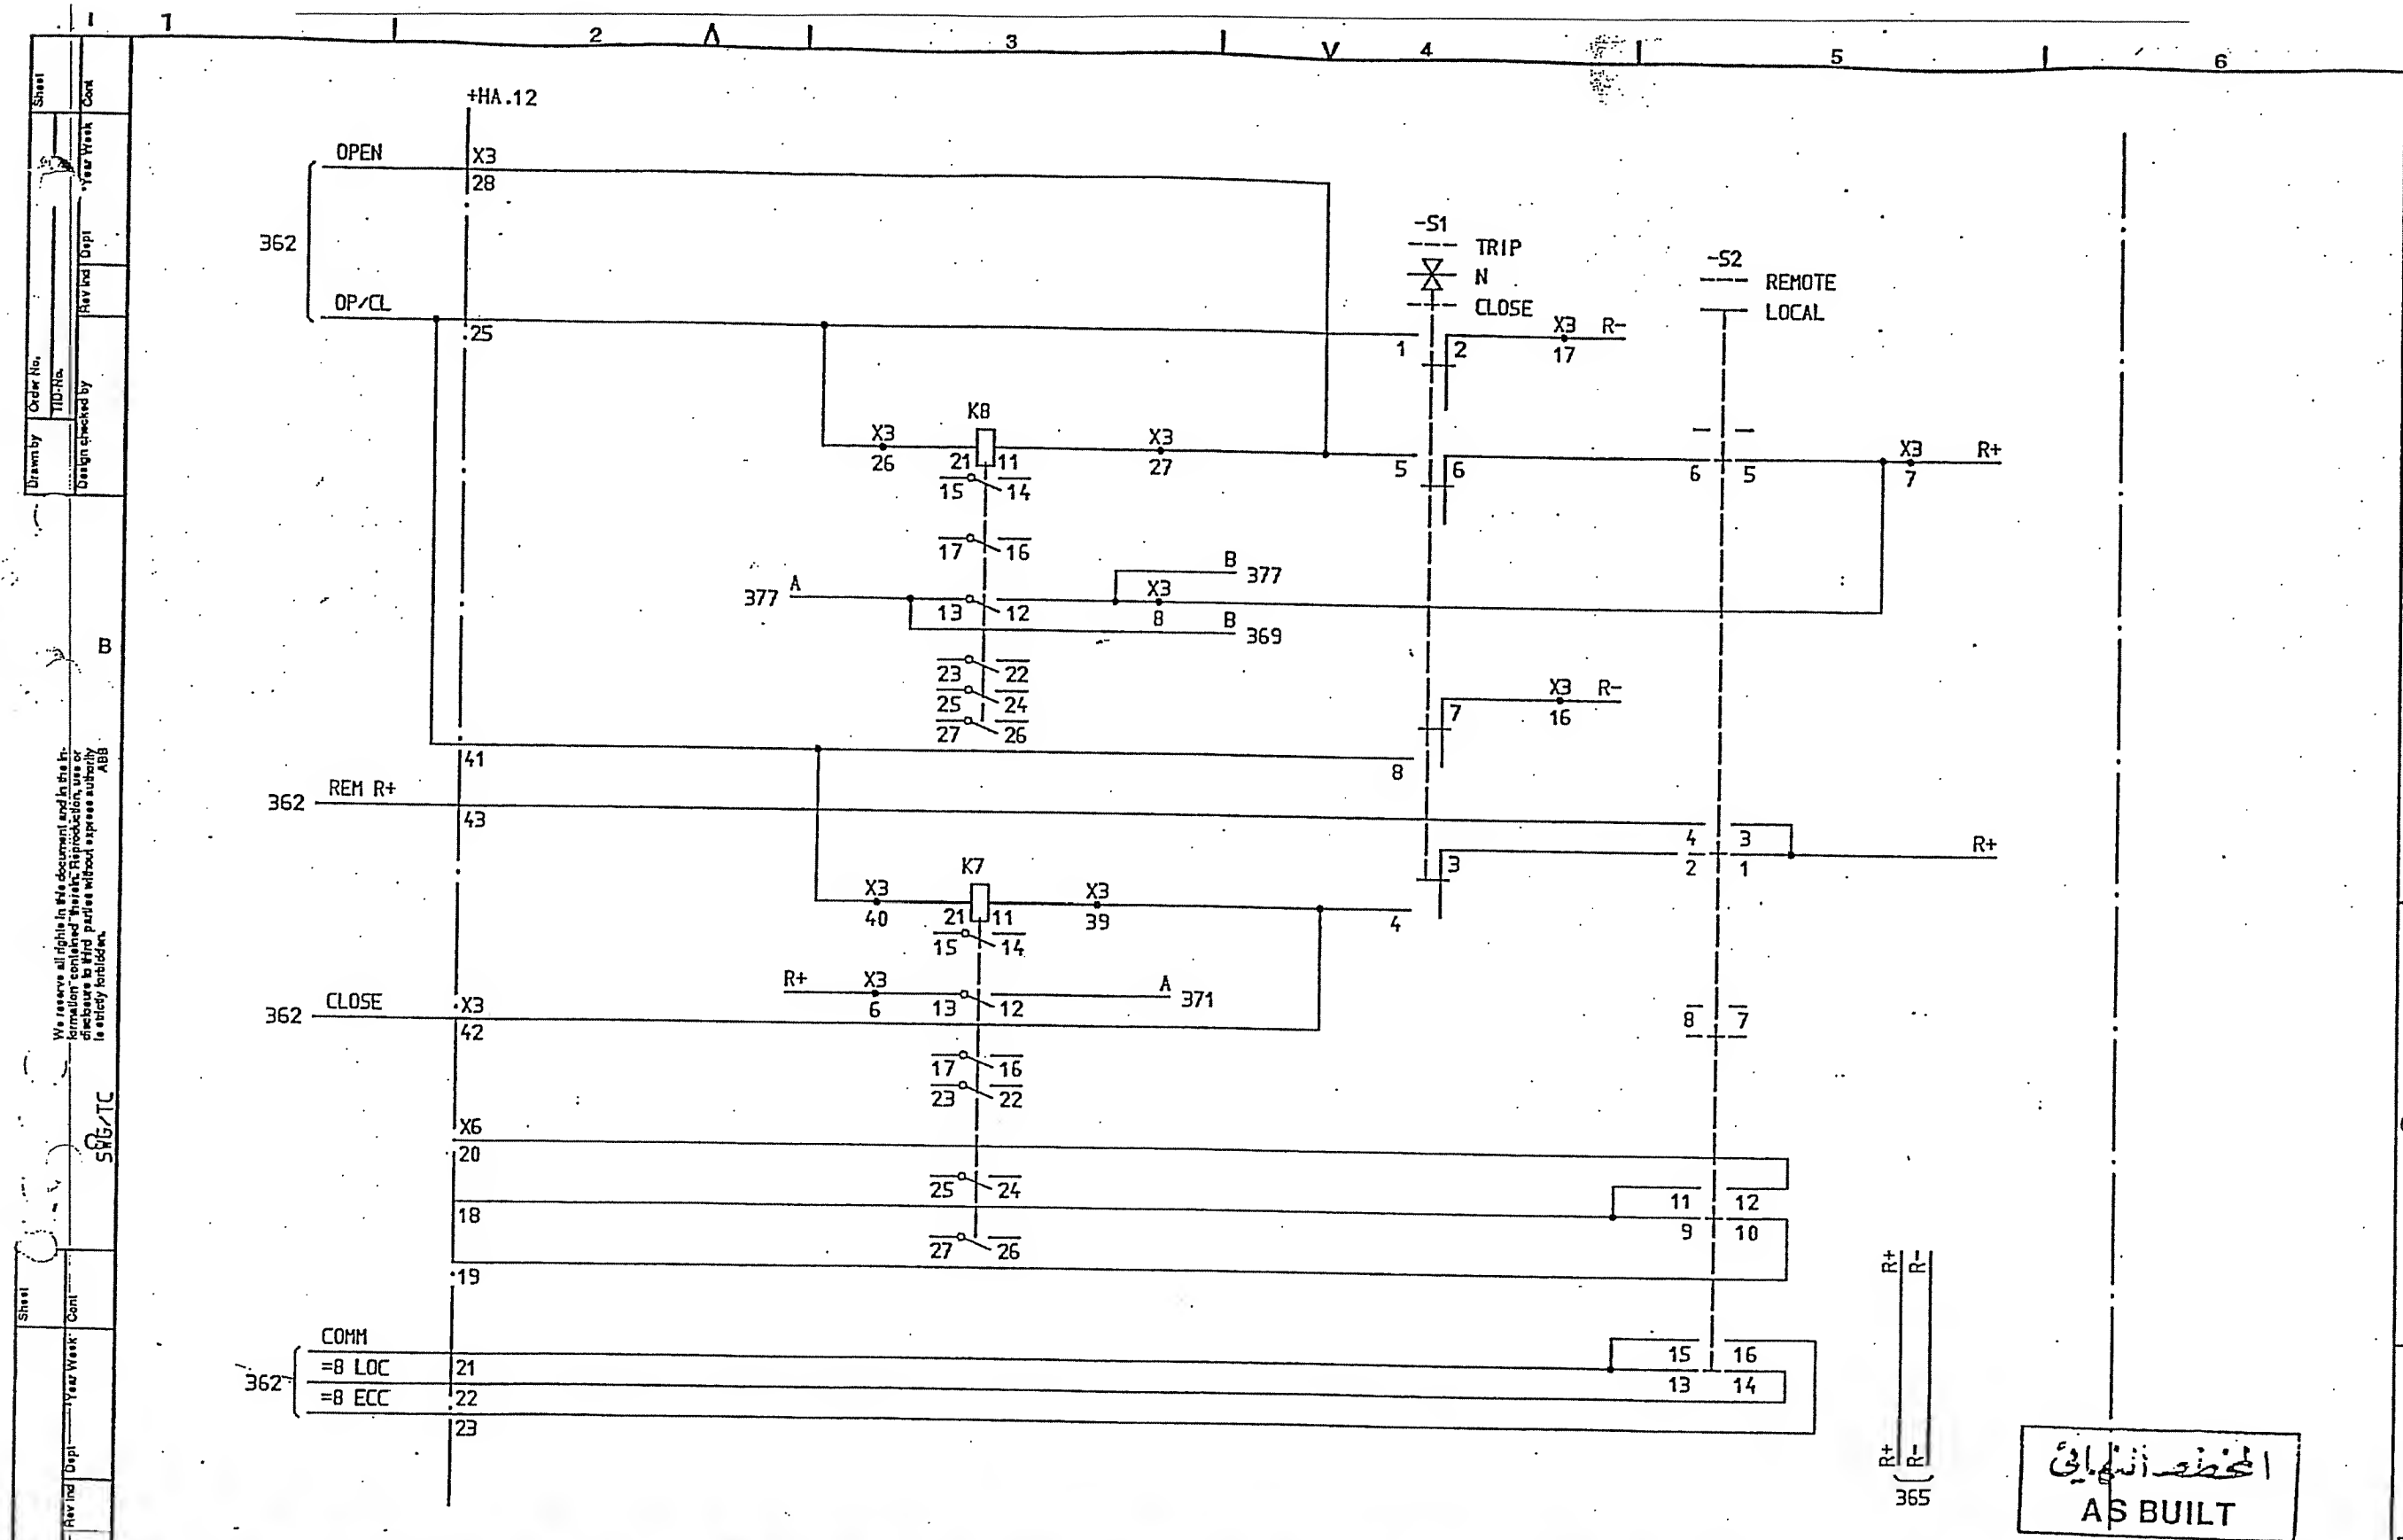


المخطط انشائي
AS BUILT

| | | | | | | | | | | | | | | | | | | | |
|---------------------------------|------------|-------------------|-------|----|----------|-------------------------------|-------|-------------------|-----------|-------------------|------------|----------------------------|------|-------------|-------|----------------|------|----------|-----|
| SYMBOL ID /D:XL824028-FBR:368/0 | | 92-07-02 18.55 | | =8 | | 33/13,8kV TRANSFORMER BAY T13 | | CIRCUIT DIAGRAM | | S/S 8501 132/33kV | | SCECO CENTRAL SAUDI ARABIA | | L 9743.1017 | | XL 824 028-FBR | | 2 368.10 | |
| 2 | SCECO SNA6 | LS | 92 26 | 1 | AS BUILT | LS | 91 21 | Design checked by | B NILSSON | Drawn by | L SVENSSON | Iss by Dept | TDCF | Year Week | 90 36 | Rev Ind | Cont | Sheet | 368 |
| C.8 SELECTOR SWITCHES | | ABB HV SWITCHGEAR | | SK | | 2 | | 3 | | 4 | | 5 | | 6 | | 7 | | 8 | |

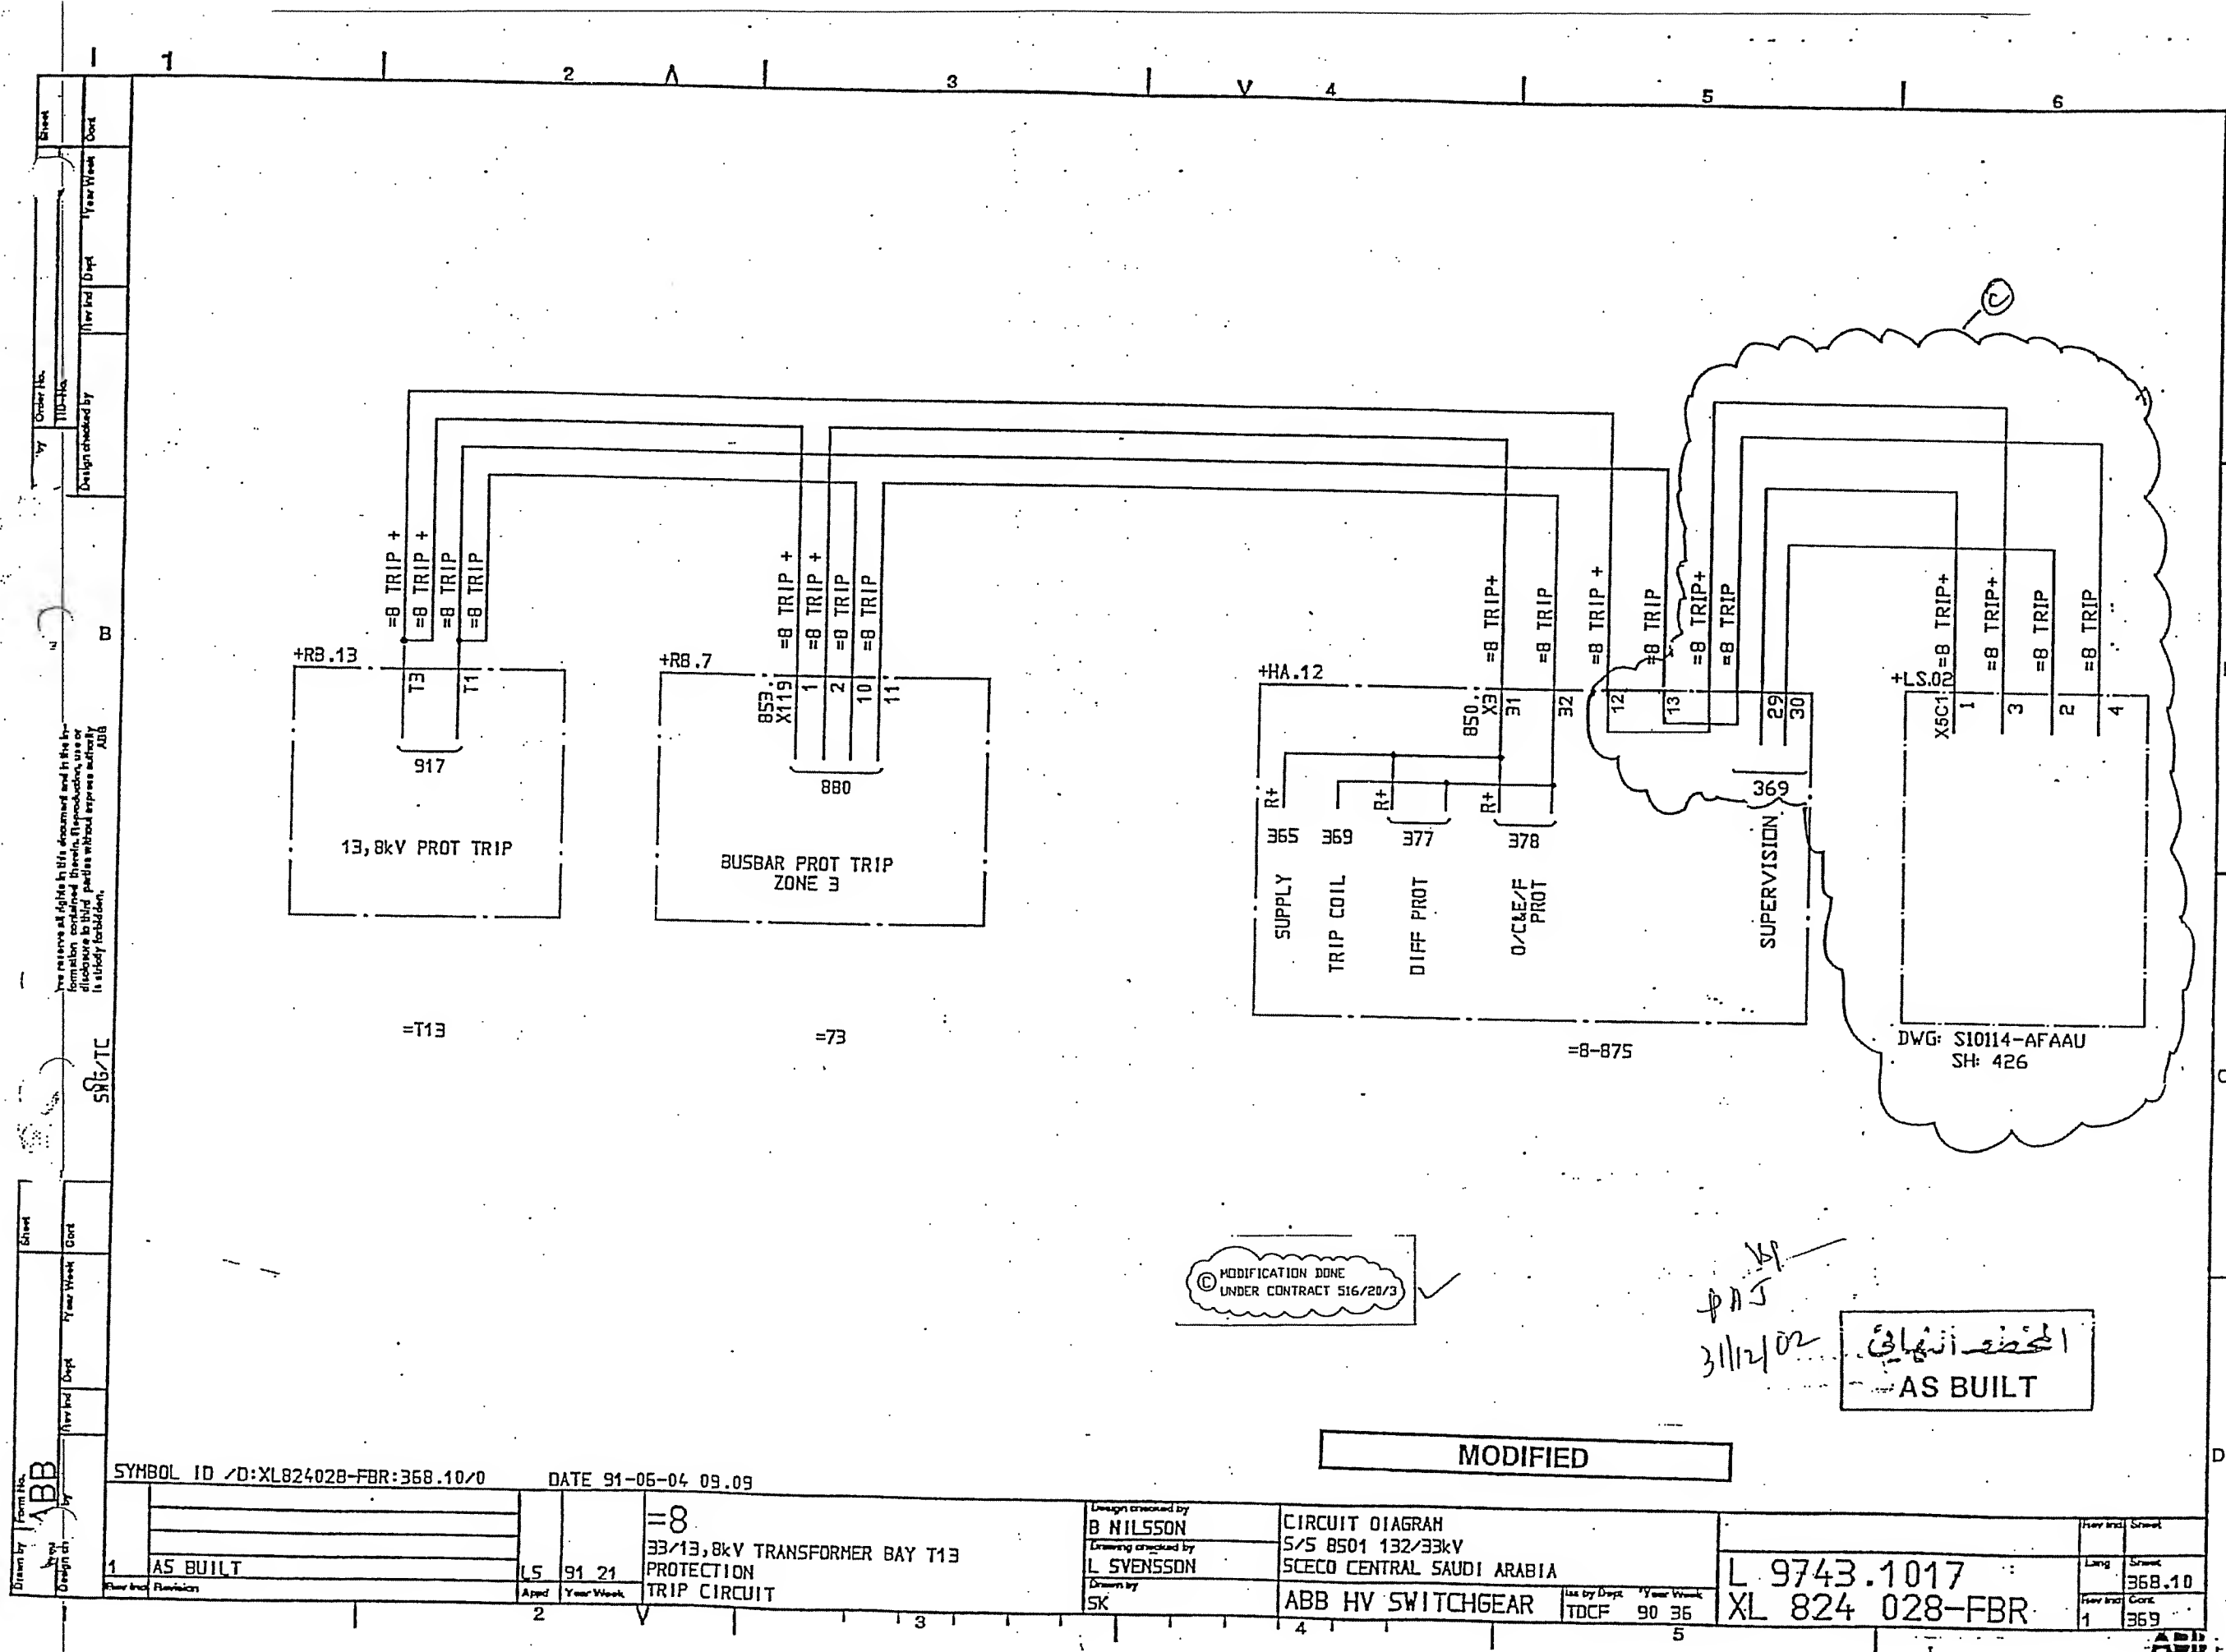



| | | | | | |
|---------------------------------------|------------|----------------------------------|----------|-------------------------------|--|
| Drawn by: ABB | | SYMBOL ID: XL824028-FBR:368.10/0 | | DATE: 91-05-04 09.09 | |
| Design of: | Year/Week: | 15 | 91 21 | =8 | |
| Rev: | Revision: | 1 | AS BUILT | 33/13.8kV TRANSFORMER BAY T13 | |
| Appr: | Year/Week: | 2 | | PROTECTION | |
| | | | | TRIP CIRCUIT | |
| Design checked by: B NILSSON | | Circuit diagram | | S/S 8501 132/33kV | |
| Drawing checked by: L SVENSSON | | SCECO CENTRAL SAUDI ARABIA | | L 9743.1017 | |
| Drawn by: SK | | ABB HV SWITCHGEAR | | XL 824 028-FBR | |
| Issued by: TDCF | | Year/Week: 90 36 | | Rev: 1 | |
| | | | | Sheet: 368.10 | |
| | | | | Total: 369 | |

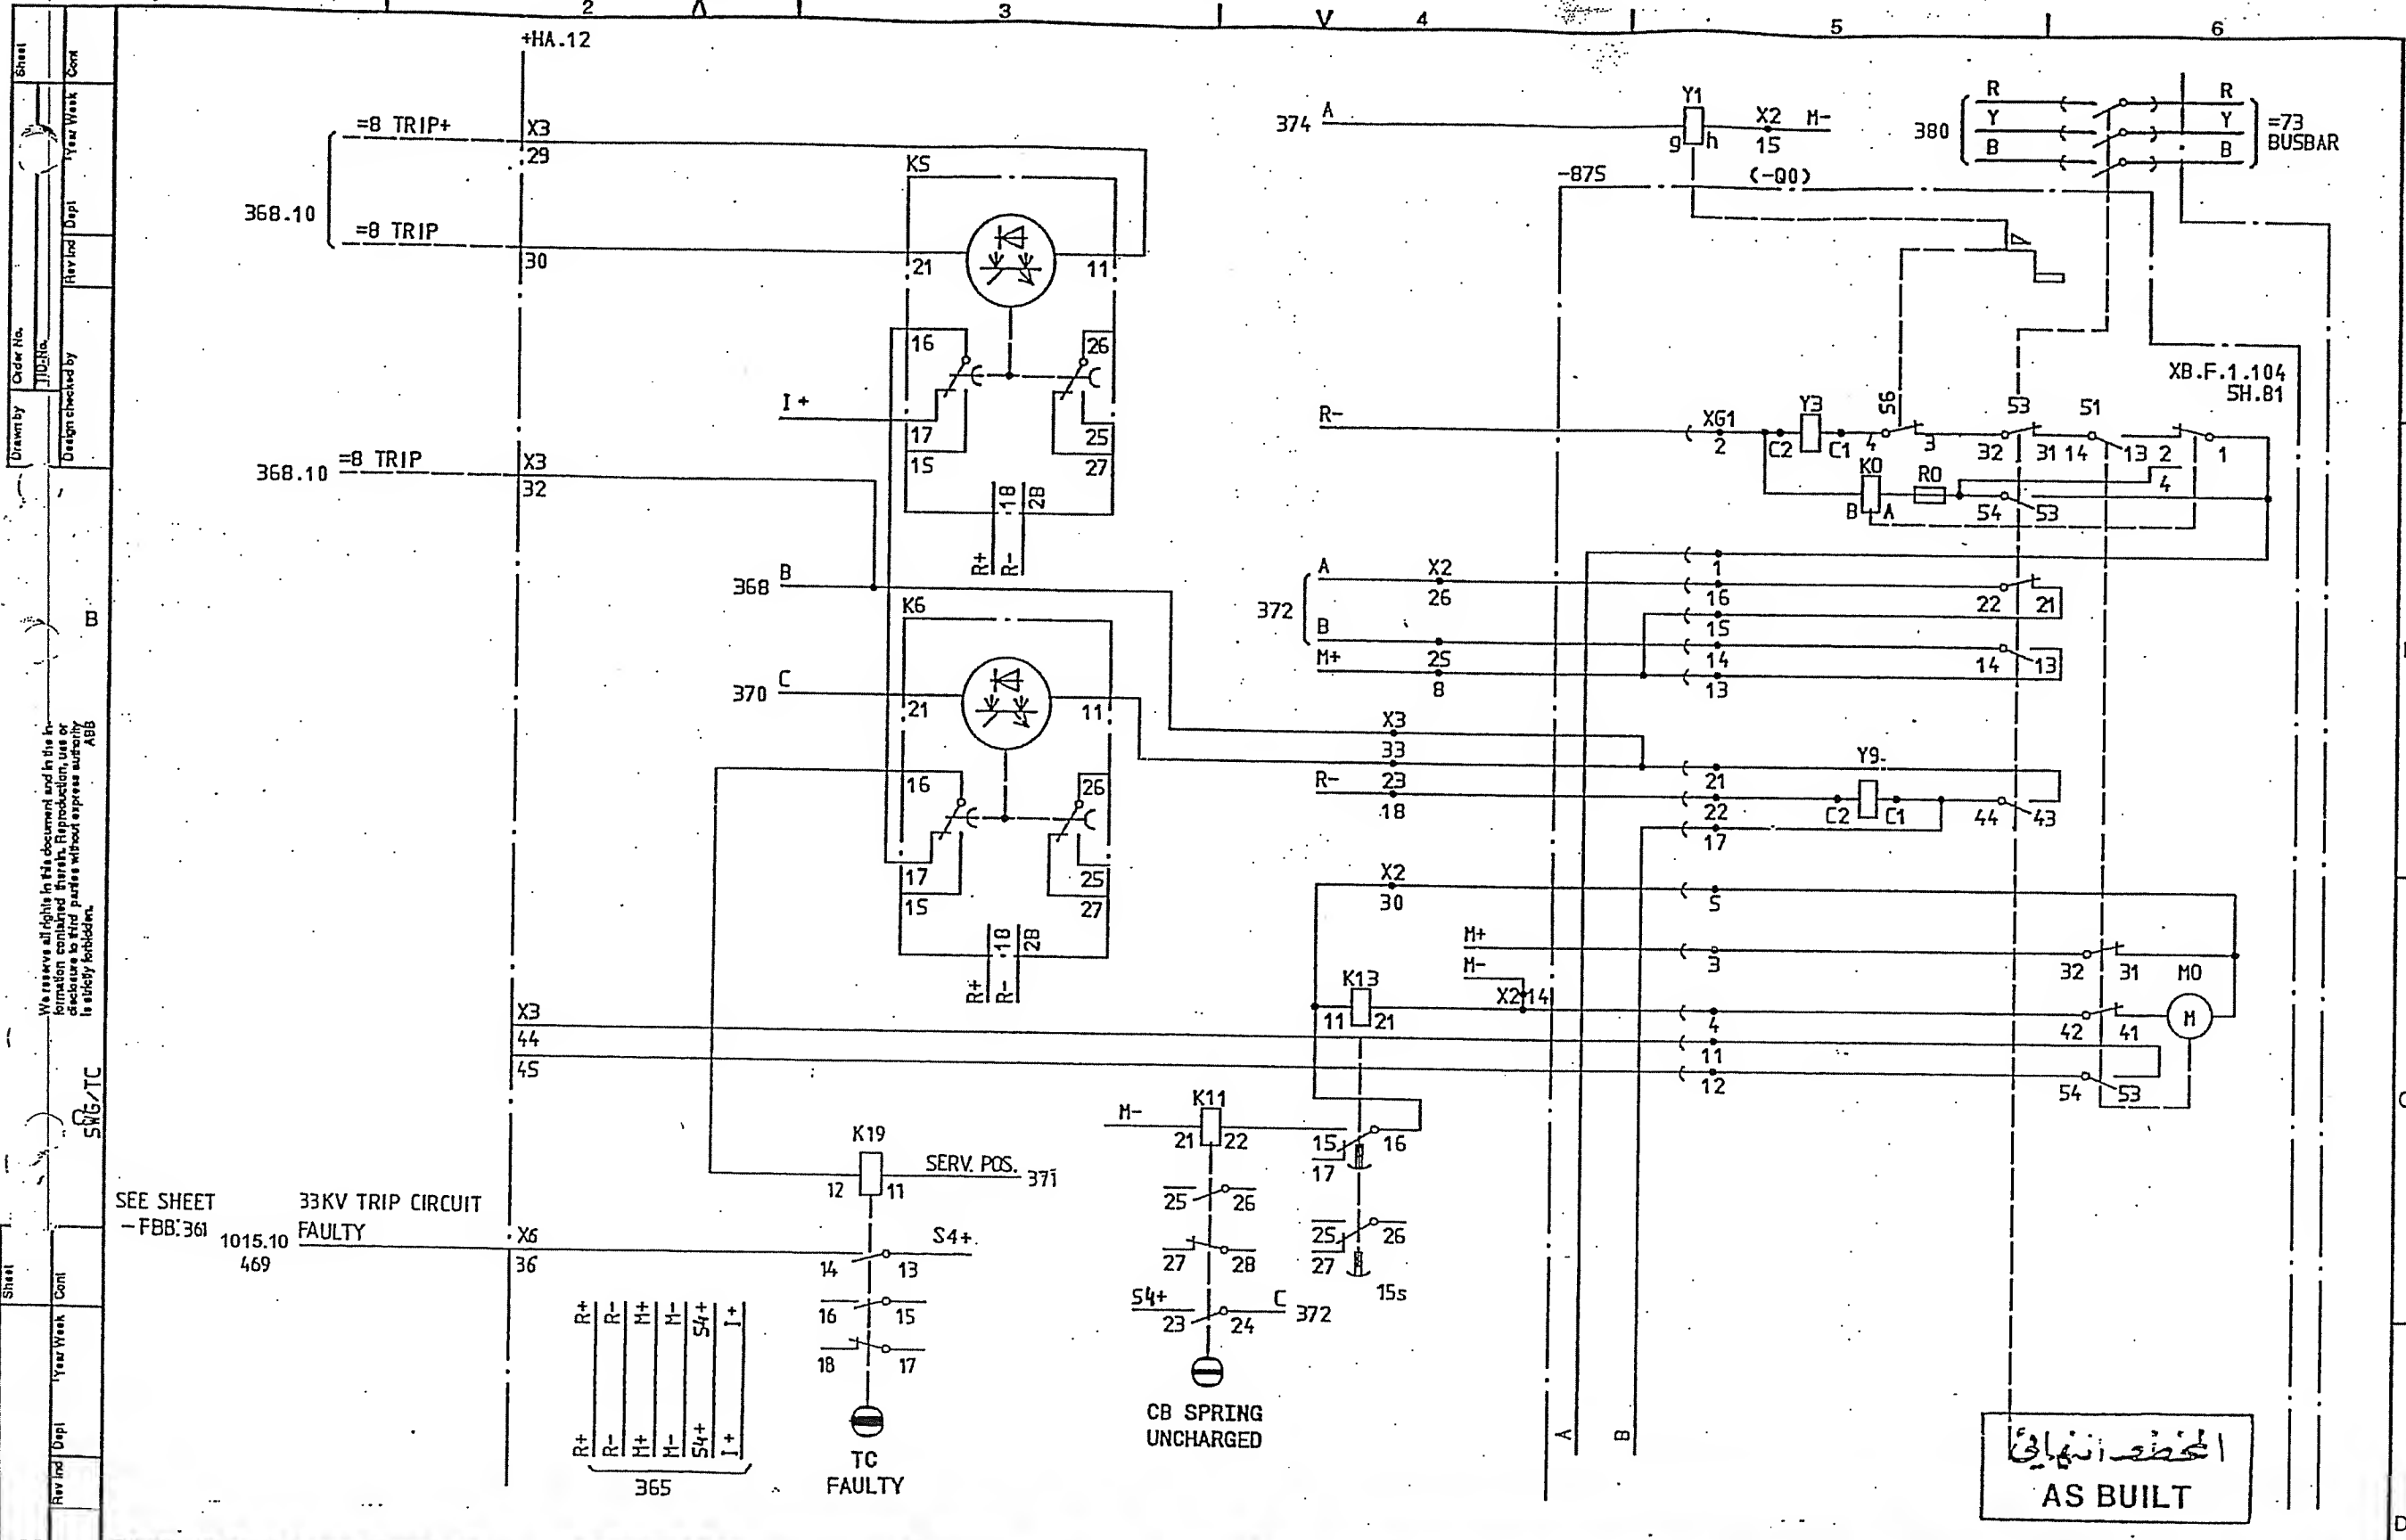

المخطط النهائي
AS BUILT

| | | | | | | | | | | | | | | | |
|-------------------------------|--|----------------|--|----------|--|-------------------------------|--|--------------------------------|--|----------------------------------|--|--|--|----------------|--|
| SYMBOL ID: XL824028-FBR:369/0 | | 92-07-02 18.55 | | =8 | | 33/13.8kV TRANSFORMER BAY T13 | | CIRCUIT BREAKER EQUIPMENT -875 | | Design checked by B NILSSON | | CIRCUIT DIAGRAM S/S 8501 132/33kV SCECO CENTRAL SAUDI ARABIA | | Rev. No. Sheet | |
| 2.1 SCECO SNAG | | LS 92 26 | | AS BUILT | | LS 91 21 | | Appd Year Week | | Drawing checked by L SVENSSON | | SCECO CENTRAL SAUDI ARABIA | | Lang Sheet | |
| Rev. No. Sheet | | Appd Year Week | | 2 | | V | | 3 | | 4 | | 5 | | 6 | |
| L 9743.1017 | | XL 824.028-FBR | | 2.1 | | 370 | | TDCF 90 36 | | ABB HV SWITCHGEAR | | Rev. No. Sheet | | Lang Sheet | |
| 2.1 | | LS 92 26 | | AS BUILT | | LS 91 21 | | Appd Year Week | | 2 | | V | | 3 | |

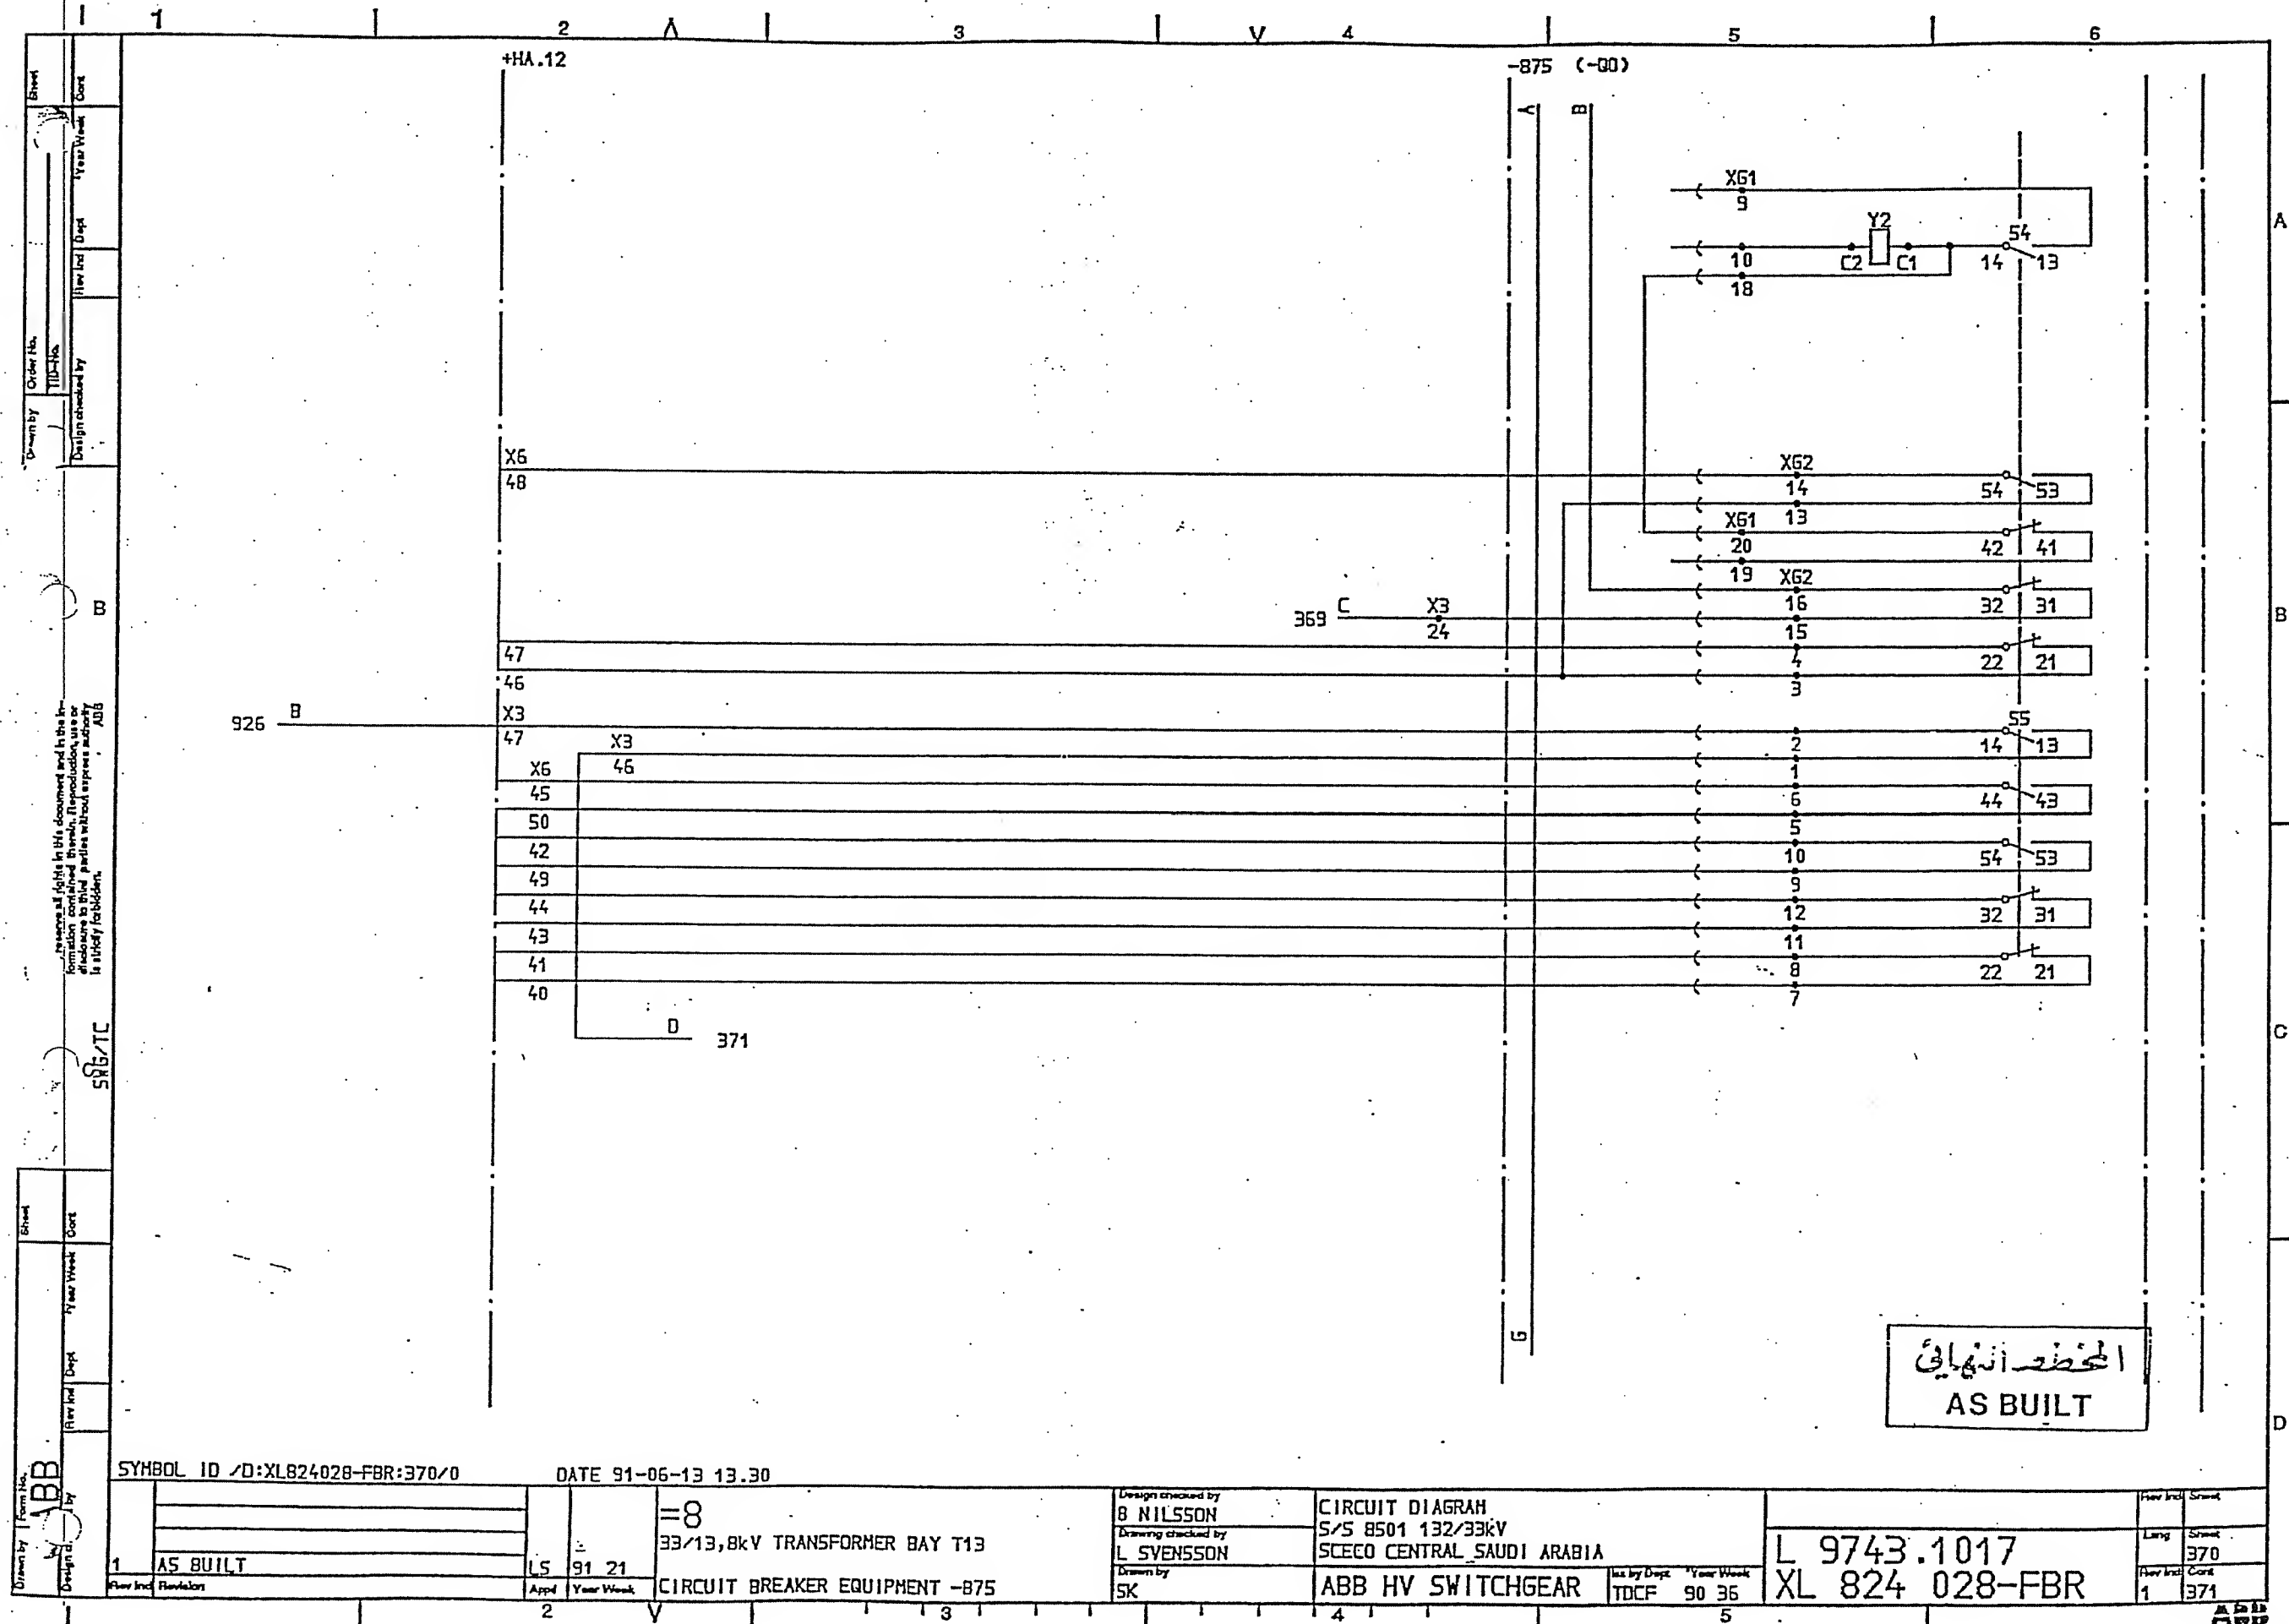

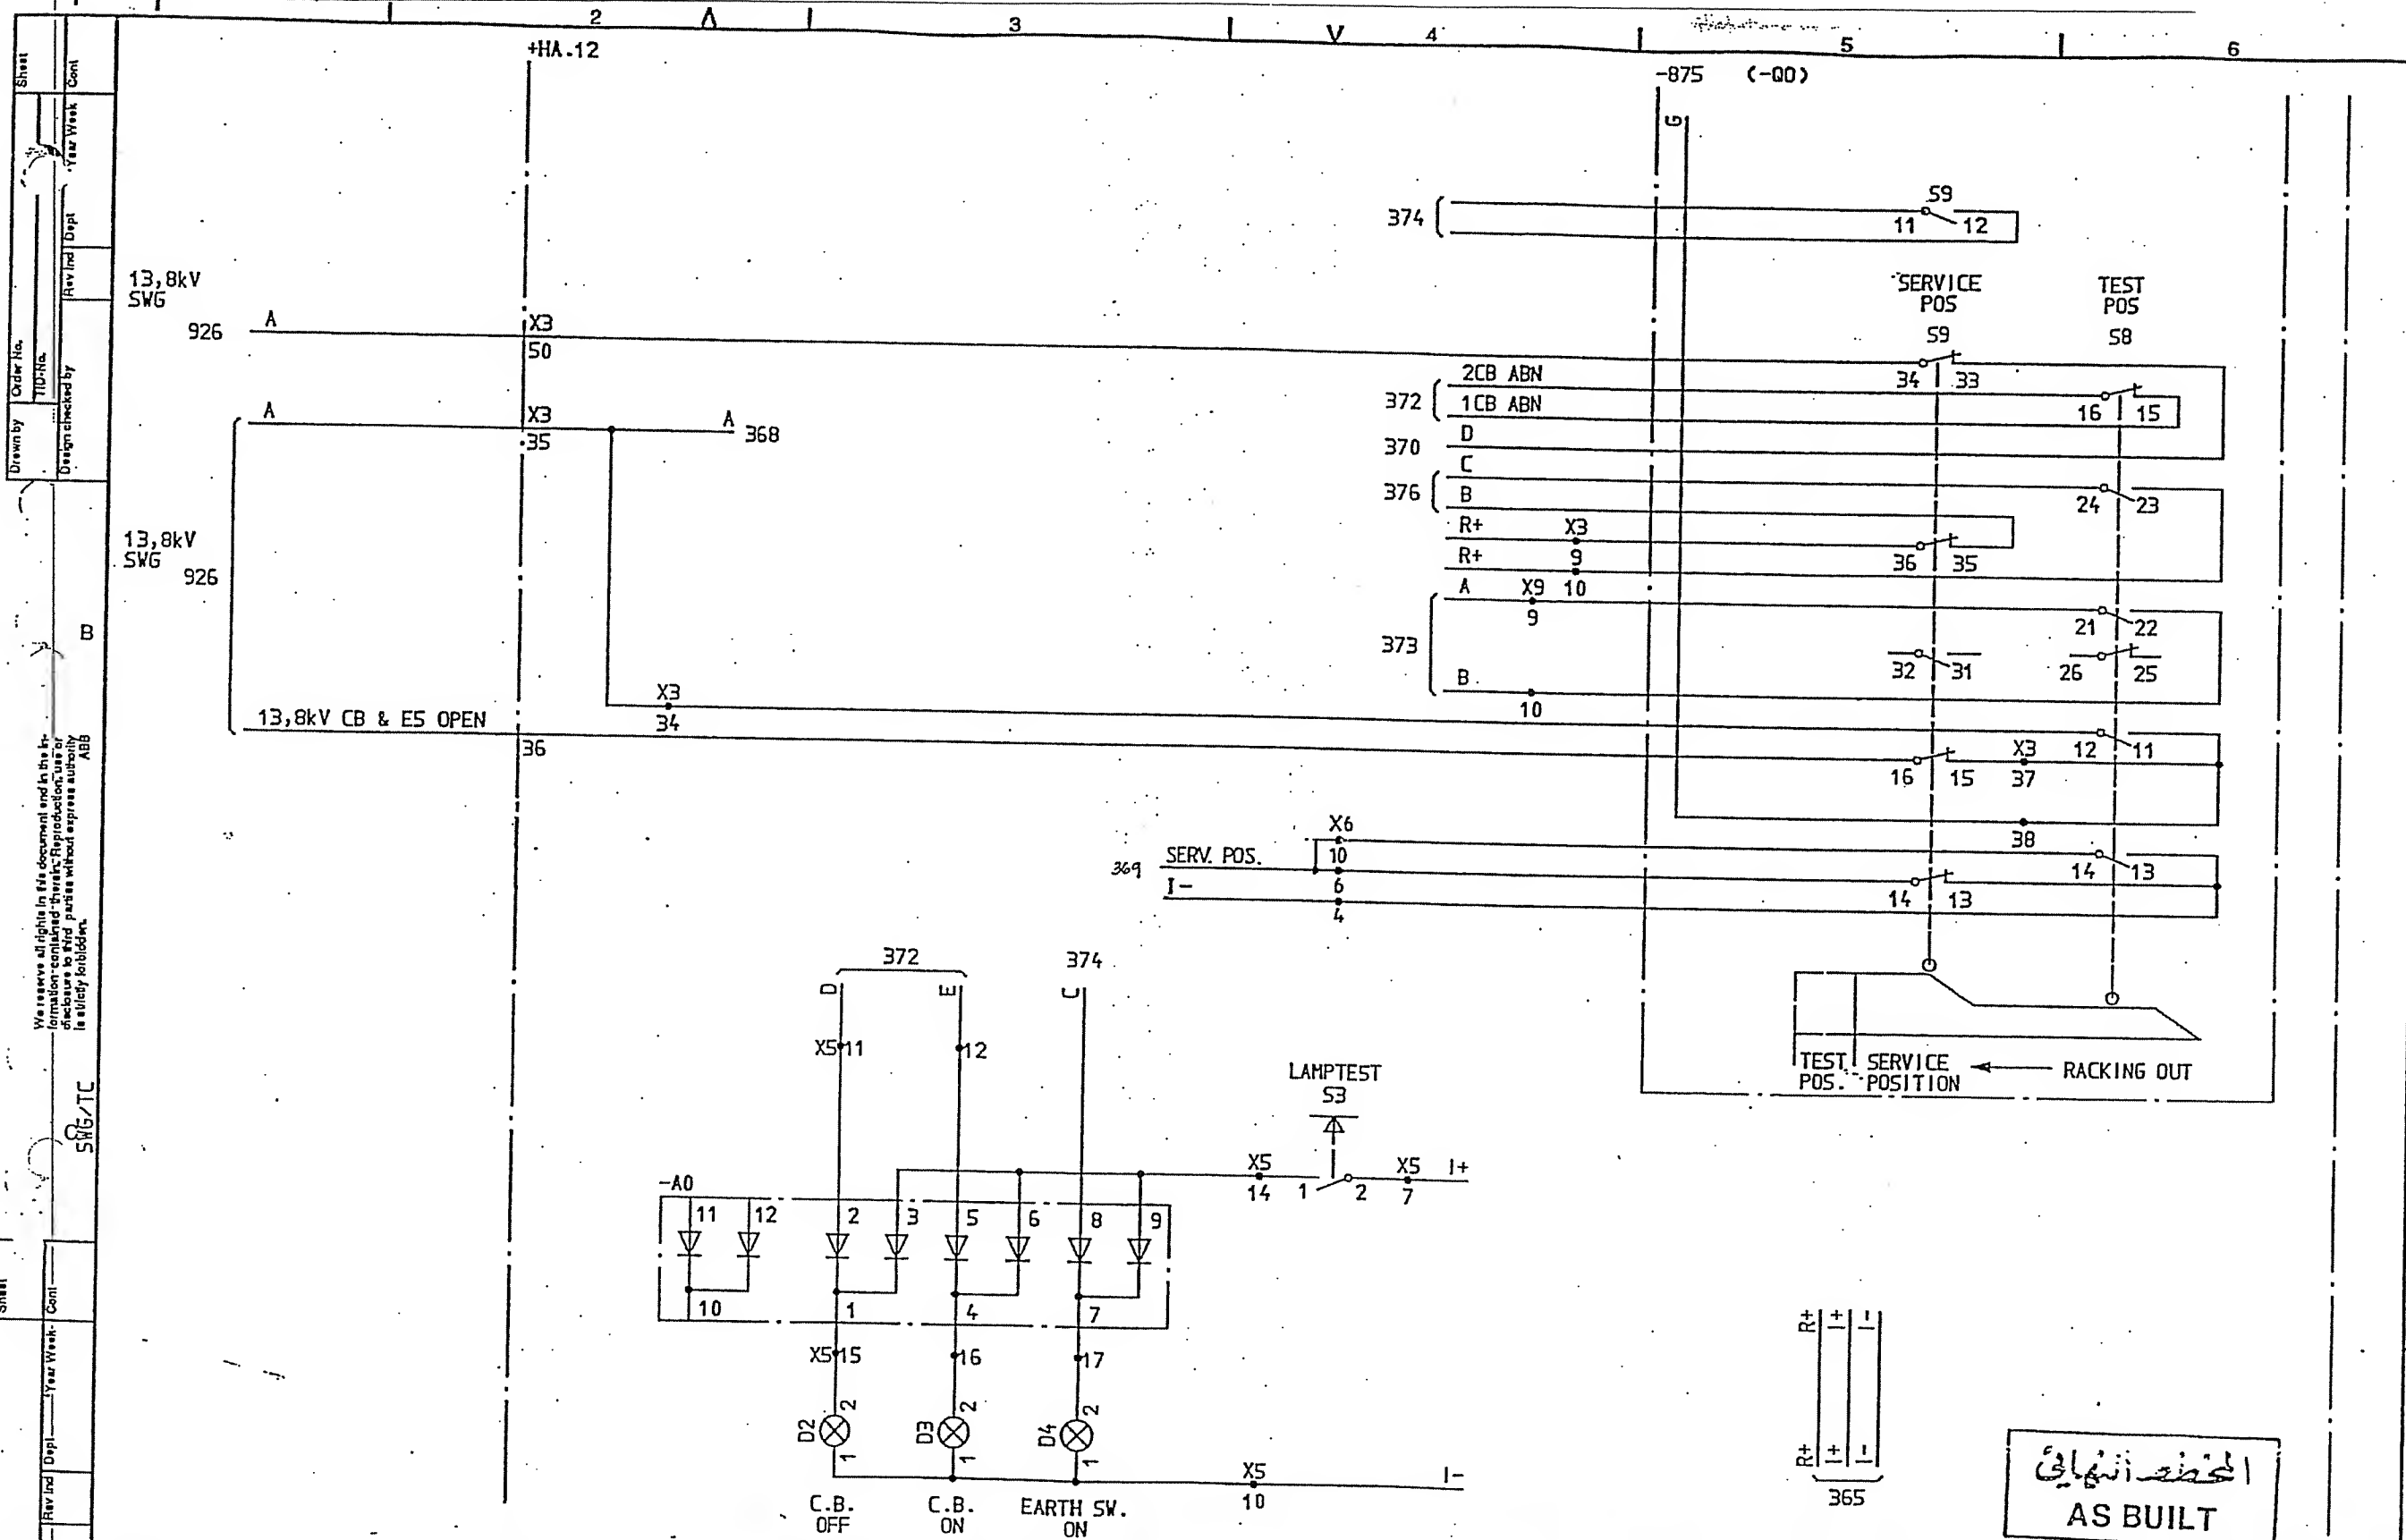

SYMBOL ID /D:XL824028-FBR:371/0

92-07-02 18.55

=8

33/13,8kV TRANSFORMER BAY T13

CIRCUIT BREAKER EQUIPMENT -875

Design checked by
B NILSSON

Drawing checked by
L SVENSSON

Drawn by
SK

CIRCUIT DIAGRAM

S/S 8501 132/33kV

SCECO CENTRAL SAUDI ARABIA

ABB HV SWITCHGEAR

Iss by Dept Year Week
TDCF 90 36

L 9743.1017
XL 824 028-FBR

Rev Ind Sheet

Long Sheet

Rev Ind Cont

2.1 372

ALBID


| | | | |
|-------------------|-----------|-----------|------|
| Drawn by | Order No. | Year Week | Cont |
| | 1015.10 | | |
| Design checked by | Rev Ind | Depl | |
| | | | |

We reserve all rights in this document and in the information contained herein. Reproduction, use or disclosure to third parties without express authority is strictly forbidden.


| | | | |
|----------|----------|-----------|------|
| Drawn by | Form No. | Year Week | Cont |
| ABB | | | |
| Rev Ind | Revision | Year Week | |
| | | | |

1015.10
472
33kV CB ABNORMAL
33kV CB ABNORMAL

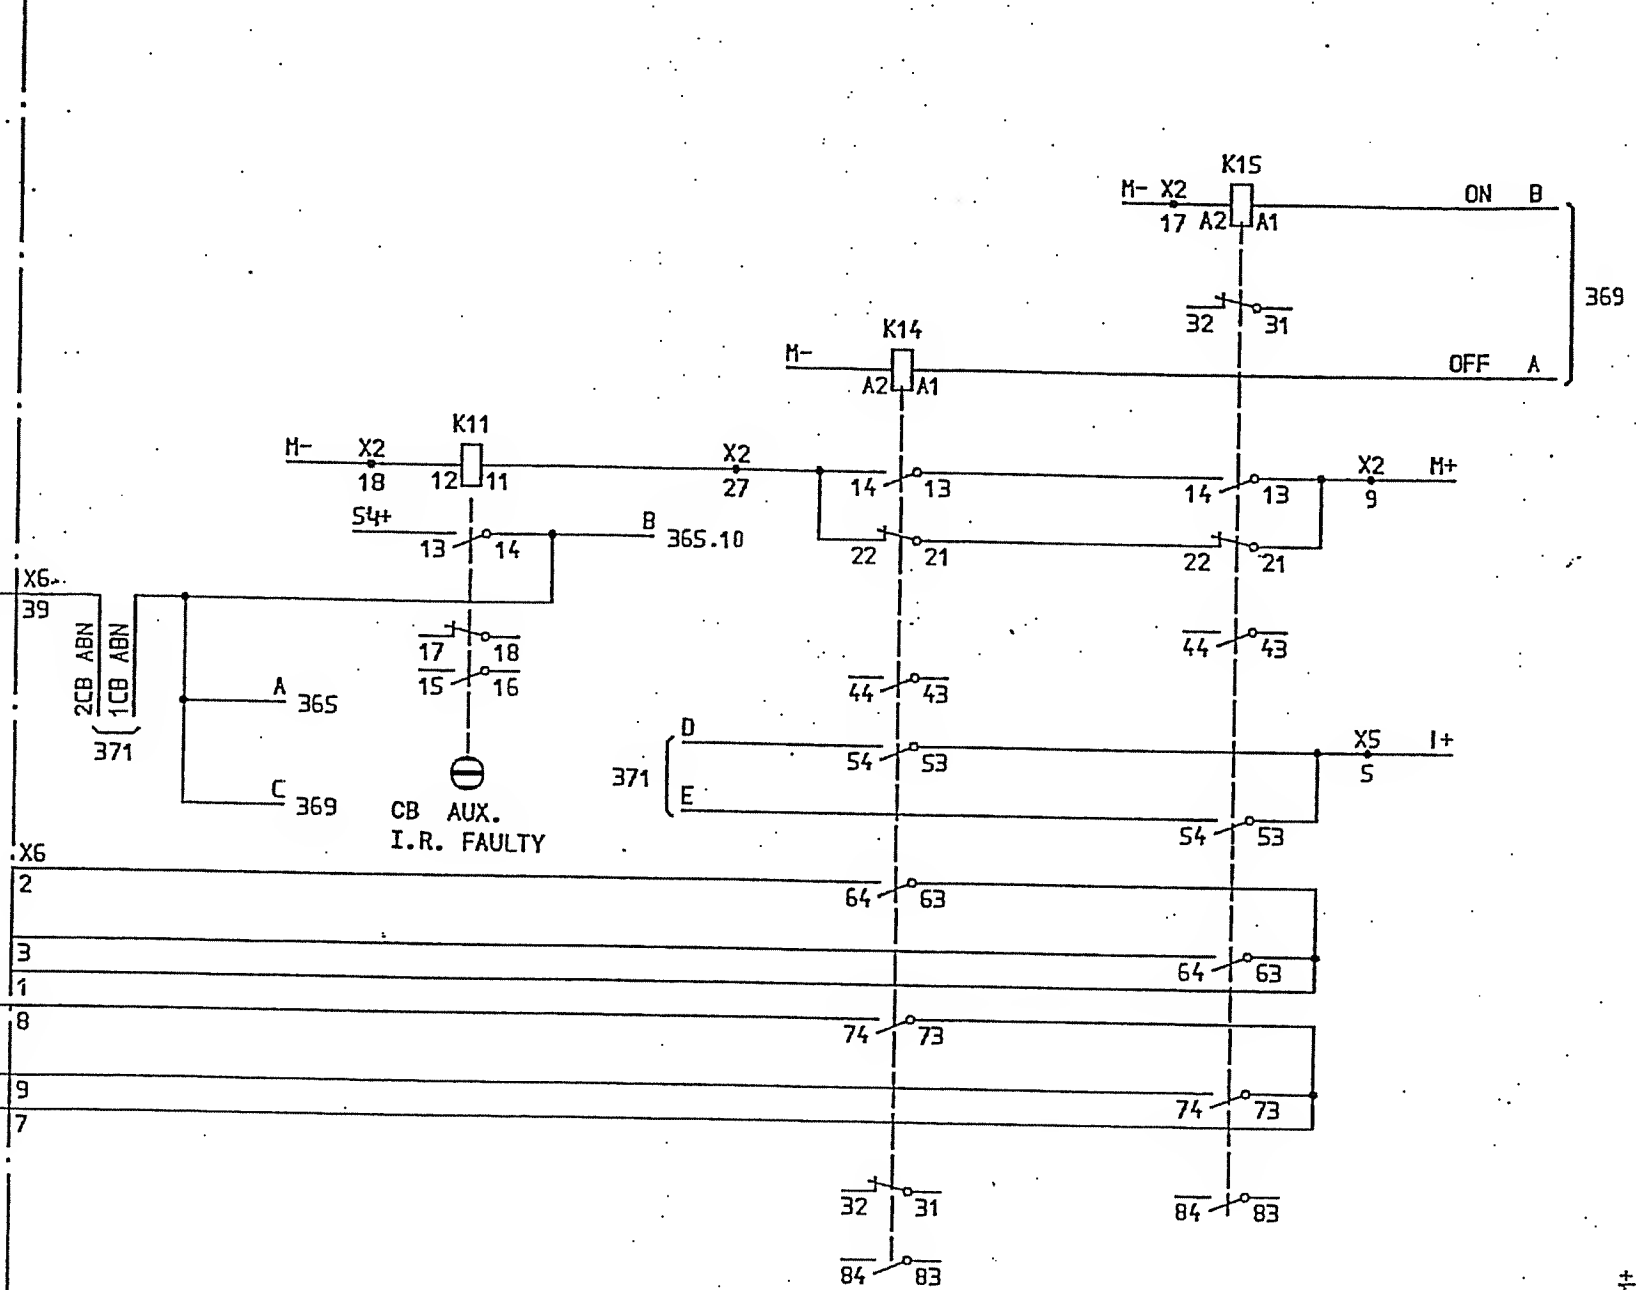+HA.12



362
OPEN
CLOSED
COMM

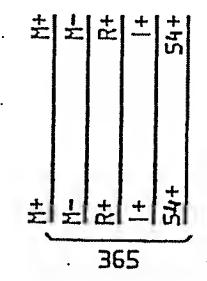

المحطة النهائية
AS BUILT

SYMBOL ID /D:XL824028-FBR:372/0

92-07-02 18.55

| | | | | | |
|---------|------------|------|-----------|----|--------------------------------|
| 2 | SCECO SNAG | LS | 92 26 | =8 | 33/13,8kV TRANSFORMER BAY T13 |
| 1 | AS BUILT | LS | 91 21 | | |
| Rev Ind | Revision | Appd | Year Week | | CIRCUIT BREAKER EQUIPMENT -875 |
| 2 | | | | | |


Design checked by
B NILSSON
Drawing checked by
L SVENSSON
Drawn by
SK


CIRCUIT DIAGRAM
S/S 8501 132/33kV
SCECO CENTRAL SAUDI ARABIA
ABB HV SWITCHGEAR

Iss by Dept Year Week
TDCF 90 36

L 9743.1017
XL 824.028-FBR

| | |
|---------|-------|
| Rev Ind | Sheet |
| 2 | 372 |
| Rev Ind | Cont |
| 2 | 373 |

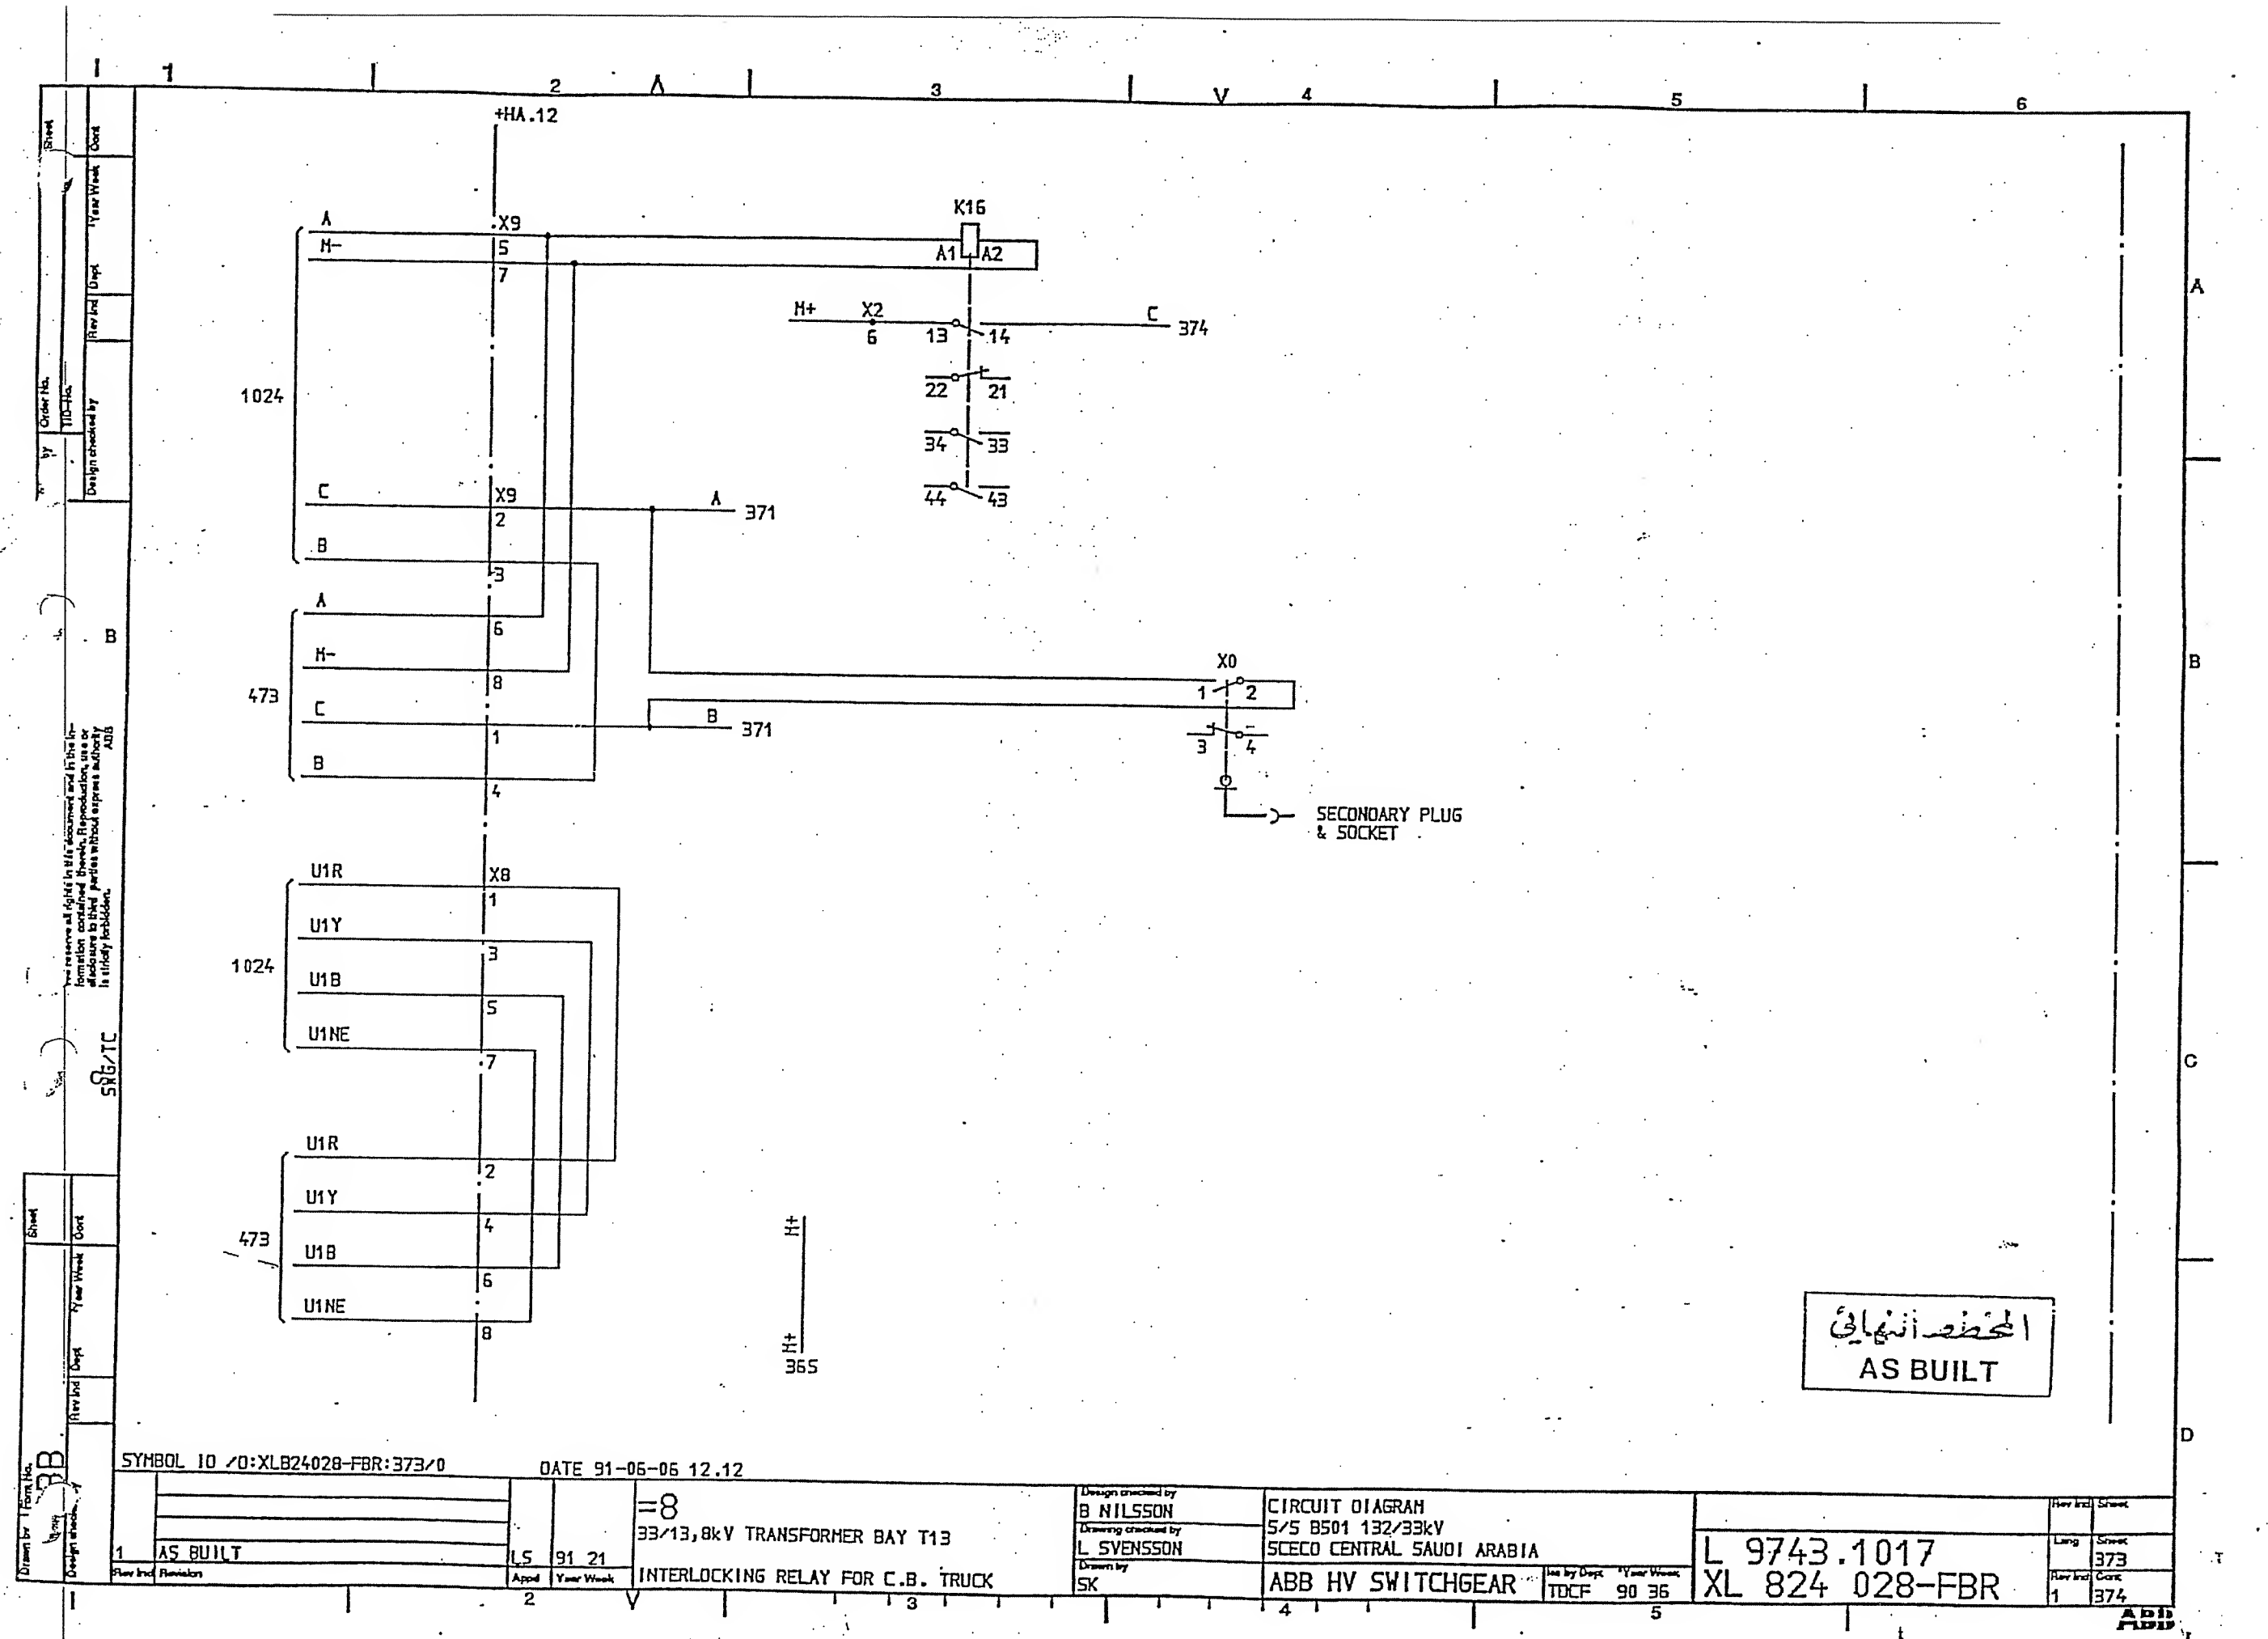


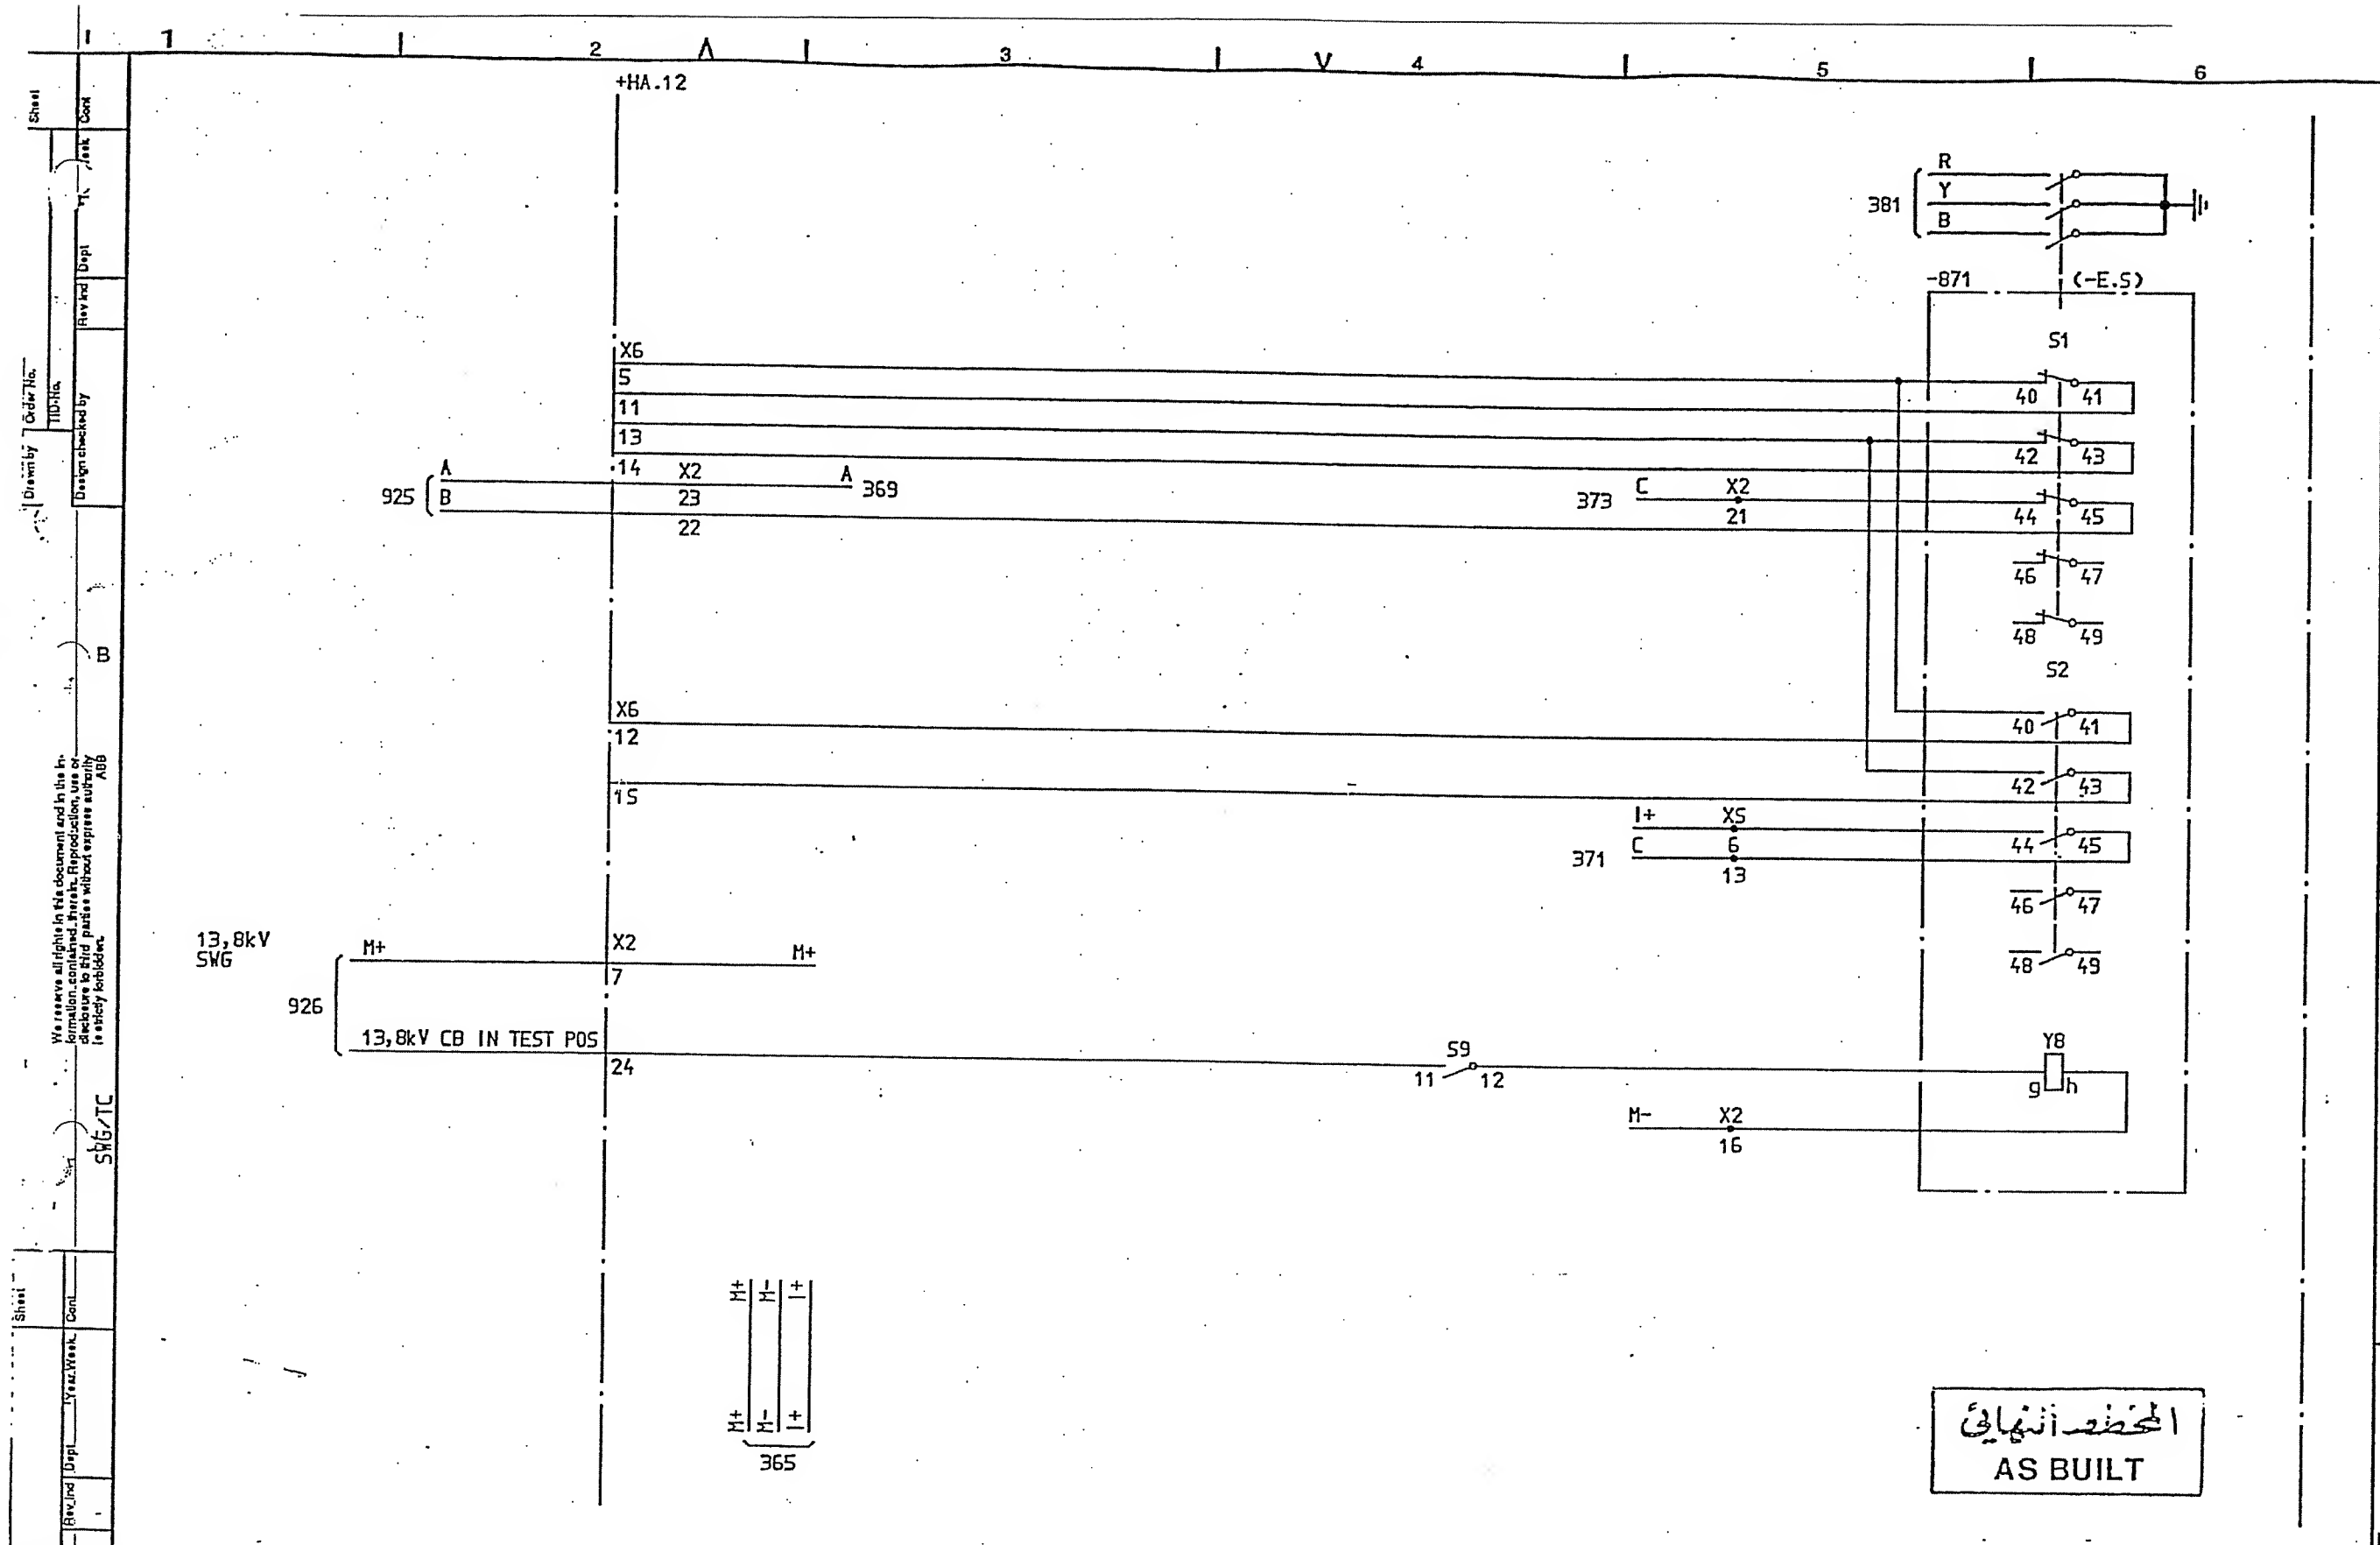


المحطة النهائية
AS BUILT

| | | | | | |
|------------------------------|--|--------------------------------|--|----------------------------|--|
| Drawn by: ABB | | Form No. 1 | | Sheet 1 | |
| Design checked by: B NILSSON | | Drawing checked by: L SVENSSON | | Issued by: TDCF | |
| CIRCUIT DIAGRAM | | S/S 8501 132/33kV | | SCECO CENTRAL SAUDI ARABIA | |
| ABB HV SWITCHGEAR | | Year Week 90 36 | | L 9743.1017 | |
| XL 824.028-FBR | | 2 | | 376 | |

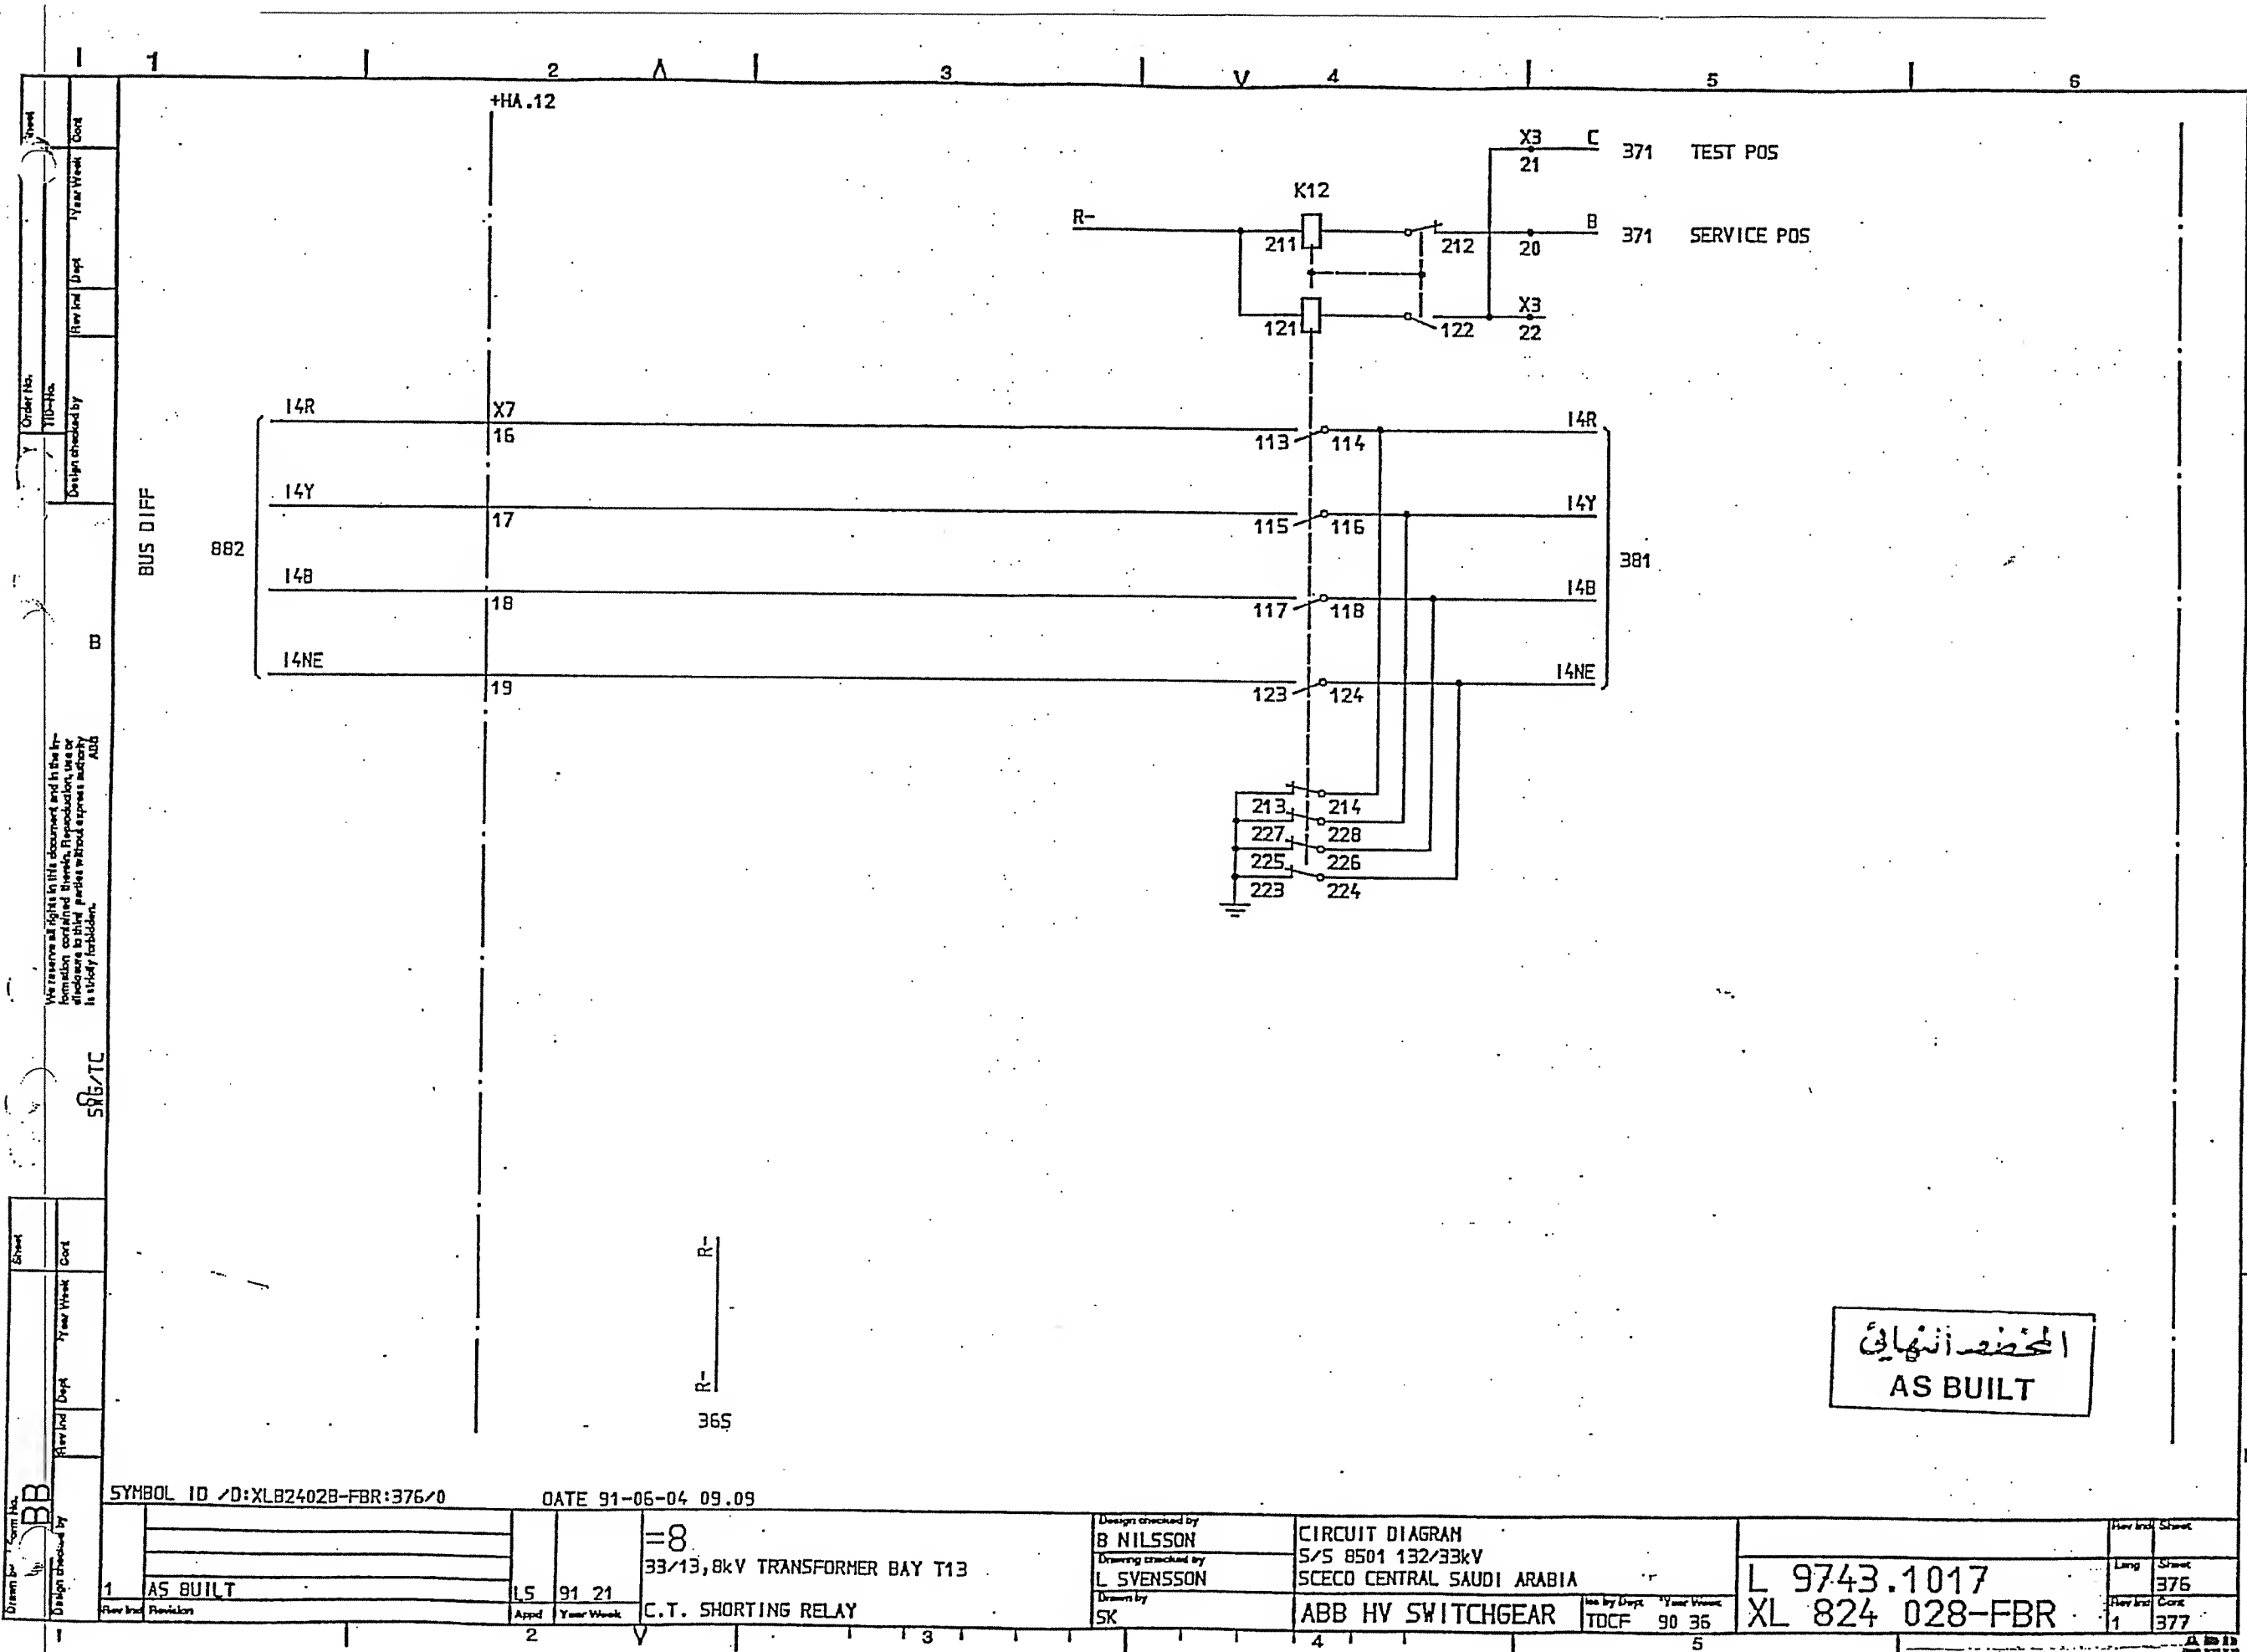AS BUILT



| | | | | | | | | | | | | | | | | | |
|---------------------------------|--|---------------------|--|---------------------|--|--------------------------------|--|----------------------------------|--|-------------------|--|----------------------------|--|-------------|--|----------------|--|
| SYMBOL ID /D:XL824028-FBR:376/0 | | DATE 91-06-04 09.09 | | =8 | | 33/13,8kV TRANSFORMER BAY T13 | | CIRCUIT DIAGRAM | | S/S 8501 132/33kV | | SCECO CENTRAL SAUDI ARABIA | | L 9743.1017 | | XL 824 028-FBR | |
| AS BUILT | | LS 91 21 | | C.T. SHORTING RELAY | | Design checked by B NILSSON | | Drawing checked by L SVENSSON | | Drawn by SK | | ABB HV SWITCHGEAR | | TDCF 90 36 | | 1 377 | |

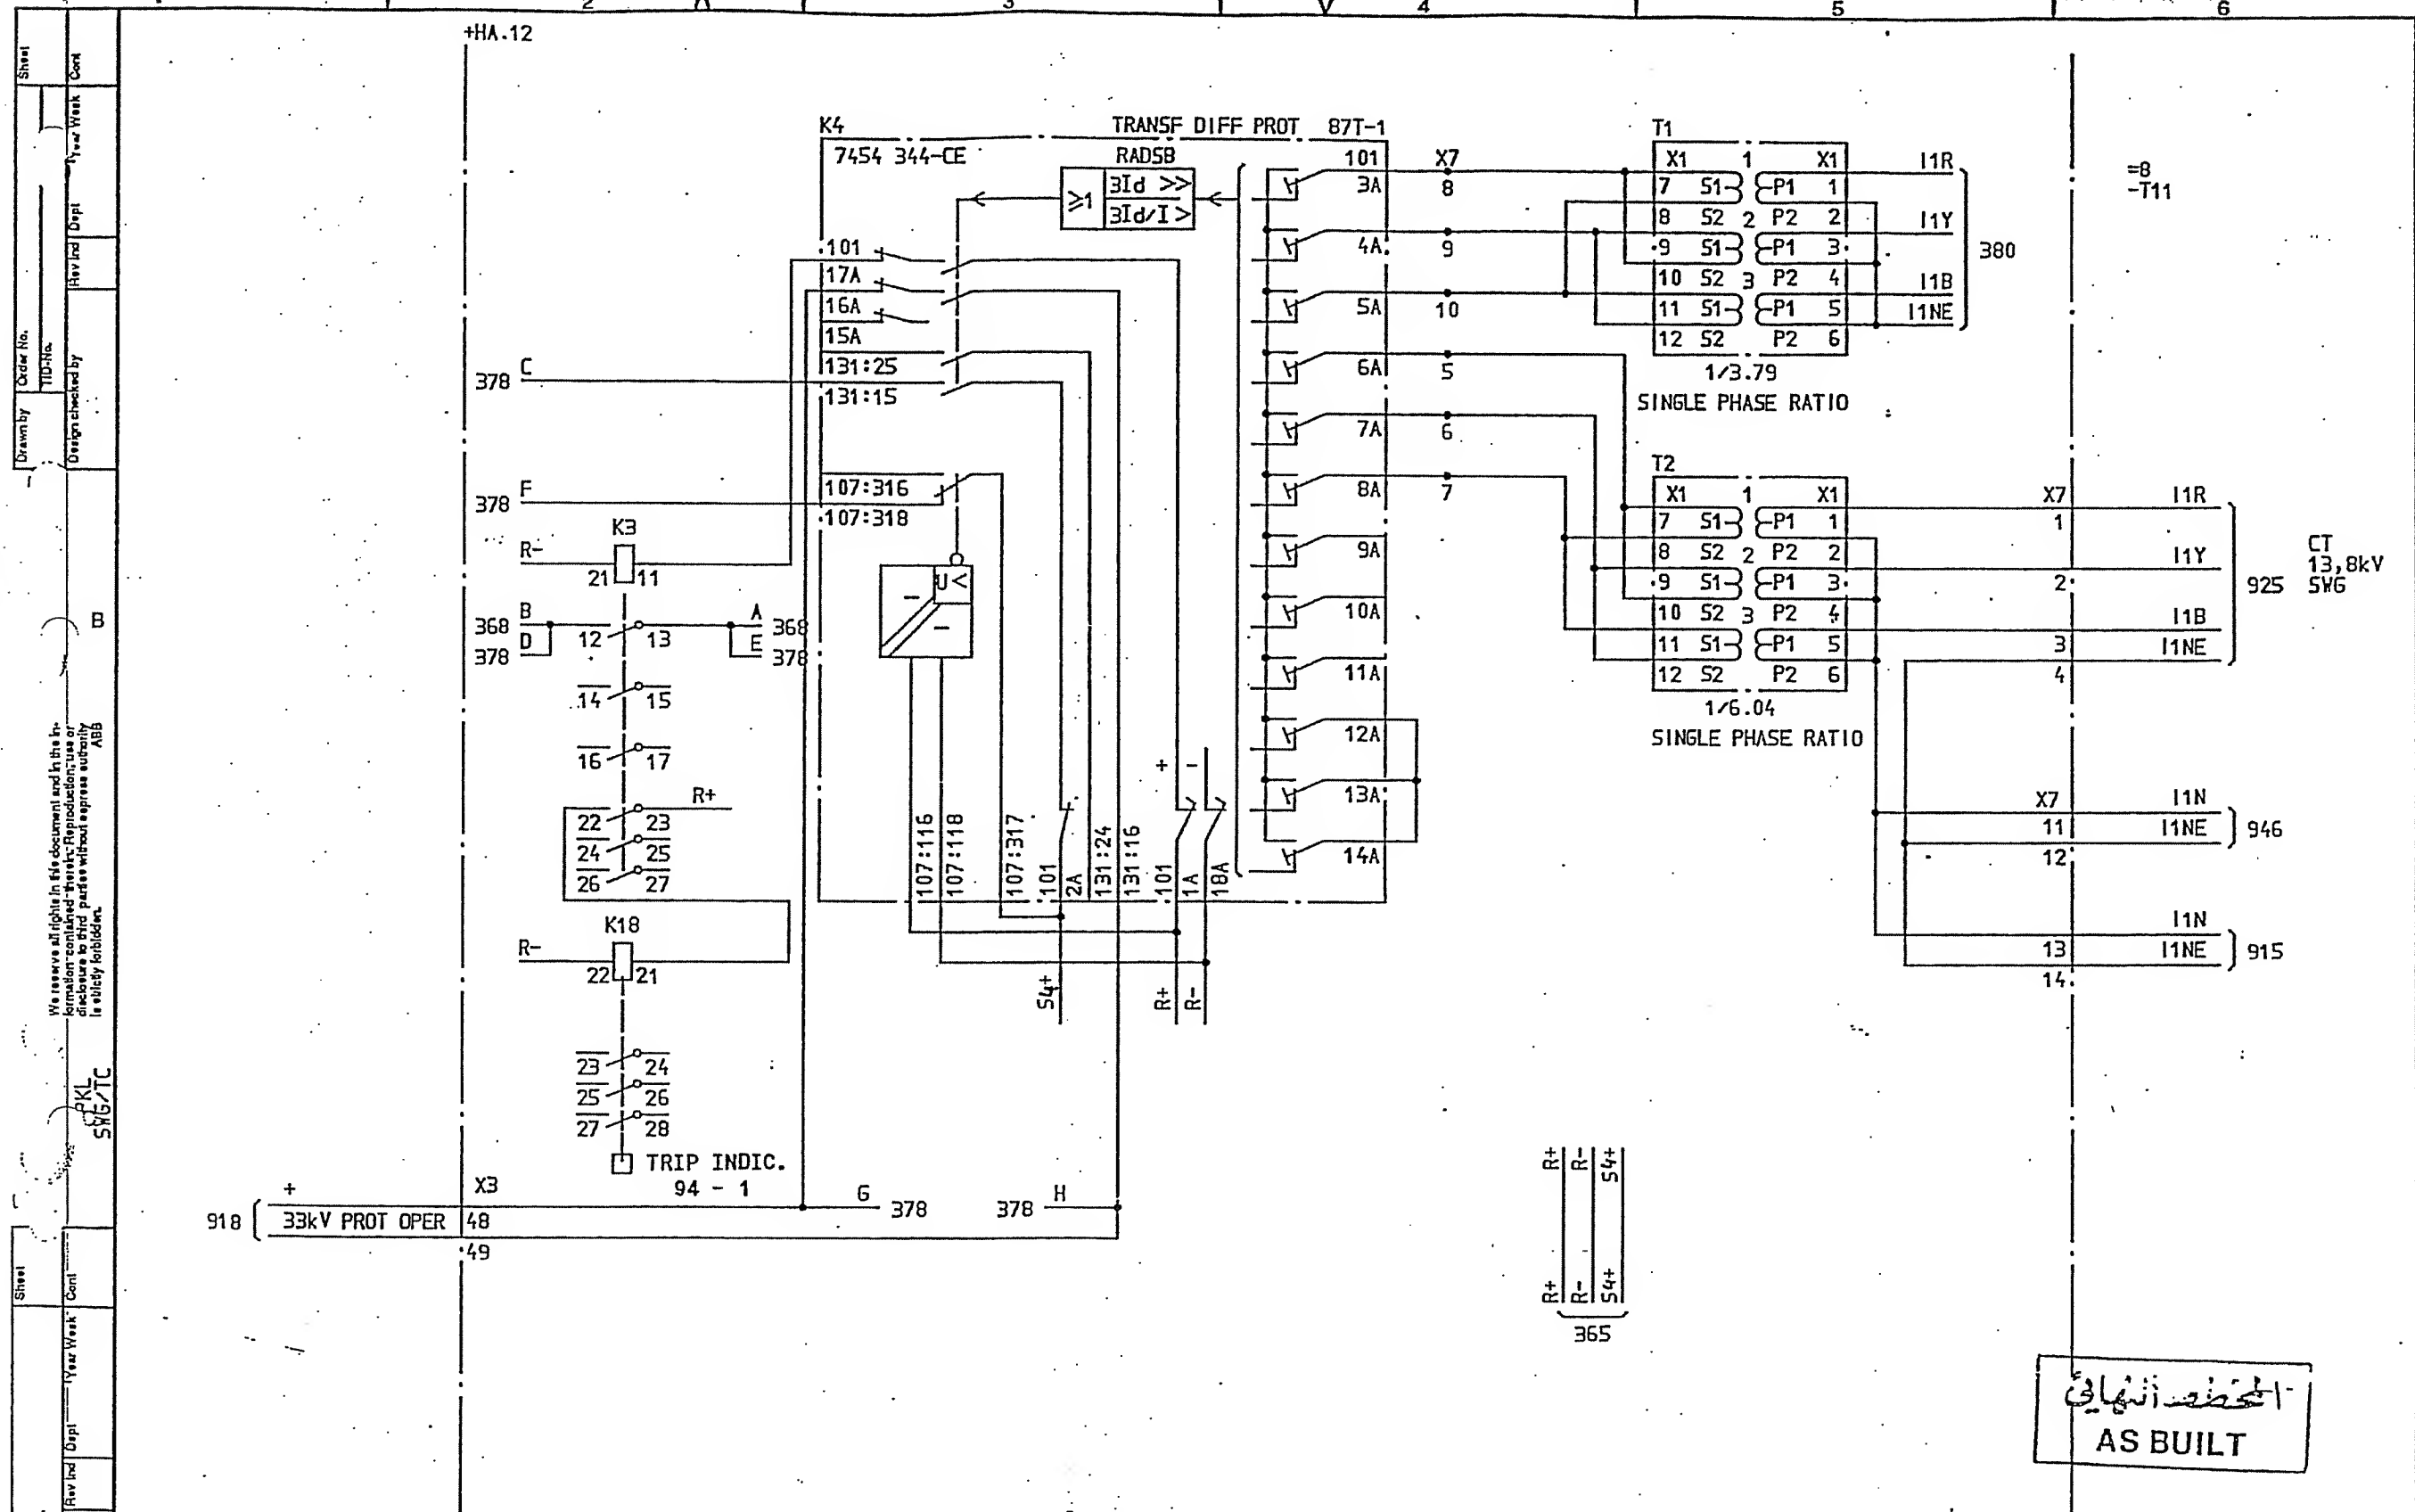

SYMBOL ID /D:XL824028-FBR:377/0

92-07-02 18.55

| | | | | | |
|---|------------|----|-------|---|-------------------------------|
| 2 | SCECO SNAG | LS | 92 26 | 8 | 33/13,8kV TRANSFORMER 8AY T13 |
| 1 | AS BUILT | CS | 91 21 | | TRANSFORMER DIFFERENTIAL PROT |

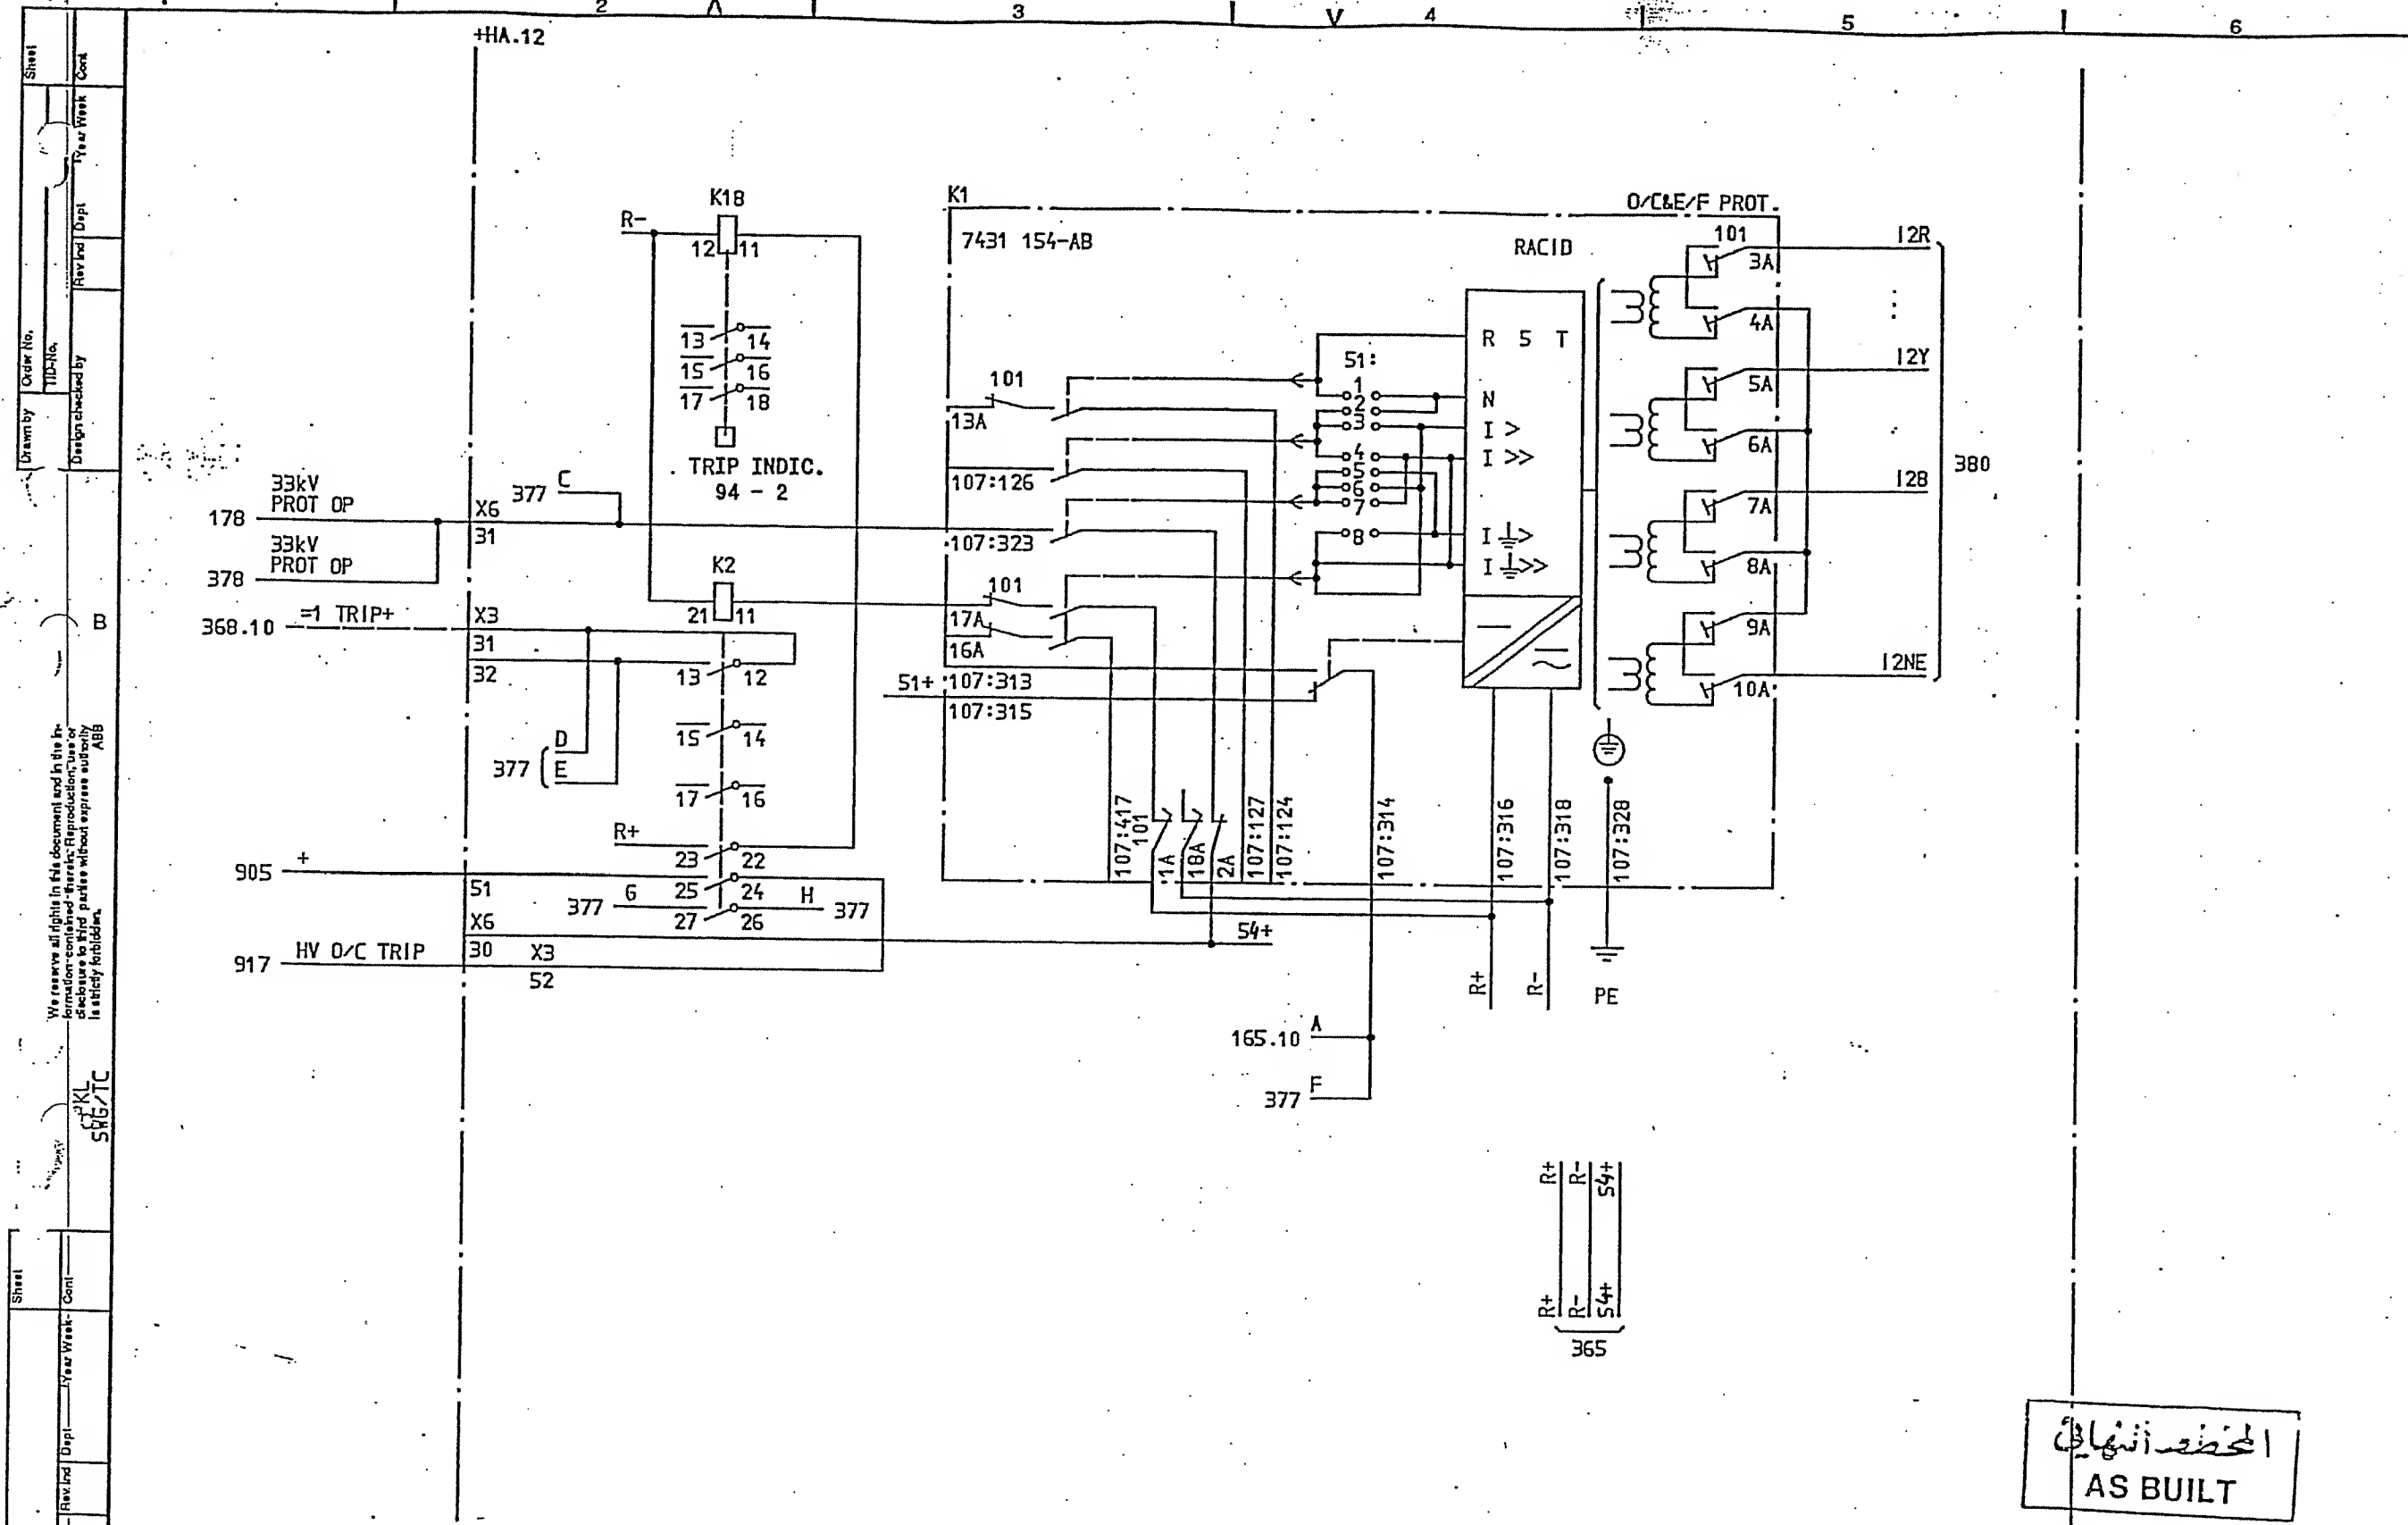
Design checked by
8 NILSSON
Drawing checked by
L SVENSSON
Drawn by
SK

CIRCUIT DIAGRAM
S/S 8501 132/33kV
SCECO CENTRAL SAUDI ARABIA
ABB HV SWITCHGEAR

Iss by Dept Year Week
TDCF 90 16


L 9743.1017
XL 824.028-FBR


Rev Ind Sheet
Lang Sheet
Rev Ind Cont
2 377
378



المحطة النهائية
AS BUILT

| | | | | | | | | | | | | | | | |
|----------------------------------|------------|----------------|-------|-----------|--|-------------------------------|--|-----------------------|--|--|--|-------------|--|----------------|--|
| SYMBOL ID / 0:XL824028-F8R:378/0 | | 92-07-02 18.55 | | =8 | | 33/13,8kV TRANSFORMER BAY T13 | | OVERCURRENT PROT 33kV | | CIRCUIT DIAGRAM S/S 8501 132/33kV SCECO CENTRAL SAUDI ARABIA | | L 9743.1017 | | XL 824 028-FBR | |
| 2 | SCECO SNA6 | LS | 92 26 | | | | | | | Design checked by B NILSSON | | | | | |
| 1 | AS BUILT | LS | 91 21 | | | | | | | Design checked by L SVENSSON | | | | | |
| Rev Ind | | Appd | | Year Week | | Drawn by | | Use by Dept | | Year Week | | Rev Ind | | Sheet | |
| | | | | | | SK | | TDCF | | 90 16 | | 2 | | 380 | |

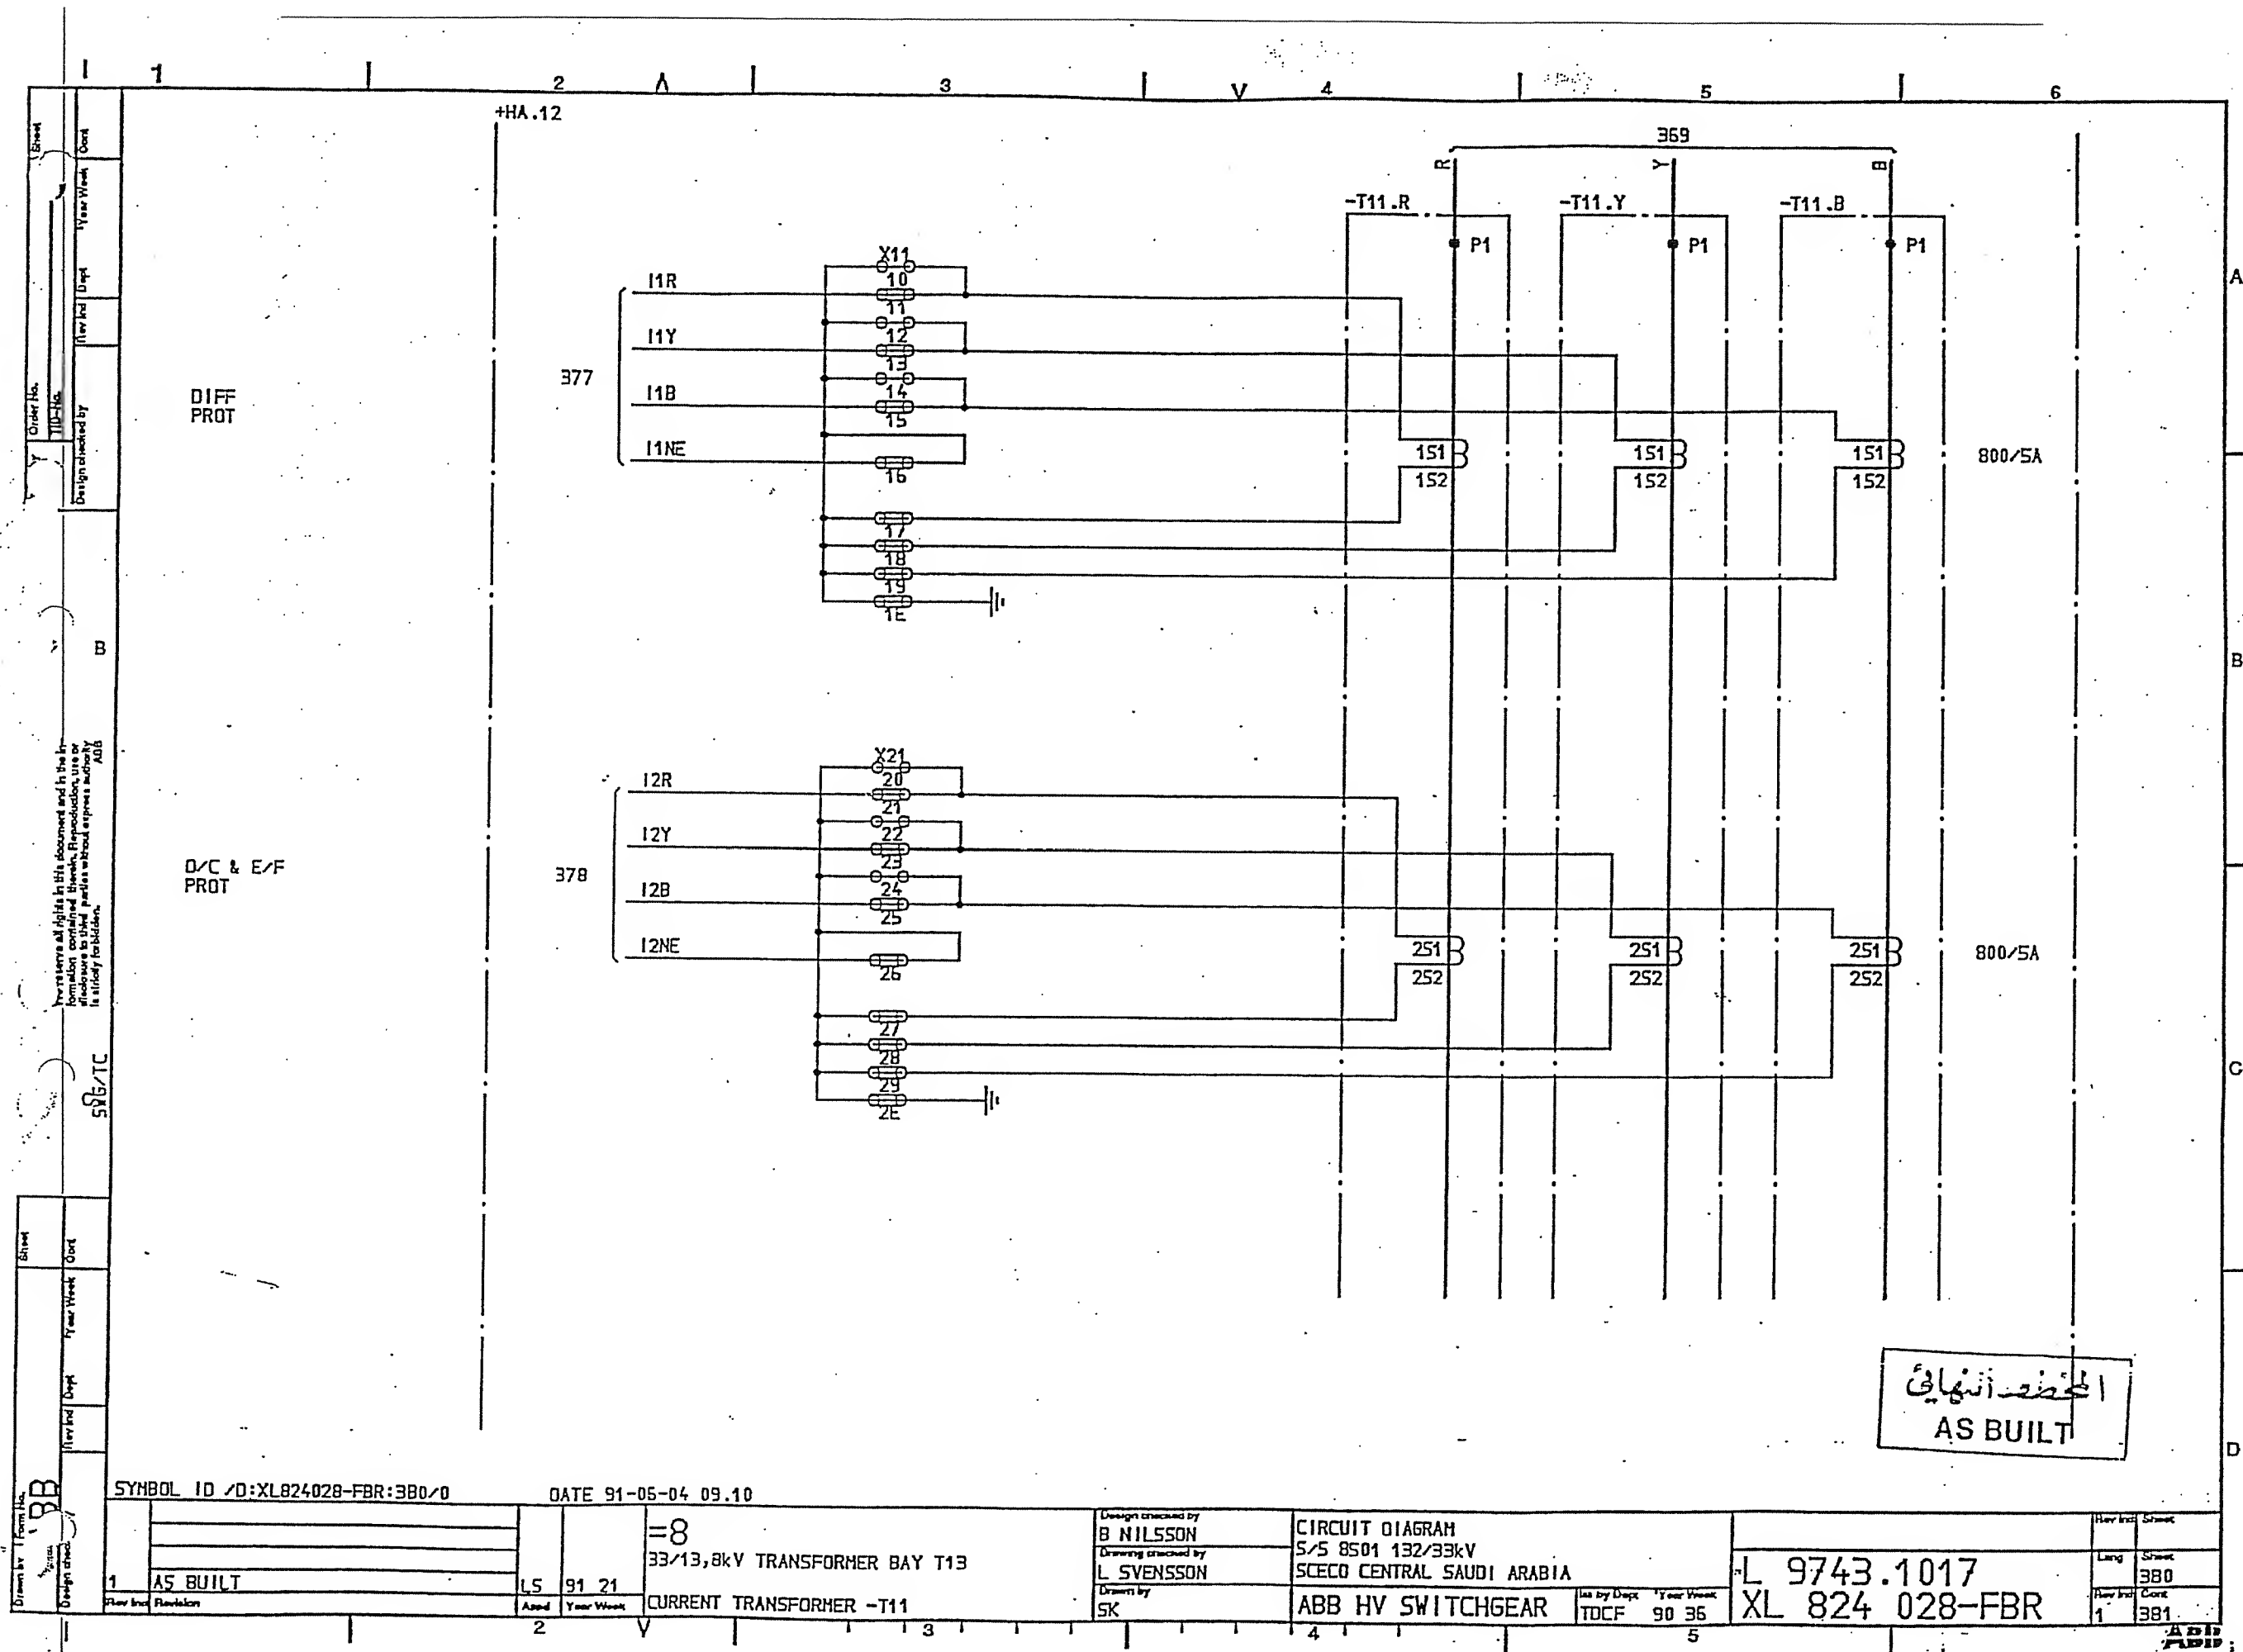

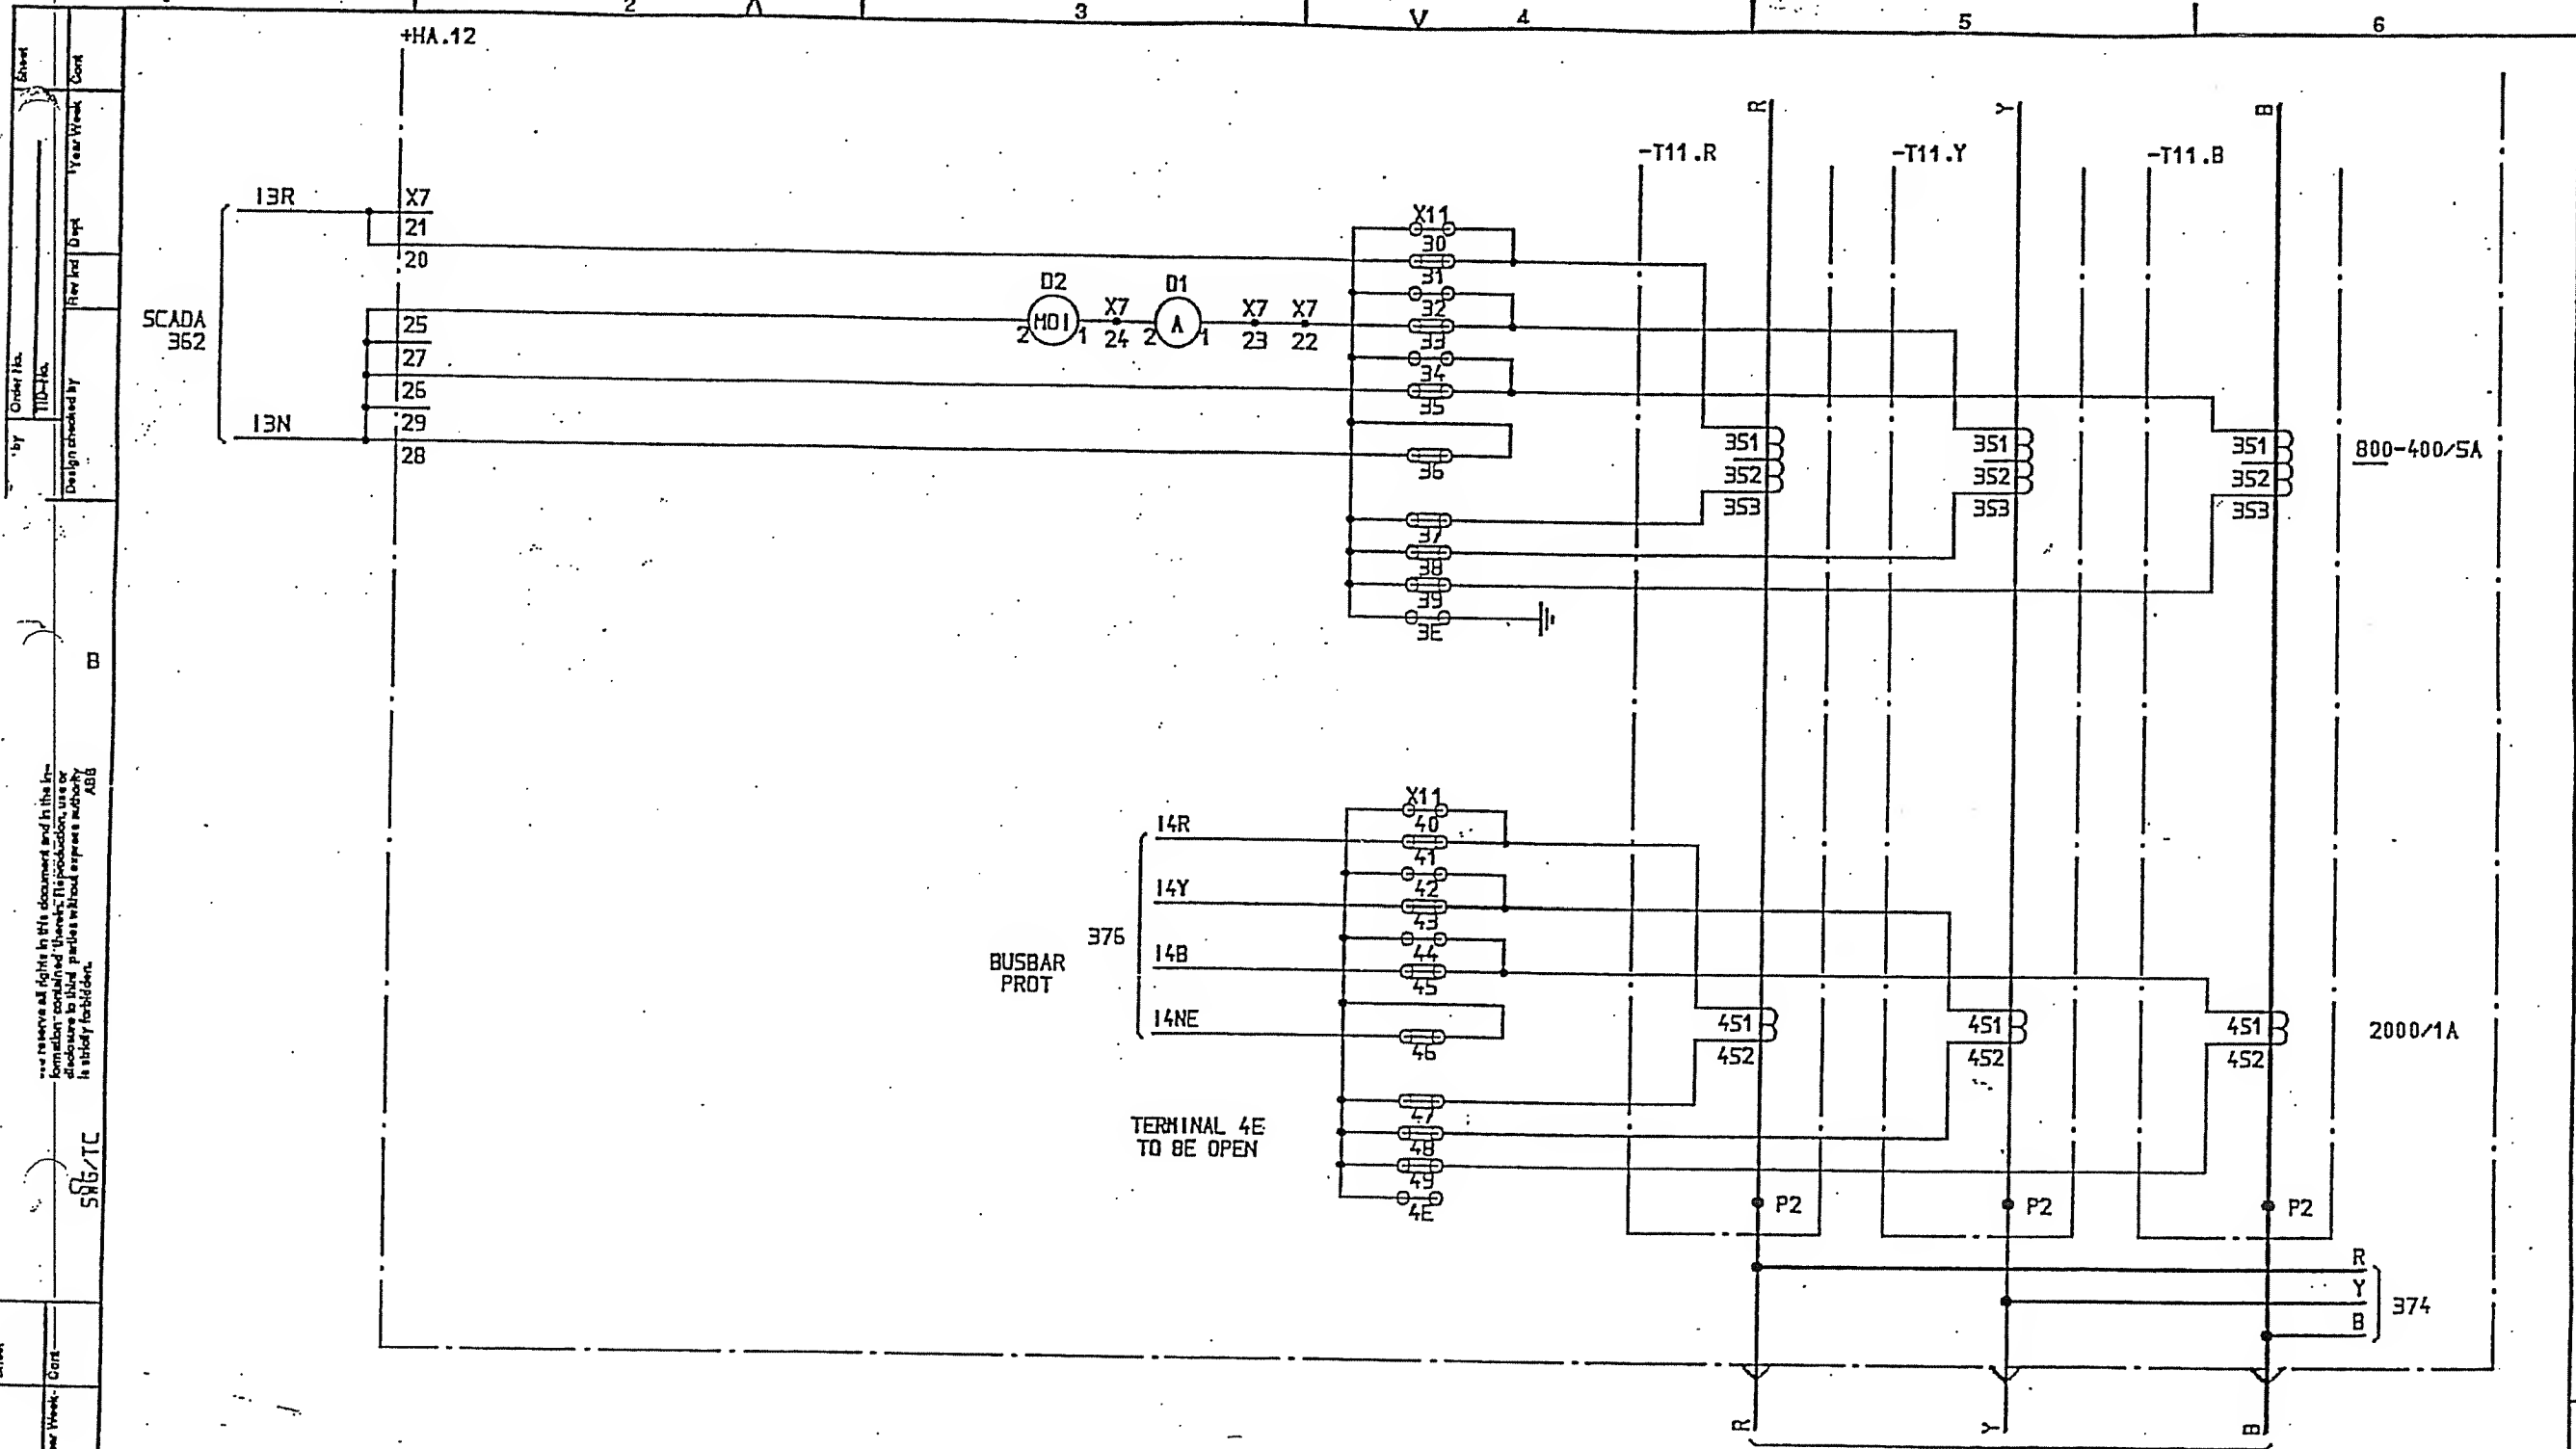

33/13,8kV TRANSFORMER T13
=T13

المحظوظ النهائي
AS BUILT

SYMBOL ID /D:XL824028-FBR:381/0

DATE 91-06-04 09.10

| | | | | | |
|---|----------|----|-------|---|-------------------------------|
| 1 | AS BUILT | LS | 91 21 | 8 | 33/13,8kV TRANSFORMER BAY T13 |
| 2 | | | | | CURRENT TRANSFORMER -T11 |

Design checked by
B NILSSON
Drawing checked by
L SVENSSON
Drawn by
SK

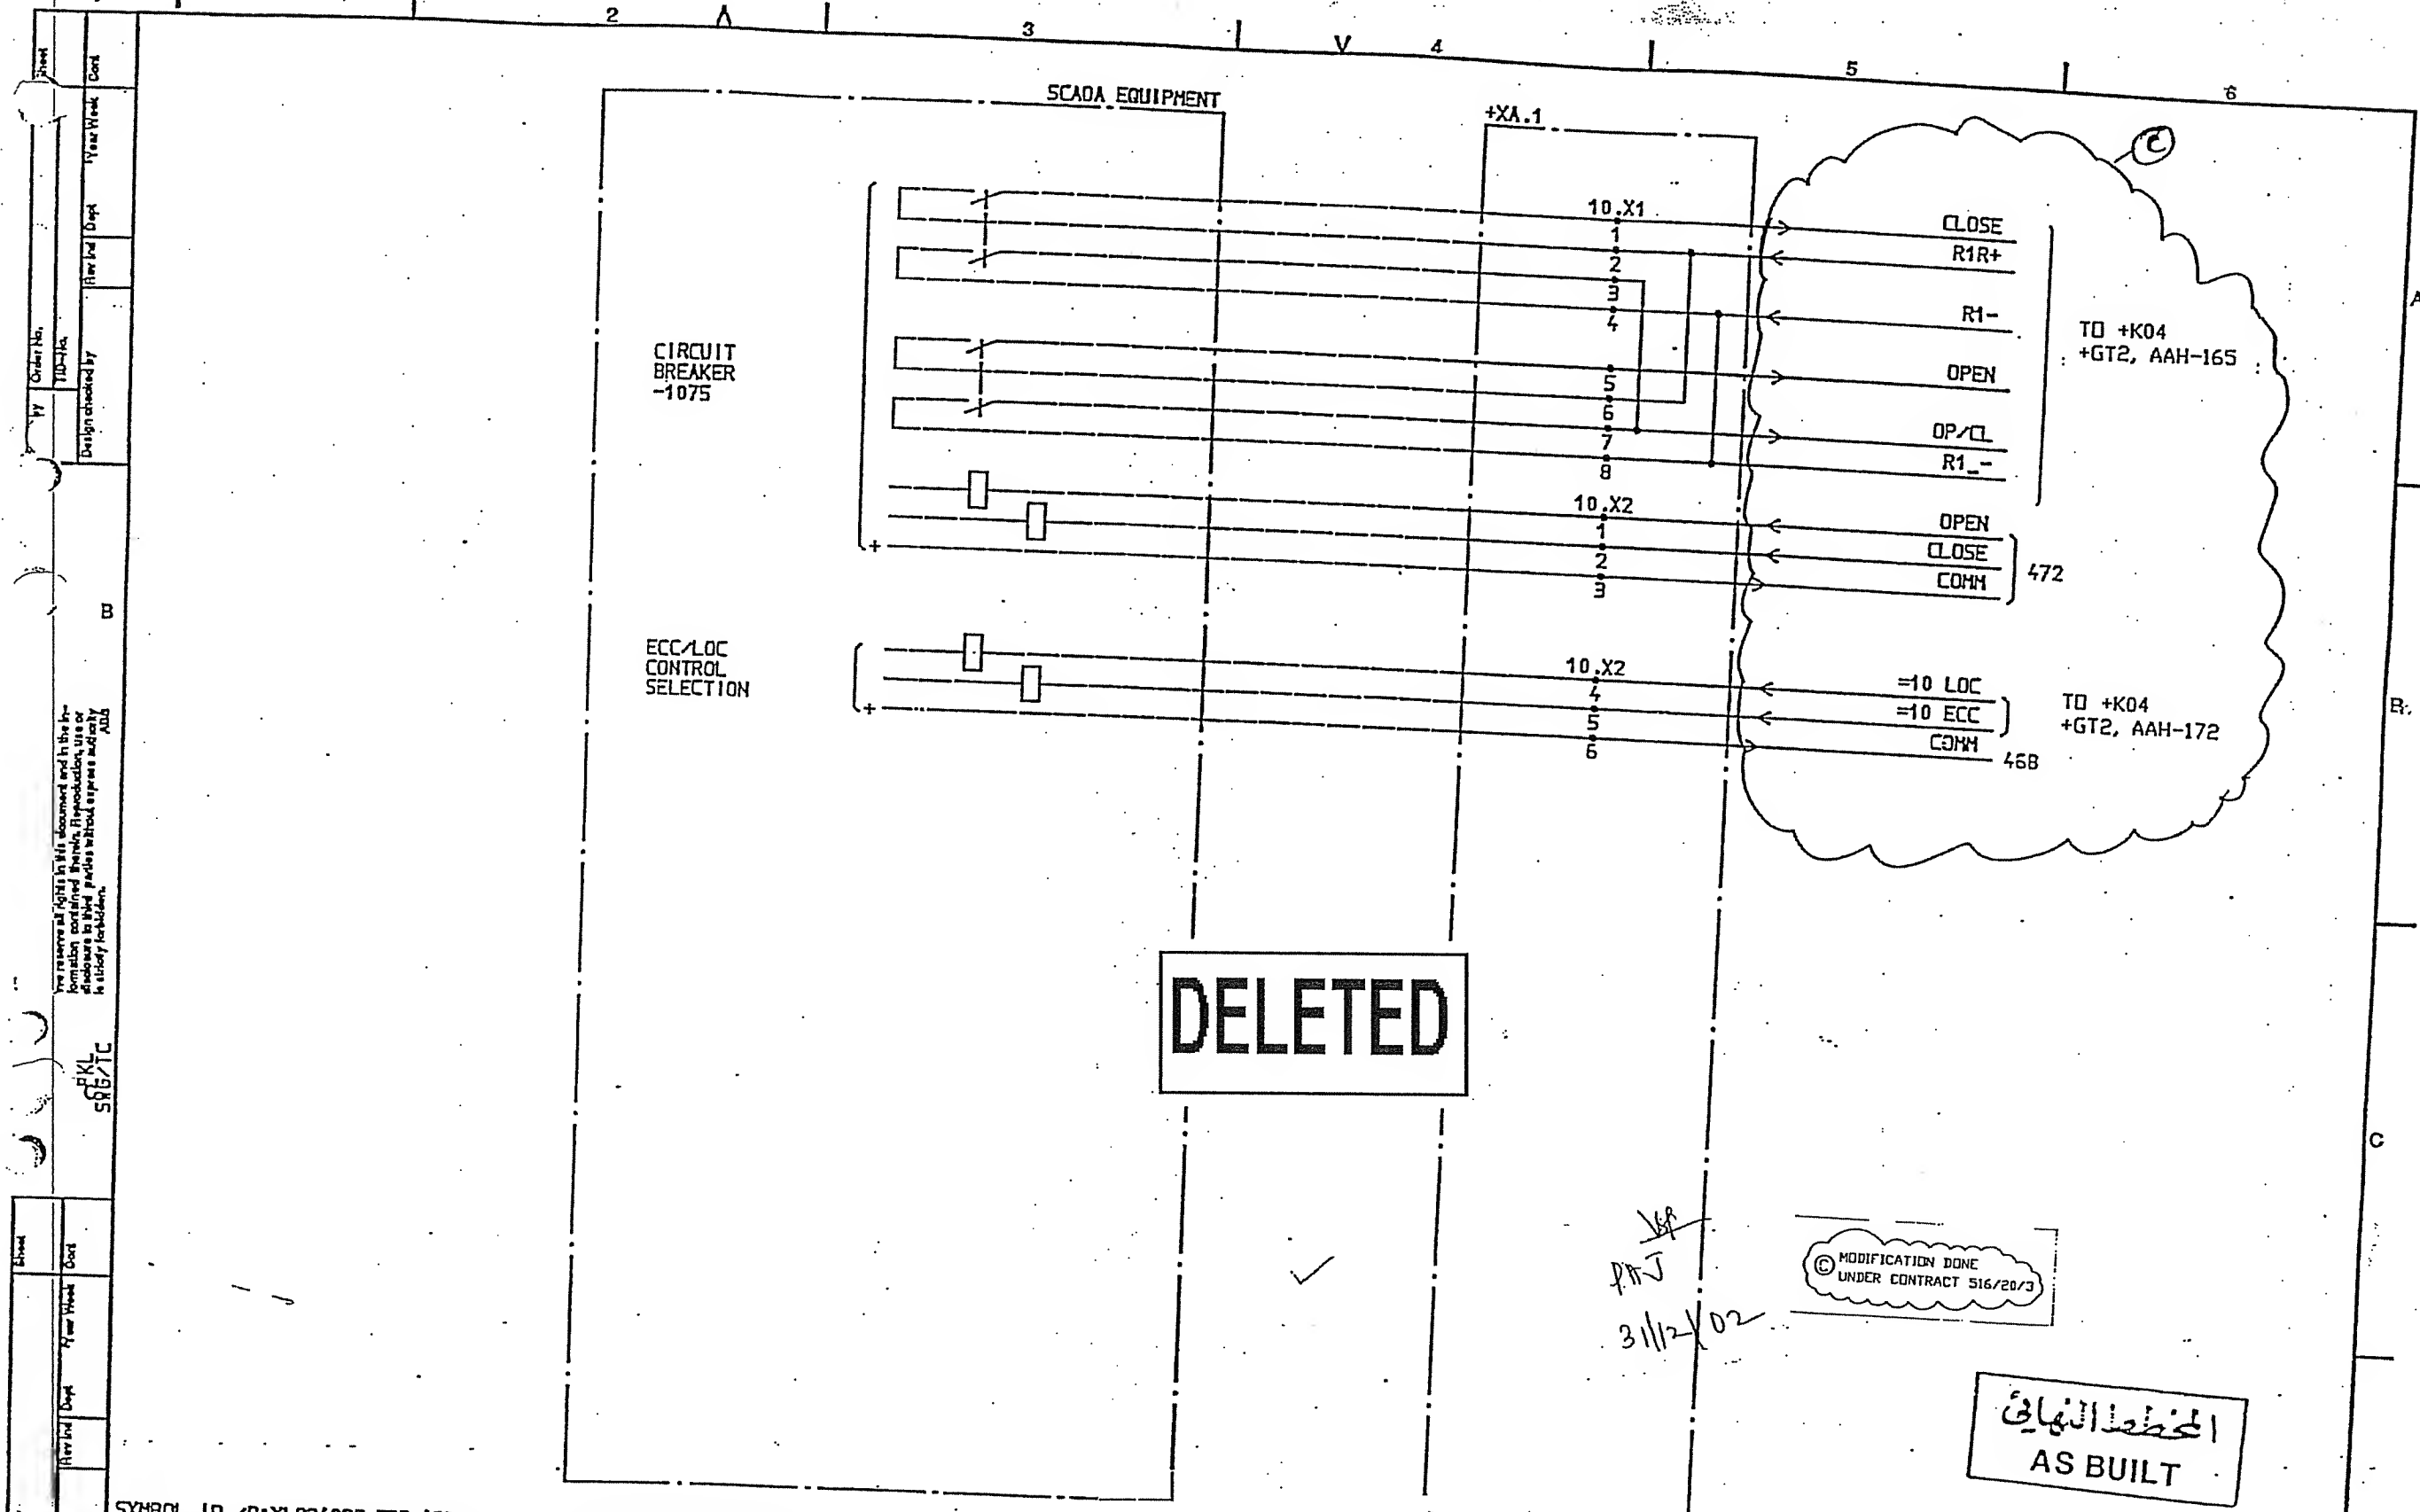
CIRCUIT DIAGRAM
S/S 8501 132/33kV
SCECO CENTRAL SAUDI ARABIA
ABB HV SWITCHGEAR

L 9743.1017
XL 824 028-FBR
1 451


ABB



[illegible]

AD
CPI



| | | | | | | | | | | | | | |
|---------------------------------|--|---------------------|--|---------------------------|--|----------------------------------|--|--------------------------------|--|--|--|-------------------------------|--|
| SYMBOL ID /D:XL824028-FBR:462/D | | DATE 91-06-04 09.10 | | =10 | | 33kV INCOMING TRANSFORMER BAY | | Design checked by B NILSSON | | CIRCUIT DIAGRAM S/S BS01 132/33kV SCECO CENTRAL SAUDI ARABIA | | L 9743.1017 XL 824 028-FBR | |
| AS BUILT | | 15 91 21 | | SCADA INTERFACE EQUIPMENT | | Design checked by S STRIDSHAN | | Drawn by IA | | Abb HV SWITCHGEAR | | 1- 465 | |
| 1 | | 2 | | 3 | | 4 | | 5 | | 6 | | 7 | |

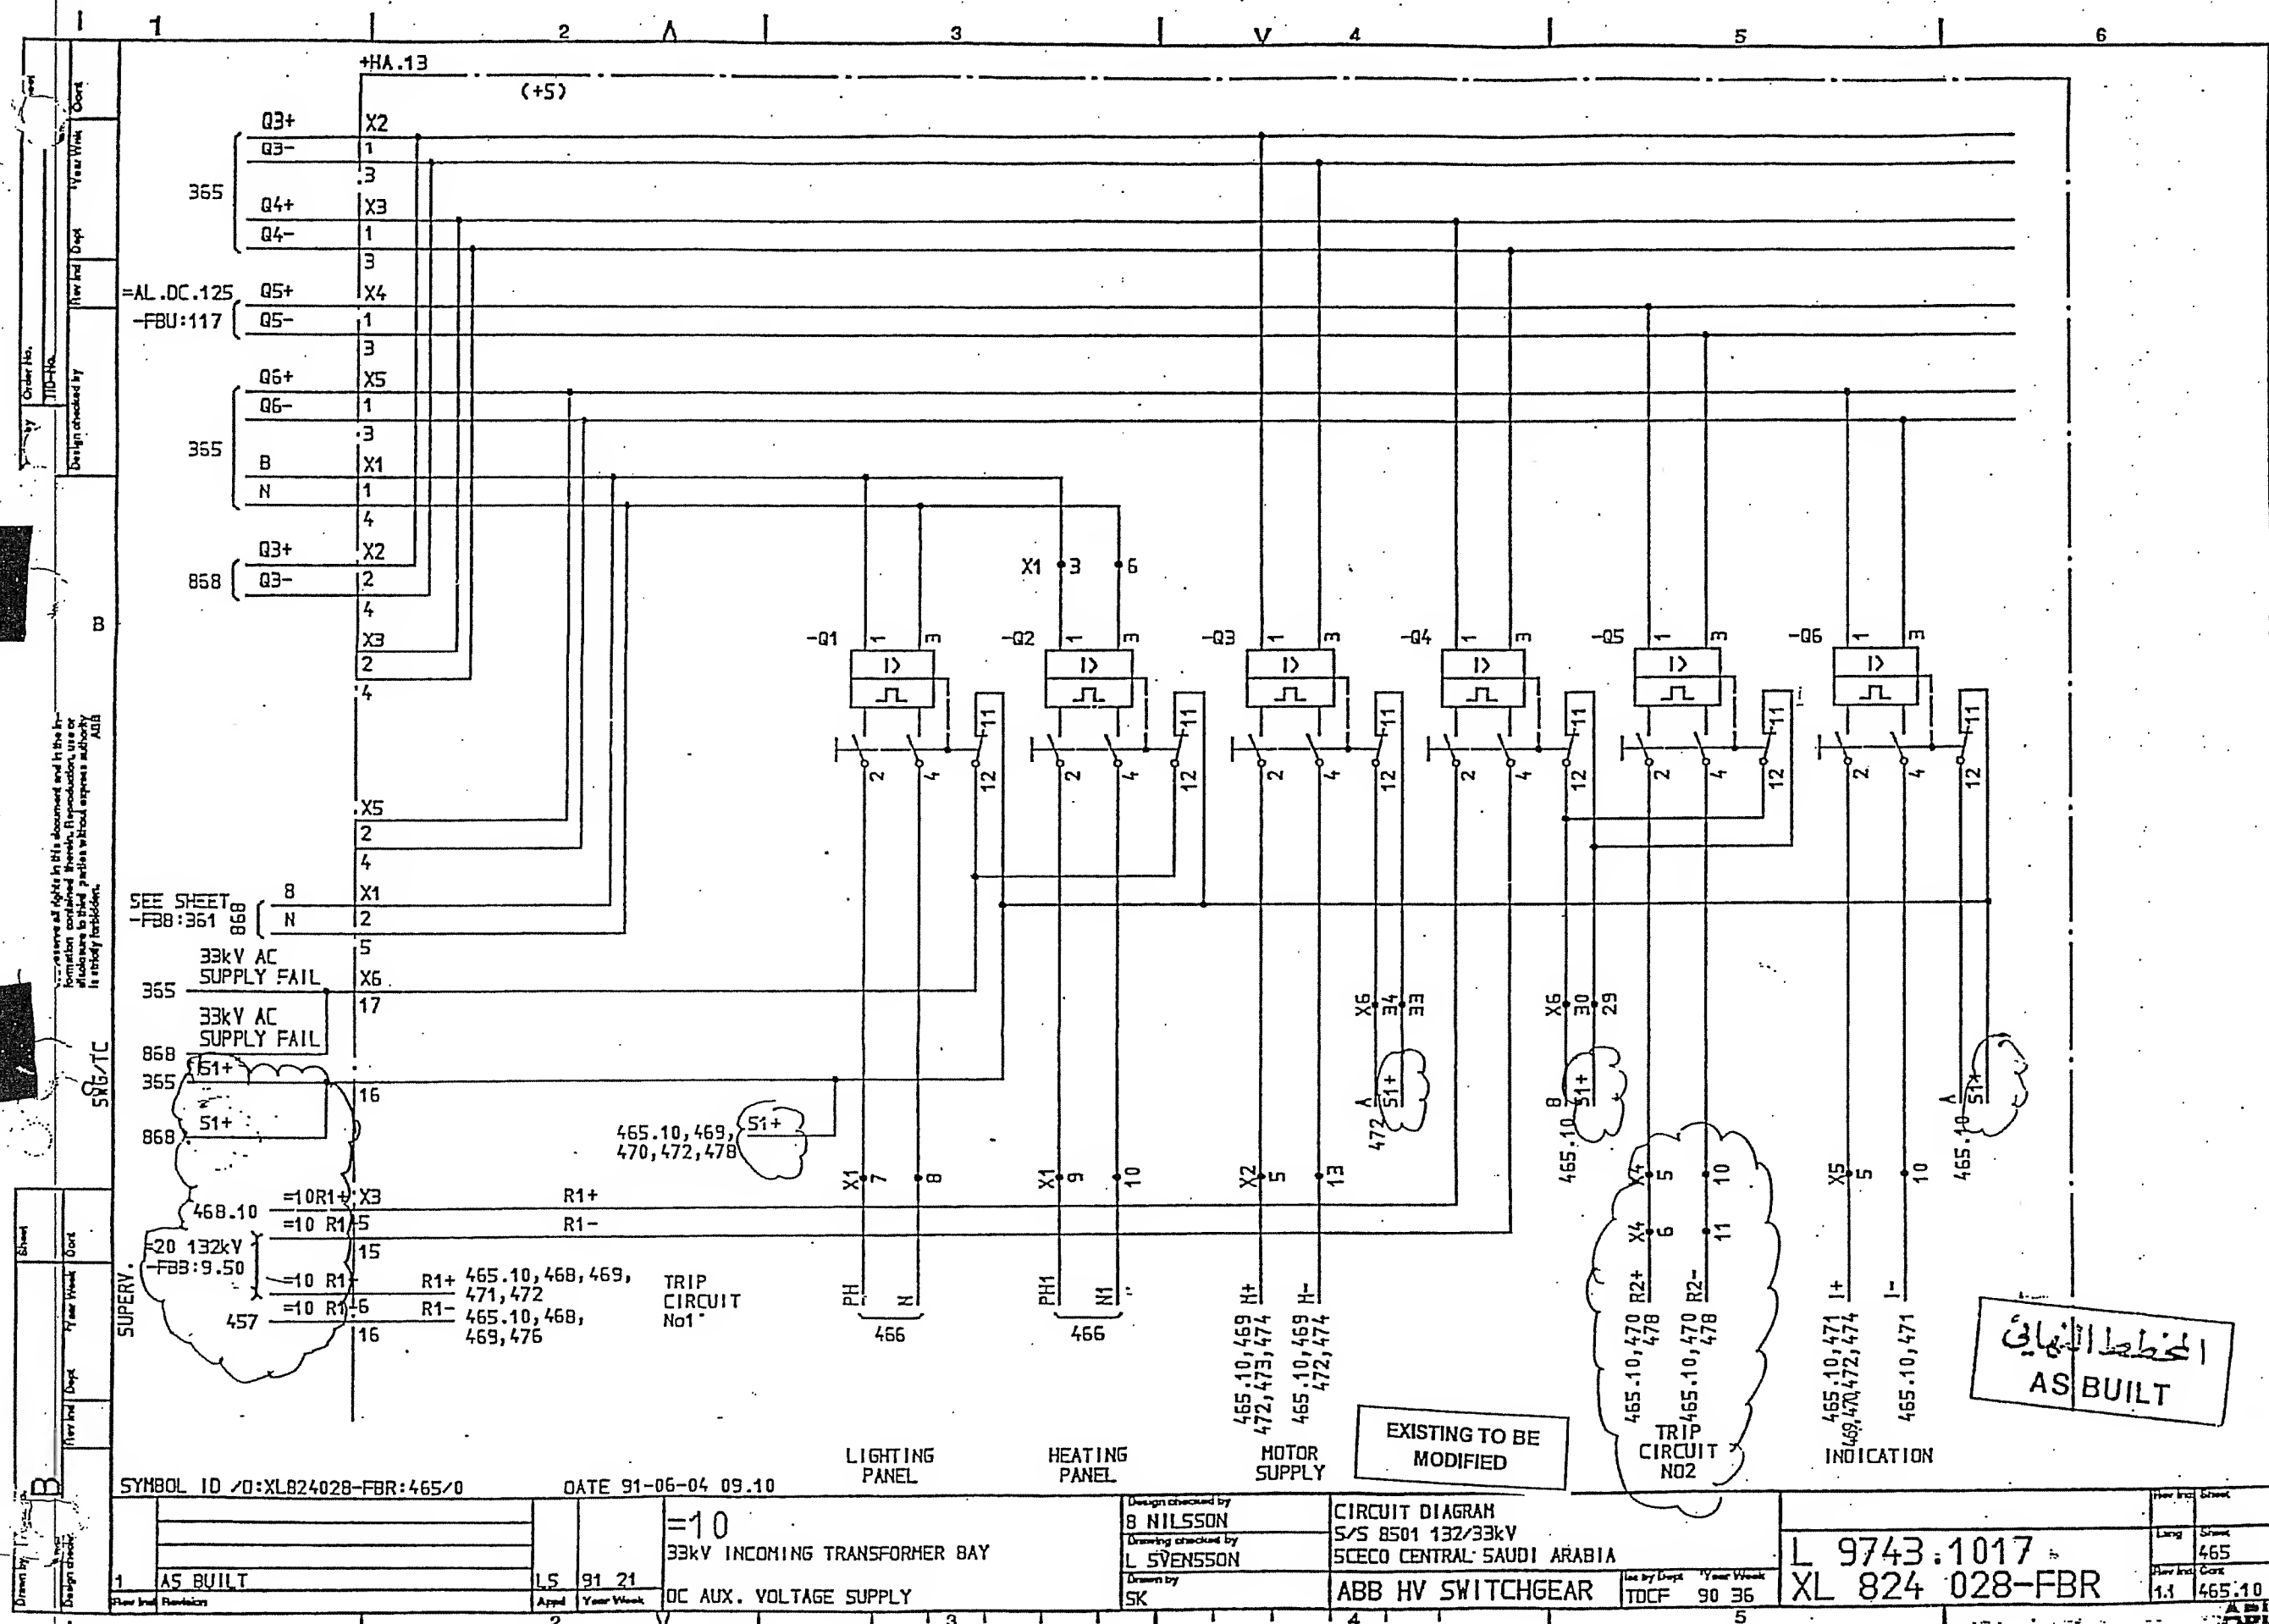

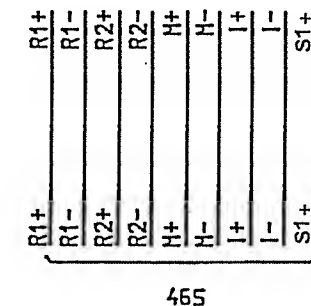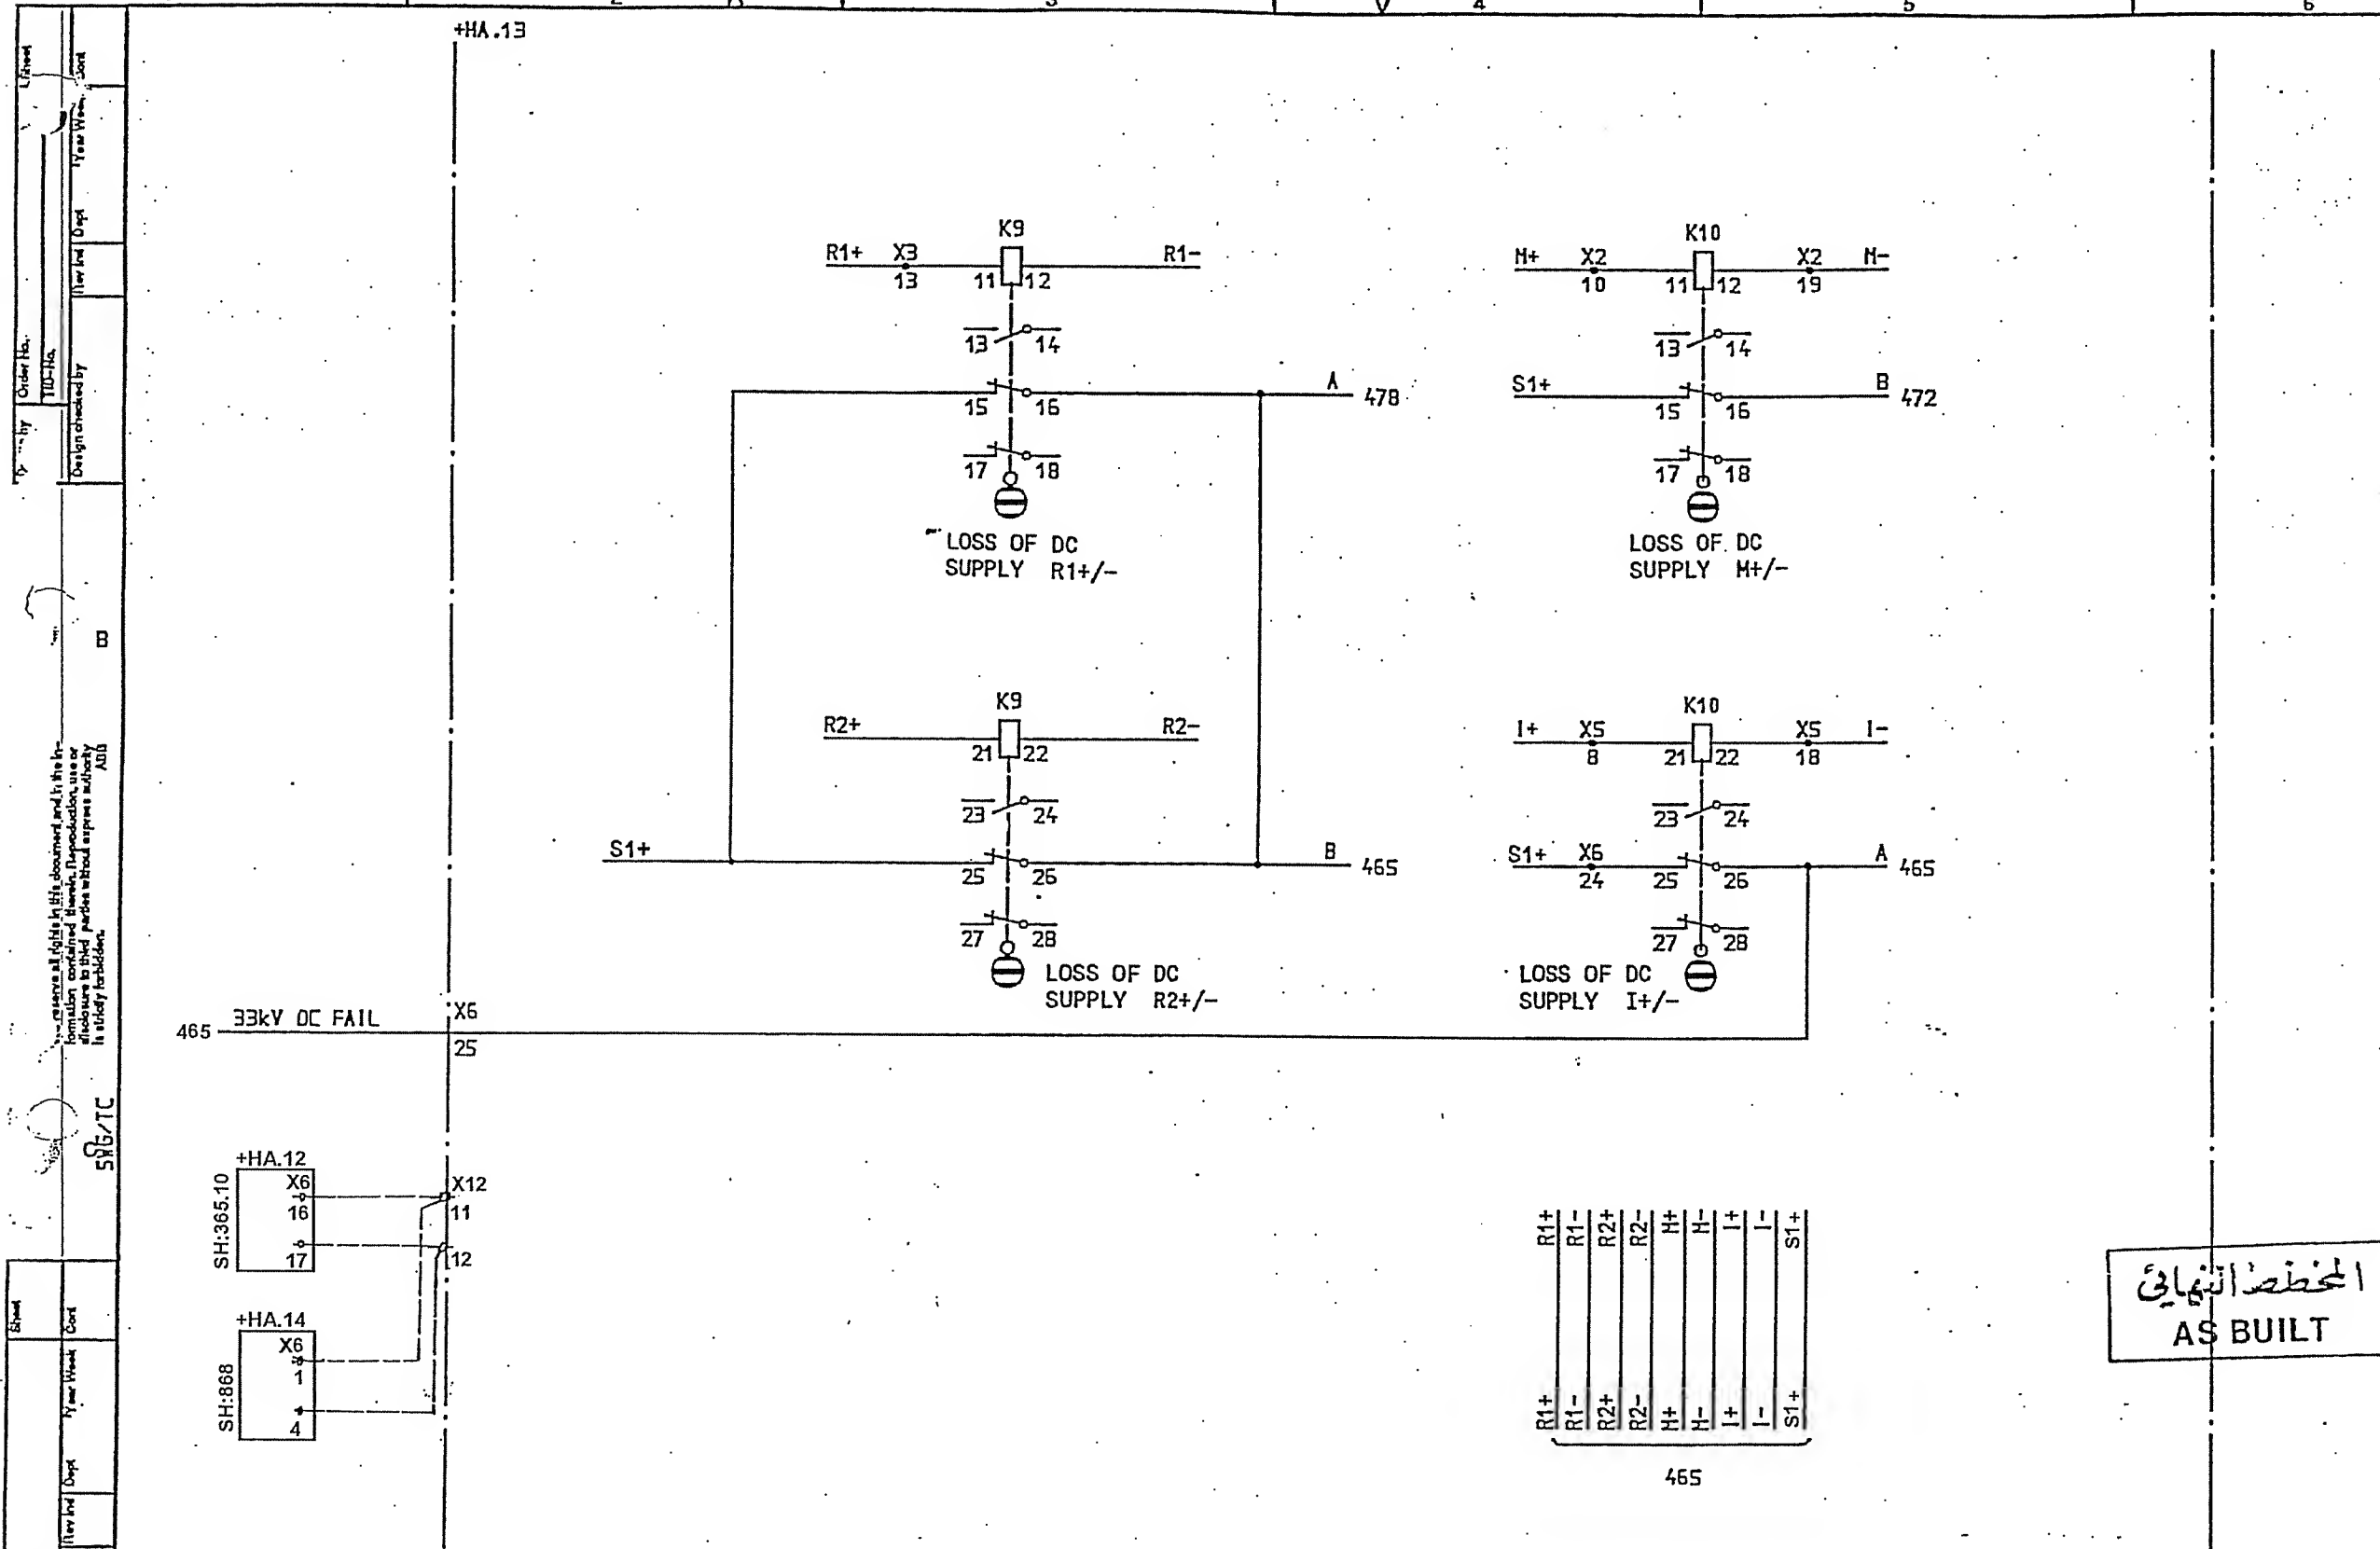

المخطط النهائي
AS BUILT

SYMBOL ID / 0:XL824028-FBR:465.10/0

DATE 91-06-04 09.10

=10

33kV INCOMING TRANSFORMER BAY

DC AUX. VOLTAGE SUPPLY

Design checked by
B NILSSON
Drawing checked by
L SVENSSON
Drawn by
SK


CIRCUIT DIAGRAM
5/5 8501 132/33kV
SCECD CENTRAL SAUDI ARABIA
ABB HV SWITCHGEAR


Iss by Dept Year Week
TDCF 90 36

L 9743.1017
XL 824 028-FBR

| Rev | Int | Sheet |
|-----|--------|-------|
| 1 | 465.10 | 465 |

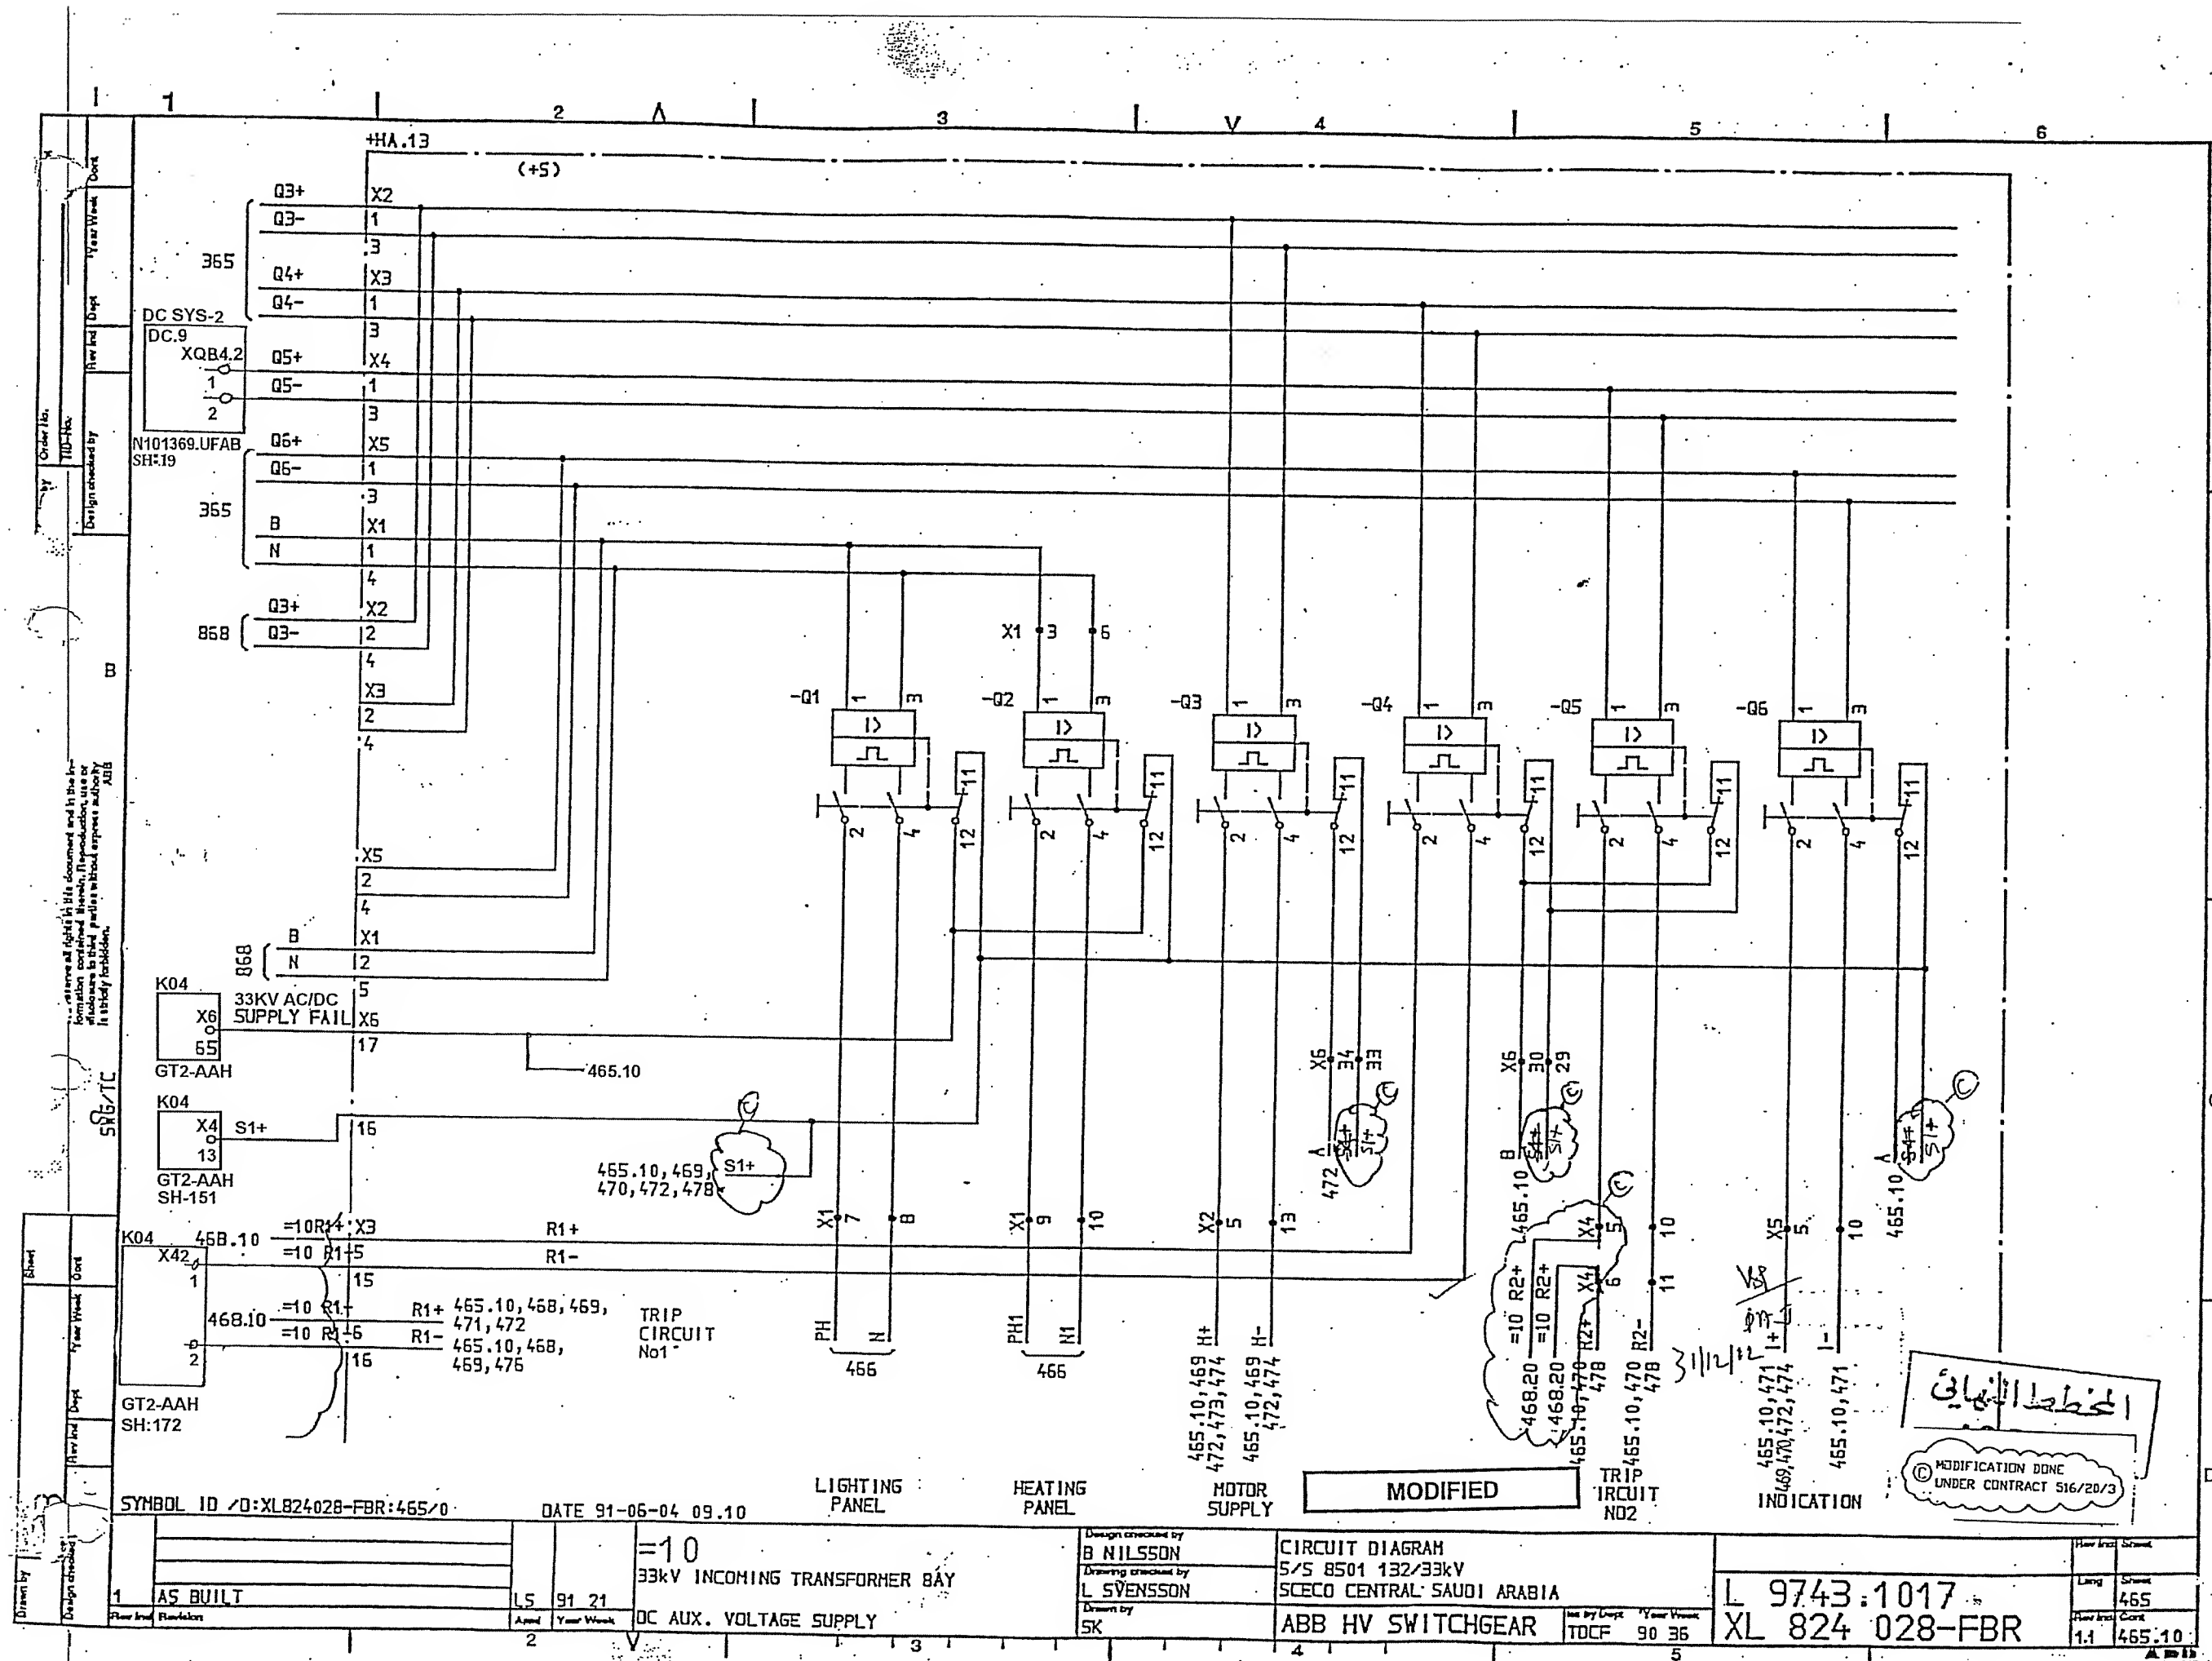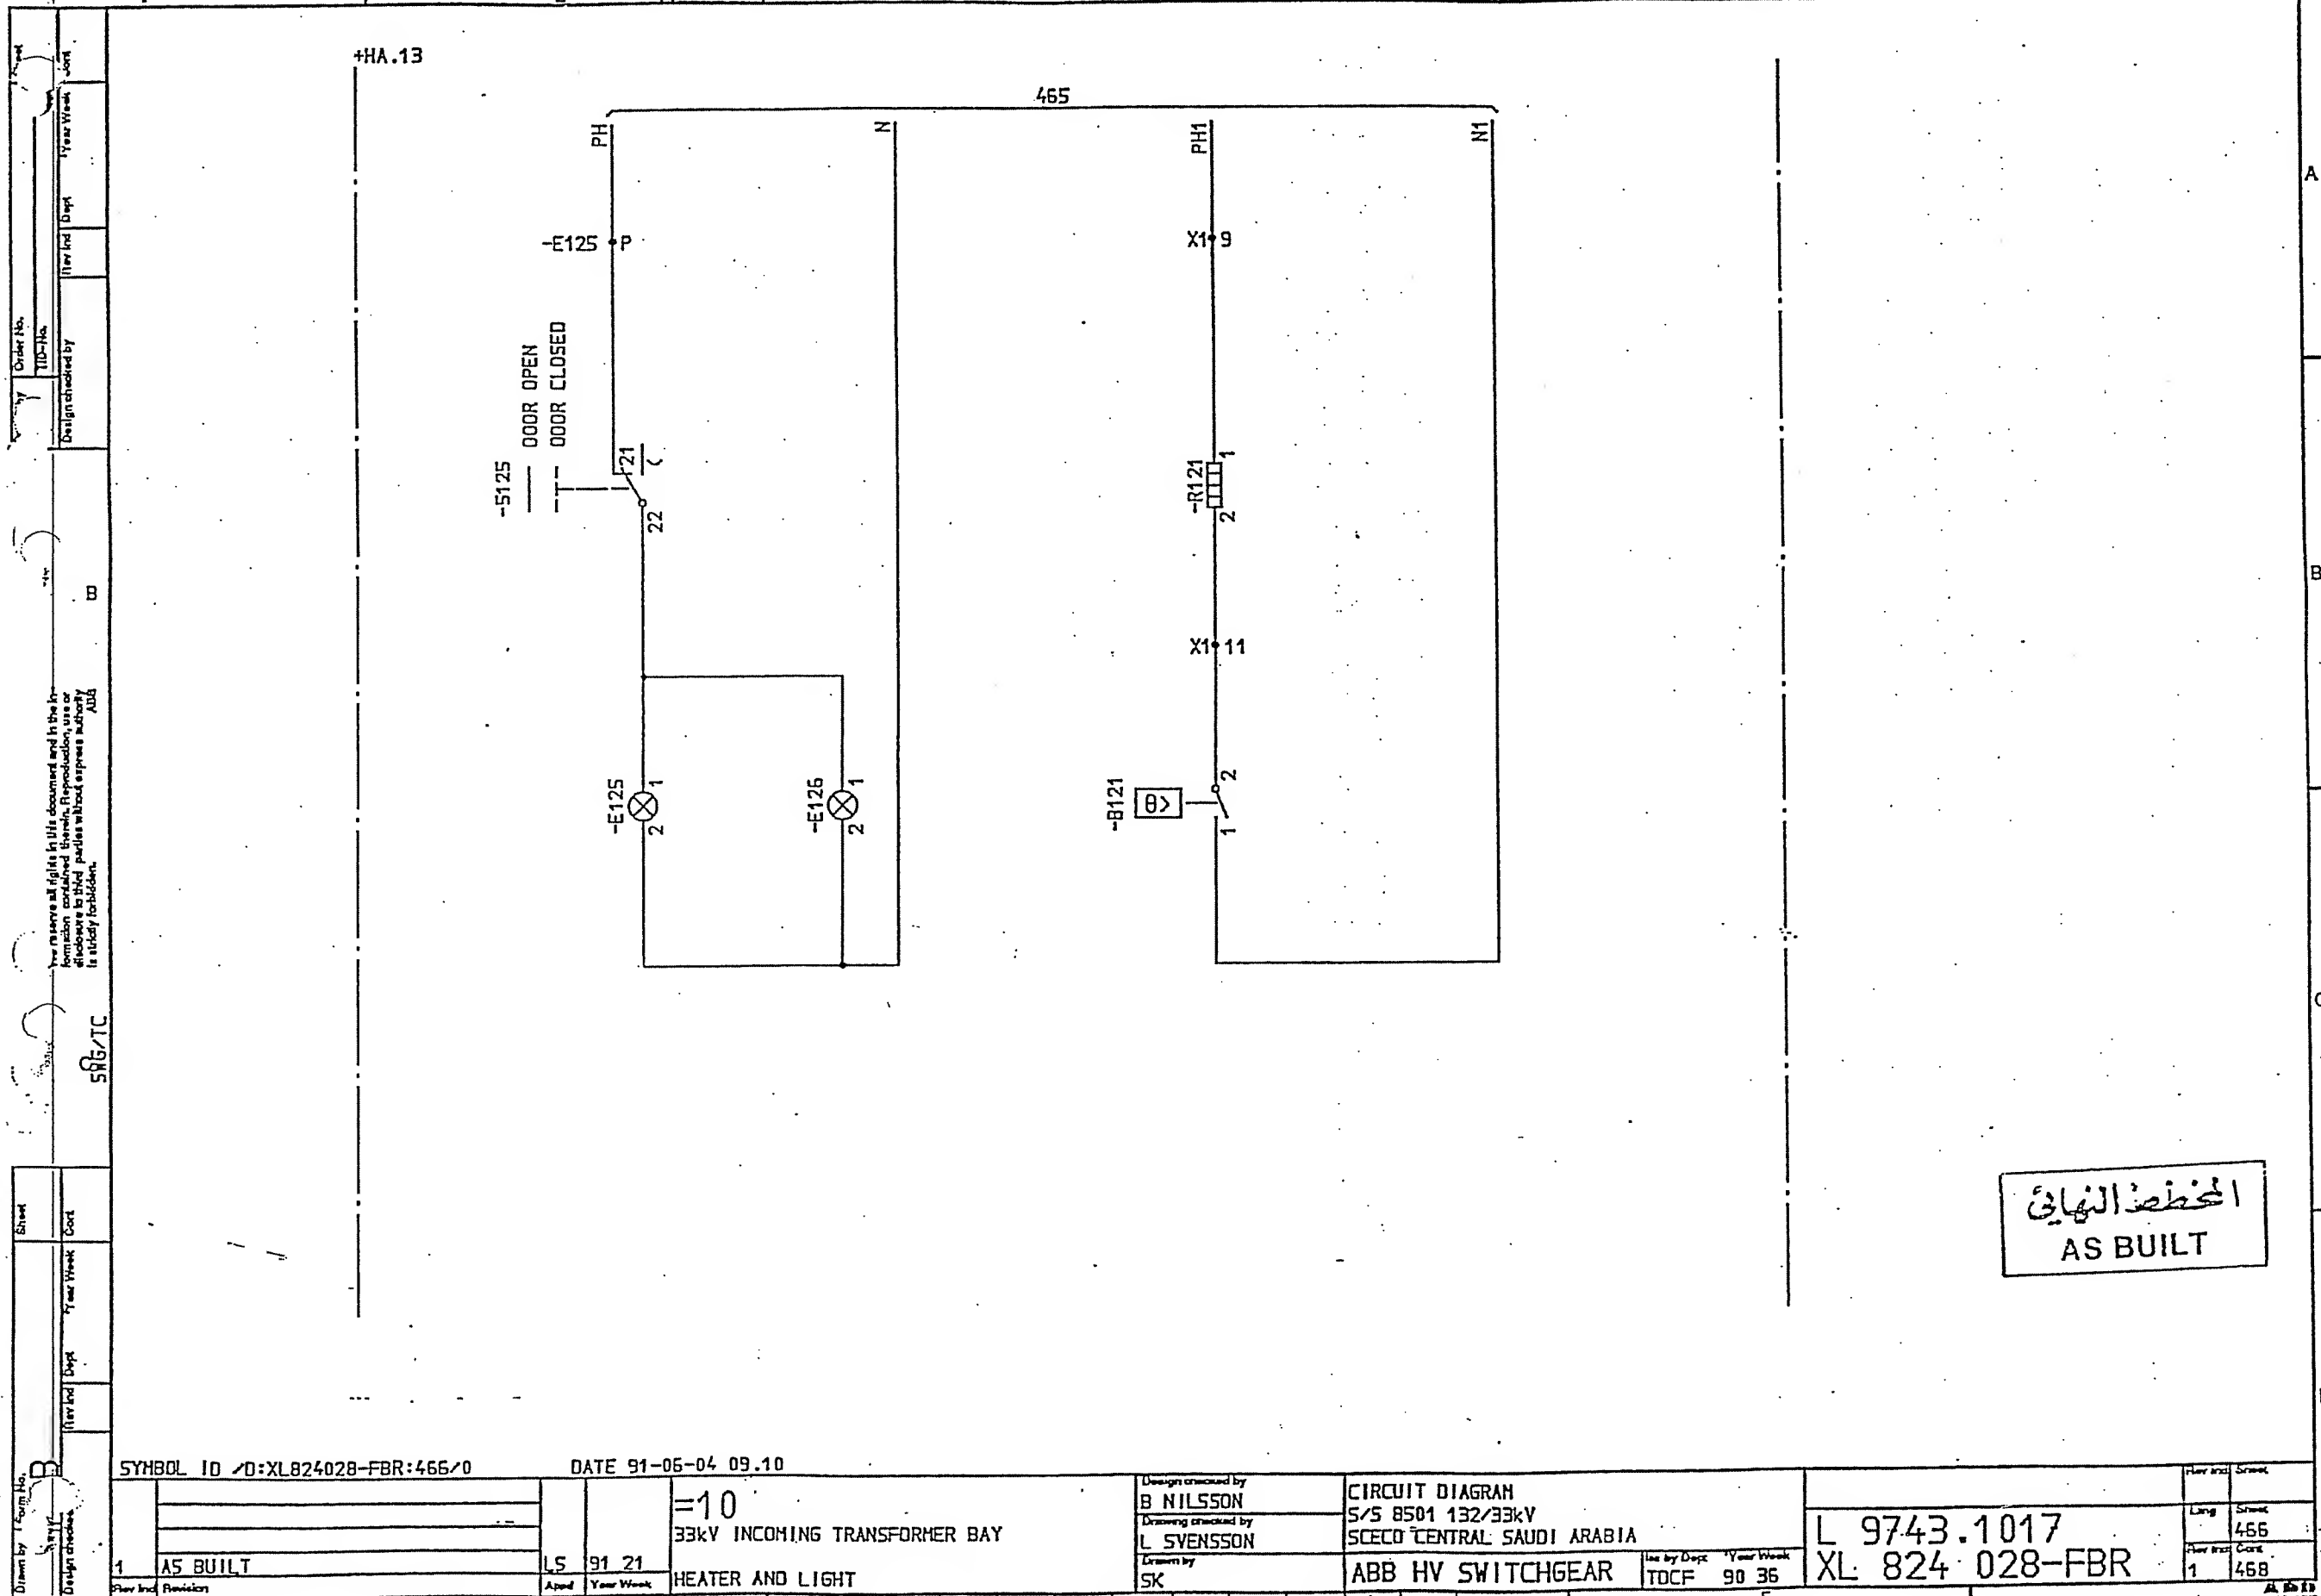AS BUILT





المخطط النهائي
AS BUILT

SYMBOL ID 0:XL824028-FBR:466/0

DATE 91-05-04 09.10

=10

33kV INCOMING TRANSFORMER BAY

HEATER AND LIGHT

Design checked by
B NILSSON
Drawing checked by
L SVENSSON
Drawn by
SK


CIRCUIT DIAGRAM
S/S 8501 132/33kV
SCECO CENTRAL SAUDI ARABIA
ABB HV SWITCHGEAR

Issued by Dept Year Week
TDCF 90 36


L 9743.1017
XL 824 028-FBR

| Rev | Issued | Sheet |
|-----|--------|-------|
| 1 | 466 | 468 |

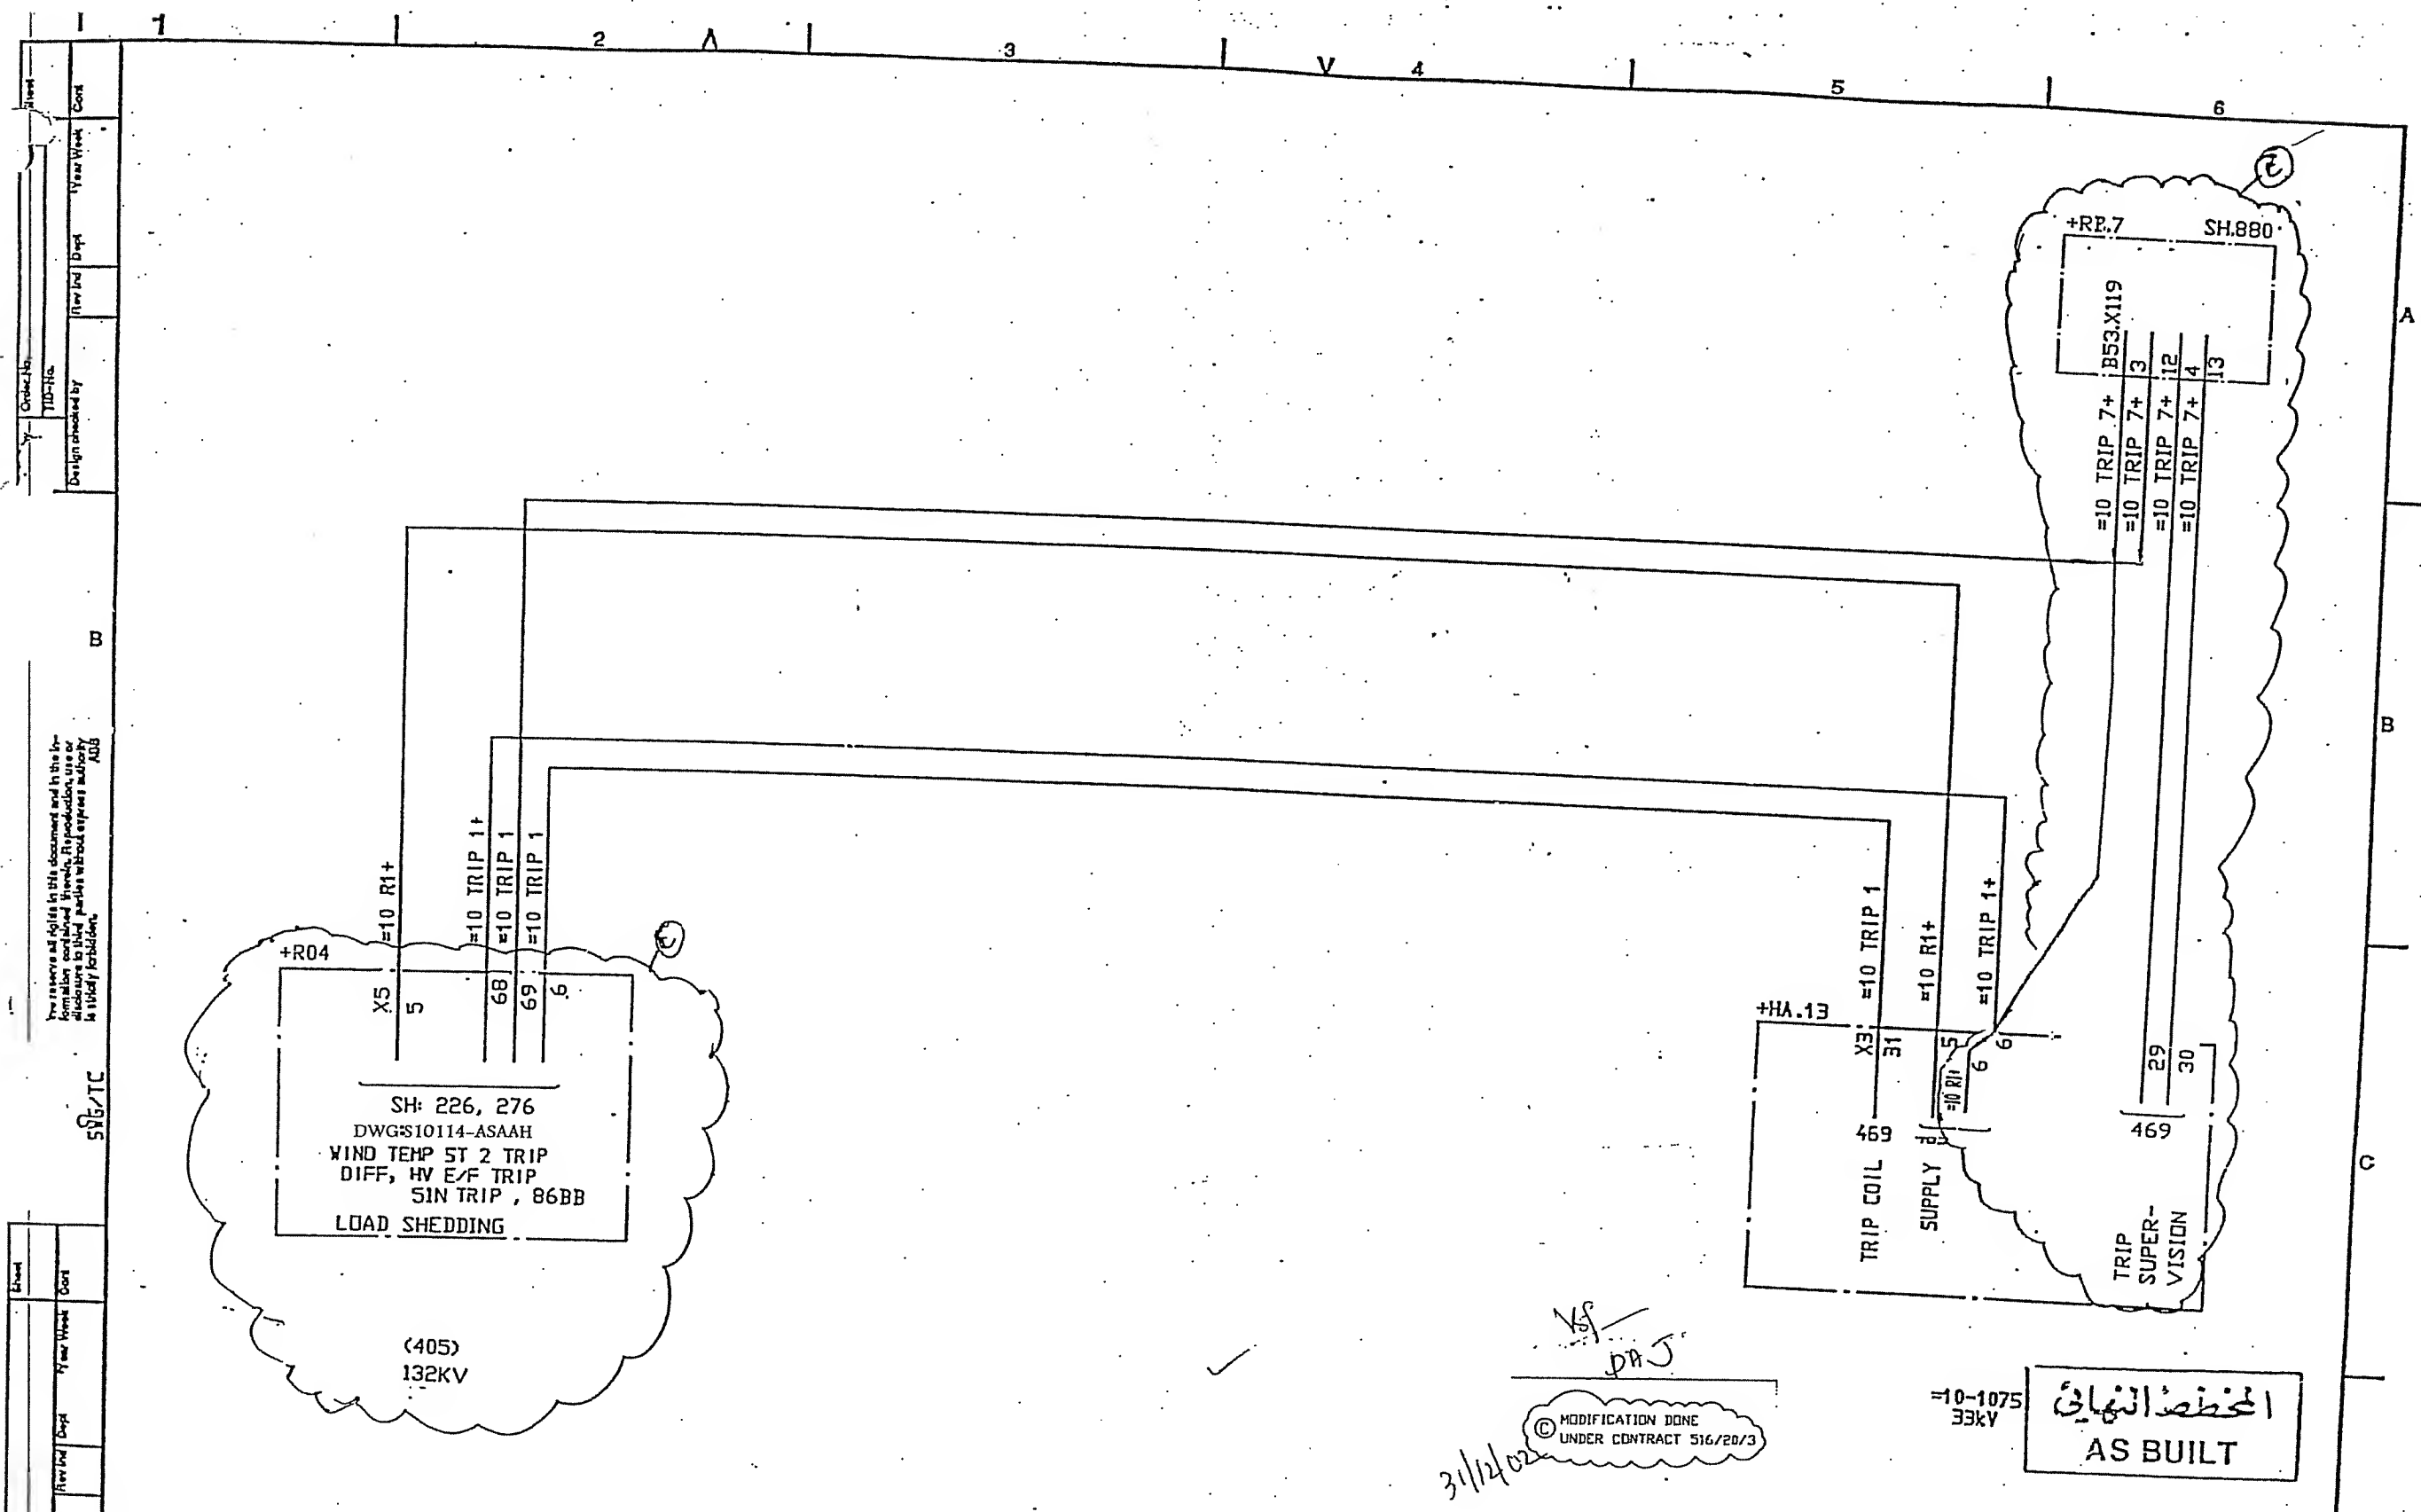AS BUILT



| | | | | | | | | | | | |
|------------------------------------|----------|---------------------|-------|-----|-------|--|-------|--|-------|----------------------------|-------|
| SYMBOL ID /D:XL824028-FBR:468.10/0 | | DATE 91-06-05 09.30 | | =10 | | 33kV INCOMING TRANSFORMER BAY PROTECTION TRIP CIRCUIT TRIP 1 | | CIRCUIT DIAGRAM S/S 8501 132/33kV SLECO CENTRAL SAUDI ARABIA | | L 9743.1017 XL 824 028-FBR | |
| 1 | AS BUILT | 15 | 91 21 | 1 | 91 21 | 1 | 91 21 | 1 | 91 21 | 1 | 91 21 |
| 2 | | 2 | | 2 | | 2 | | 2 | | 2 | |
| 3 | | 3 | | 3 | | 3 | | 3 | | 3 | |
| 4 | | 4 | | 4 | | 4 | | 4 | | 4 | |
| 100 | | 100 | | 100 | | 100 | | 100 | | 100 | |

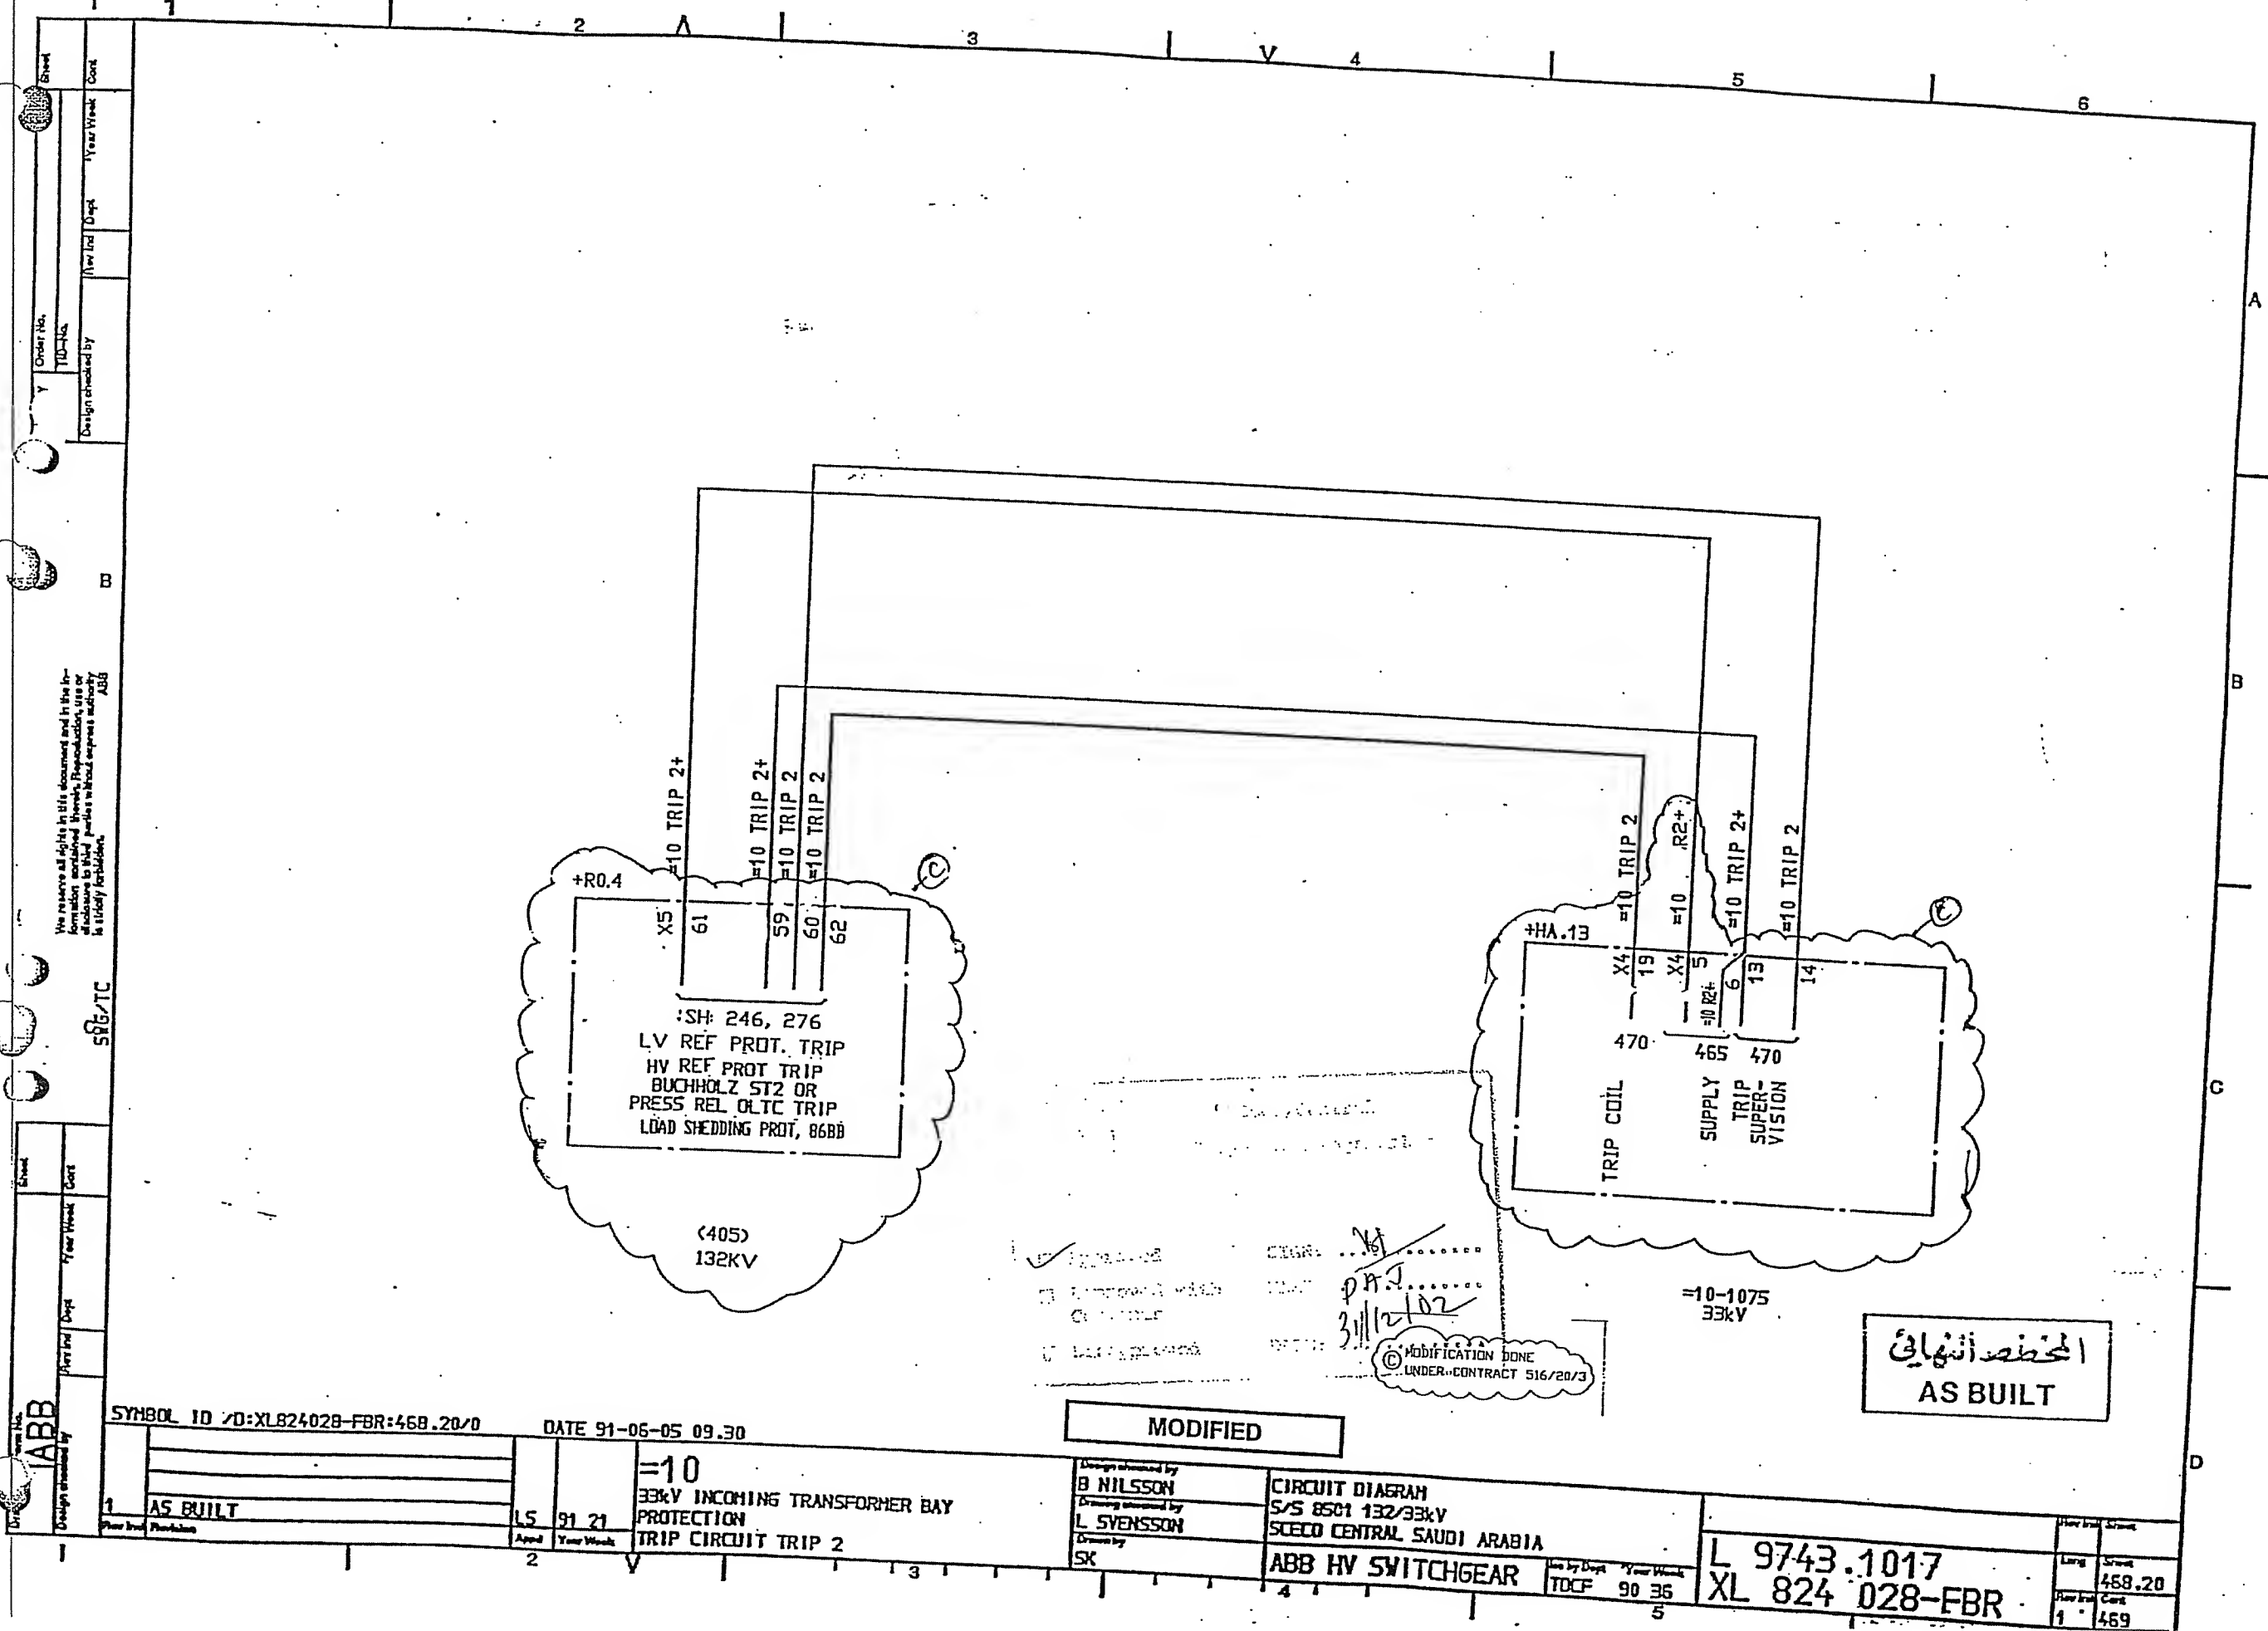

We reserve all rights in this document and in the information contained therein. Reproduction, use or disclosure in any form without express authority is strictly prohibited.

506/TC

SYMBOL ID: XL824028-FBR:468.20/0

DATE 91-06-05 09.30

MODIFIED

المخطط النهائي
AS BUILT

| | | | | | |
|---|----------|------|-----------|-----|--|
| 1 | AS BUILT | LS | 91 21 | =10 | 33kV INCOMING TRANSFORMER BAY PROTECTION TRIP CIRCUIT TRIP 2 |
| 2 | | Appd | Year Week | | |


| | |
|--------------------|------------|
| Design checked by | B NILSSON |
| Drawing checked by | L SVENSSON |
| Drawn by | SK |

CIRCUIT DIAGRAM
S/S 8501 132/33kV
SCECO CENTRAL SAUDI ARABIA
ABB HV SWITCHGEAR

| | |
|----------------|-----------|
| Issued by Dept | Year Week |
| TDCE | 90 36 |

L 9743.1017
XL 824 028-FBR

| | |
|---------|--------|
| How Inv | Sheet |
| Long | 468.20 |
| How Inv | Cont |
| 1 | 469 |

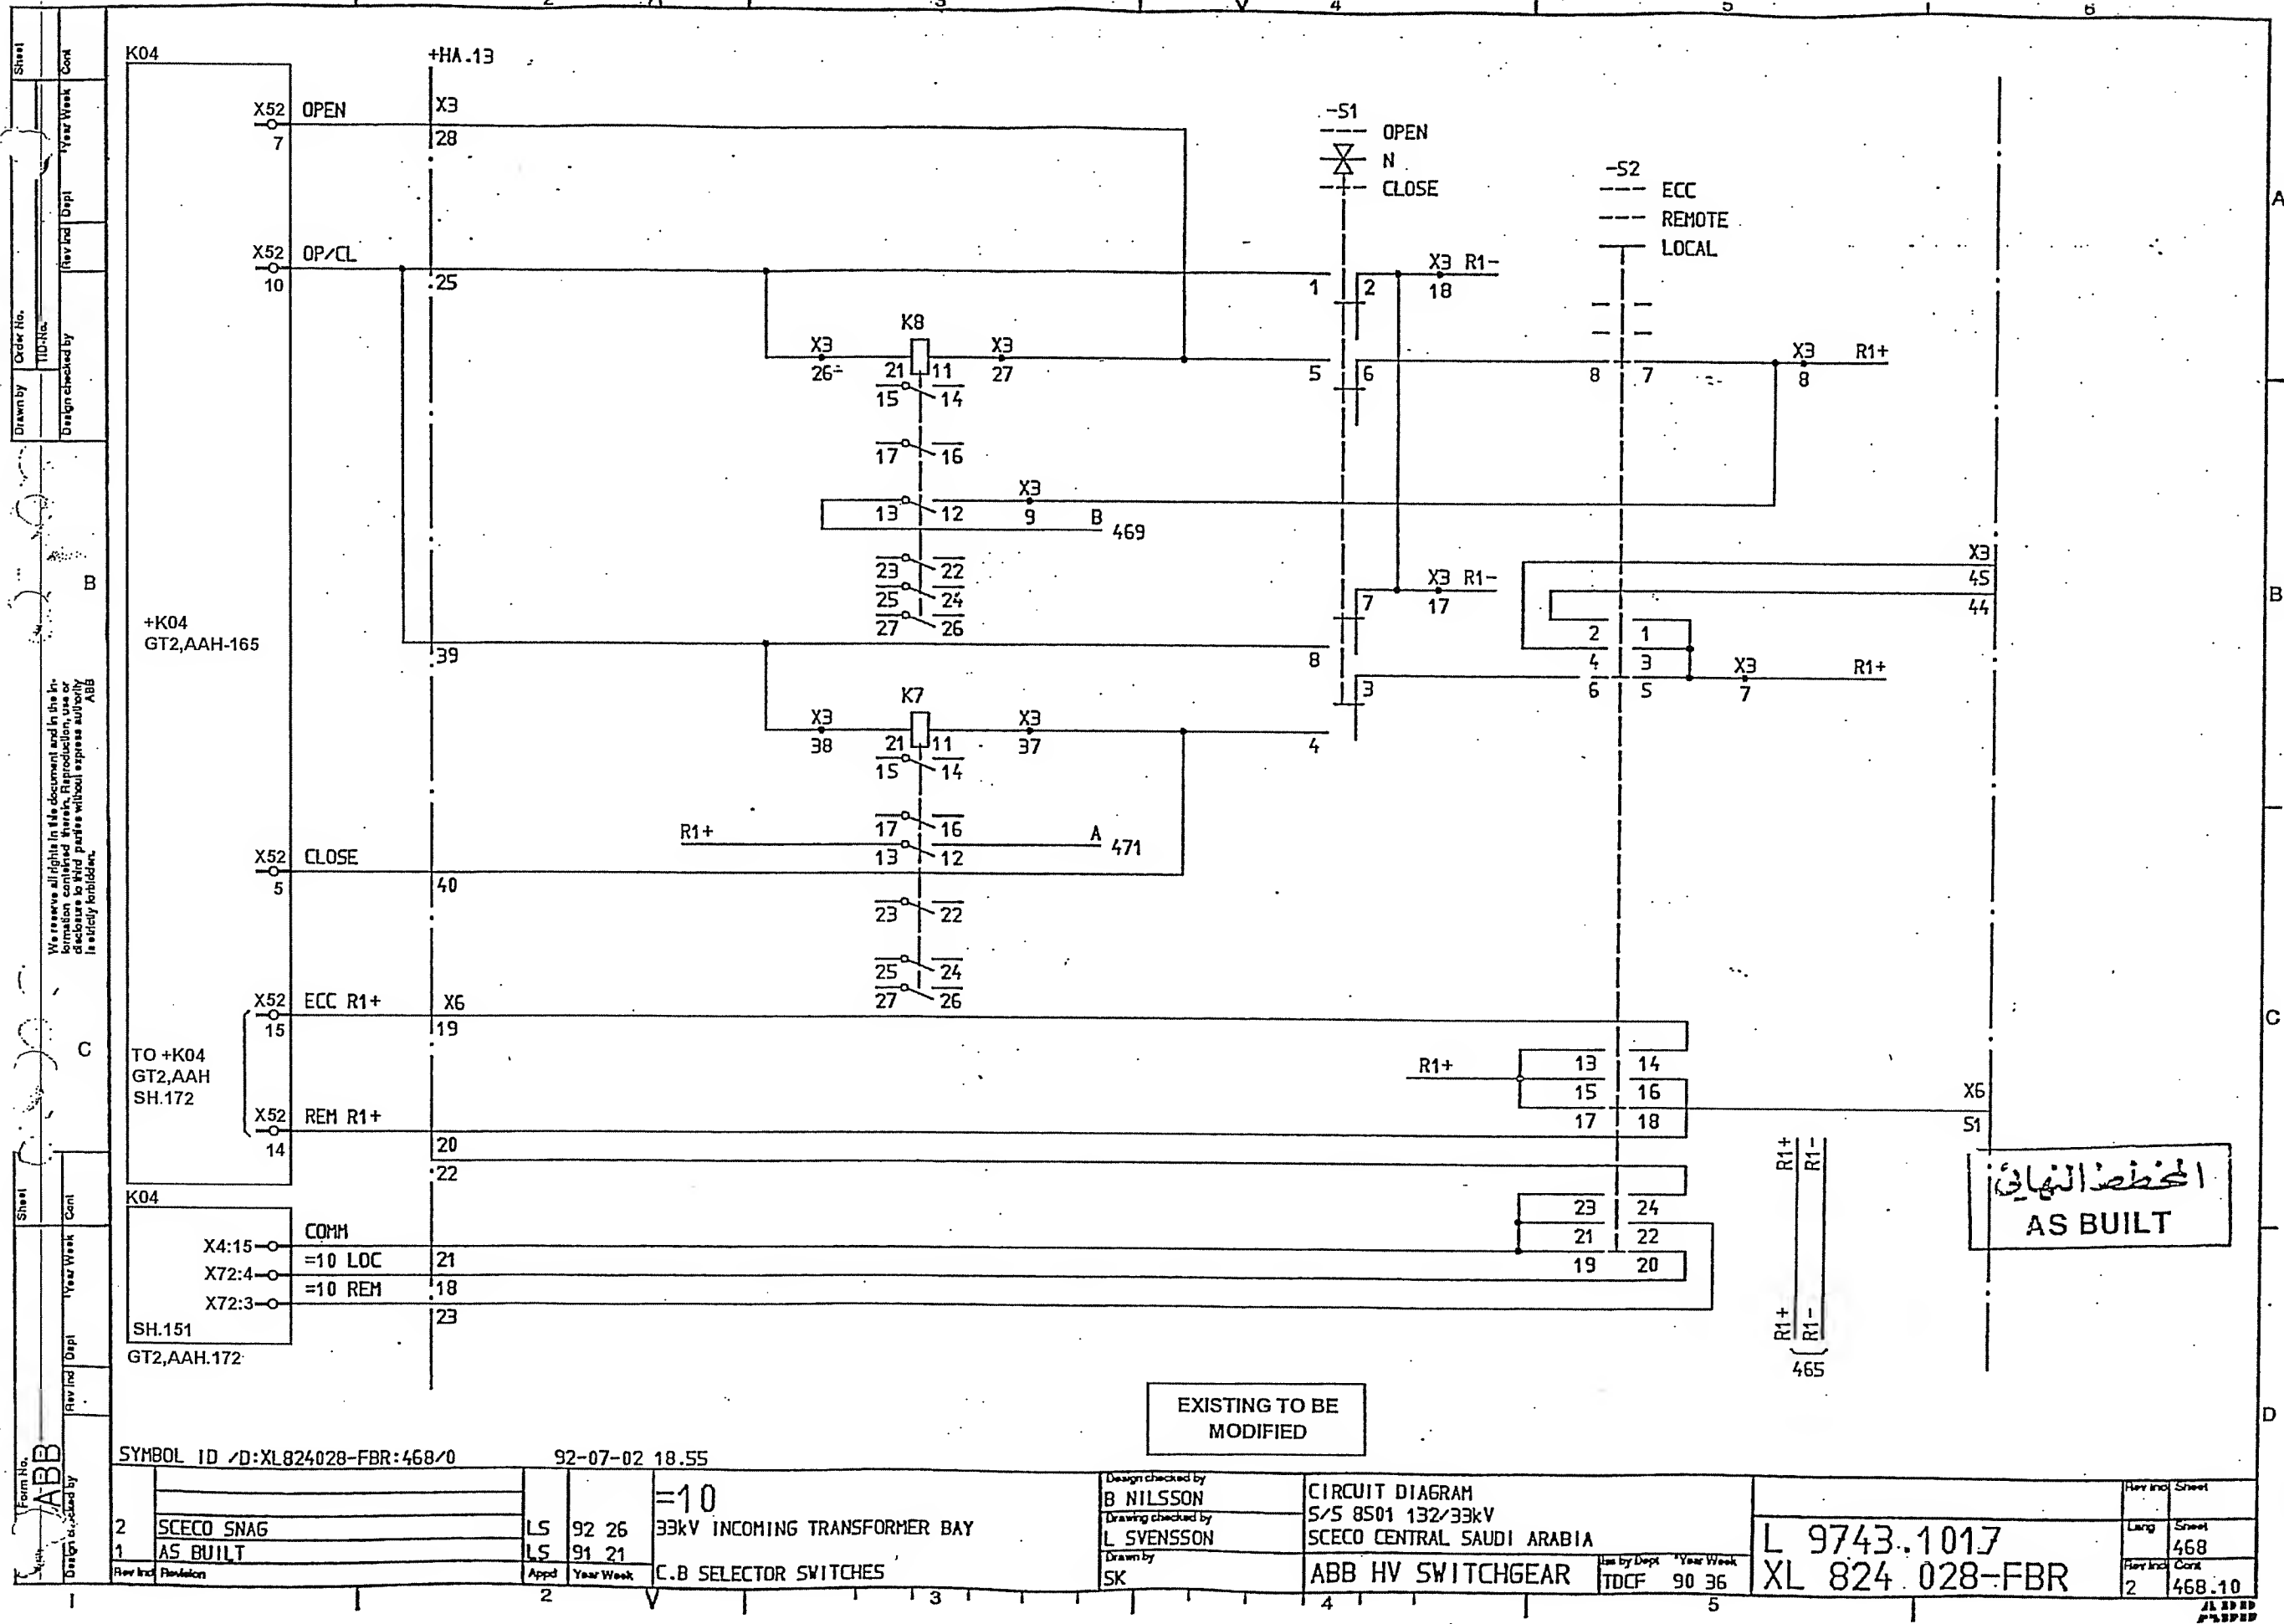

EXISTING TO BE
MODIFIED

SYMBOL ID /D:XL824028-FBR:468/0 92-07-02 18.55


| | | | | |
|---|------------|------|-----------|-------------------------------|
| 2 | SCECO SNAG | LS | 92 26 | =10 |
| 1 | AS BUILT | LS | 91 21 | 33kV INCOMING TRANSFORMER BAY |
| | | Appd | Year Week | C.B SELECTOR SWITCHES |

Design checked by
B NILSSON
Drawing checked by
L SVENSSON
Drawn by
SK

CIRCUIT DIAGRAM
S/S 8501 132/33kV
SCECO CENTRAL SAUDI ARABIA
ABB HV SWITCHGEAR
TDCF 90 36

| | | |
|----------------|----------|--------|
| L 9743.1017 | Rev Incd | Sheet |
| XL 824.028-FBR | Lang | 468 |
| | Rev Incd | 468.10 |

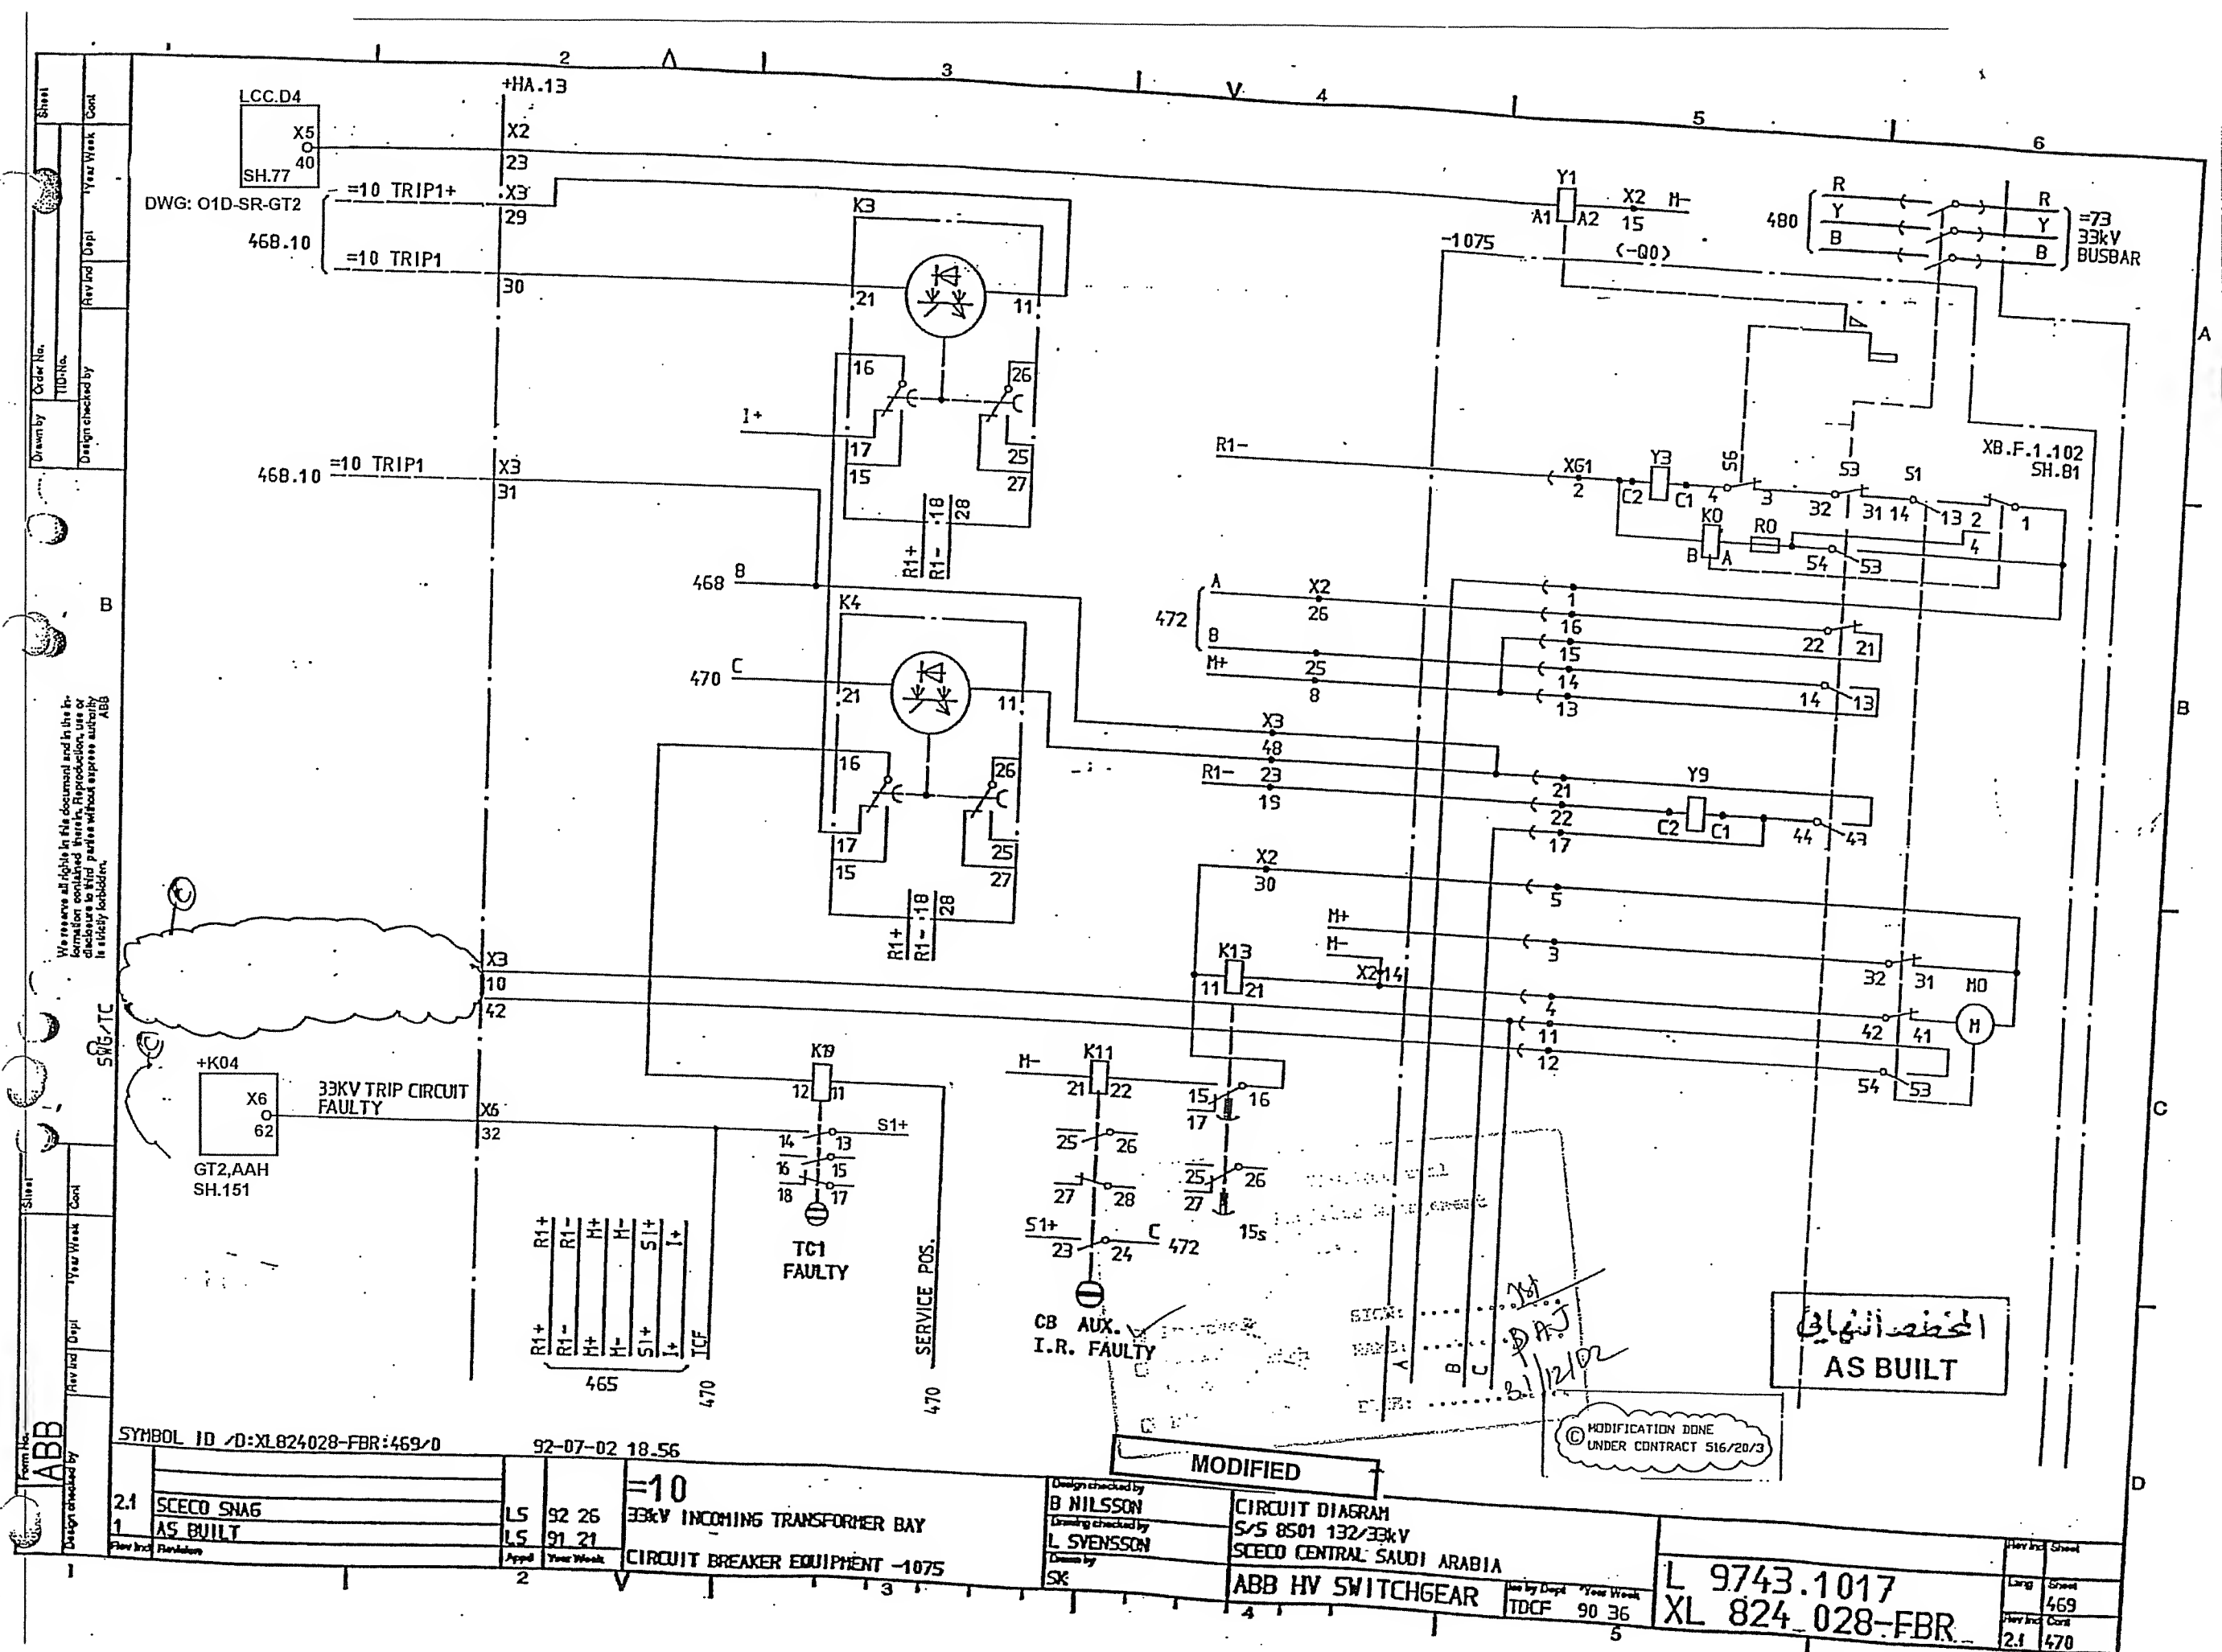ABB



DWG: 01D-SR-GT2
468.10

LCC.D4
X5
SH.77
40

=10 TRIP1+
=10 TRIP1

468.10 =10 TRIP1

+K04
X6
GT2,AAH
SH.151
33KV TRIP CIRCUIT
FAULTY

R1+ R1- H+ H- S1+ I+
R1+ R1- H+ H- S1+ I+
465 470

K9
12 11
14 13
16 15
18 17
S1+
TC1
FAULTY
SERVICE POS.
470

K11
21 22
25 26
27 28
S1+ 23 24
472
15s
CB AUX.
I.R. FAULTY

MODIFIED

المخطط النهائي
AS BUILT

© MODIFICATION DONE
UNDER CONTRACT 516/20/3

SYMBOL ID /D:XL824028-FBR:469/0

92-07-02 18.56

| | | | | |
|---------|------------|------|-----------|---------------------------------|
| 2.1 | SCECO SNA6 | LS | 92 26 | =10 |
| 1 | AS BUILT | LS | 91 21 | 33KV INCOMING TRANSFORMER BAY |
| Rev Inc | Revisions | Appd | Year Week | CIRCUIT BREAKER EQUIPMENT -1075 |
| | | 2 | | |


Design checked by
B NILSSON
Drawing checked by
L SVENSSON
Drawn by
SK



CIRCUIT DIAGRAM
S/S 8501 132/33KV
SCECO CENTRAL SAUDI ARABIA
ABB HV SWITCHGEAR

Rev by Dept Year Week
TDCF 90 36

L 9743.1017
XL 824_028-FBR

| | |
|---------|-------|
| Rev Inc | Sheet |
| 2.1 | 469 |
| Rev Inc | Cont |
| | 470 |

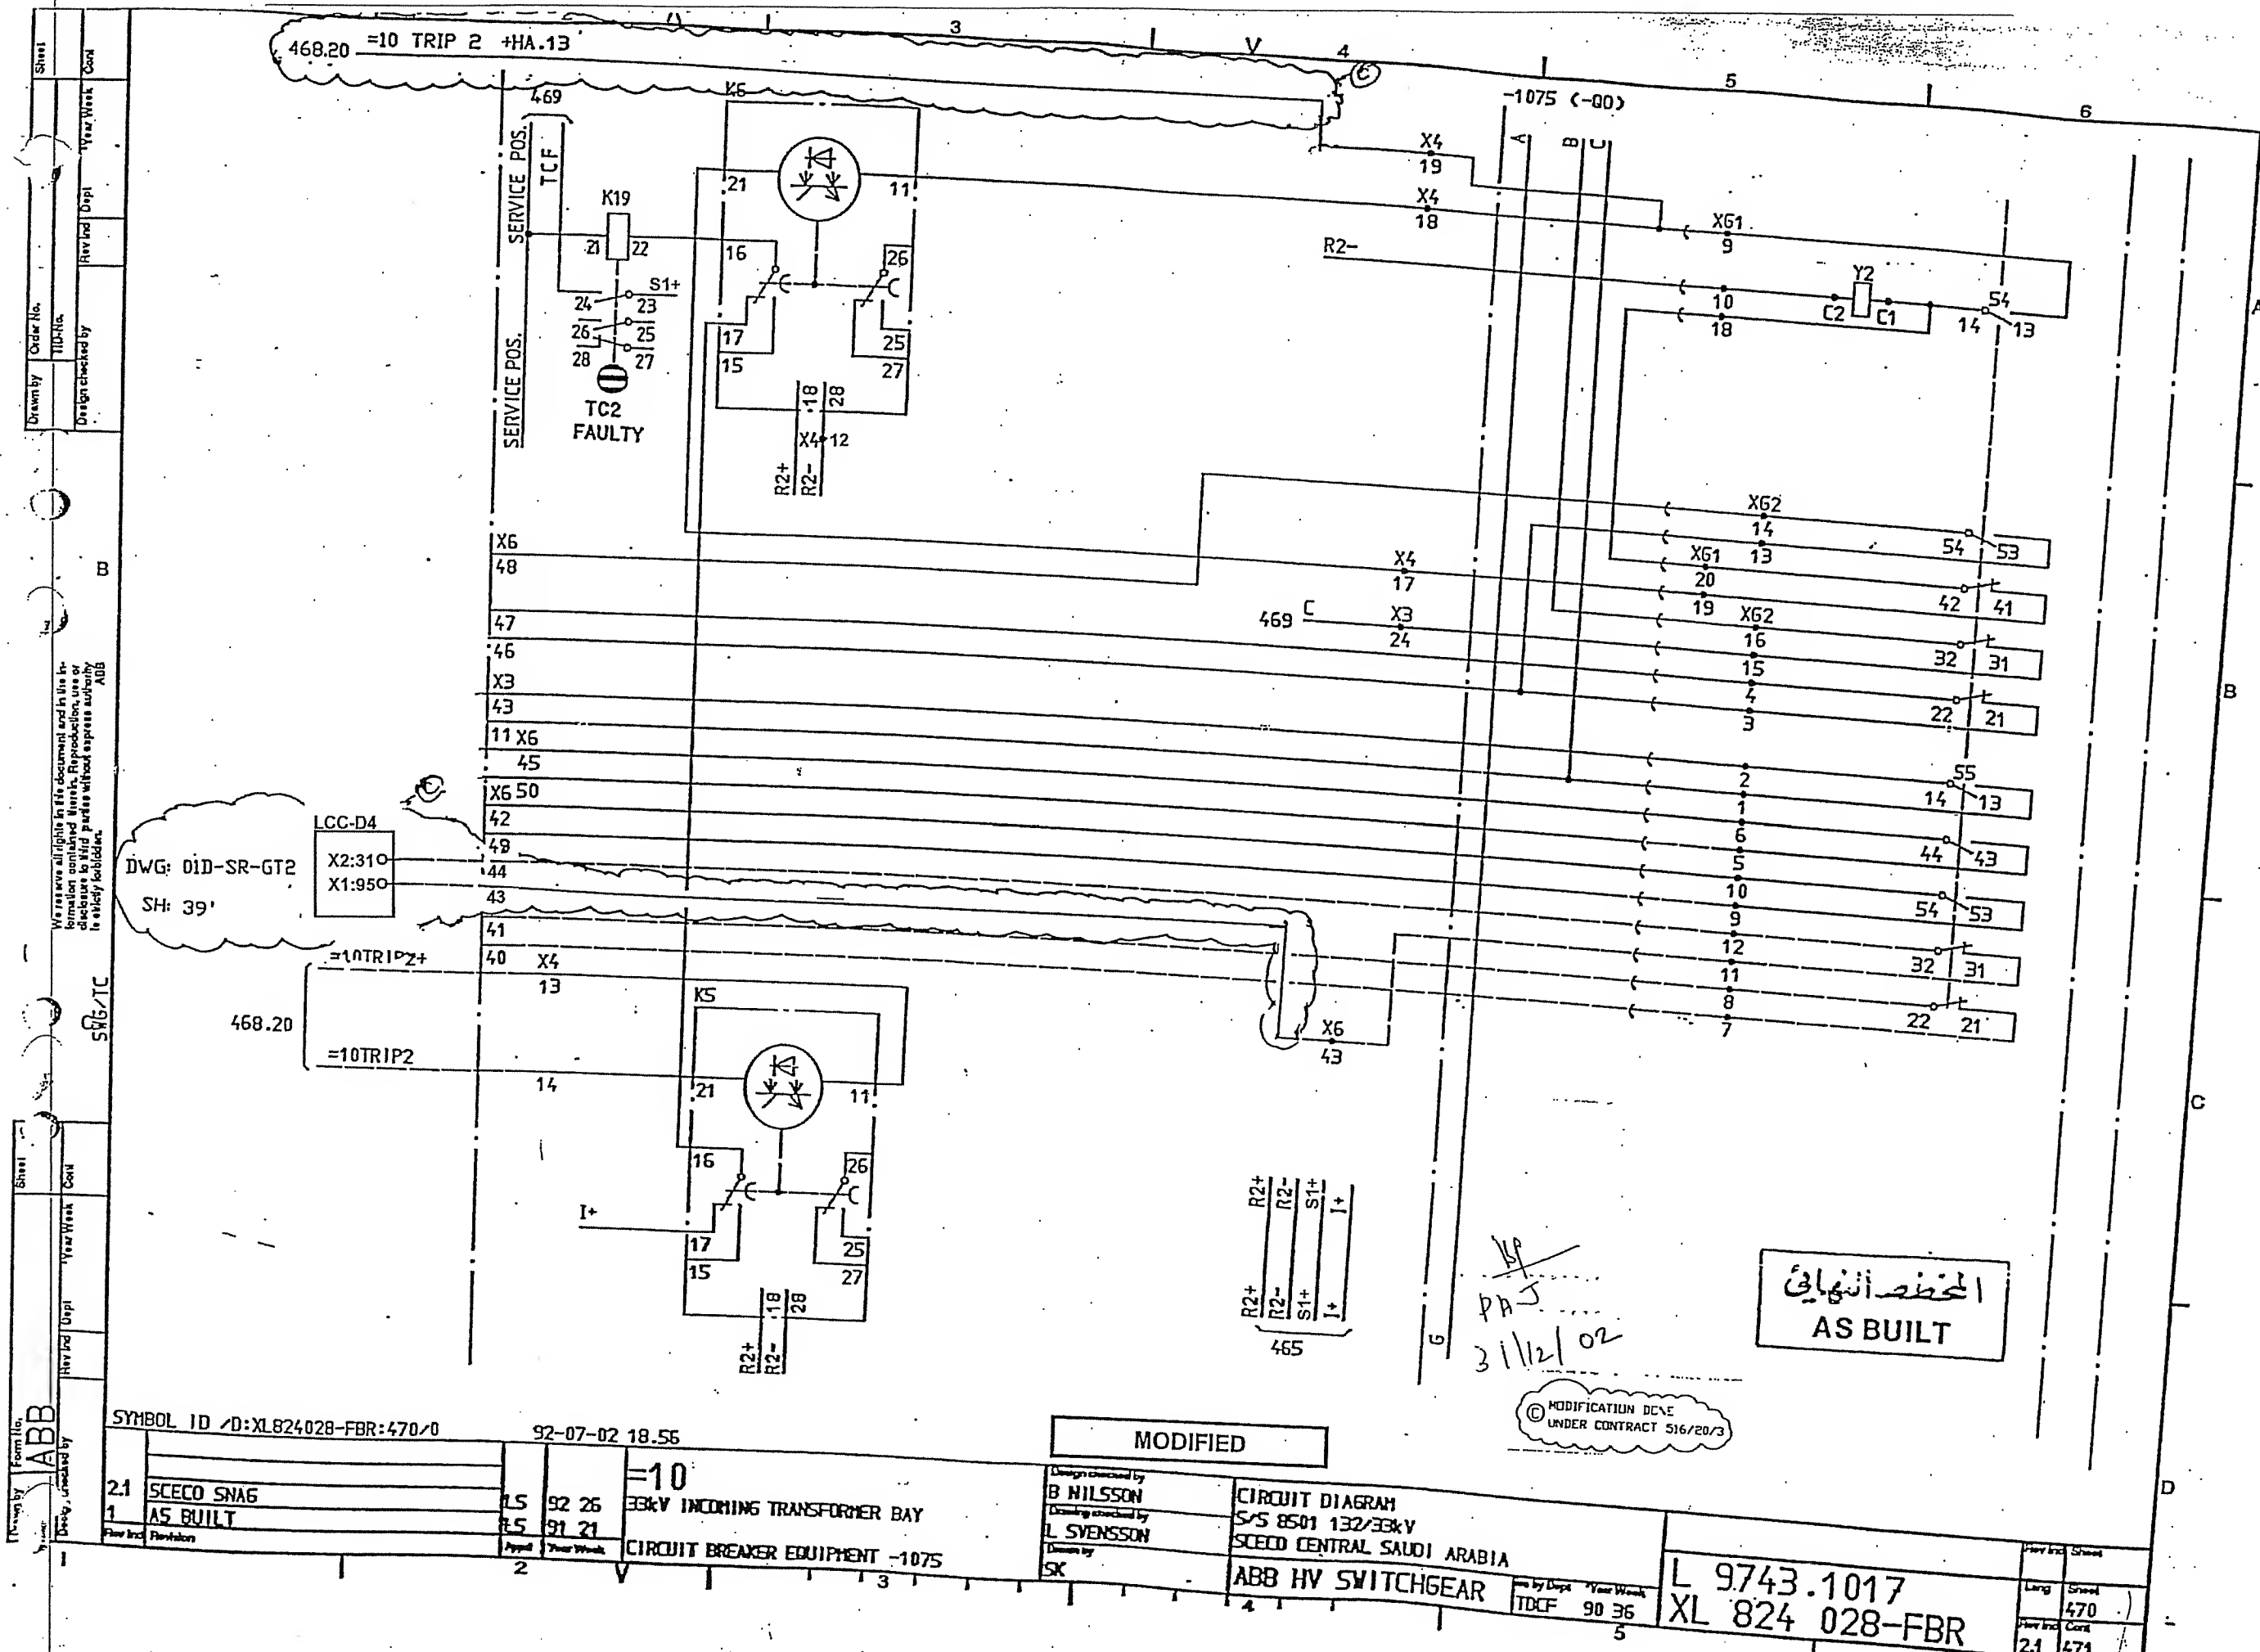

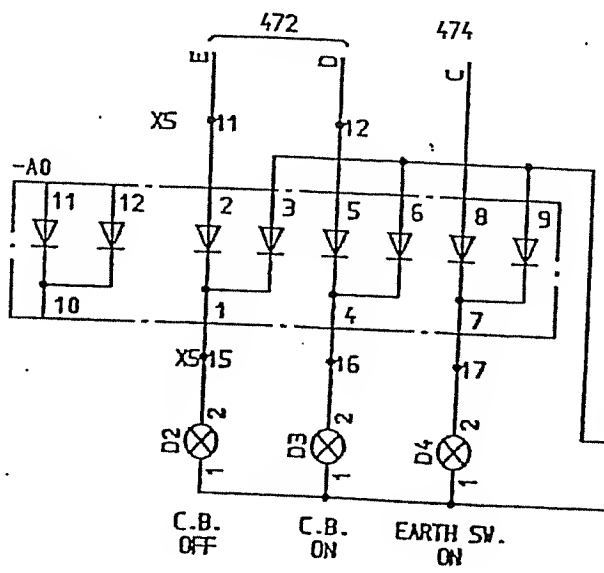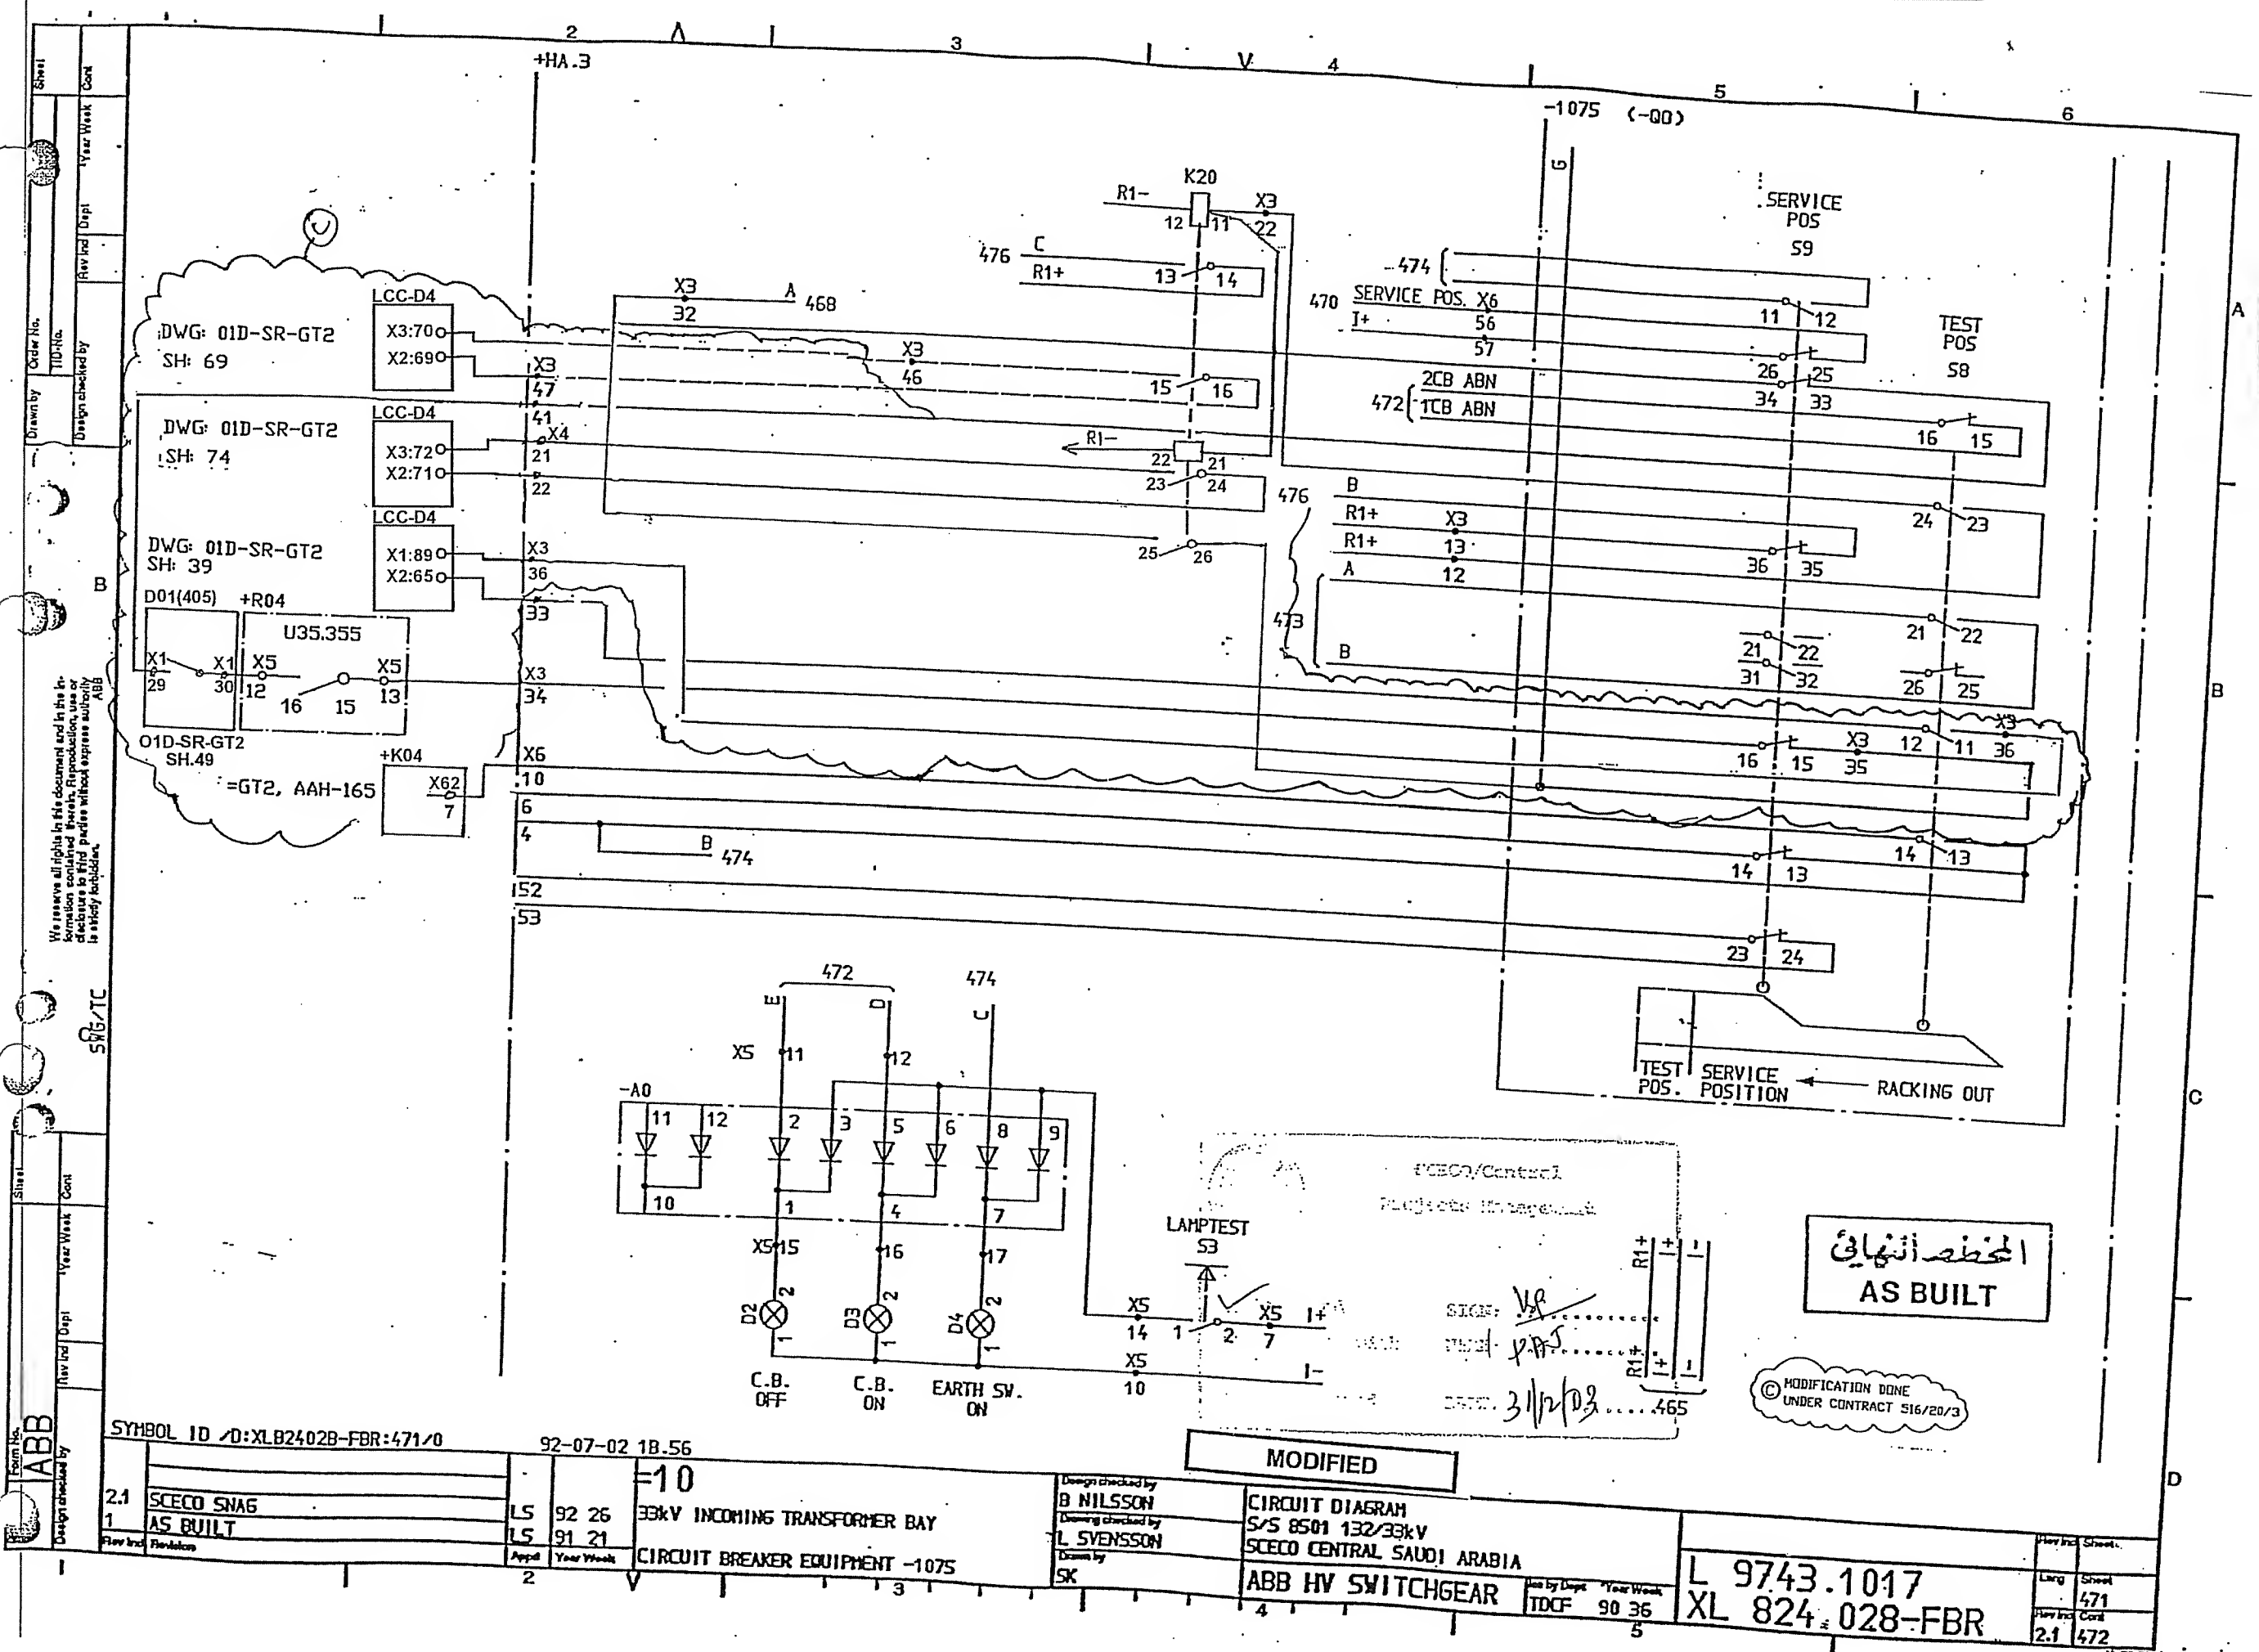


TEST SERVICE POS. POSITION RACKING OUT


المخطط النهائي
AS BUILT

© MODIFICATION DONE UNDER CONTRACT S16/20/3

| | | | | | | | | | | | | | |
|----------------------------------|------------|----------------|-------|--------------------|-------|-------------------------------|------|---------------------------------|---|--|---|-------------------------------|---|
| SYMBOL ID /D: XLB2402B-FBR:471/0 | | 92-07-02 1B.56 | | =10 | | 33kV INCOMING TRANSFORMER BAY | | CIRCUIT BREAKER EQUIPMENT -1075 | | CIRCUIT DIAGRAM S/S 8501 132/33kV SCECO CENTRAL SAUDI ARABIA | | L 9743.1017 XL 824.028-FBR | |
| 2.1 | SCECO SNA6 | LS | 92 26 | LS | 91 21 | Appd | Year | Week | 2 | 3 | 4 | 5 | 6 |
| 1 | AS BUILT | LS | 91 21 | Appd | Year | Week | 2 | 3 | 4 | 5 | 6 | 7 | 8 |
| DESIGN CHECKED BY | | B NILSSON | | DRAWING CHECKED BY | | L SVENSSON | | DRAWN BY | | SK | | L 9743.1017 XL 824.028-FBR | |
| DESIGN CHECKED BY | | B NILSSON | | DRAWING CHECKED BY | | L SVENSSON | | DRAWN BY | | SK | | L 9743.1017 XL 824.028-FBR | |
| DESIGN CHECKED BY | | B NILSSON | | DRAWING CHECKED BY | | L SVENSSON | | DRAWN BY | | SK | | L 9743.1017 XL 824.028-FBR | |

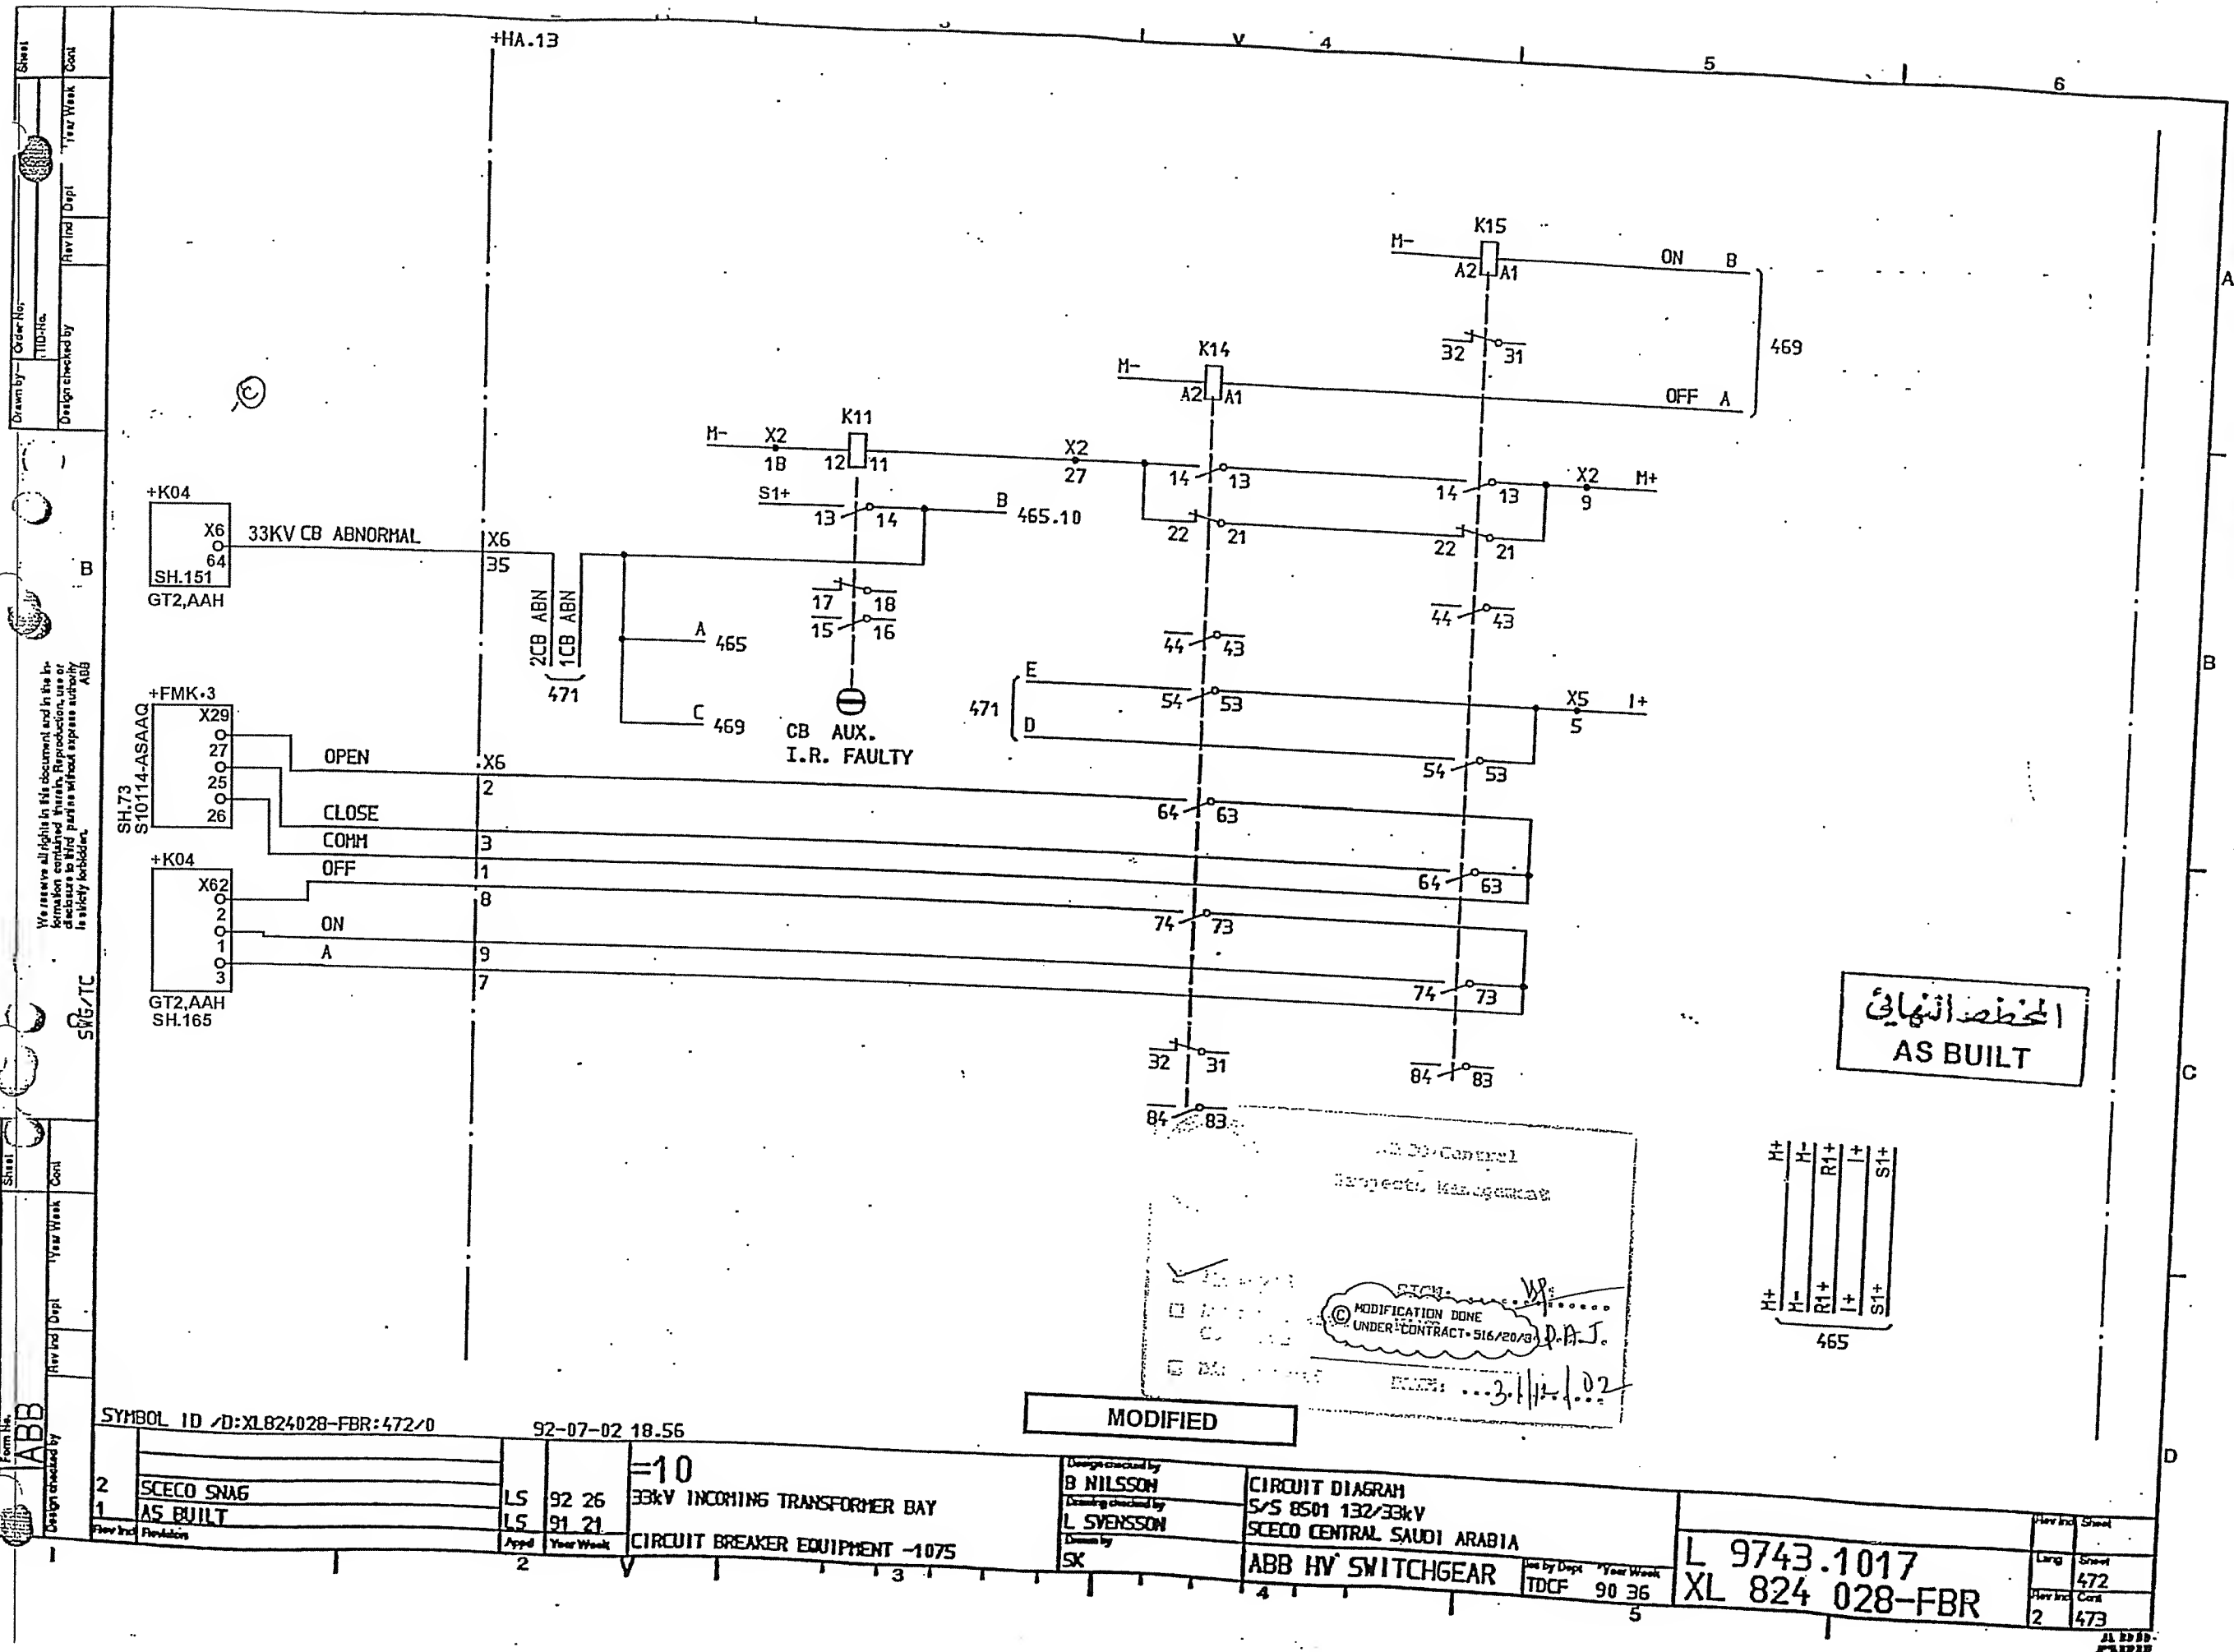

المحطة النهائية
AS BUILT

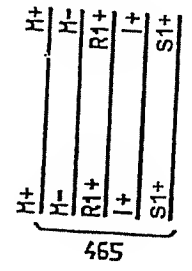

AS BUILT Control
Project: Kingdome
MODIFICATION DONE
UNDER CONTRACT 516/20/3A
DATE: 3.11.02

MODIFIED

SYMBOL ID /D:XL824028-FBR:472/0

92-07-02 18.56

33kV INCOMING TRANSFORMER BAY
CIRCUIT BREAKER EQUIPMENT -1075


Designed by
B NILSSON
Drawing checked by
L SVENSSON
Drawn by
SX

CIRCUIT DIAGRAM
S/S 8501 132/33kV
SCECO CENTRAL SAUDI ARABIA
ABB HV SWITCHGEAR

Issued by Dept
TDCF 90 36

L 9743.1017
XL 824 028-FBR

| | | |
|-----|-----|-------|
| Rev | Inc | Sheet |
| 2 | 472 | 473 |

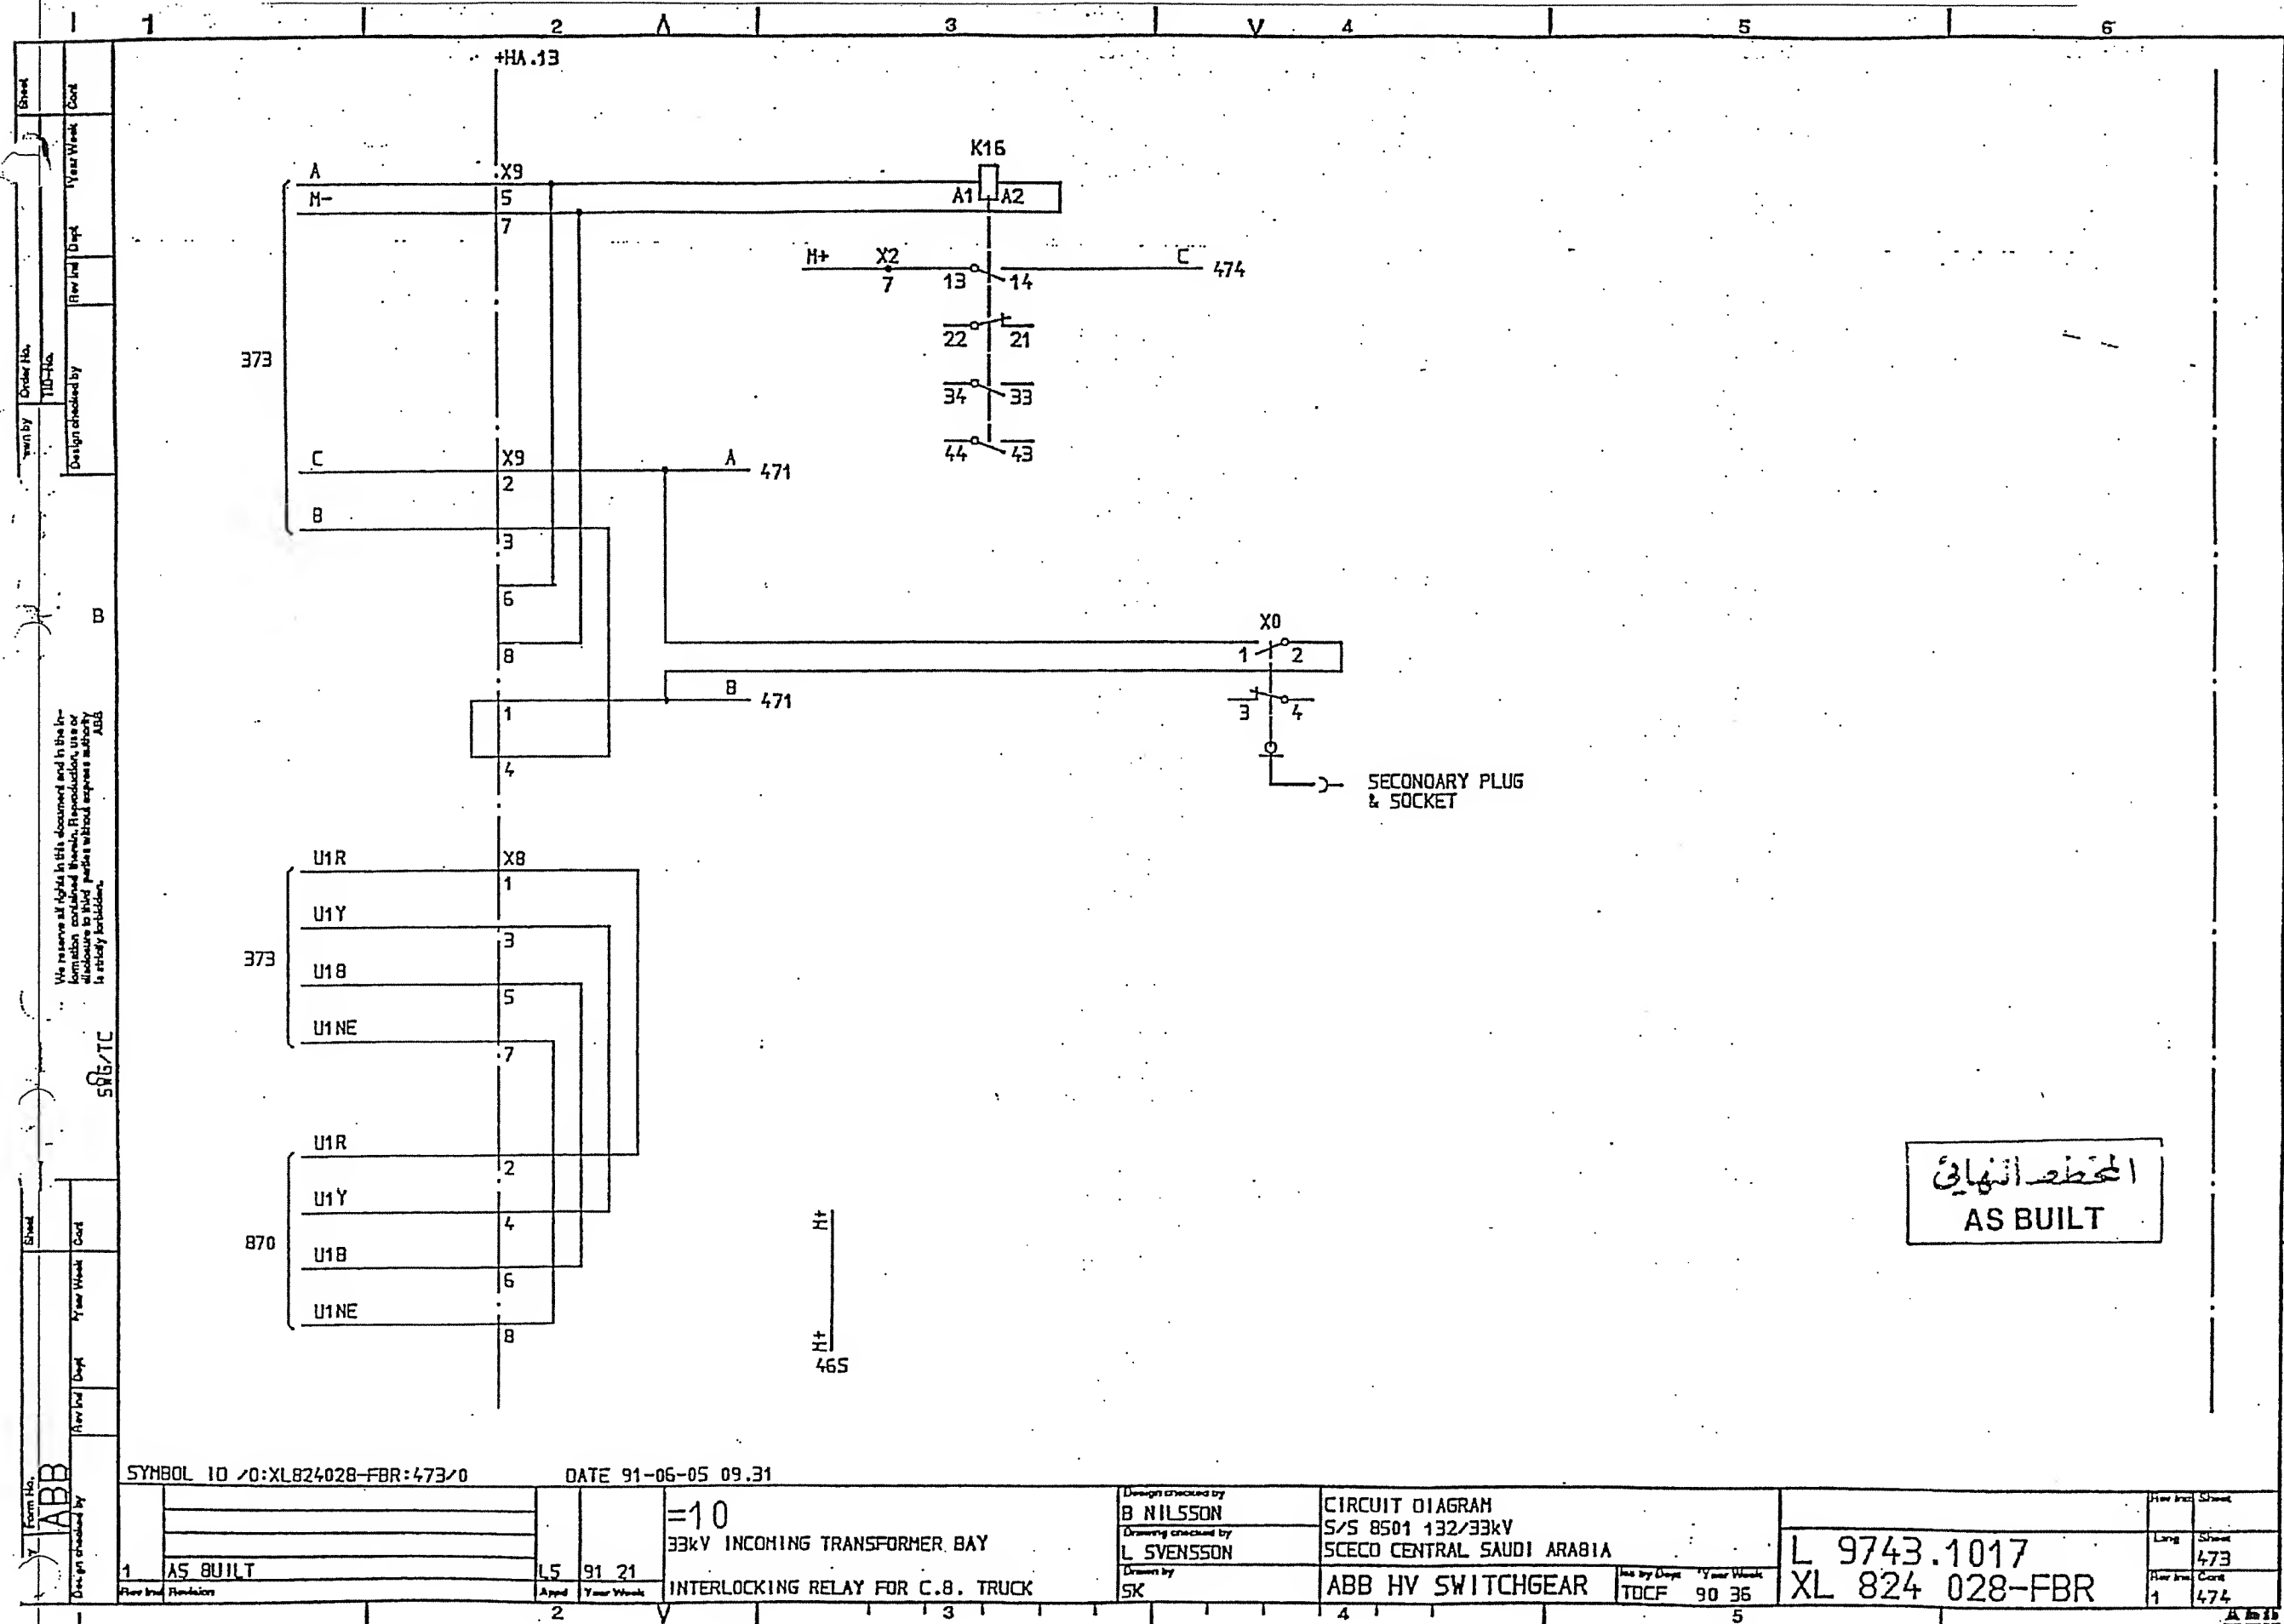

المخطط النهائي
AS BUILT

SYMBOL ID /0:XL824028-FBR:473/0

DATE 91-06-05 09.31

=10
33kV INCOMING TRANSFORMER BAY
INTERLOCKING RELAY FOR C.B. TRUCK

Design checked by
B NILSSON
Drawing checked by
L SVENSSON
Drawn by
SK


CIRCUIT DIAGRAM
S/S 8501 132/33kV
SCECO CENTRAL SAUDI ARABIA
ABB HV SWITCHGEAR

Issued by Dept
TOCF 90 35


L 9743.1017
XL 824 028-FBR


| | |
|----------|-------|
| How Incl | Sheet |
| Long | 473 |
| How Incl | Core |
| 1 | 474 |

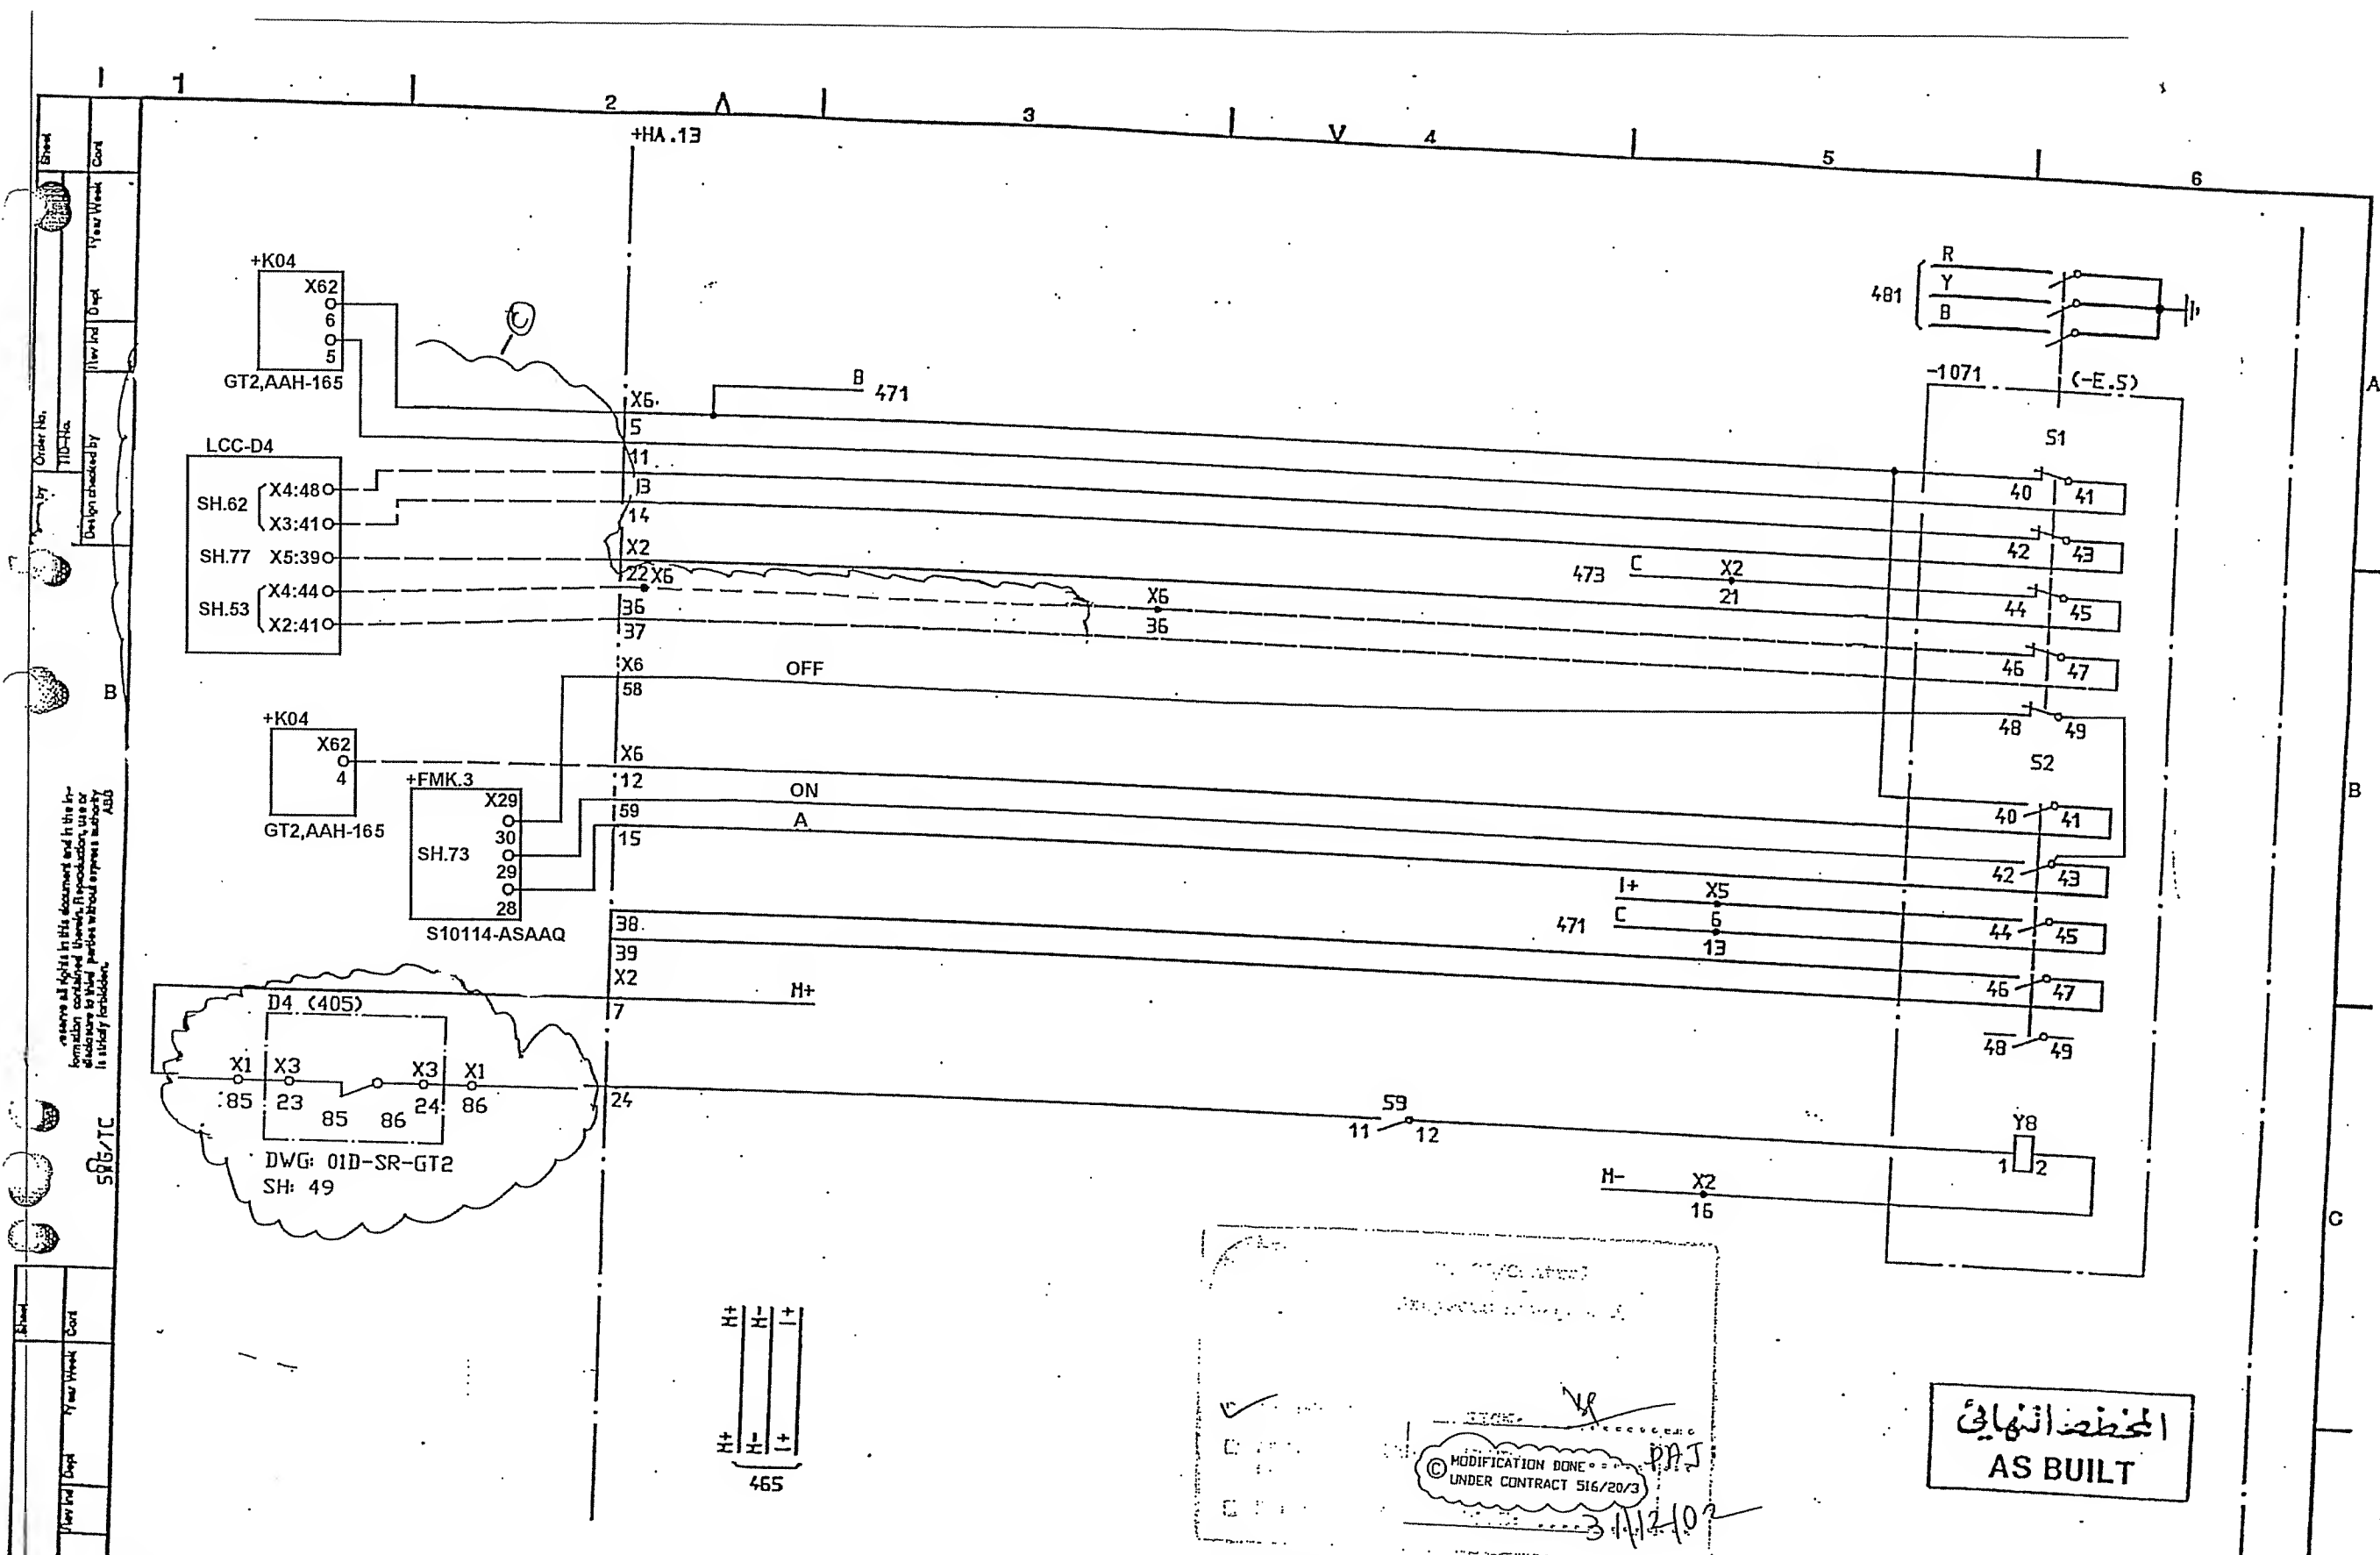ABB
ASB



| | | | | | | | | | | | | | | | | | |
|-----------------------------------|--|---------------------|--|------------------------------|--|-------------------------------|--|---------------------|--|-------------------|--|----------------------------|--|-------------|--|----------------|--|
| SYMBOL ID / D: XL824028-FBR:474/0 | | DATE 91-05-05 09.31 | | =10 | | 33kV INCOMING TRANSFORMER BAY | | CIRCUIT DIAGRAM | | S/S 8501 132/33kV | | SCECO CENTRAL SAUDI ARABIA | | L 9743.1017 | | XL 824 028-FBR | |
| AS BUILT | | 15 91 21 | | EARTH SWITCH EQUIPMENT -1071 | | DESIGNED BY B NILSSON | | DRAWN BY L SVENSSON | | CHECKED BY SK | | ABB HV SWITCHGEAR | | TDCF 90 36 | | 1 474 | |
| 1 | | 2 | | 3 | | 4 | | 5 | | 6 | | 7 | | 8 | | 9 | |

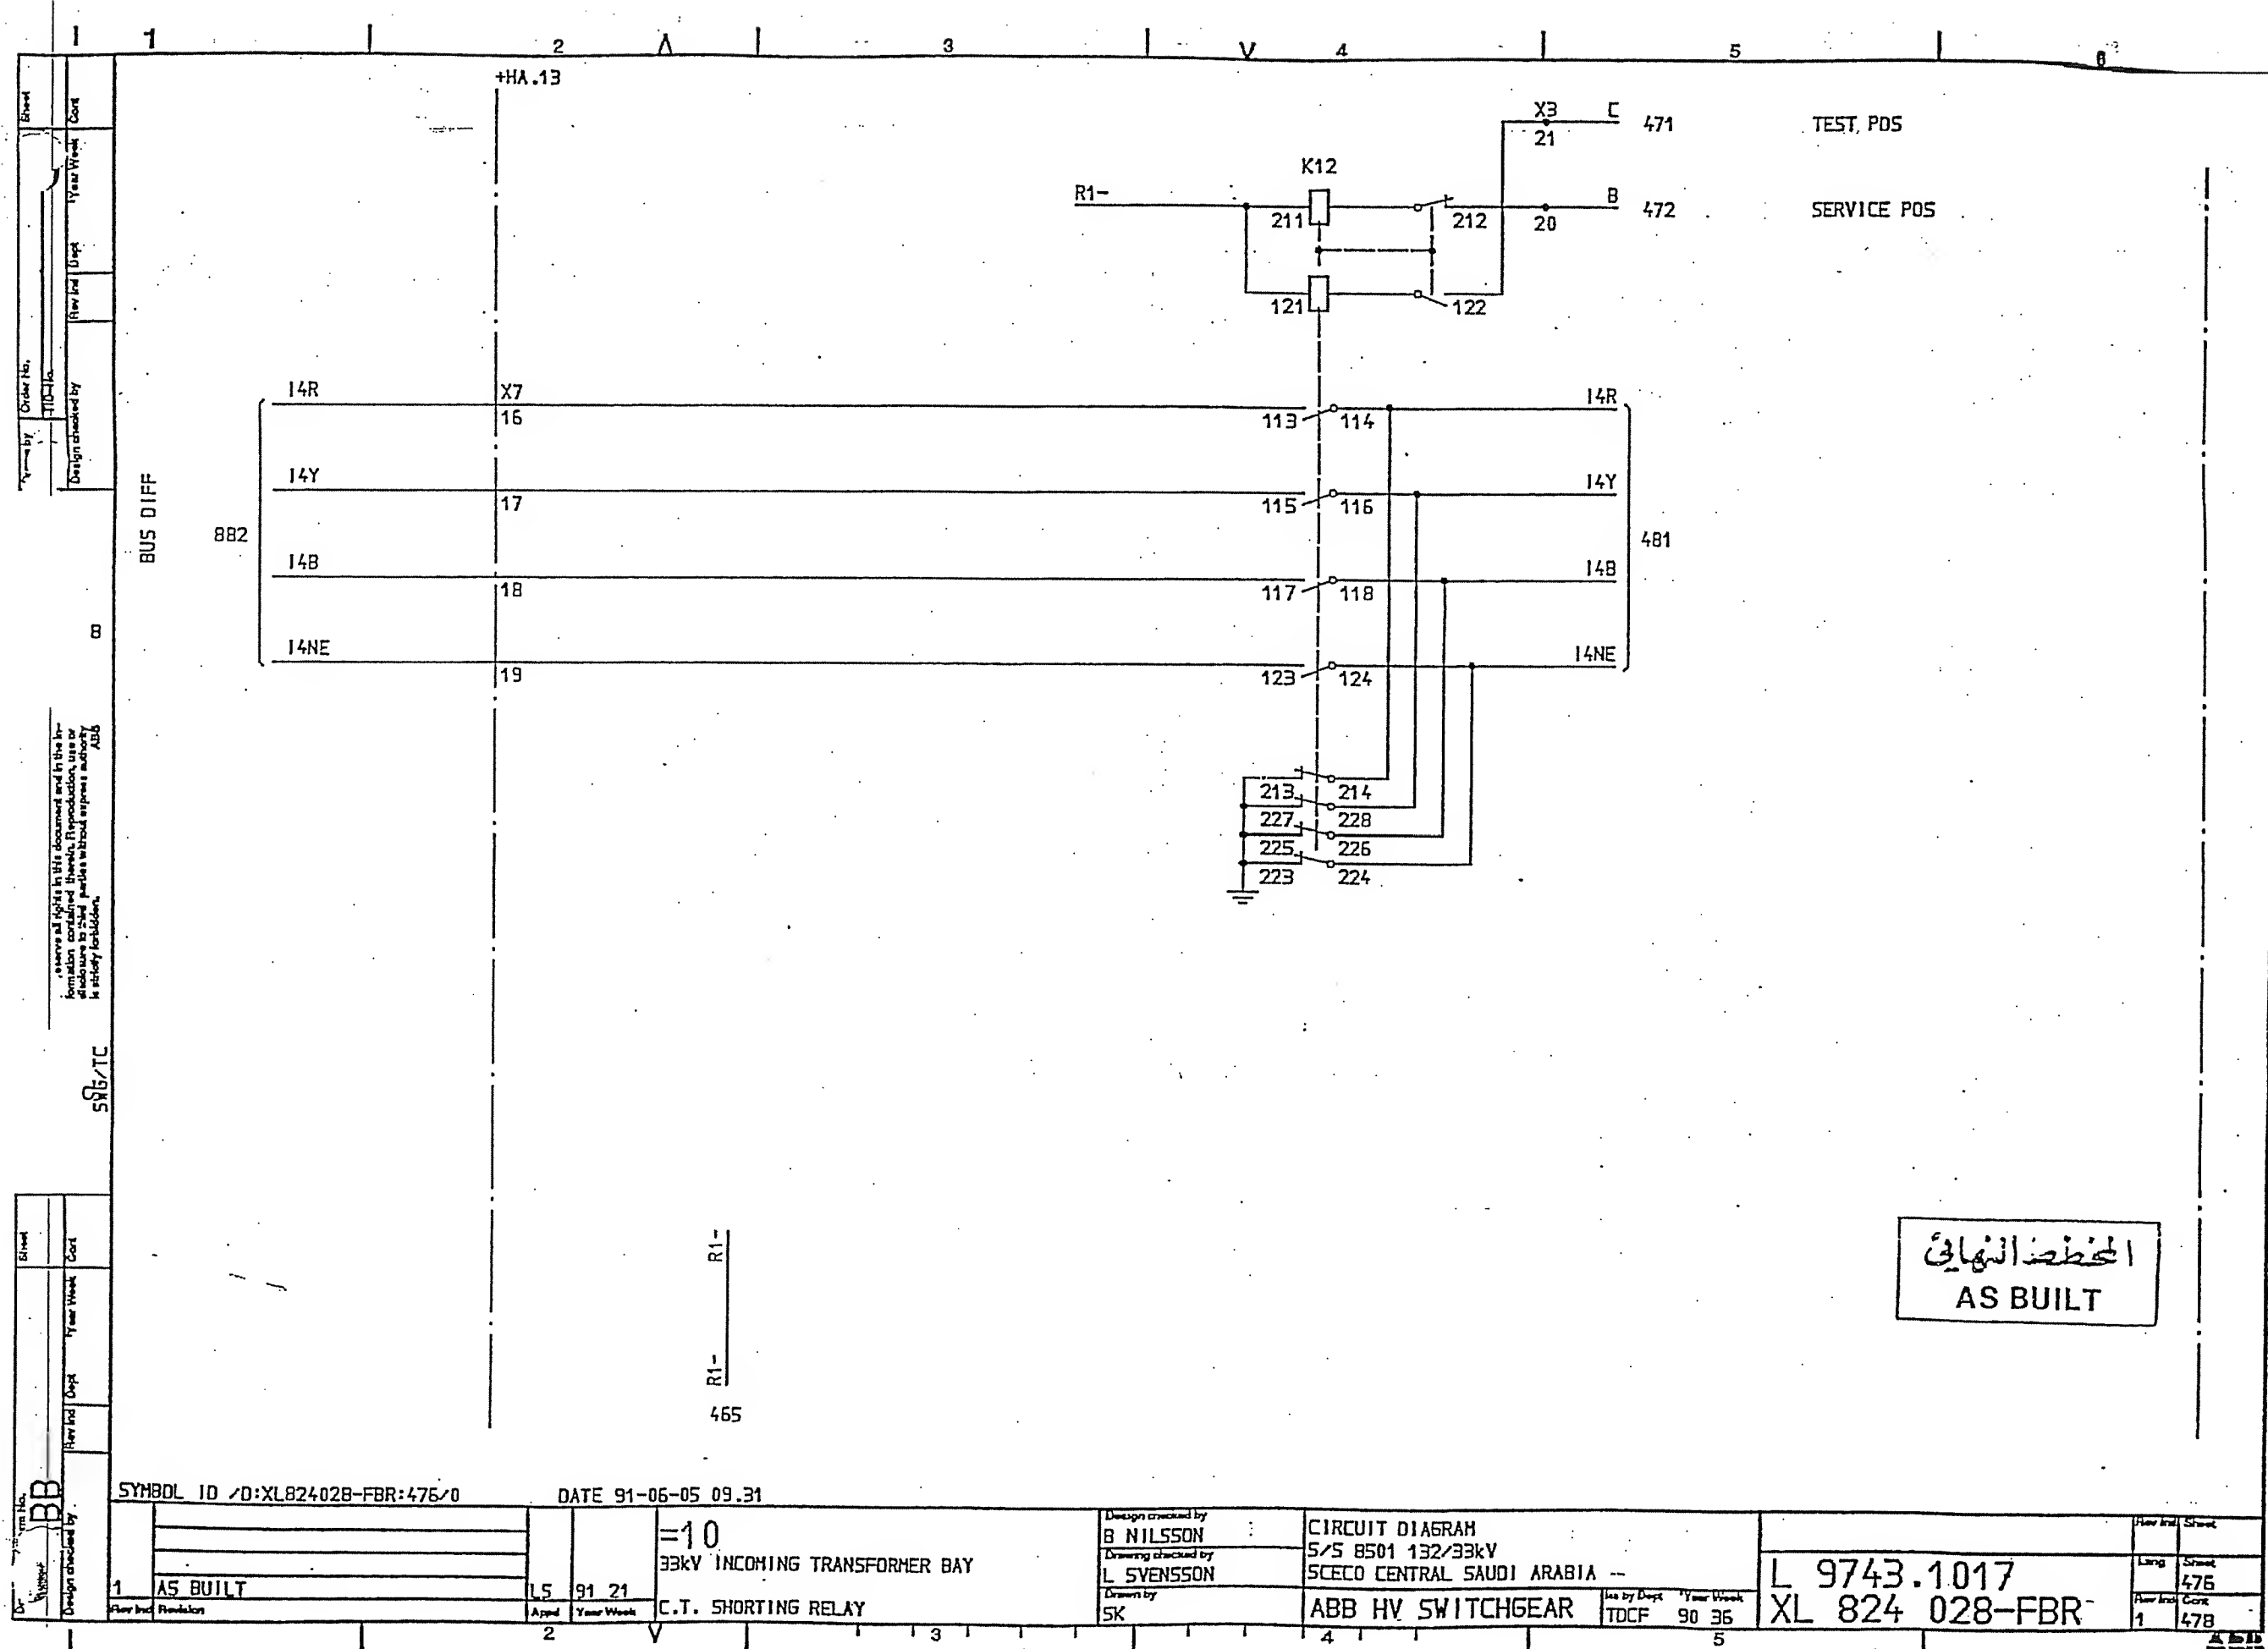


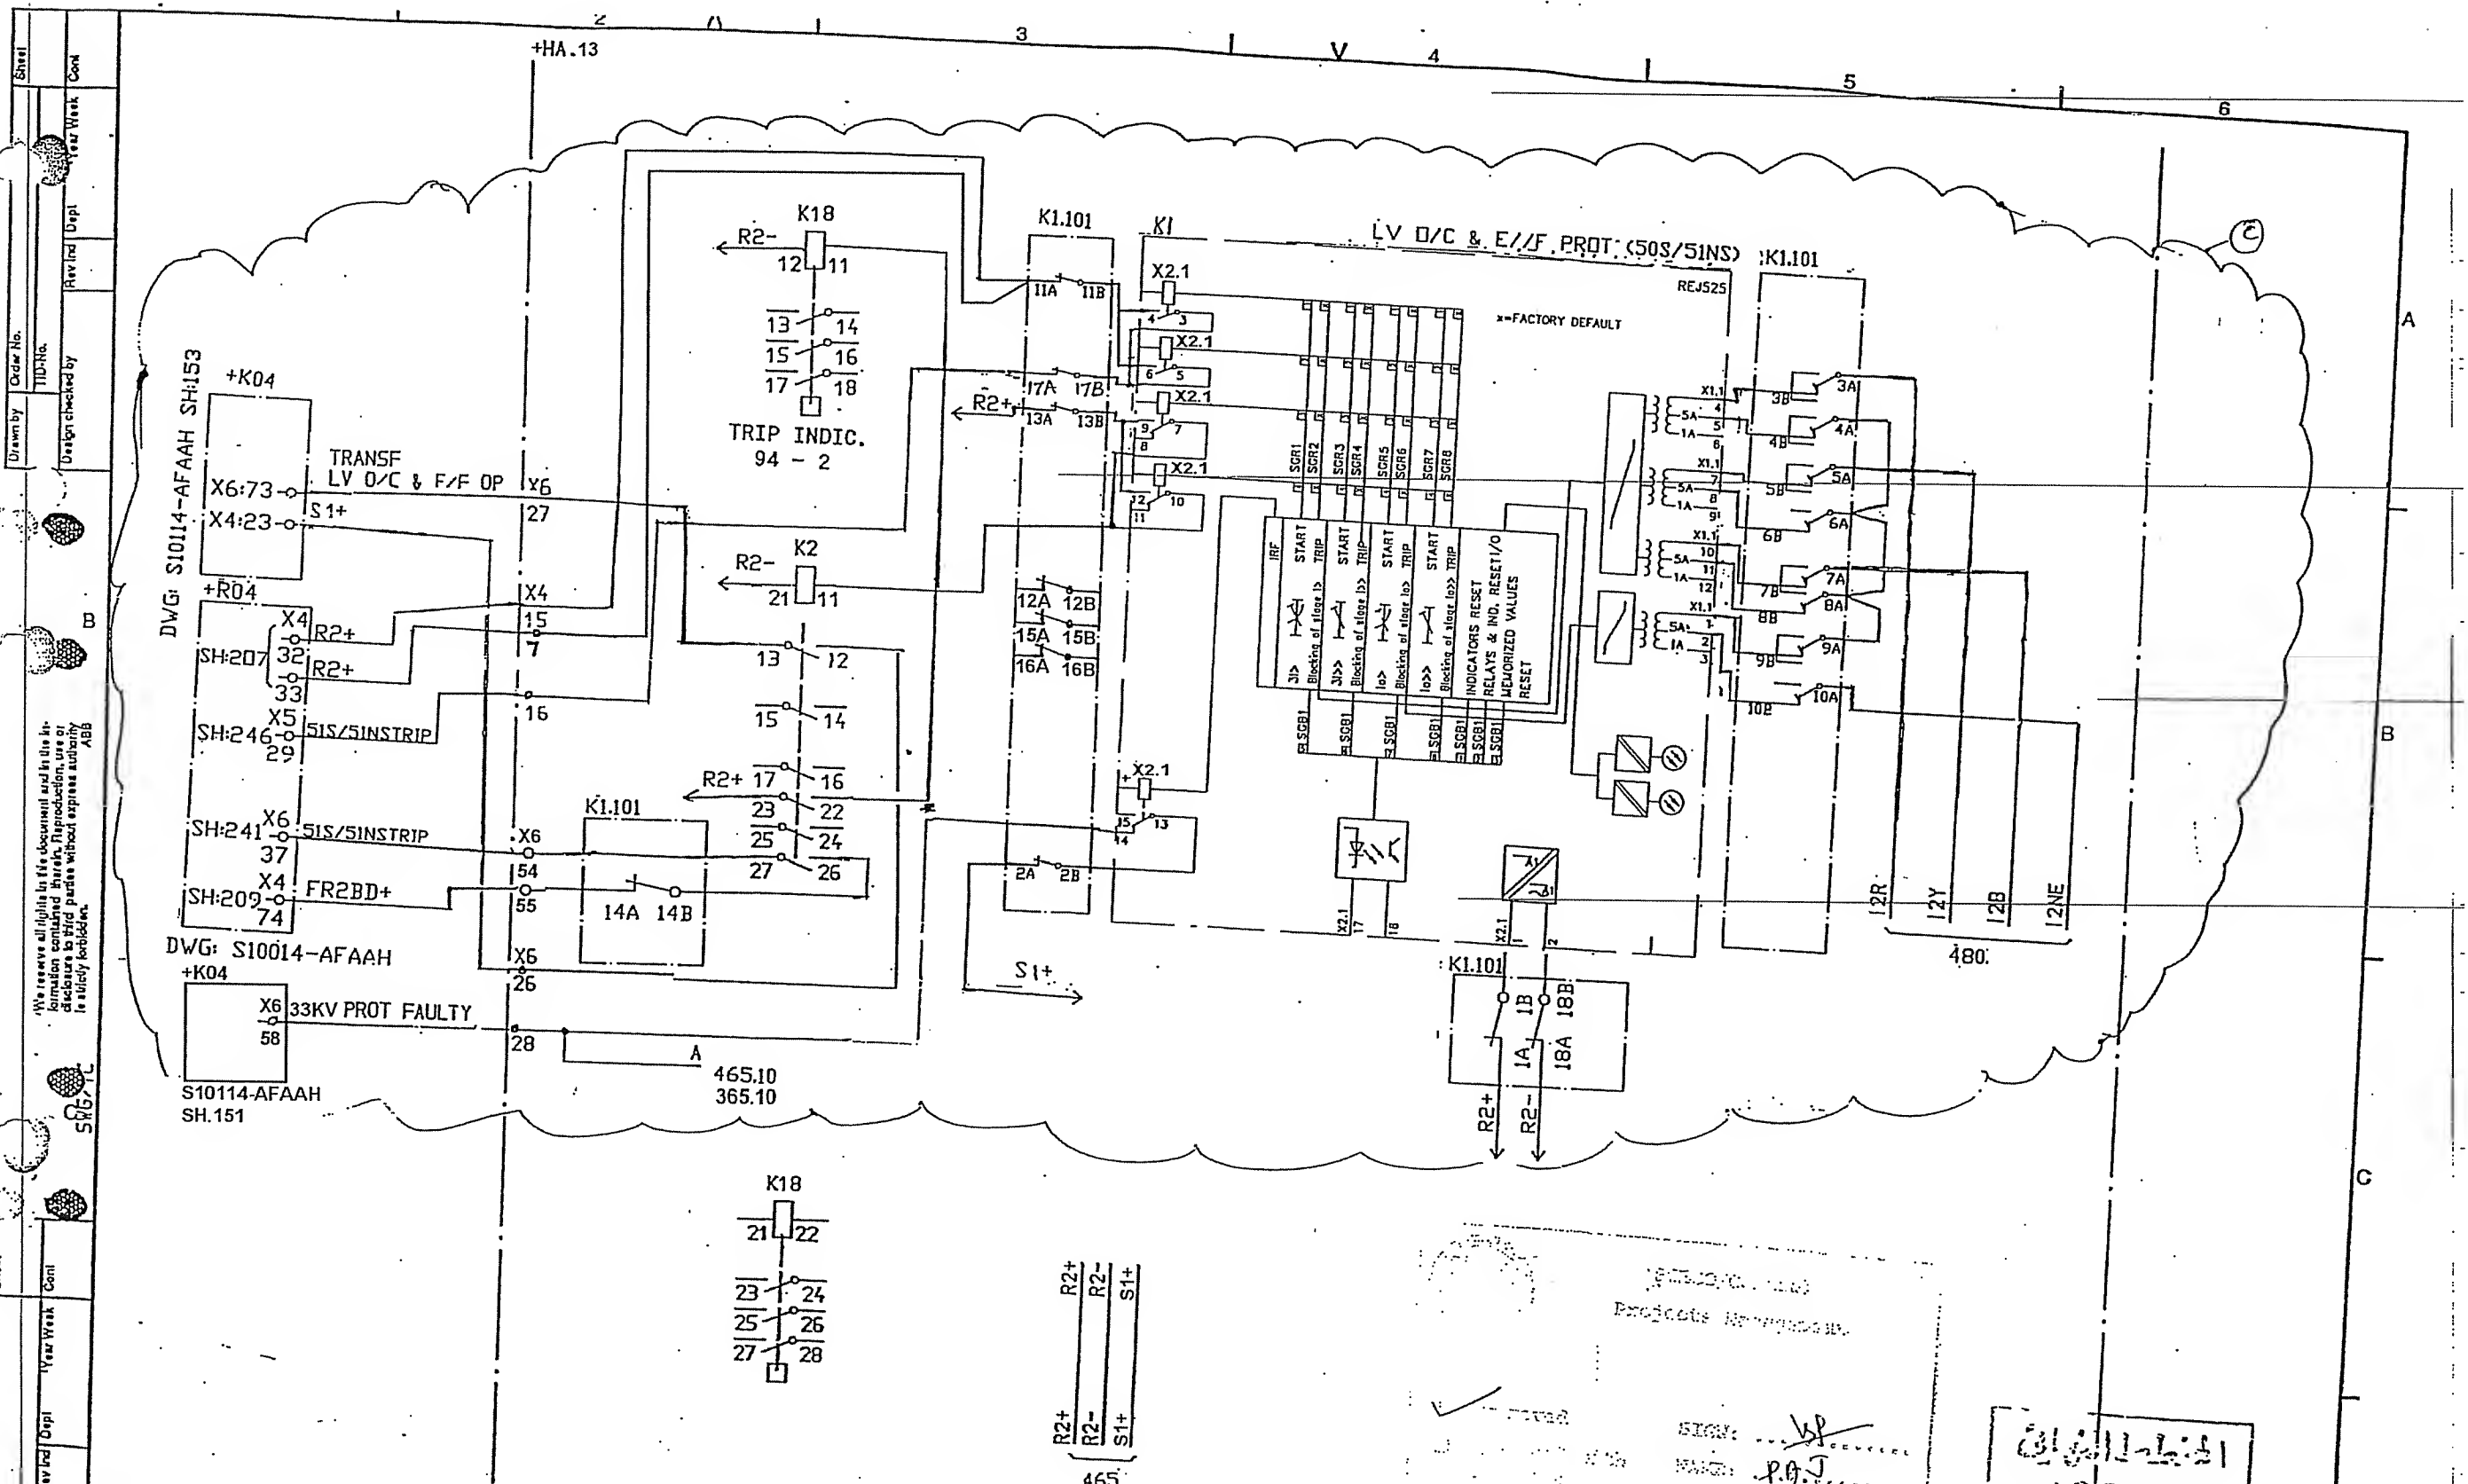

| | | | | | | | |
|--|--|--|--|---|--|---|--|
| SYMBOL ID /D:XL824028-FBR:128/0 92-07-02 18.53 =10 33kV INCOMING TRANSFORMER BAY OVERCURRENT PROT 33kV | | Design checked by B NILSSON Drawing checked by L SVENSSON Drawn by SK | | CIRCUIT DIAGRAM S/S 8501 132/33kV SCECO CENTRAL SAUDI ARABIA ABB HV SWITCHGEAR | | L 9743.1017 XL 824 028-FBR | |
| 2 SCECO SNAG 1 AS BUILT | | Appd Year Week 2 92 26 1 91 21 | | Use by Dept Year Week TDCF 90 36 | | How Inc Sheet Long 478 How Inc Sheet 2 480 | |


01/01/1-1:1
 ASECULT

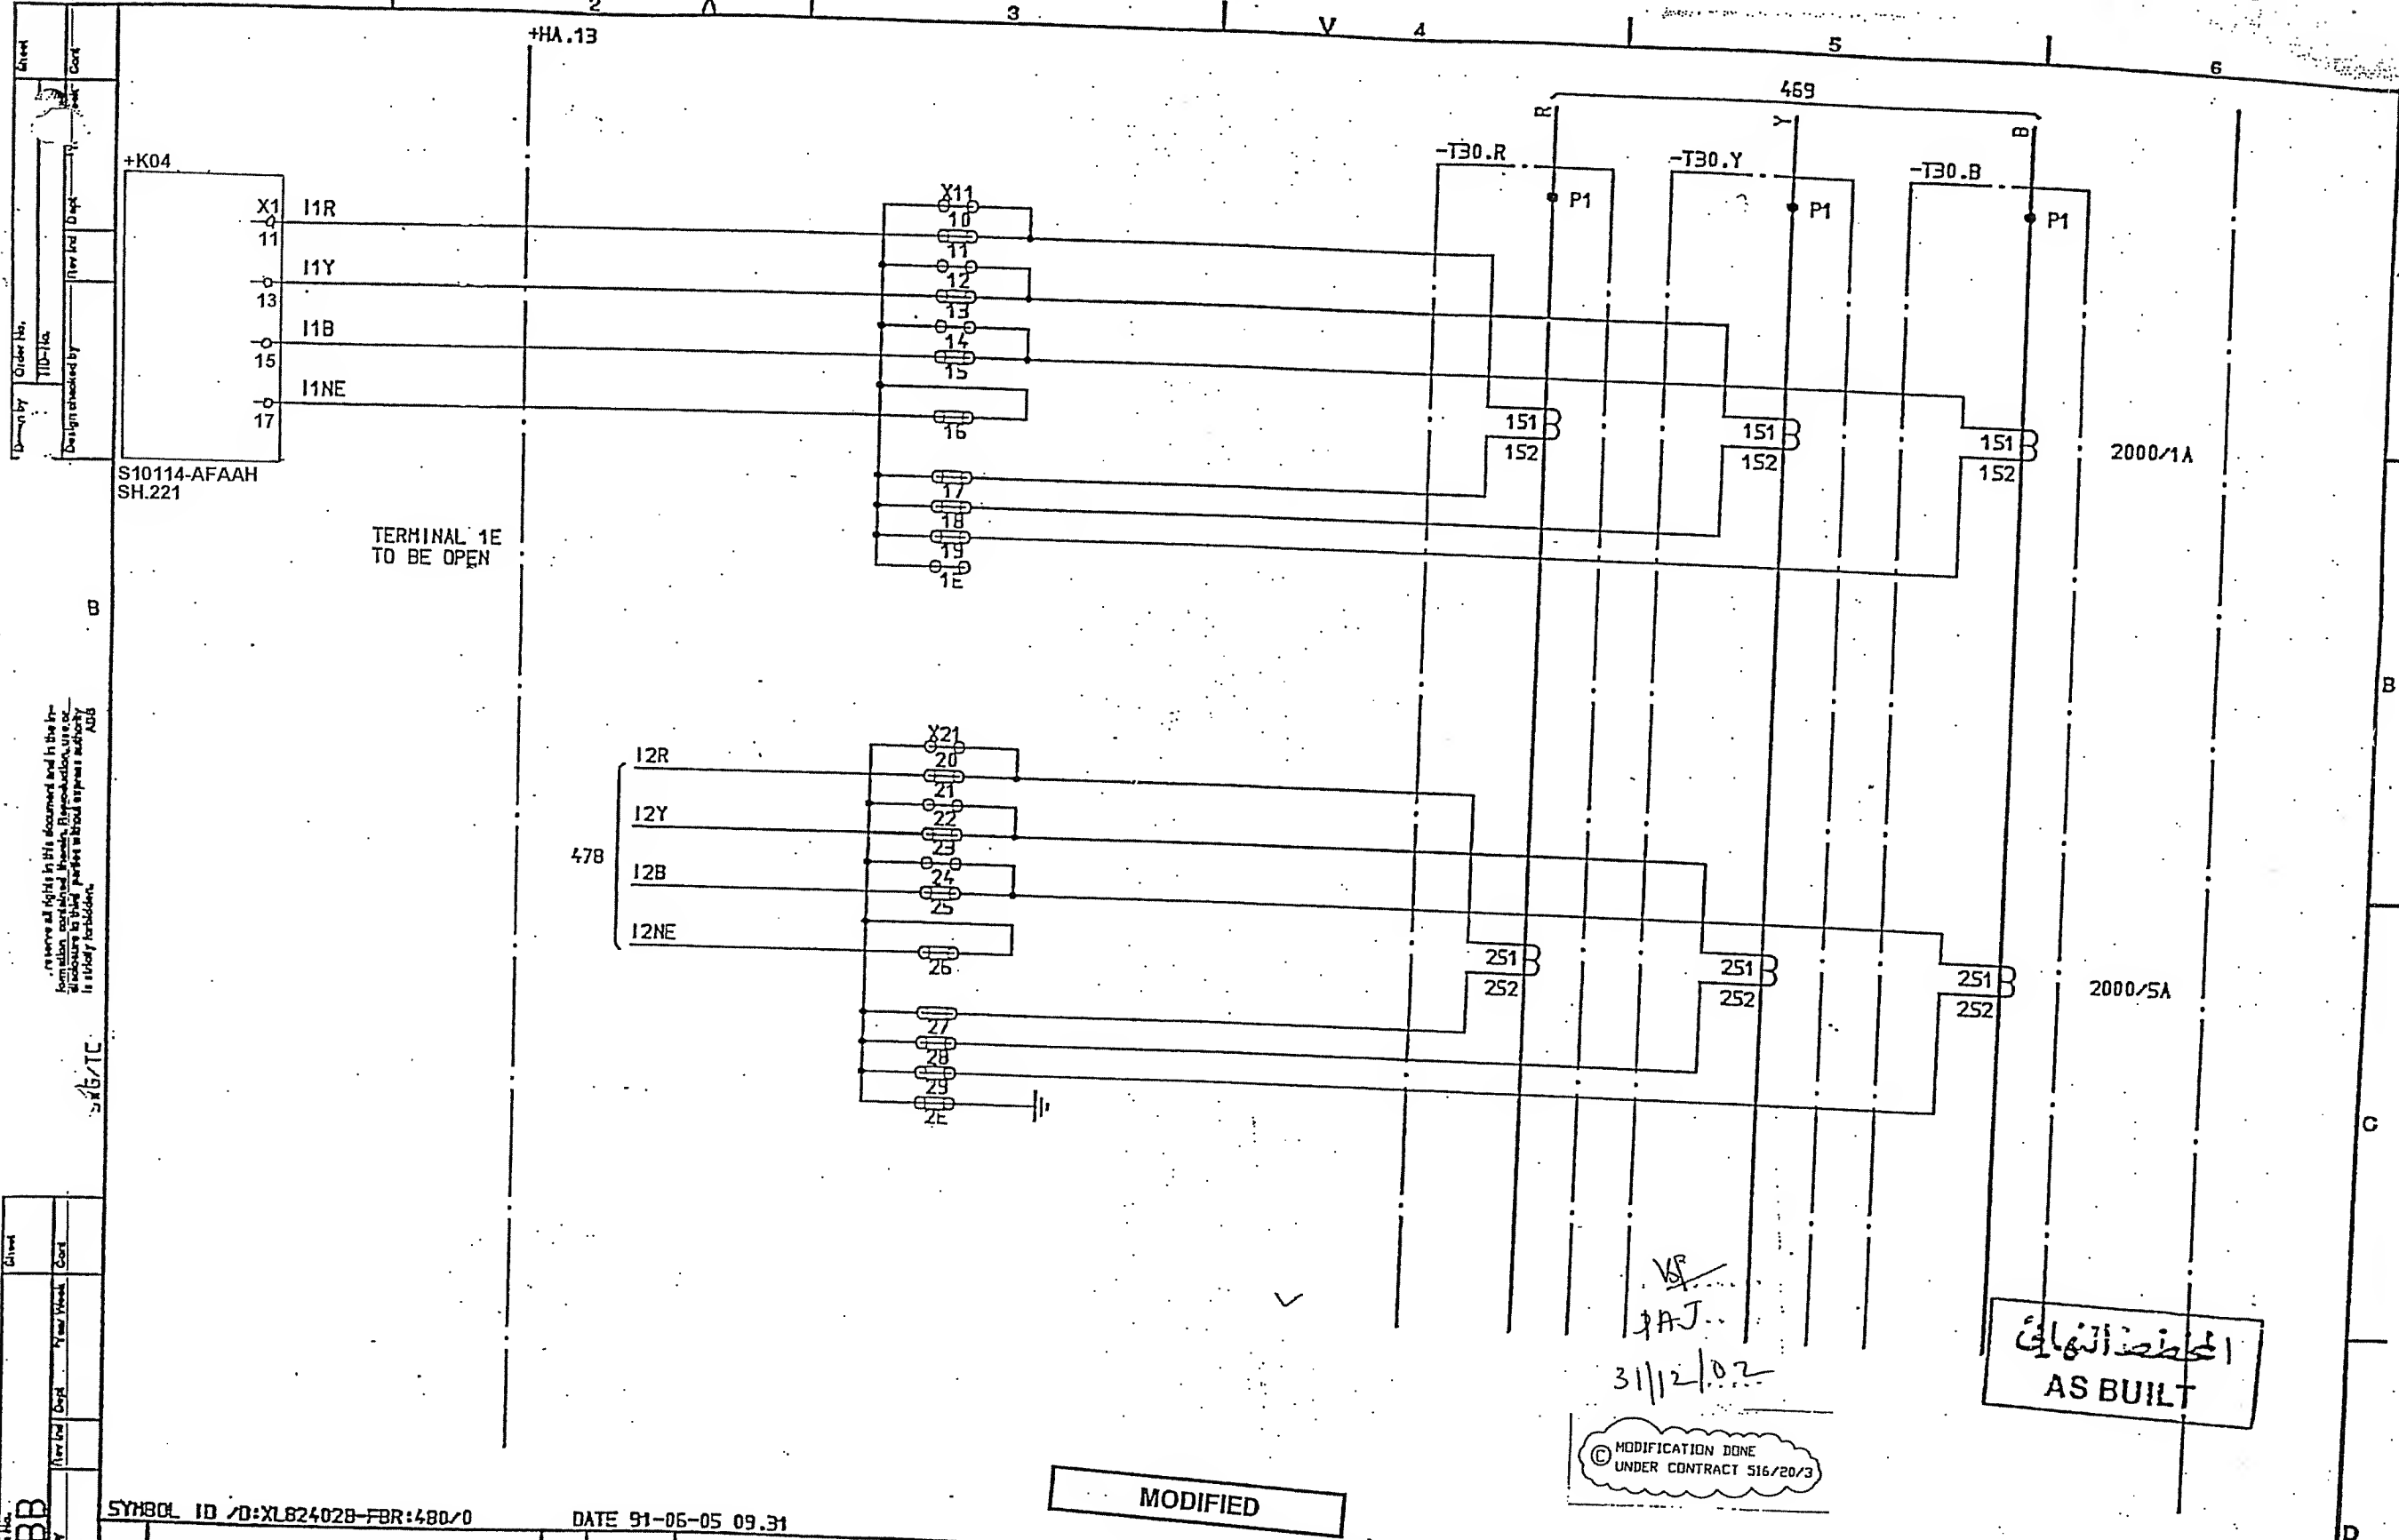MODIFIED




| | | | | | |
|---|--|---|--|--|--|
| Drawn by: ABB Checked by: ABB | | SYMBOL ID /D:XL824028-FBR:480/0 | | DATE 91-05-05 09.31 | |
| AS BUILT | | 15 91 21 | | =10 33kV INCOMING TRANSFORMER BAY CURRENT TRANSFORMER -T30 | |
| Design checked by: B NILSSON Drawing checked by: L SVENSSON Drawn by: SK | | CIRCUIT DIAGRAM S/S 8501 132/33kV SCEED CENTRAL SAUDI ARABIA ABB HV SWITCHGEAR | | L 9743:1017 XL 824 028-FBR | |
| 1 | | 2 | | 3 | |
| 4 | | 5 | | 6 | |

| 1 | | 2 | | 3 | | 4 | | 5 | | 6 | |
|--|--|---|--|---|--|---|--|---|--|---|--|
| <div style="position: absolute; top: 100px; left: 670px; border: 1px solid black; padding: 5px;">DELETED</div> <div style="position: absolute; top: 260px; left: 390px;"> <p>+KA.2.K1</p> </div> <div style="position: absolute; top: 730px; left: 740px; border: 1px solid black; padding: 5px;"> المخطط النهائي AS BUILT </div> | | | | | | | | | | | |
| <div style="display: flex; justify-content: space-between;"> <div> SYMBOL ID /D:XL824028-FBR:485/0 DATE 91-06-05 09.31 </div> <div> <div style="border: 1px solid black; padding: 2px;"> =10 33kV INCOMING TRANSFORMER BAY EARTH SWITCH EQUIPMENT -1071 INDICATION </div> <div style="border: 1px solid black; padding: 2px;"> Design checked by B NILSSON Drawing checked by S STRIOGHAN Drawn by SK </div> <div style="border: 1px solid black; padding: 2px;"> CIRCUIT DIAGRAM S/S 8501 132/33kV SCECO CENTRAL SAUDI ARABIA ABB HV SWITCHGEAR </div> <div style="border: 1px solid black; padding: 2px;"> L 9743.1017 XL 824 028-FBR </div> </div> </div> | | | | | | | | | | | |
| <div style="display: flex; justify-content: space-between;"> <div> 1 AS BUILT </div> <div> L5 91 21 </div> <div> 1 485 </div> <div> 1 491 </div> </div> | | | | | | | | | | | |

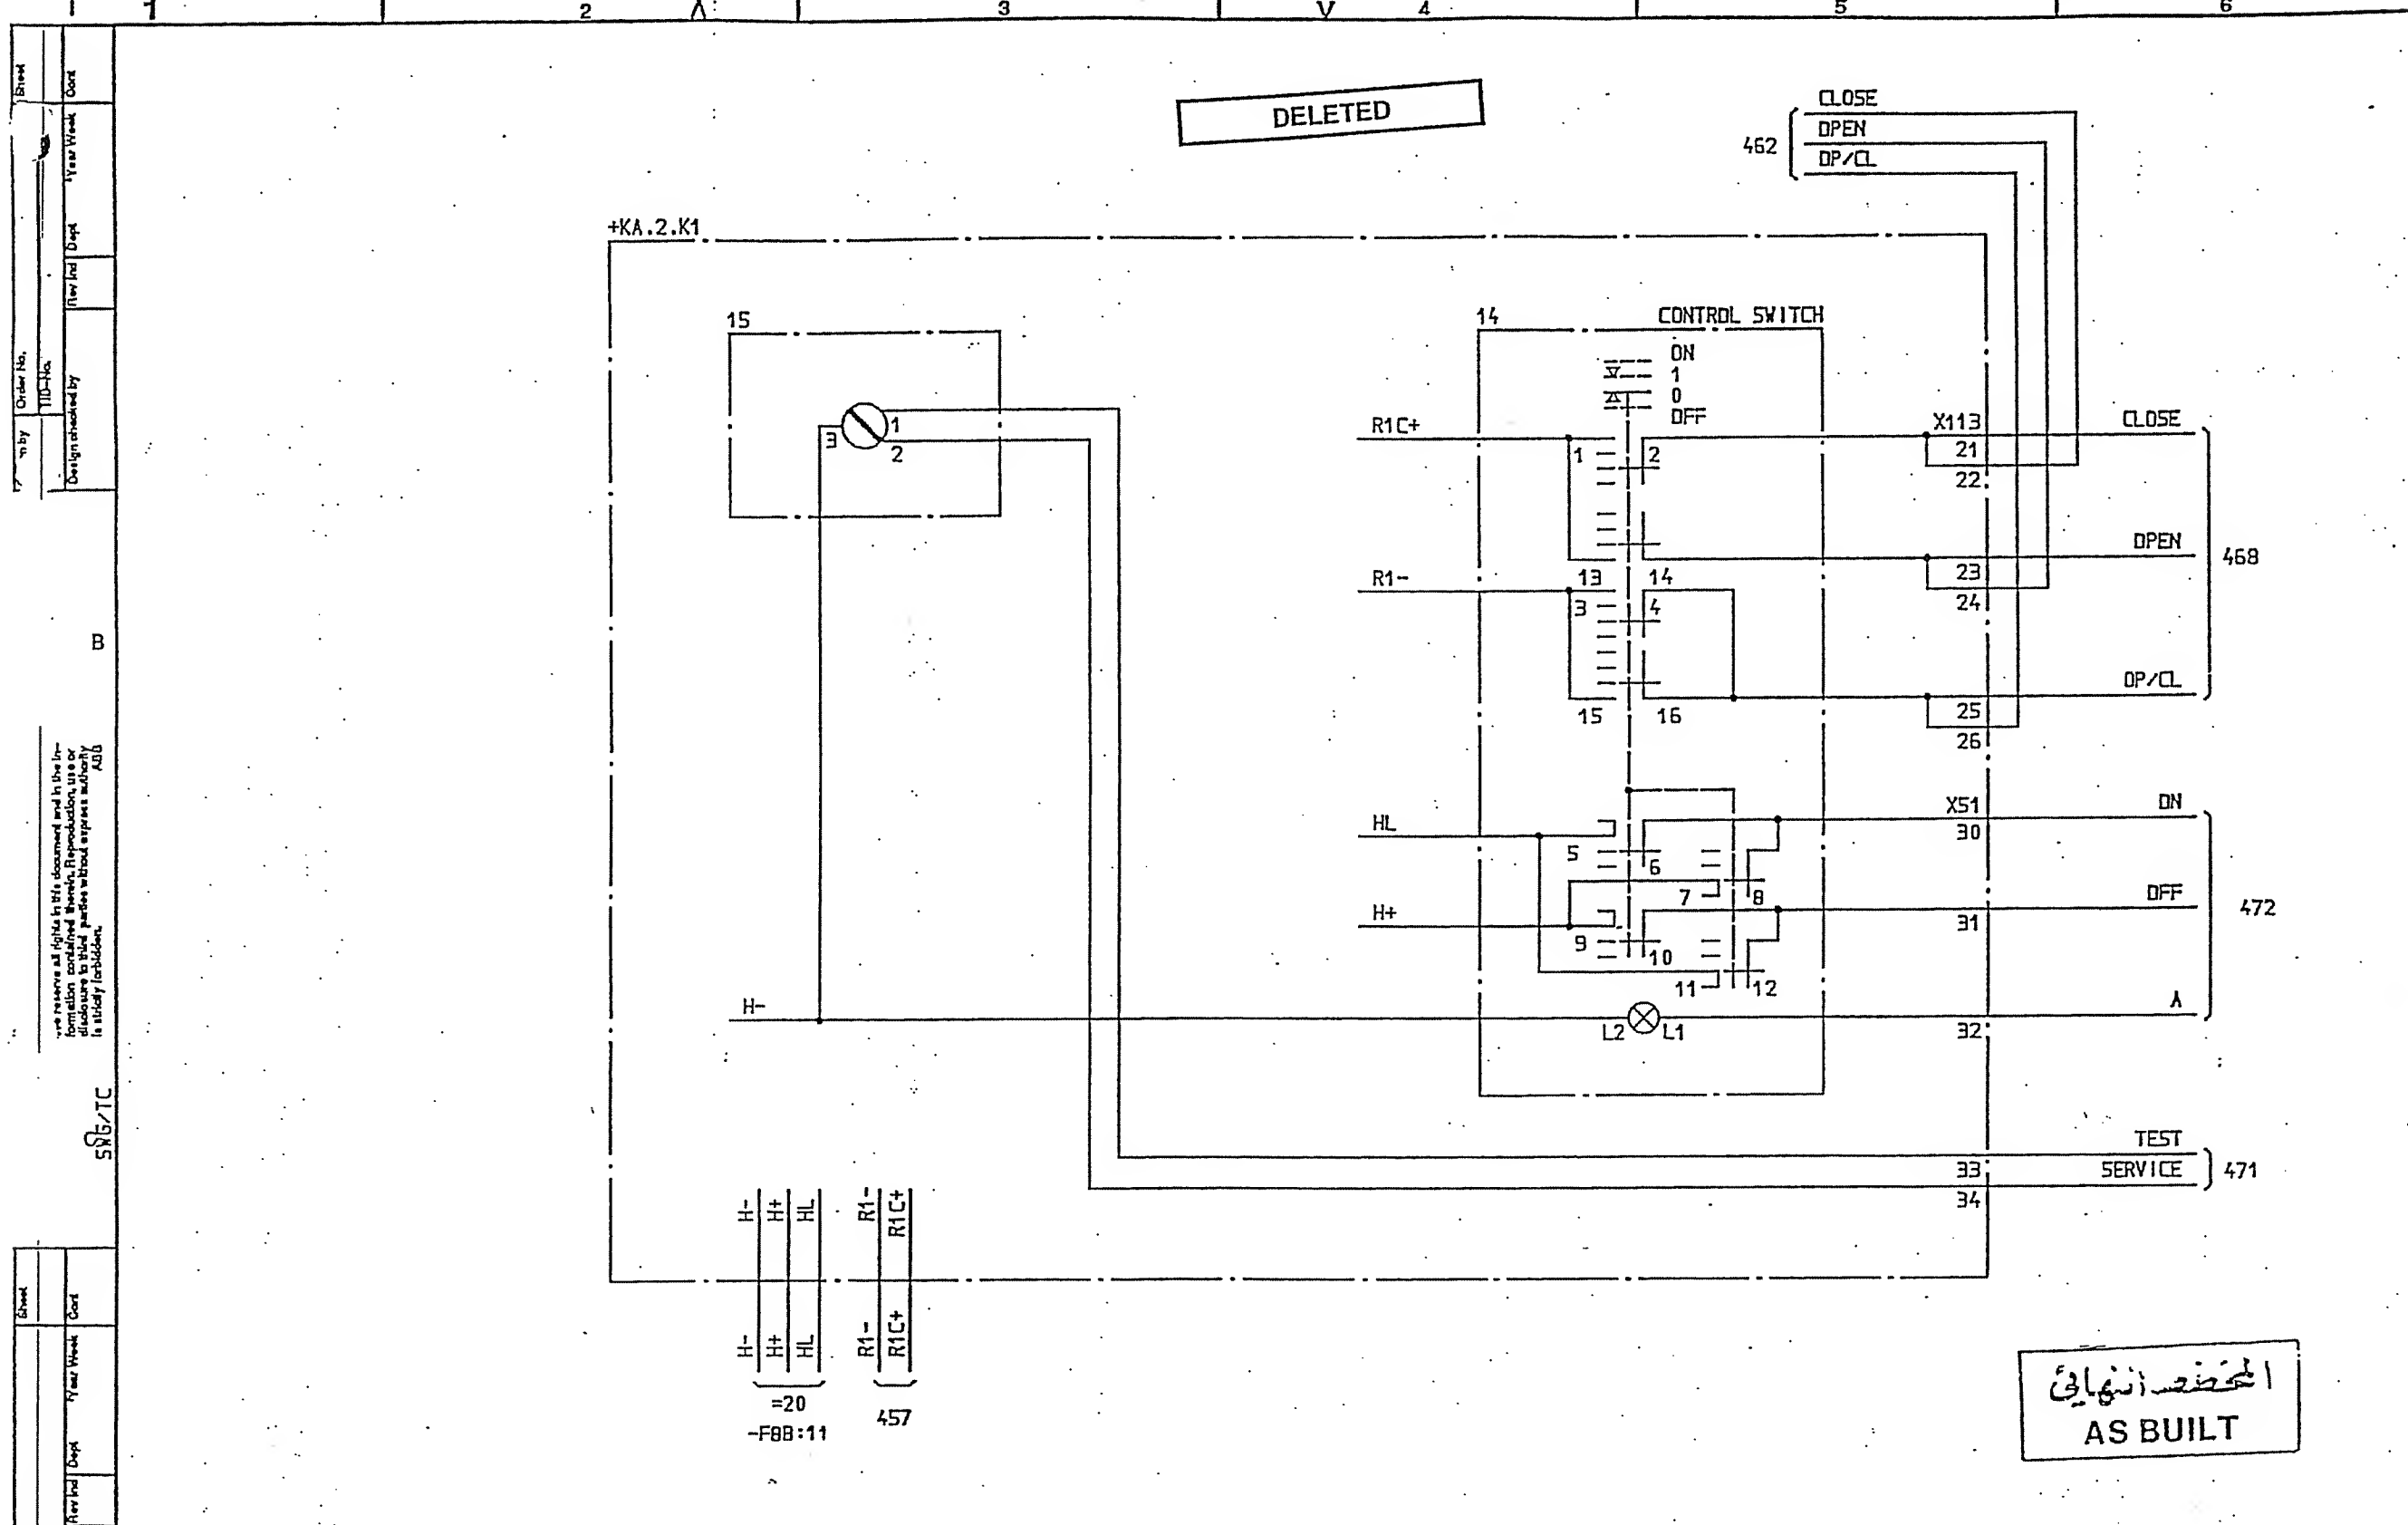

| | | | | | | | | | |
|---------------------------------|--|-------------------------------|--|----------------------------------|--|--|--|-------------------------------|--|
| SYMBOL ID /D:XL824028-FBR:490/0 | | DATE 91-06-05 09.31 | | Design checked by B NILSSON | | CIRCUIT DIAGRAM 5/5 8501 132/33kV SCECO CENTRAL SAUDI ARABIA | | How long Long 490 | |
| =10 | | 33kV INCOMING TRANSFORMER BAY | | Drawing checked by S STRIDMAN | | See by Dept TCF 90 08 | | How long Long 491 | |
| AS BUILT | | L5 91 21 | | Drawn by SK | | ABB HV SWITCHGEAR | | L 9743.1017 XL 824 028-FBR | |

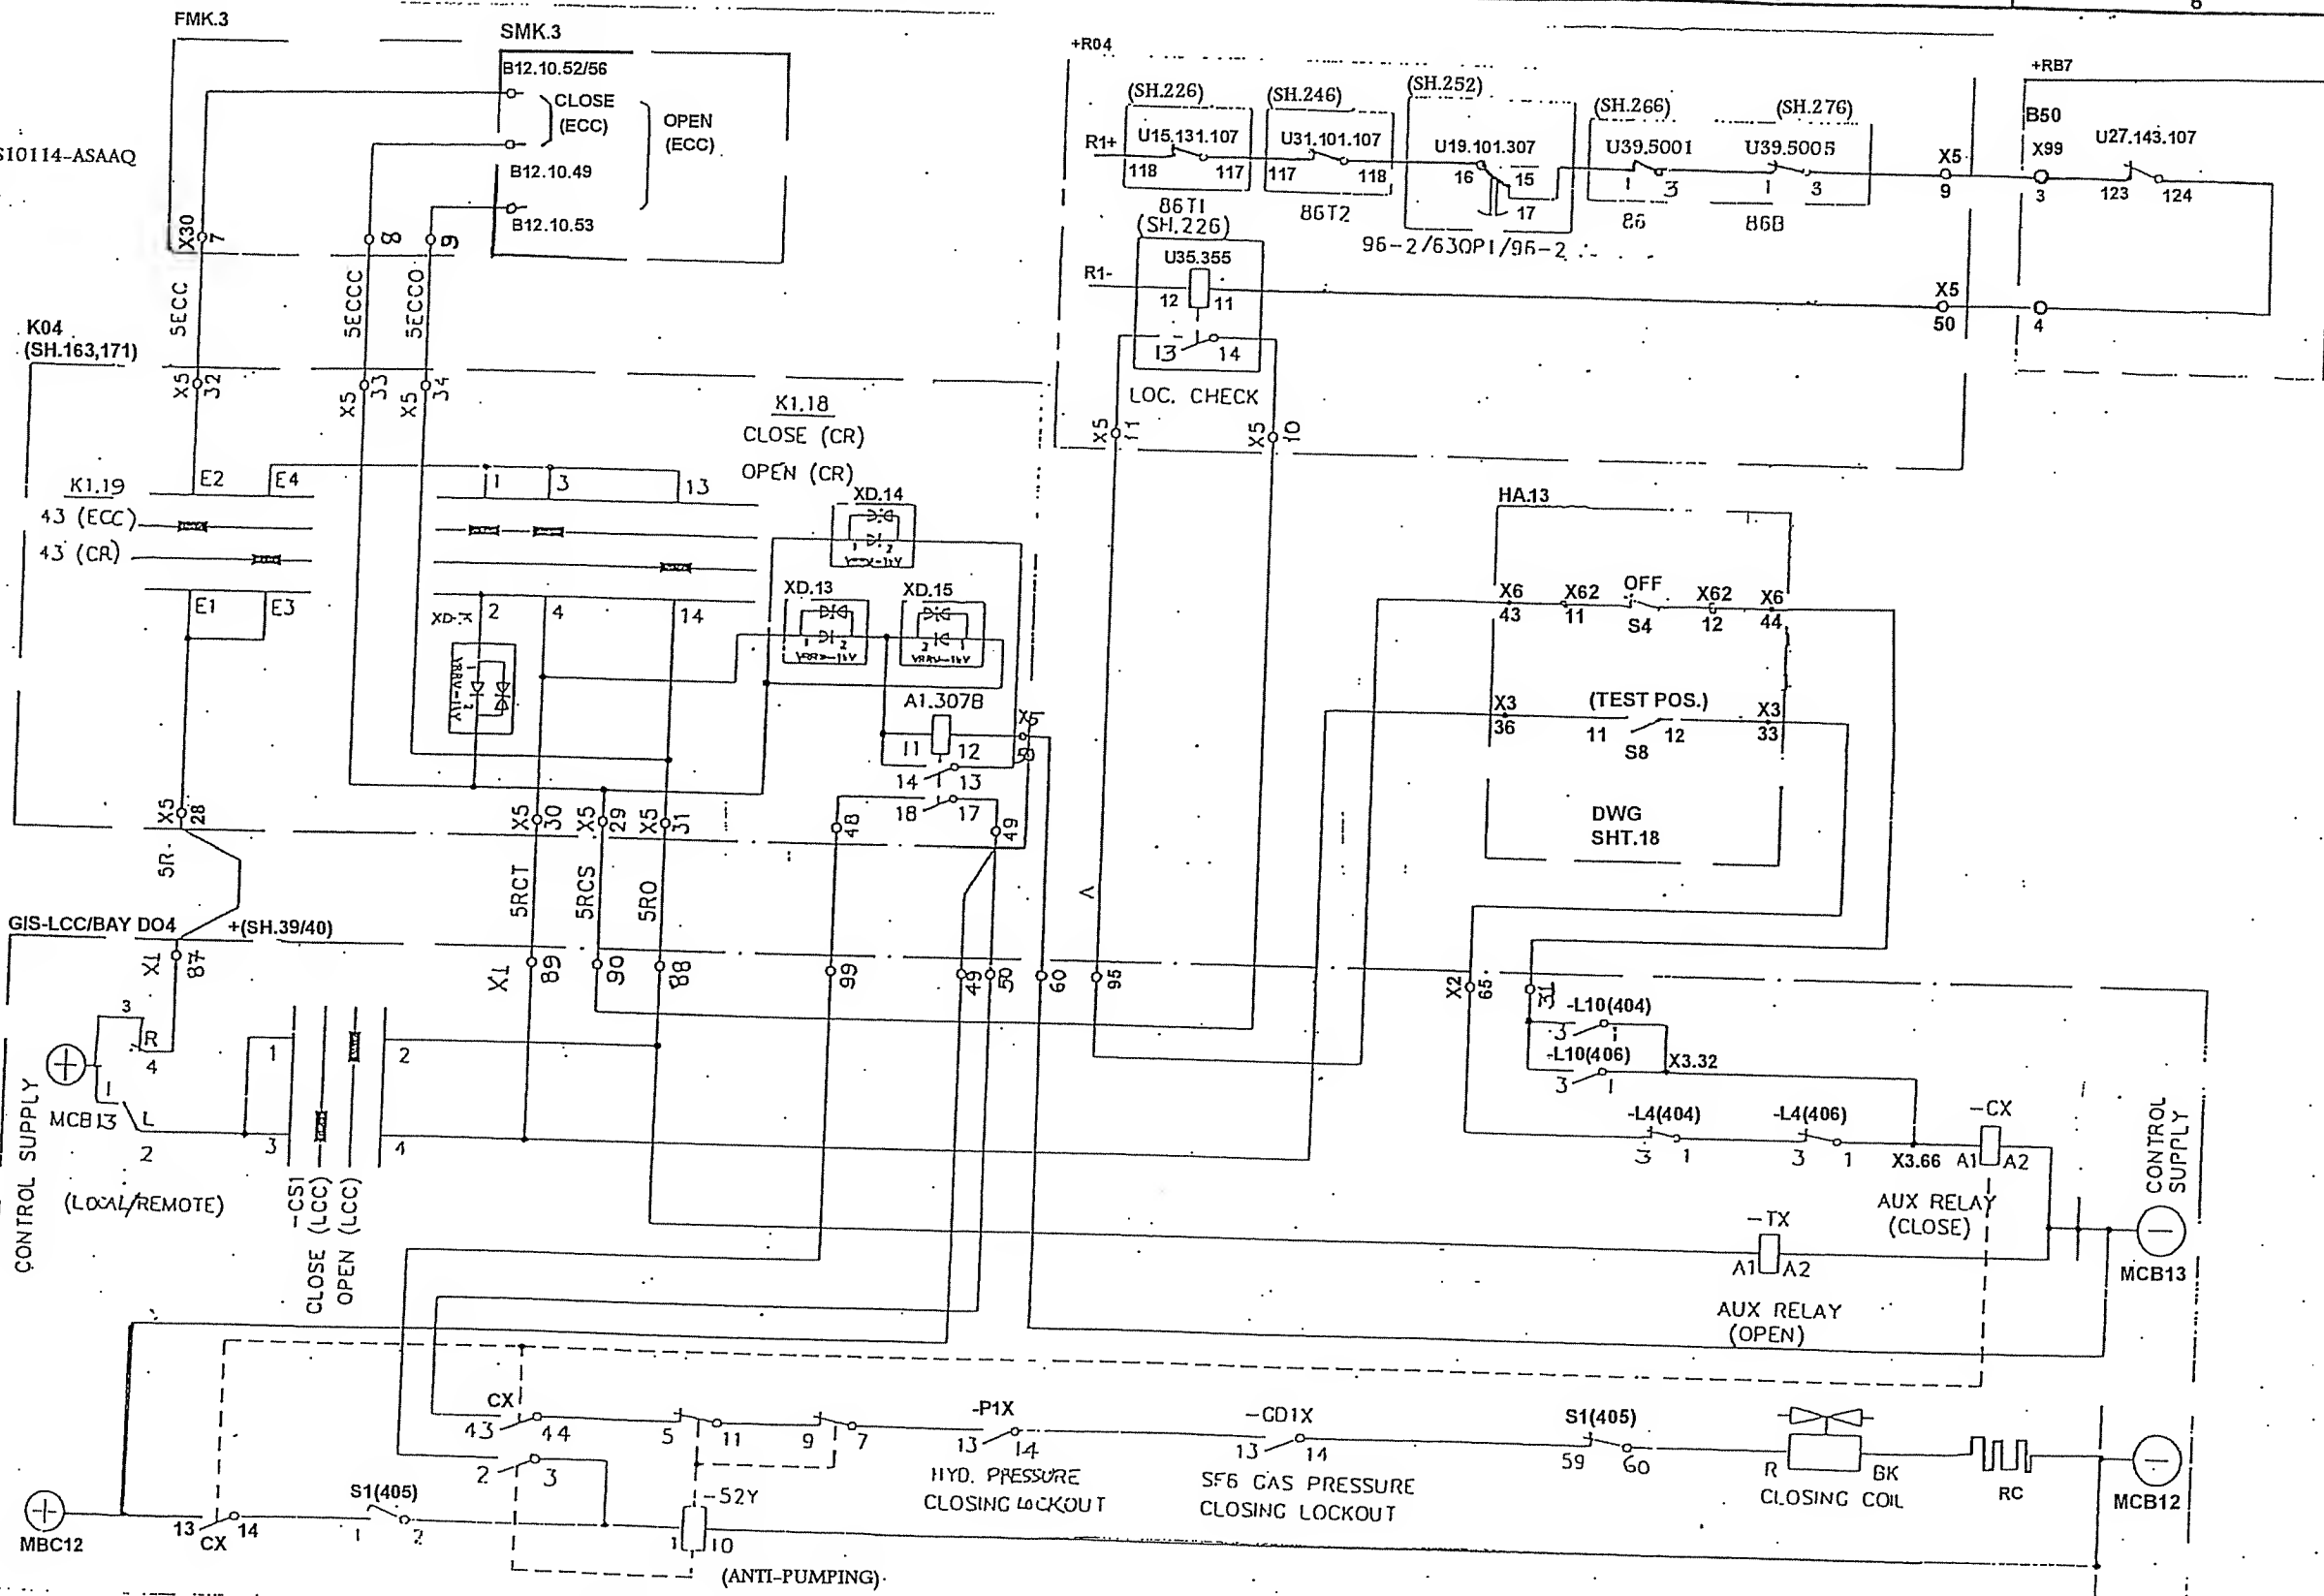DWG: S10114-ASAAQ
SH:27




SYMBOL

DATE 91-05-03 08.39

| | | | | |
|-------------------|--|---|---|---------------------------------------|
| <p>1 AS-BUILT</p> | <p>3 132/33kV GRID TRANSFORMER 132kV CB.405 CLOSING CIRCUIT =GT2</p> | <p>Design checked by B NILSSON Drawing checked by S STRIDSHAN Drawn by SK</p> | <p>CIRCUIT DIAGRAM S/S 8501 132/33kV SCECO CENTRAL SAUDI ARABIA ABB HV SWITCHGEAR</p> | <p>L 9743.1017 XL 824 028-FBR</p> |
|-------------------|--|---|---|---------------------------------------|

491
492

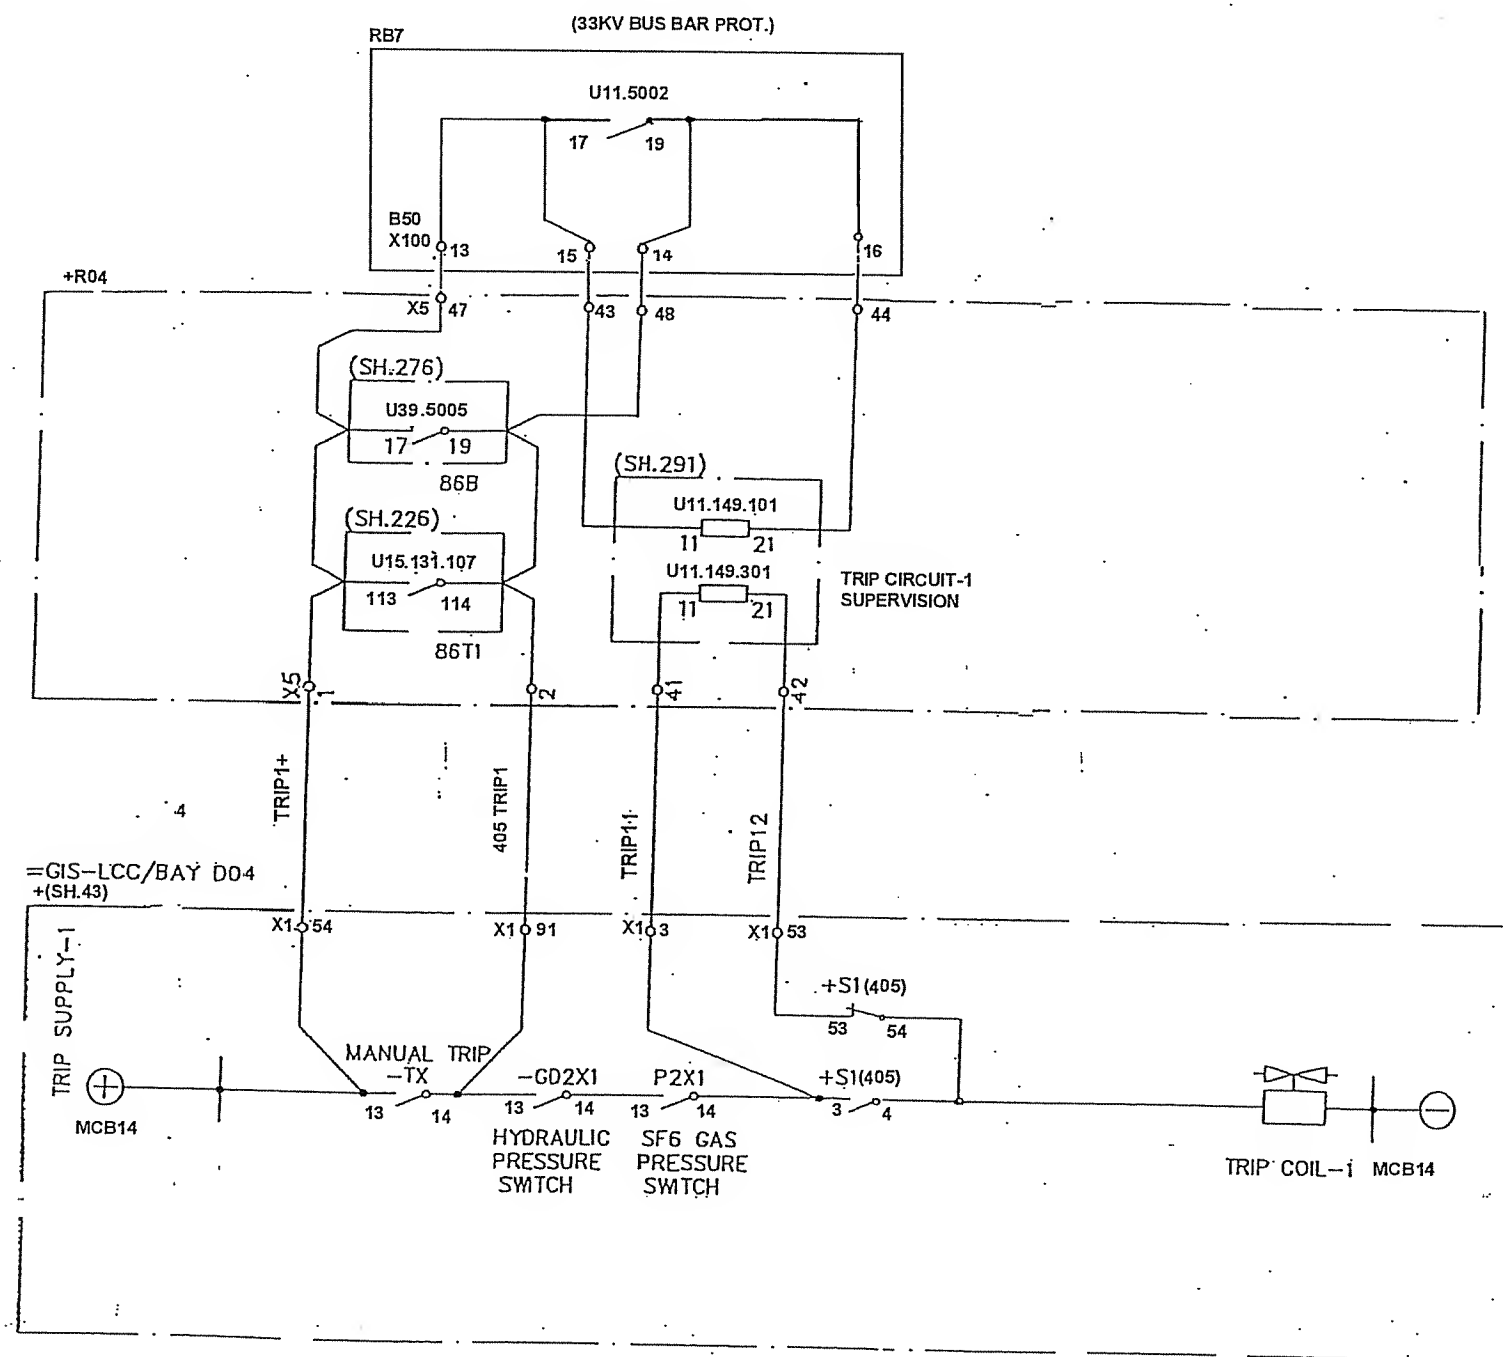Information of this document is for reference only. It is not to be used for any purpose without the written authority of the concerned authority. All rights reserved.



Based on

Issued 01 44 KARTHIK
 Issued 01 44 KAMAL AL-MUHANNA
 8501, 132/33/13.5KV
 -CRB, CONTRACT NO. 516/20/3

132/33KV GRID TRANSFORMER-2
 BREAKER-405 TRIPPING COIL-1


=GT2

Rev'd by AL

HV SWITCHGEAR

L9743-1017
 XL 824 028-FBR

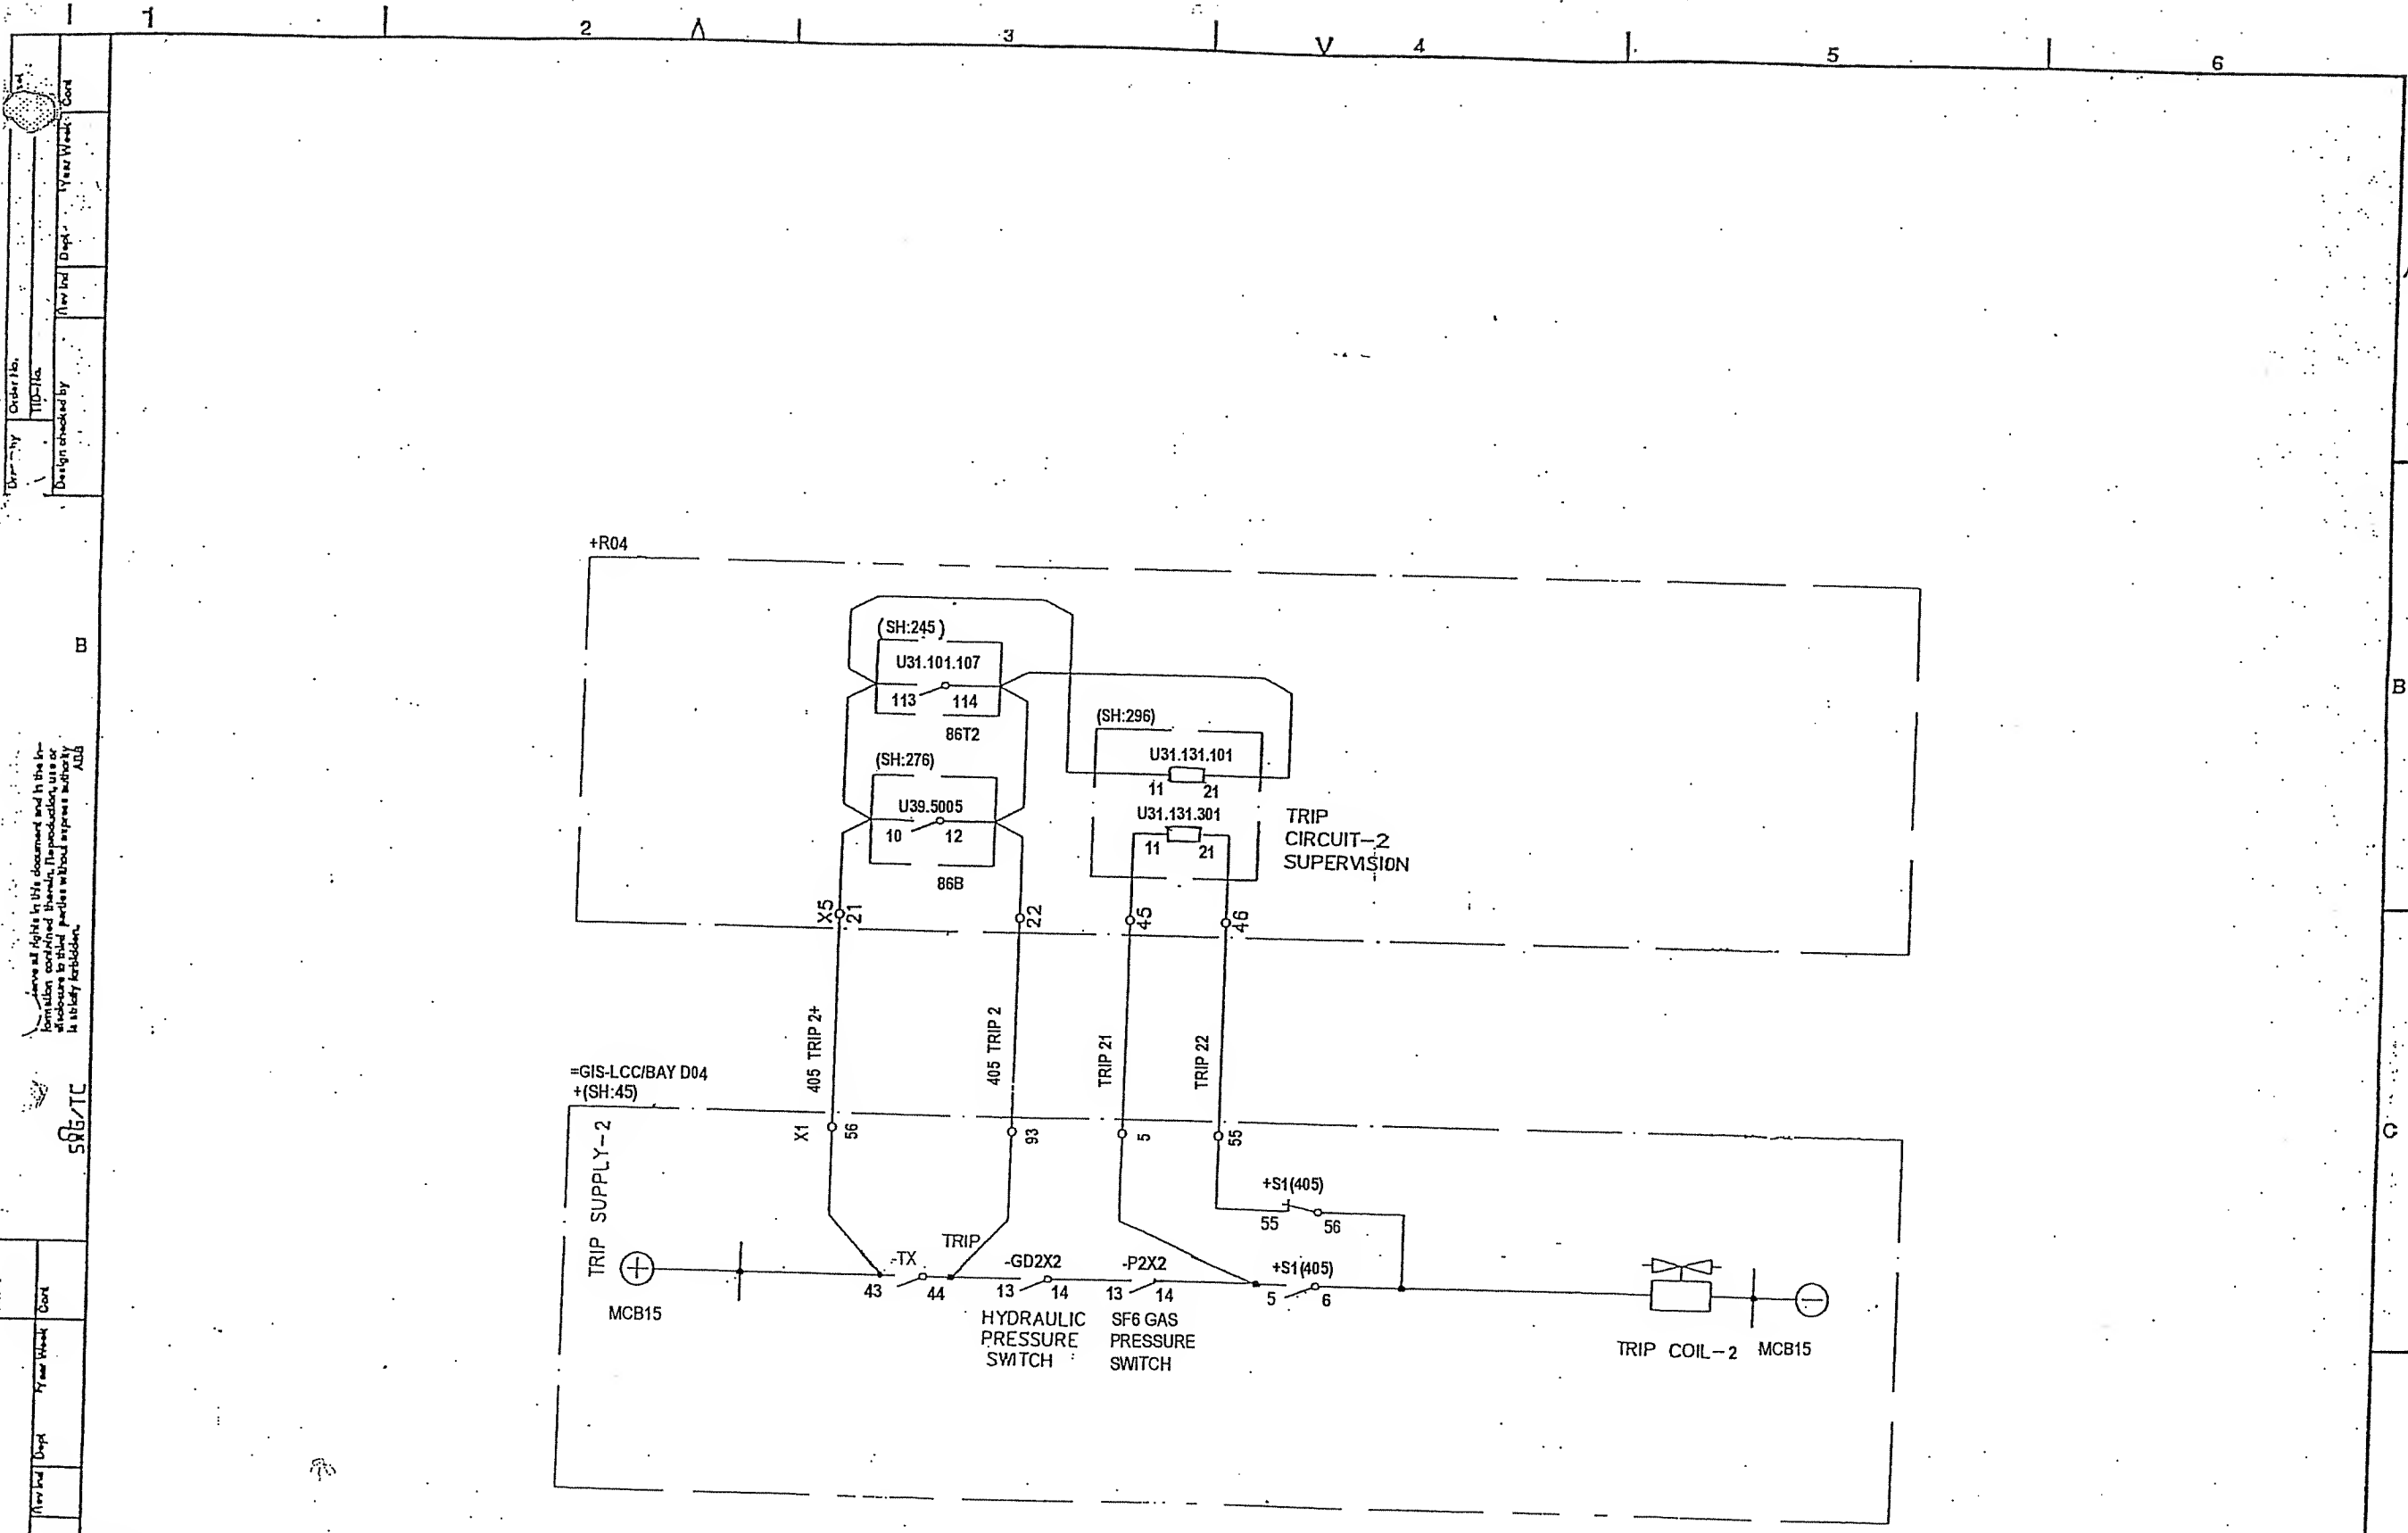SHT 492
 CONT 493




SYMBOL

DATE 91-05-03 08.39

| | |
|-------------------|-----------|
| Drawn by | Sheet |
| Design checked by | Year Work |
| Drawn by | Year Work |
| Design checked by | Year Work |
| Drawn by | Year Work |
| Design checked by | Year Work |

| | | | | | | | | |
|---|----------|----|----------|---|-----------------------------------|--|---------|-------|
| 1 | AS-BUILT | LS | 91-21... | 132/33KV GRID TRANSFORMER-2 BREAKER-405 TRIPPING COIL-2 =GT2 | Design checked by B NILSSON | CIRCUIT DIAGRAM S/S 8501 132/33kV SCECO CENTRAL SAUDI ARABIA | Rev Ino | Sheet |
| 2 | | | | | Drawing checked by S STRIDSMAN | ABB HV SWITCHGEAR | Long | Sheet |
| | | | | | Drawn by SK | TCF 90 08 | Rev Ino | Sheet |
| | | | | | | | 1 | 493 |
| | | | | | | | | 494 |

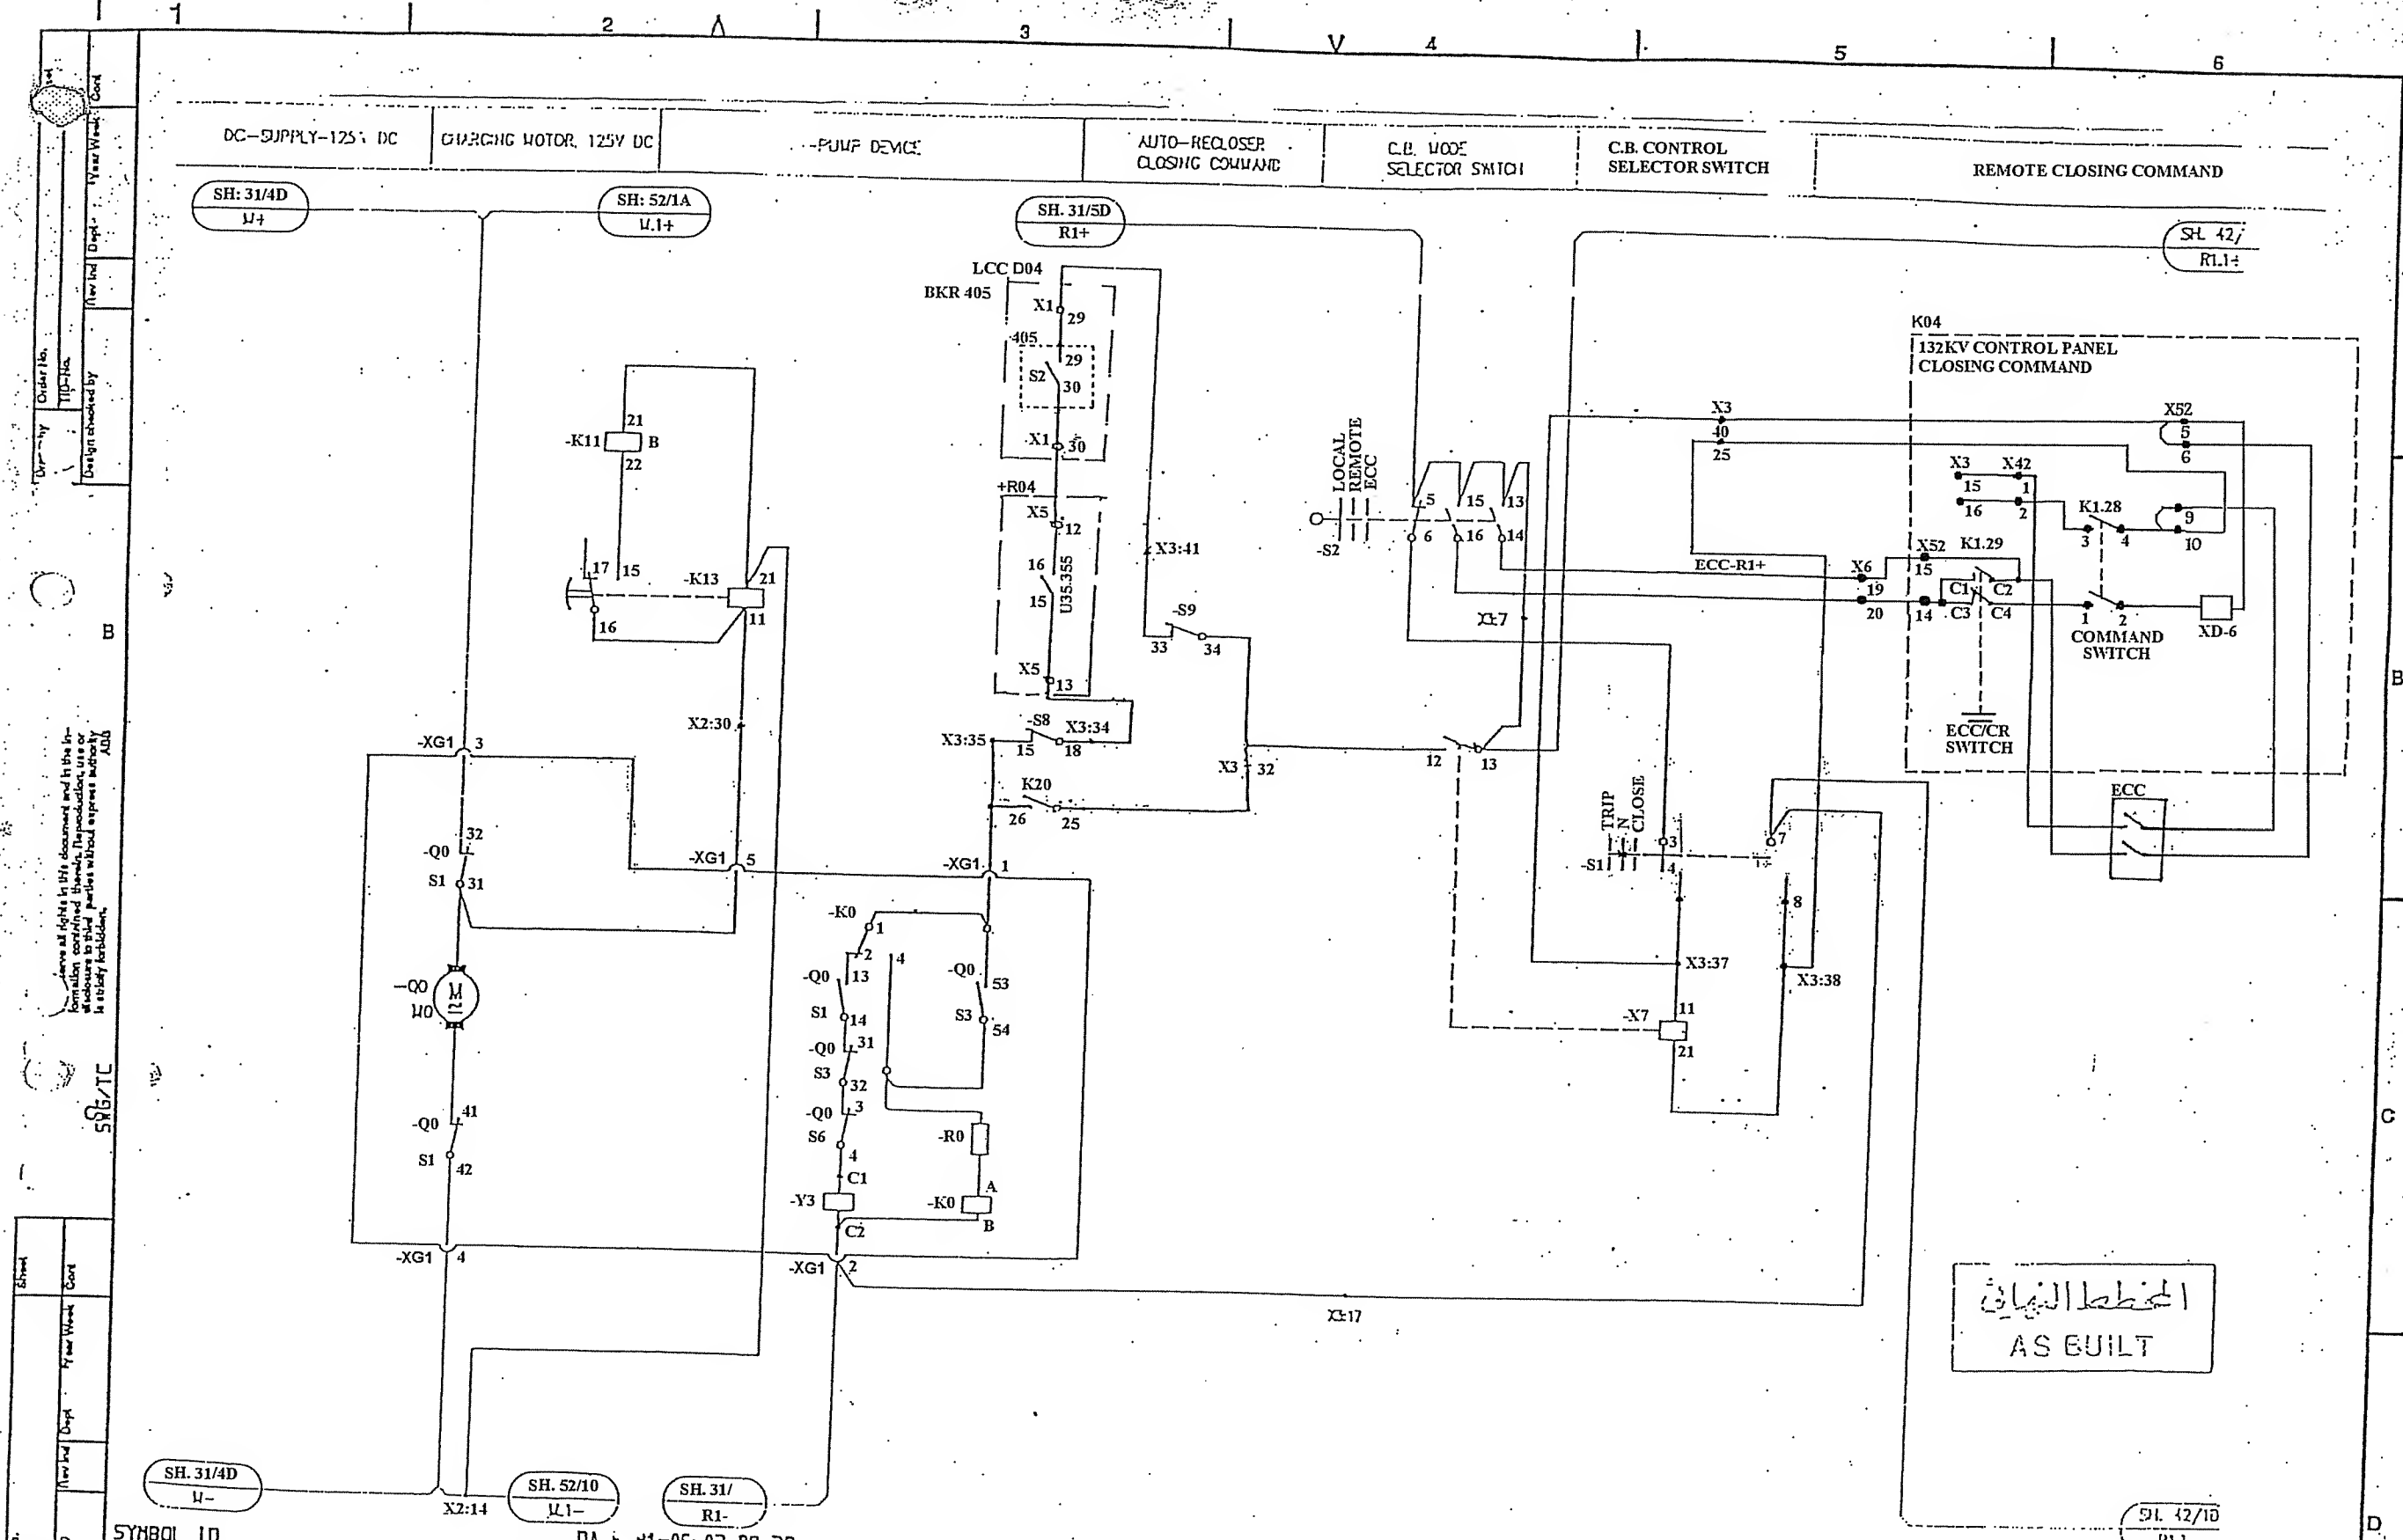
132/33KV



الخطة البنية
AS BUILT

SYMBOL ID
DA.E J1-05-03 08.39


| | | | | | | | | | |
|---|----------|----|-------|---|--|-----------------------------------|--|-------------------------------|-----------------------|
| 1 | A5-BUILT | L5 | 91-21 | 3 | 132/33kV GRID TRANSFORMER- 2 BEAKER-475 =GT2 | Design checked by B NILSSON | CIRCUIT DIAGRAM S/S 8501 132/33kV SCECO CENTRAL SAUDI ARABIA | L 9743.1017 XL 824 028-FBR | Rev Ino. Sheet 494 |
| 2 | | | | 4 | | Drawing checked by S STRIDSHAN | ABB HV SWITCHGEAR | 1 | Rev Ino. Sheet 495 |
| 3 | | | | 5 | | Drawn by SK | TCF 90 08 | | |

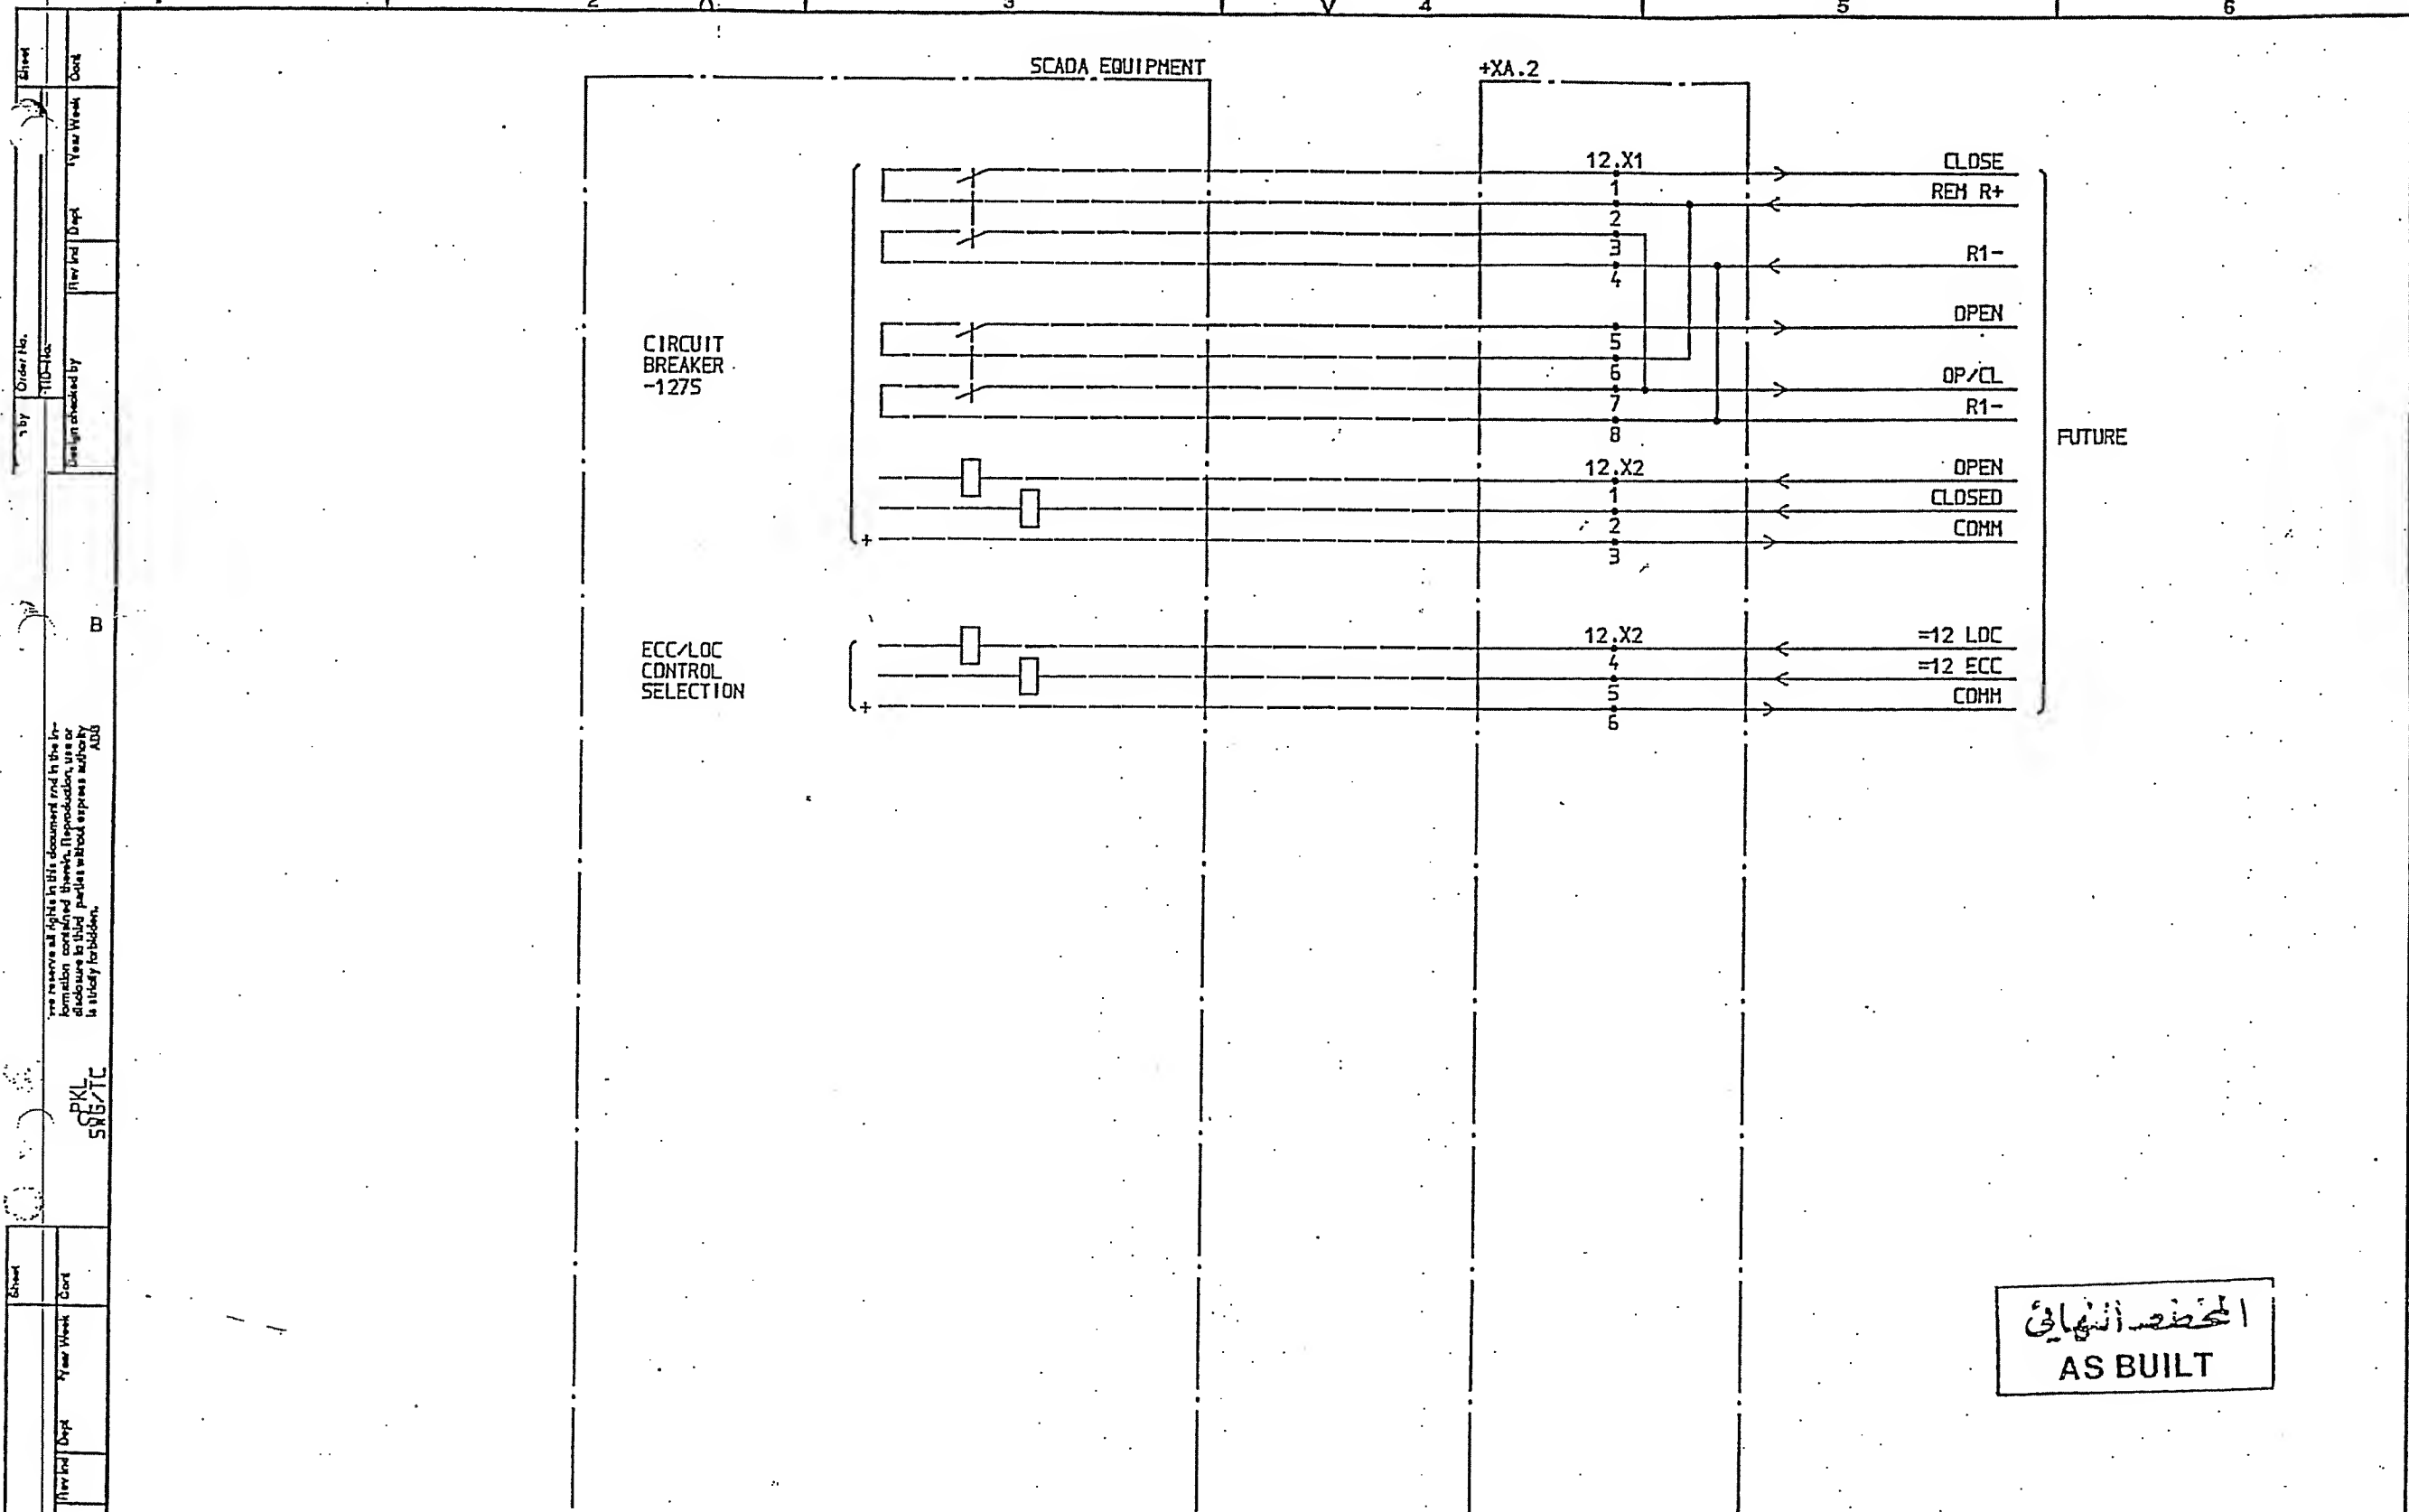

المخطط النهائي
AS BUILT

| | | | | | | | | | | | |
|---------------------------------|--|---------------------|--|-----------------------------------|--|------------------------------------|--|----------------|--|--|--|
| SYMBOL ID /0:XL824028-FBR:562/0 | | DATE 91-06-05 09.31 | | | | | | | | | |
| =12 | | 33kV FUTURE LINE | | Design checked by B NILSSON | | CIRCUIT DIAGRAM | | Rev Int Sheet | | | |
| AS BUILT | | LS 91 21 | | Drawing checked by S STRIDSHAN | | S/S 8501 132/33kV | | Lang Sheet | | | |
| SCADA INTERFACE EQUIPMENT | | Appd Year Week | | Drawn by IA | | SCECO CENTRAL SAUDI ARABIA. | | Rev Int Sheet | | | |
| | | | | | | ABB HV SWITCHGEAR | | L 9743.1017 | | | |
| | | | | | | See by Dept Year Week TCF 90 10 | | XL 824 028-FBR | | | |
| | | | | | | | | 1 512 | | | |

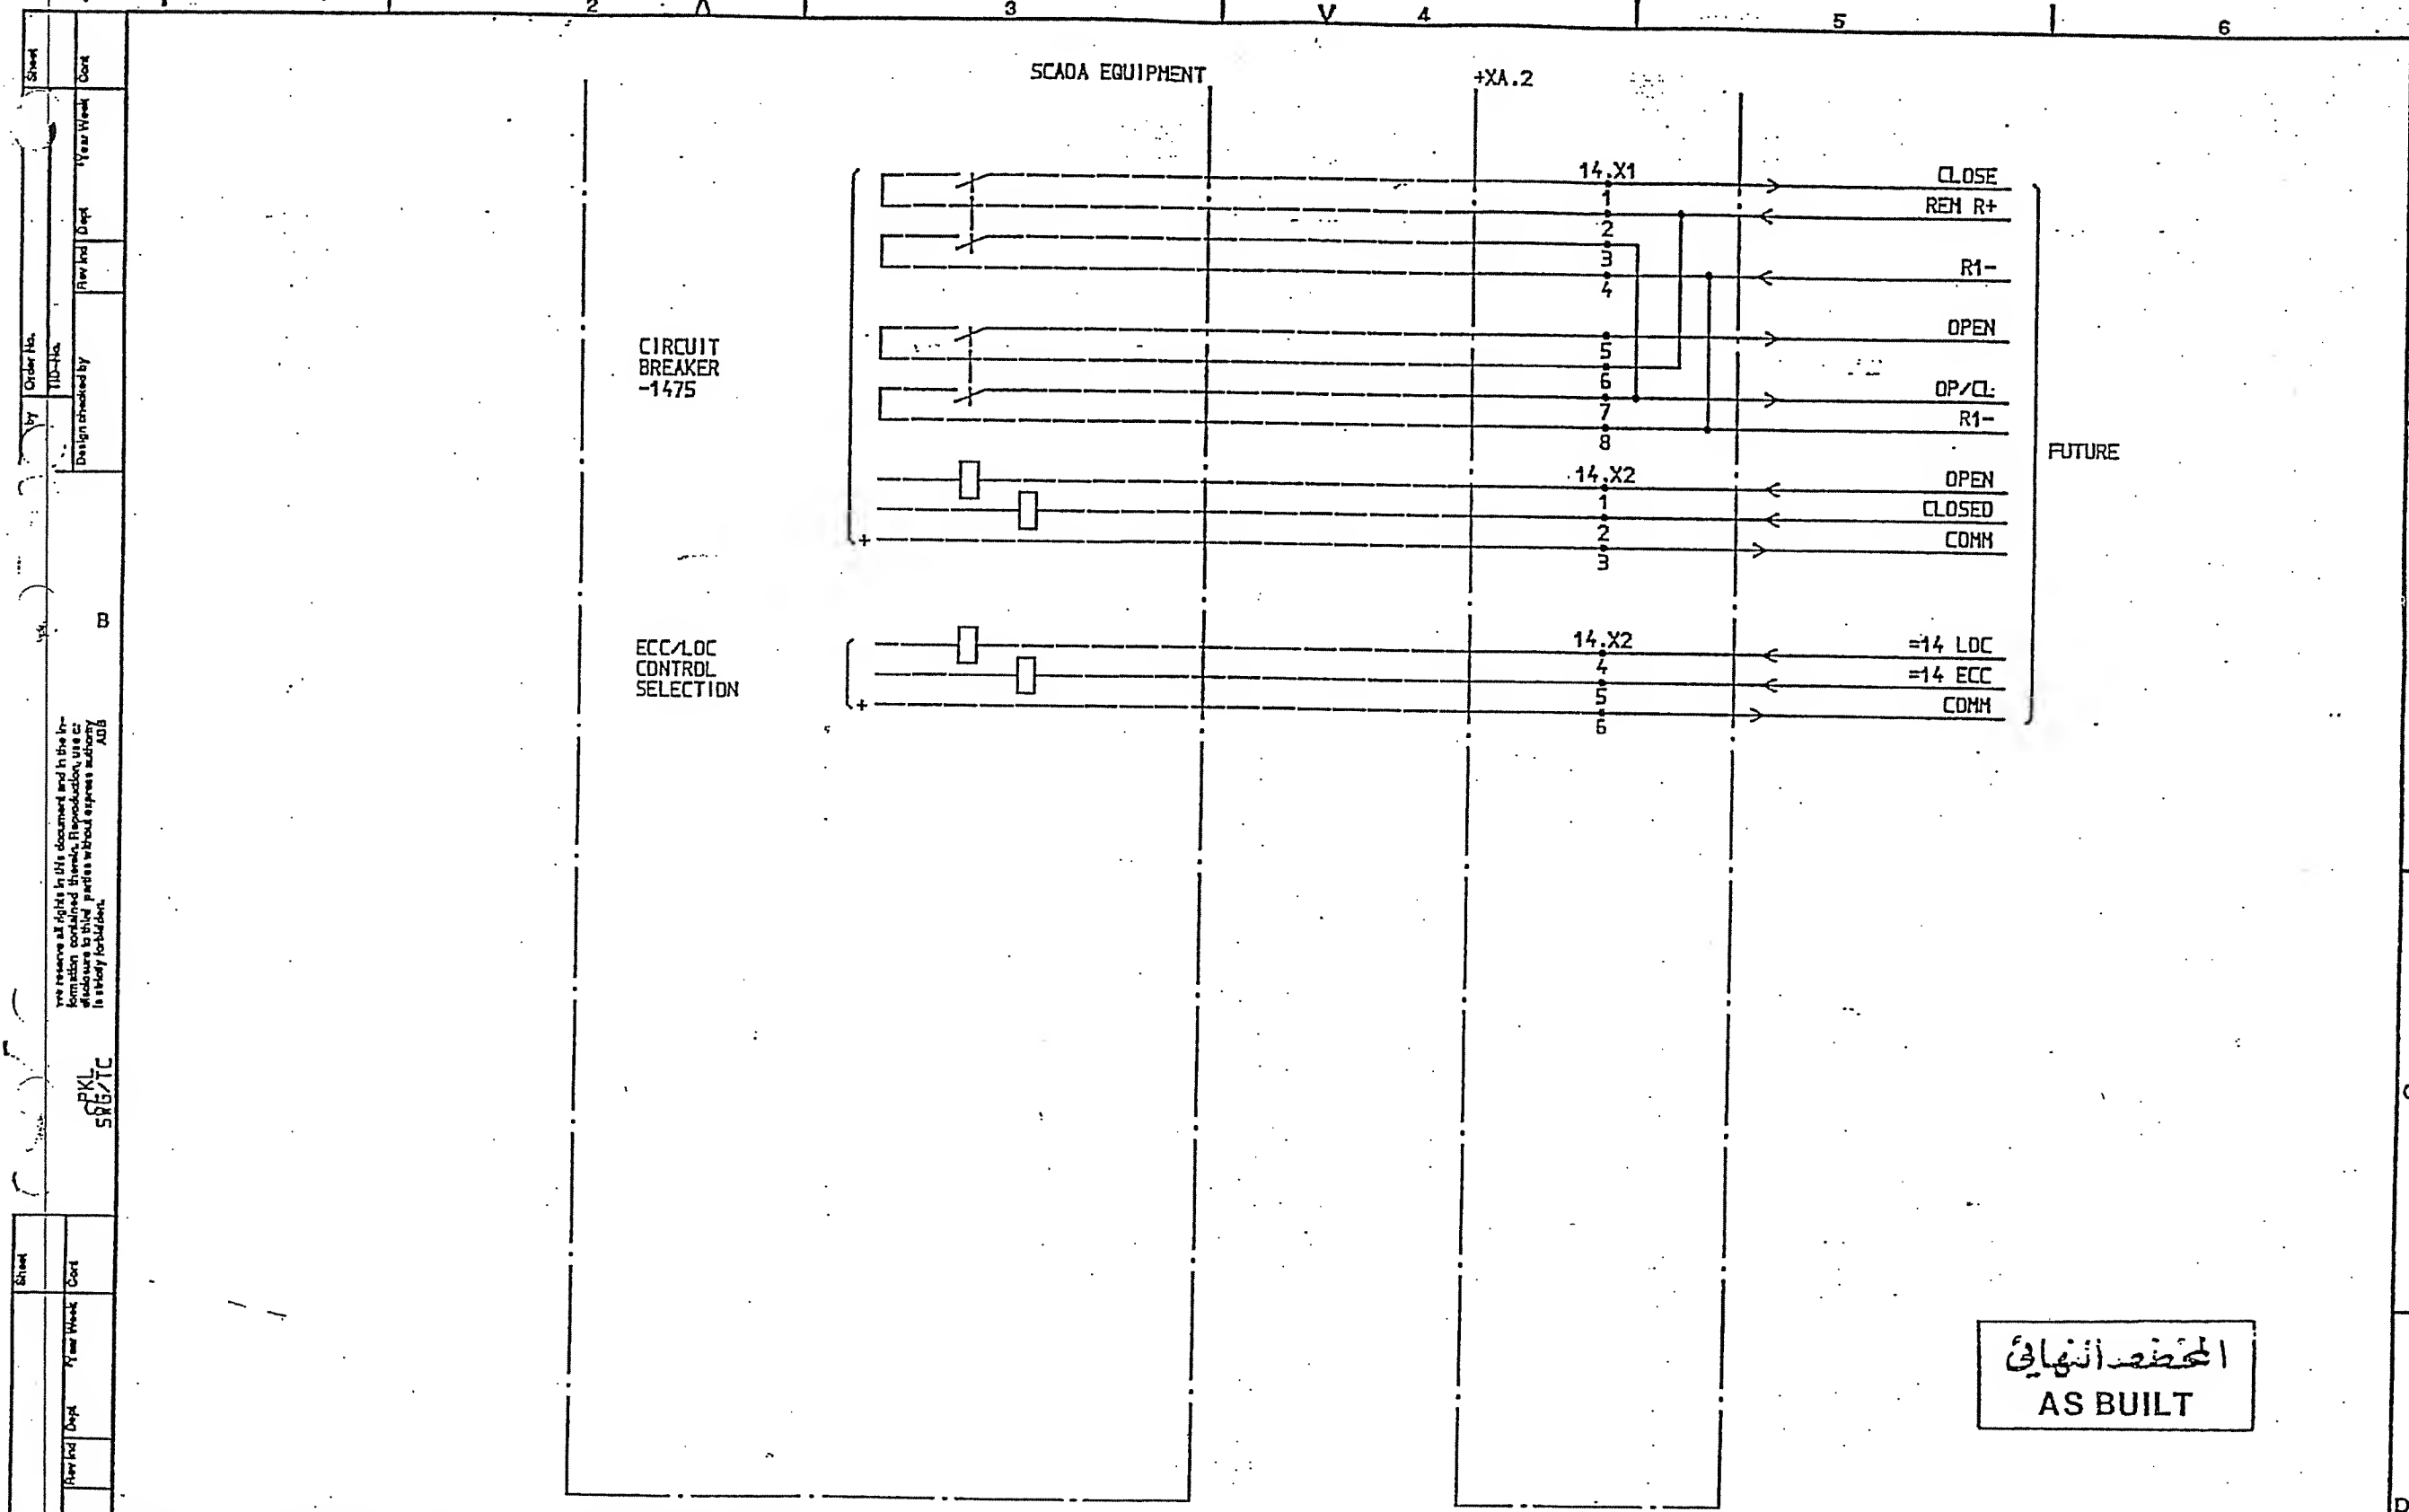ABB




المخطط النهائي
AS BUILT

| | | | | | |
|---------------------------------|----------|---------------------|------|----------------------------|------|
| SYMBOL ID /D:XL824028-FBR:612/0 | | DATE 91-06-05 09.31 | | | |
| Design checked by | Rev Ind | Dept | Year | Week | Cont |
| 1 | AS BUILT | LS | 91 | 21 | |
| 2 | | | | | |
| =14 | | 33kV FUTURE LINE | | SCADA INTERFACE EQUIPMENT | |
| Design checked by | | B NILSSON | | CIRCUIT DIAGRAM | |
| Drawing checked by | | S STRIDSMAN | | S/S 8501 132/33kV | |
| Drawn by | | IA | | SCECO CENTRAL SAUDI ARABIA | |
| Rev Ind | | TCF | | ABB HV SWITCHGEAR | |
| Rev Ind | | 90 | | 10 | |
| L 9743.1017 | | XL 824 028-FBR | | Long | |
| 1 | | 651 | | Sheet | |
| 1 | | 651 | | Cont | |

ADD


المحظوظ النهائي
AS BUILT

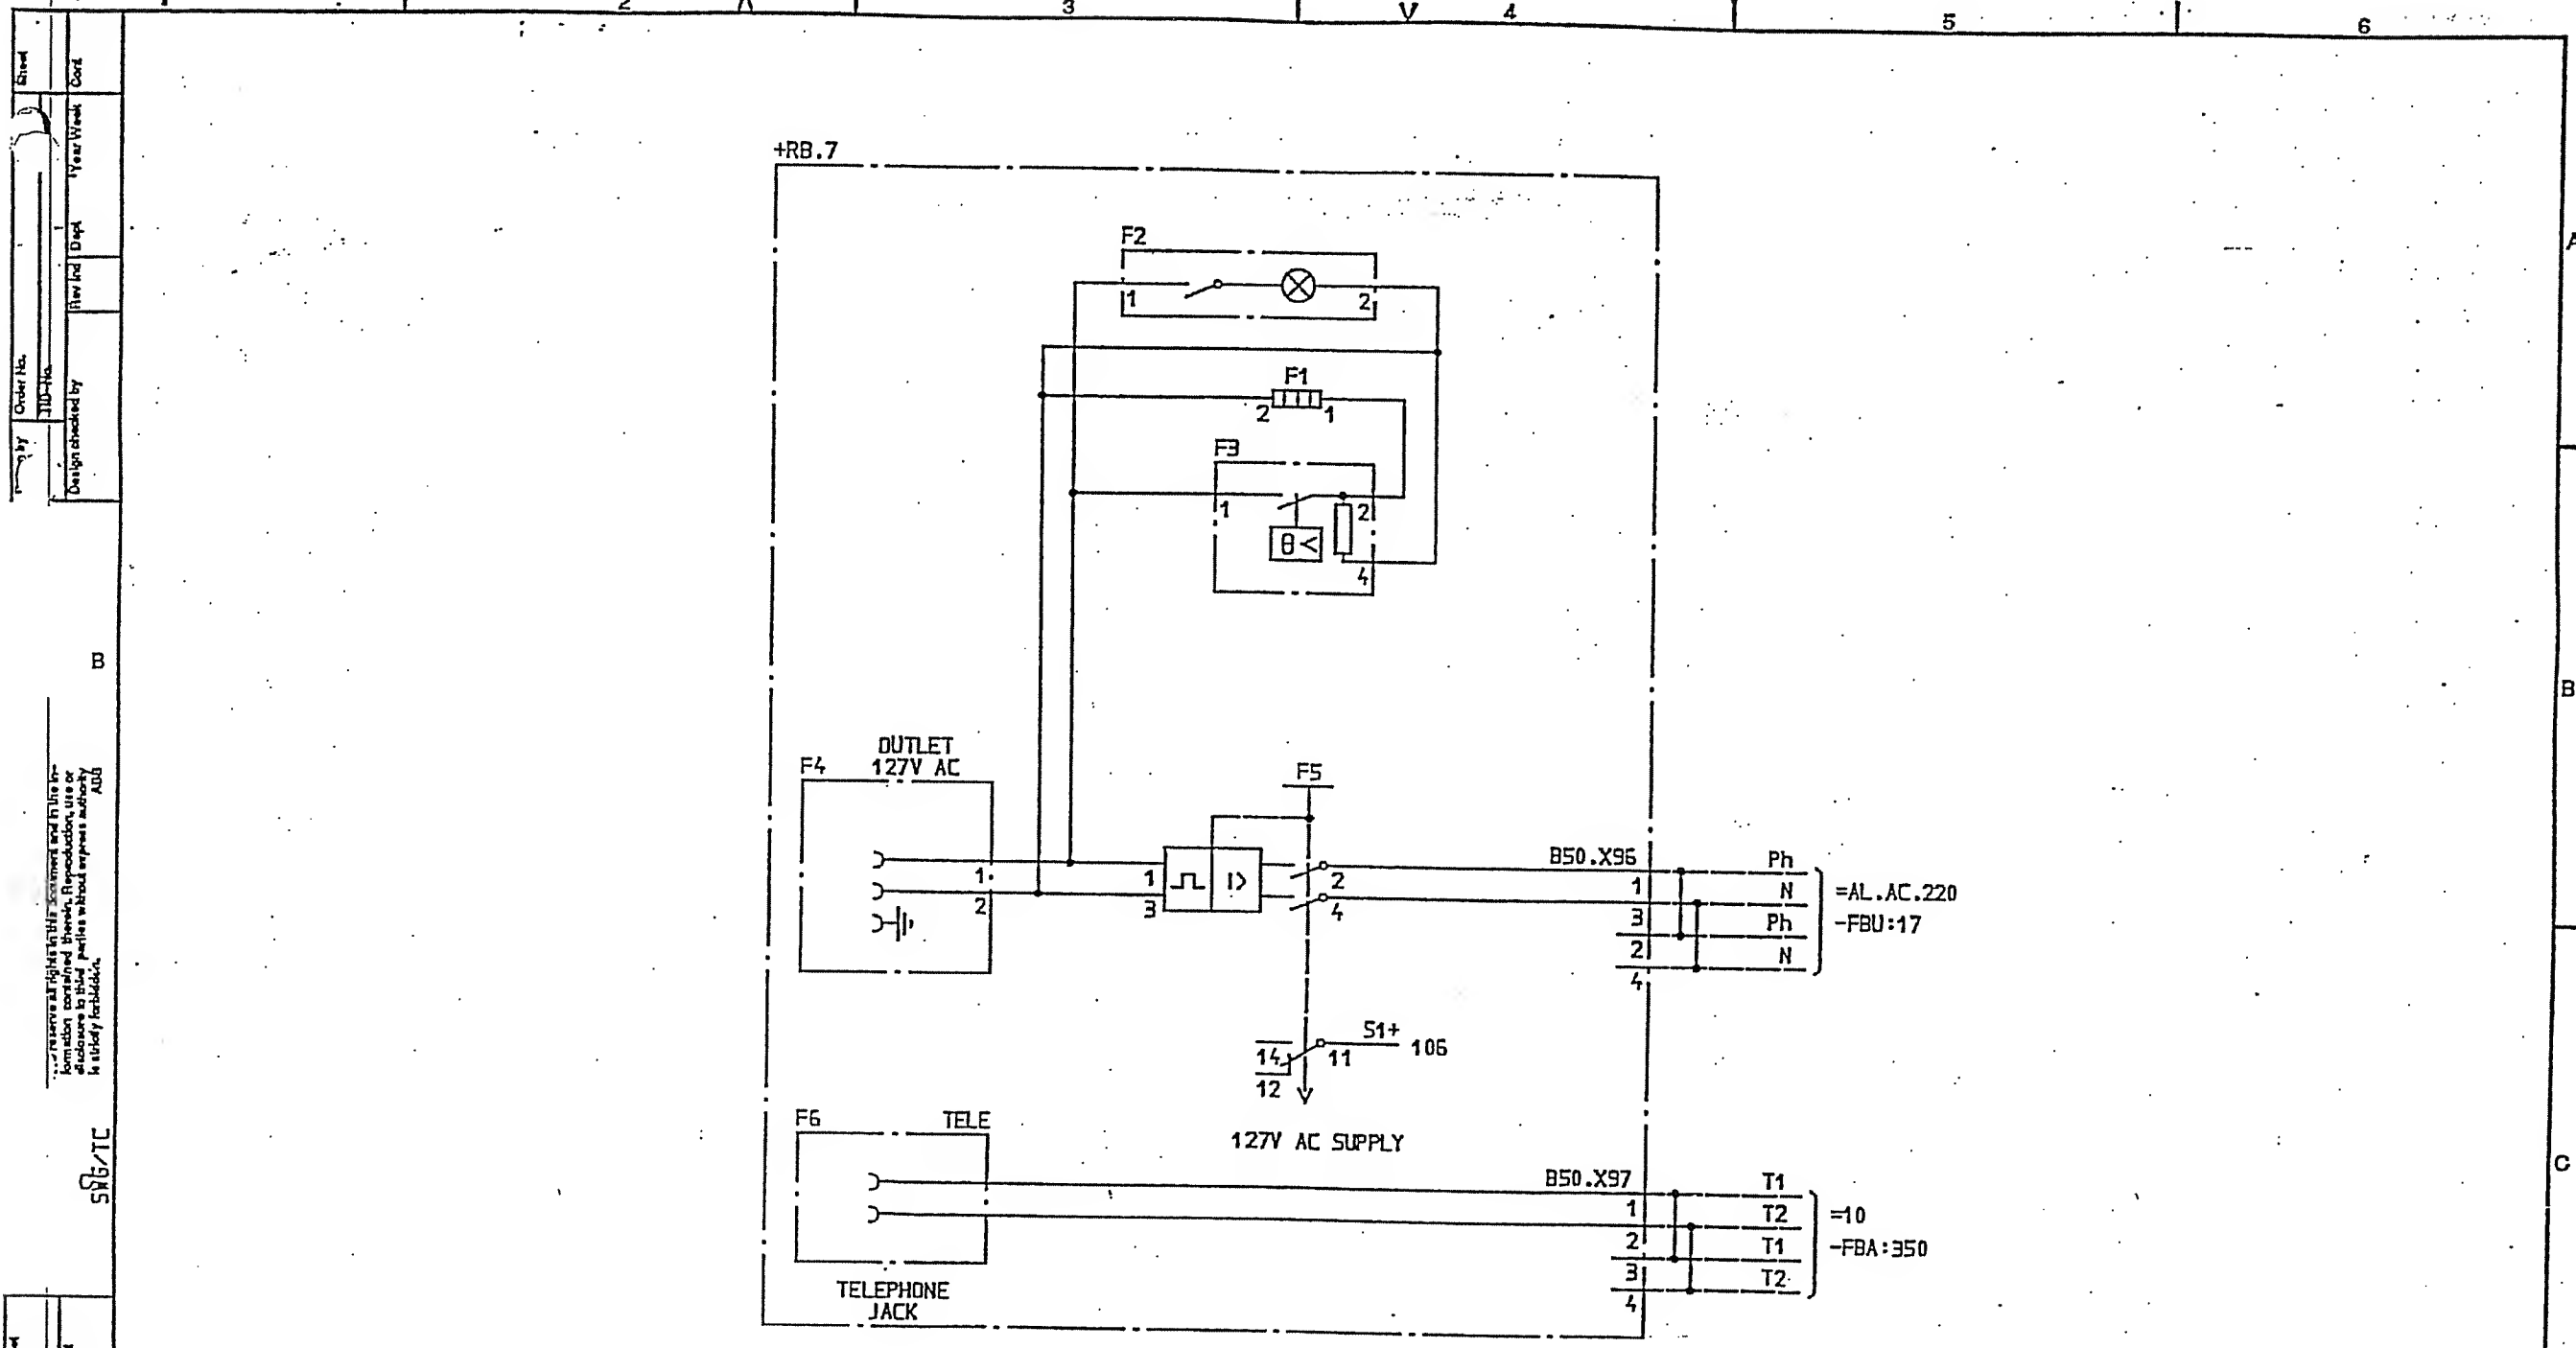
[illegible]



المخطط النهائي
AS BUILT

| | | | | | | | | | | | | | | | | | | | | | | | | | | | |
|---------------------------------|--|---------------------|--|-----|--|--------------------|--|----------------------------------|--|----------------------|--|-----------------|--|-------------------|--|----------------------------|--|-------------------|--|-------------|--|----------------|--|---|--|-----|--|
| SYMBOL ID /D:XL824028-F8R:654/0 | | DATE 91-06-05 09.31 | | =71 | | 33kV BUSBAR ZONE 1 | | AC AND TELEPHONE JACKET CIRCUITS | | VOLTAGE DISTRIBUTION | | CIRCUIT DIAGRAM | | S/S 8501 132/33kV | | SCECO CENTRAL SAUDI ARABIA | | ABB HV SWITCHGEAR | | L 9743.1017 | | XL 824 028-FBR | | 1 | | 655 | |
| AS BUILT | | 91 21 | | =71 | | 33kV BUSBAR ZONE 1 | | AC AND TELEPHONE JACKET CIRCUITS | | VOLTAGE DISTRIBUTION | | CIRCUIT DIAGRAM | | S/S 8501 132/33kV | | SCECO CENTRAL SAUDI ARABIA | | ABB HV SWITCHGEAR | | L 9743.1017 | | XL 824 028-FBR | | 1 | | 655 | |
| AS BUILT | | 91 21 | | =71 | | 33kV BUSBAR ZONE 1 | | AC AND TELEPHONE JACKET CIRCUITS | | VOLTAGE DISTRIBUTION | | CIRCUIT DIAGRAM | | S/S 8501 132/33kV | | SCECO CENTRAL SAUDI ARABIA | | ABB HV SWITCHGEAR | | L 9743.1017 | | XL 824 028-FBR | | 1 | | 655 | |

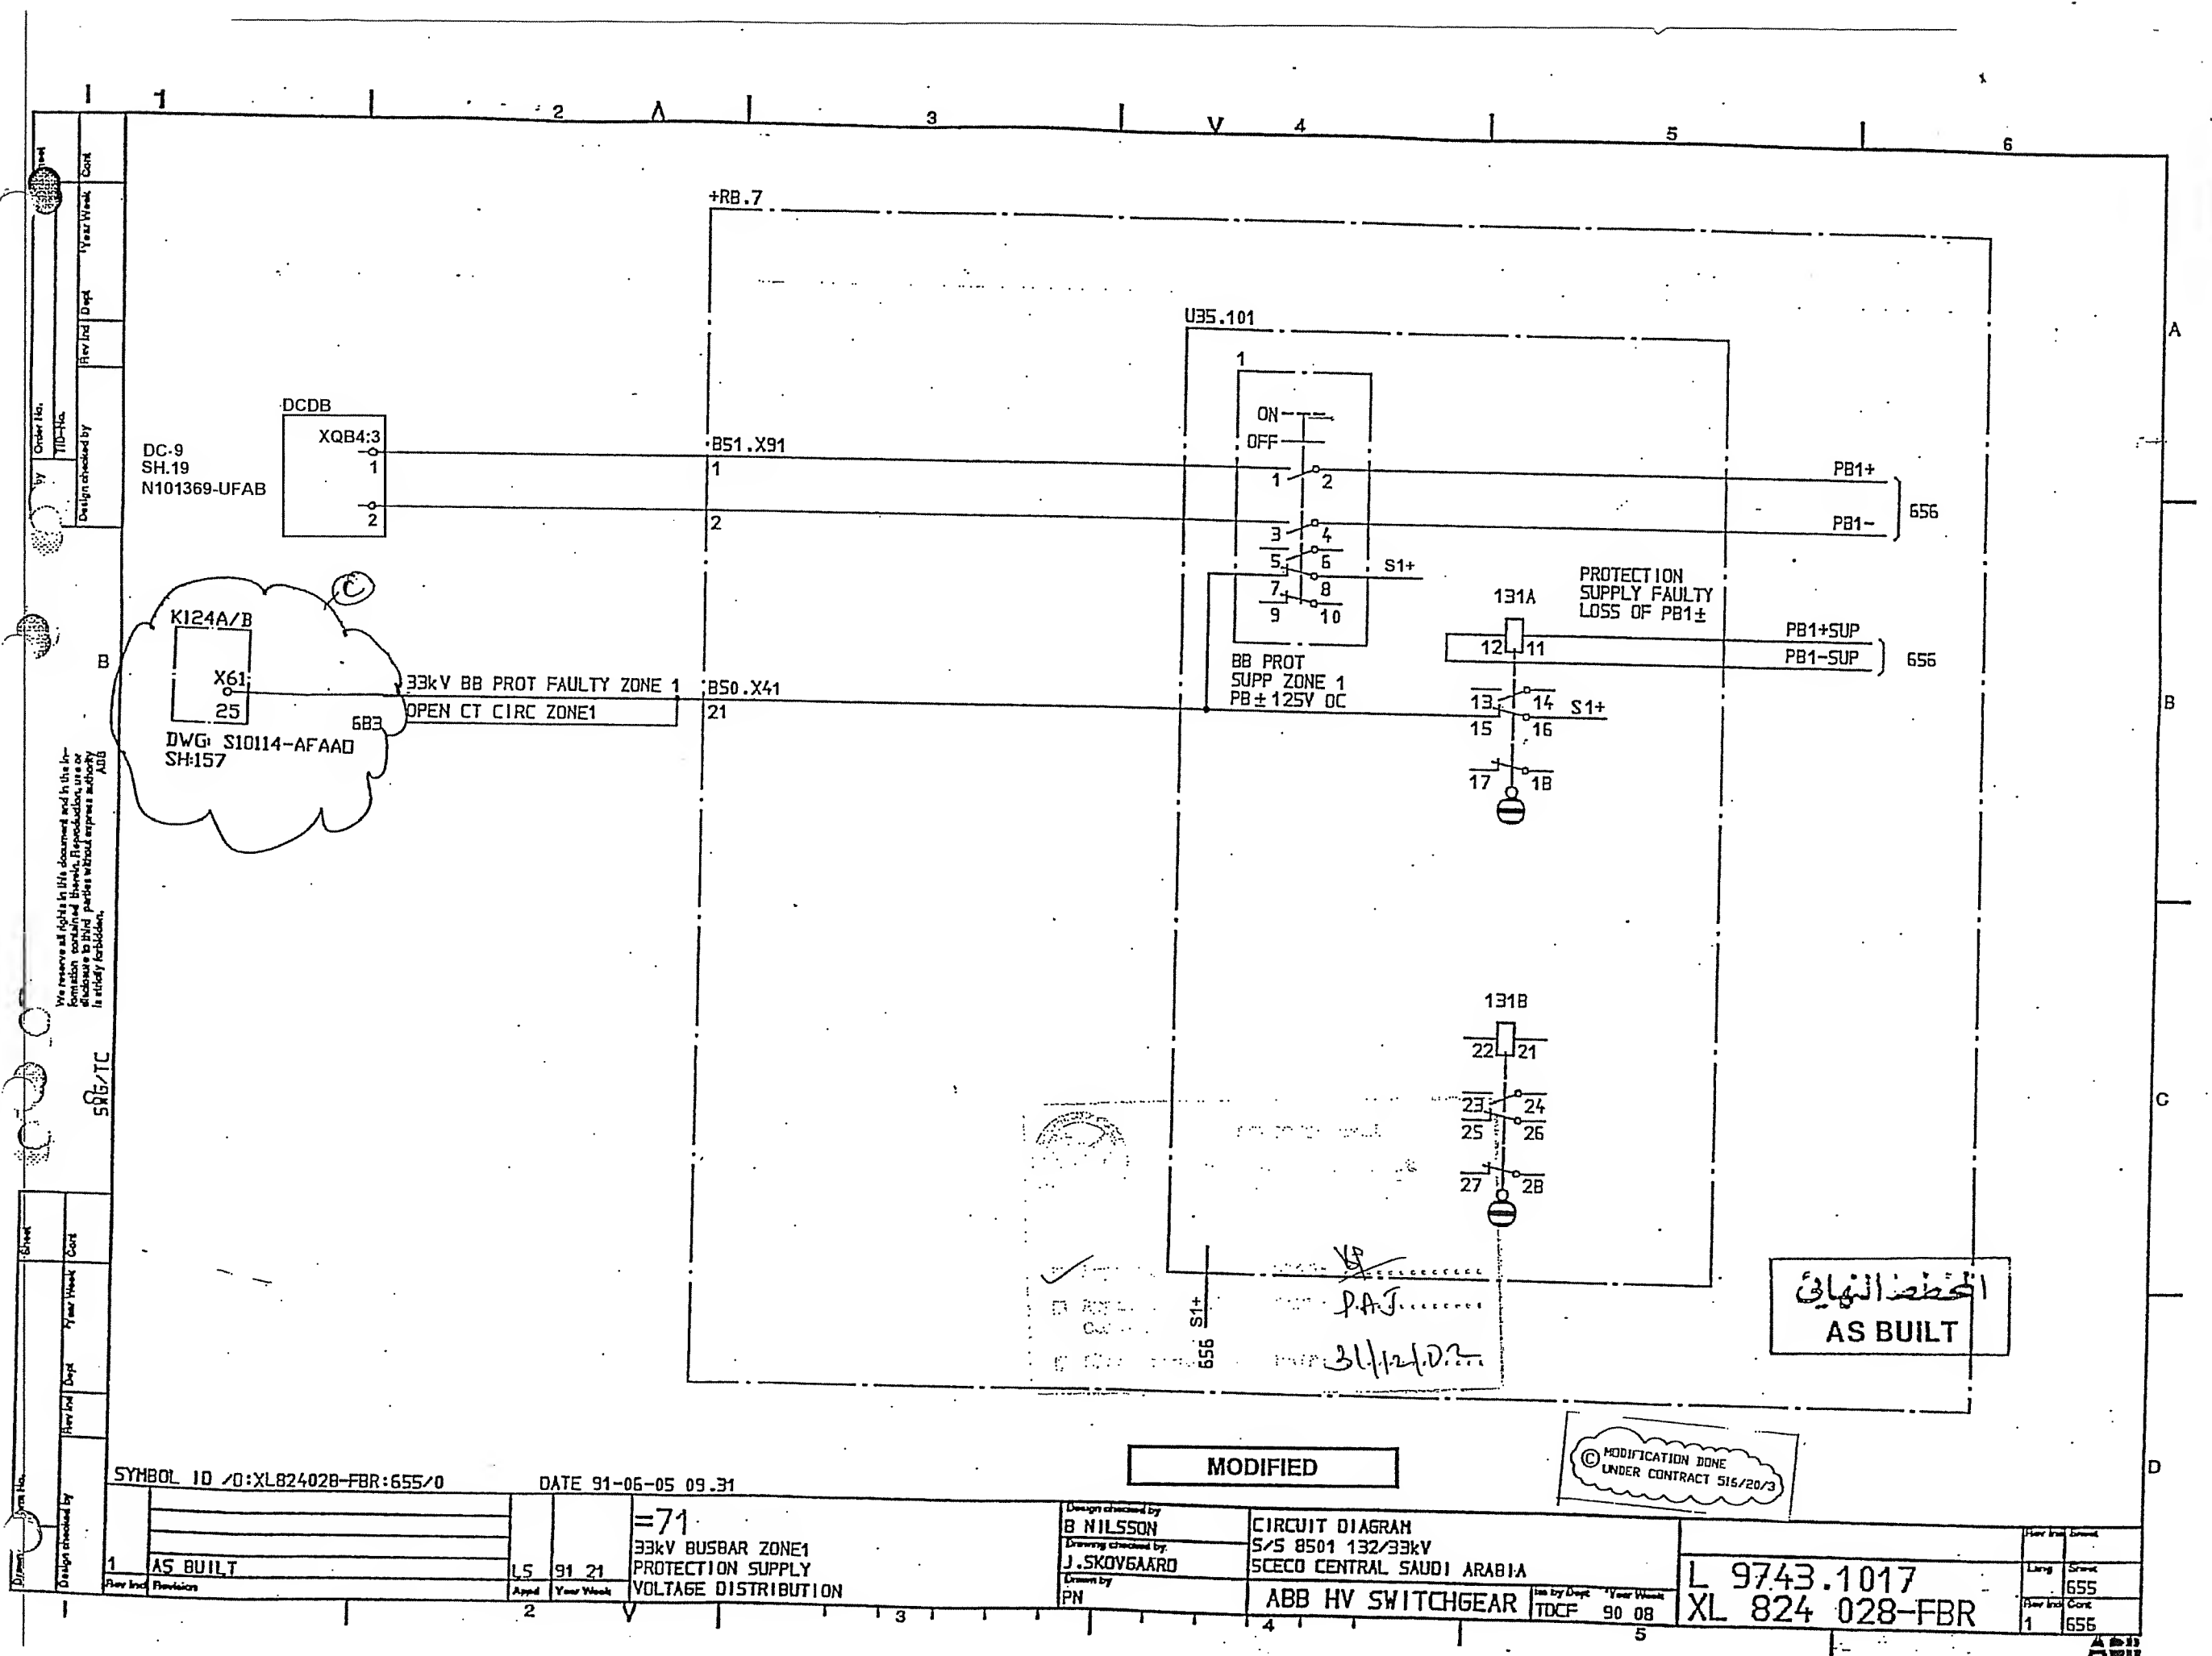

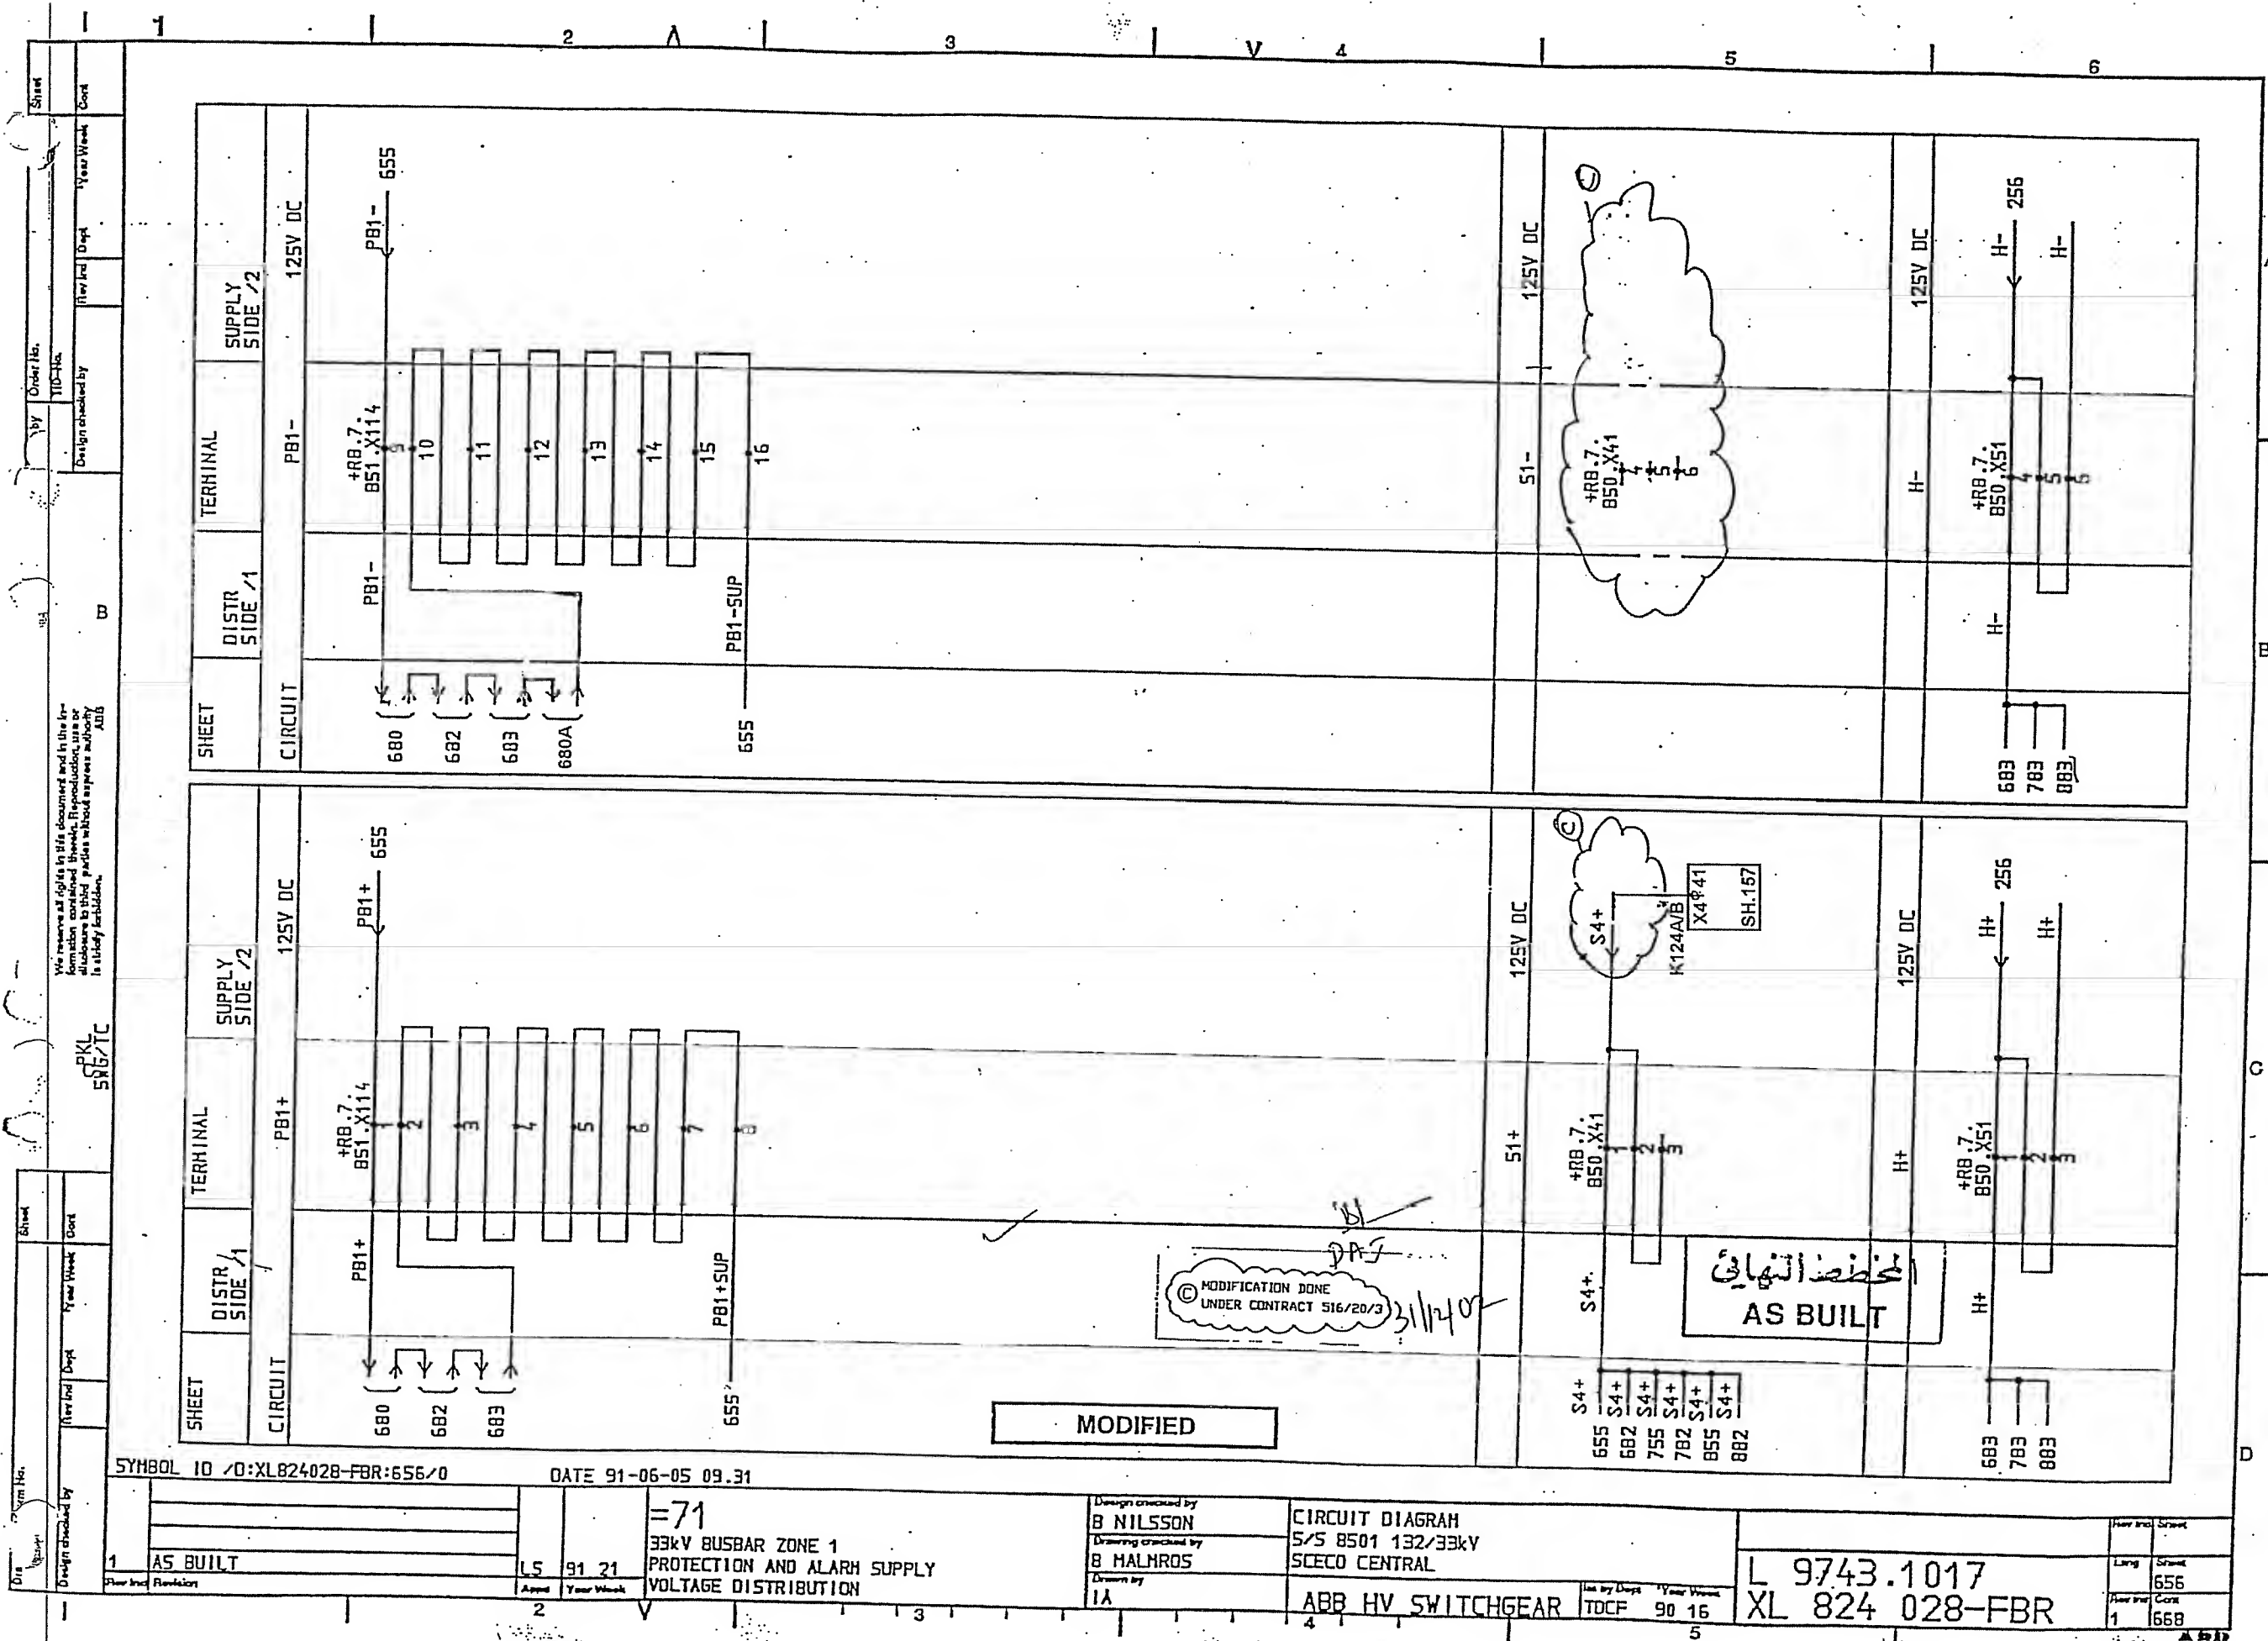

© MODIFICATION DONE
UNDER CONTRACT 516/20/3

MODIFIED

المخطط النهائي
AS BUILT

SYH80L 10 /0:XL824028-FBR:656/0

DATE 91-06-05 09.31

| | | | |
|---|----------|----|-------|
| 1 | AS BUILT | LS | 91 21 |
| 2 | | | |
| 3 | | | |


=71
33kV BUSBAR ZONE 1
PROTECTION AND ALARM SUPPLY
VOLTAGE DISTRIBUTION


Design checked by
B NILSSON
Drawing checked by
B MALMROS
Drawn by
IA

CIRCUIT DIAGRAM
S/S 8501 132/33kV
SCECO CENTRAL
ABB HV SWITCHGEAR

L 9743.1017
XL 824 028-FBR

| | | |
|-----|-------|-------|
| Rev | Drawn | Sheet |
| 1 | 1 | 656 |
| | | 658 |

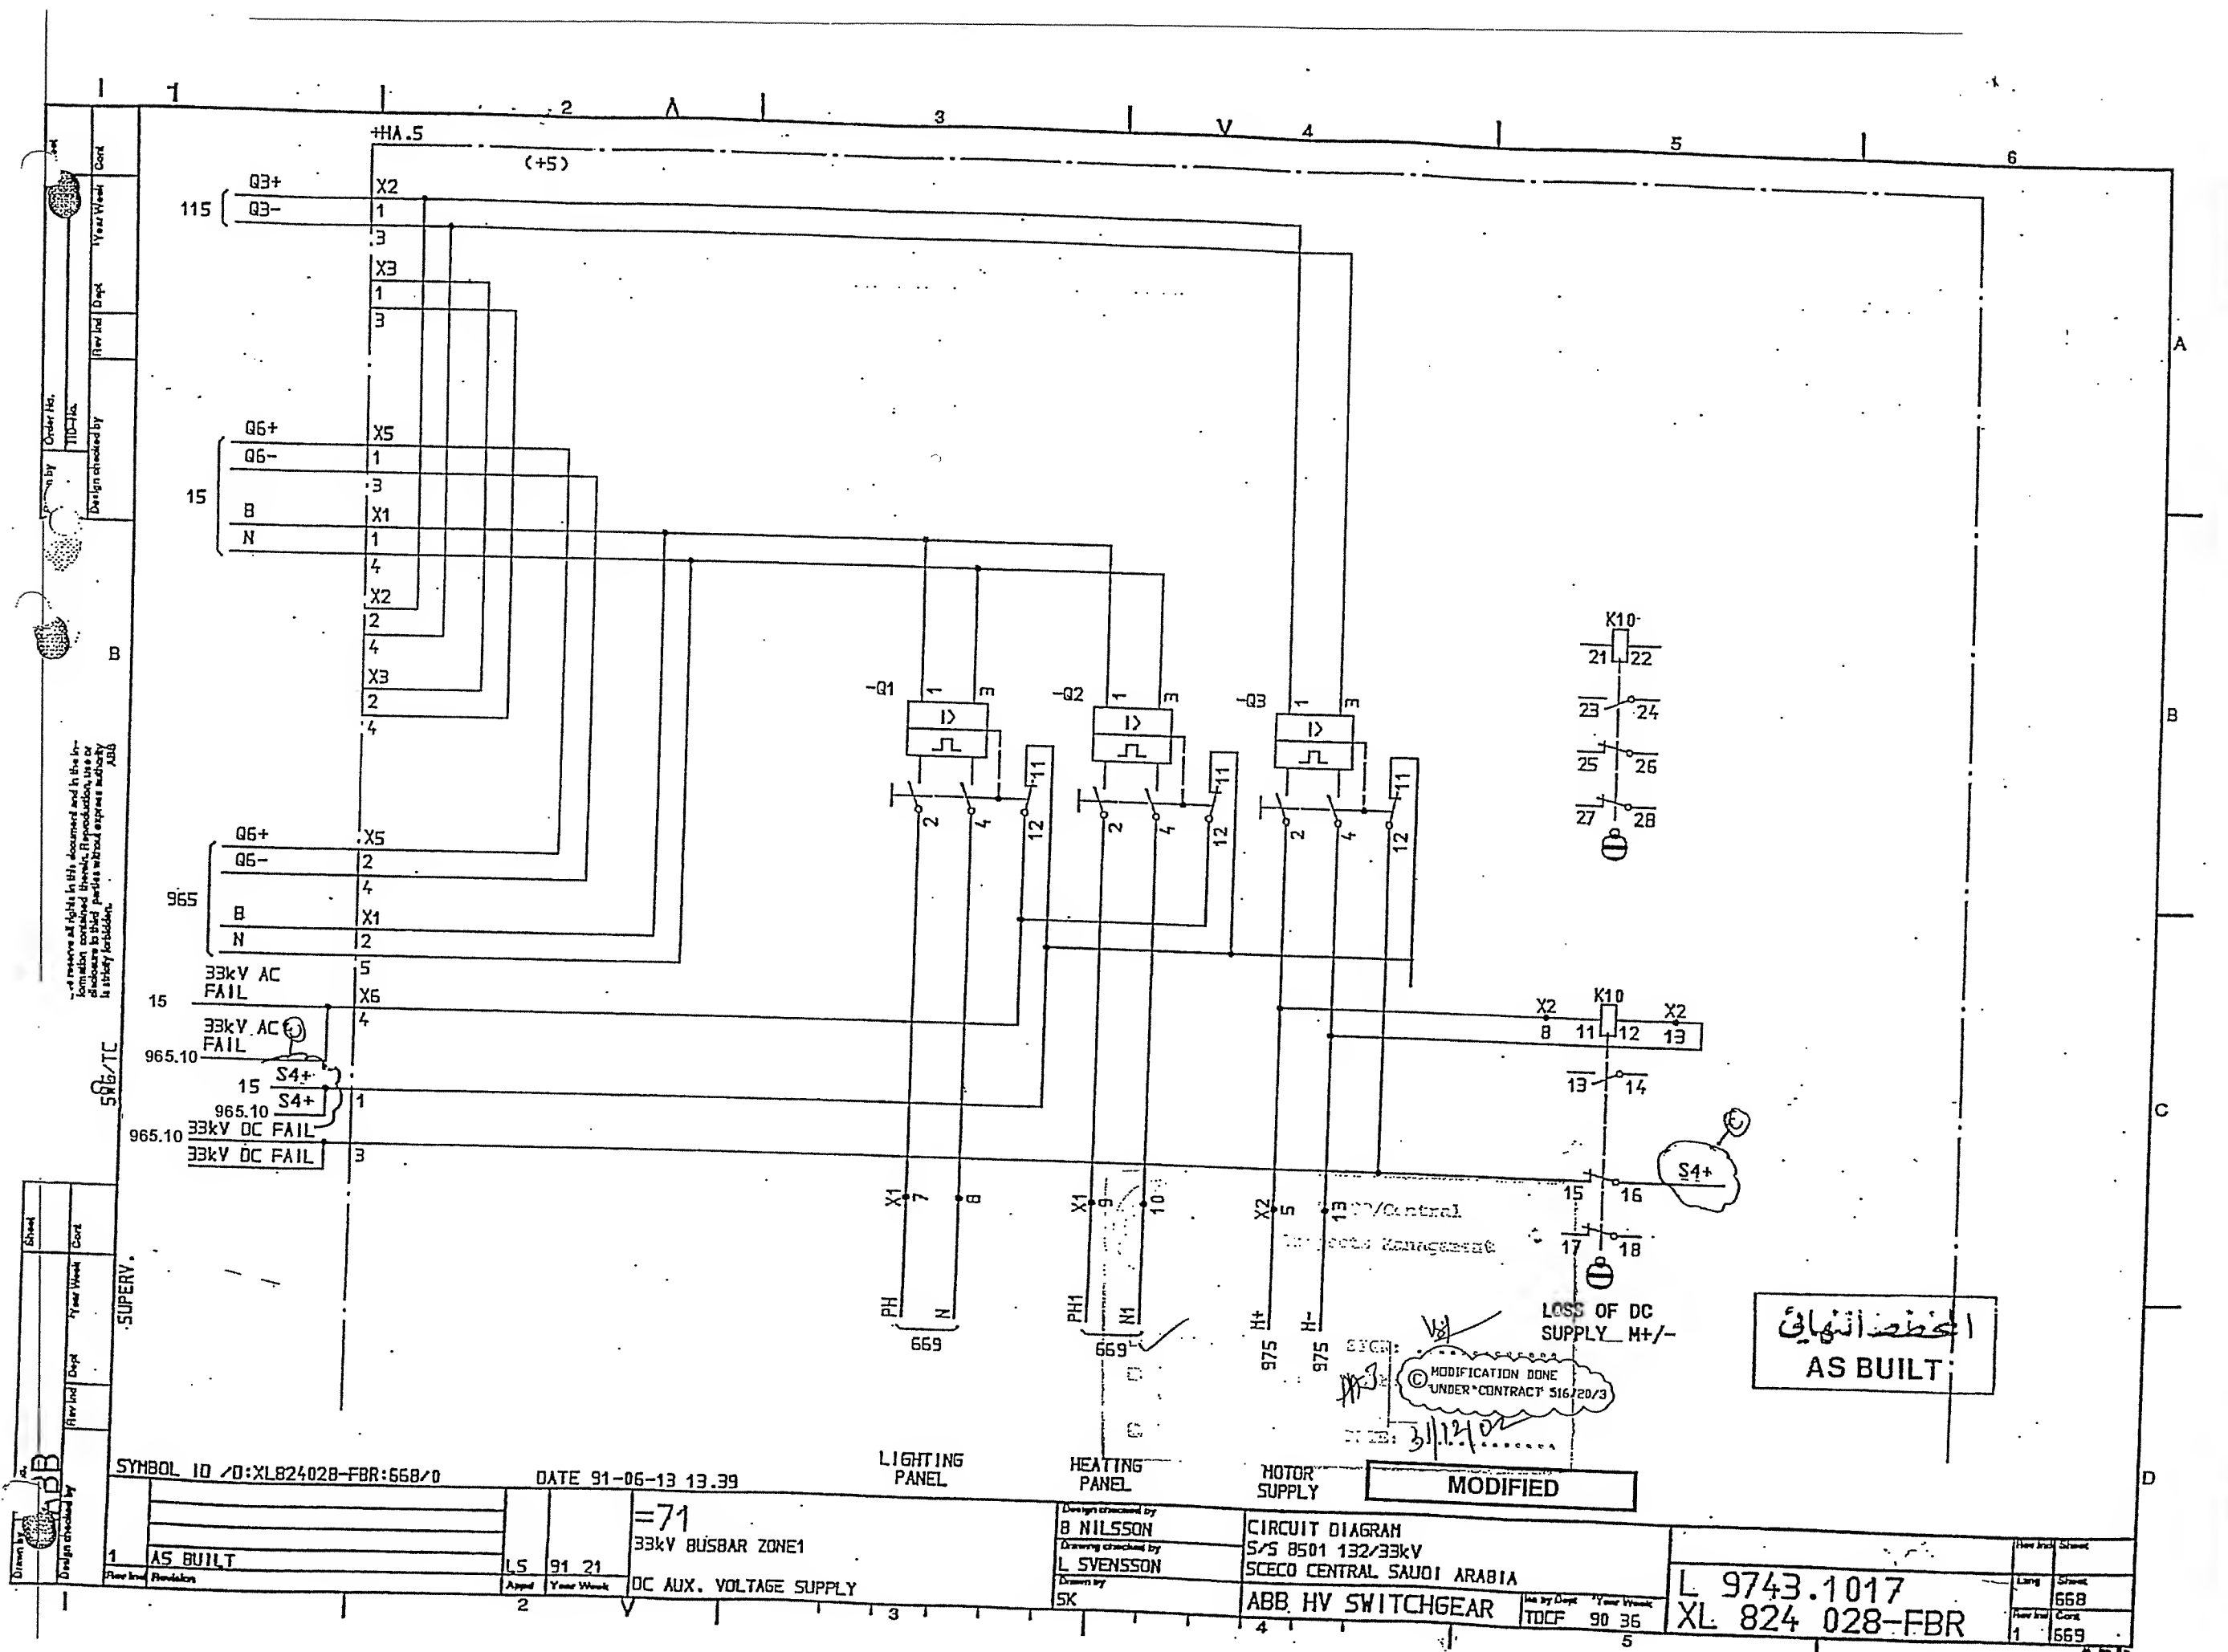

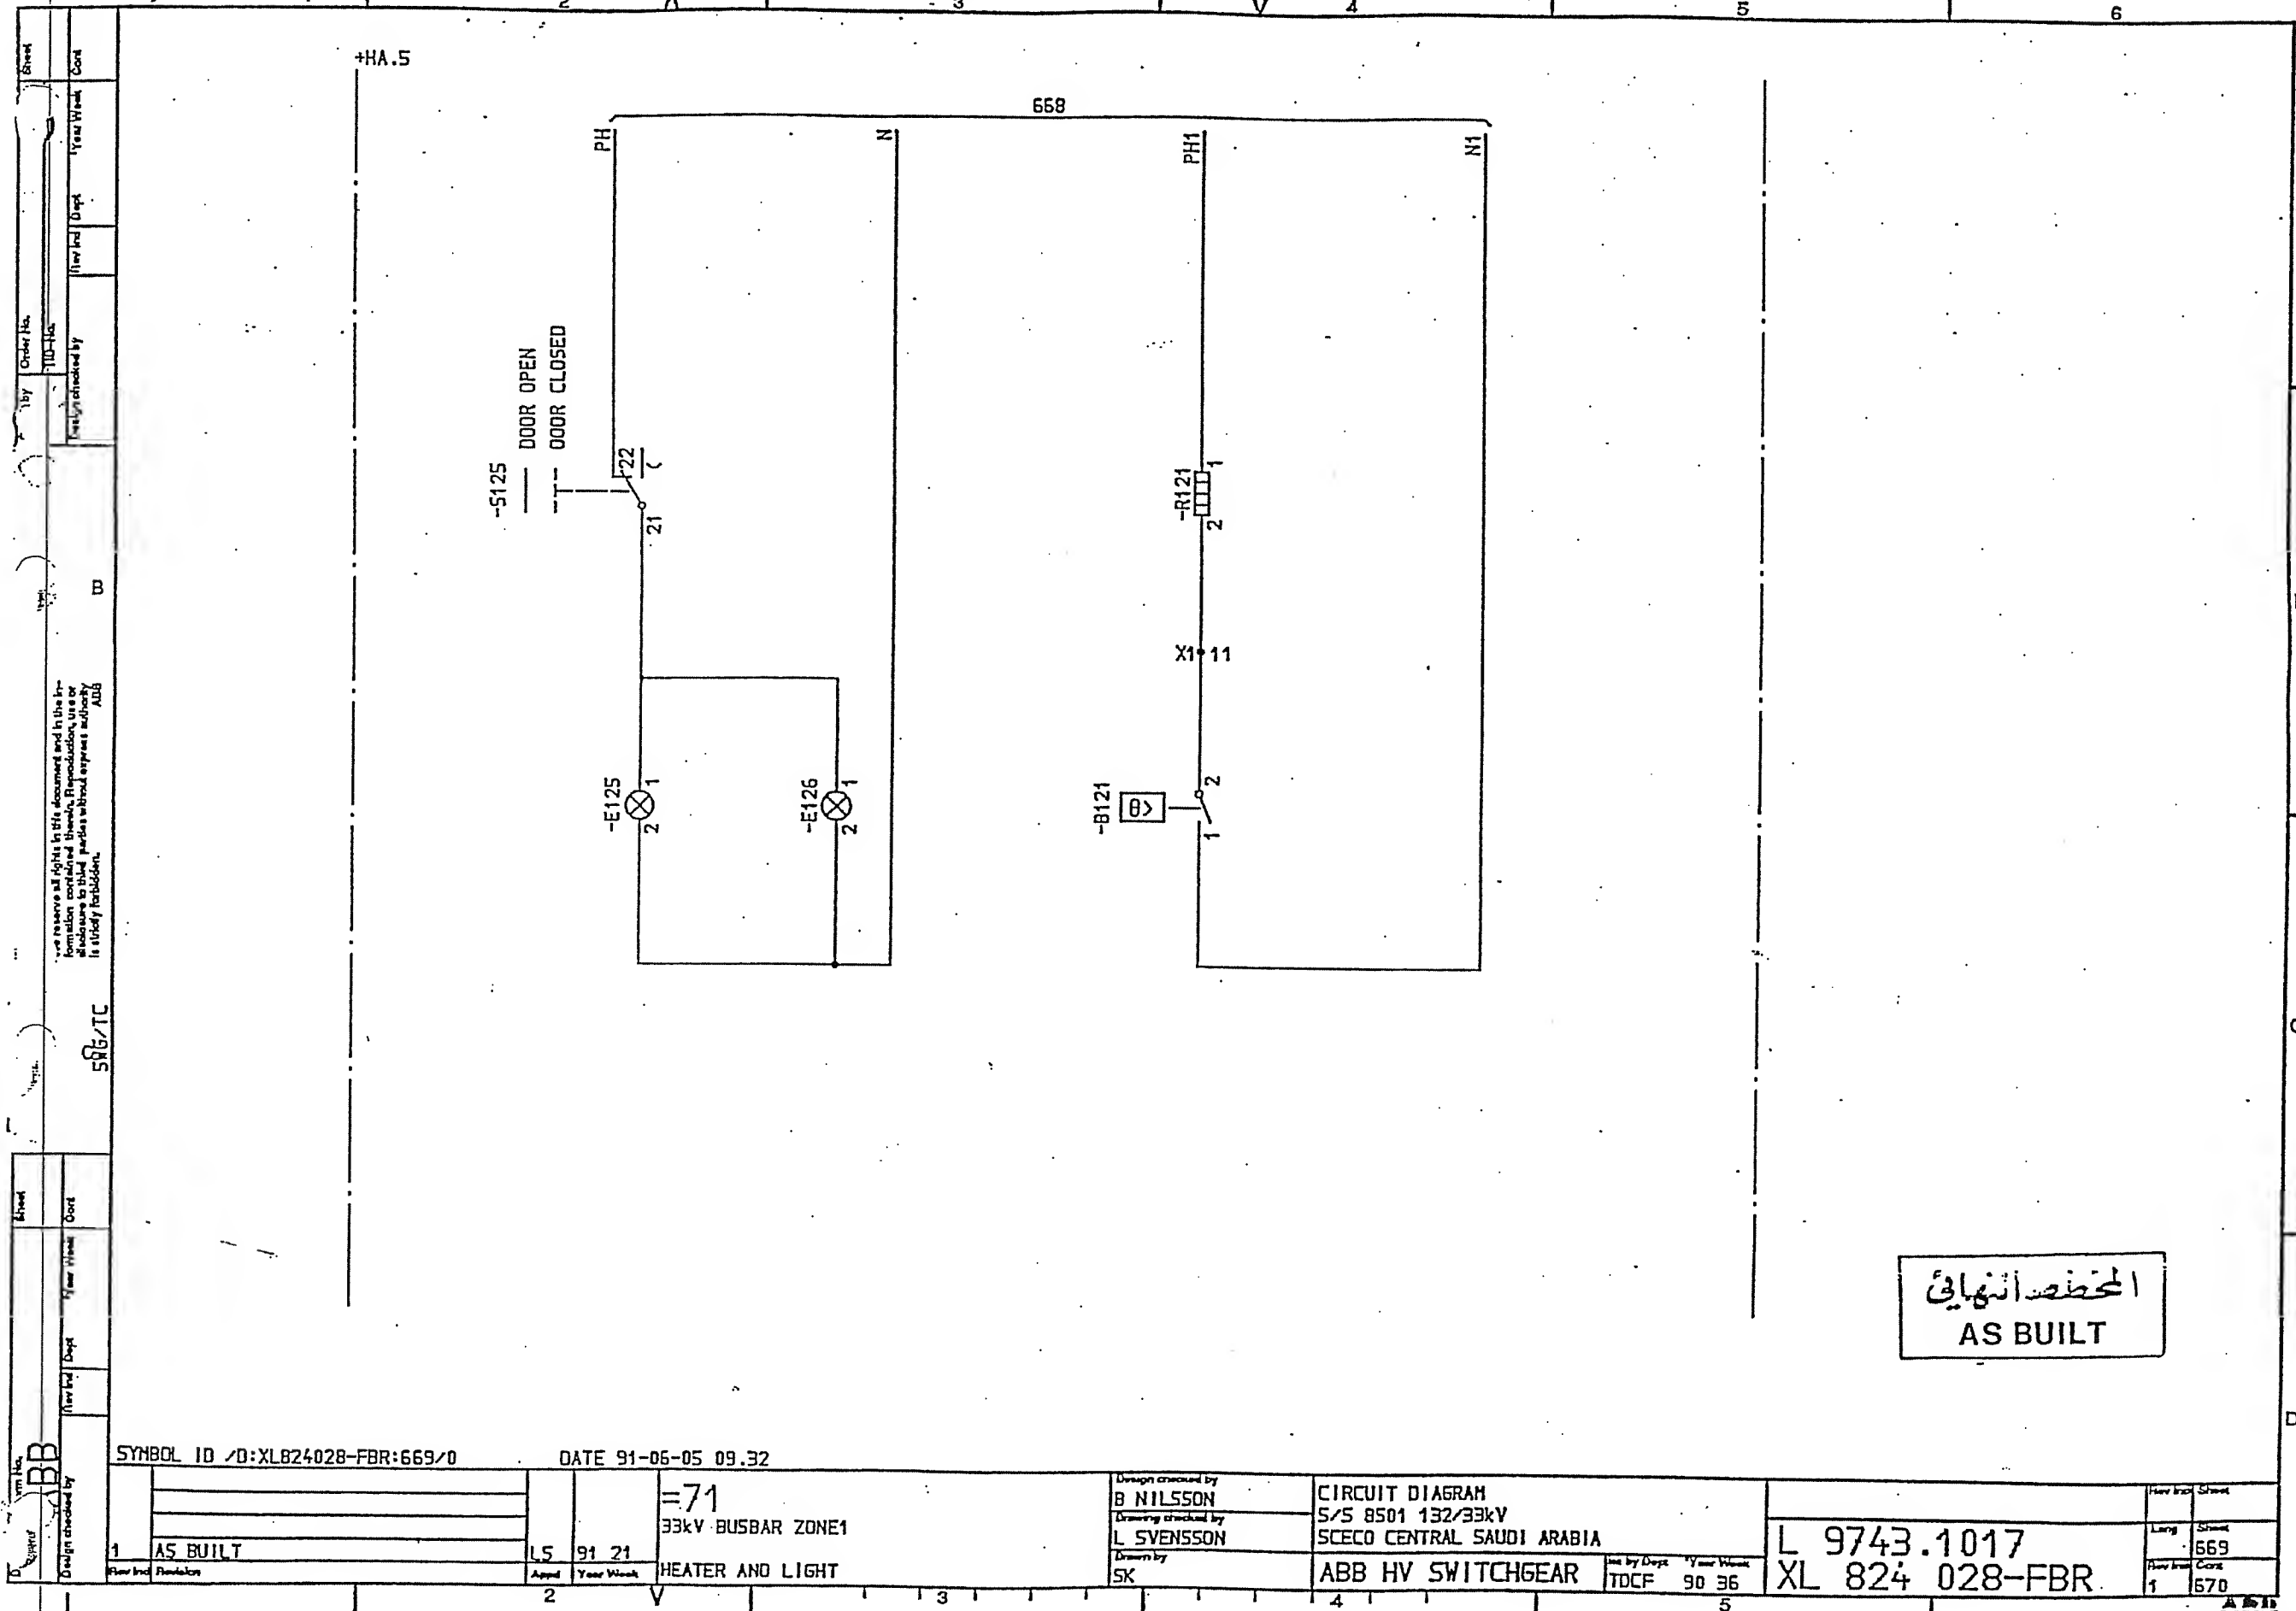

المخطط النهائي
AS BUILT

SYMBOL ID /D:XL824028-FBR:669/0

DATE 91-06-05 09.32

| | |
|---|----------|
| 1 | AS BUILT |
| 2 | AS BUILT |
| 3 | AS BUILT |
| 4 | AS BUILT |
| 5 | AS BUILT |
| 6 | AS BUILT |

| | |
|---|----------|
| 1 | AS BUILT |
| 2 | AS BUILT |
| 3 | AS BUILT |
| 4 | AS BUILT |
| 5 | AS BUILT |
| 6 | AS BUILT |


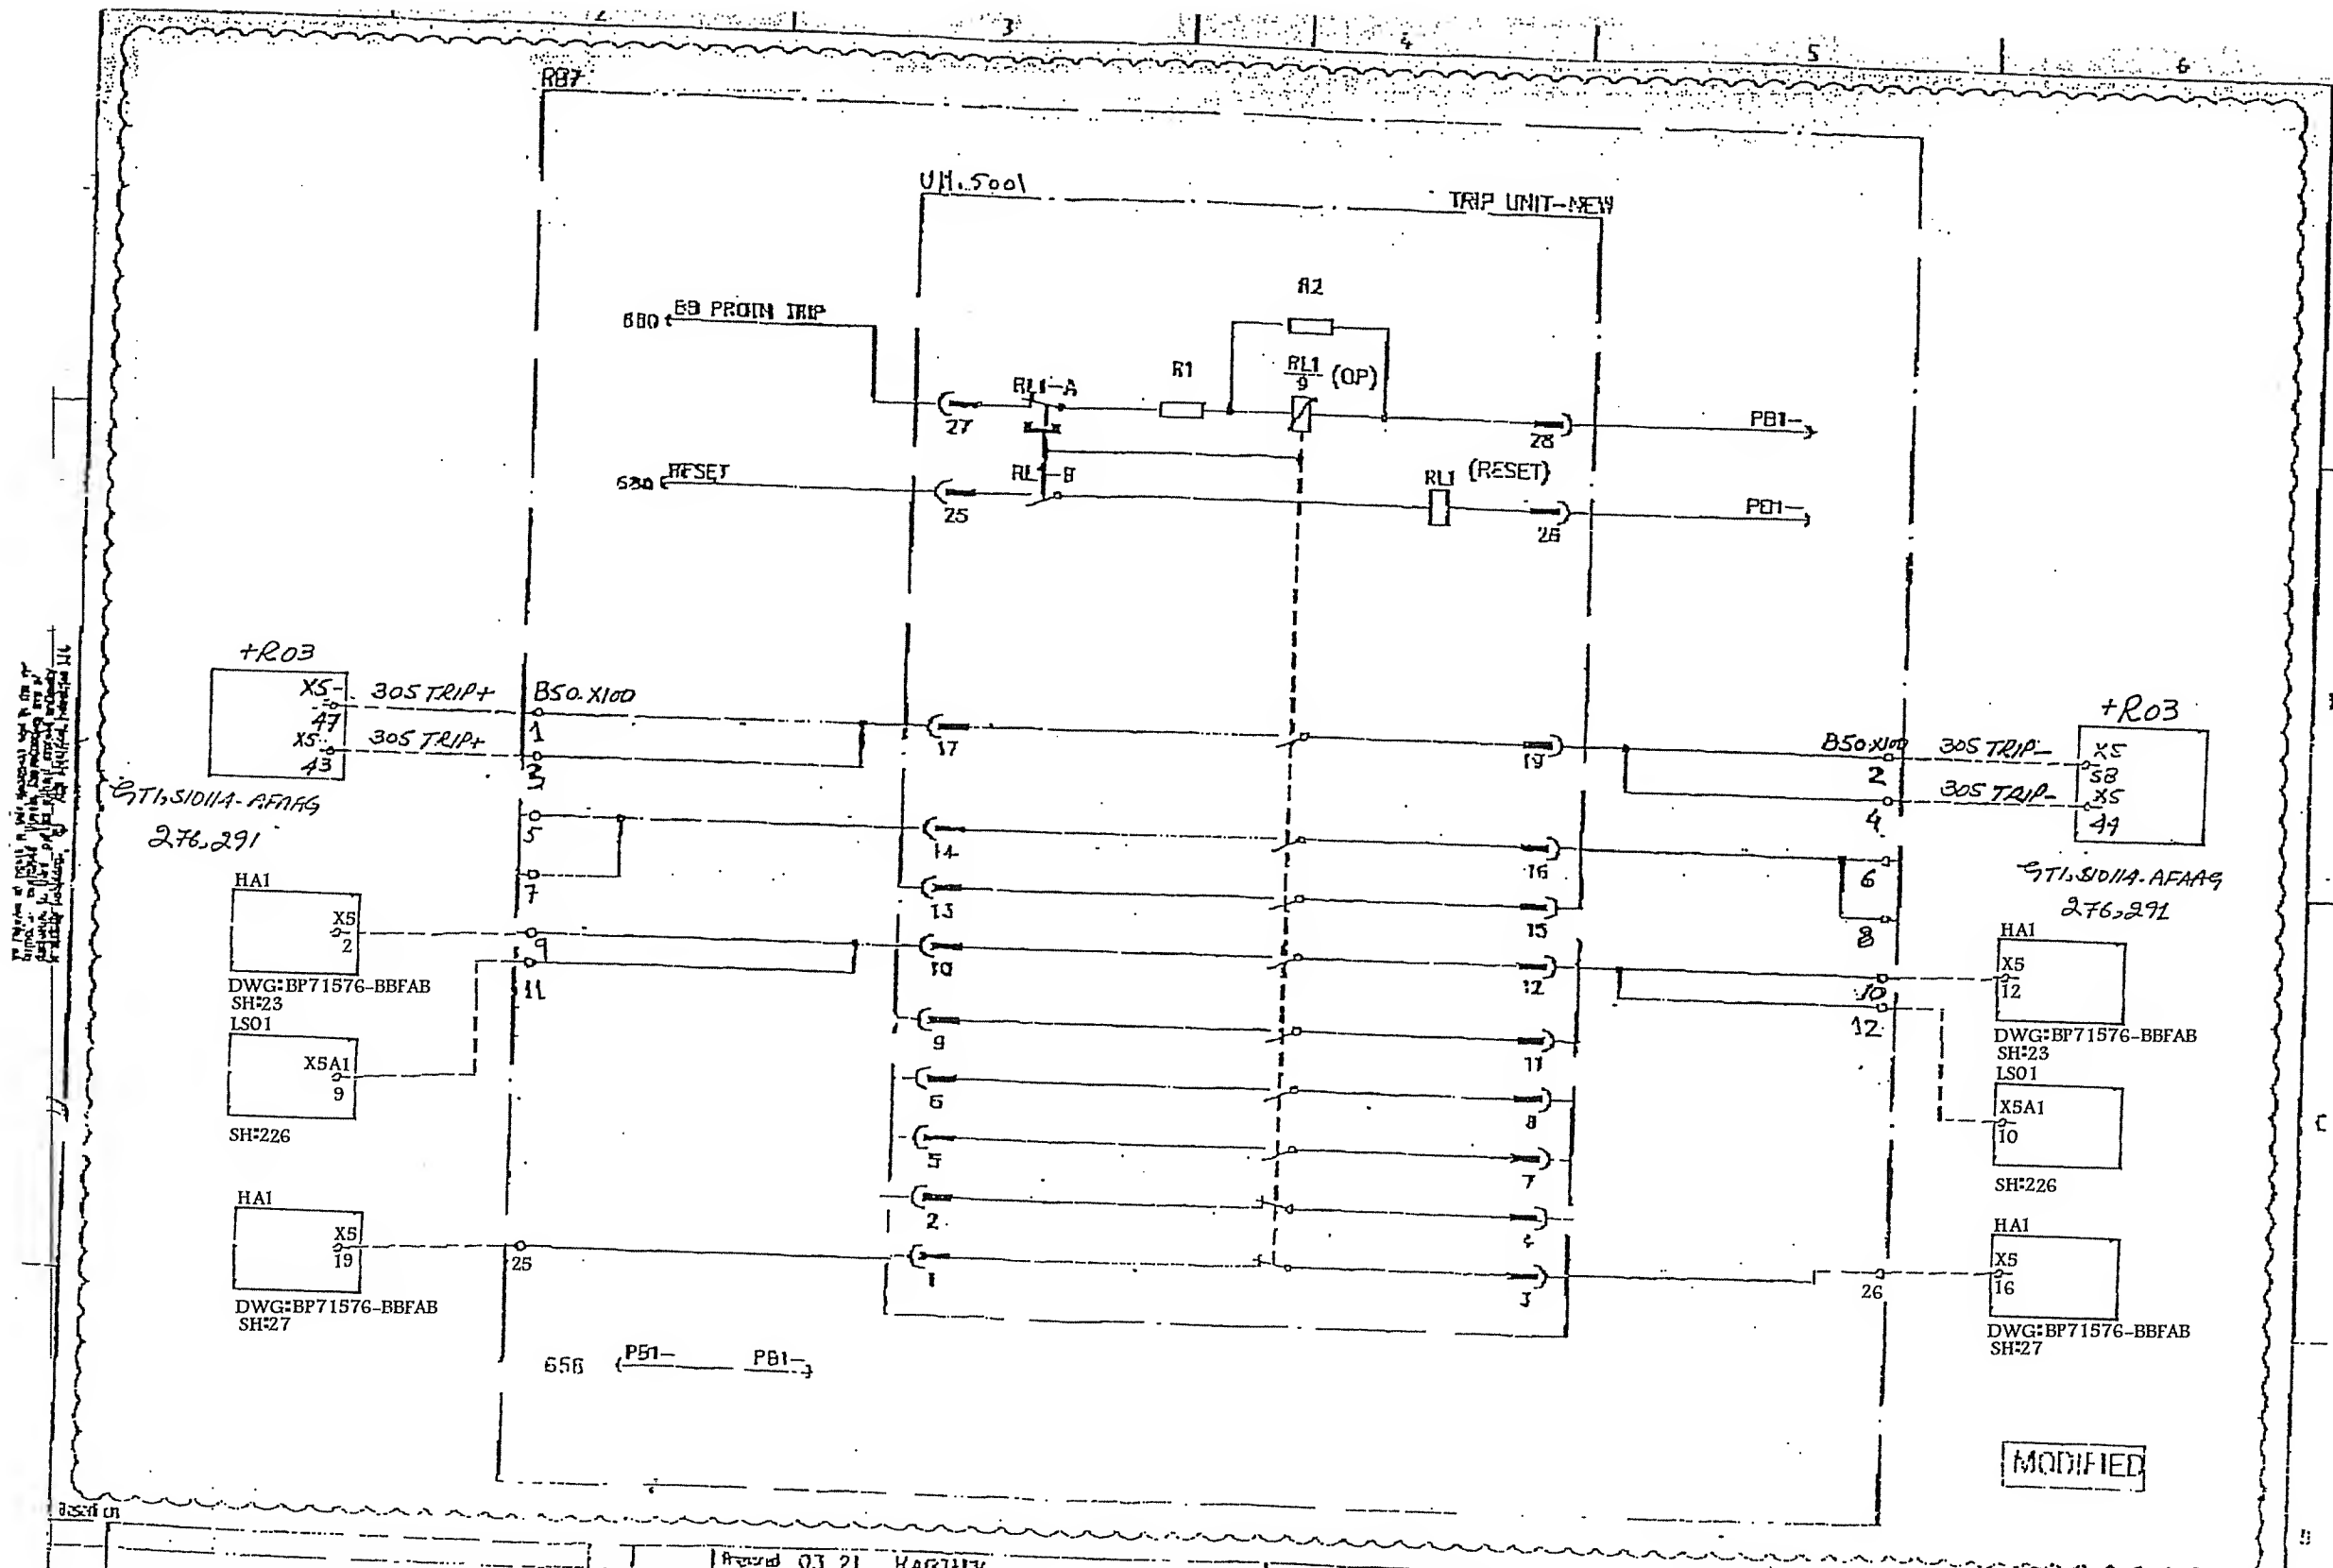ASH



| | | | | |
|------------------------------------|------------------------------------|------------------------------------|------------------------------------|------------------------------------|
| DWG:BP71576-BBFAB SH:23 LS01 | DWG:BP71576-BBFAB SH:23 LS01 | DWG:BP71576-BBFAB SH:23 LS01 | DWG:BP71576-BBFAB SH:23 LS01 | DWG:BP71576-BBFAB SH:23 LS01 |
| SH:226 | SH:226 | SH:226 | SH:226 | SH:226 |
| DWG:BP71576-BBFAB SH:27 | DWG:BP71576-BBFAB SH:27 | DWG:BP71576-BBFAB SH:27 | DWG:BP71576-BBFAB SH:27 | DWG:BP71576-BBFAB SH:27 |
| SH:27 | SH:27 | SH:27 | SH:27 | SH:27 |

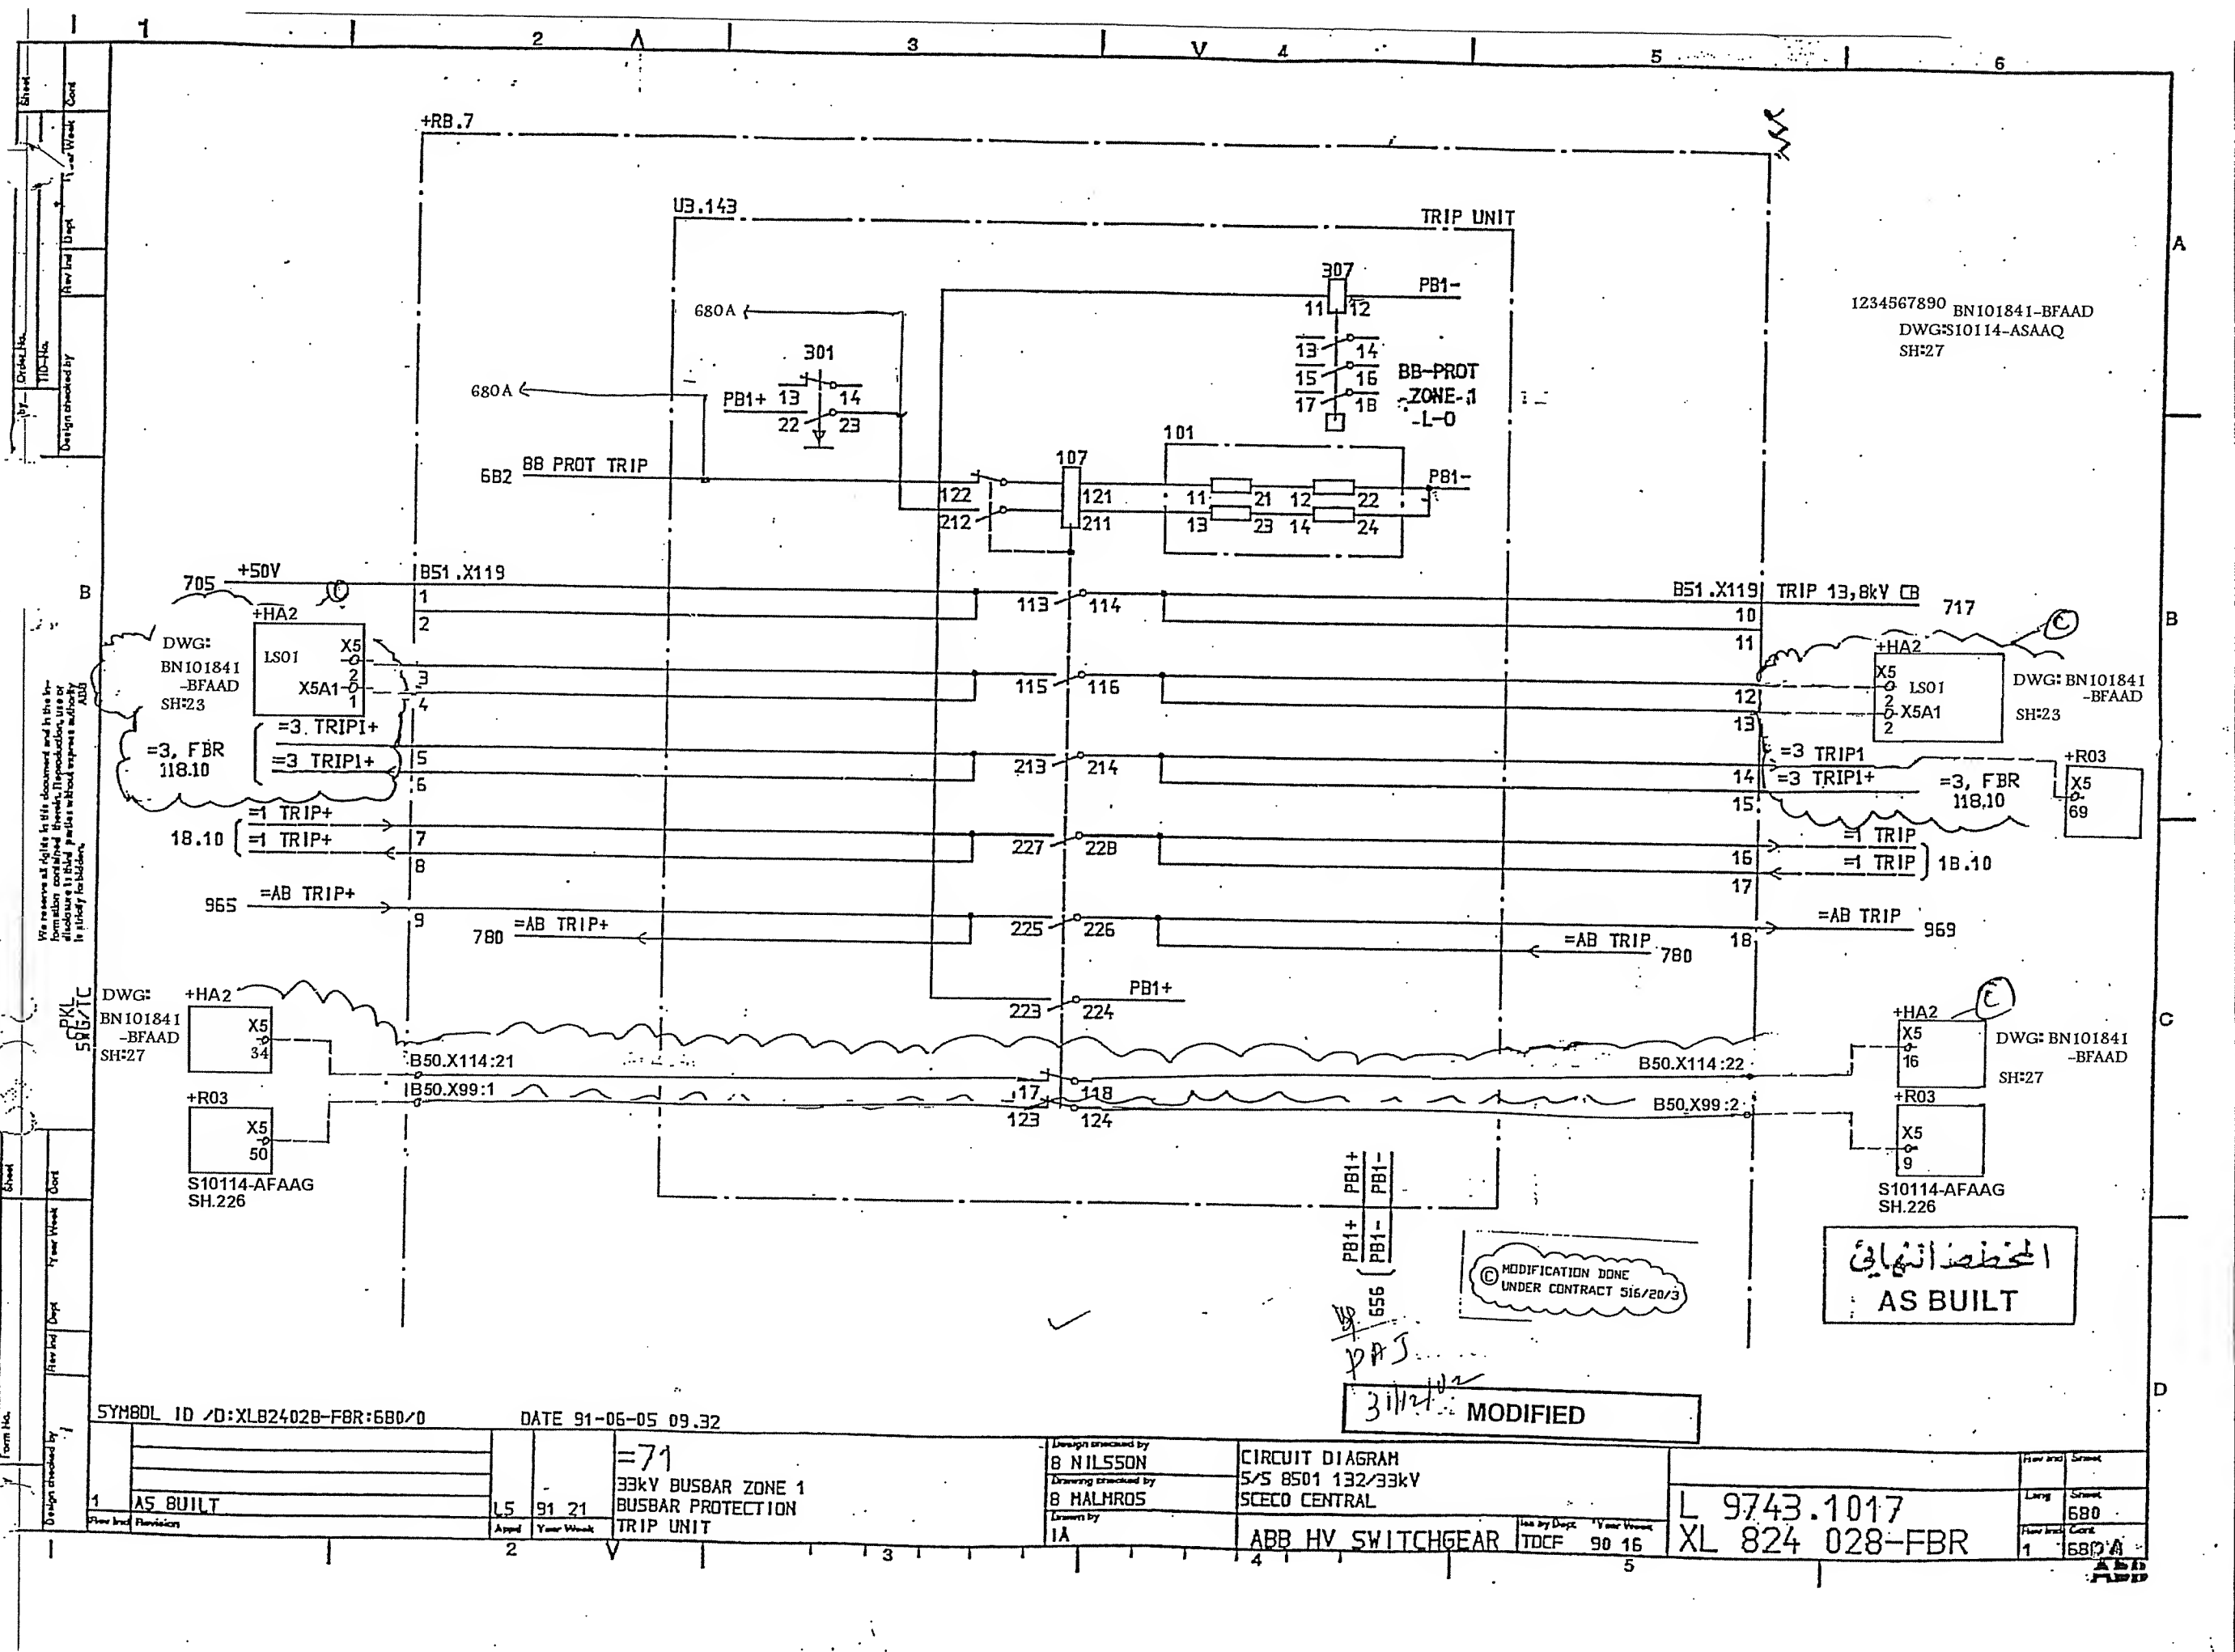

1234567890 BN101841-BFAAD
DWG:S10114-ASAAQ
SH:27

DWG: BN101841-BFAAD
SH:23
=3, FBR 118.10
=3, TRIP1+
=3, TRIP1+

DWG: BN101841-BFAAD
SH:23
=3, FBR 118.10
=3, TRIP1+
=3, TRIP1+
=1 TRIP
=1 TRIP

DWG: BN101841-BFAAD
SH:27
+HA2
X5 34
+R03
X5 50
S10114-AFAAG
SH.226

DWG: BN101841-BFAAD
SH:27
+HA2
X5 16
+R03
X5 9
S10114-AFAAG
SH.226


© MODIFICATION DONE
UNDER CONTRACT 516/20/3

المخطط النهائي
AS BUILT

31/12/2002
MODIFIED


SYHBDL ID /D:XL824028-FBR:680/D
DATE 91-06-05 09.32

| | | | | | | | | | | | | | | | |
|----------|--|----------|--|---|--|---------------------------------|--|---|--|----------------|--|-------------------------------|--|-------------------------|--|
| AS BUILT | | L5 91 21 | | =71 33kV BUSBAR ZONE 1 BUSBAR PROTECTION TRIP UNIT | | Design checked by B NILSSON | | CIRCUIT DIAGRAM S/S 8501 132/33kV SCECO CENTRAL | | Drawn by IA | | L 9743.1017 XL 824 028-FBR | | Rev and Sheet 580 | |
| Revision | | Appd | | Year Week | | Drawing checked by B HALMROS | | SCECO CENTRAL | | Drawn by IA | | L 9743.1017 XL 824 028-FBR | | Rev and Sheet 580 | |
| 1 | | 2 | | 3 | | 4 | | 5 | | 6 | | 7 | | 8 | |

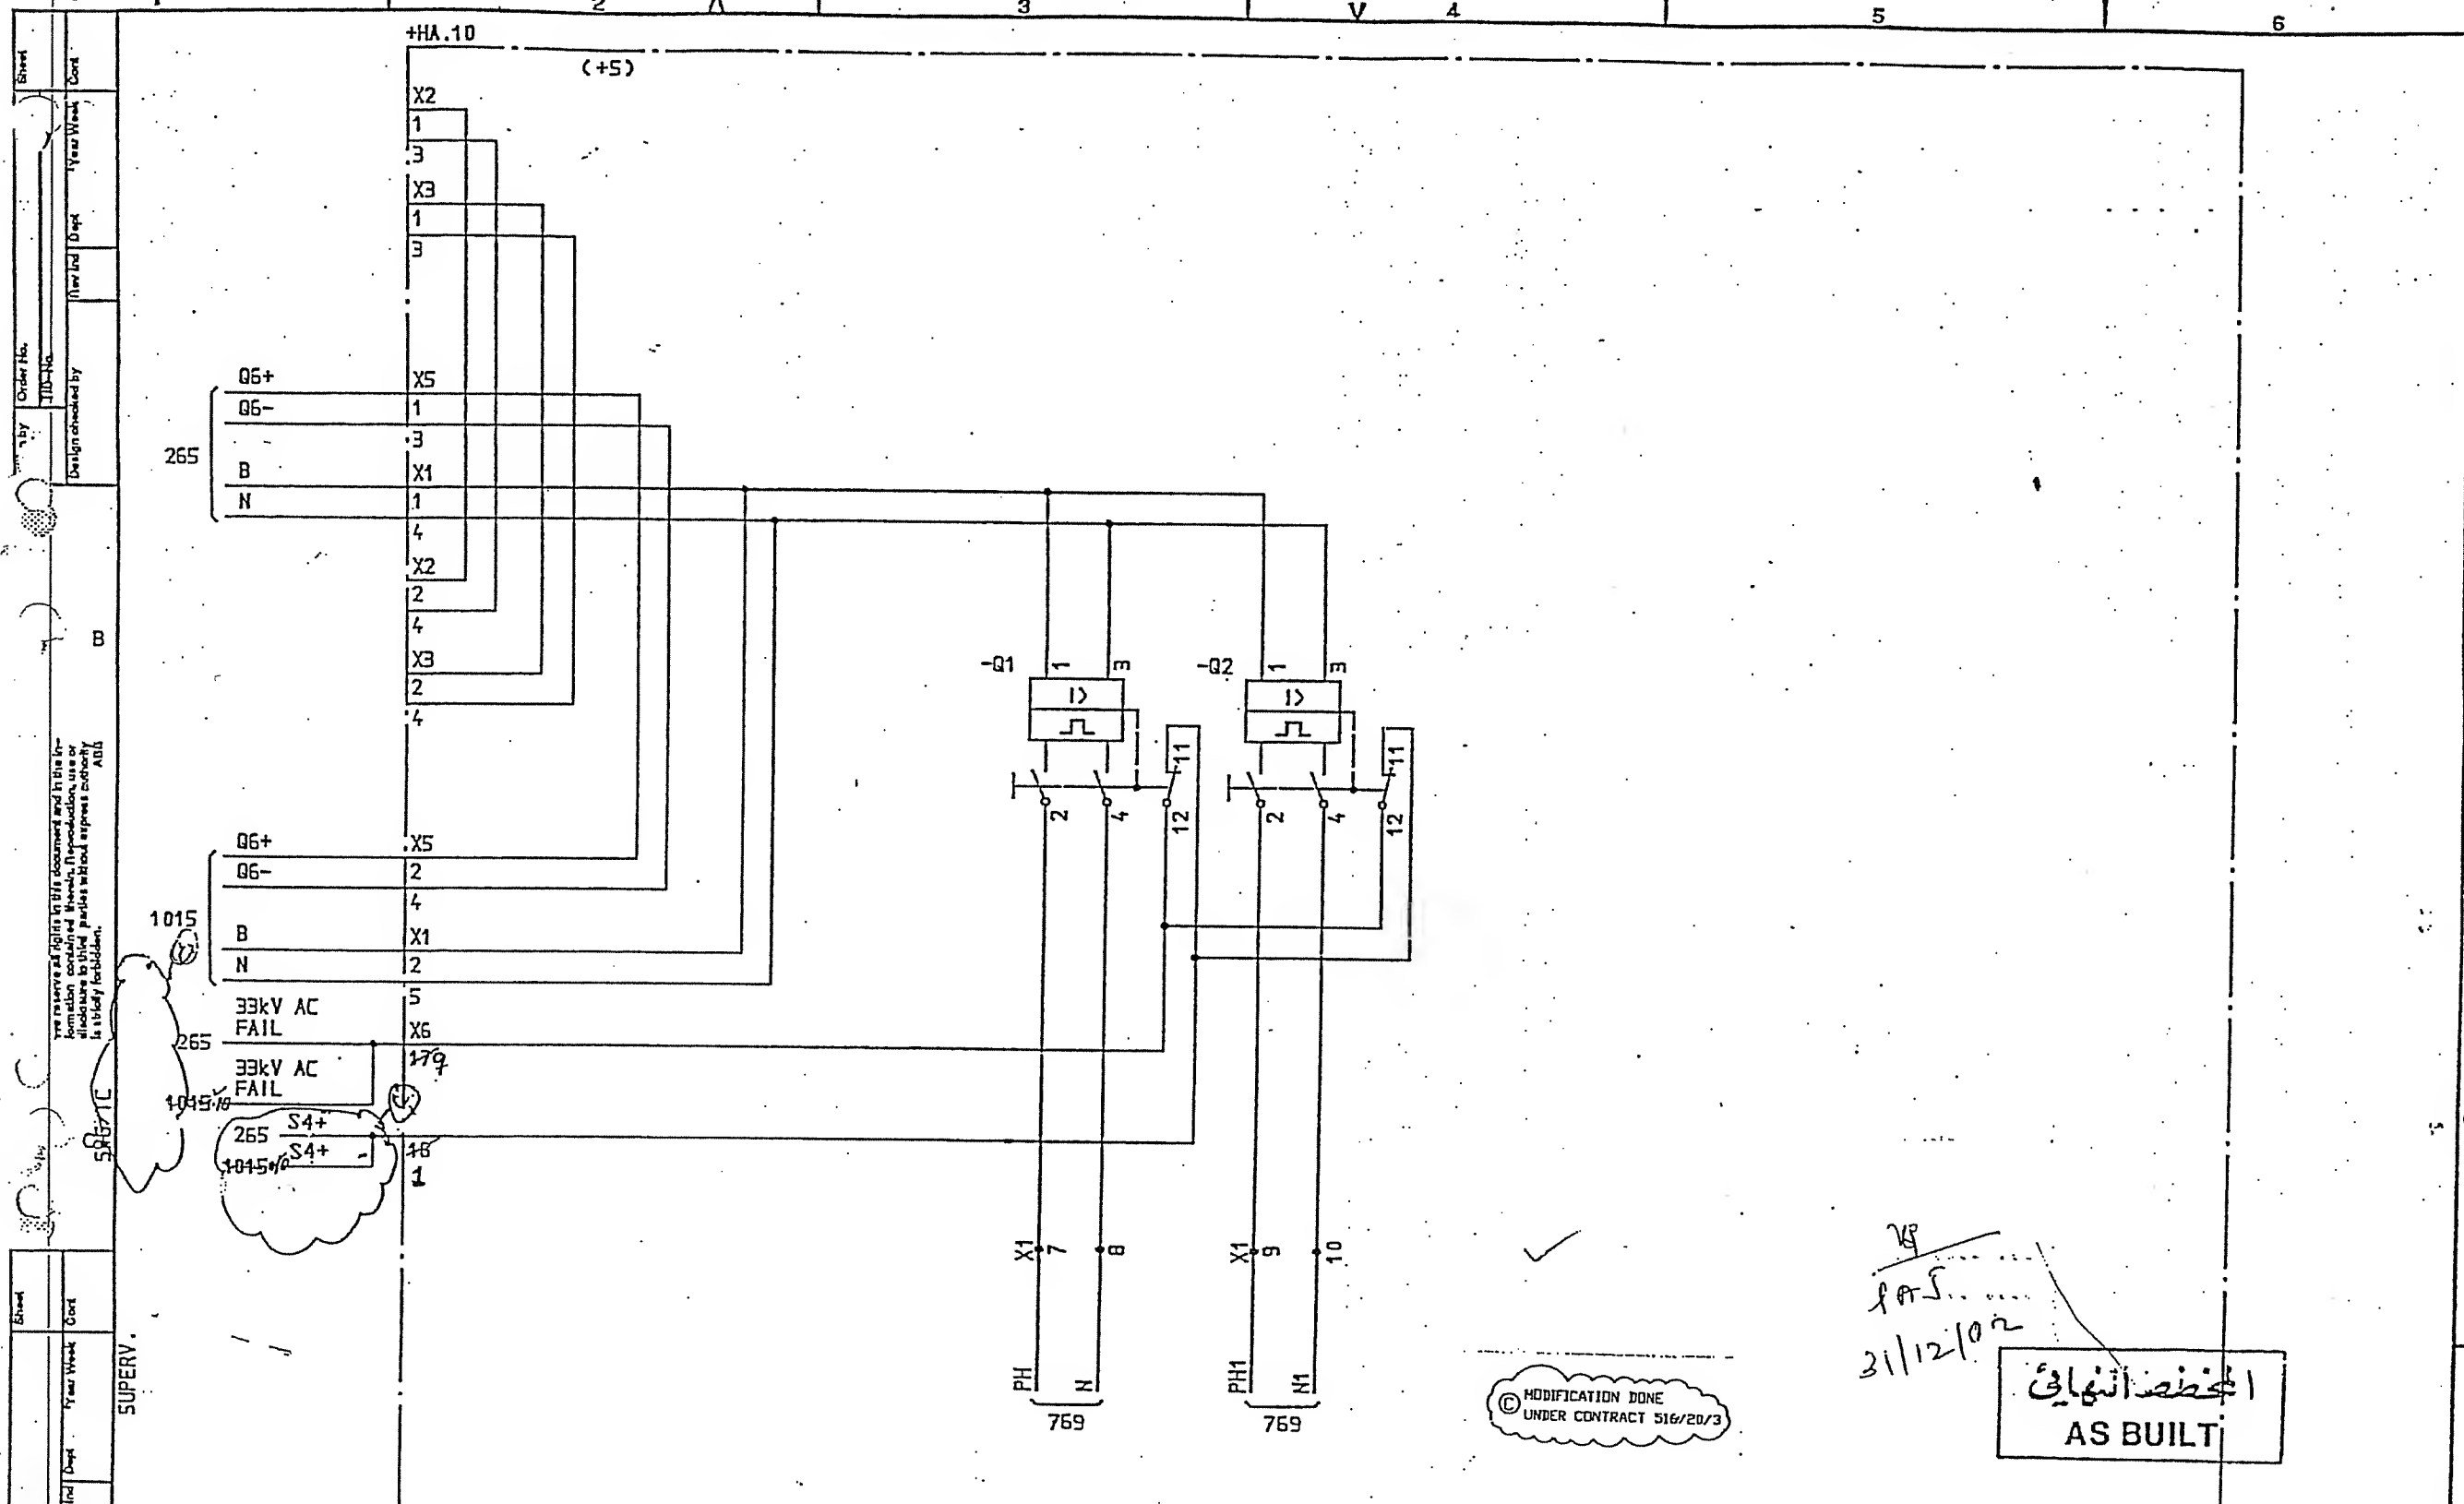

| | | | | | | | | | |
|---------------------------------|--|---------------------|--|-------------------------------|--|-------------------|--|----------------|--|
| SYMBOL ID /D:XL824028-FBR:768/0 | | DATE 91-06-05 09.33 | | LIGHTING PANEL | | HEATING PANEL | | MODIFIED | |
| =72 | | 33kV BUSBAR ZONE2 | | Design checked by 8 NILSSON | | CIRCUIT DIAGRAM | | L 9743.1017 | |
| AS BUILT | | L5 91 21 | | Drawing checked by L SVENSSON | | S/S 8501 132/33kV | | XL 824 028-FBR | |
| DC AUX. VOLTAGE SUPPLY | | Drawn by SK | | ABB HV SWITCHGEAR | | TDCF 90 36 | | 768 | |
| | | | | | | | | 769 | |

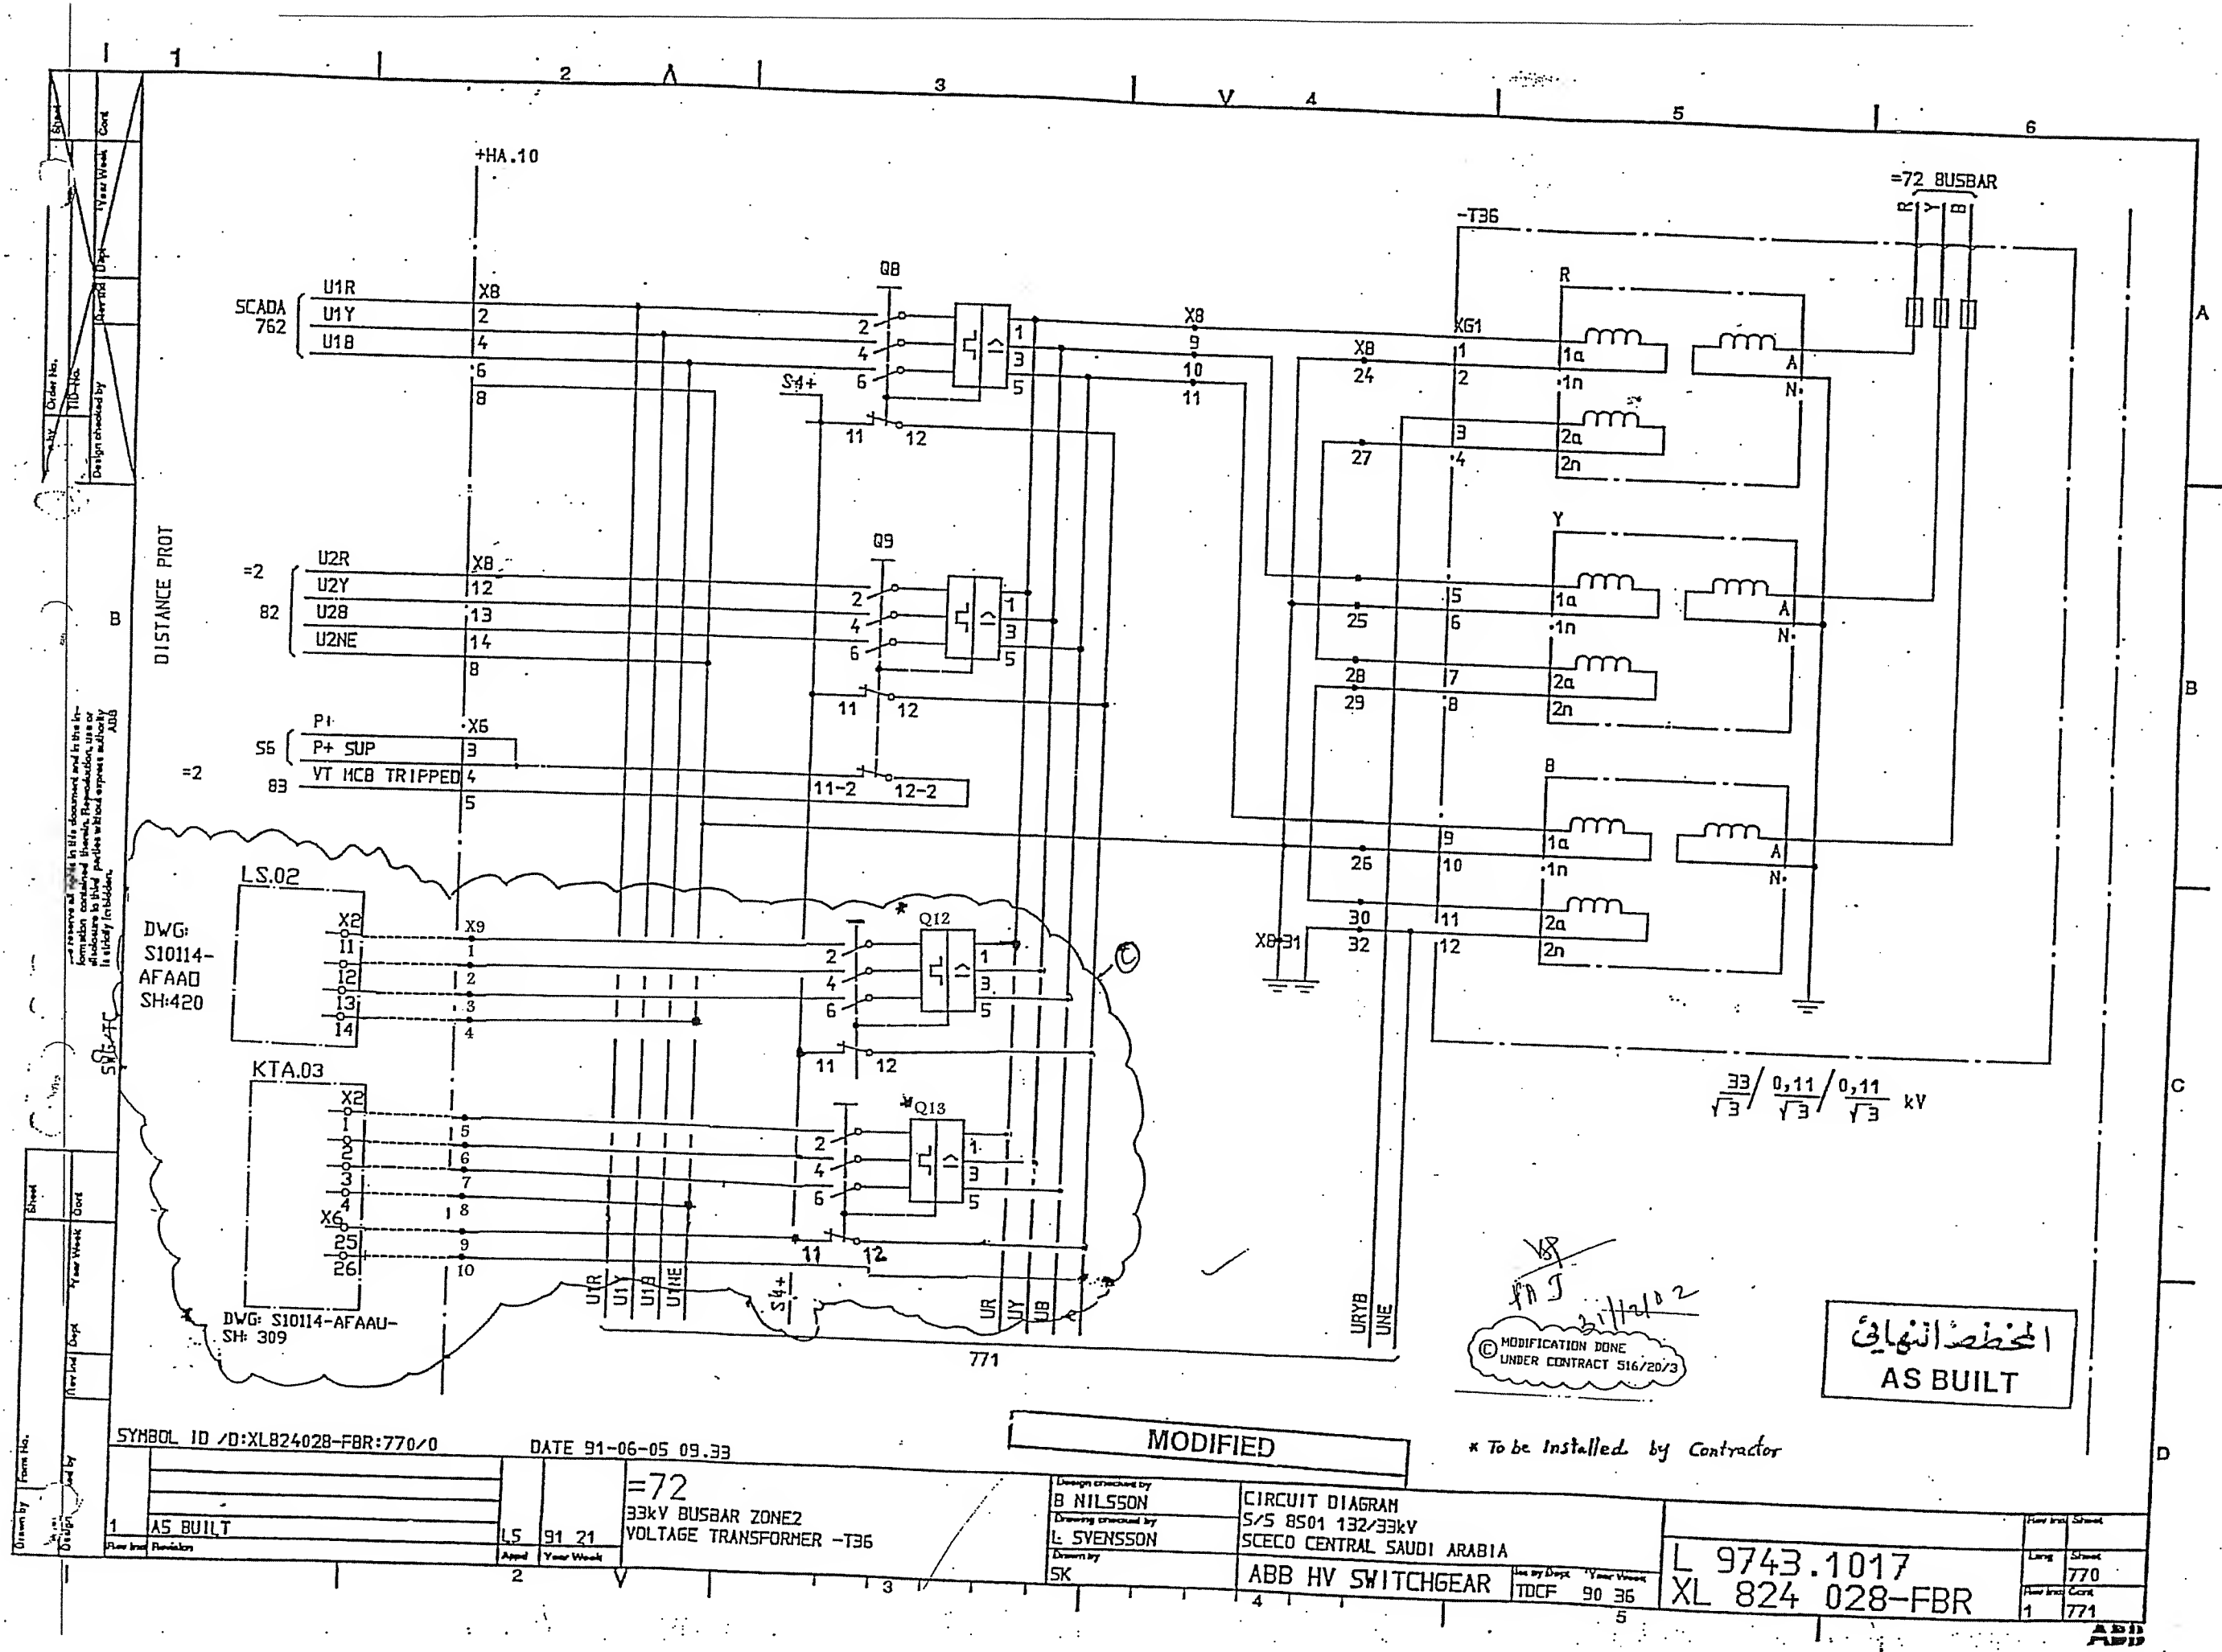ABB



DISTANCE PROT

المخطط النهائي
AS BUILT

MODIFICATION DONE
UNDER CONTRACT 516/20/3

MODIFIED

* To be Installed by Contractor

SYMBOL ID /D:XL824028-FBR:770/0 DATE 91-06-05 09.33

| | | | |
|---|----------|----|-------|
| 1 | AS BUILT | 15 | 91 21 |
| 2 | | 2 | |


=72
33kV BUSBAR ZONE2
VOLTAGE TRANSFORMER -T36


| | |
|----------------------------------|----------------------------|
| Design checked by B NILSSON | CIRCUIT DIAGRAM |
| Drawing checked by L SVENSSON | S/S 8501 132/33kV |
| Drawn by SK | SCECO CENTRAL SAUDI ARABIA |
| | ABB HV SWITCHGEAR |


L 9743.1017
XL 824 028-FBR

| | |
|----------|-------|
| Drawn by | Sheet |
| 1 | 770 |
| 2 | 771 |

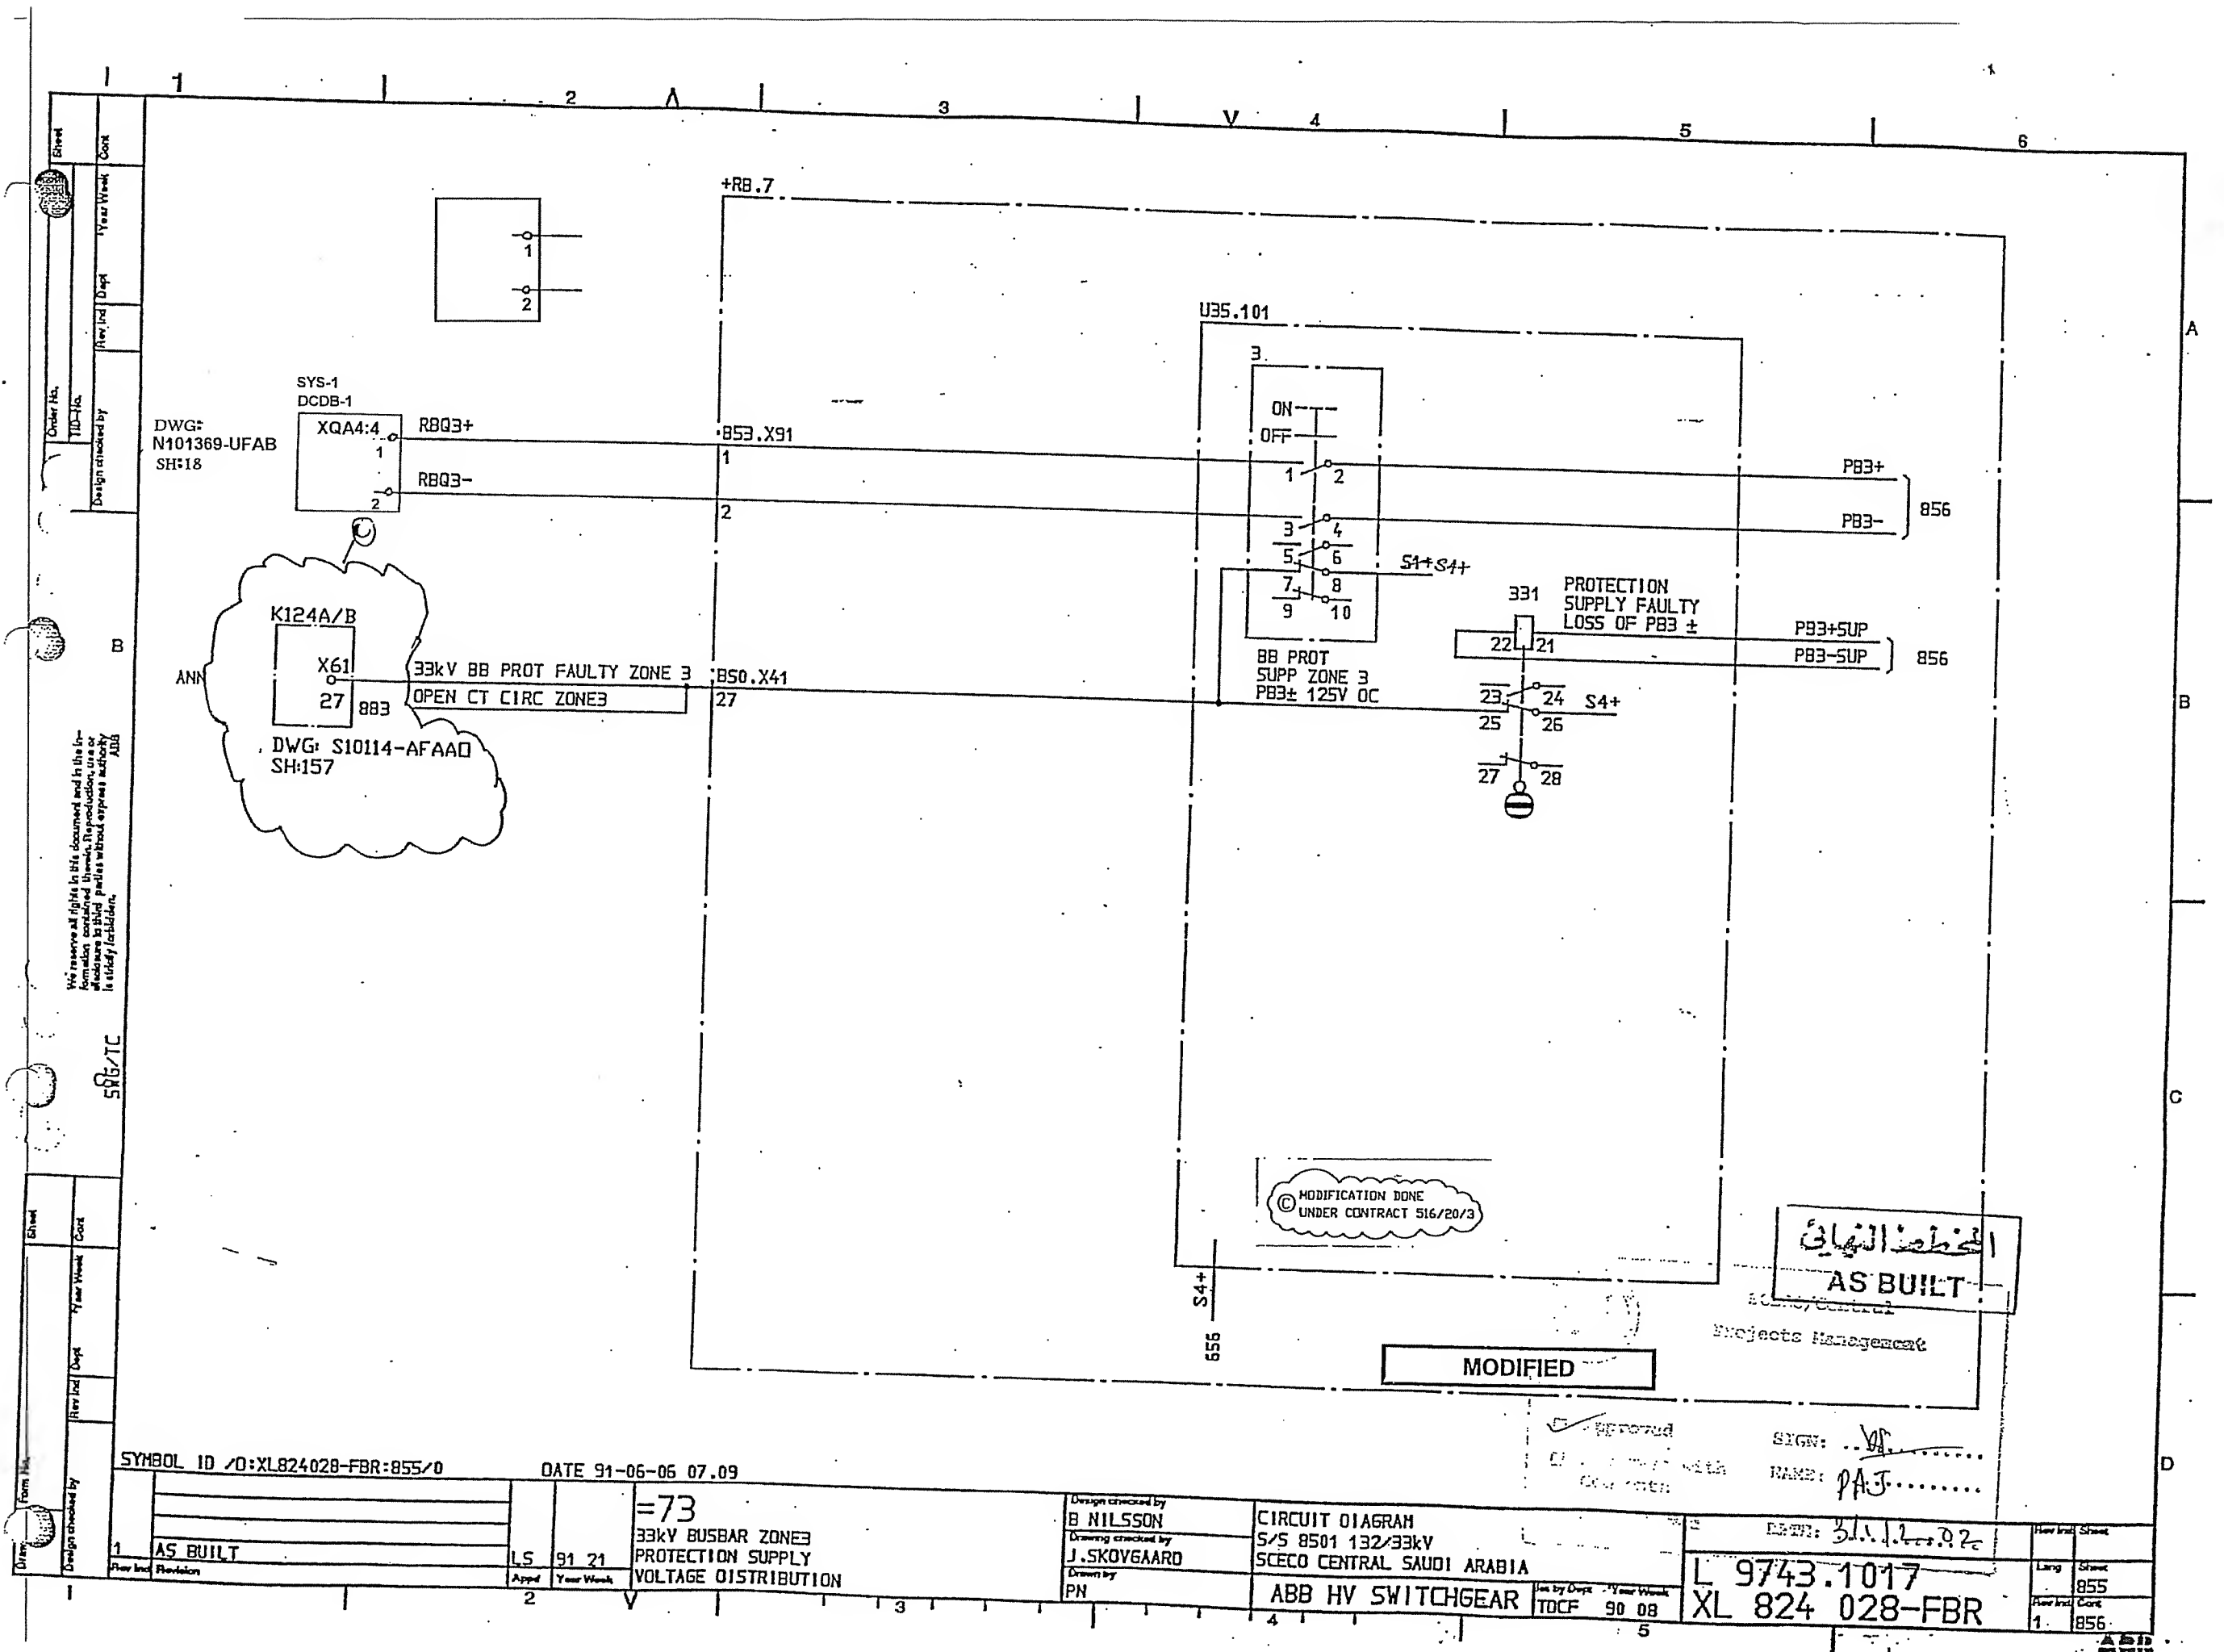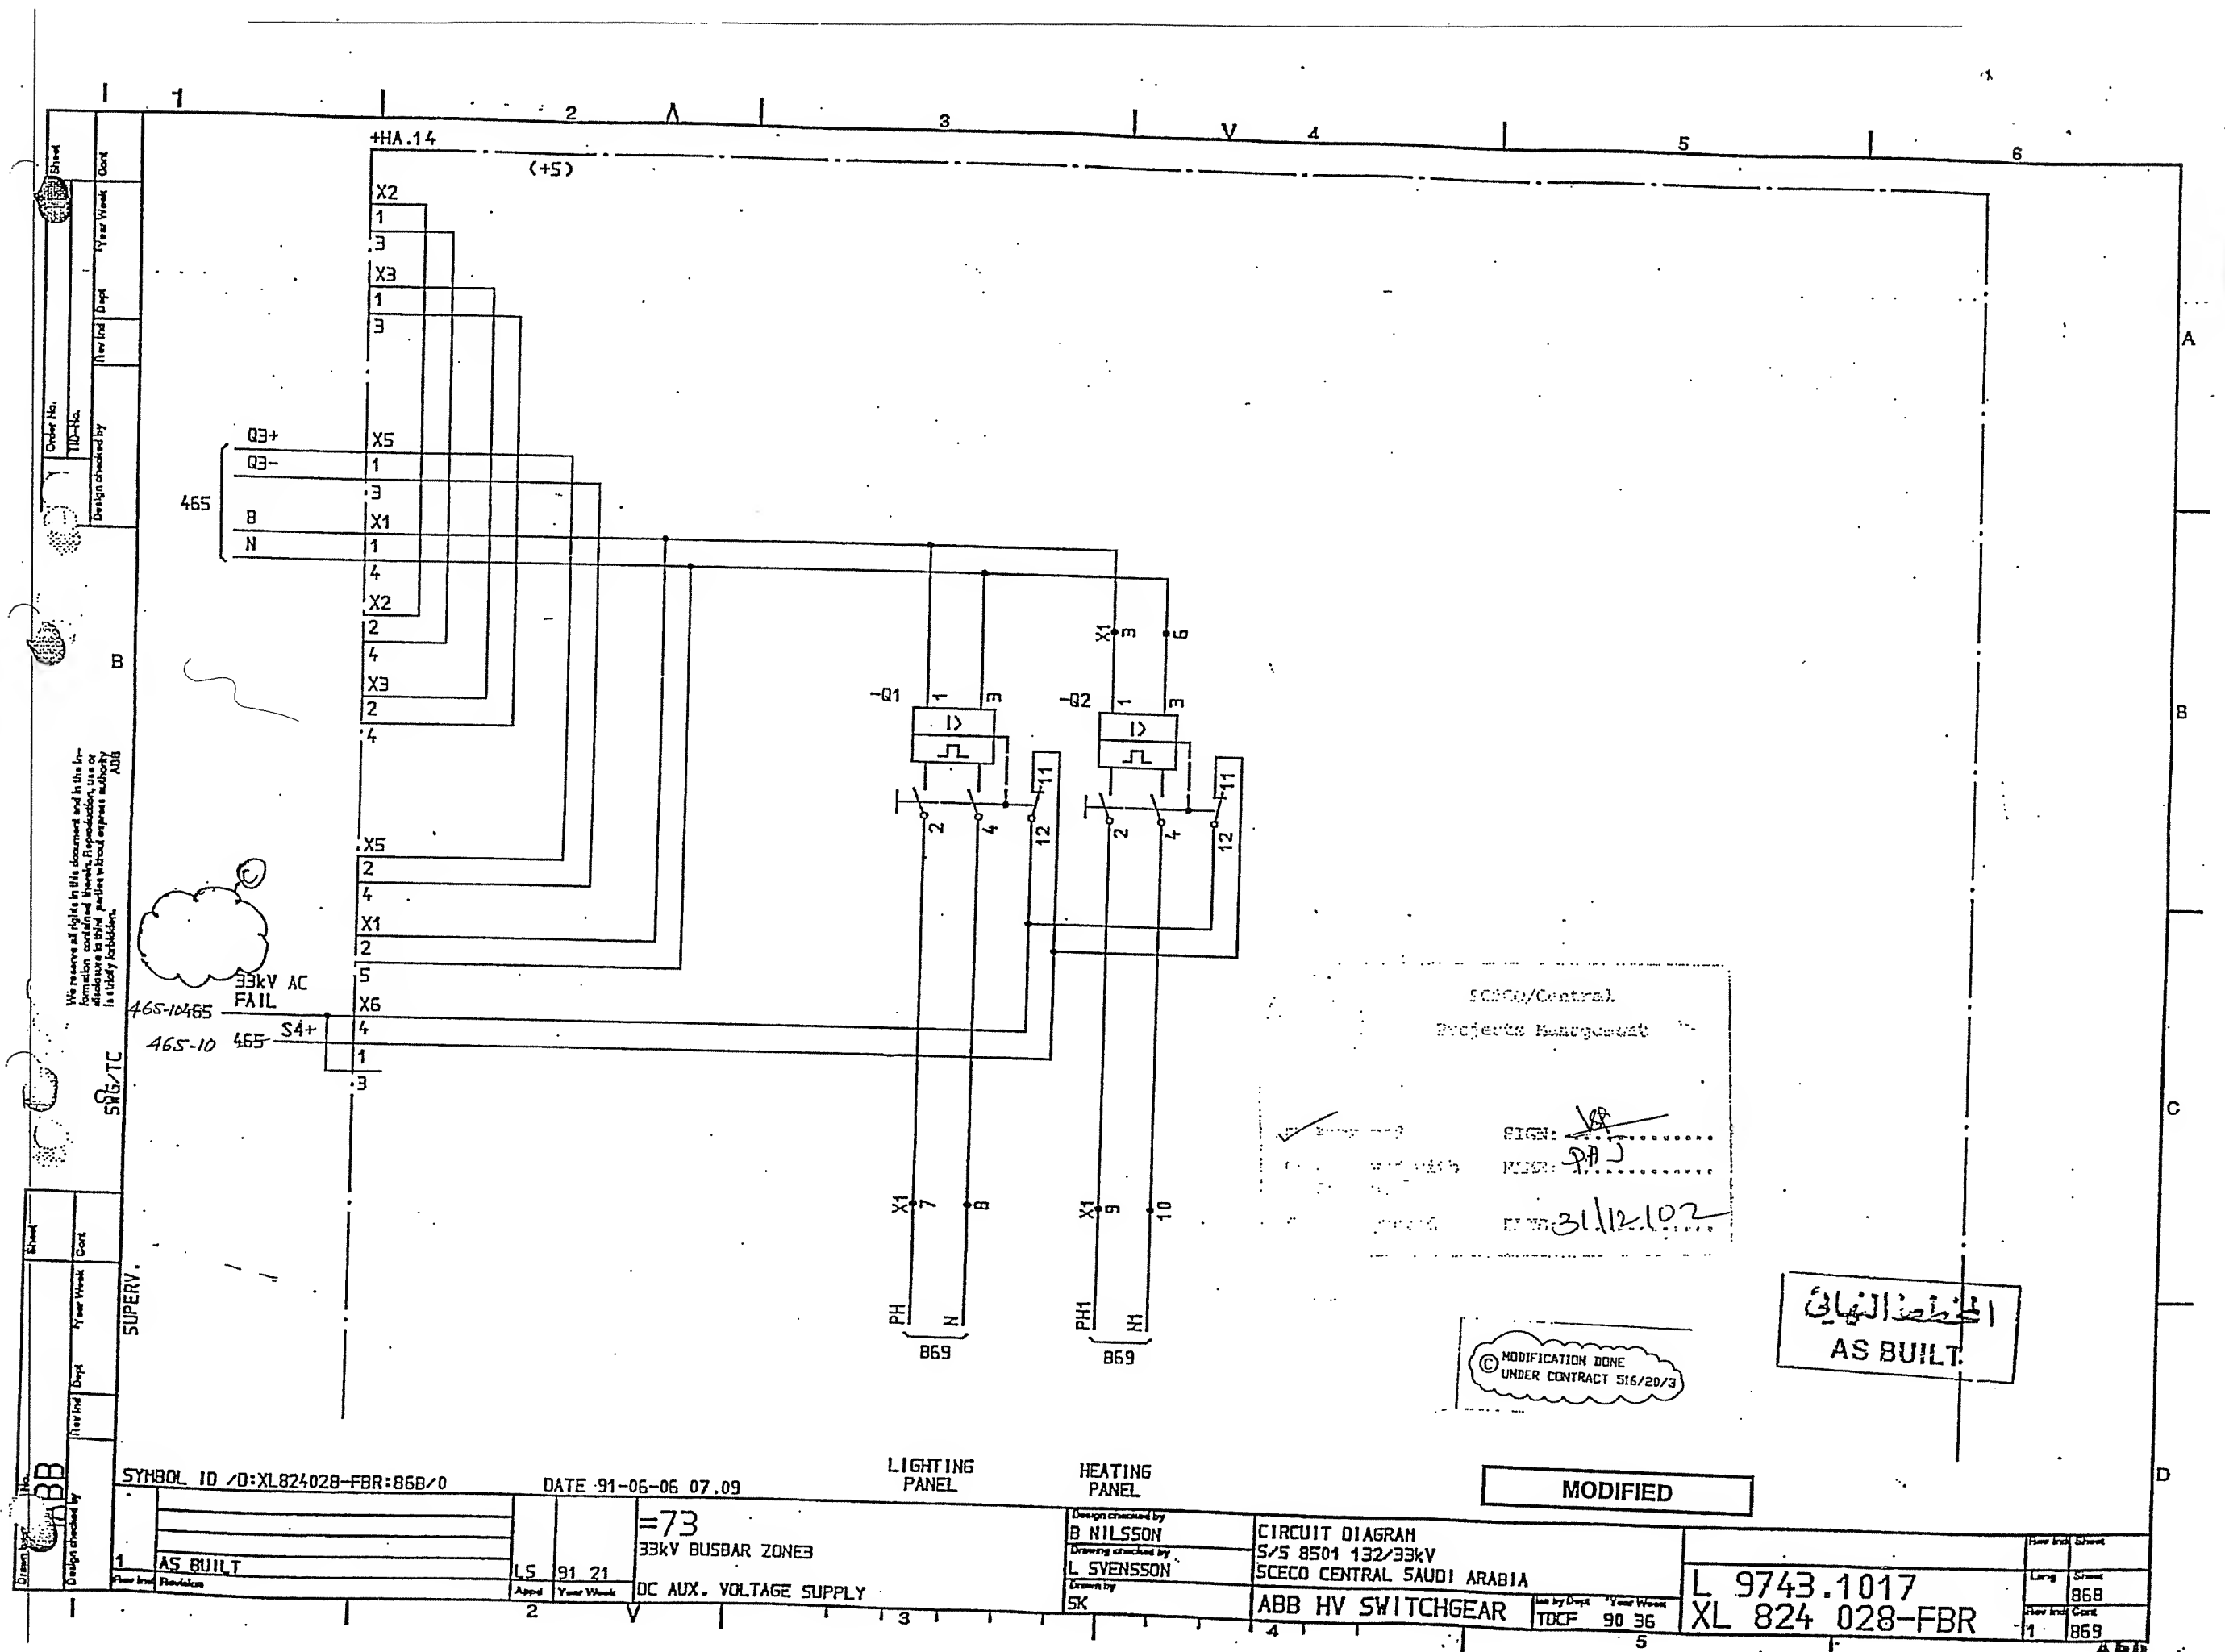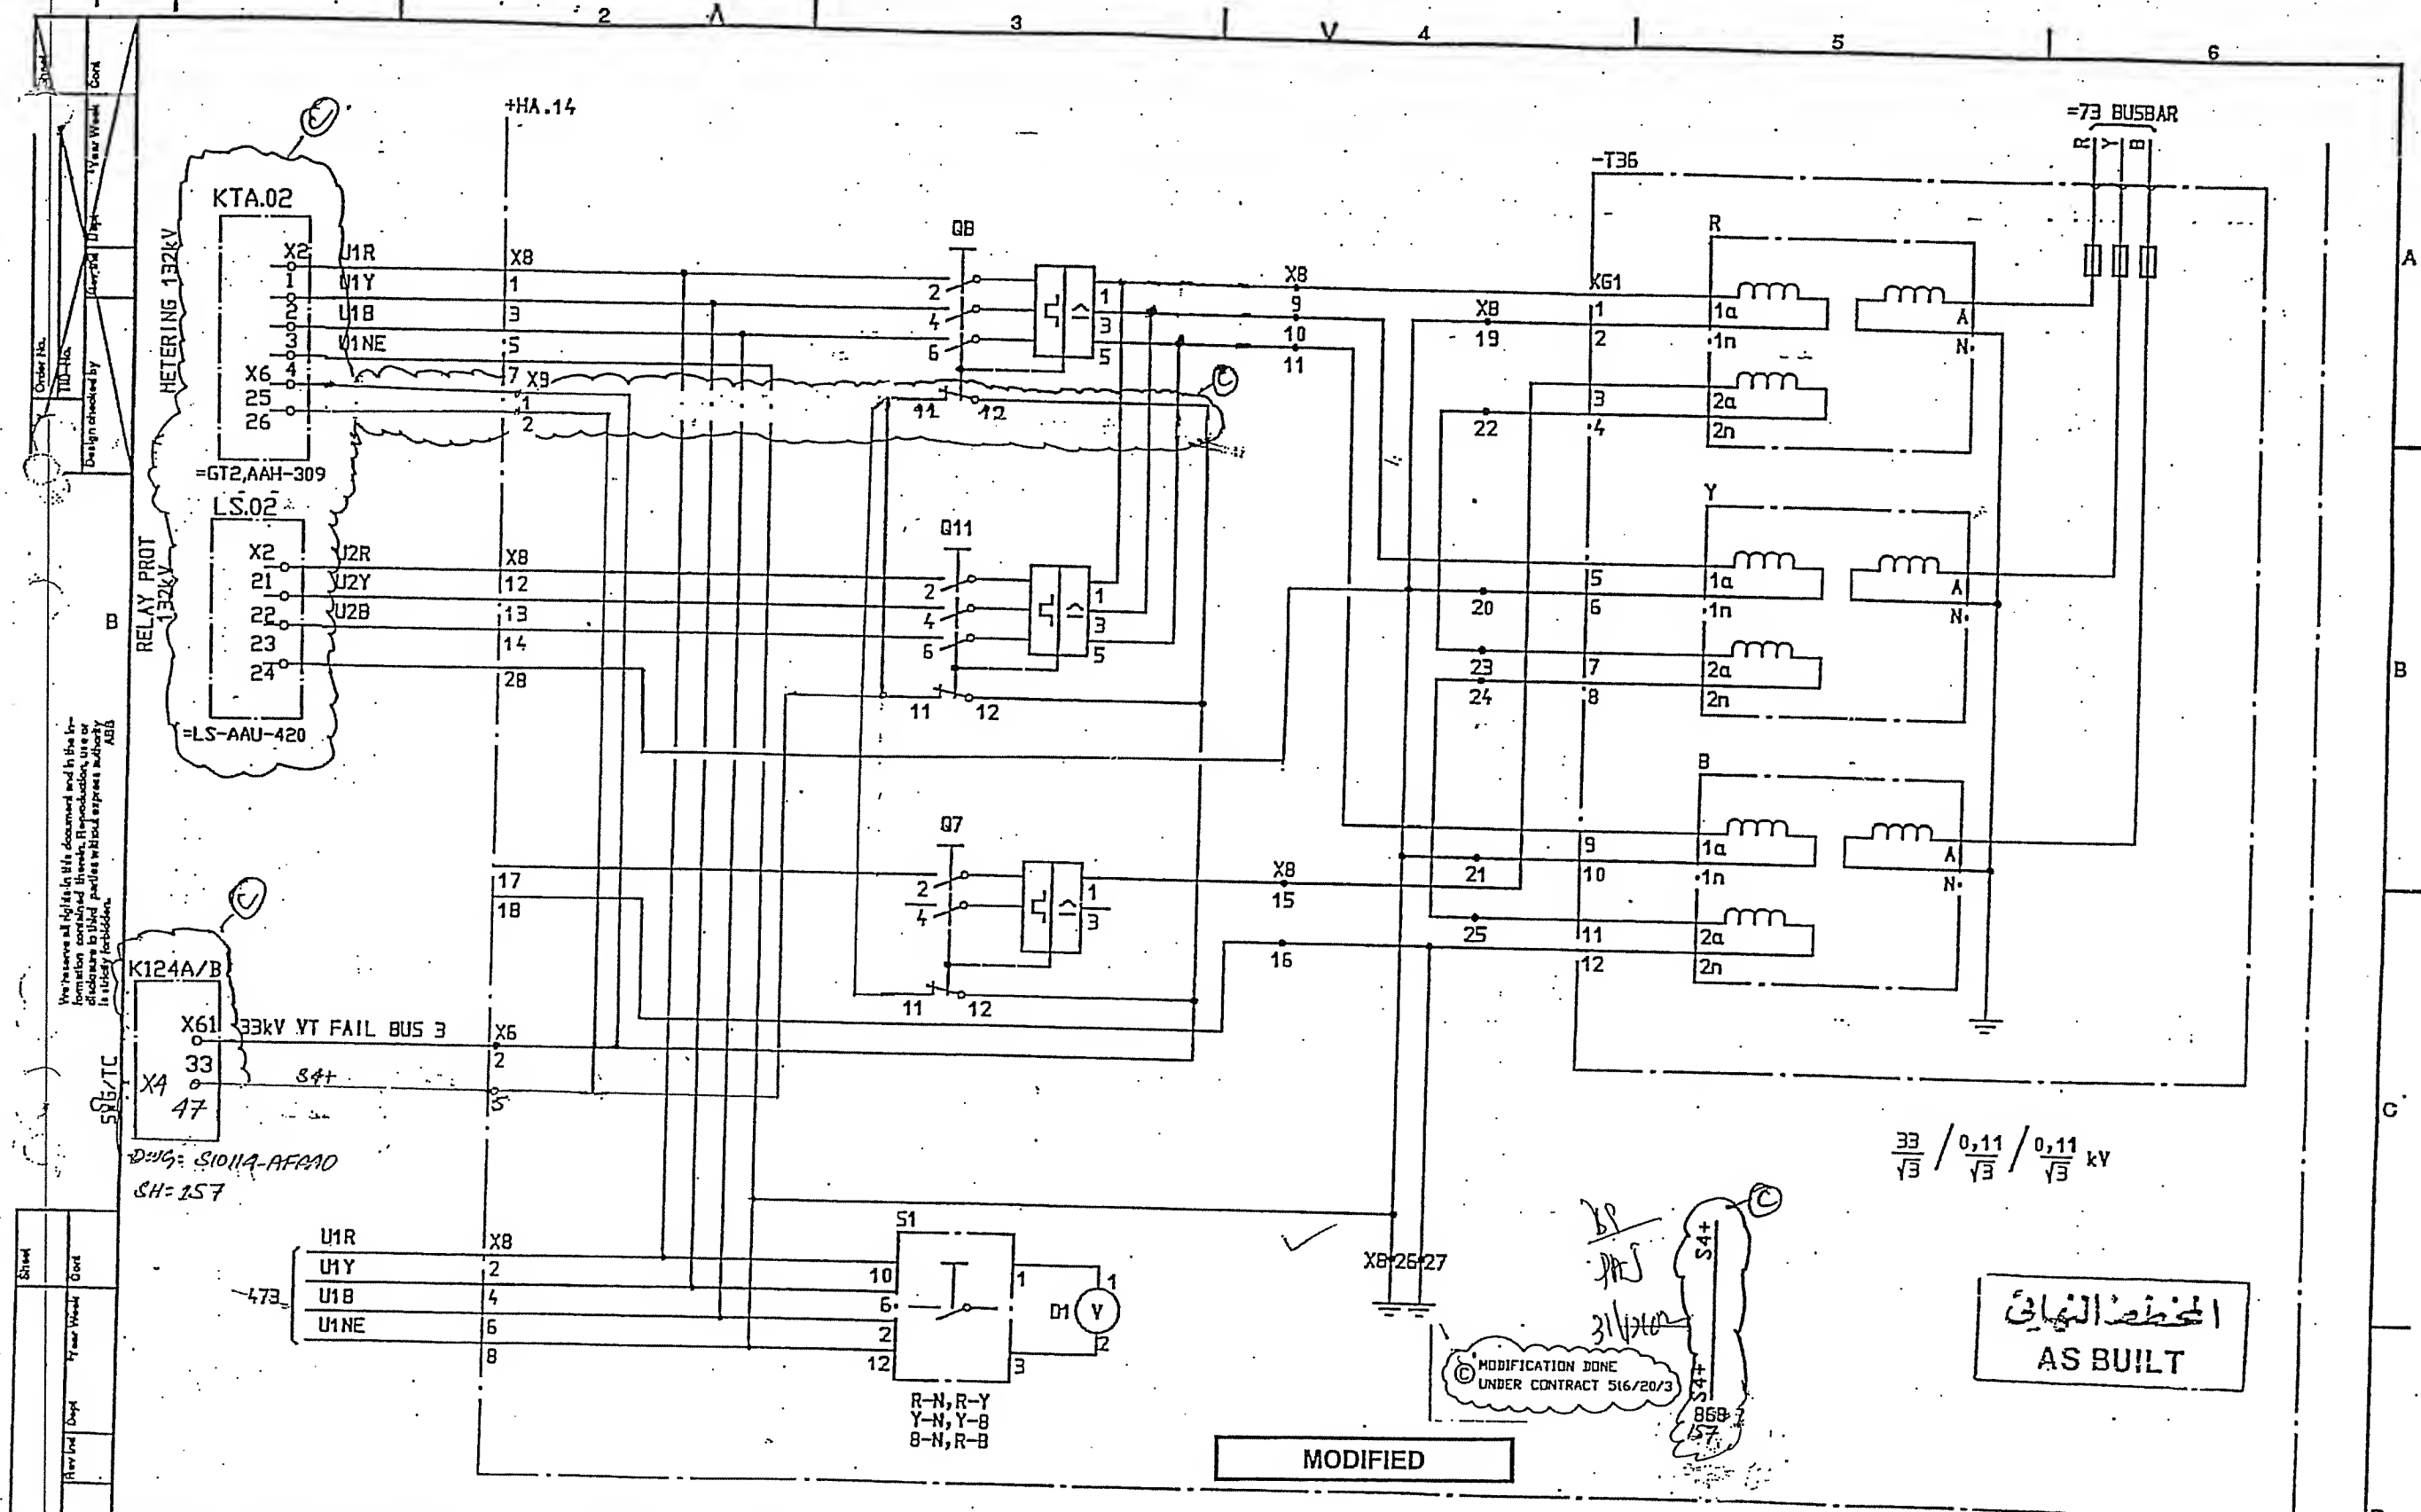ABB







المحطة النهائية
AS BUILT

MODIFICATION DONE
UNDER CONTRACT 516/20/3

MODIFIED

SYMBOL ID /O:XL824028-FBR:870/0

DATE 91-06-06 07.09

| | | | |
|----|----------|----|-------|
| 1 | AS BUILT | LS | 91 21 |
| 2 | | | |
| 3 | | | |
| 4 | | | |
| 5 | | | |
| 6 | | | |
| 7 | | | |
| 8 | | | |
| 9 | | | |
| 10 | | | |


=73
33kV BUSBAR ZONE
VOLTAGE TRANSFORMER -T35

Design checked by
B NILSSON
Drawing checked by
L SVENSSON
Drawn by
SK

CIRCUIT DIAGRAM
S/S 8501 132/33kV
SCECO CENTRAL SAUDI ARABIA
ABB HV SWITCHGEAR


L 9743.1017
XL 824 028-FBR


| | |
|----------|-------|
| How Incl | Sheet |
| Long | 870 |
| How Incl | 880 |
| 1 | |

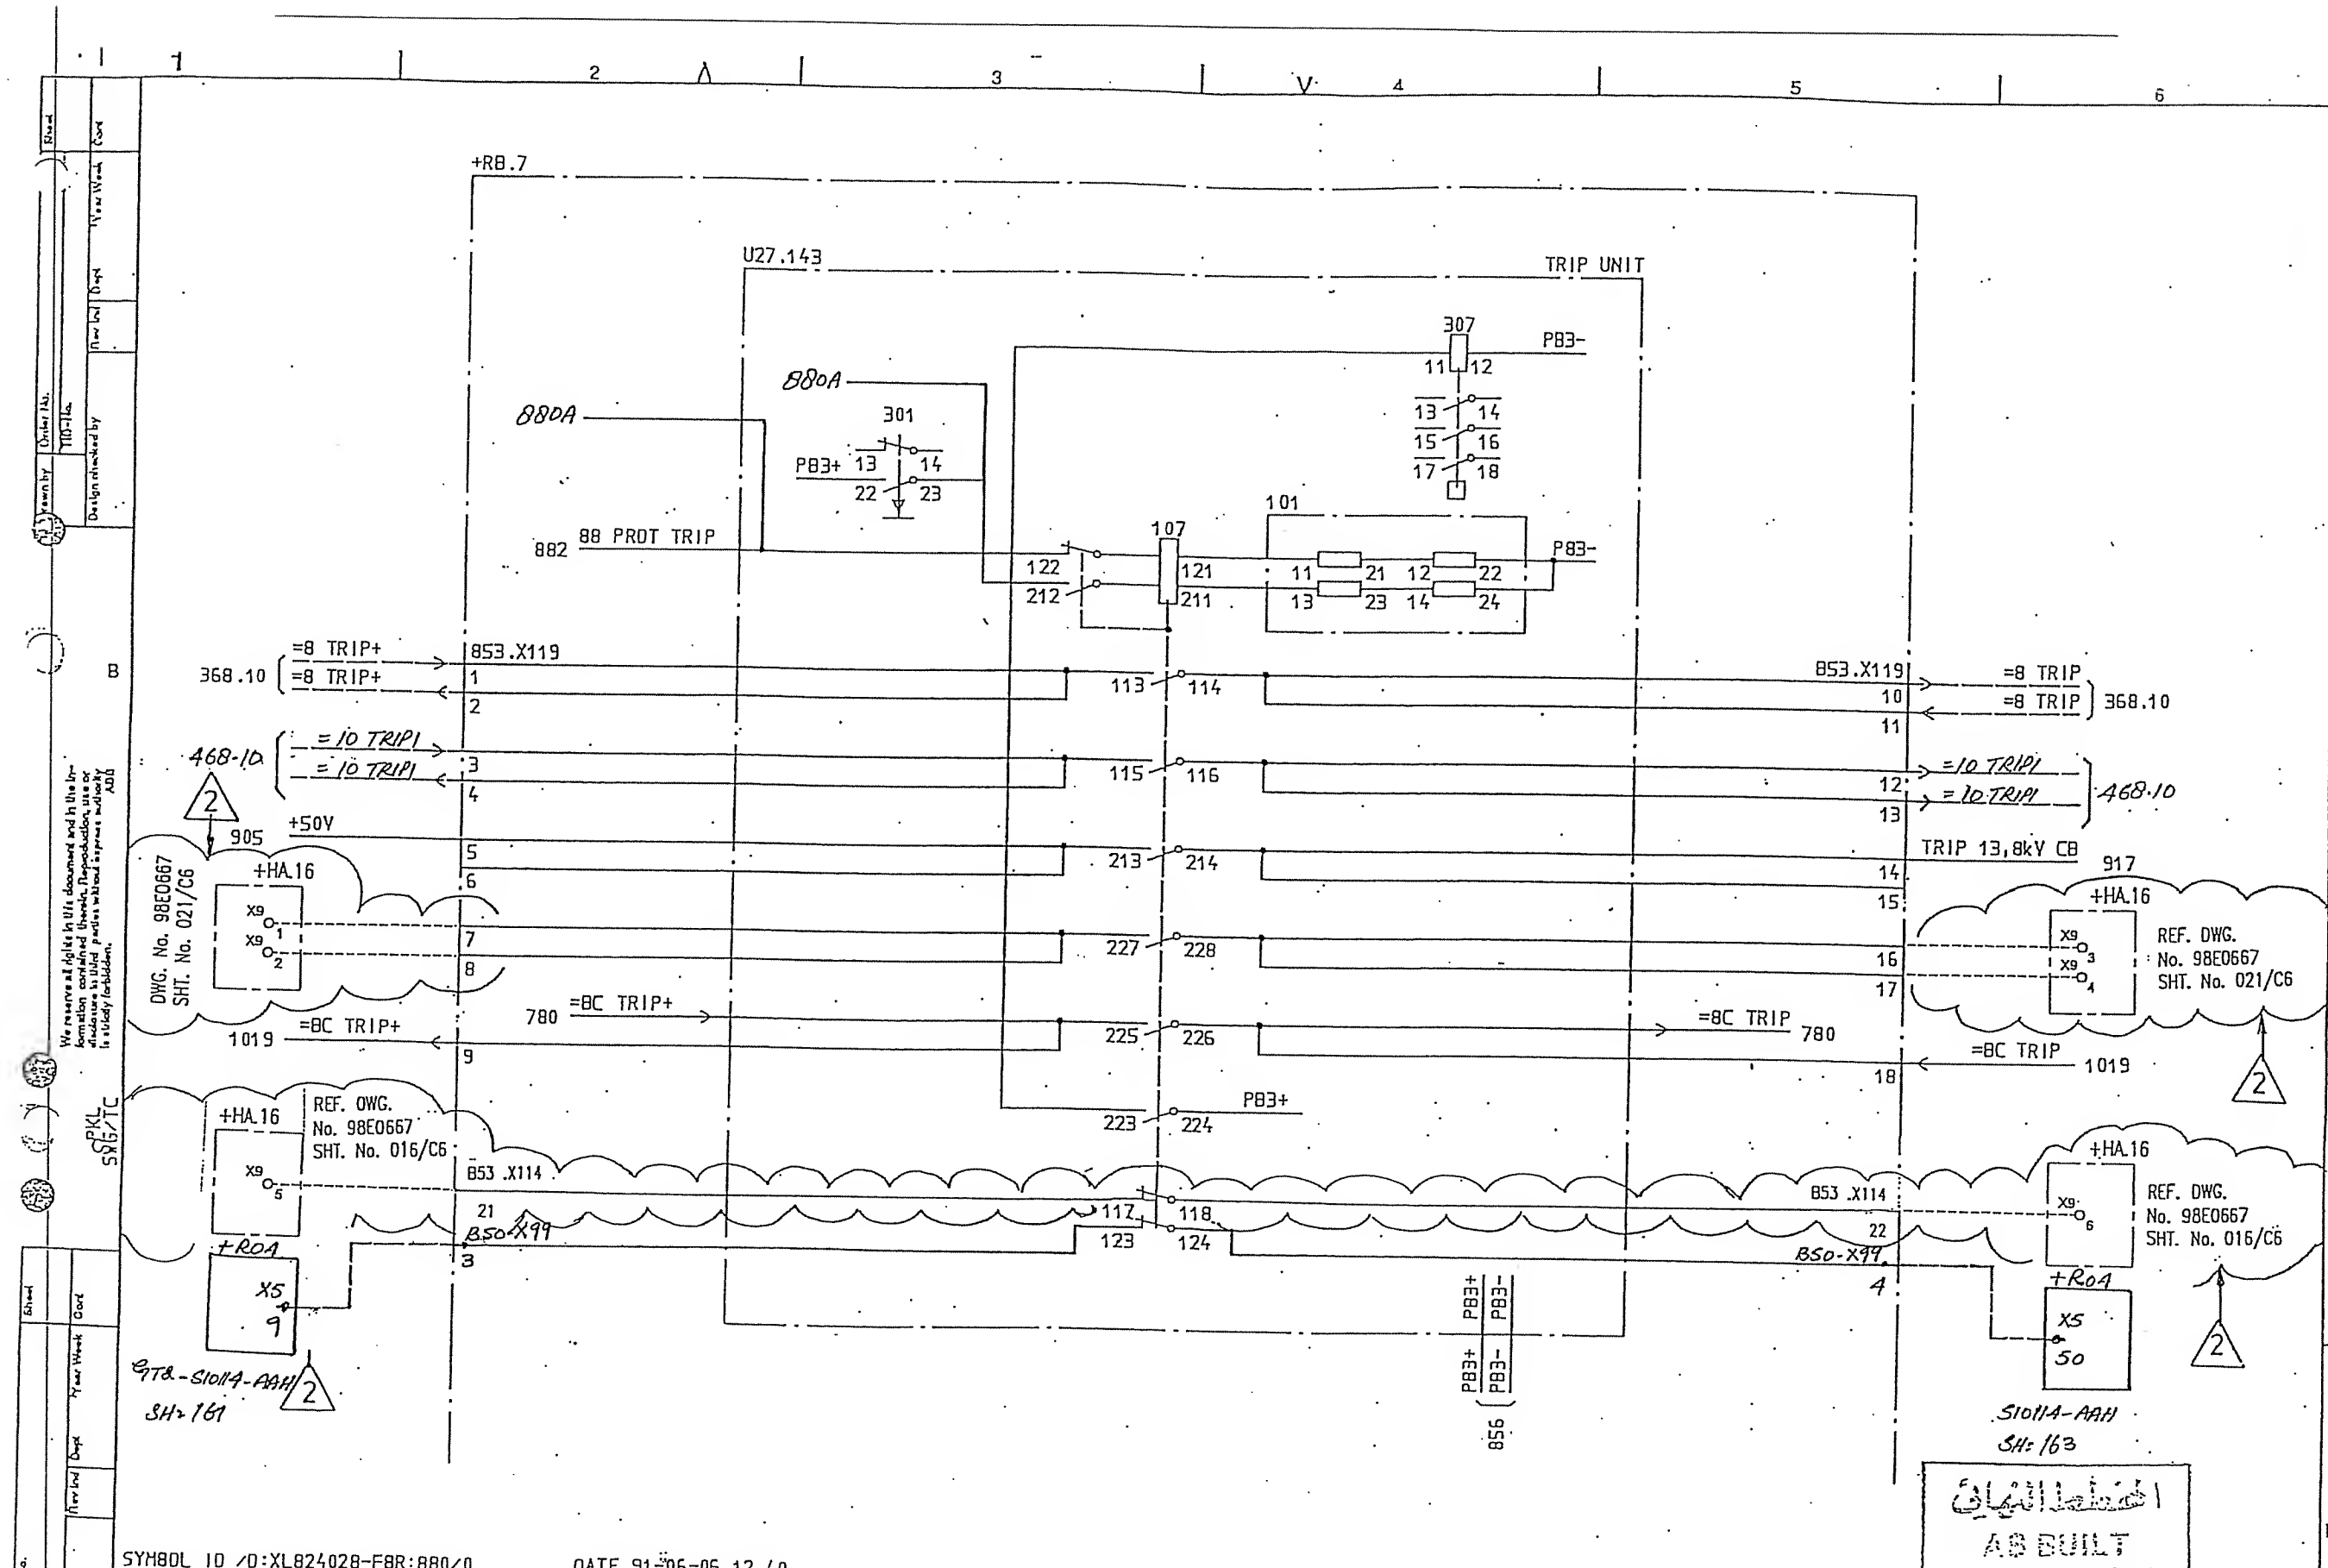

| | | | | | | | | | | | | | | | |
|----------------------------------|--|---------------------|--|---------------------------------|--|---|--|-----------------------|--|-------------------------------|--|-----------------------|--|-------------------|--|
| SYMBOL 10 / 0:XL824028-FBR:880/0 | | DATE 91-06-06 12.40 | | Design checked by B NILSSON | | CIRCUIT DIAGRAM S/S 8501 132/33kV SCECO CENTRAL | | Rev by Date Year Week | | L 9743.1017 XL 824 028-FBR | | Rev by Date Year Week | | Long Sheet 880 | |
| 2 REVISED TO SUIT EXTENSION | | 00 08 | | Drawing checked by B MALHROS | | ABB HV SWITCHGEAR TOCF 90 15 | | 1A | | 5 | | 2 | | 880A | |
| 1 AS BUILT | | LS 91 21 | | Drawn by 1A | | | | | | | | | | | |
| | | | | | | | | | | | | | | | |

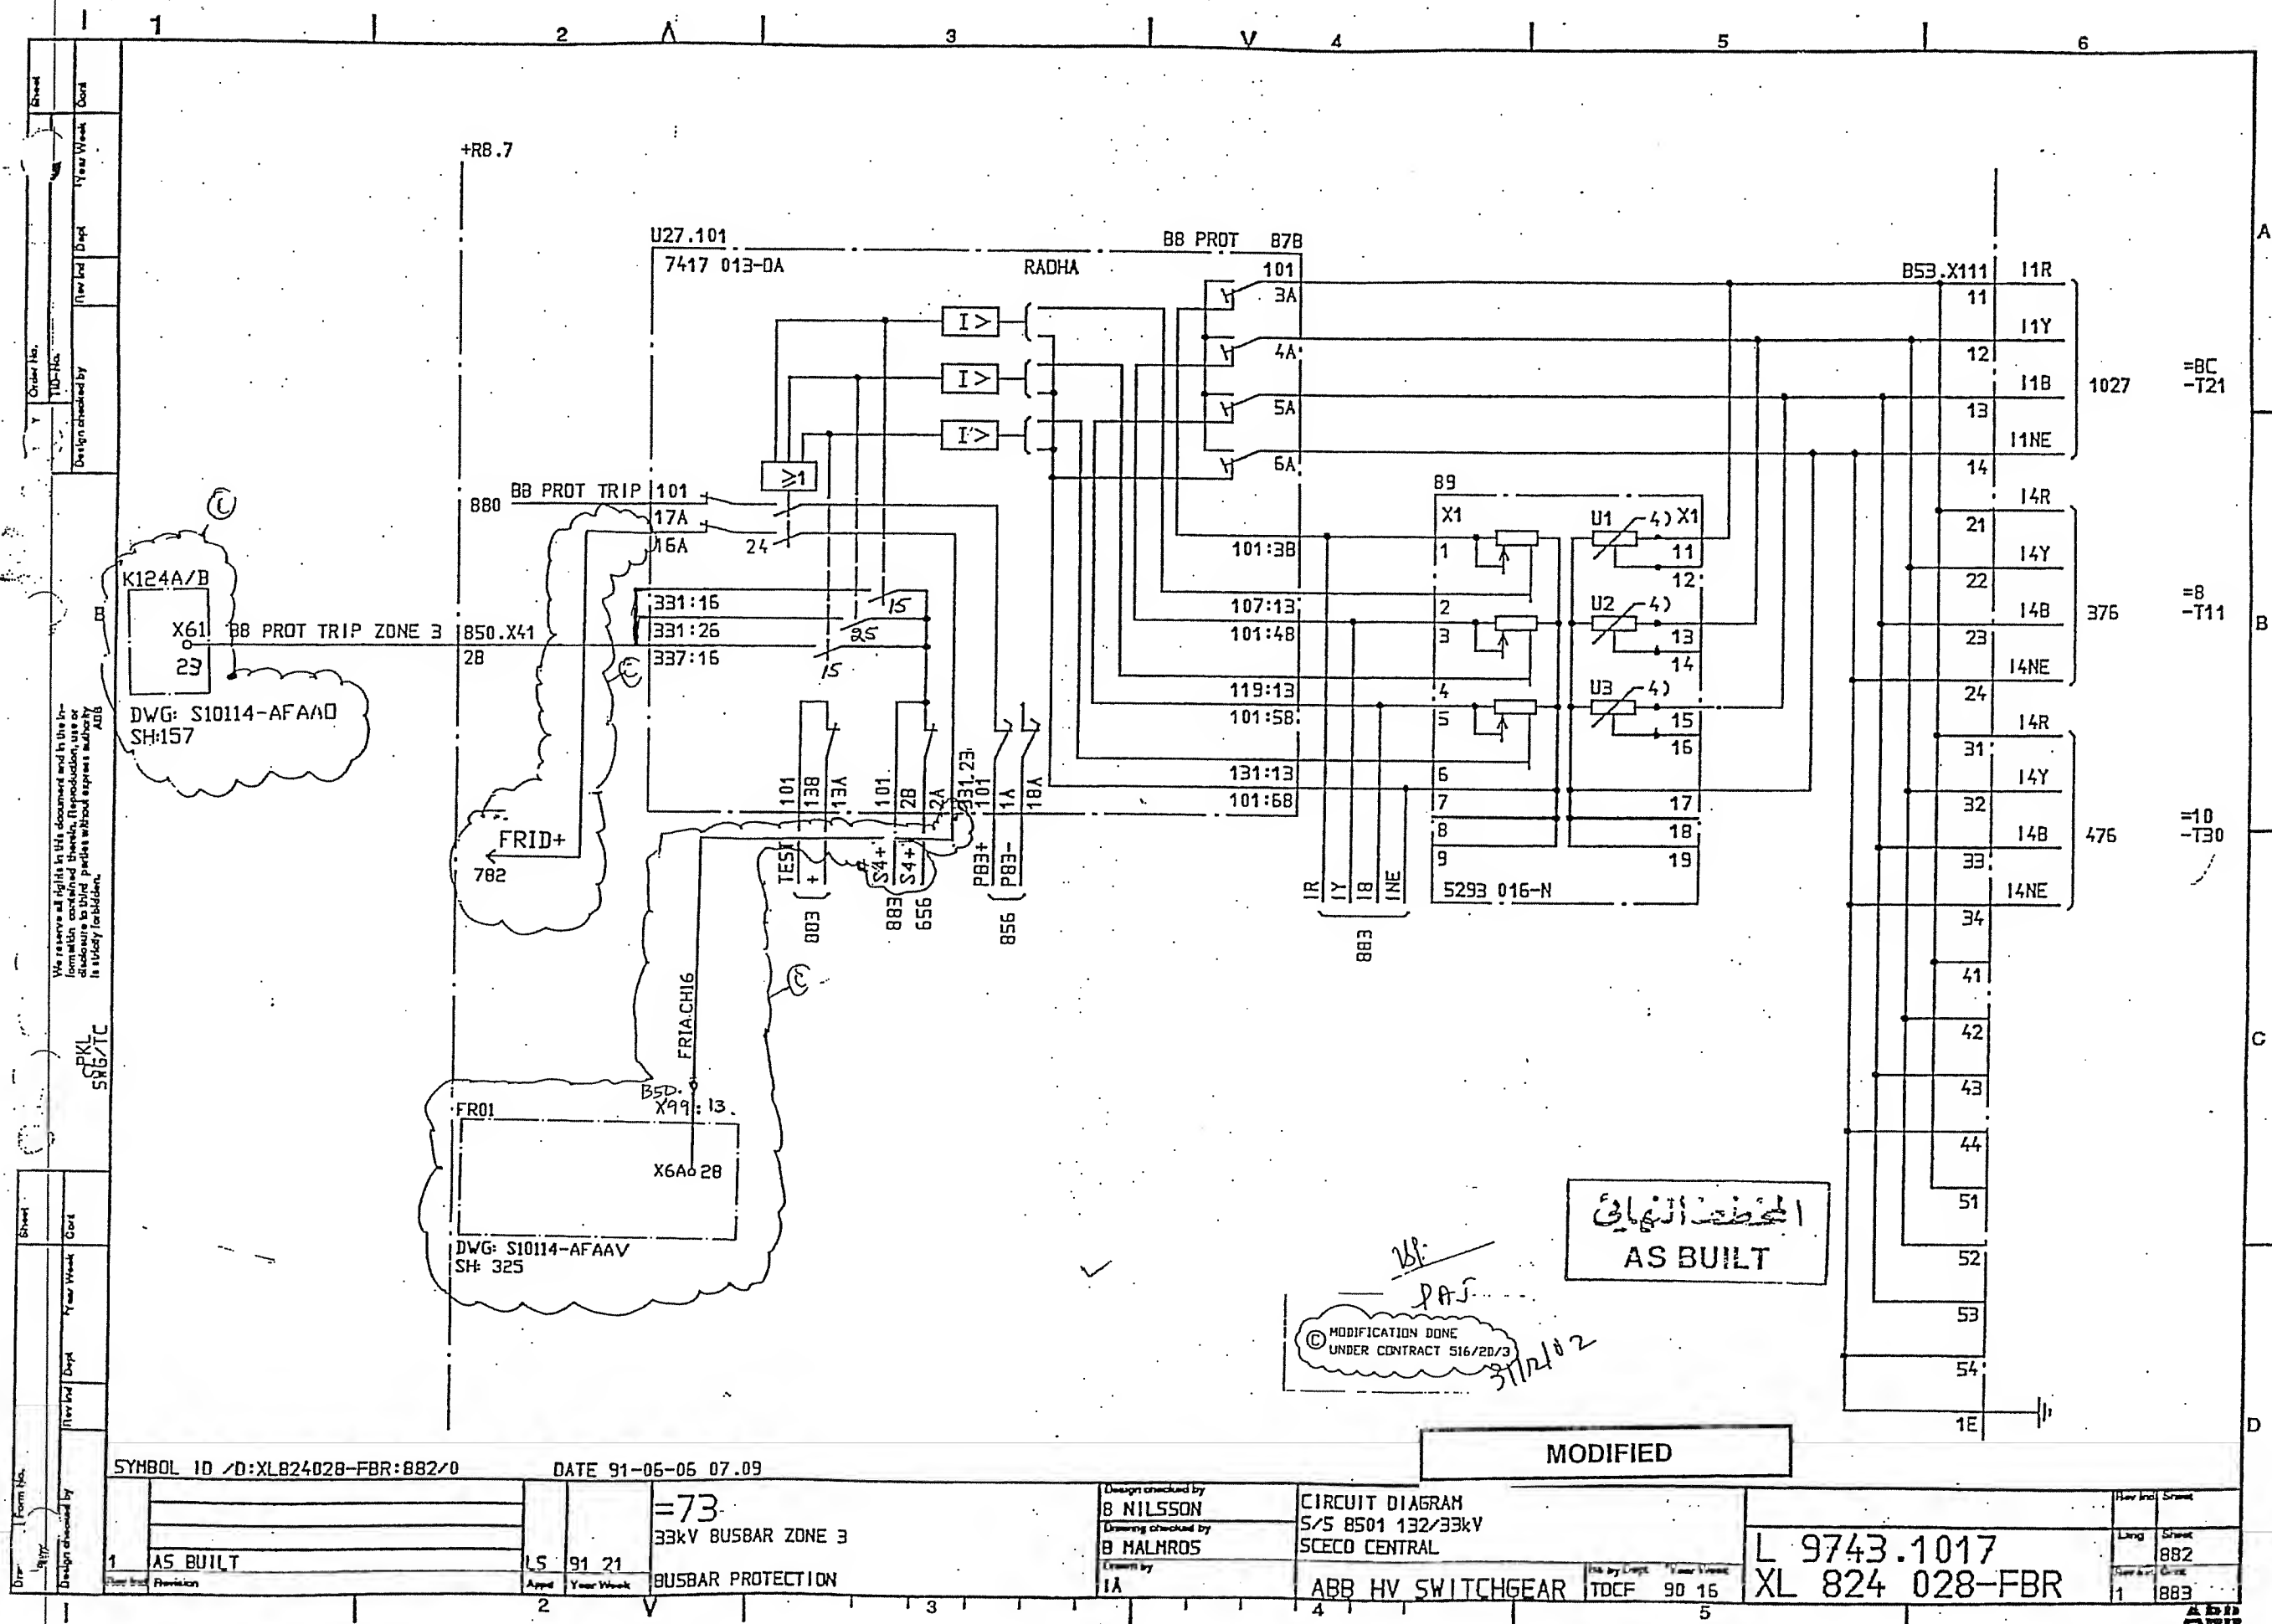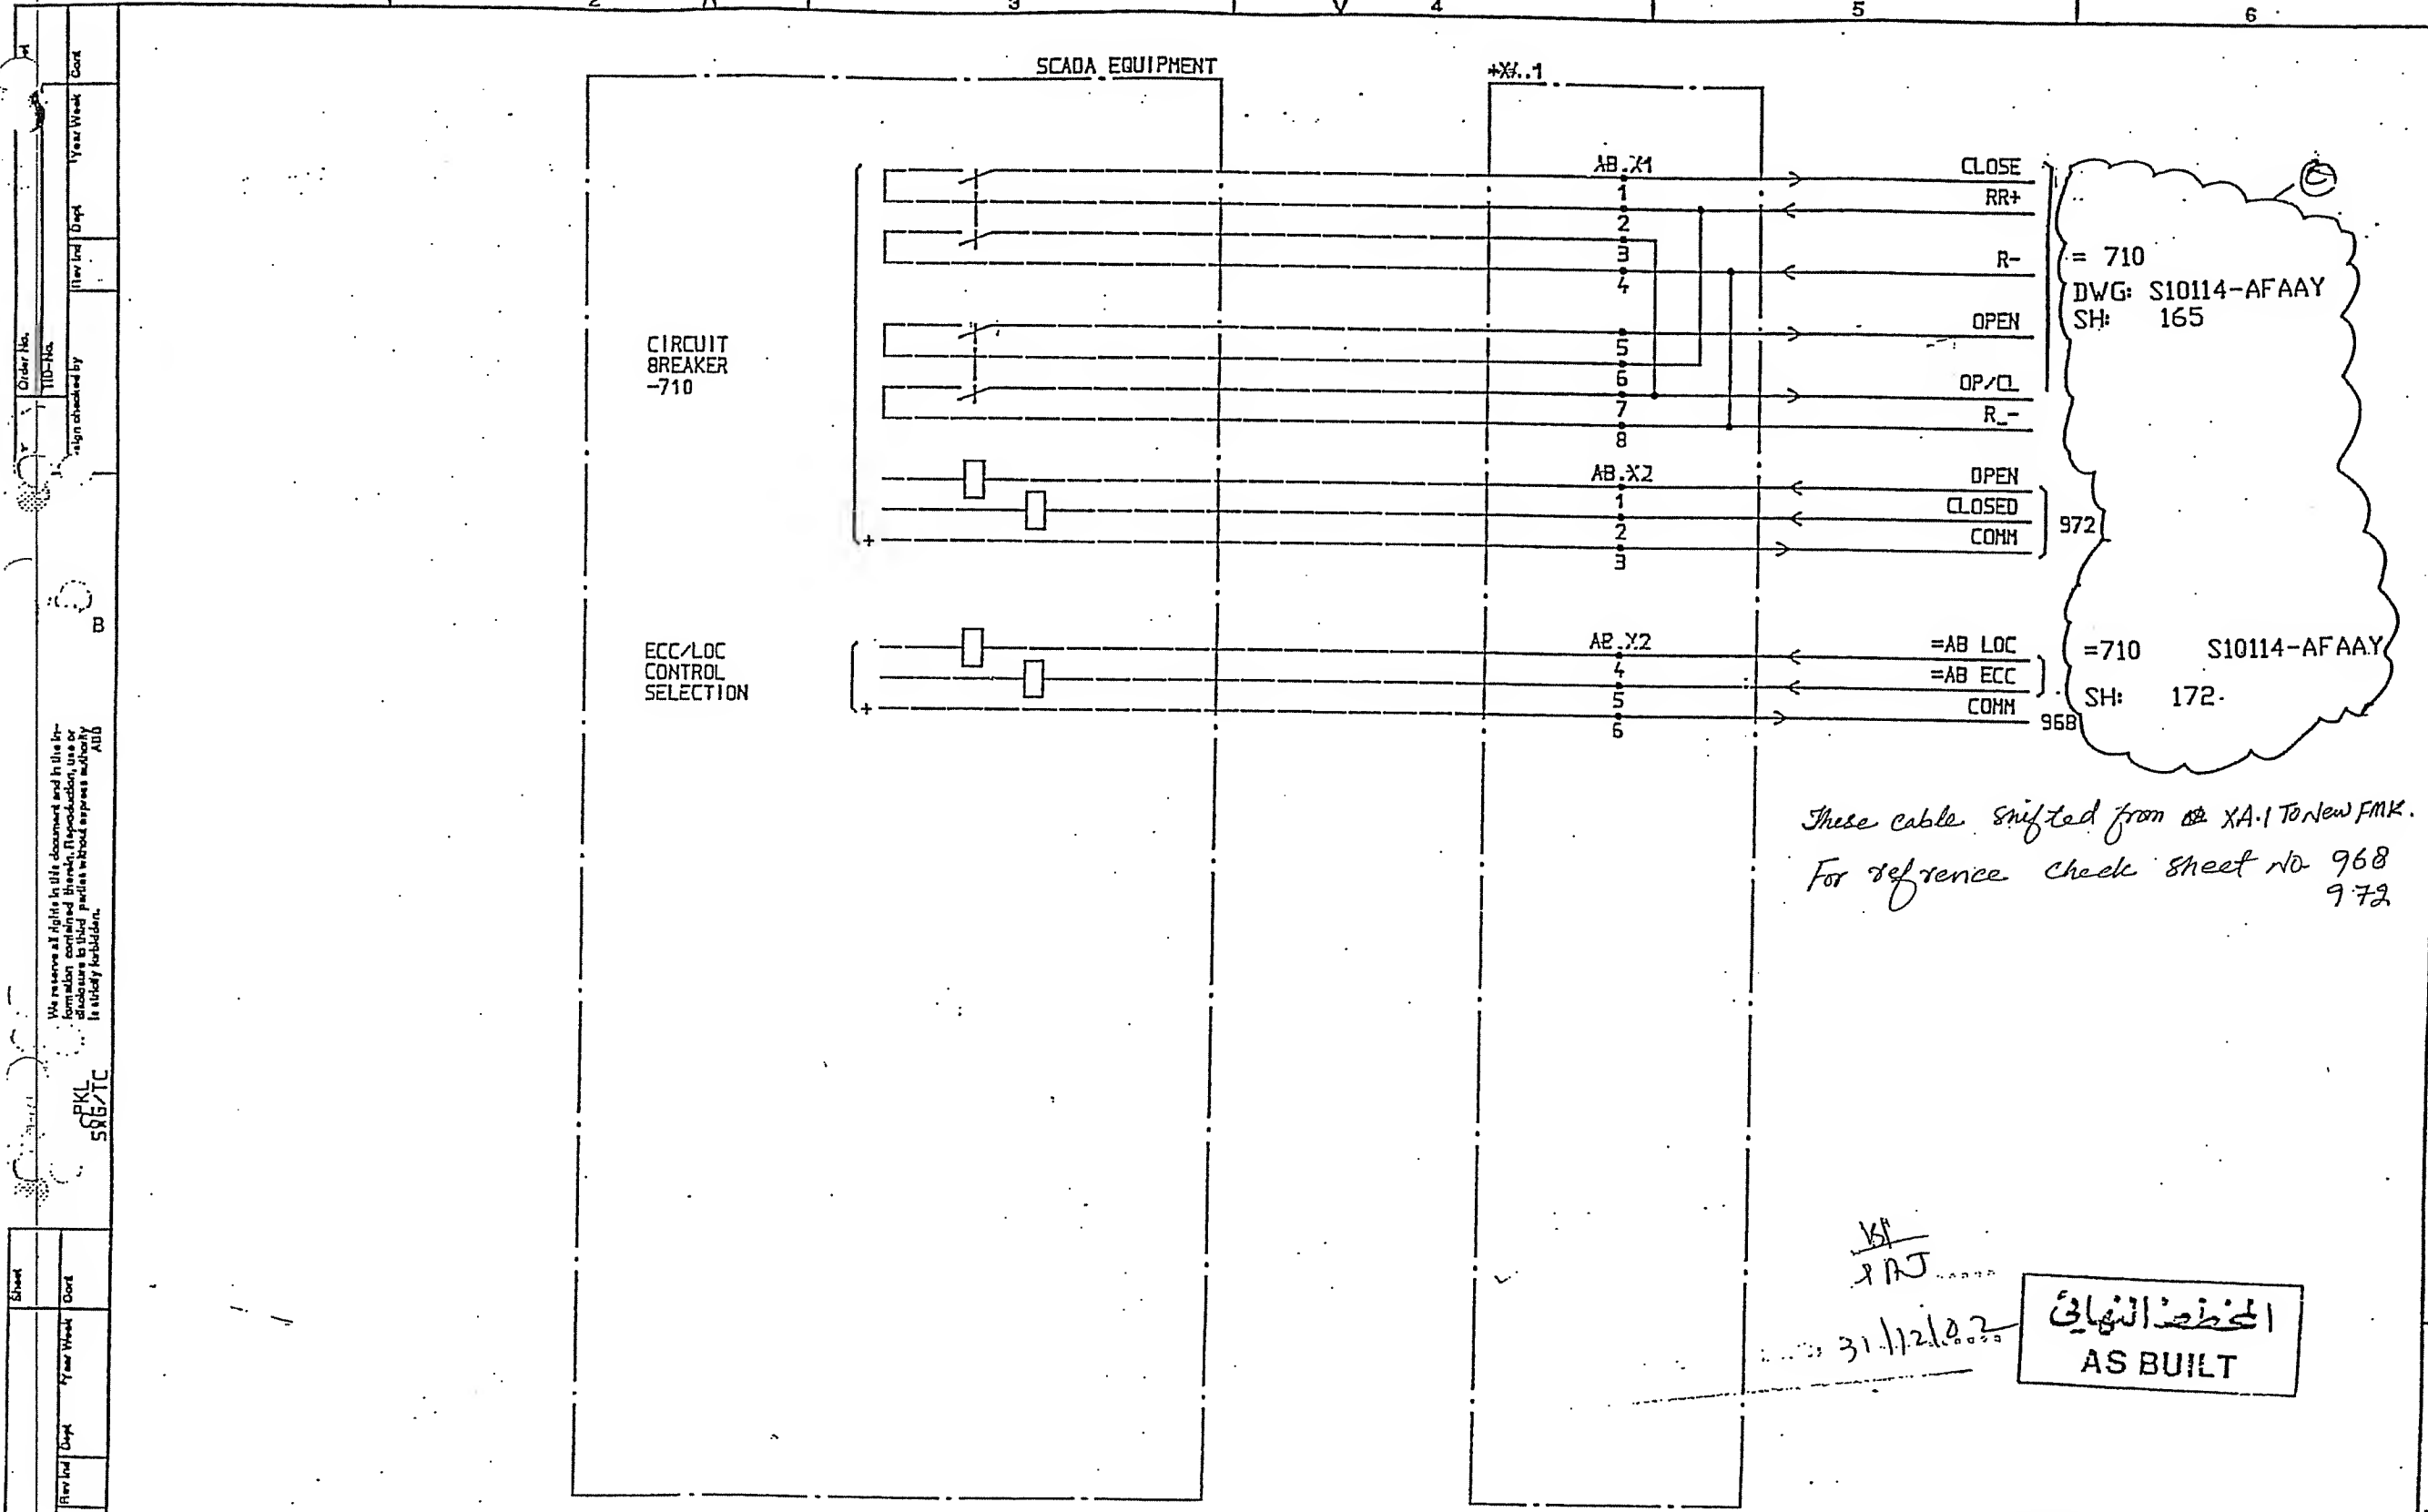الخطات المبنية
AS BUILT






| | | | | | | | | | | | | | | | |
|---------------------------------|----------|--|----|---------------------|----|---------------------------|--------------------|-----------|----------------------------|-----|--------------|-----------|-------------------------------|----------|-------|
| SYMBOL ID /0:XLB24028-FBR:962/0 | | | | DATE 91-06-06 07.10 | | | | MODIFIED | | | | | | | |
| Design checked by | | | LS | 91 | 21 | =AB 33kV BUSSECTION | Design checked by | | CIRCUIT DIAGRAM | | How Incl | Sheet | | | |
| | | | | | | | B NILSSON | | S/S 8501 132/33kV | | | | | | |
| | | | | | | | Drawing checked by | | SCECO CENTRAL SAUDI ARABIA | | | | | | |
| | | | | | | | L SVENSSON | | | | | | | | |
| 1 | AS BUILT | | | | | SCADA INTERFACE EQUIPMENT | Drawn by | | ABB HV SWITCHGEAR | | Line by Dept | Year Week | L 9743.1017 XL 824 028-FBR | How Incl | Sheet |
| | Revision | | | | | | Appd | Year Week | PN | TCF | 90 10 | 1 | | | |
| | | | | | | | | | | | | | | | |
| | | | | | | | | | | | | | | | |
المخطط النهائي
AS BUILT

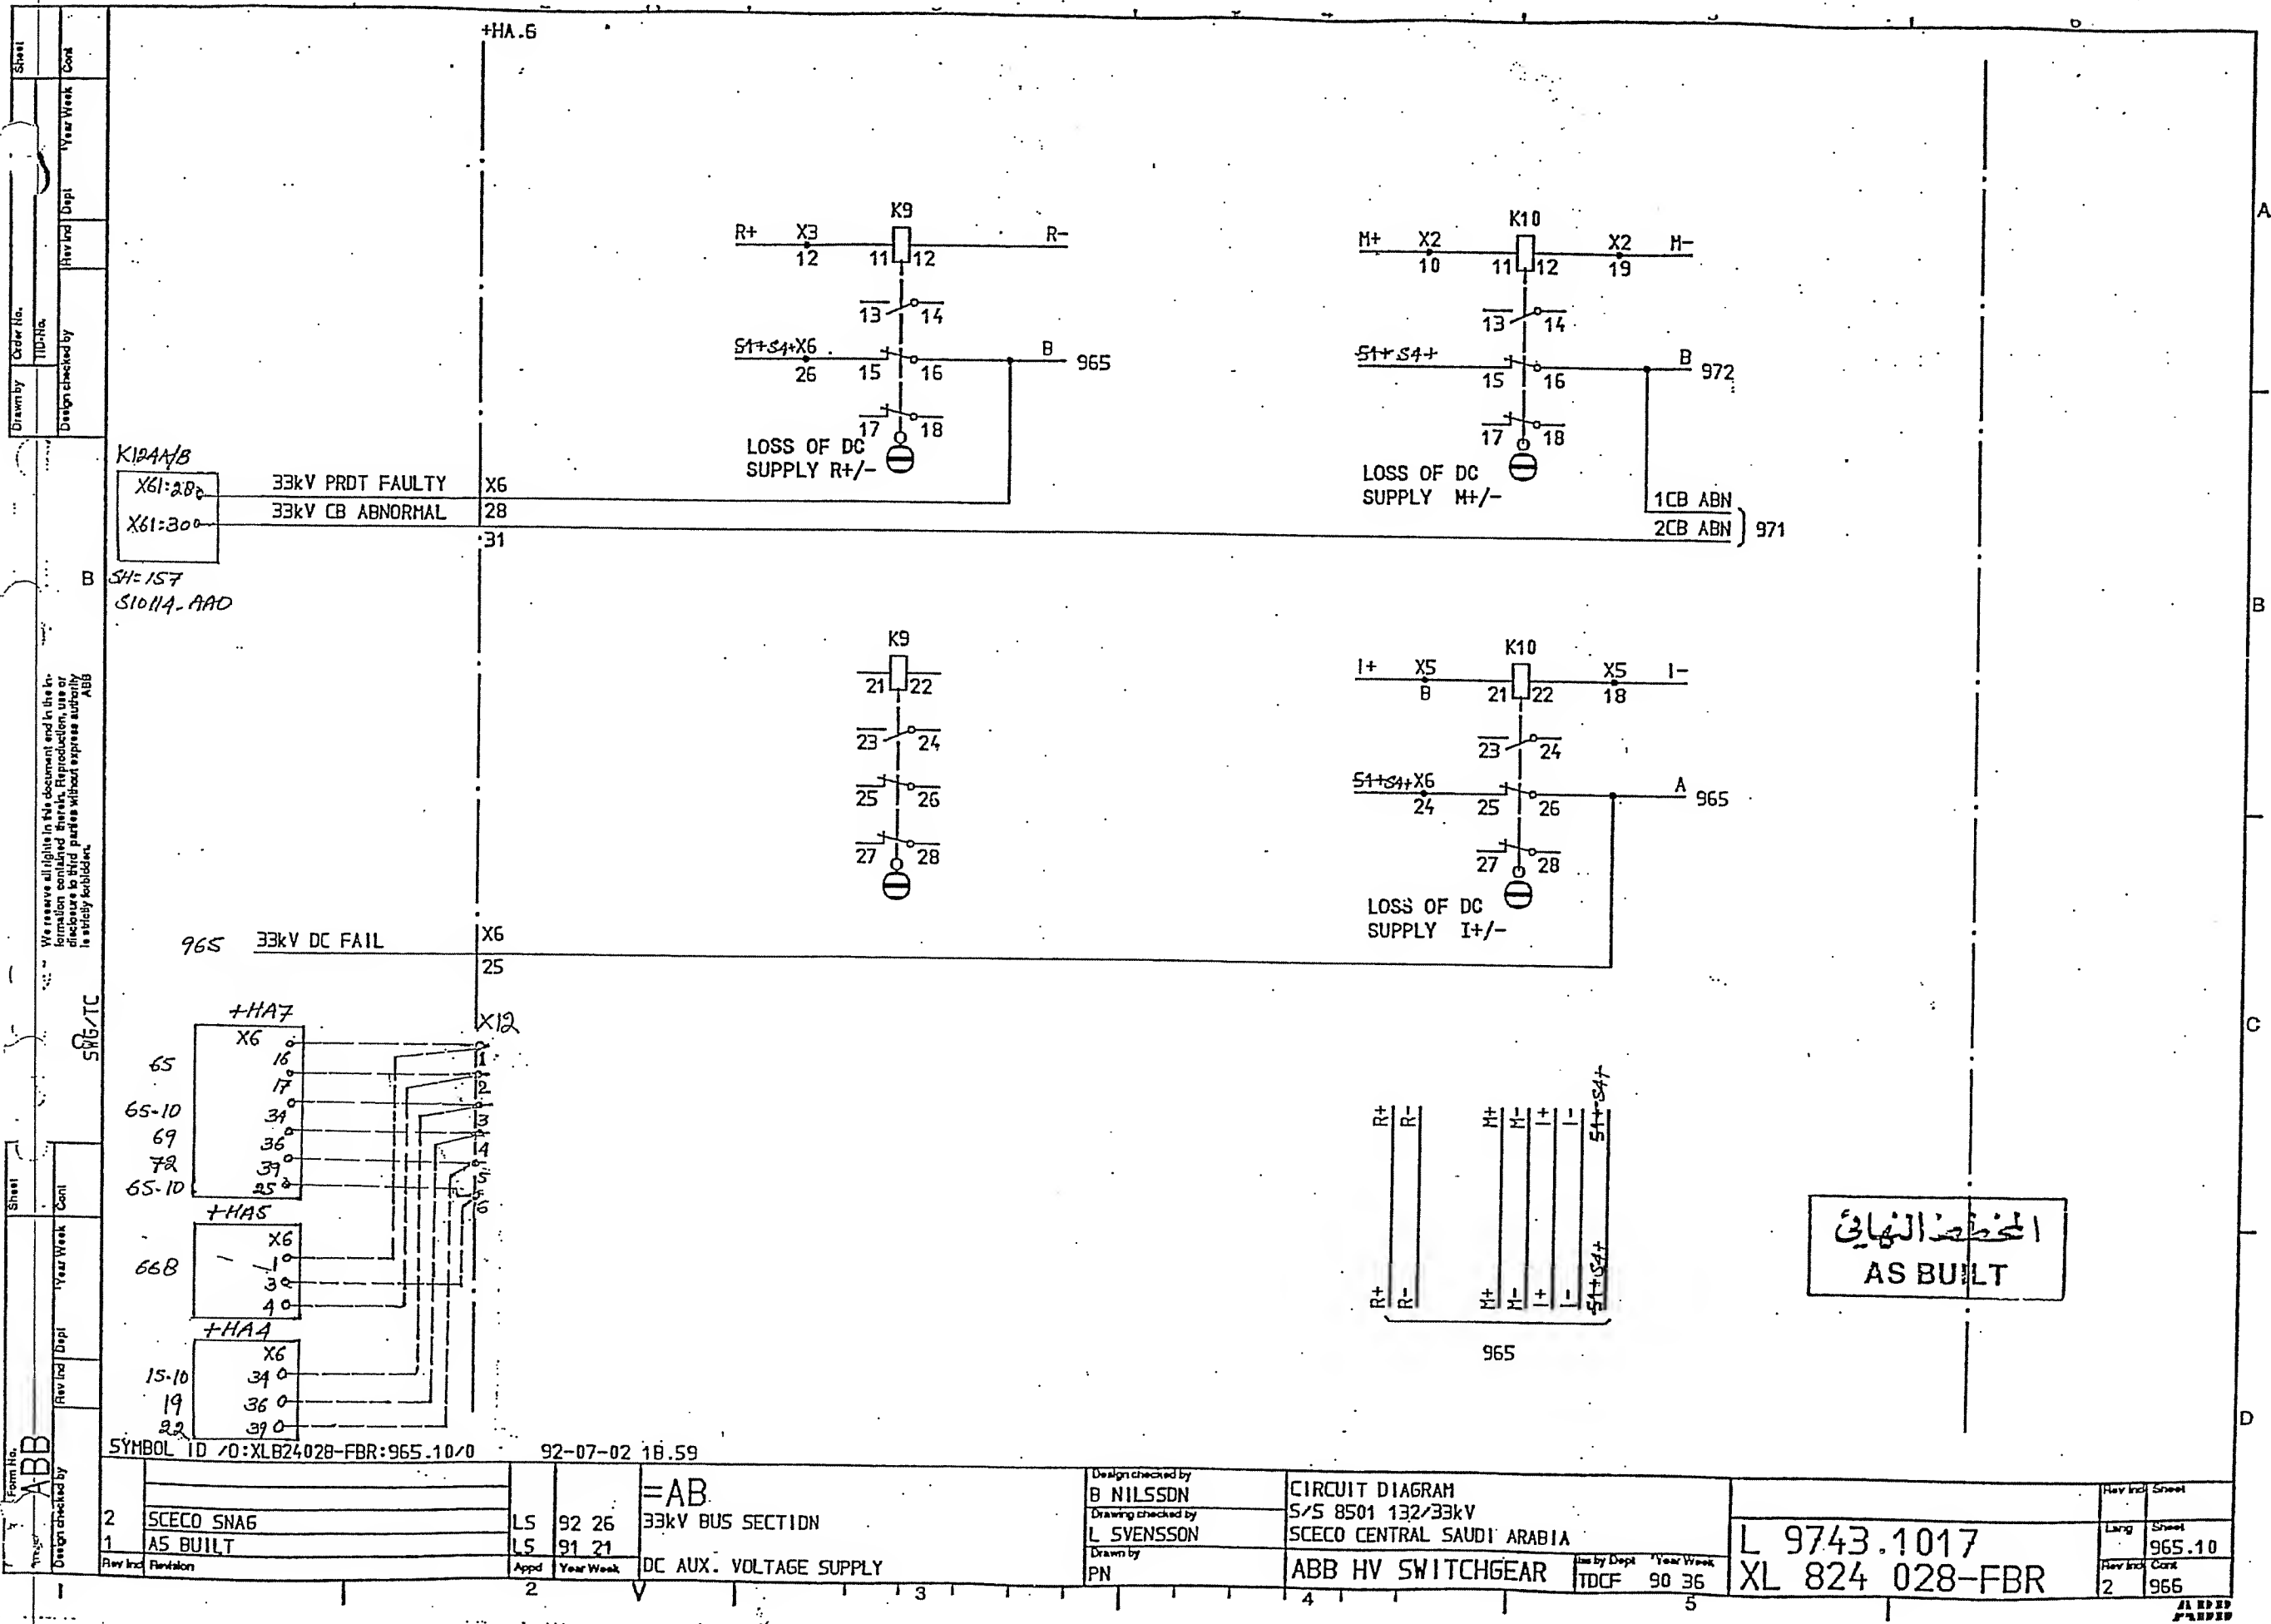ABB




المخطط النهائي
AS BUILT

K12A/B
X61:28
X61:30
33kV PRDT FAULTY
33kV CB ABNORMAL
X6
28
31

B
SH-157
S10114-AAD

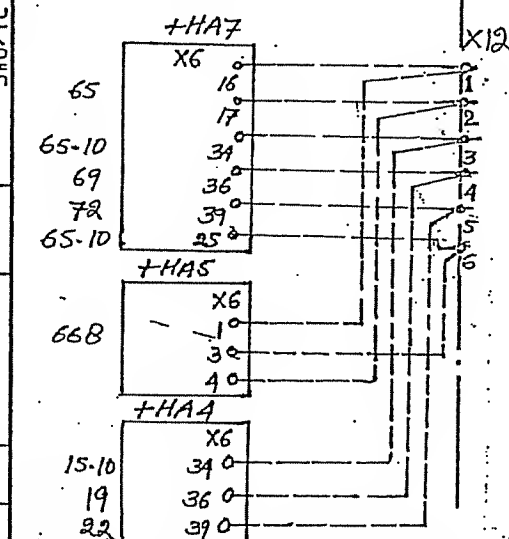965 33kV DC FAIL
X6
25



SYMBOL ID /0:XL824028-FBR:965.10/0

92-07-02 18.59


| | | | | |
|---------|------------|------|-----------|------------------------|
| 2 | SCECO SNAG | LS | 92 26 | =AB |
| 1 | AS BUILT | LS | 91 21 | 33kV BUS SECTION |
| Rev Ind | Revision | Appd | Year Week | DC AUX. VOLTAGE SUPPLY |


Design checked by
B NILSSON
Drawing checked by
L SVENSSON
Drawn by
PN

CIRCUIT DIAGRAM
S/S 8501 132/33kV
SCECO CENTRAL SAUDI ARABIA
ABB HV SWITCHGEAR
Rev Ind Sheet
TDCF 90 36

L 9743.1017
XL 824 028-FBR
Rev Ind Sheet
2 965

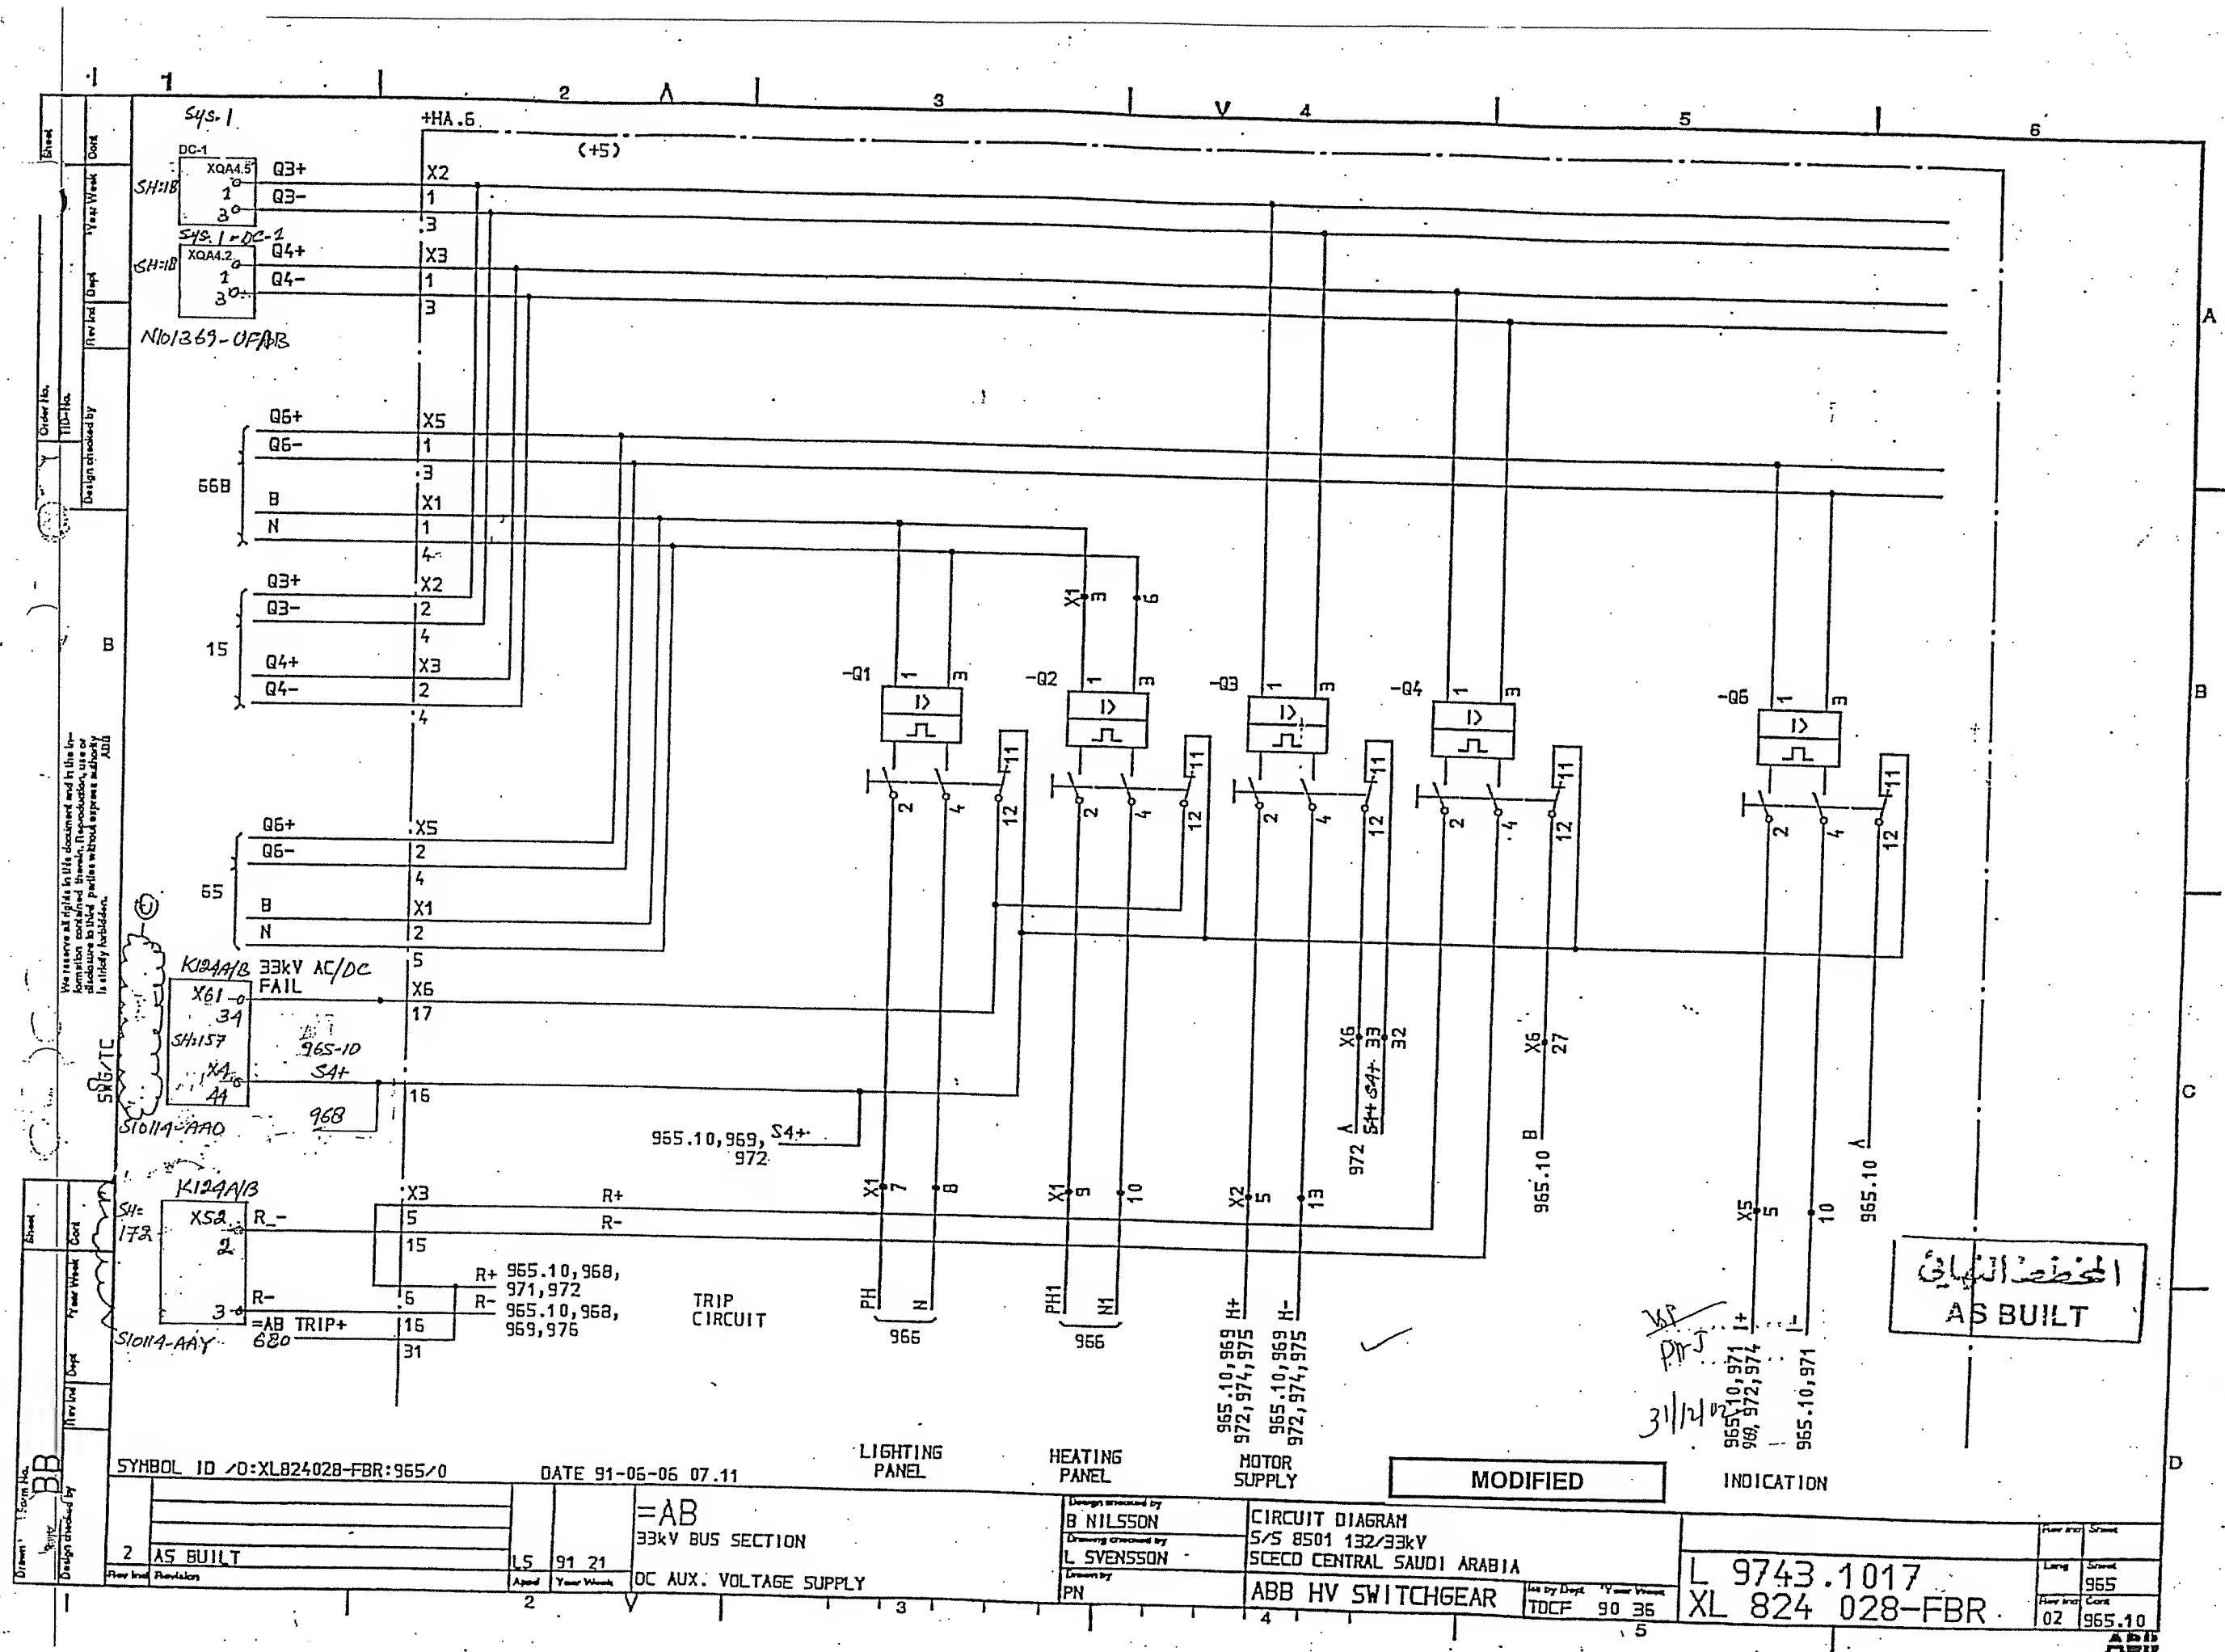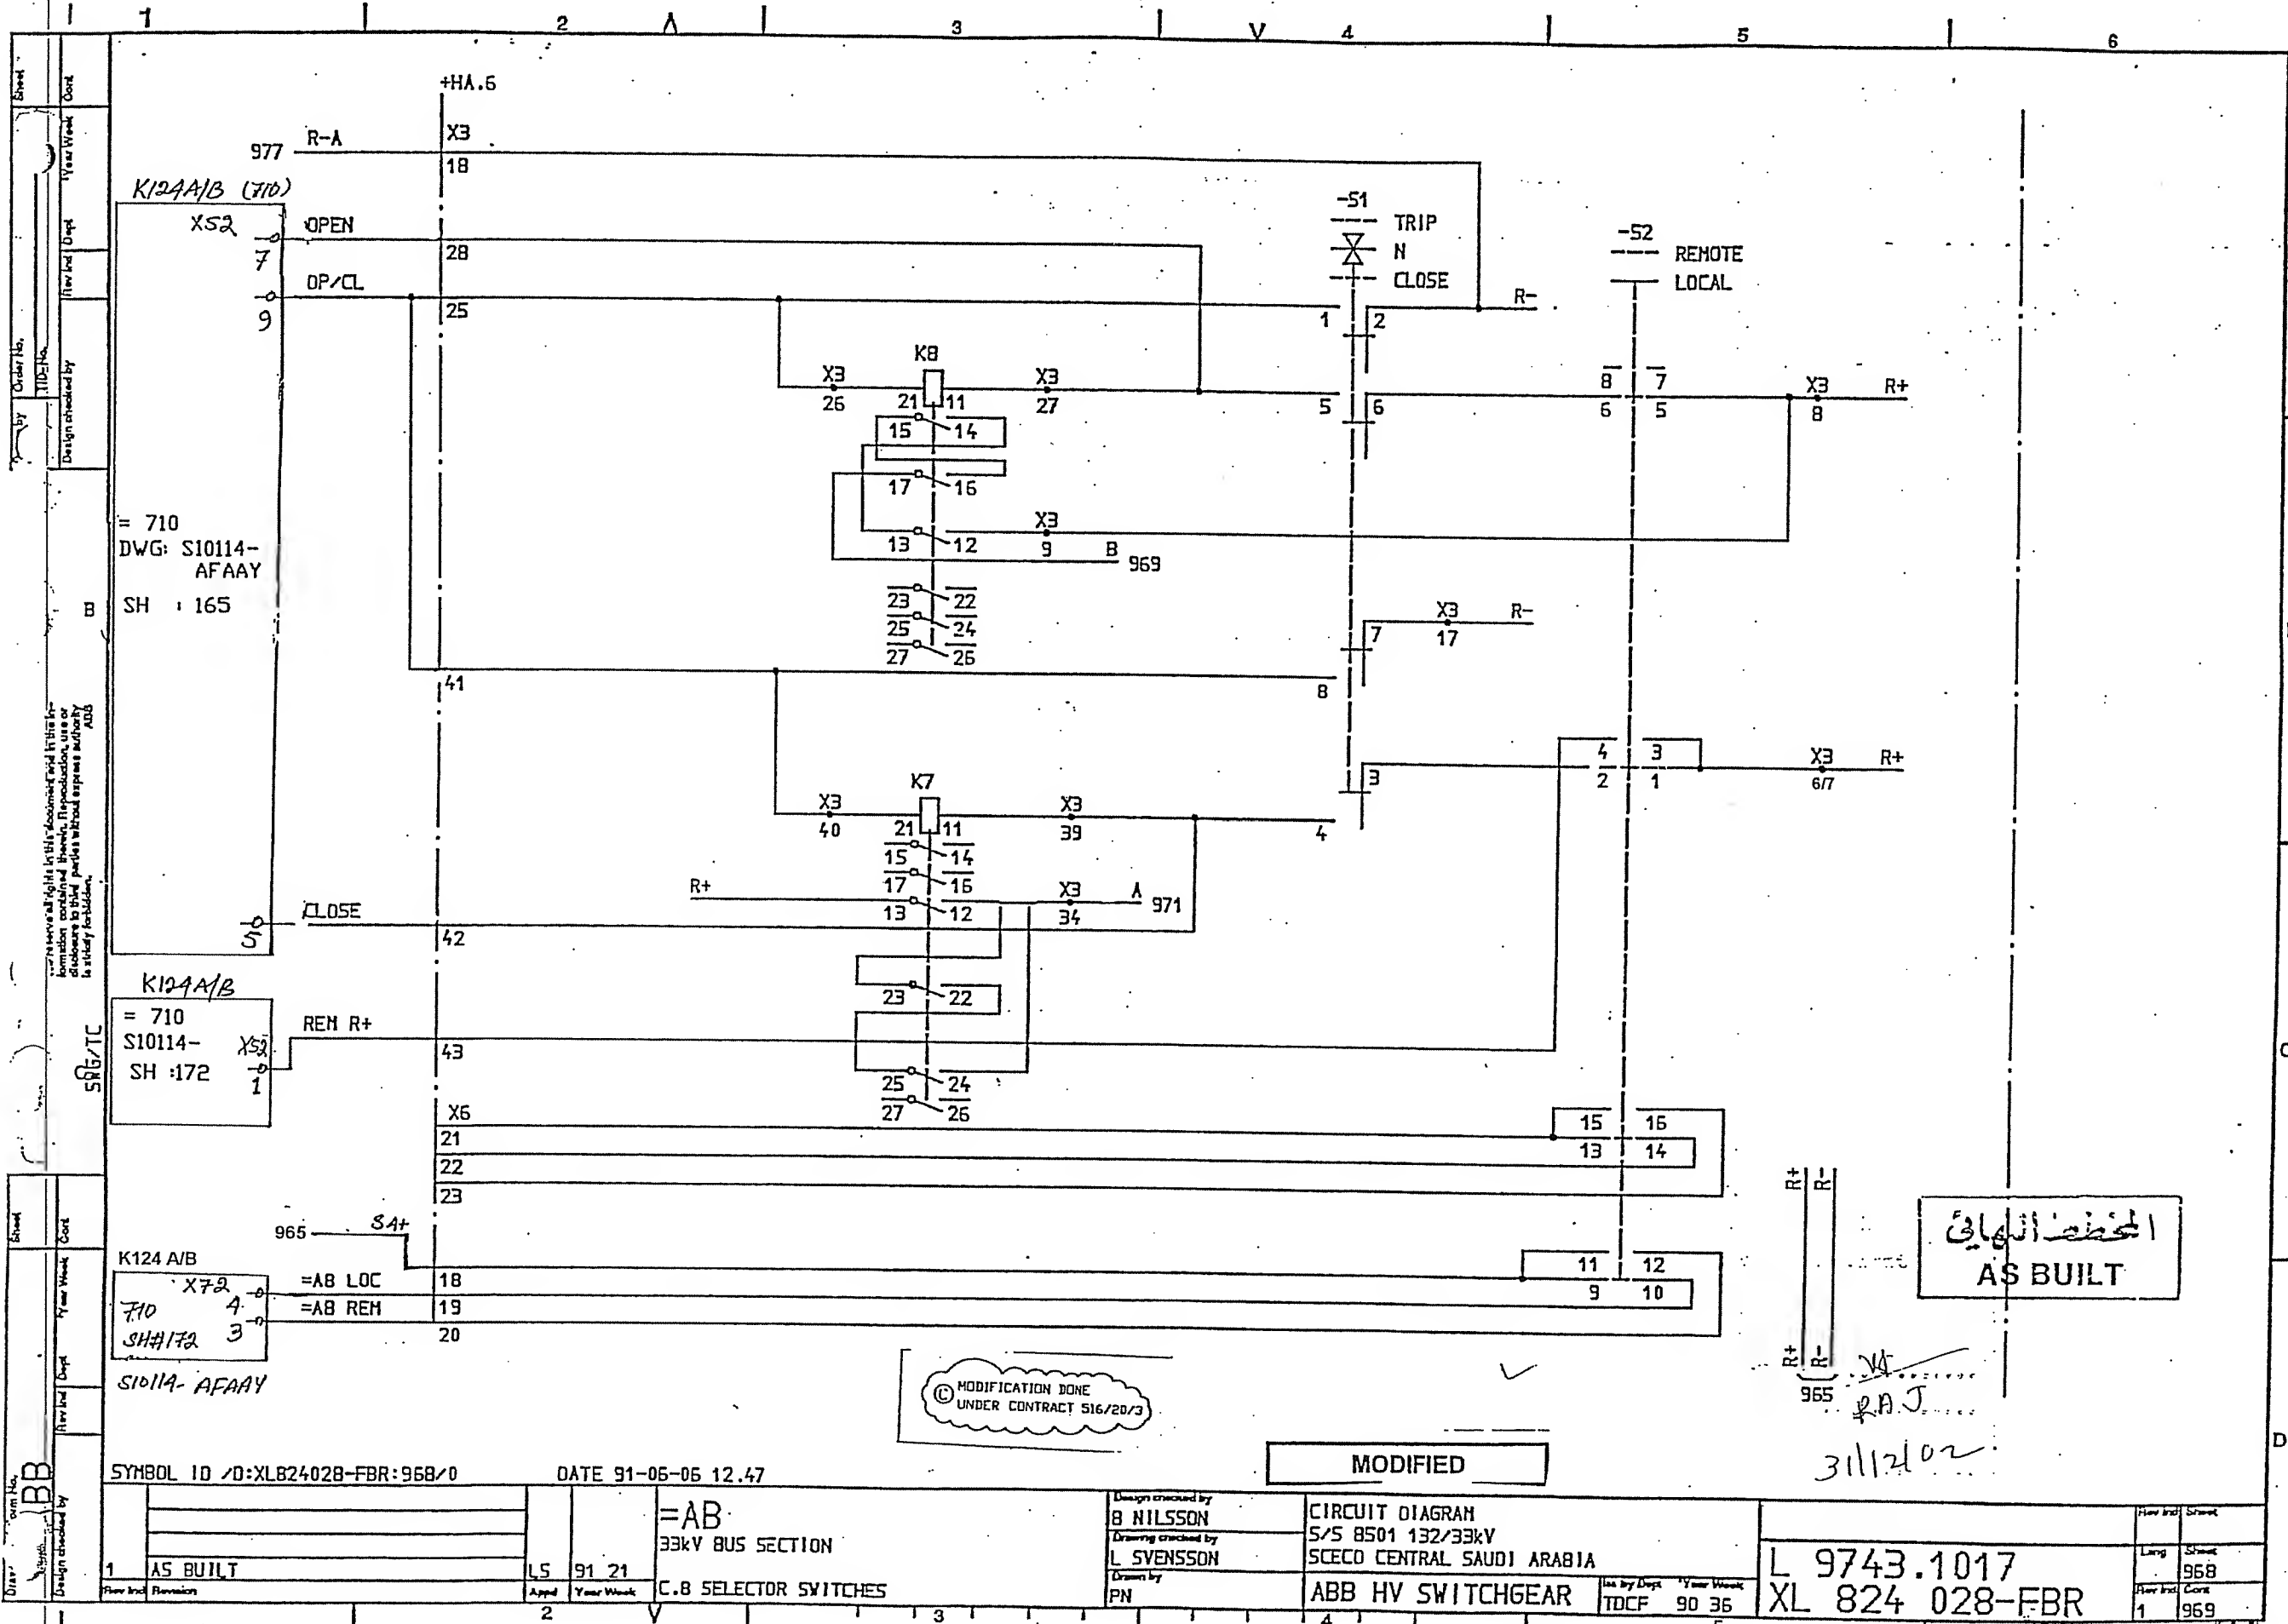ABB





المخطط النهائي
AS BUILT


MODIFICATION DONE
UNDER CONTRACT 516/20/3

MODIFIED


L 9743.1017
XL 824 028-FBR

| Rev | Rev | Rev |
|-----|-----|-----|
| 1 | 1 | 1 |
| 968 | 968 | 968 |
| 969 | 969 | 969 |

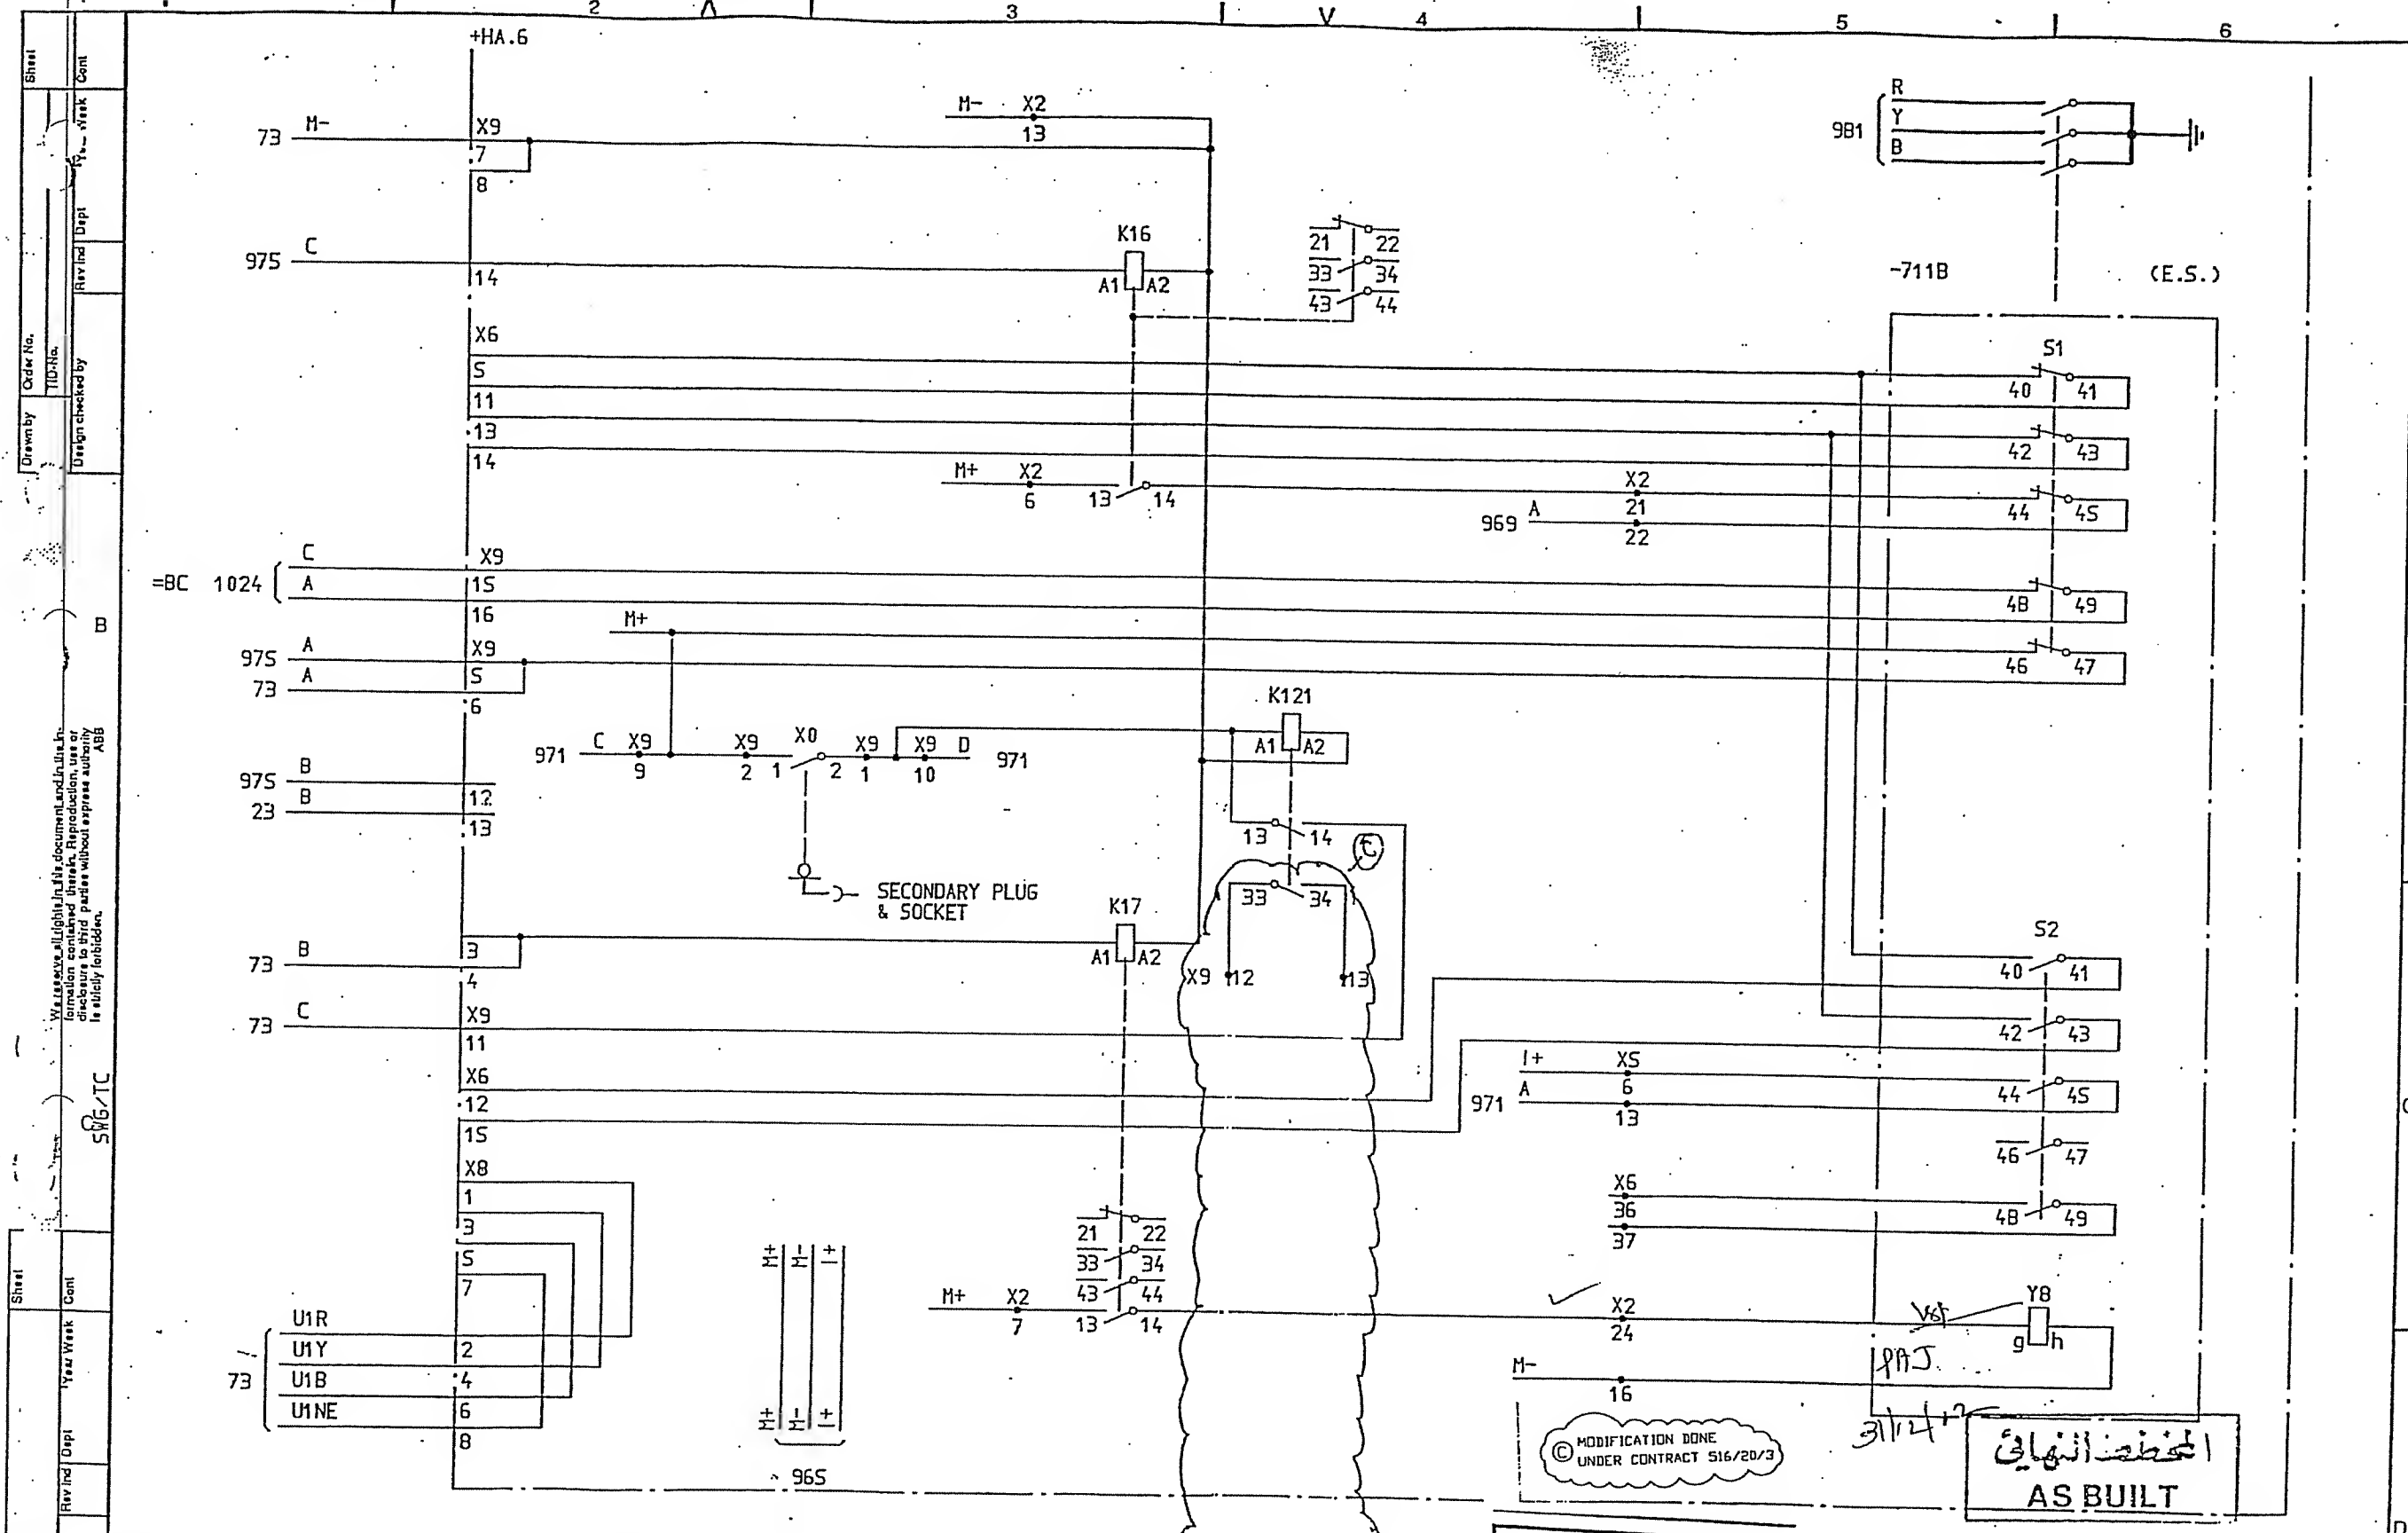ABB





| | | | | | | | | | | | | | |
|---------------------------------|--|----------------|--|------------------------------|--|----------------------------------|--|----------------------------|--|----------------|--|---------------|--|
| SYMBOL ID /D:XL824028-FBR:974/0 | | 92-07-02 19.00 | | | | Design checked by B NILSSON | | CIRCUIT DIAGRAM | | | | Rev Ind Sheet | |
| | | | | | | Drawing checked by L SVENSSON | | S/S 8501 132/33kV | | | | Lang Sheet | |
| 2 SCECO SNAG | | LS 92 26 | | =AB | | Drawn by PN | | SCECO CENTRAL SAUDI ARABIA | | L 9743.1017 | | 974 | |
| 1 AS BUILT | | LS 91 21 | | 33kV BUS SECTION | | | | | | XL 824 028-FBR | | 975 | |
| Rev Ind Revision | | Appd Year Week | | EARTH SWITCH EQUIPMENT -711B | | | | | | | | Rev Ind Cont | |
| | | 2 | | AND INTERLOCKING RELAY | | | | | | | | 2 | |
| | | | | | | | | | | | | | |
| | | | | | | | | | | | | | |
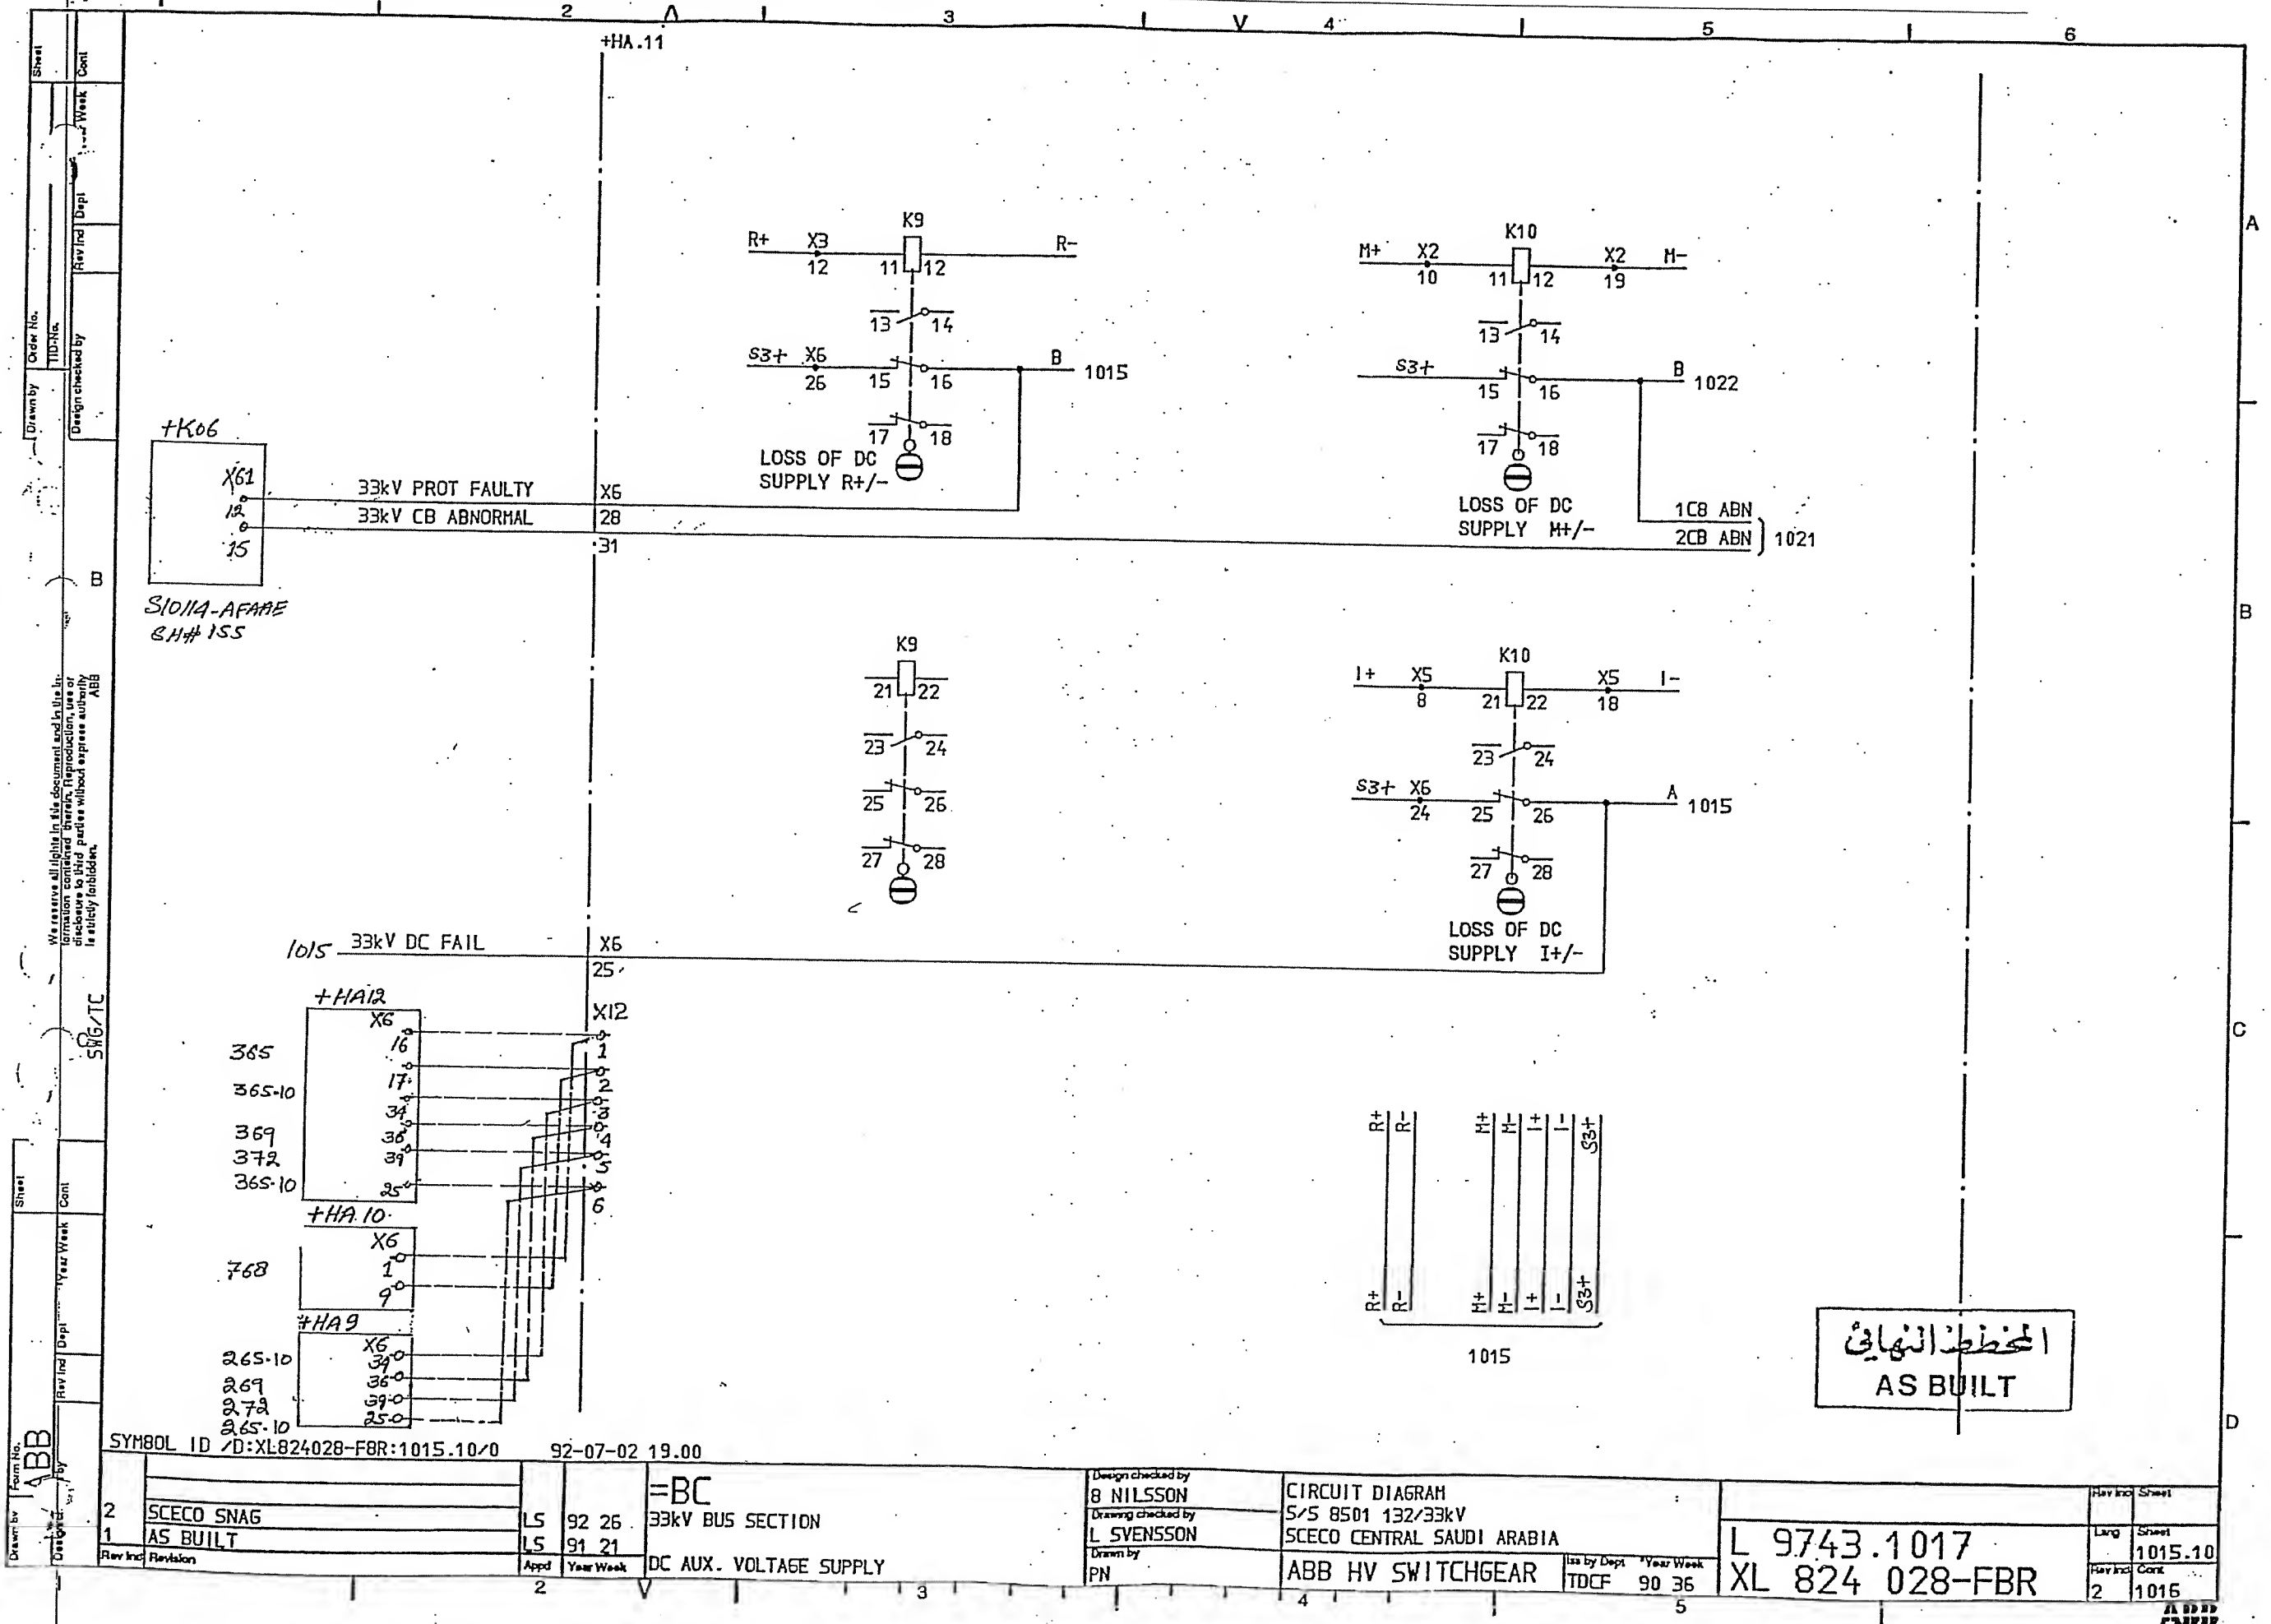

المخطط النهائي
AS BUILT

| | | | | | | | | | |
|-------------------------------------|--|----------------|--|------------------------|--|----------------------------|--|----------------|--|
| SYMBOL ID /D:XL824028-FBR:1015.10/0 | | 92-07-02 19.00 | | =BC | | CIRCUIT DIAGRAM | | L 9743.1017 | |
| SCECO SNAG | | LS 92 26 | | 33kV BUS SECTION | | S/S 8501 132/33kV | | XL 824 028-FBR | |
| AS BUILT | | LS 91 21 | | DC AUX. VOLTAGE SUPPLY | | SCECO CENTRAL SAUDI ARABIA | | 1015.10 | |
| Rev Inc Revision | | Appd Year Week | | Design checked by | | ABB HV SWITCHGEAR | | 1016 | |
| 2 | | 2 | | B NILSSON | | Iss by Dept Year Week | | 2 | |
| 1 | | 1 | | L SVENSSON | | TDCF 90 36 | | 1015 | |
| | | | | Drawn by | | | | | |
| | | | | PN | | | | | |

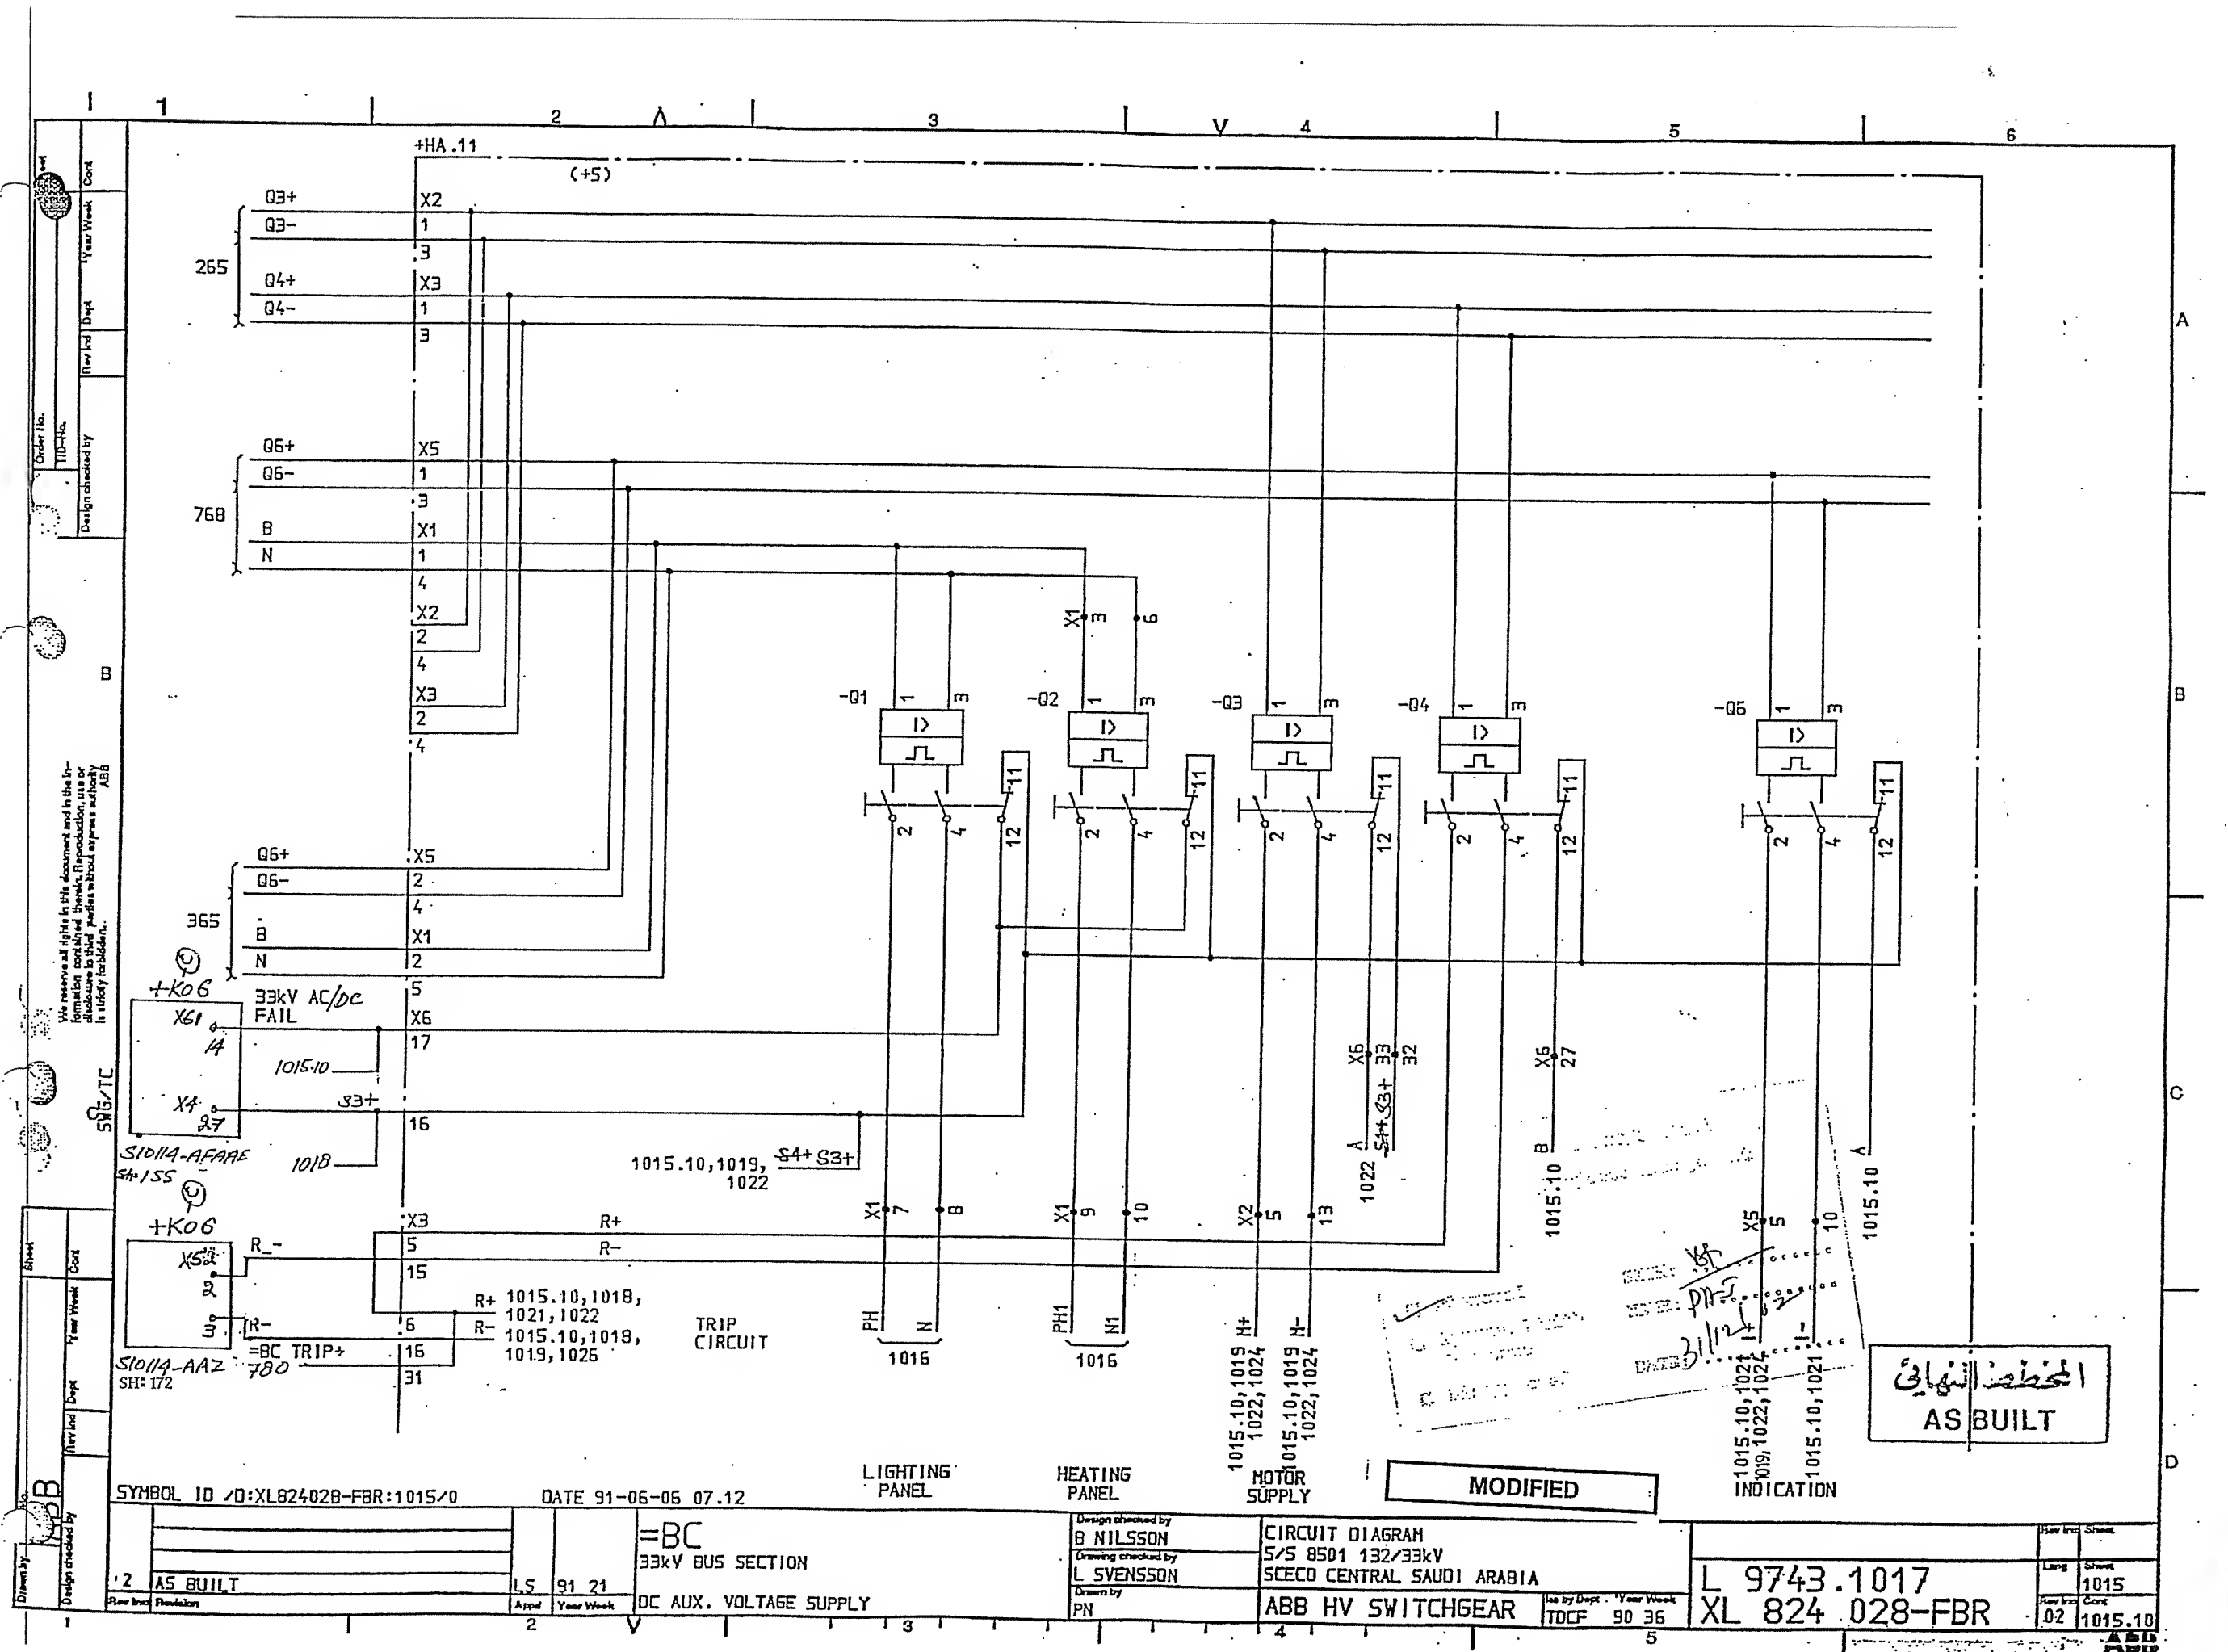

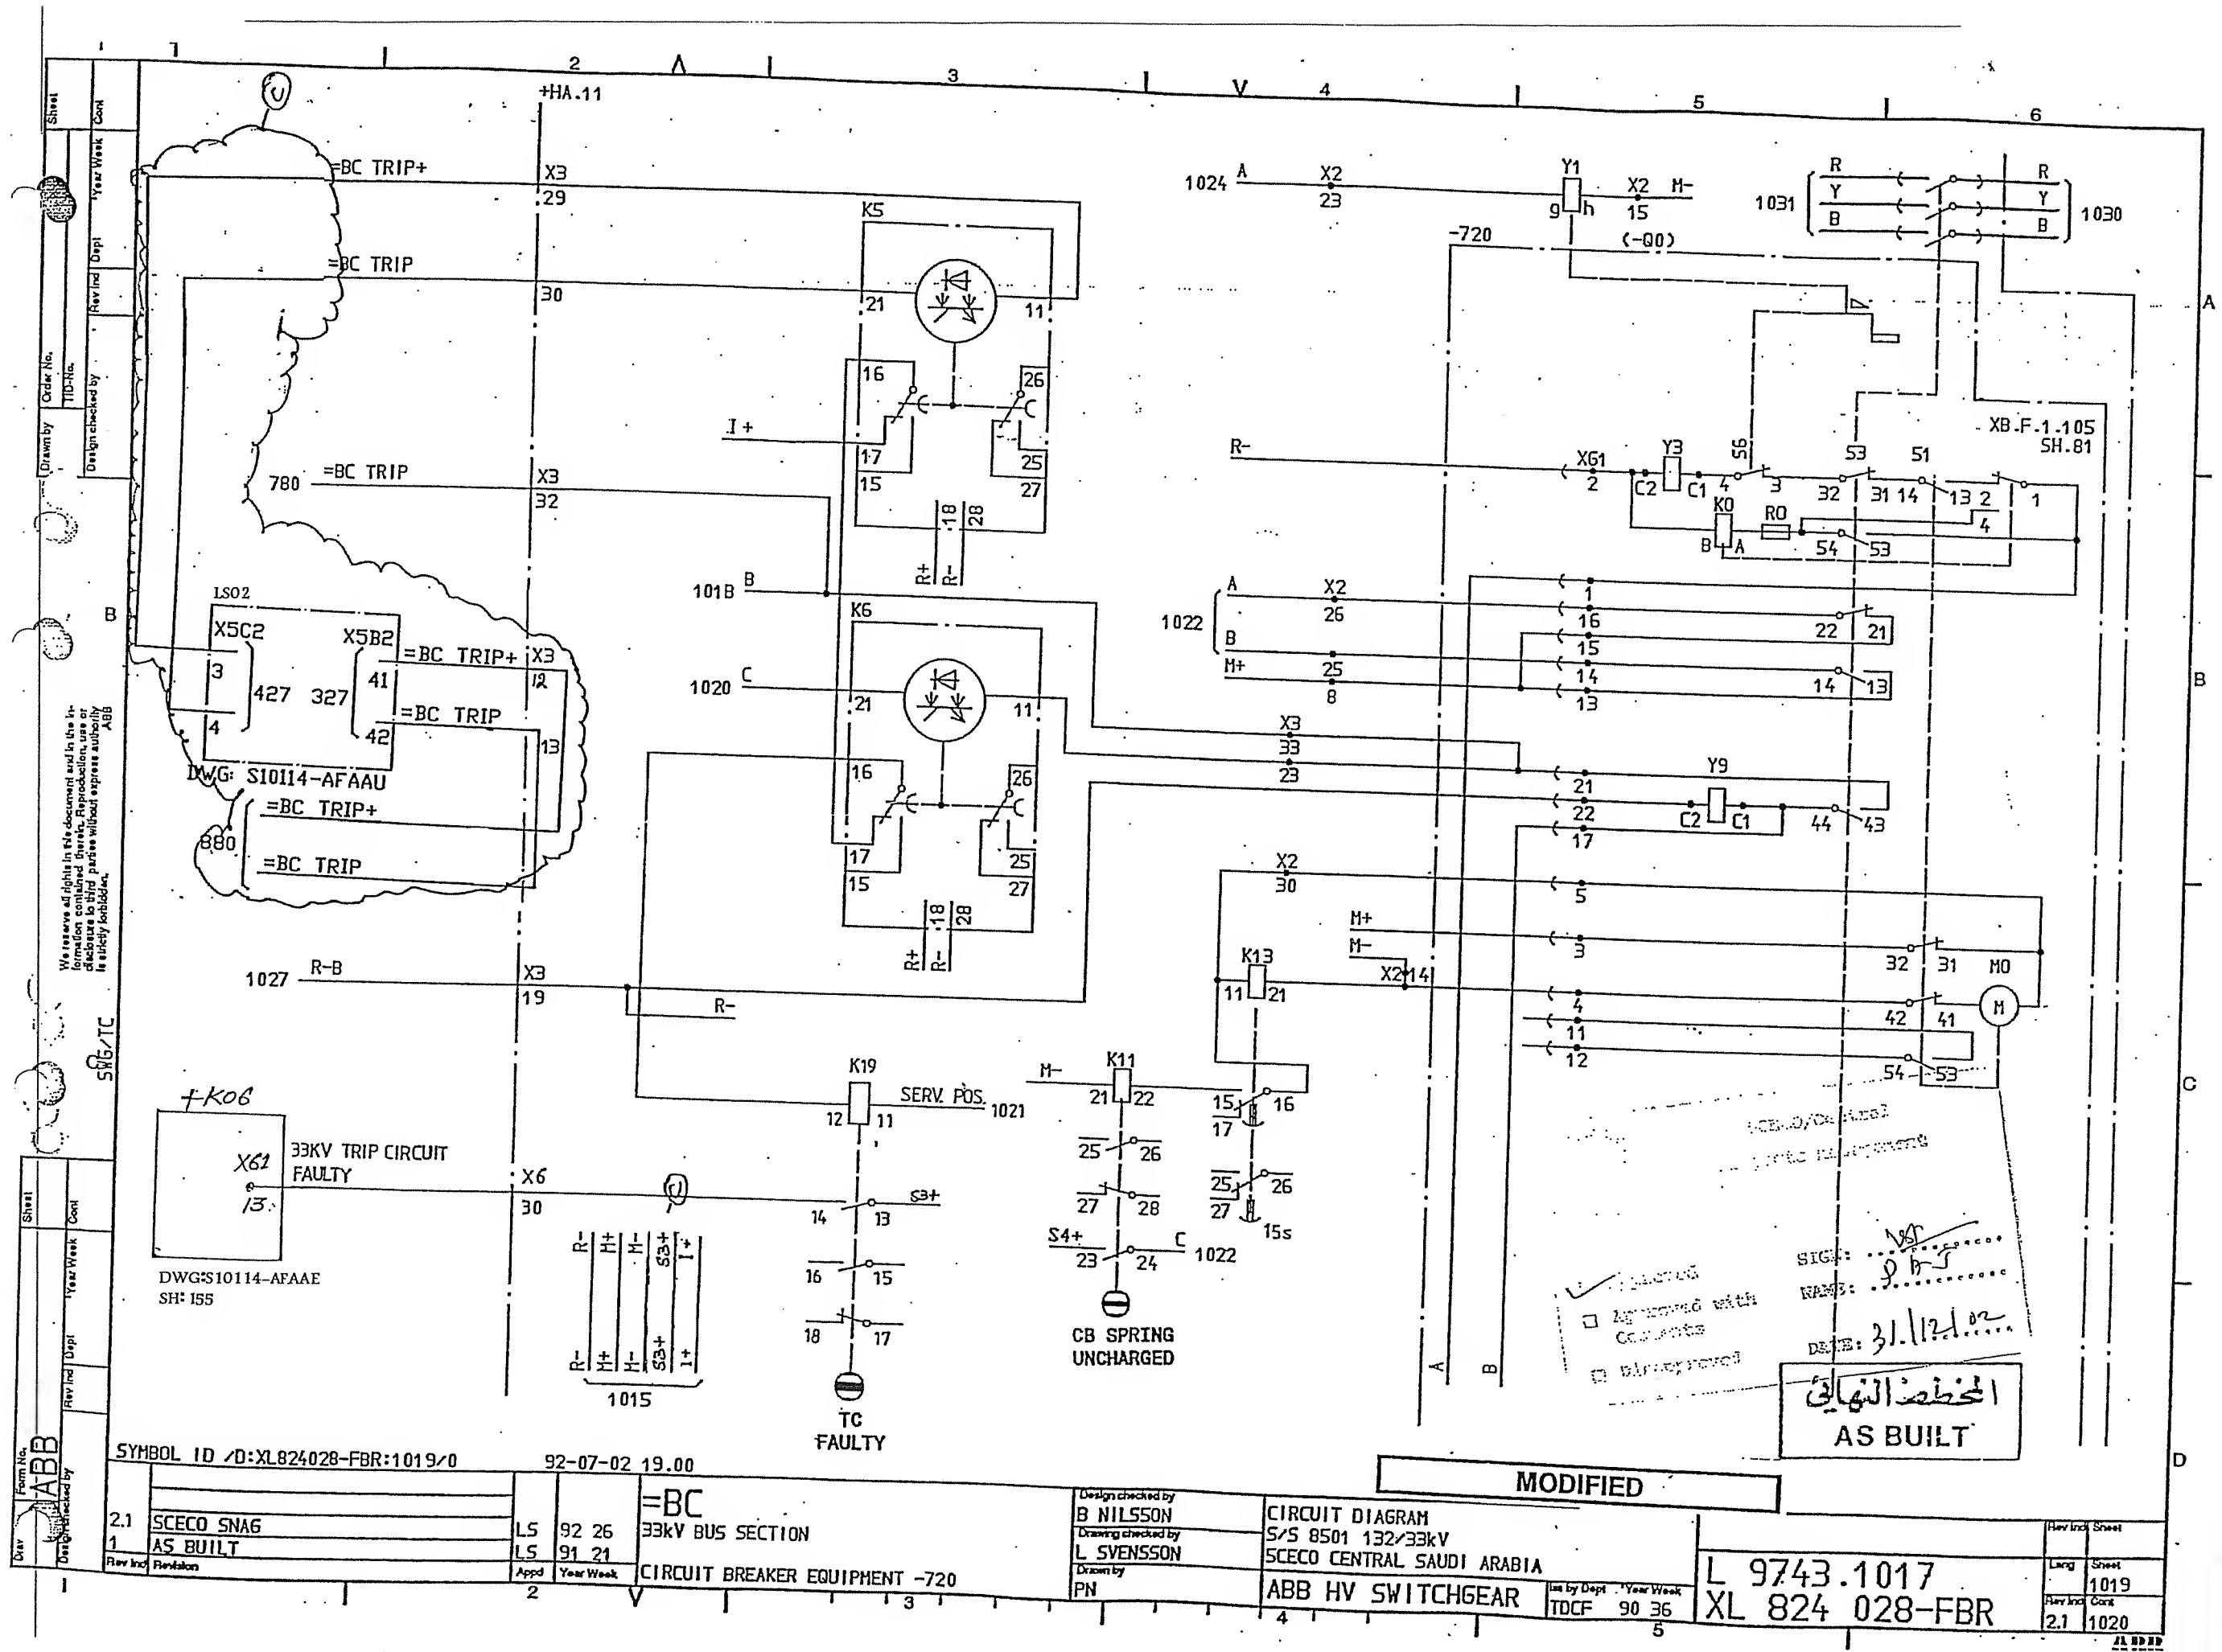

Sheet 1 of 1
 Order No. 92-07-02 19.00
 Design checked by L SVENSSON
 Drawn by PN
 We reserve all rights in this document and in the information contained herein. Reproduction, use or disclosure to third parties without express authority is strictly prohibited.

SYMBOL ID /D:XL824028-FBR:1019/0

| | | | |
|-----|------------|----|-------|
| 2.1 | SCECO SNA6 | LS | 92 26 |
| 1 | AS BUILT | LS | 91 21 |

33kV BUS SECTION
 CIRCUIT BREAKER EQUIPMENT -720

Design checked by B NILSSON
 Drawing checked by L SVENSSON
 Drawn by PN

CIRCUIT DIAGRAM
 S/S 8501 132/33kV
 SCECO CENTRAL SAUDI ARABIA
 ABB HV SWITCHGEAR

Issued by Dept. Year Week
 TDCF 90 36

L 9743.1017
 XL 824 028-FBR

| | | |
|-----|------|-------|
| Rev | Ind | Sheet |
| 2.1 | 1019 | 1020 |

MODIFIED

المخطط النهائي
 AS BUILT
 SIGN: [Signature]
 NAME: [Name]
 DATE: 31.12.92

- ☒ Approved
- ☐ Agreed with Comments
- ☐ Disapproved